


BOSTWICK ROAD

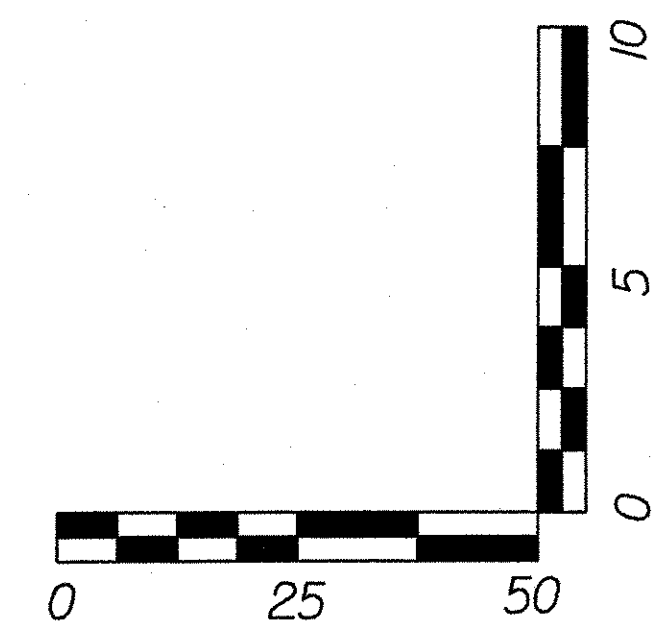

DATUM  
 VERTICAL NAVD 88  
 HORIZONTAL NAD 83 (1996)

PROFILE

PROJECT NAME:	SHELBURNE
PROJECT NUMBER:	BRO 1445(30)
FILE NAME:	m:\595402 Bostwick\HWY\DRAW\PROFILES\prof001.dgn
PROJECT LEADER:	MBZ
DESIGNED BY:	DMB
CHECKED BY:	MDL
PLOT DATE:	01-AUG-2003
DRAWN BY:	MJF
SHEET	24 OF 73