

BOSTWICK ROAD

BRIDGE #15
BOSTWICK ROAD OVER
VERMONT RAILWAYS

STA 19+35.86 BOSTWICK ROAD =
STA 40+00.00 BOSTWICK FARM ROAD DRIVE
ELEVATION = 240.49

STA 20+00.88
STOP ROADWAY
BEGIN BRIDGE

STA 20+93.19
END BRIDGE
RESUME ROADWAY

PVI 20+50.00
ELEV 248.34

HP STA 21+54.54
ELEV 245.37

PVT 22+50.00
ELEV 244.44


6.2208%

-1.9500%

EXISTING GROUND
ALONG CENTERLINE

PROPOSED GRADE
ALONG CENTERLINE

L = 400.00 FT
K = 49

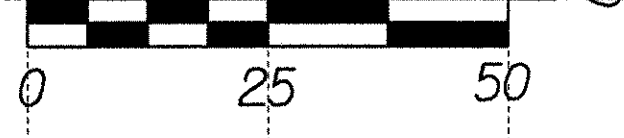

DATUM
VERTICAL NAVD 88
HORIZONTAL NAD 83 (1996)

PROFILE

PROJECT NAME: SHELBURNE
PROJECT NUMBER: BRO 1445(30)
FILE NAME: m:\1595402 Bostwick\HWY\DRAW\PROFILES\prof003.dgn
PROJECT LEADER: MBZ PLOT DATE: 01-AUG-2003
DESIGNED BY: DMB DRAWN BY: MJF
CHECKED BY: MDL SHEET 26 OF 73