


VERTICAL CURVE
ELIMINATED
STRAIGHT GRADE

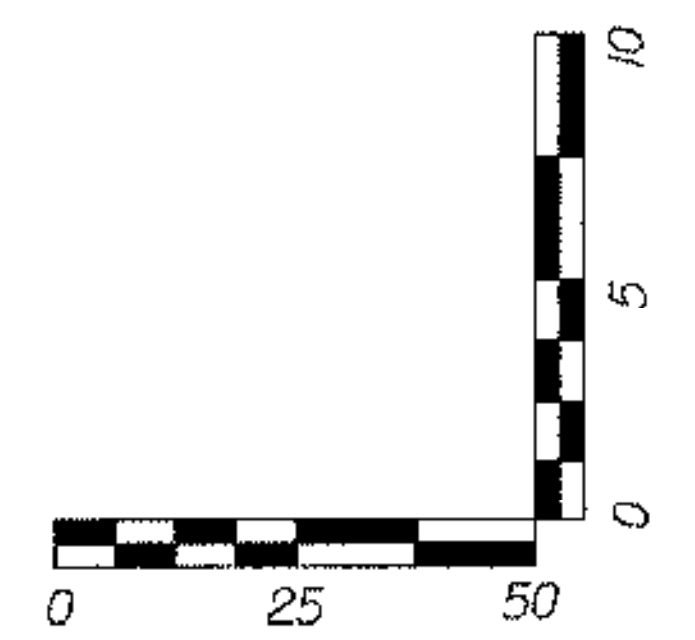

DATUM	
VERTICAL	NAVD 88
HORIZONTAL	NAD 83 (1996)

BOSTWICK FARM ROAD DRIVE

PROFILE	PROJECT NAME:	SHELBURNE	
	PROJECT NUMBER:	BRO 1445(30)	
	FILE NAME:	M:\1595402 Bostwick\HWY\DRAW\PROFILES\prof005.dgn	
	PROJECT LEADER:	MBZ	PLOT DATE:
DESIGNED BY:	DMB	DRAWN BY:	MJF
CHECKED BY:	MDL	SHEET	26 OF 73