



STA 13+60.00
 BEGIN PROJECT BRO 1445 (30)
 END APPROACH CONSTRUCTION

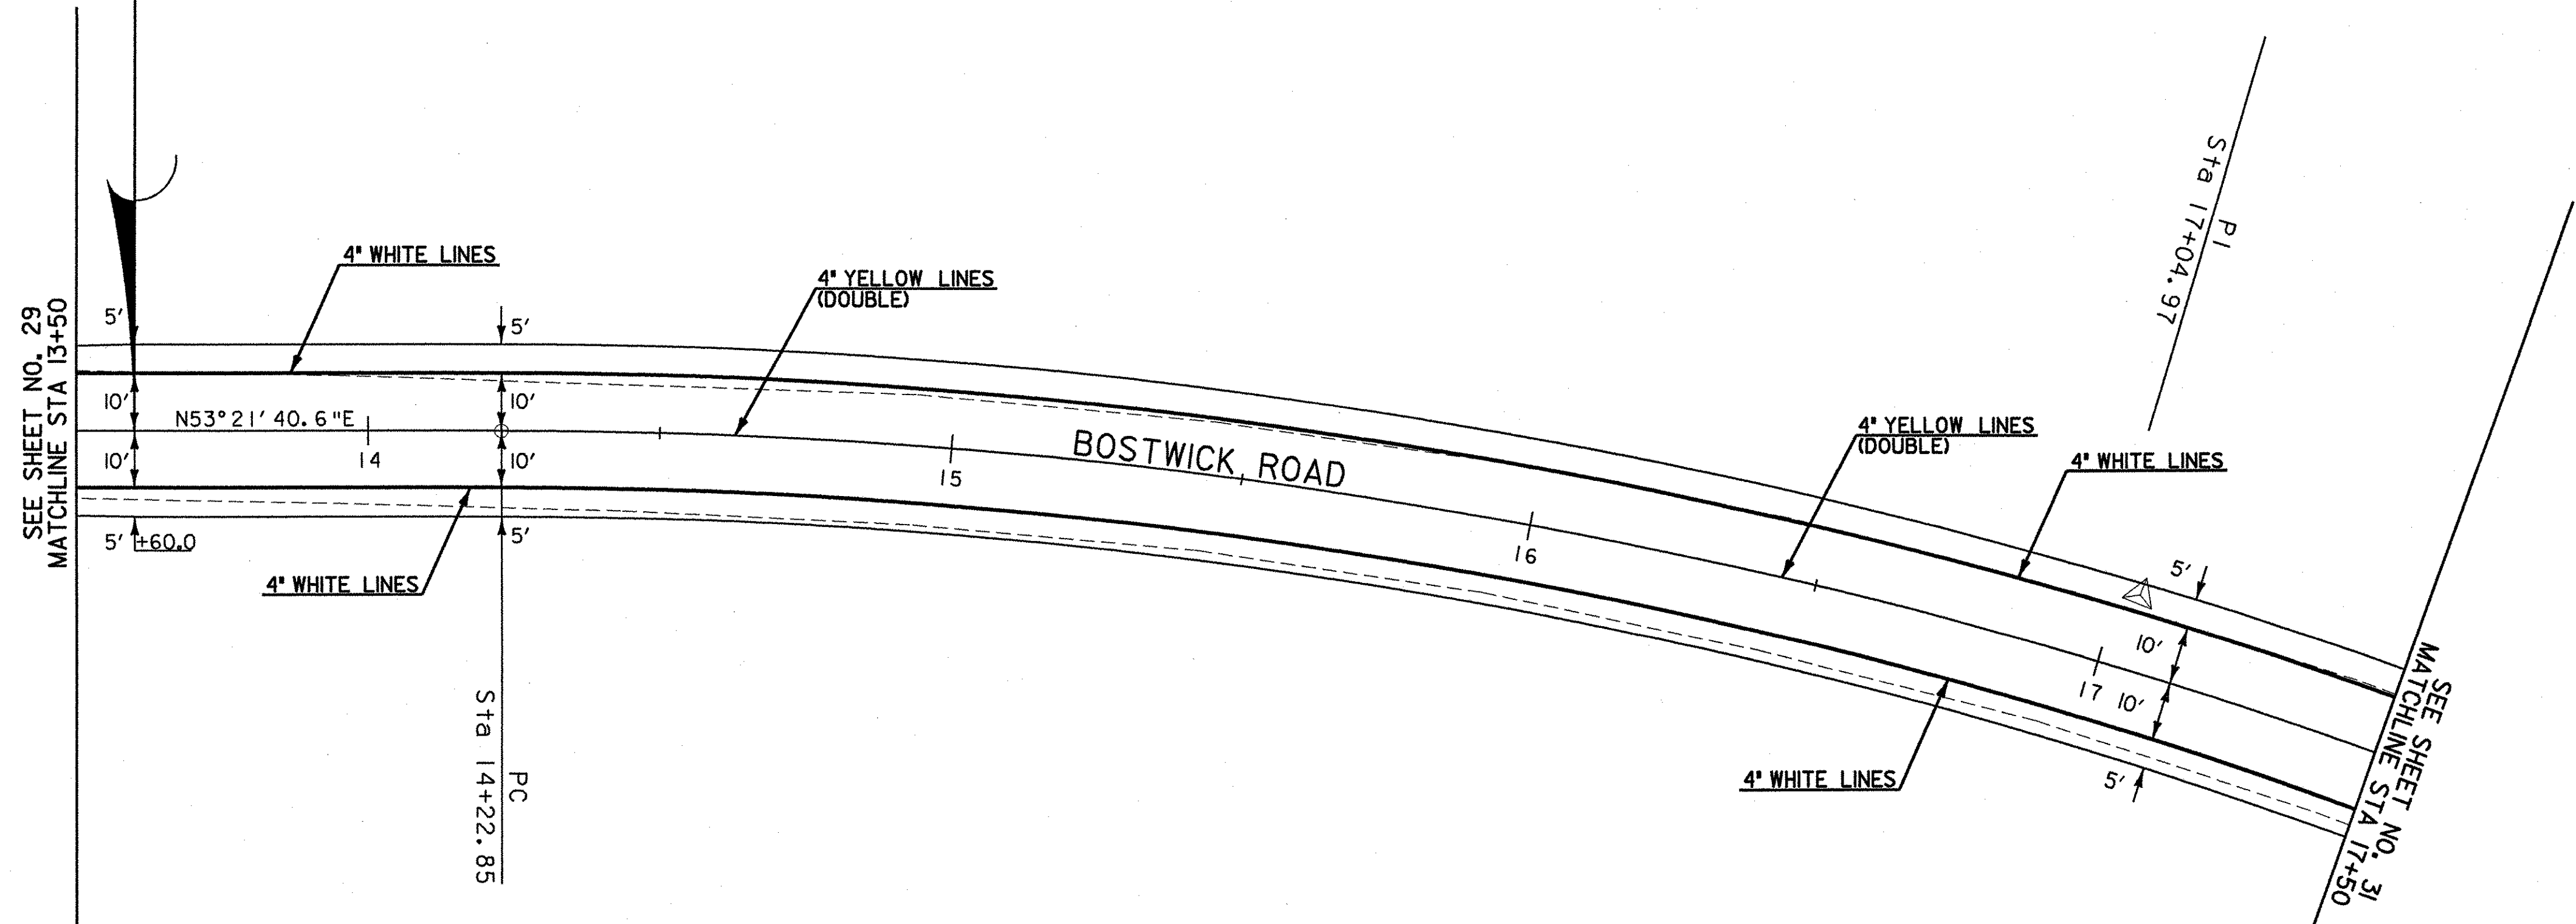

SIGN LEGEND
 R = REMOVE
 S = SALVAGE
 RR = REMOVE AND RESET
 N = NEW
 RET = RETAIN
 B-B = BACK TO BACK
 T-T = THINNING AND TRIMMING
 EXISTING =
 NEW =

DATUM
 VERTICAL NAVD 88
 HORIZONTAL NAD 83 (1996)

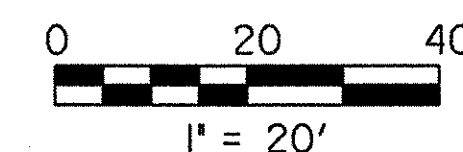

**ALIGNMENT
 SIGNING
 AND
 STRIPING**

PROJECT NAME:	SHELBURNE
PROJECT NUMBER:	BRO 1445(30)
FILE NAME:	M:\595402 Bostwick\HWY\DRAW\SGNPLNS\sgn002.dgn
PROJECT LEADER:	MBZ
DESIGNED BY:	DMB
CHECKED BY:	MDL
PLOT DATE:	01-AUG-2003
DRAWN BY:	MJF
SHEET	30 OF 73