


SIGN LEGEND
 R = REMOVE
 S = SALVAGE
 RR = REMOVE AND RESET
 N = NEW
 RET = RETAIN
 B-B = BACK TO BACK
 T-T = THINNING AND TRIMMING
 EXISTING =
 NEW =

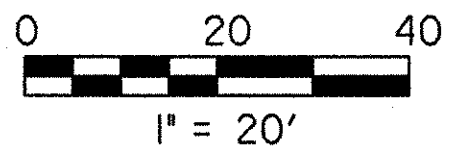

DATUM
 VERTICAL NAVD 88
 HORIZONTAL NAD 83 (1996)

ALIGNMENT SIGNING AND STRIPING	PROJECT NAME: <u>SHELBURNE</u>
	PROJECT NUMBER: <u>BRO 1445(30)</u>
	FILE NAME: <u>M:\1595402 Bostwick\HWY\DRAW\SGNPLNS\sgn003.dgn</u>
	PROJECT LEADER: <u>MBZ</u> PLOT DATE: <u>01-AUG-2003</u>
DESIGNED BY: <u>DMB</u> DRAWN BY: <u>MJF</u>	
CHECKED BY: <u>MDL</u> SHEET <u>31</u> OF <u>73</u>	