



STA 28+25.00
 END APPROACH CONSTRUCTION
 MATCH EXISTING PAVEMENT

STA 26+75.00
 END PROJECT BRO 1445 (30)
 BEGIN APPROACH CONSTRUCTION

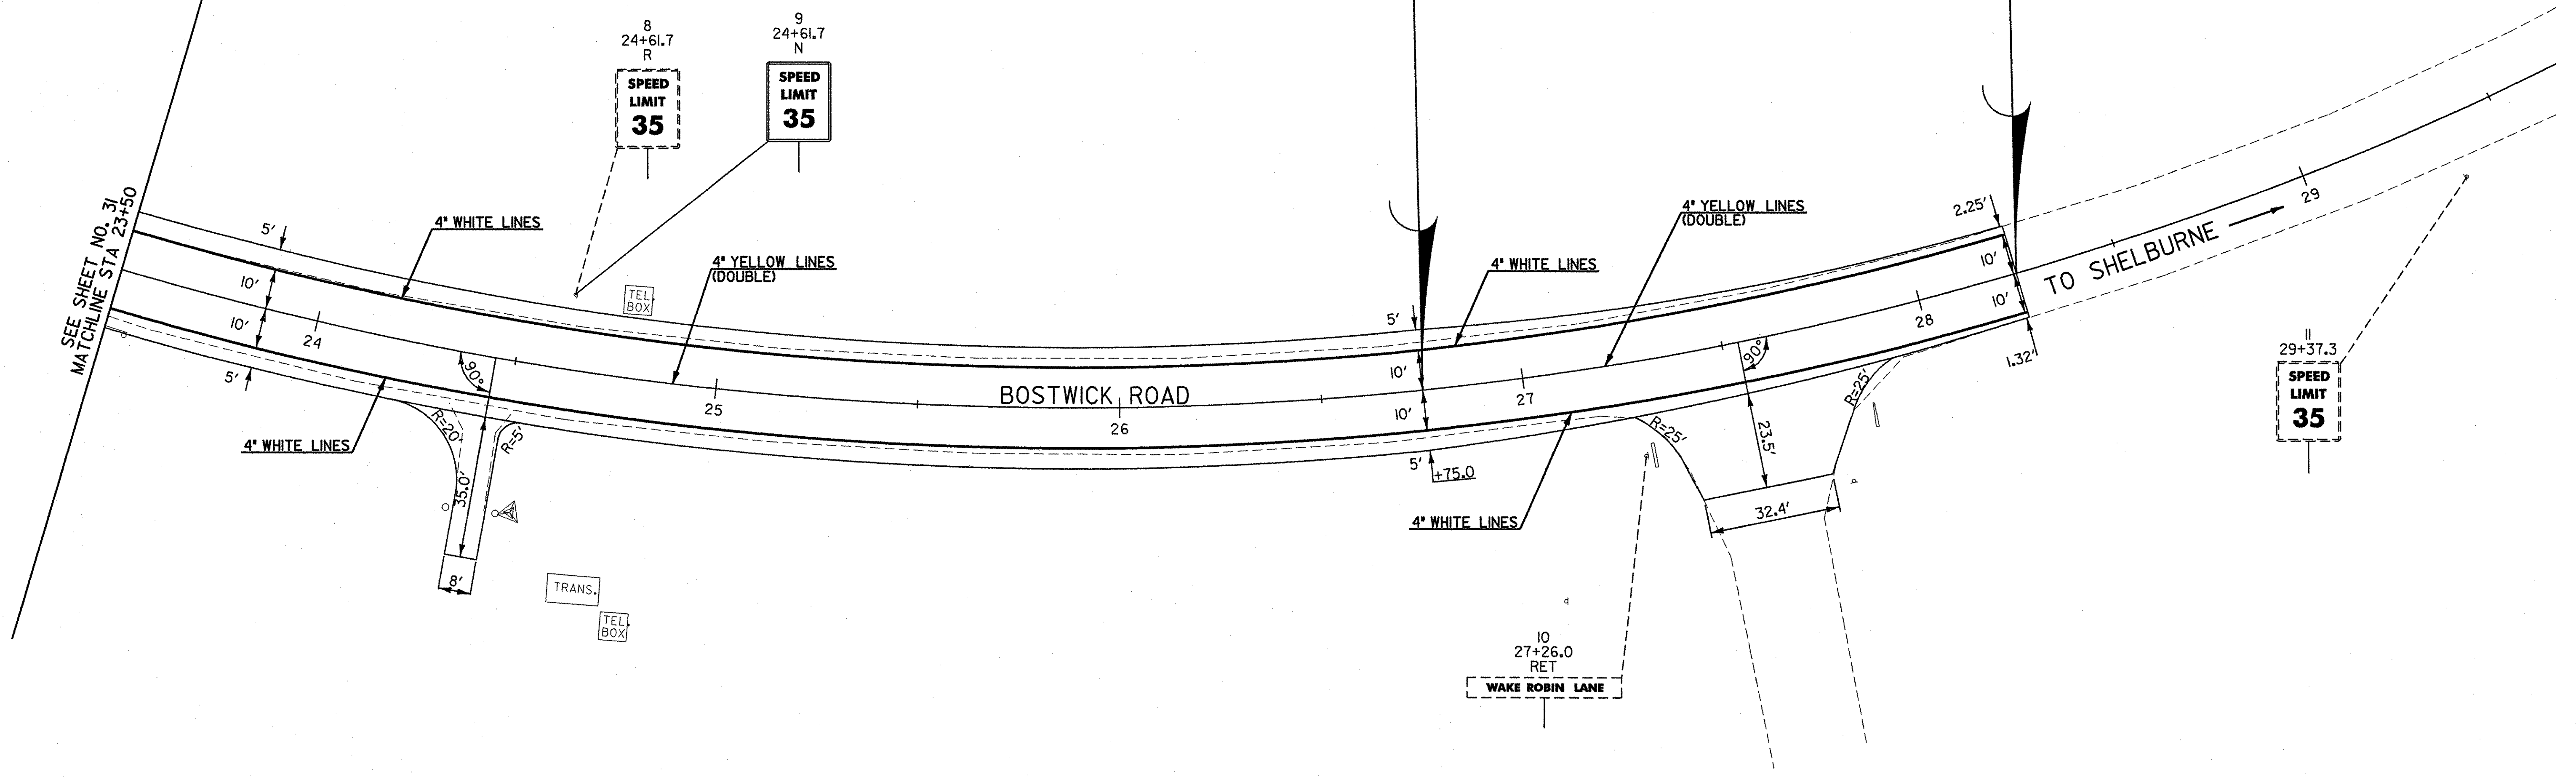

SIGN LEGEND
 R = REMOVE
 S = SALVAGE
 RR = REMOVE AND RESET
 N = NEW
 RET = RETAIN
 B-B = BACK TO BACK
 T-T = THINNING AND TRIMMING
 EXISTING = [dashed box]
 NEW = [solid box]

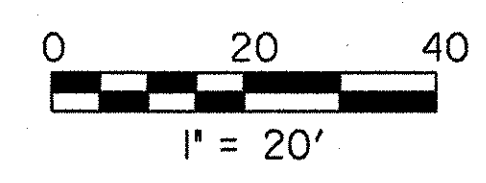

PI
 Sta 26+63.21

DATUM
 VERTICAL NAVD 88
 HORIZONTAL NAD 83 (1996)

ALIGNMENT SIGNING AND STRIPING	PROJECT NAME: SHELBURNE
	PROJECT NUMBER: BRO 1445(30)
	FILE NAME: M:\1595402 Bostwick\HWY\DRAW\SGNPLNS\sgn004.dgn
	PROJECT LEADER: MBZ
DESIGNED BY: DMB	PLOT DATE: 01-AUG-2003
CHECKED BY: MDL	DRAWN BY: MJF
	SHEET 32 OF 73