


BOSTWICK ROAD DETOUR

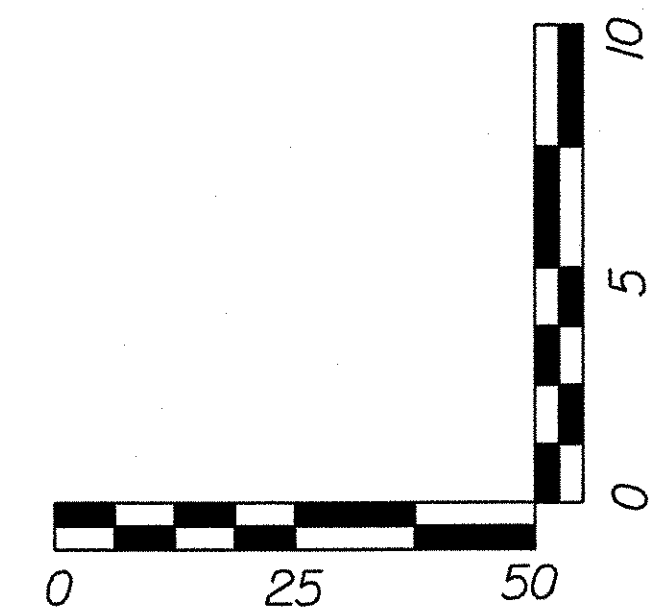

DETOUR
PROFILE

PROJECT NAME:	SHELBURNE
PROJECT NUMBER:	BRO 1445(30)
FILE NAME:	M:\1595402 Bostwick\HWY\DRAW\PROFILES\detprof002.dgn
PROJECT LEADER:	MBZ
DESIGNED BY:	DMB
CHECKED BY:	MDL
PLOT DATE:	01-AUG-2003
DRAWN BY:	MJF
SHEET	39 OF 73

DATUM	
VERTICAL	NAVD 88
HORIZONTAL	NAD 83 (1996)