


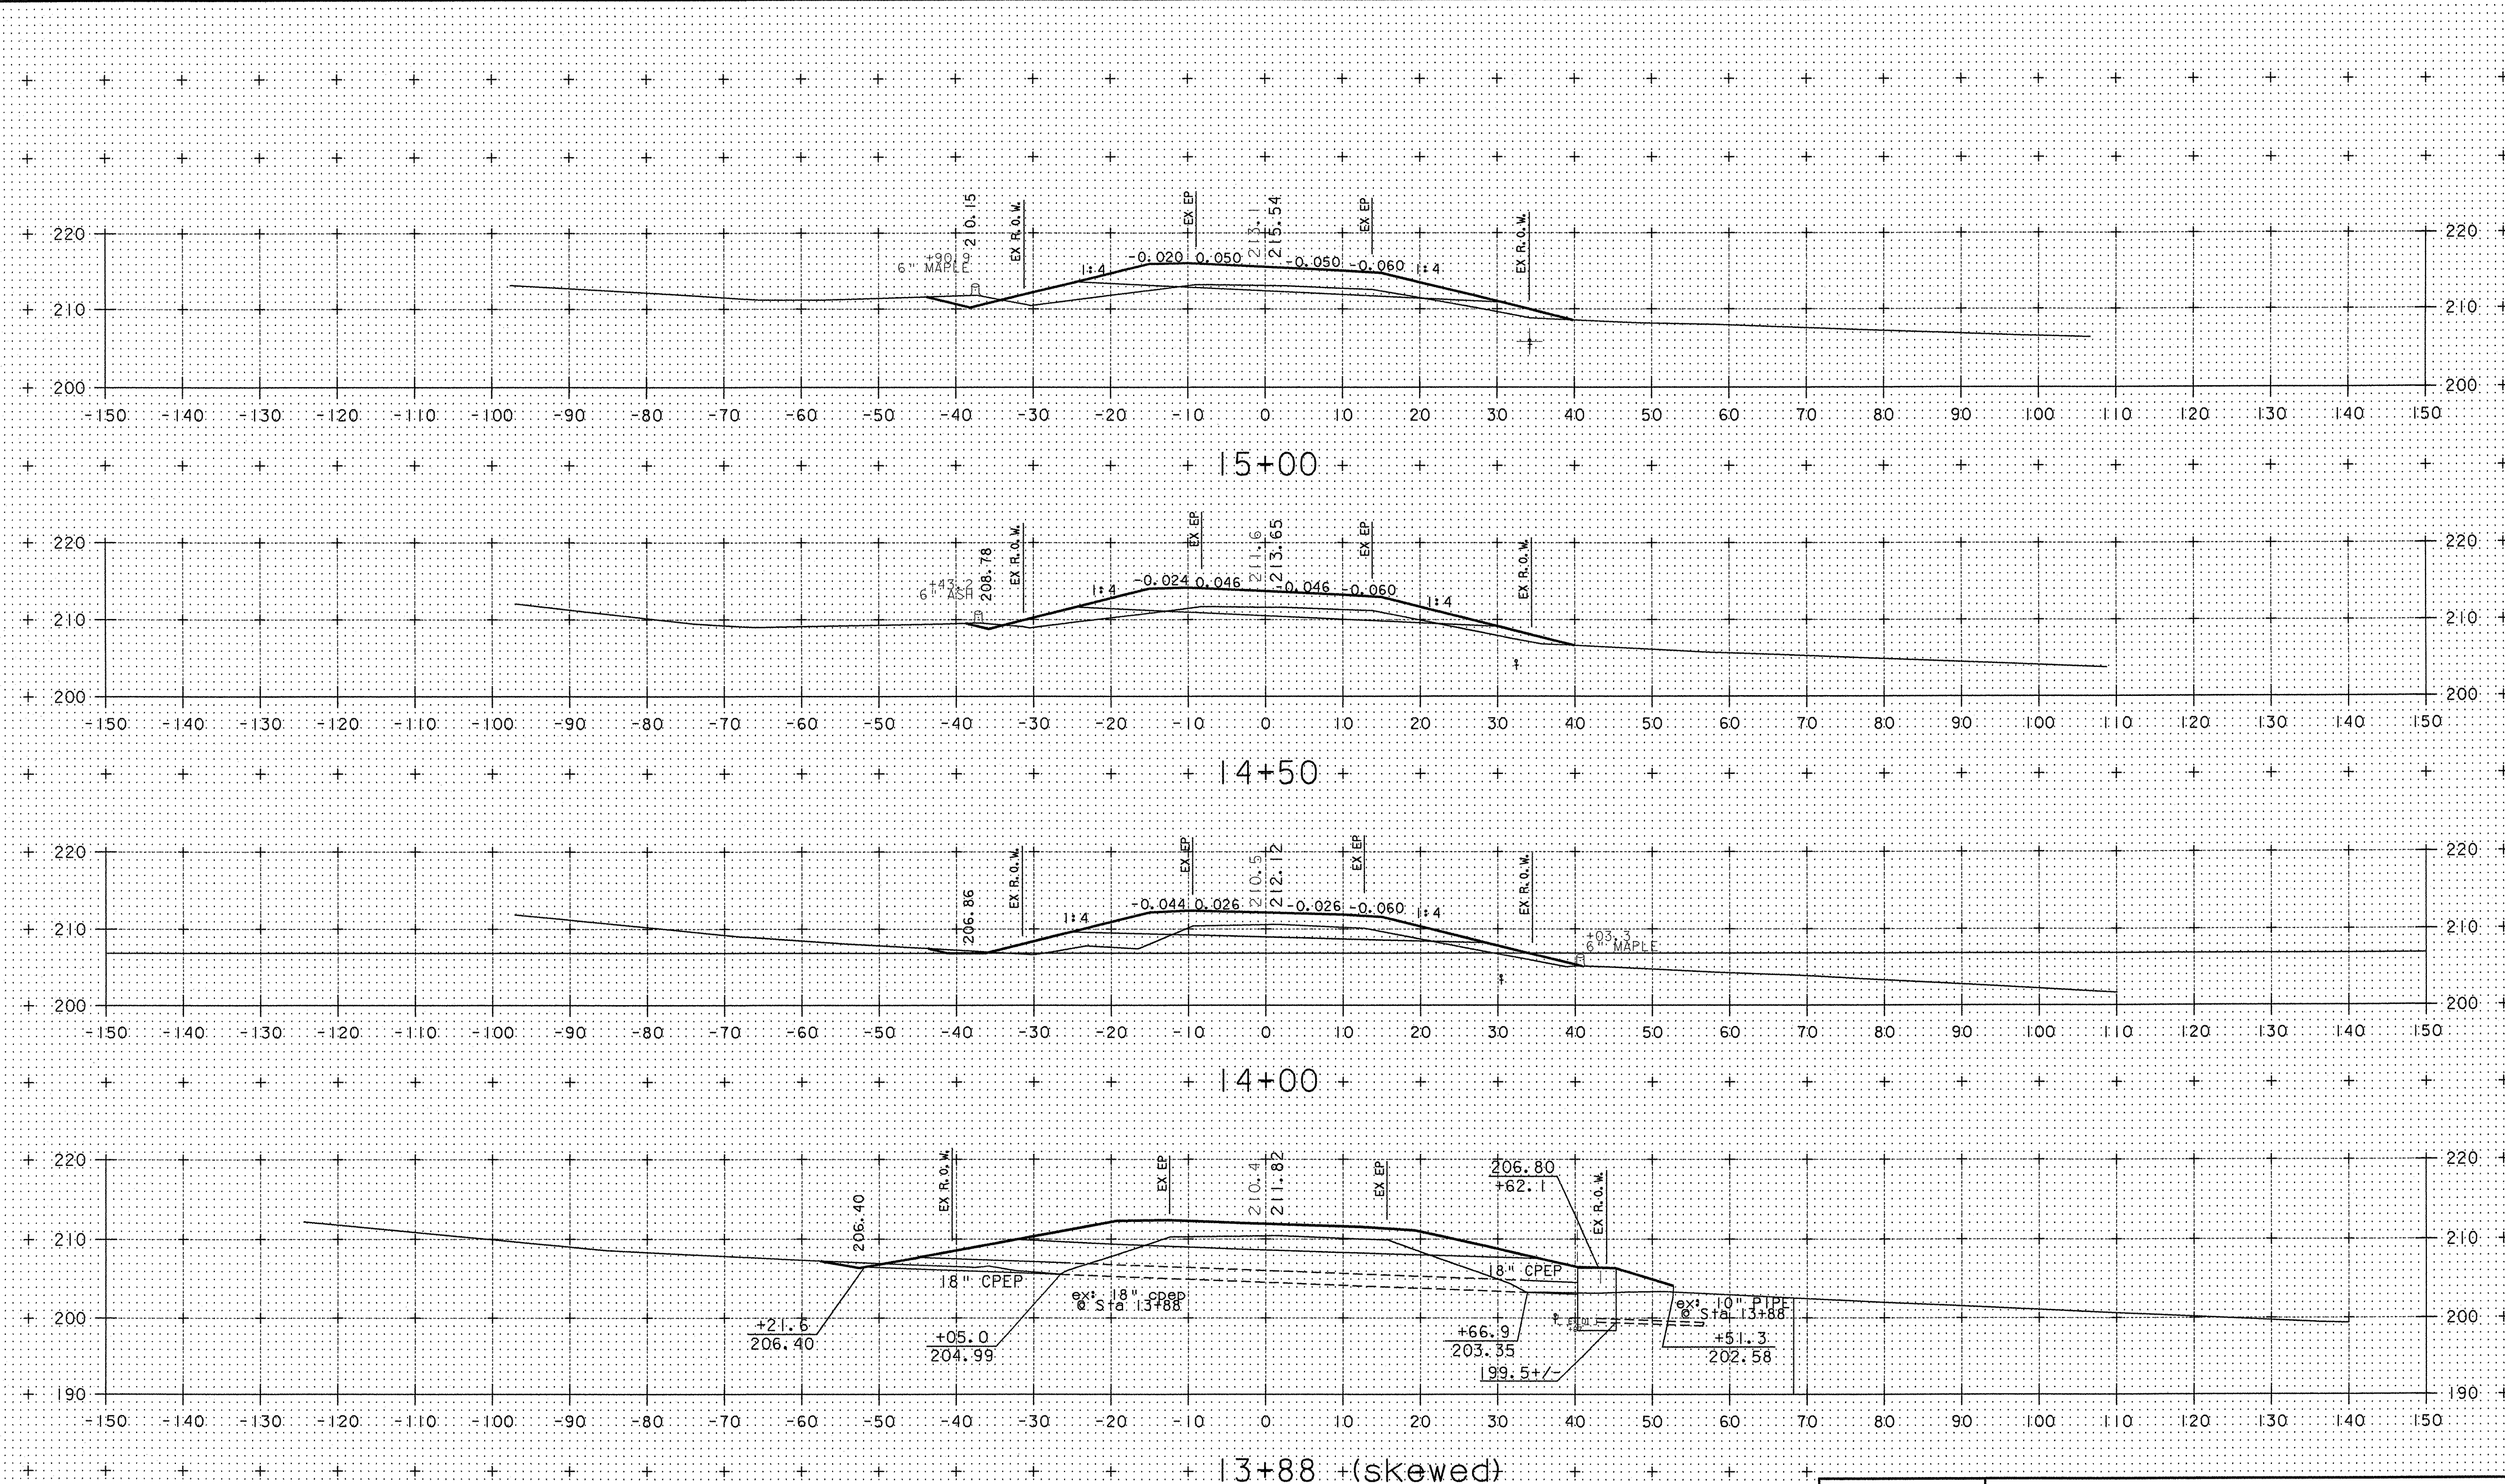

BOSTWICK
ROAD

PROJECT NAME:	SHELBURNE
PROJECT NUMBER:	BRO 1445(30)
FILE NAME:	M:\595402 Bostwick\HWY\DRAW\J196wrk.dgn
PROJECT LEADER:	MBZ
DESIGNED BY:	DMB
CHECKED BY:	MDL
PLOT DATE:	01-AUG-2003
DRAWN BY:	DMB
SHEET	61 OF 73

