

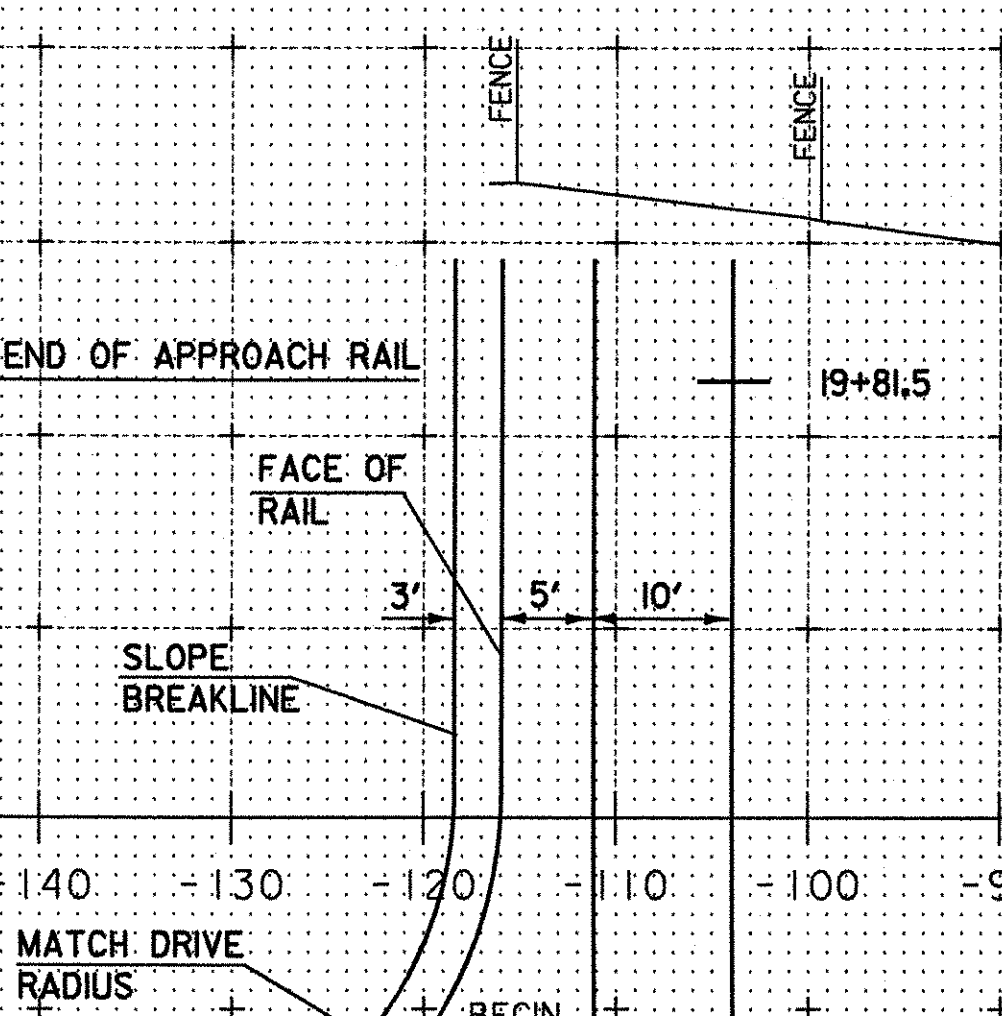


SHOULDER TRANSITION		
STATION	LT	RT
19+00	-0.020	-0.060
19+50	-0.020	-0.016
19+90	-0.020	+0.020

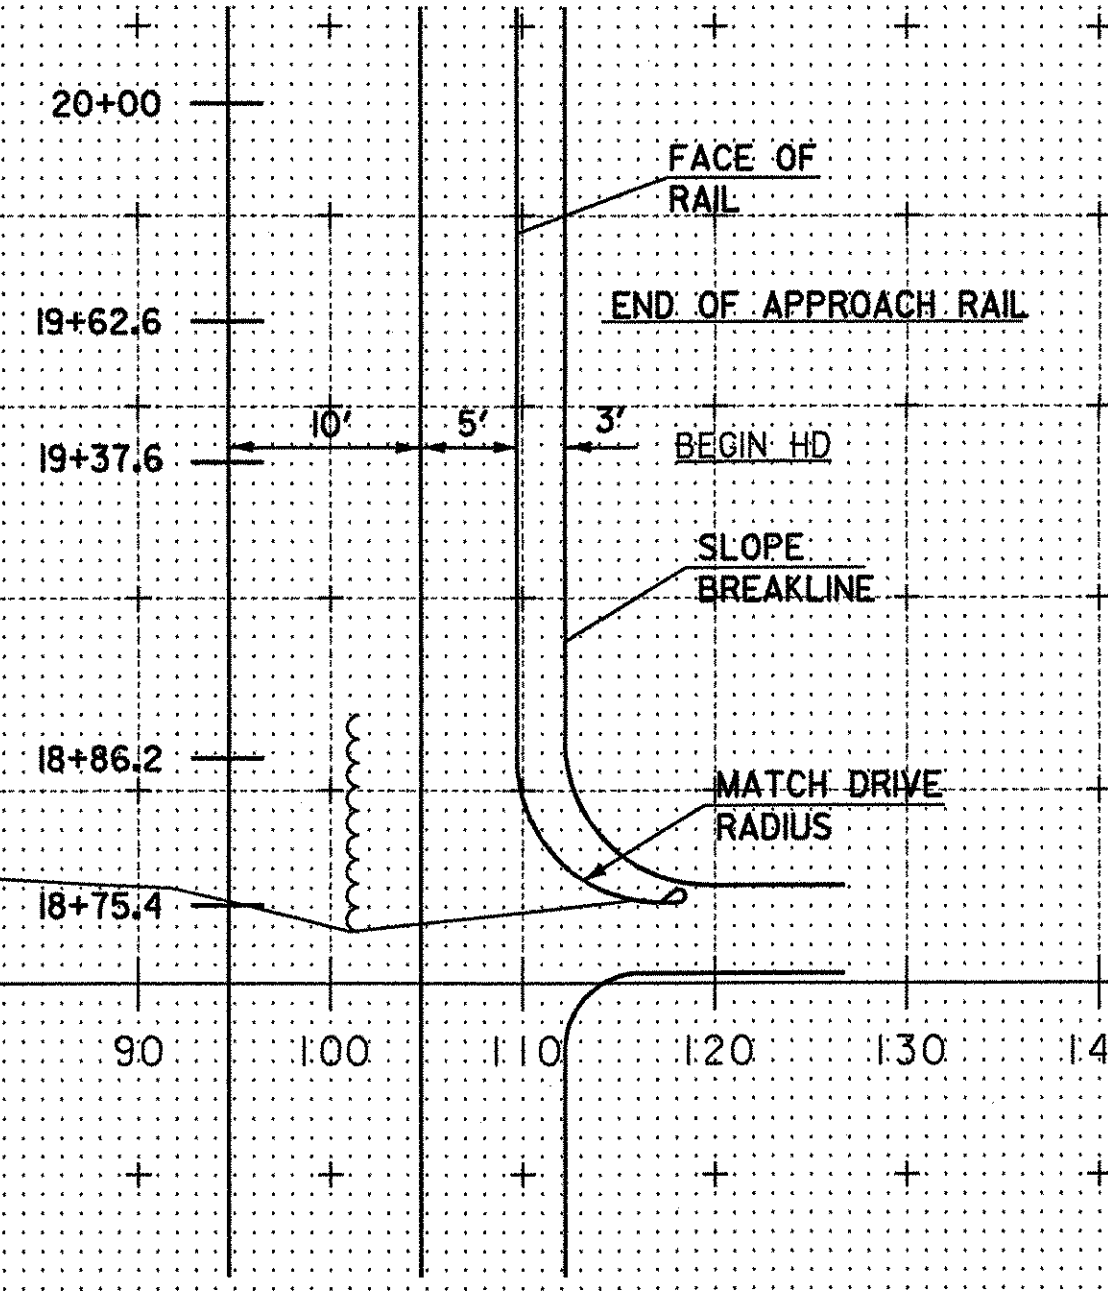

BOSTWICK ROAD

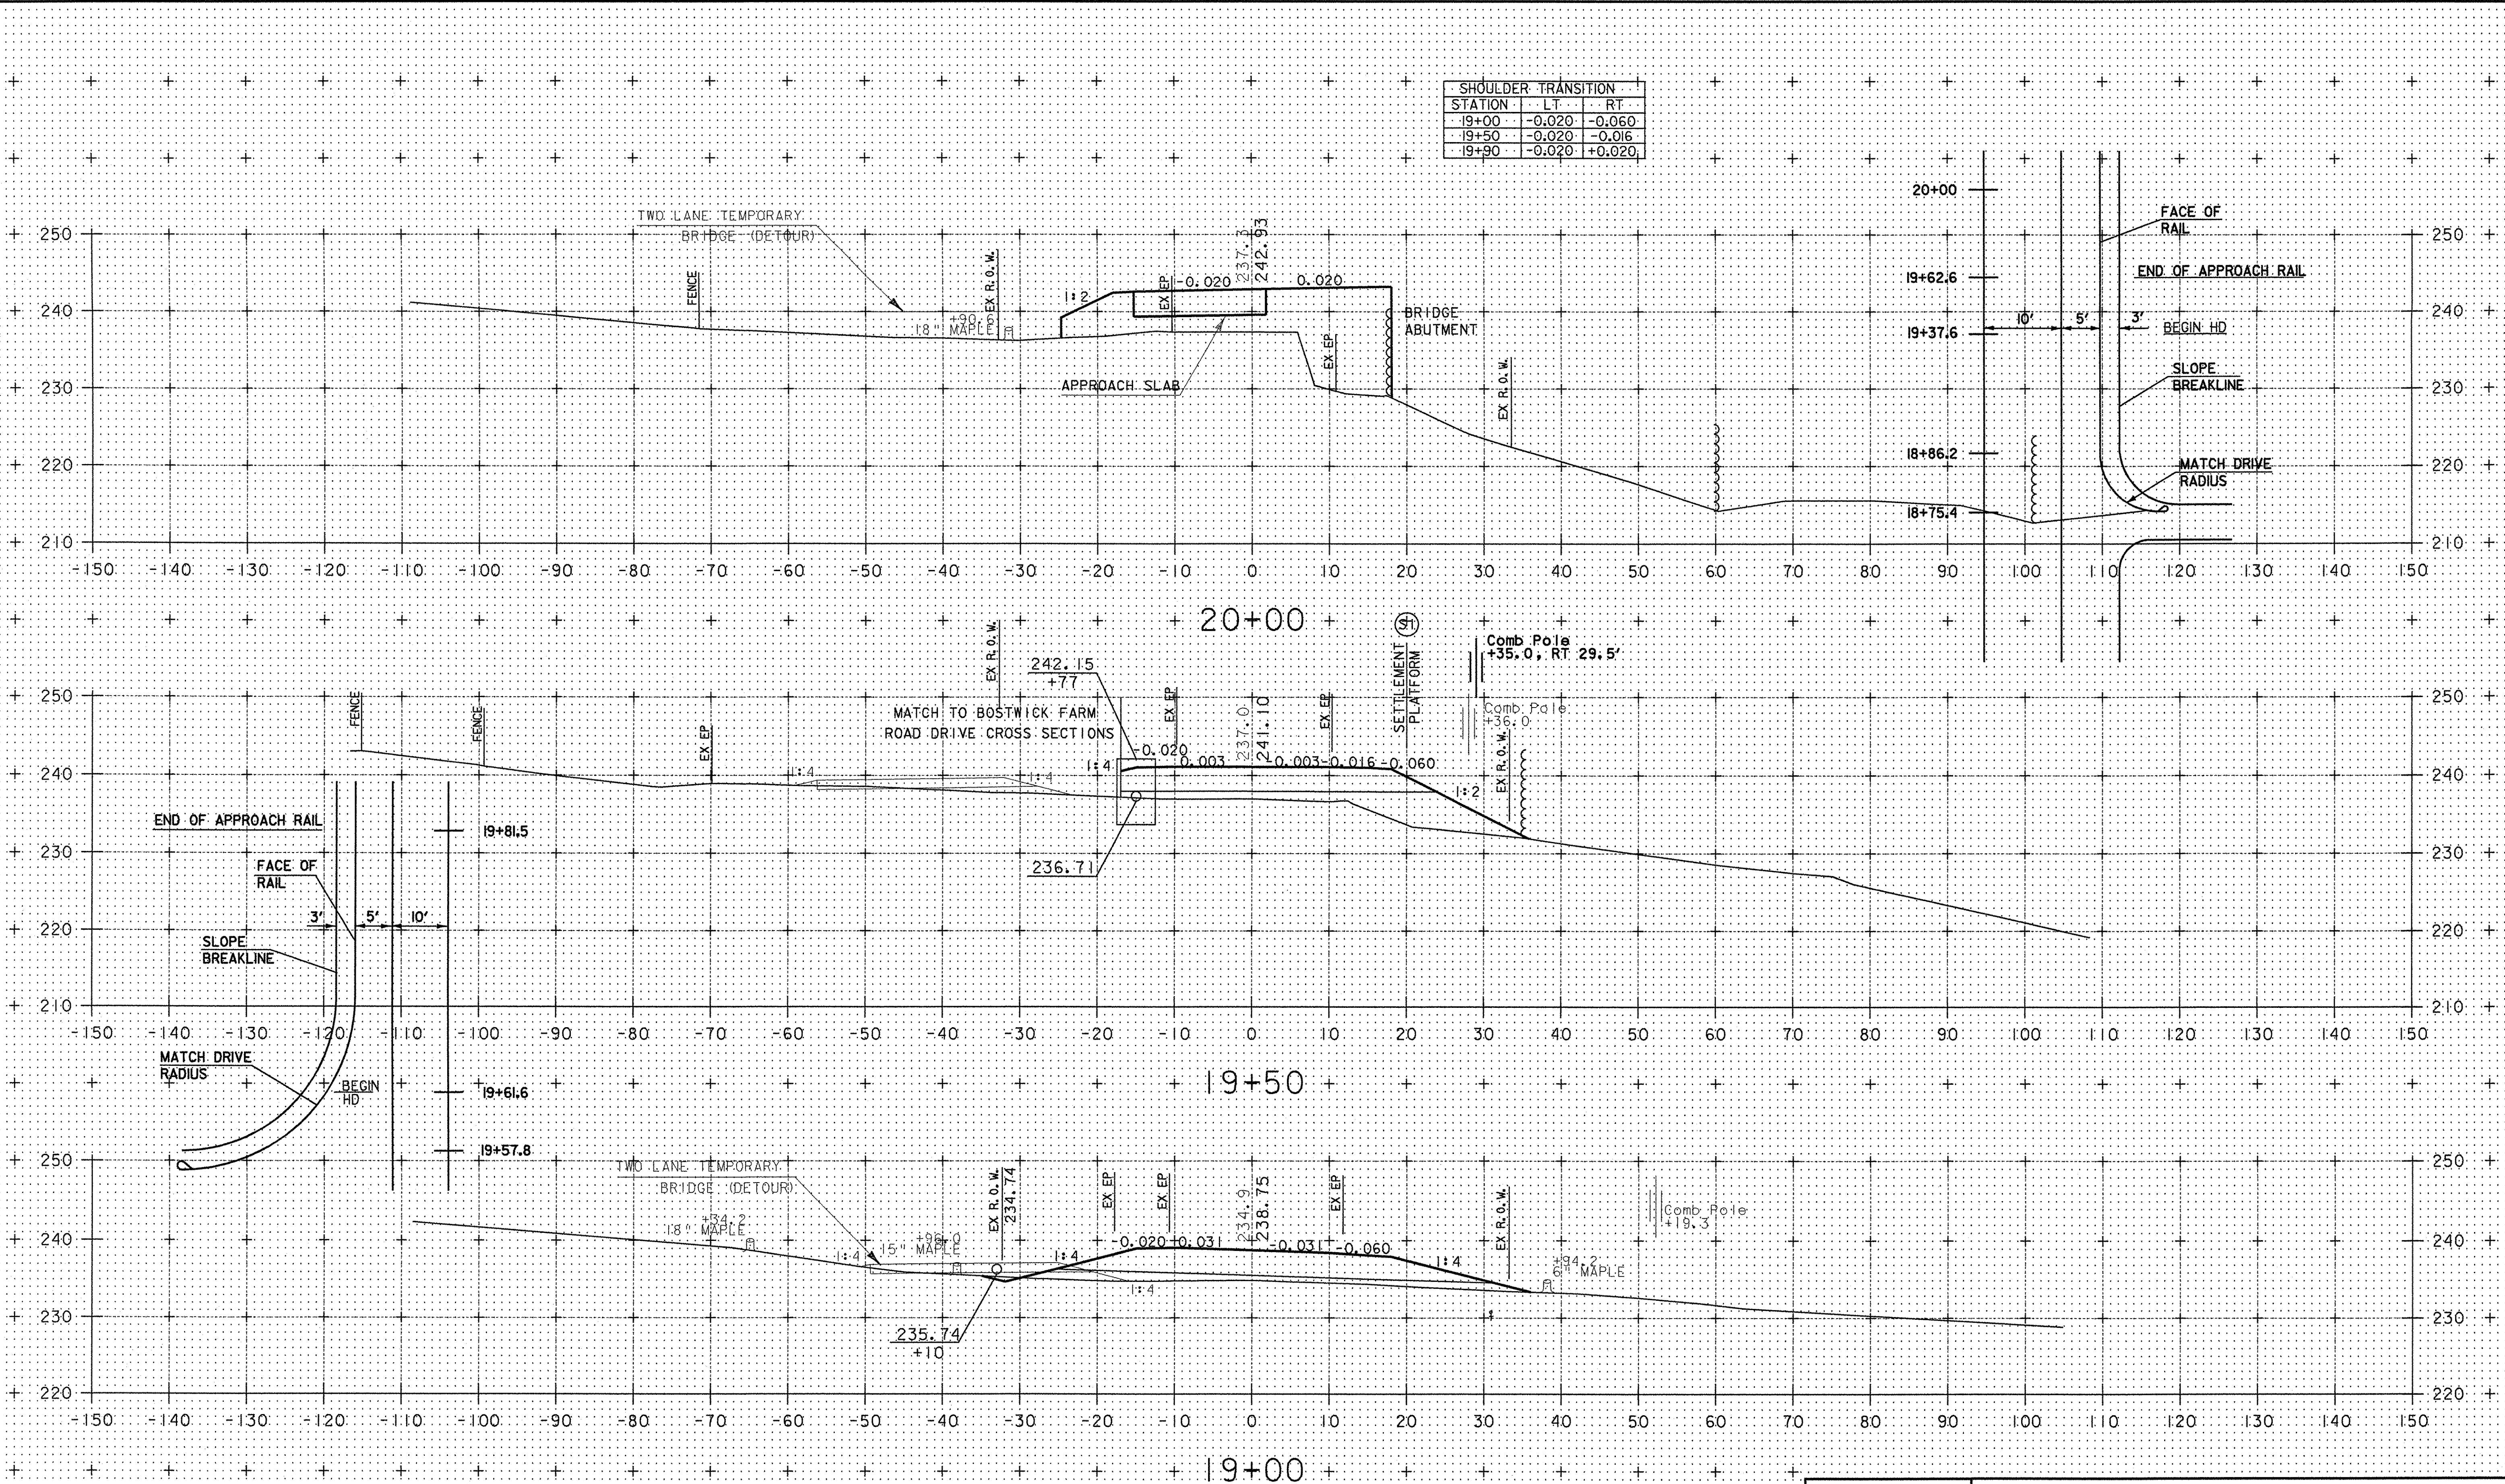

PROJECT NAME:	SHELBURNE
PROJECT NUMBER:	BRO 1445(30)
FILE NAME:	M:\1595402 Bostwick\HWY\DRAW\J196wrk.dgn
PROJECT LEADER:	MBZ
DESIGNED BY:	DMB
CHECKED BY:	MDL
PLOT DATE:	01-AUG-2003
DRAWN BY:	DMB
SHEET	64 OF 73