


SHOULDER TRANSITION		
STATION	LT	RT
21+0	-0.020	+0.020
21+50	-0.043	+0.004



BOSTWICK ROAD	PROJECT NAME: SHELBURNE
	PROJECT NUMBER: BRO 1445(30)
	FILE NAME: M:\1595402 Bostwick\HWY\DRAW\J196wrk.dgn
	PROJECT LEADER: MBZ
DESIGNED BY: DMB	PLOT DATE: 01-AUG-2003
CHECKED BY: MDL	DRAWN BY: DMB
	SHEET 65 OF 73

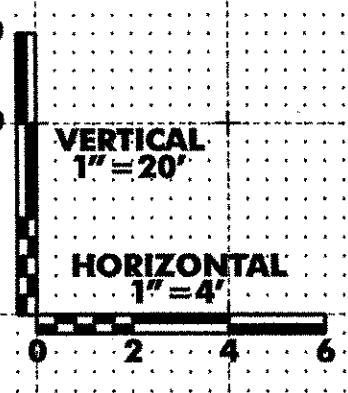