


+21+68 (skewed)+

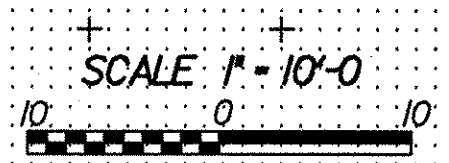

BOSTWICK ROAD	PROJECT NAME: SHELBURNE	PLOT DATE: 01-AUG-2003
	PROJECT NUMBER: BRO 1445(30)	
	FILE NAME: M:\1595402 Bostwick\HWY\DRAW\J196wrk.dgn	DRAWN BY: DMB
	PROJECT LEADER: MBZ	CHECKED BY: MDL