



41+32

STATION 41+00 LIMIT OF WORK

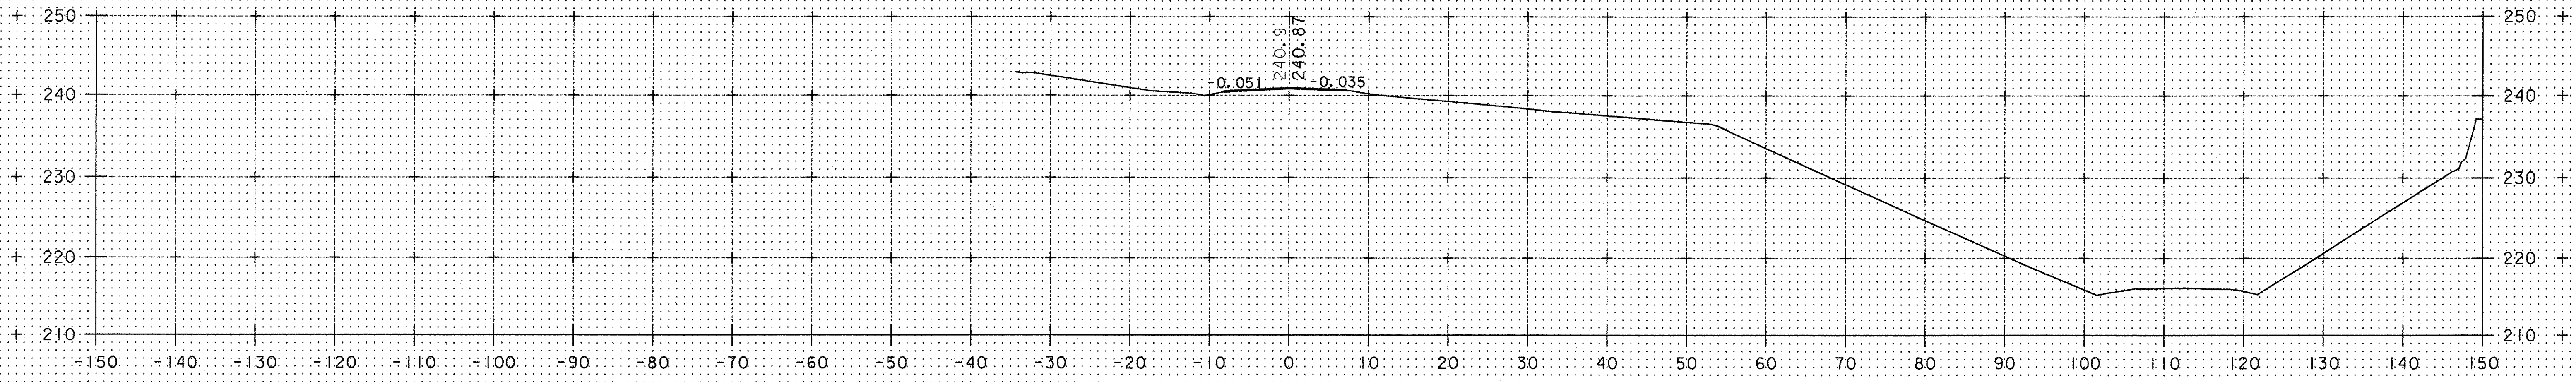

41+00

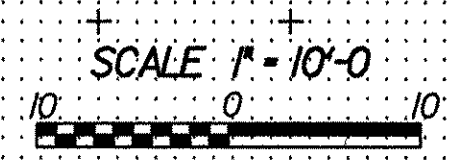

**BOSTWICK
FARM
ROAD
DRIVE**

PROJECT NAME:	SHELBURNE
PROJECT NUMBER:	BRO 1445(30)
FILE NAME:	M:\1595402 Bostwick\HWY\DRAW\J196wrk.dgn
PROJECT LEADER:	MBZ
DESIGNED BY:	DMB
CHECKED BY:	MDL
PLOT DATE:	01-AUG-2003
DRAWN BY:	DMB
SHEET	73 OF 73