



20+93.6

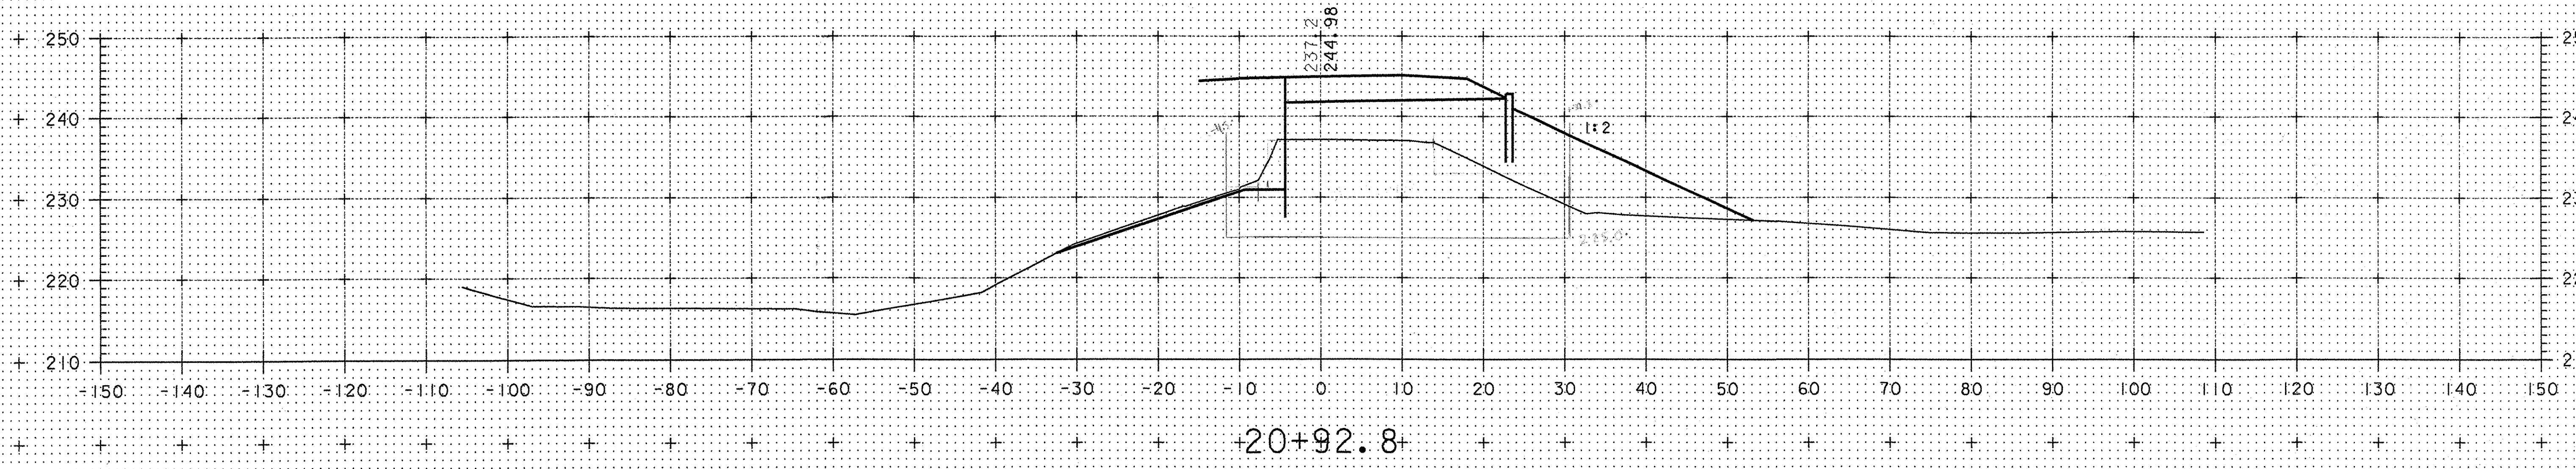


20+92.8

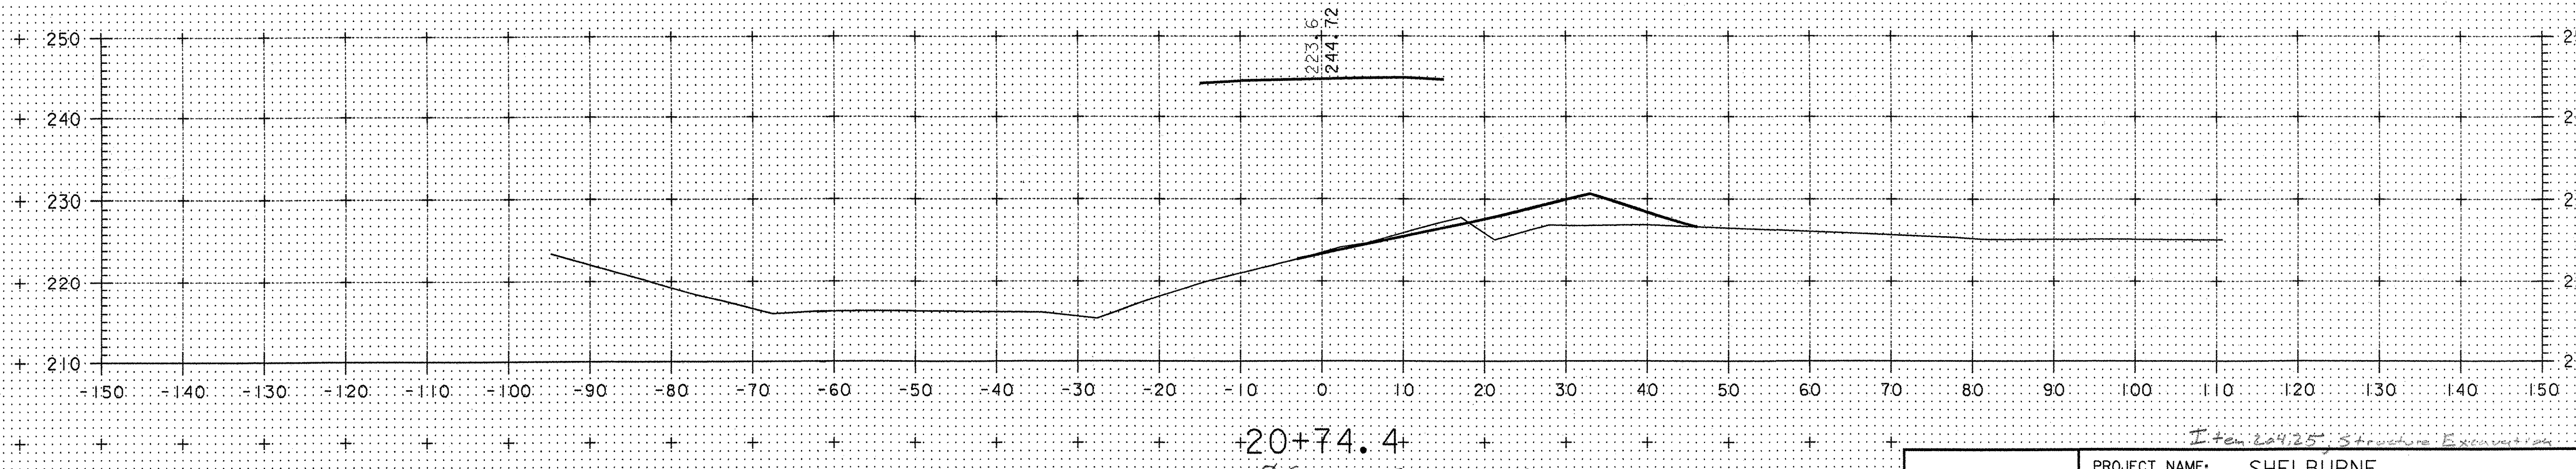

20+74.4

Ø Section - Item 204.25
(Abutment 2)

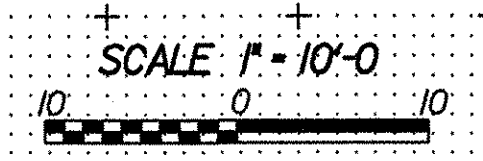

BOSTWICK ROAD

PROJECT NAME:	SHEI BURNE
PROJECT NUMBER:	BRQ J445(30)
FILE NAME:	m:\595402_Bostwick\HWY\INROADS\BRC-Construction_Sections
PROJECT LEADER:	MBZ
DESIGNED BY:	DMB
CHECKED BY:	MDL
PLOT DATE:	12-FEB-2004
DRAWN BY:	DMB
SHEET	4 OF 6

Item 204.25, Structure Excavation