



+21+50.0

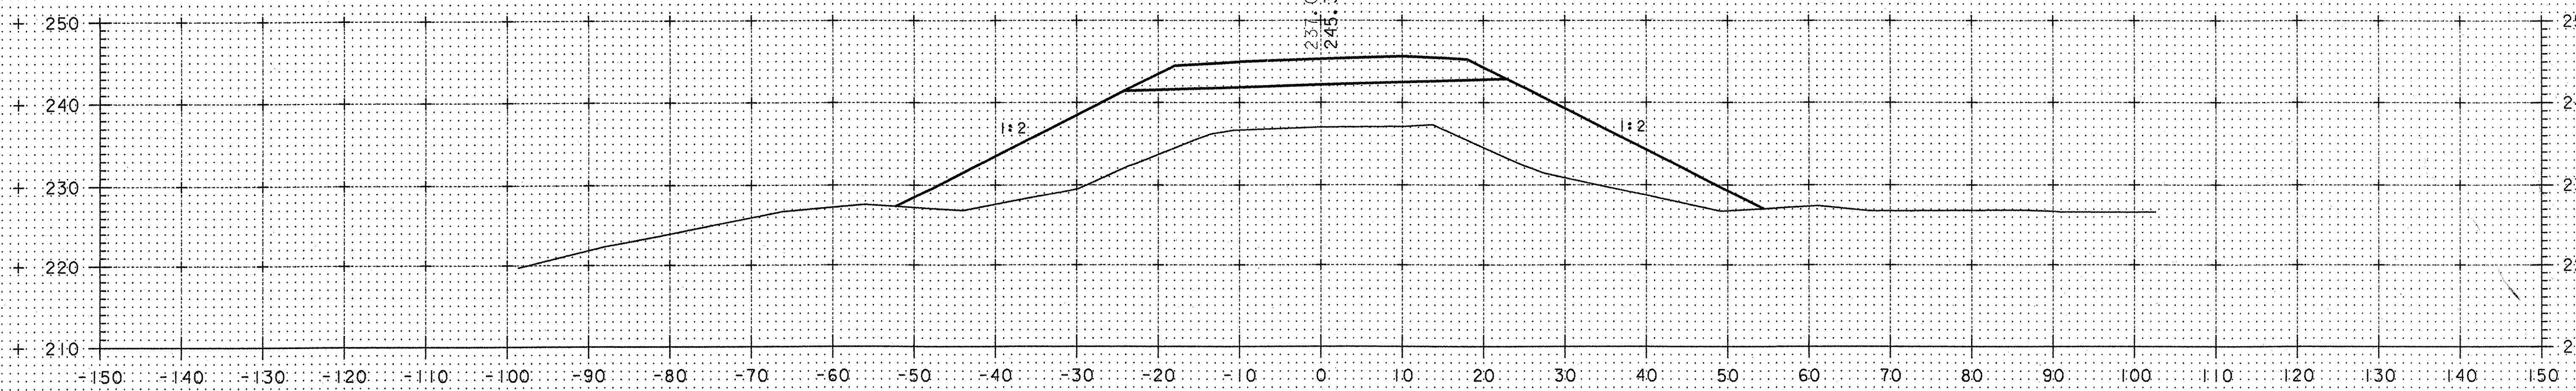


+21+31.0

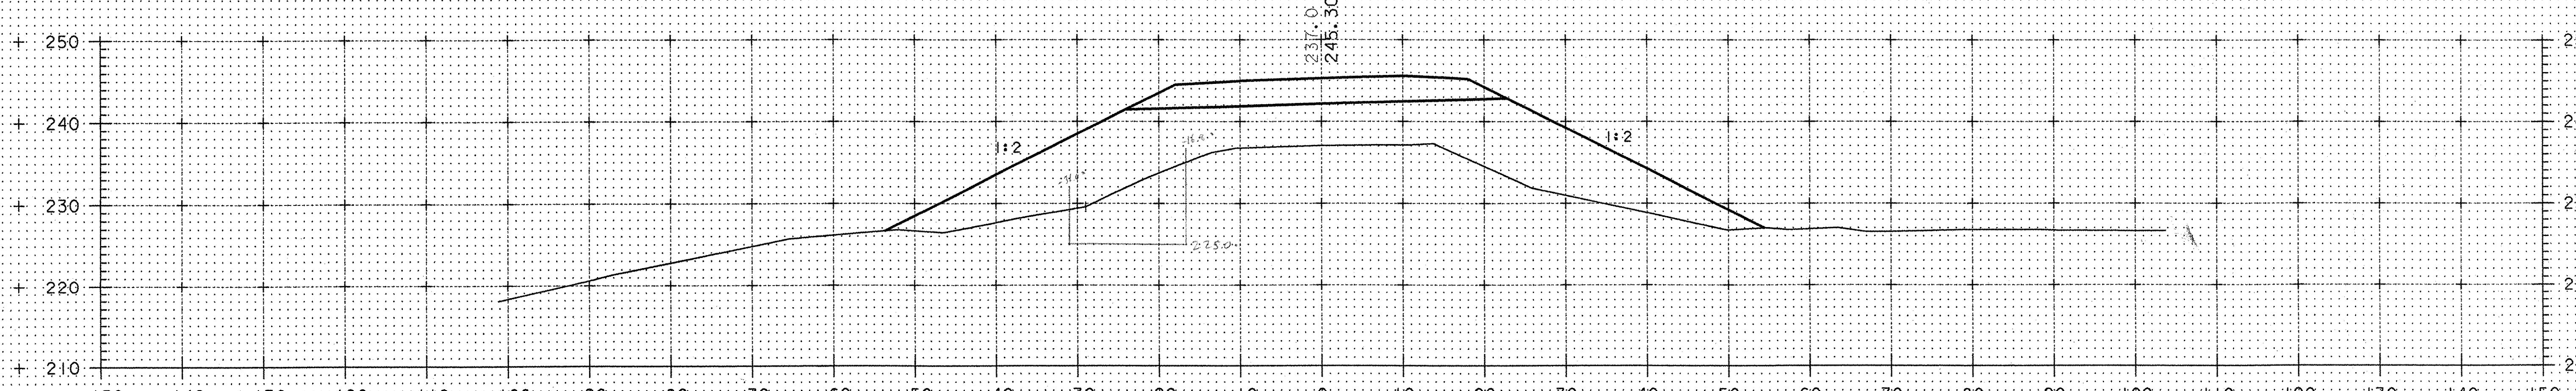

+21+27.4

Iron 204.25, Structure Excavation

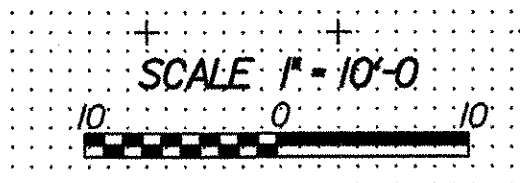

BOSTWICK ROAD	PROJECT NAME: SHELBURNE
	PROJECT NUMBER: BRQ J445(30)
	FILE NAME: m:\595402_Bostwick\HWY\INROADS\BRC-Construction_Sections.k
	PROJECT LEADER: MBZ PLOT DATE: 12-FEB-2004
DESIGNED BY: DMB DRAWN BY: DMB	
CHECKED BY: MDL SHEET 6 OF 6	