


18+00

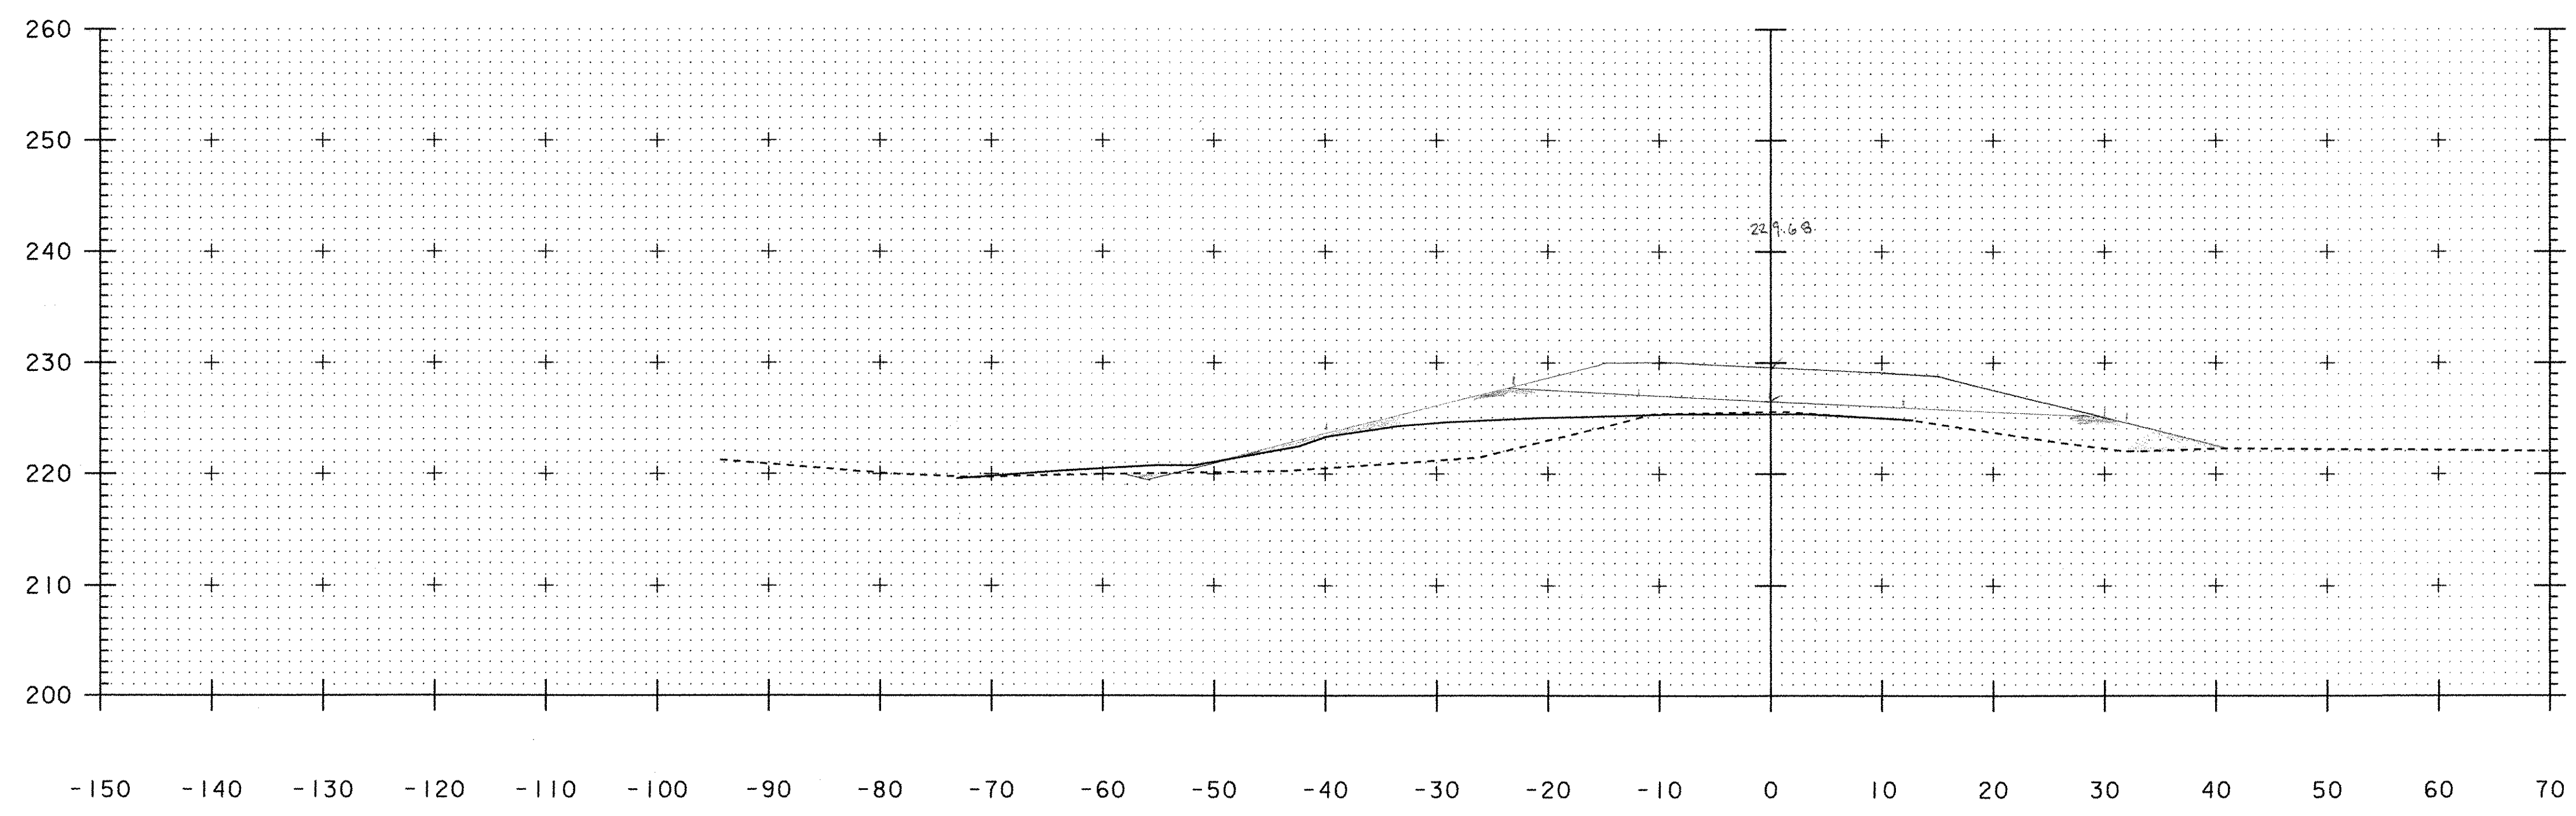

17+50

REVISED ORIGINAL SECTIONS

PROJECT NAME: SHELBURNE	PLOT DATE: 07-JUL-2004
PROJECT NUMBER: BRO 1445(30)	DRAWN BY: BEYOR
FILE NAME: 94J196/SURVEY/X94J196DQ	CHECKED BY:
PROJECT LEADER:	SHEET 2 OF 9
DESIGNED BY:	
DETOUR SECTIONS - MAY 28, 2004	

107 8/5