


19+00

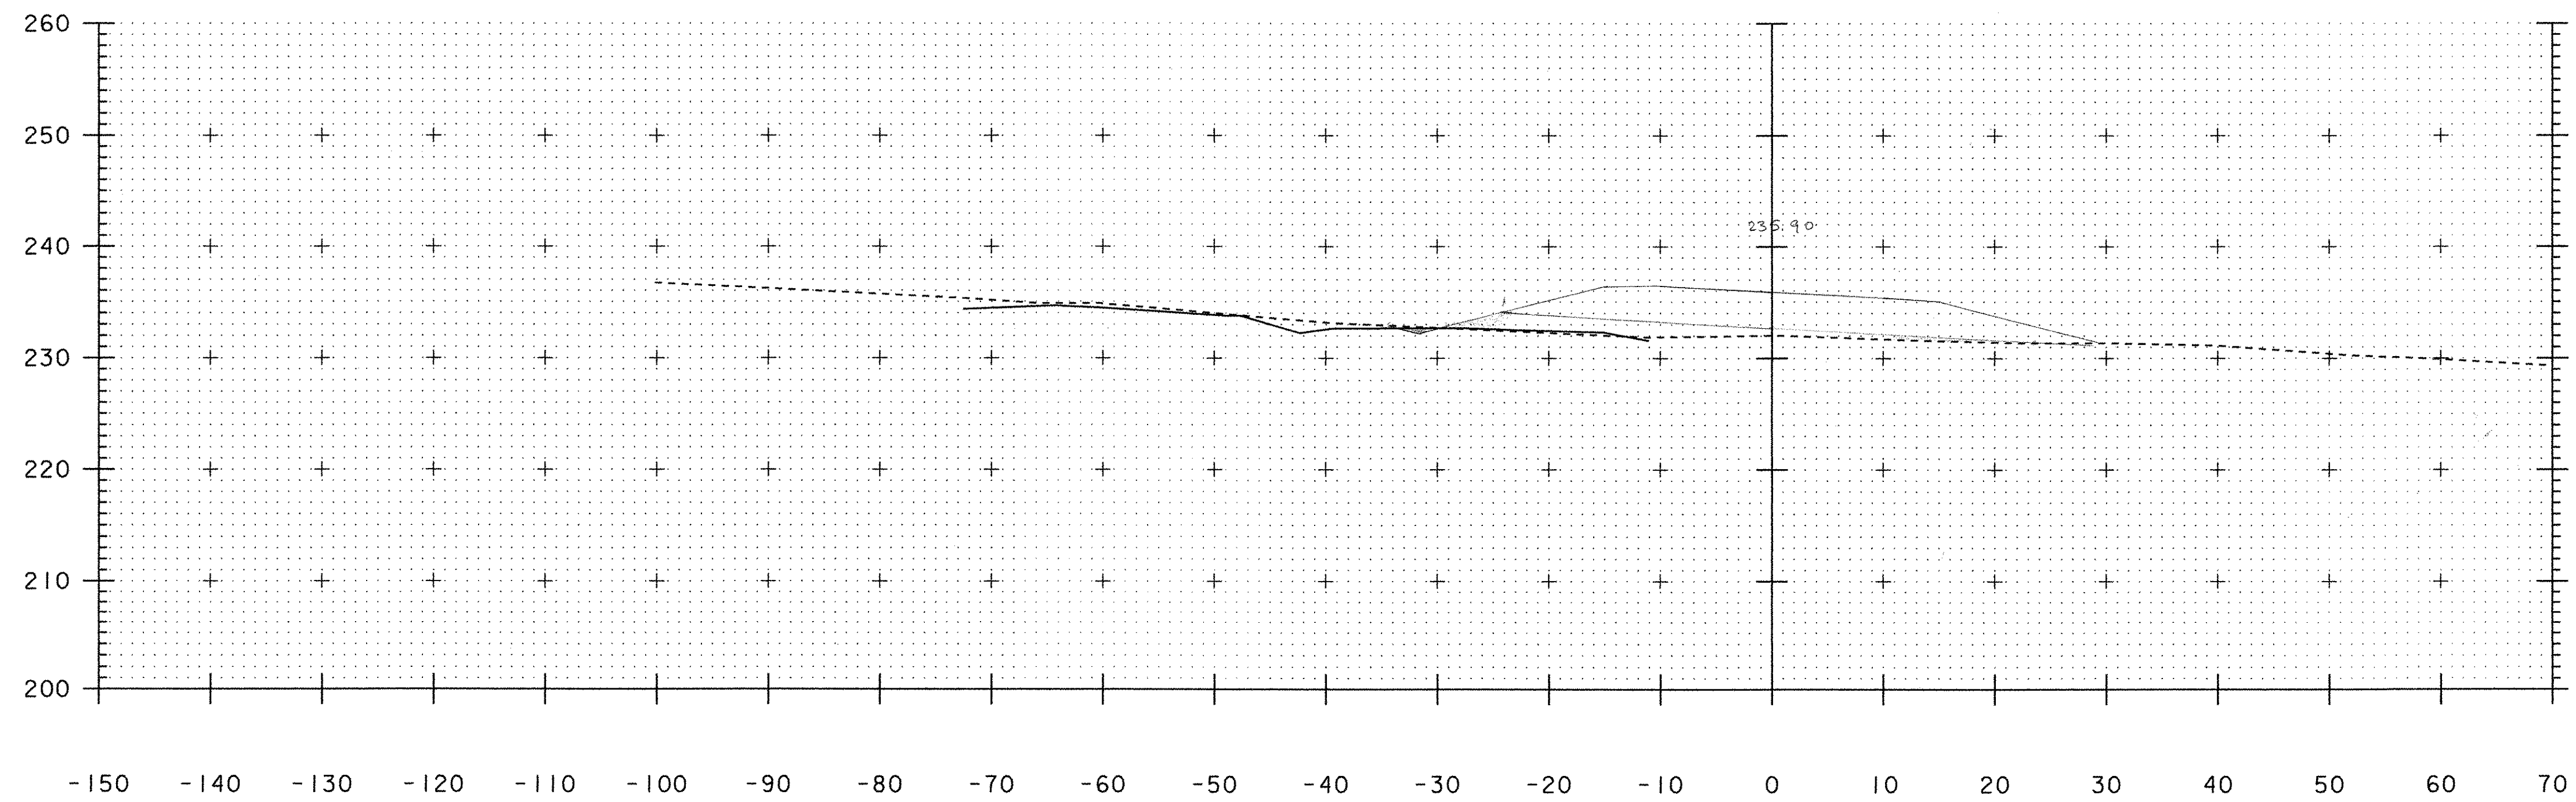

18+50

28  
Back 56.7  
F - 28 x 1.55 = 43.4 SF  
- (4 x 2/12) = 42.7 SF  
C - 1 x 1.55 = 1.6 VSF

24  
AHEAD 58.7  
F - 24 x 1.55 = 37.2 SF - (4 x 2/12) = 36.5 SF  
C - 0 V

OK  
2-11-05

260 x 1.55 40.3  
40.5 OK  
F - 24 x 1.55 = 37.2 SF - (6 x 2/12) = 36.2 SF  
C - 1 x 1.55 = 1.6 VSF

POOL DECKER 39.5  
OK  
2-11-05

REVISED ORIGINAL SECTIONS

PROJECT NAME:	SHELBURNE
PROJECT NUMBER:	BRO 1445(30)
FILE NAME:	94JI96/SURVEY/X94JI96DQ
PROJECT LEADER:	DESIGNED BY:
DESIGNED BY:	DETOUR SECTIONS - MAY 28, 2004
PLOT DATE:	07-JUL-2004
DRAWN BY:	BEYOR
CHECKED BY:	
SHEET	3 OF 9