


2102
G.P.S.
19 + 91.5
G.P.S.

211.1317
SLAB
19 + 20.6
SLAB

20+00

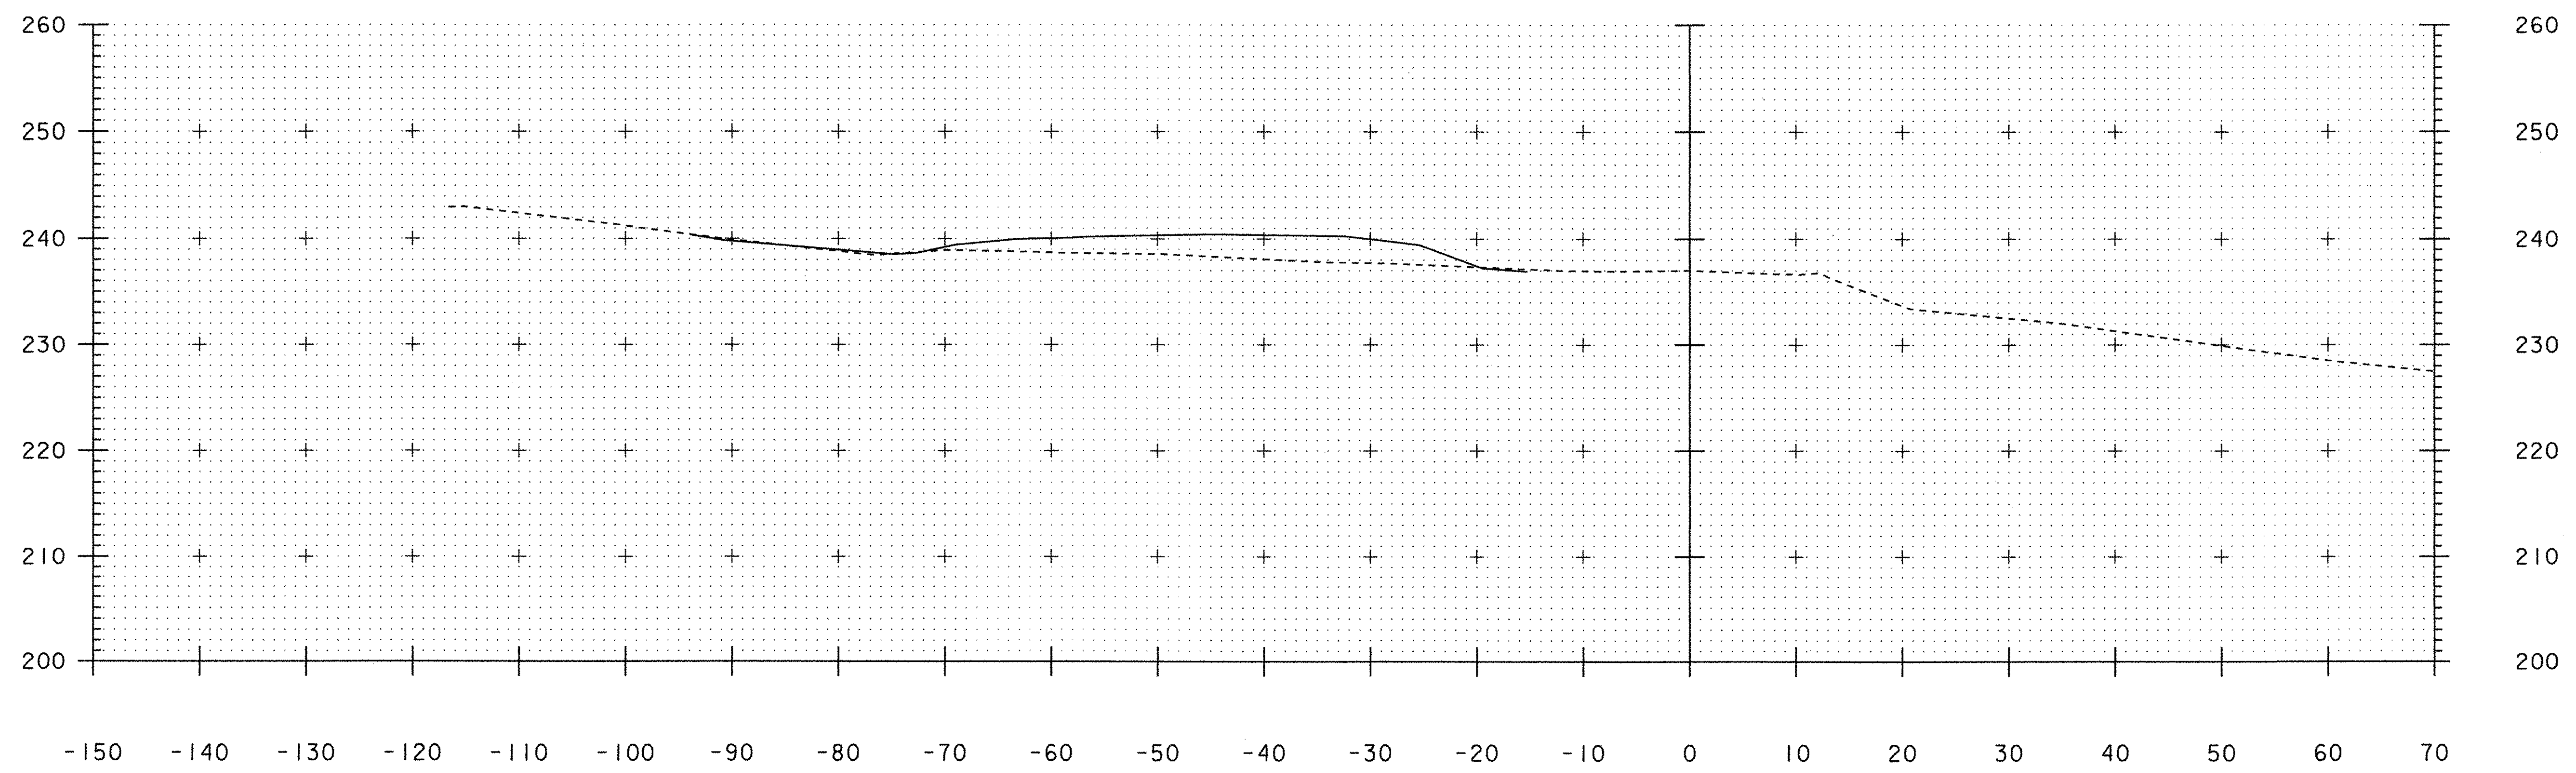

Revised Original Sections

PROJECT NAME: SHELBURNE	PLOT DATE: 07-JUL-2004
PROJECT NUMBER: BRO 1445(30)	DRAWN BY: BEYOR
FILE NAME: 94J196/SURVEY/X94J196DQ	CHECKED BY:
DESIGNED BY:	SHEET 4 OF 9
DETOUR SECTIONS - MAY 28, 2004	

19+50

109 1/2