


22+00

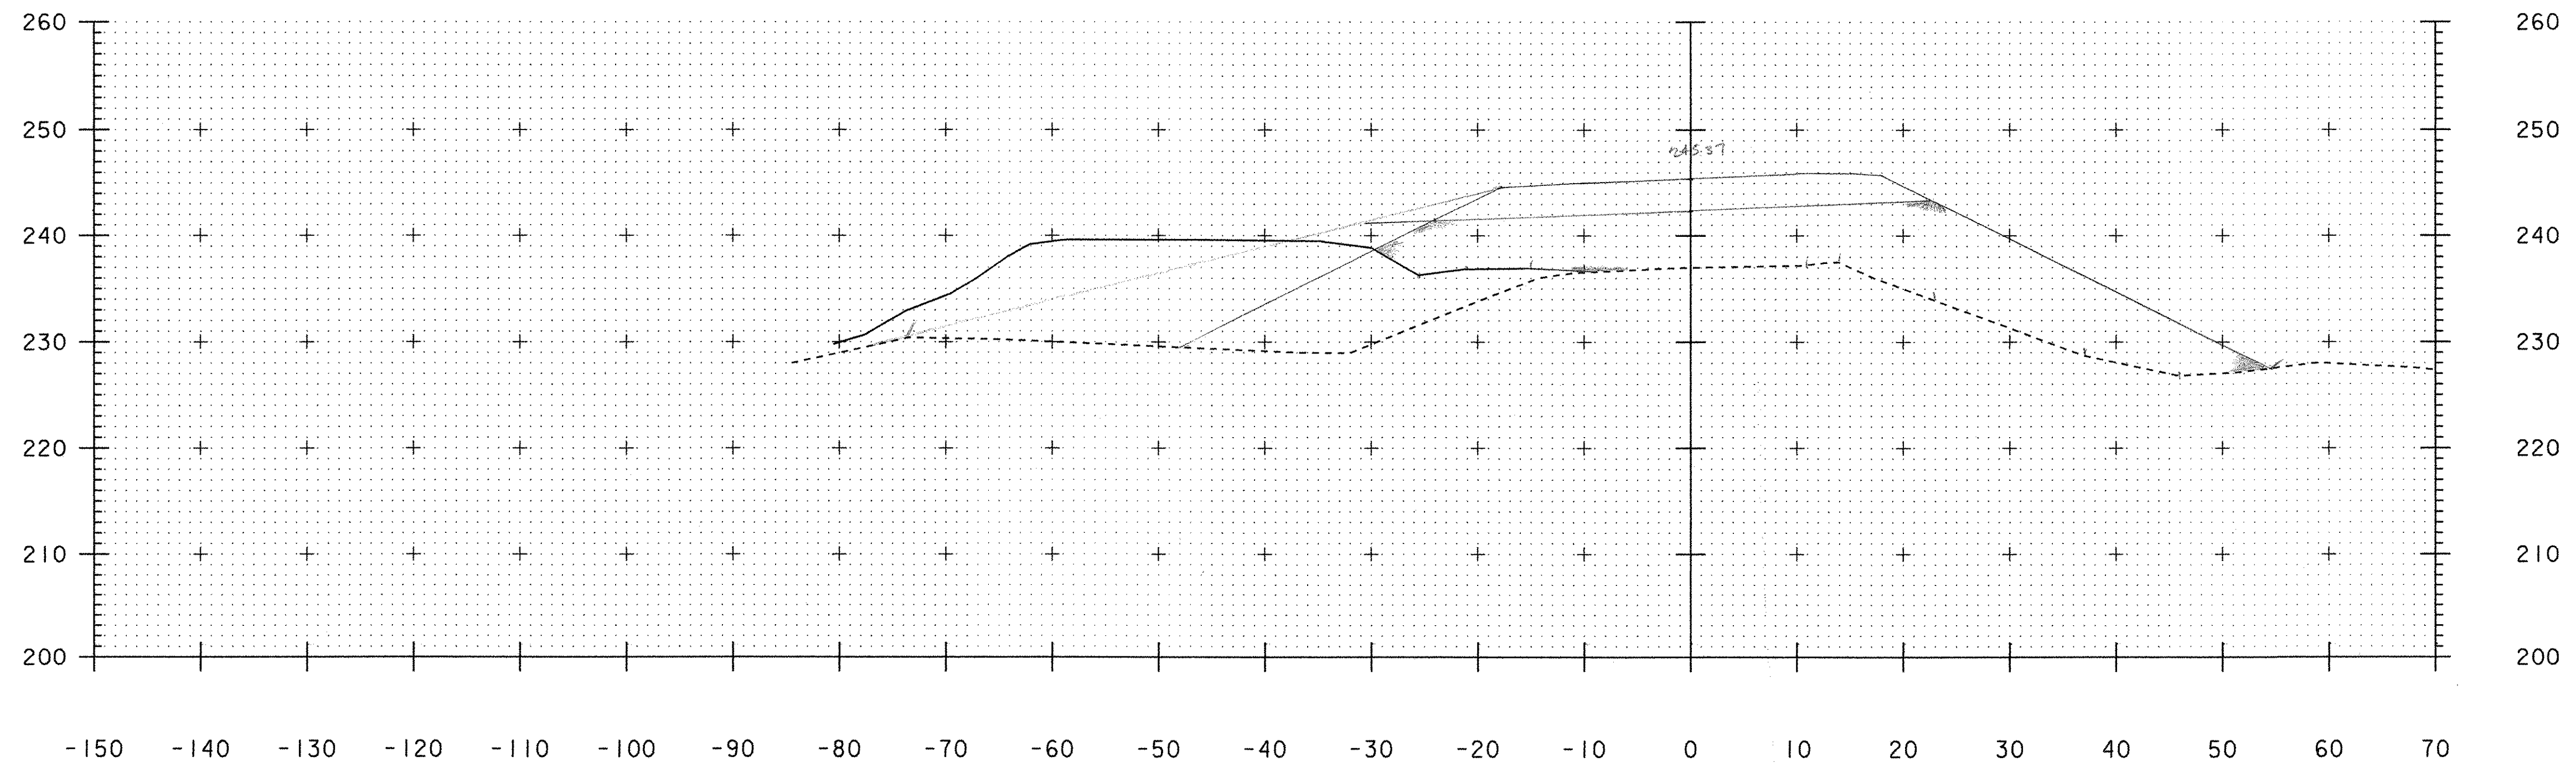

21+50

$F = 230 \times 1.35 = 436.7$
 $- (37' \times 2/12) = 427.8 \text{ SF}$
 063 02/16/05

TO PAUL DEWICK
 $F = 309 \times 1.35 = 417.15$
 $- (40' \times 2/12) = 412.3 \text{ SF}$
 063 02/16/05

REVISED ORIGINAL SECTIONS

PROJECT NAME:	SHELBURNE	FILE NAME:	94J196/SURVEY/X94J196DQ	PLOT DATE:	07-JUL-2004
PROJECT NUMBER:	BRO 1445(30)	PROJECT LEADER:		DRAWN BY:	BEYOR
DESIGNED BY:		DESIGNED BY:		CHECKED BY:	
DETOUR SECTIONS -	MAY 28, 2004	DETOUR SECTIONS -	MAY 28, 2004	SHEET	7 OF 9

112 1/2 x 3