


23+00

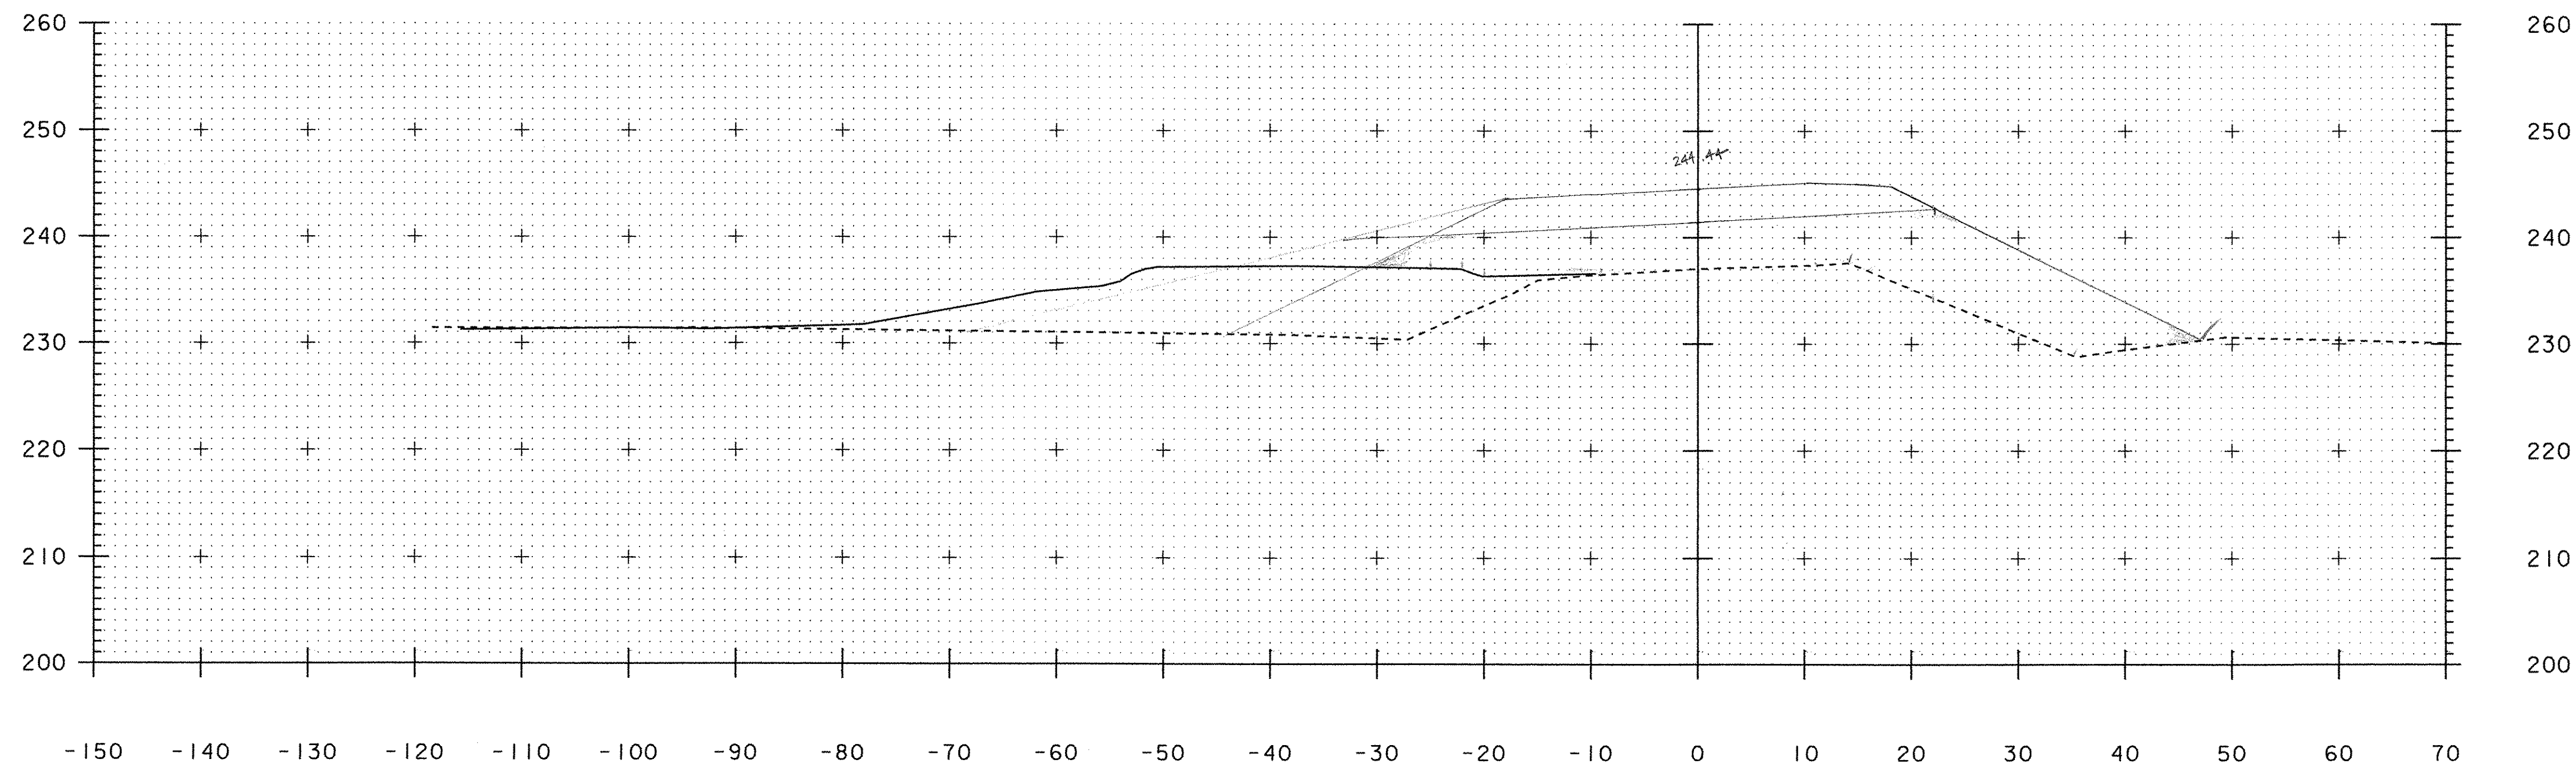

22+50

REVISED ORIGINAL SECTION 45

PROJECT NAME:	SHELBURNE		
PROJECT NUMBER:	BRO 1445(30)		
FILE NAME:	94J196/SURVEY/X94J196DQ	PROJECT LEADER:	BEYOR
DESIGNED BY:		CHECKED BY:	
DETOUR SECTIONS -	MAY 28, 2004	PLOT DATE:	07-JUL-2004
		DRAWN BY:	BEYOR
		CHECKED BY:	
		SHEET	B OF 3