



STATE OF VERMONT AGENCY OF TRANSPORTATION

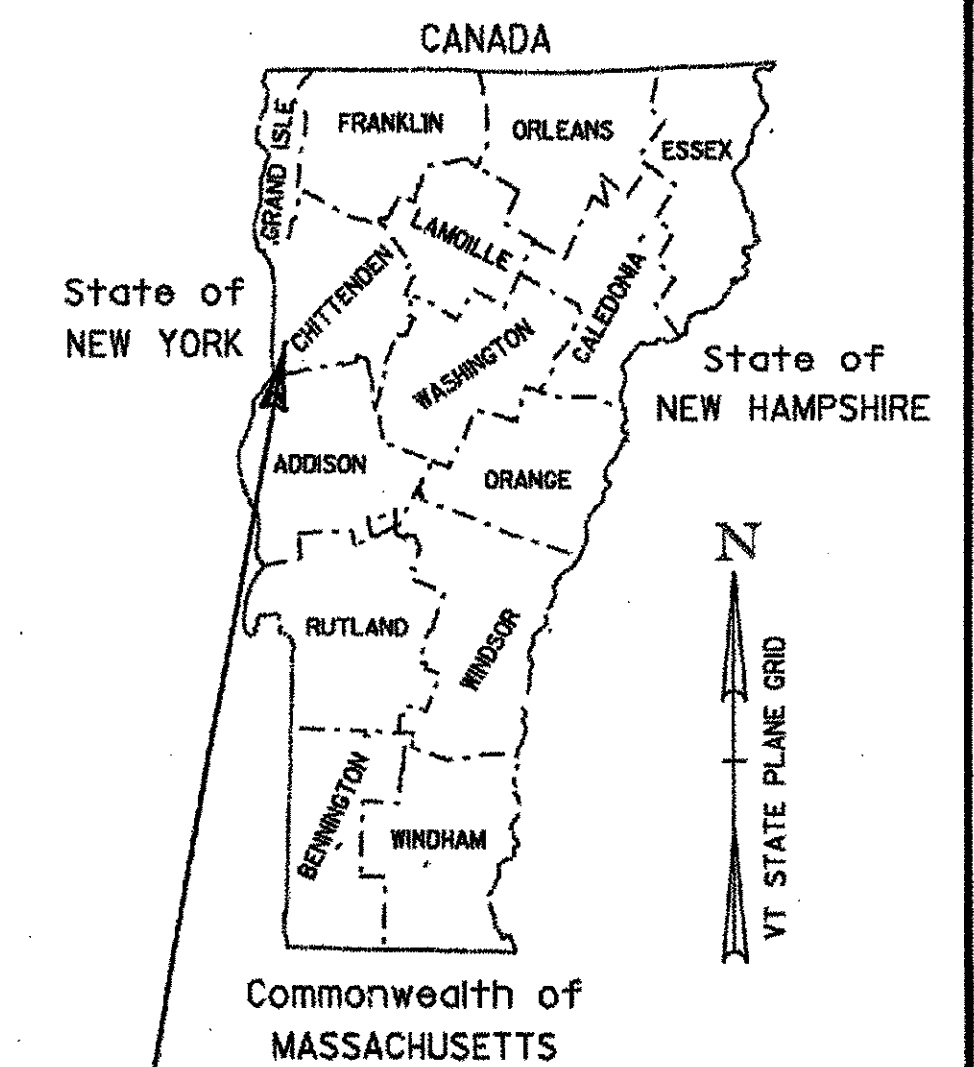

PROPOSED IMPROVEMENT BRIDGE PROJECT TOWN OF SHELBURNE COUNTY OF CHITTENDEN BOSTWICK ROAD (TH3 BR15)

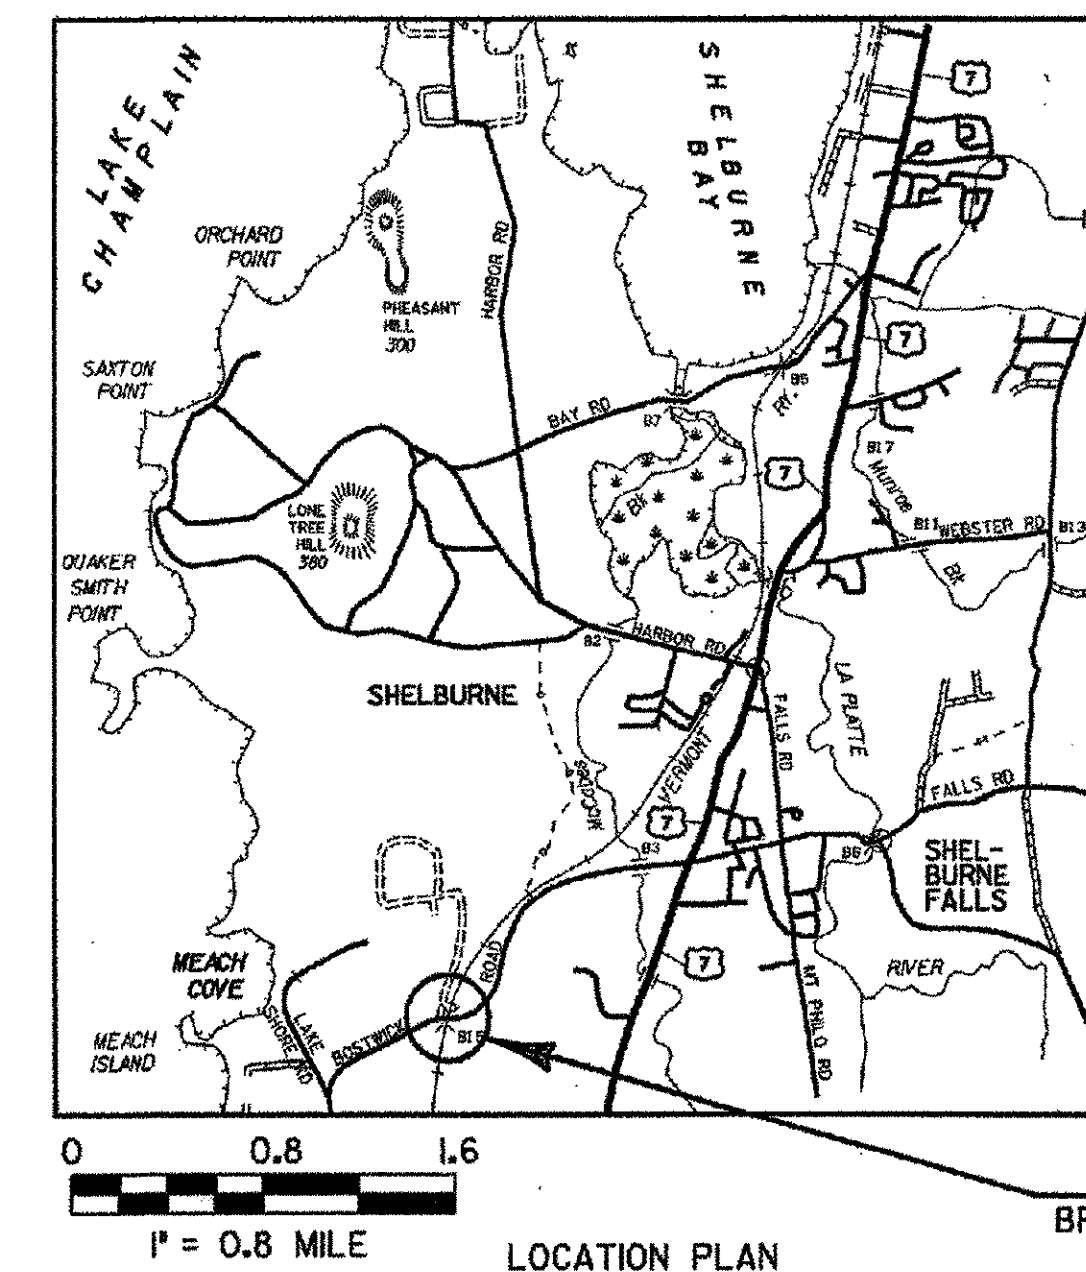


INDEX OF SHEETS
SEE SHEET 2

TRAFFIC DATA	
2004 ADT = 2300	2024 ADT = 3100
2004 DHV = 230	2024 DHV = 300
2004 ADTT = 80	2024 ADTT = 100
XT = 3%	
%D = 50%	
V = 35mph	
POSTED SPEED LIMIT = 35mph	
2004-2024 (20 YEAR) 18K ESAL = 250,000	
2004-2044 (40 YEAR) 18K ESAL = 350,000 LOCAL ROAD	

Beginning on Bostwick Road approximately 1.4 miles west of the junction of Bostwick Road and US Route 7 and extending along Bostwick Road 1625 feet, within the town limits of Shelburne.

Work to be performed on this project includes Roadway Reconstruction, Bridge Reconstruction, and the associated drainage, utility relocation, grading, subbase, pavement and other related items.
 Length of Roadway = 0.291 miles = 1533 feet
 Length of Bridge = 0.017 miles = 92 feet
 Length of Project = 0.308 miles = 1625 feet

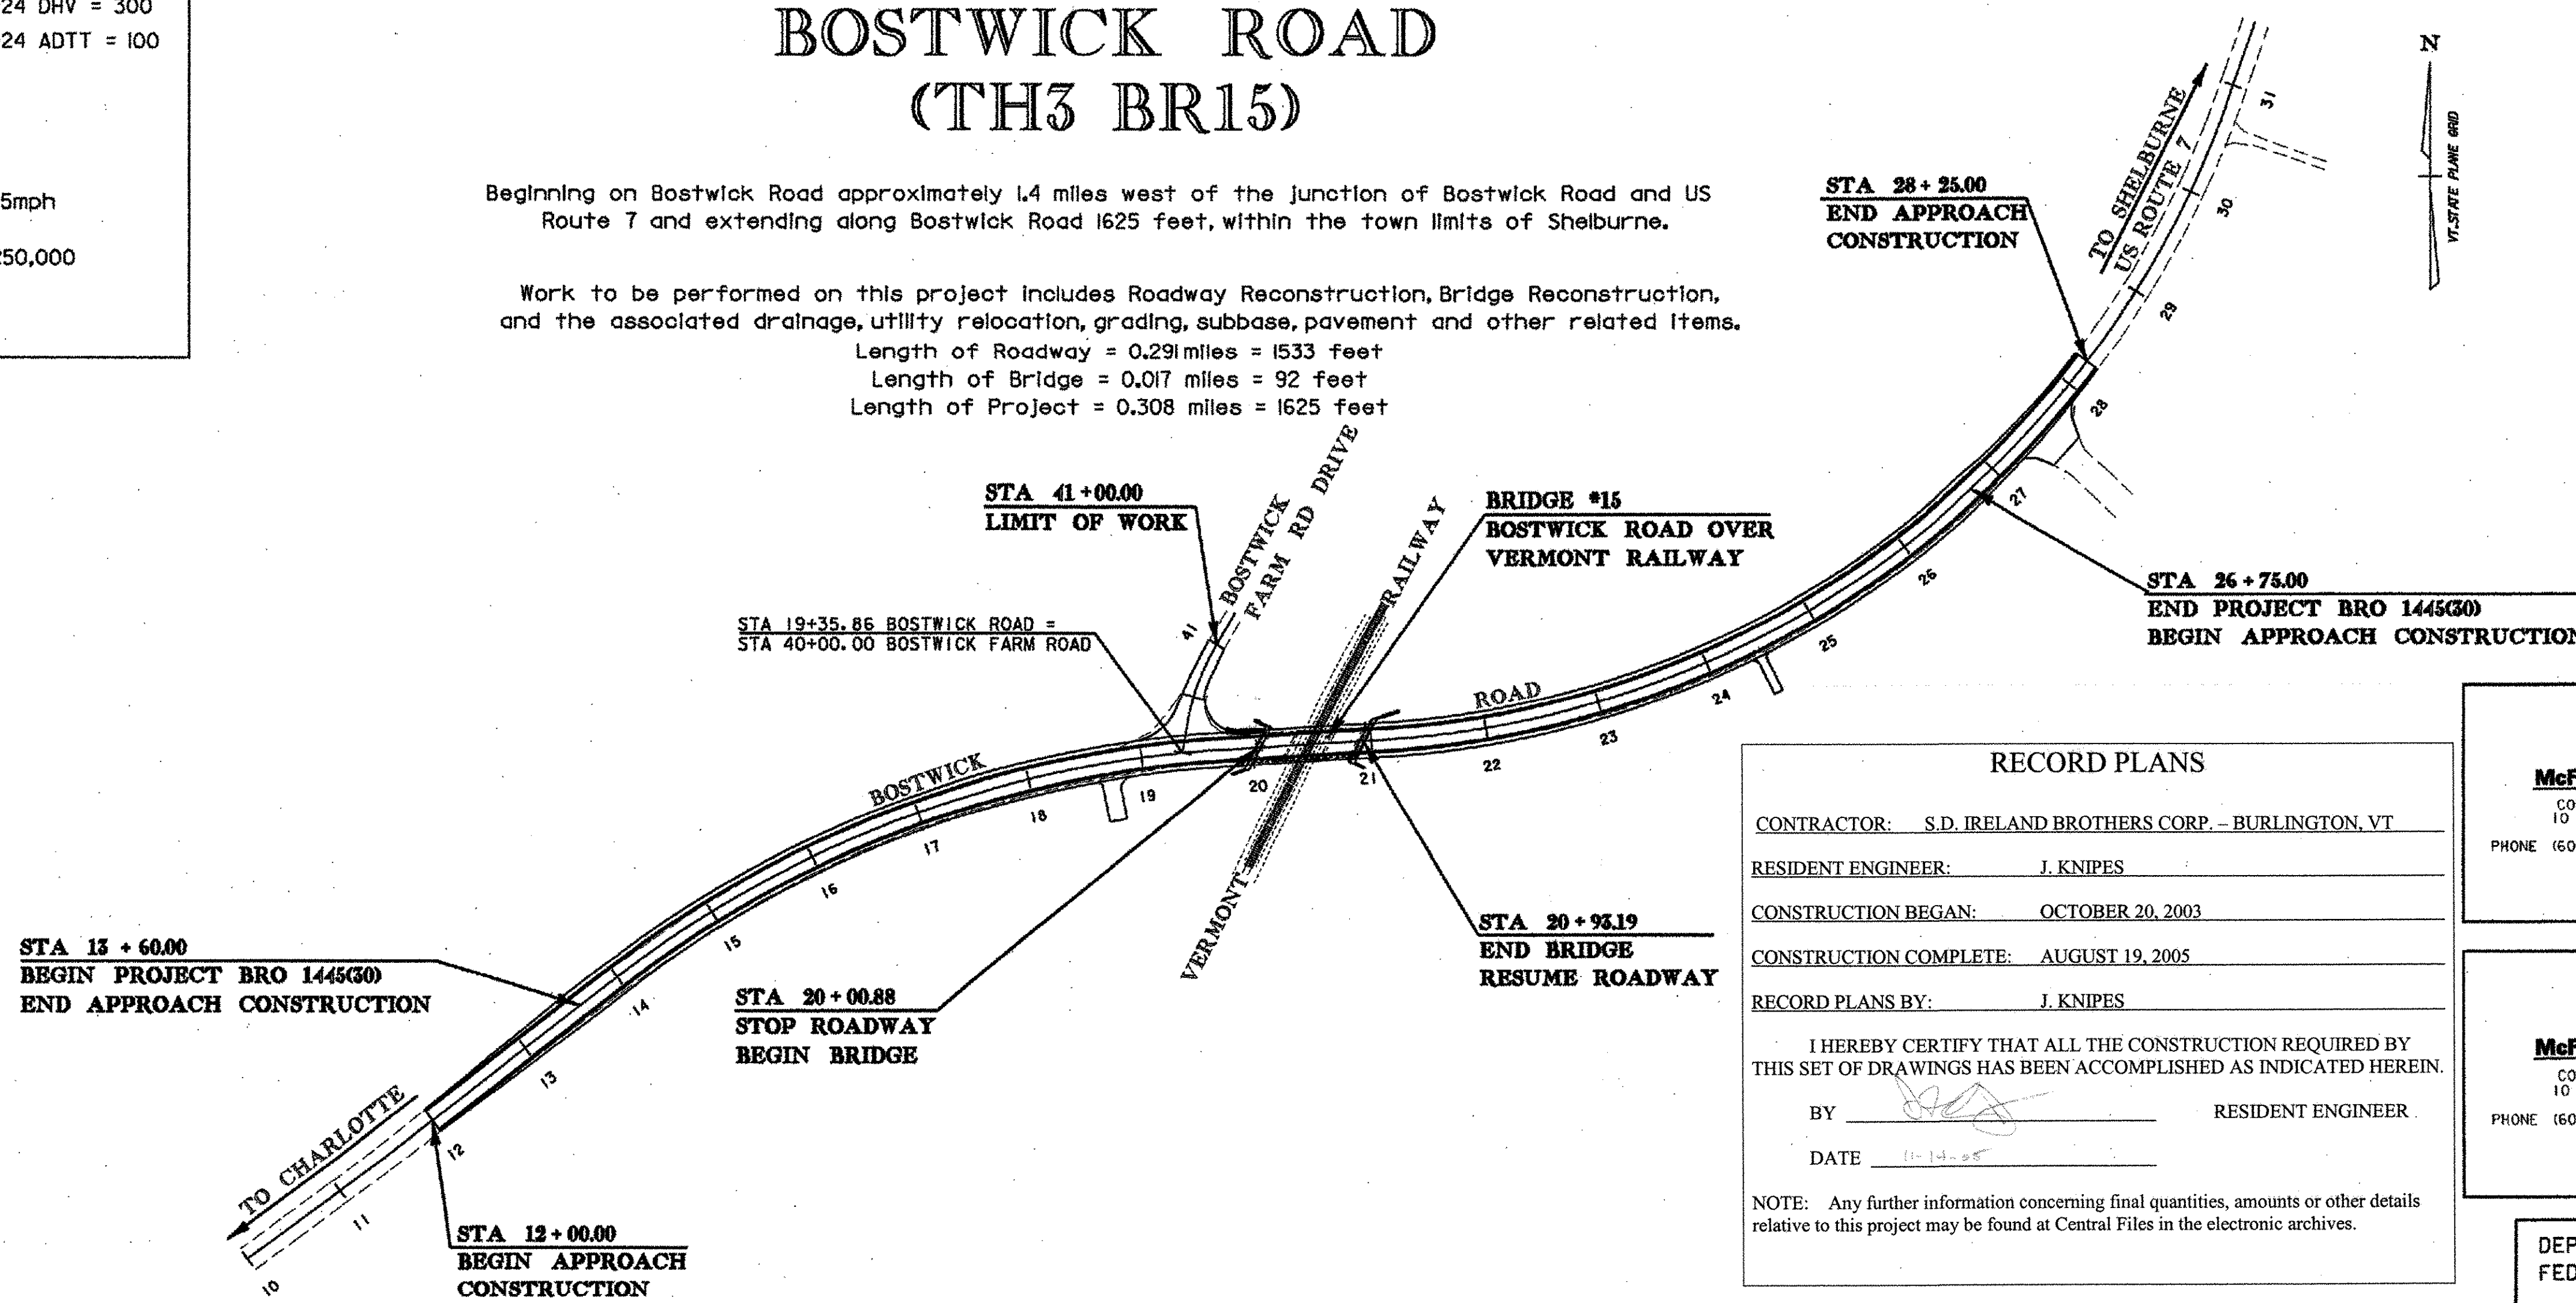

CONVENTIONAL SYMBOLS

COUNTY LINE	
TOWN LINE	
LIMITS OF ACCESS	
POINT OF ACCESS	
FENCE LINE	
STONE WALL	
TRAVELED WAY	
GUARD RAIL	
RAILROAD	
SURVEY LINE	
CULVERT	
POWER POLE	
TELEPHONE POLE	
TREES	
CONTROL OF ACCESS	
PROPERTY LINE	
R.O.W. TAKING LINE	
SLOPE RIGHTS	
TOP OF CUT	
TOE OF SLOPE	

SURVEYED BY : VERMONT SURVEYING & ENGINEERING
SURVEYED DATE : 8/1999

DATUM
VERTICAL NAVD 88
HORIZONTAL NAD 83 (1996)

RECORD PLANS

CONTRACTOR: S.D. IRELAND BROTHERS CORP. - BURLINGTON, VT

RESIDENT ENGINEER: J. KNIPES

CONSTRUCTION BEGAN: OCTOBER 20, 2003

CONSTRUCTION COMPLETE: AUGUST 19, 2005

RECORD PLANS BY: J. KNIPES

I HEREBY CERTIFY THAT ALL THE CONSTRUCTION REQUIRED BY THIS SET OF DRAWINGS HAS BEEN ACCOMPLISHED AS INDICATED HEREIN.

BY: RESIDENT ENGINEER

DATE: 11-14-05

NOTE: Any further information concerning final quantities, amounts or other details relative to this project may be found at Central Files in the electronic archives.

McFarland-Johnson, Inc.

CONCORD CENTER, STE 210
10 FERRY STREET, UNIT 11
CONCORD, NH 03301
PHONE (603) 225-2978 FAX (603) 225-0095

BRIDGE DESIGN

McFarland-Johnson, Inc.

CONCORD CENTER, STE 210
10 FERRY STREET, UNIT 11
CONCORD, NH 03301
PHONE (603) 225-2978 FAX (603) 225-0095

ROADWAY DESIGN



THESE PLANS ARE SUBJECT TO SUCH ENGINEERING CHANGES AS MAY BE REQUIRED BY THE FEDERAL HIGHWAY ADMINISTRATION OR THE DIRECTOR OF PROJECT DEVELOPMENT.
 CONSTRUCTION IS TO BE CARRIED ON IN ACCORDANCE WITH THESE PLANS AND THE STANDARD SPECIFICATIONS FOR CONSTRUCTION DATED 2006, AS APPROVED BY THE FEDERAL HIGHWAY ADMINISTRATION ON JANUARY 4, 2001 FOR USE ON THIS PROJECT, INCLUDING ALL SUBSEQUENT REVISIONS AND SUCH REVISED SPECIFICATIONS AND SPECIAL PROVISIONS AS ARE INCORPORATED IN THESE PLANS.

DEPARTMENT OF TRANSPORTATION
FEDERAL HIGHWAY ADMINISTRATION

APPROVED _____ DATE _____

DIRECTOR OF PROJECT DEVELOPMENT

APPROVED DATE 8/15/05

PROJECT MANAGER : ROGER WHITCOMB

PROJECT NAME : SHELBURNE
PROJECT NUMBER : BRO 1445(30)

SHEET 1 OF 73 SHEETS

INDEX OF SHEETS

1 TITLE SHEET
 2 INDEX SHEET
 3-5 TYPICAL SECTIONS
 6-10 ROW SHEETS
 11 TIE SHEET
 12 DRAINAGE DETAILS
 13-15 QUANTITY SHEETS
 16 DRAINAGE DETAIL SHEET
 17 ITEM DETAIL SHEET
 18-19 EARTHWORK SHEETS
 20-23 LAYOUT SHEETS
 24-28 PROFILE SHEETS
 29-32 PAVEMENT LAYOUT, ALIGNMENT, SIGNING & STRIPING
 33 TRAFFIC SIGN SUMMARY SHEET
 34-37 DETOUR LAYOUT SHEETS
 38-39 DETOUR PROFILE SHEETS
 40 PRELIMINARY INFORMATION SHEET
 41 BORING INFORMATION SHEET
 42 BORING LOG SHEET
 43 PLAN AND ELEVATION SHEET
 44 GENERAL NOTES
 45 DECK REINFORCEMENT DETAILS
 46-47 DECK DETAILS
 48 FRAMING PLAN AND DETAILS
 49 GIRDER DETAILS
 50 BEARING DETAILS
 51 APPROACH SLABS
 52 ABUTMENT NO. 1
 53 ABUTMENT NO. 1 FOOTING
 54 ABUTMENT NO. 2
 55 ABUTMENT NO. 2 FOOTING
 56 ABUTMENT DETAILS
 57 WINGWALL DETAILS
 58 REINFORCING STEEL SCHEDULE
 59-71 BOSTWICK ROAD CROSS SECTIONS
 72-73 BOSTWICK FARM ROAD DRIVE CROSS SECTIONS

STANDARD SHEETS

B-5 SLOPE GRADING, EMBANKMENTS, MUCK 06/01/94
 B-17 DETAIL OF TURNOUTS 02/23/95
 B-71 RESIDENTIAL AND COMMERCIAL DRIVES 11/16/00
 C-1 GRANITE SLOPE EDGING AND VERTICAL GRANITE CURB 01/03/00
 D-4 TYPICAL WATERFALL FOR CULVERTS, EXTENSION SERVICE BOX & CURB STOP 06/01/94
 D-8 REINFORCED CONCRETE DROP INLET W/ PRECAST COVER, REINFORCED 01/03/00
 D-10 TOP FOR A DROP INLET WITH BITUMINOUS CONCRETE CURB 06/01/94
 D-11 STEEL GRATE TYPE A CAST IRON COVER 06/01/94
 E-100 CONSTRUCTION APPROACH SIGNS 01/06/97
 E-101 CONSTRUCTION SIGN DETAILS 03/10/97
 E-102 CONSTRUCTION SIGN DETAILS 08/08/95
 E-102A CONSTRUCTION SIGN DETAILS 08/08/95
 E-106 TRAFFIC CONTROL MISCELLANEOUS DETAILS 08/08/95
 E-107 DELINEATION, BARRICADES AND DETOURS 08/08/95
 E-107A BREAKAWAY BARRICADE DETAILS 08/08/95
 E-108 CONSTRUCTION ZONE LONGITUDINAL DROP OFFS 08/18/95
 E-119 UTILITY WORK ZONE 08/08/95
 E-121 STANDARD SIGN PLACEMENT CONVENTIONAL ROAD 08/08/95
 E-134 BRIDGE NUMBER PLAQUE 08/08/95
 E-142 REGULATORY SIGN DETAILS 09/20/95
 E-143 REGULATORY SIGN DETAILS 09/20/95
 E-160 FLANGED CHANNEL STEEL SIGN POST 05/20/99
 G-1 STEEL BEAM GUARDRAIL W/ STEEL POSTS, WOOD POSTS 01/03/00
 G-1d STEEL BEAM GUARDRAIL APPROACH END TERMINAL 01/03/00
 G-4 STEEL MARKER POSTS 06/01/94
 G-18 PRECAST CONCRETE TEMPORARY TRAFFIC BARRIER 06/01/94
 J-3 MAILBOX SUPPORT DETAIL 08/07/95
 L-1 SETTLEMENT PLATFORMS 03/09/95
 T-1 TEMPORARY EROSION CONTROL DETAILS 06/01/94
 T-2 TEMPORARY EROSION CONTROL DETAILS 06/01/94
 SB-R6-82 BRIDGE RAILING-HEAVY DUTY STEEL BEAM 01/06/95
 SB-R7-90 BRIDGE RAILING-HEAVY DUTY STEEL BEAM 01/11/95

STANDARD SHEETS AND INDEX

PROJECT NAME:	SHELBURNE		
PROJECT NUMBER:	BRO 1445(30)		
FILE NAME:	M:\595402 Bostwick\HWY\DRAW\index.dgn	PLOT DATE:	01-AUG-2003
PROJECT LEADER:	MBZ	DRAWN BY:	MJF
DESIGNED BY:	DMB	CHECKED BY:	MDL
		SHEET	2 OF 73


DATUM	
VERTICAL	NAVD 88
HORIZONTAL	NAD 83 (1996)

TYPICAL SECTIONS


MATERIAL ITEM	THICKNESS TOLERANCE
PAVEMENT (TOTAL DEPTH)	1/4"
SUBBASE	1"
SAND	1"

TRAVELWAY: 3" BITUMINOUS CONCRETE PAVEMENT (2 1-1/2" LIFTS) TYPE III OR IV
 5" BITUMINOUS CONCRETE PAVEMENT (2 2-1/2" LIFTS) TYPE I OR II
 18" DENSE GRADED CRUSHED STONE
 12" SAND BORROW


SHOULDERS: 3" BITUMINOUS CONCRETE PAVEMENT (2 1-1/2" LIFTS) TYPE III OR IV
 18" DENSE GRADED CRUSHED STONE
 12" SAND BORROW

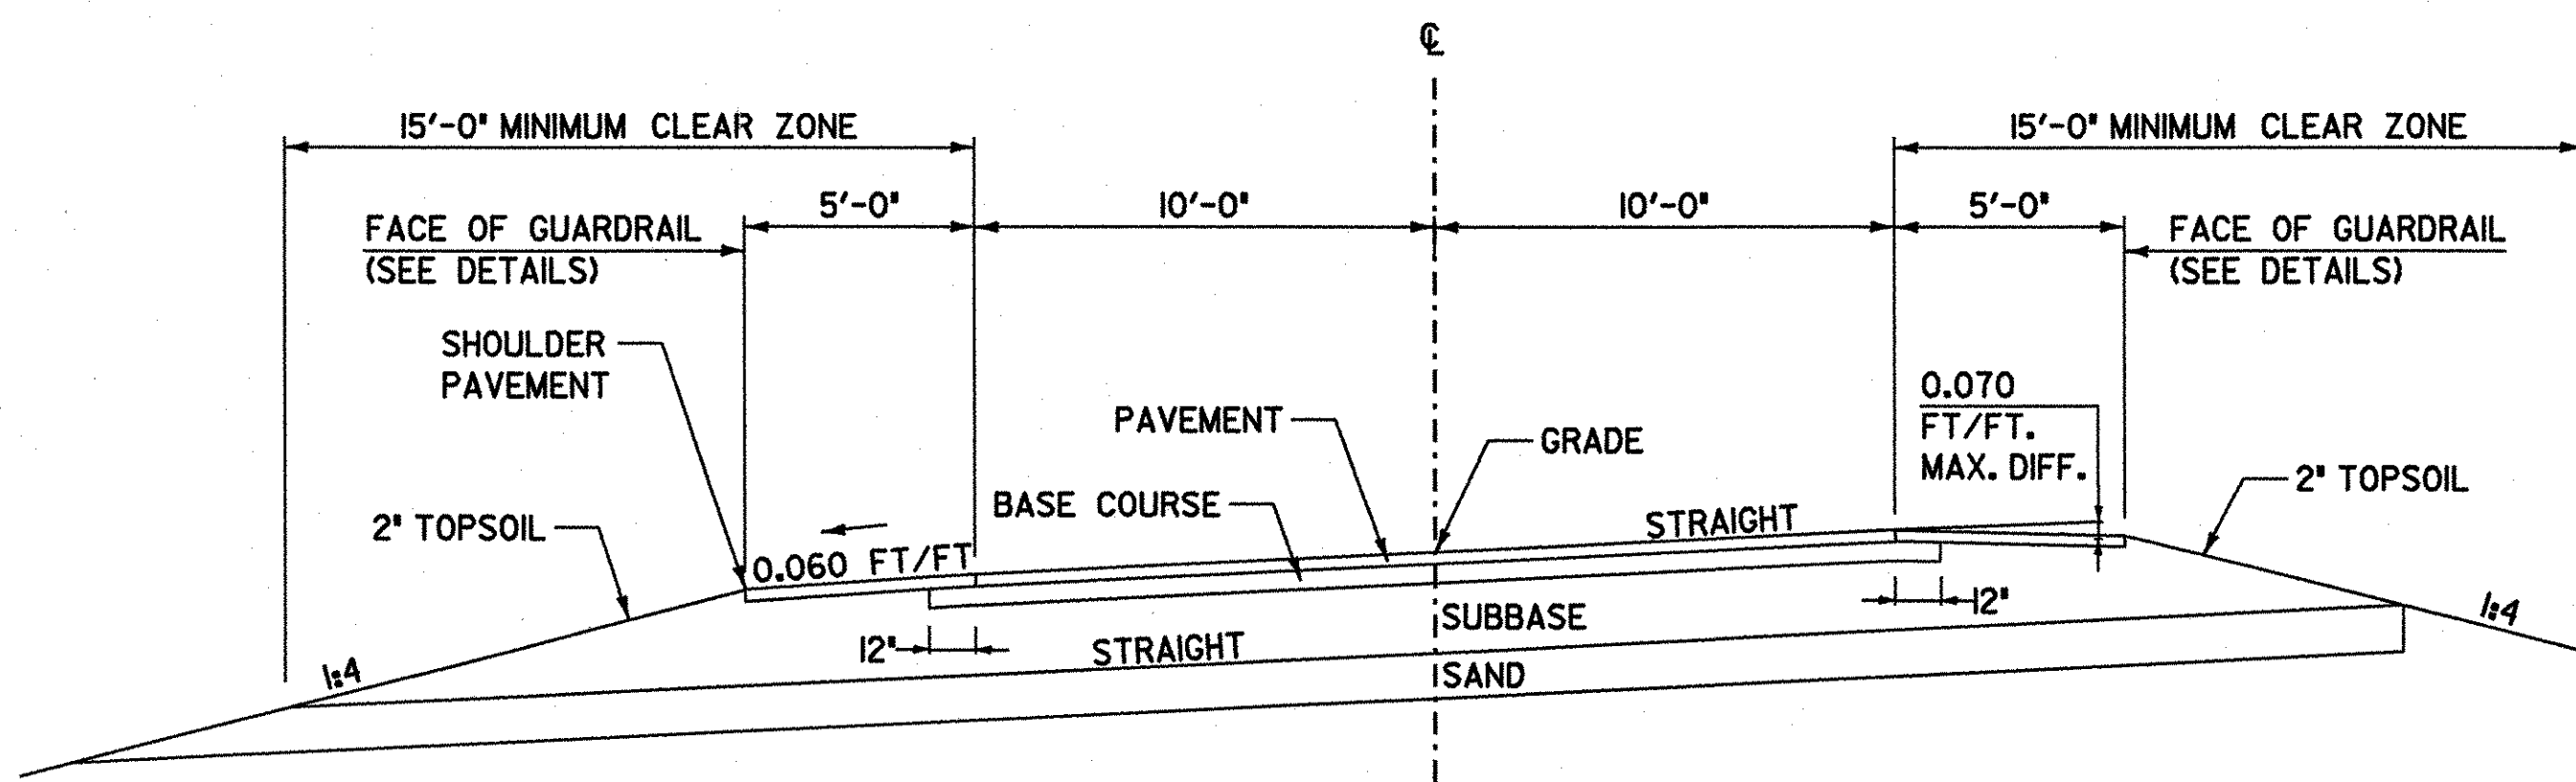

MAXIMUM BANKED SECTION 0.053 FT/FT

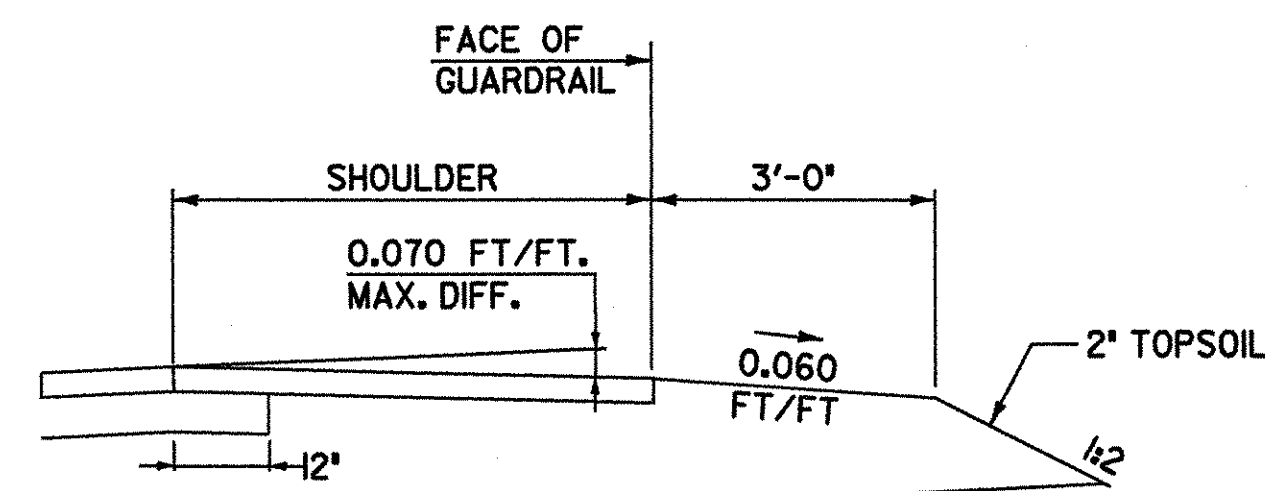

DETAIL OF GUARDRAIL ON HIGH SIDE OF BANKED SECTION

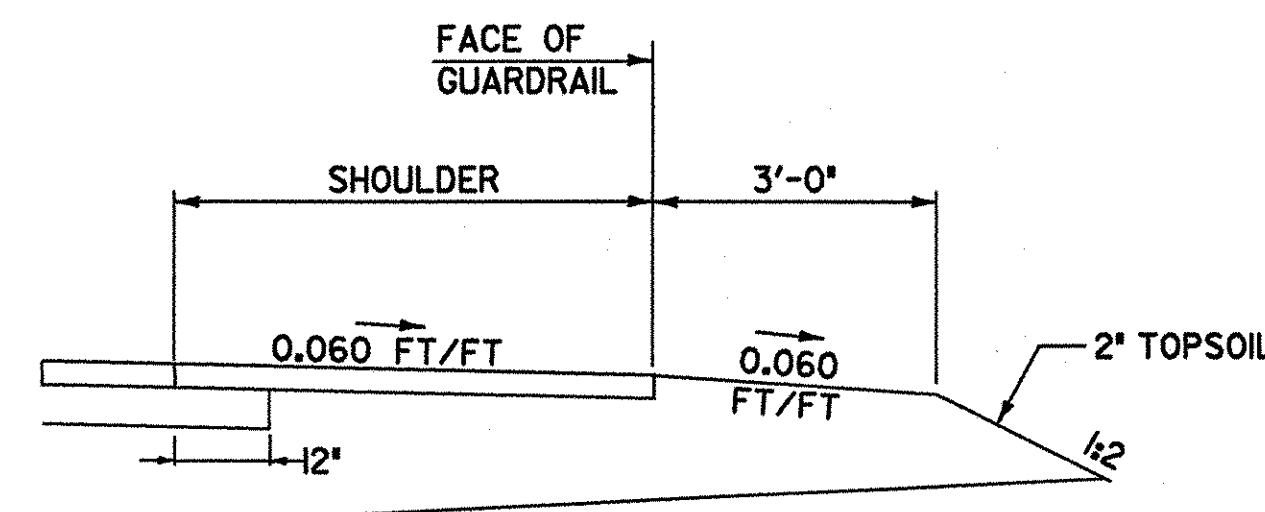

DETAIL OF GUARDRAIL ON LOW SIDE OF BANKED SECTION

SEEDING FORMULA RURAL AREAS

% WT.	LBS/A	NAME	PUR %	GERM %
37.5	22.5	CREEPING RED FESCUE	98	85
37.5	22.5	TALL FESCUE	95	90
5.0	3.0	RED TOP	95	90
15.0	9.0	BIRDSFOOT TREFOIL	98	85
5.0	3.0	ANNUAL RYE GRASS	95	85
100.0	60.0			

GENERAL NOTES

SEED MIXTURE: SHALL NOT HAVE A WEED CONTENT EXCEEDING 0.40% BY WEIGHT AND SHALL BE FREE OF ALL NOXIOUS SEED.

SEED: TO BE APPLIED PER SEEDING FORMULAS OR AS DIRECTED BY THE ENGINEER.

FERTILIZER: FORMULA 10-20-10, TO BE USED WITH SEED, APPLIED AT THE RATE OF 1/4 T/AC. (HYDRO SEEDERS MAY USE 19-19-19 FORMULA).

AGRICULTURAL LIMESTONE: TO BE APPLIED AT THE RATE OF 2 T/AC, OR AS DIRECTED BY THE ENGINEER.

HAY MULCH: TO BE PLACED ON EARTH SLOPES AT THE RATE OF 2 T/AC, OR AS DIRECTED BY THE ENGINEER.

TOPSOIL: TO BE USED WITH SEED AS INDICATED ON THE PLANS, OR AS DIRECTED BY THE ENGINEER.

TACK COAT: EMULSIFIED ASPHALT IS TO BE APPLIED AT THE RATE OF 0.15 GAL/SY BETWEEN SUCCESSIVE COURSES OF PAVEMENT AS DIRECTED BY THE ENGINEER.

BOSTWICK
ROAD
TYPICAL
SECTIONS

PROJECT NAME: SHELBURNE
 PROJECT NUMBER: BRO 1445(30)

FILE NAME: M:\1595402 Bostwick\HWY\DRAW\TYPICALS\typ001.dgn
 PROJECT LEADER: MBZ PLOT DATE: 01-AUG-2003
 DESIGNED BY: DMB DRAWN BY: MJF
 CHECKED BY: MDL SHEET 3 OF 73

DATUM
 VERTICAL NAVD 88
 HORIZONTAL NAD 83 (1996)


FOR SILT FENCE DETAIL, SEE STANDARD SHEET T-1

TYPICAL SECTIONS


PAVED DRIVES: 3" BITUMINOUS CONCRETE PAVEMENT (2 1-1/2" LIFTS) TYPE III OR IV
15" DENSE GRADED CRUSHED STONE

GRAVEL DRIVES: 3" AGGREGATE SURFACE COURSE
12" DENSE GRADED CRUSHED STONE

MATERIAL ITEM	THICKNESS TOLERANCE
PAVEMENT (TOTAL DEPTH)	1/4"
SUBBASE	1"
SAND	1"

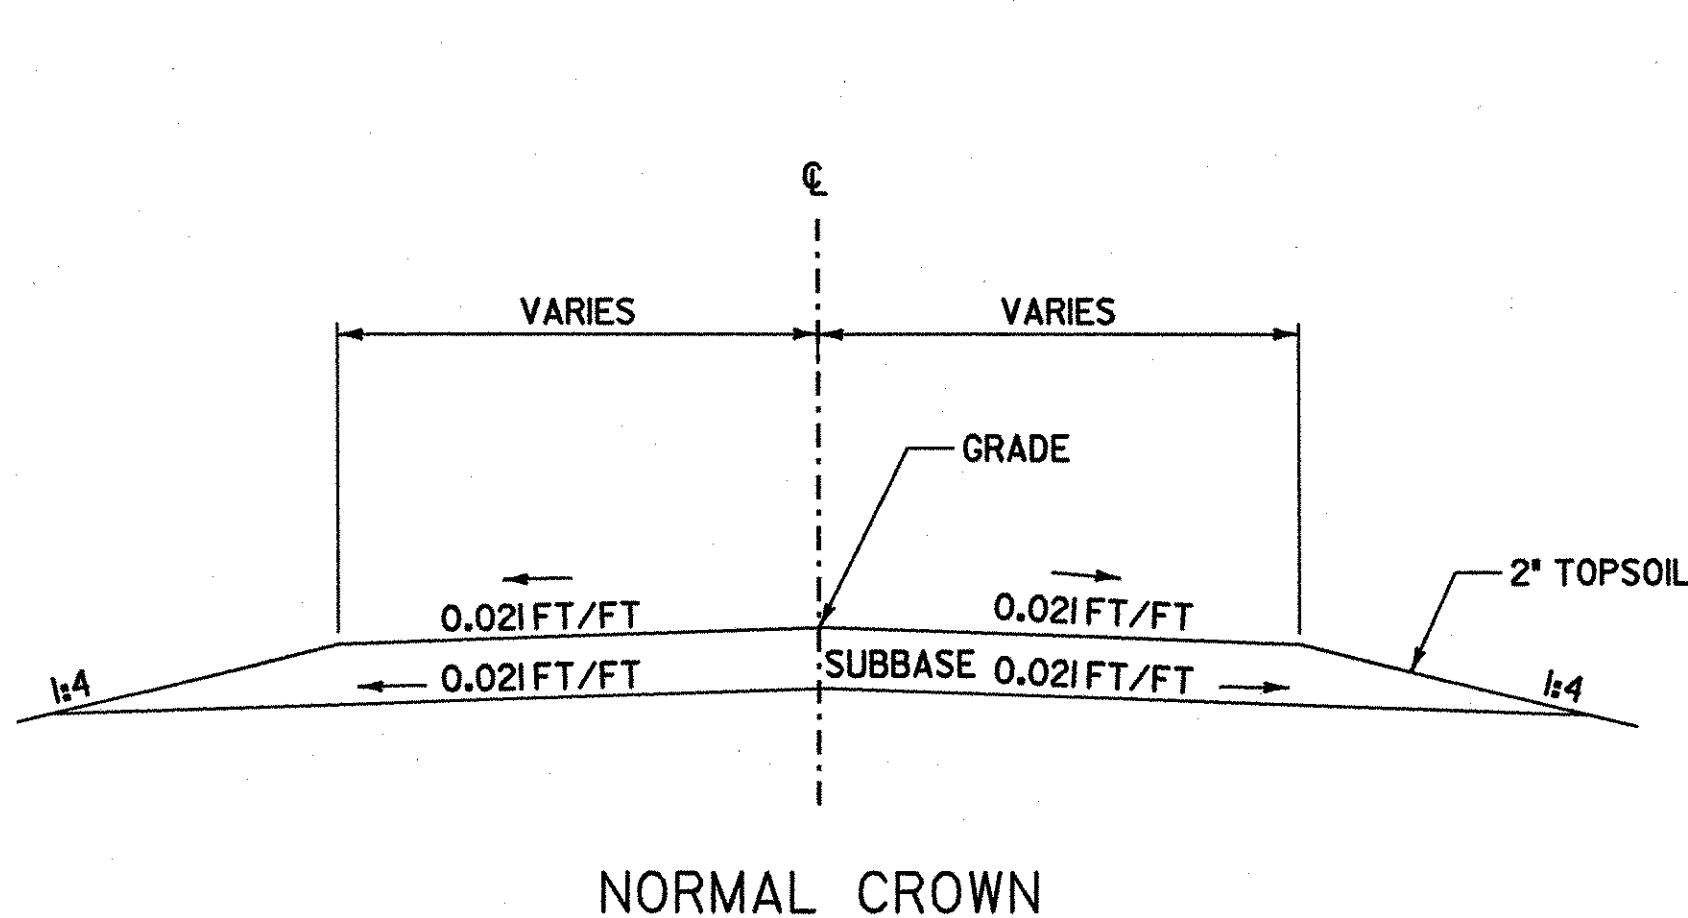


NORMAL CROWN

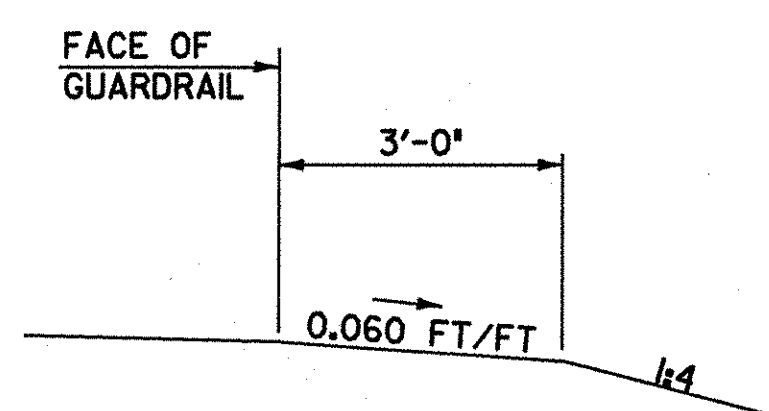


DETAIL OF GUARDRAIL SECTION

BOSTWICK FARM ROAD DRIVE

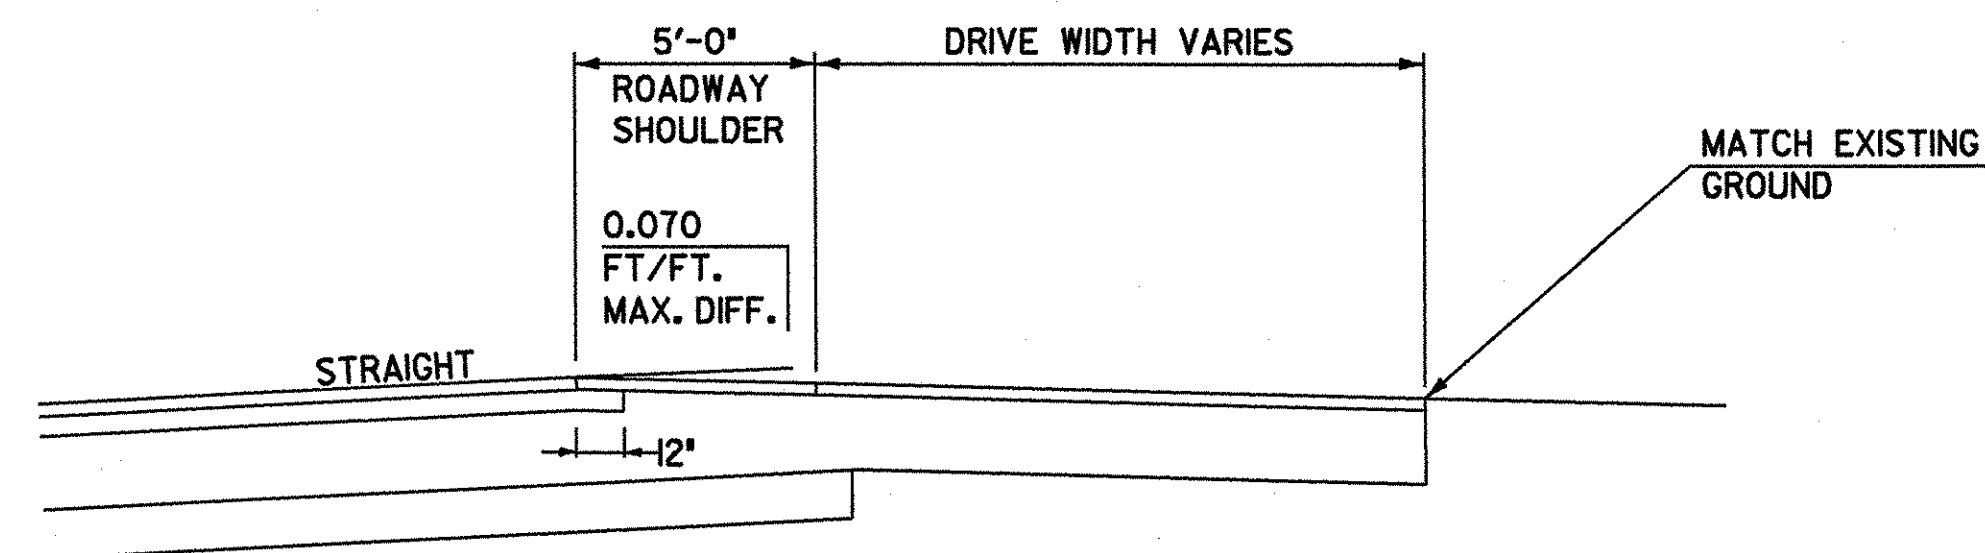

PAVED DRIVE

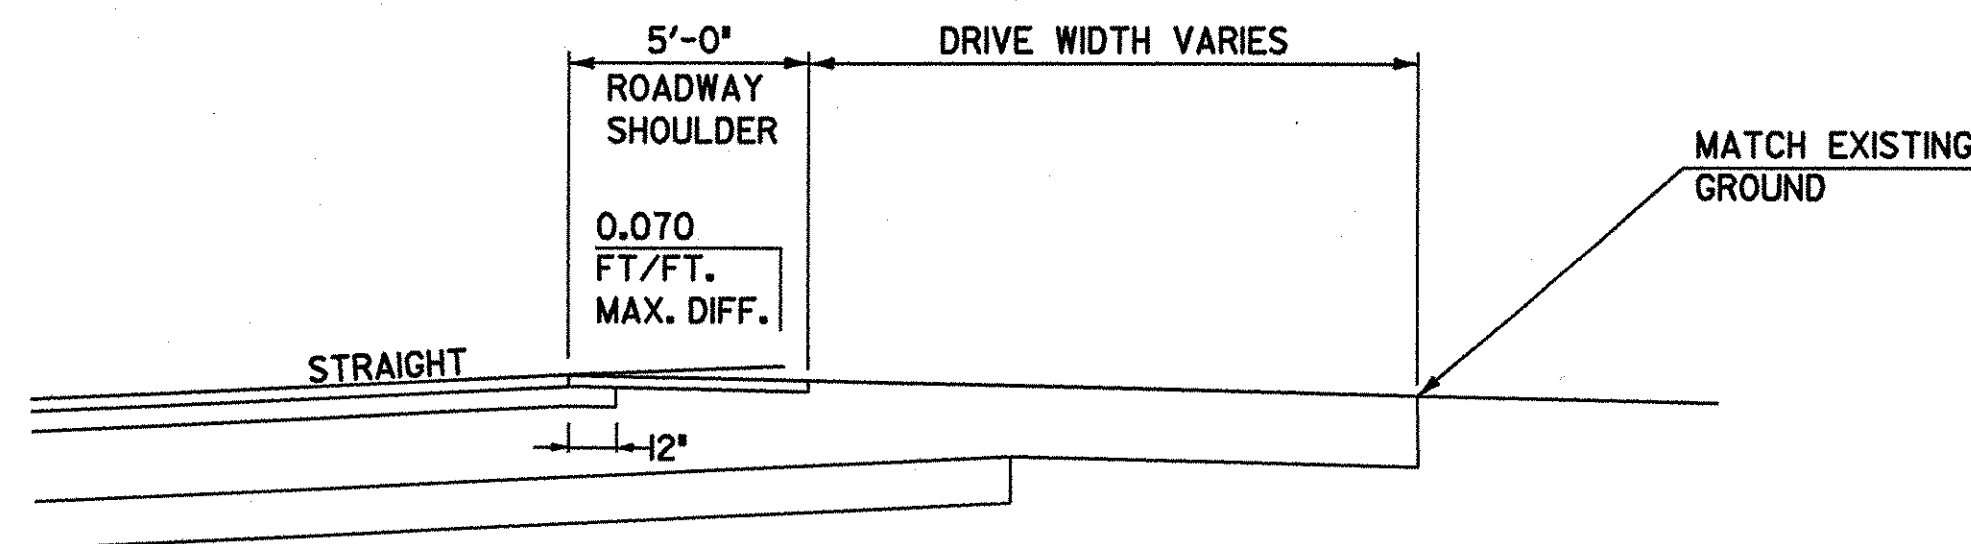

GRAVEL DRIVE

**SEEDING FORMULA
RURAL AREAS**

% WT.	LBS/A	NAME	PUR %	GERM %
37.5	22.5	CREEPING RED FESCUE	98	85
37.5	22.5	TALL FESCUE	95	90
5.0	3.0	RED TOP	95	90
15.0	9.0	BIRDSFOOT TREFOIL	98	85
5.0	3.0	ANNUAL RYE GRASS	95	85
100.0	60.0			

GENERAL NOTES

SEED MIXTURE: SHALL NOT HAVE A WEED CONTENT EXCEEDING 0.40% BY WEIGHT AND SHALL BE FREE OF ALL NOXIOUS SEED.

SEED: TO BE APPLIED PER SEEDING FORMULAS OR AS DIRECTED BY THE ENGINEER.

FERTILIZER: FORMULA 10-20-10, TO BE USED WITH SEED, APPLIED AT THE RATE OF 1/4 T/AC. (HYDRO SEEDERS MAY USE 19-19-19 FORMULA).

AGRICULTURAL LIMESTONE: TO BE APPLIED AT THE RATE OF 2 T/AC, OR AS DIRECTED BY THE ENGINEER.

HAY MULCH: TO BE PLACED ON EARTH SLOPES AT THE RATE OF 2 T/AC, OR AS DIRECTED BY THE ENGINEER.

TOPSOIL: TO BE USED WITH SEED AS INDICATED ON THE PLANS, OR AS DIRECTED BY THE ENGINEER.

TACK COAT: EMULSIFIED ASPHALT IS TO BE APPLIED AT THE RATE OF 0.15 GAL/SY BETWEEN SUCCESSIVE COURSES OF PAVEMENT AS DIRECTED BY THE ENGINEER.

DATUM	
VERTICAL	NAVD 88
HORIZONTAL	NAD 83 (1996)


FOR SILT FENCE DETAIL, SEE STANDARD SHEET T-1

DRIVE TYPICAL SECTIONS	PROJECT NAME: SHELBURNE
	PROJECT NUMBER: BRO 1445(30)
	FILE NAME: M:\1595402 Bostwick\HWY\DRAW\TYPICALS\typ002.dgn
	PROJECT LEADER: MBZ
DESIGNED BY: DMB	PLOT DATE: 01-AUG-2003
CHECKED BY: MDL	DRAWN BY: MJF
	SHEET 4 OF 73


MATERIAL ITEM	THICKNESS TOLERANCE
PAVEMENT (TOTAL DEPTH)	1/4"
SUBBASE	1"
SAND	1"

DETOUR TYPICAL SECTIONS


3" BITUMINOUS CONCRETE PAVEMENT TYPE III
12" DENSE GRADED CRUSHED STONE

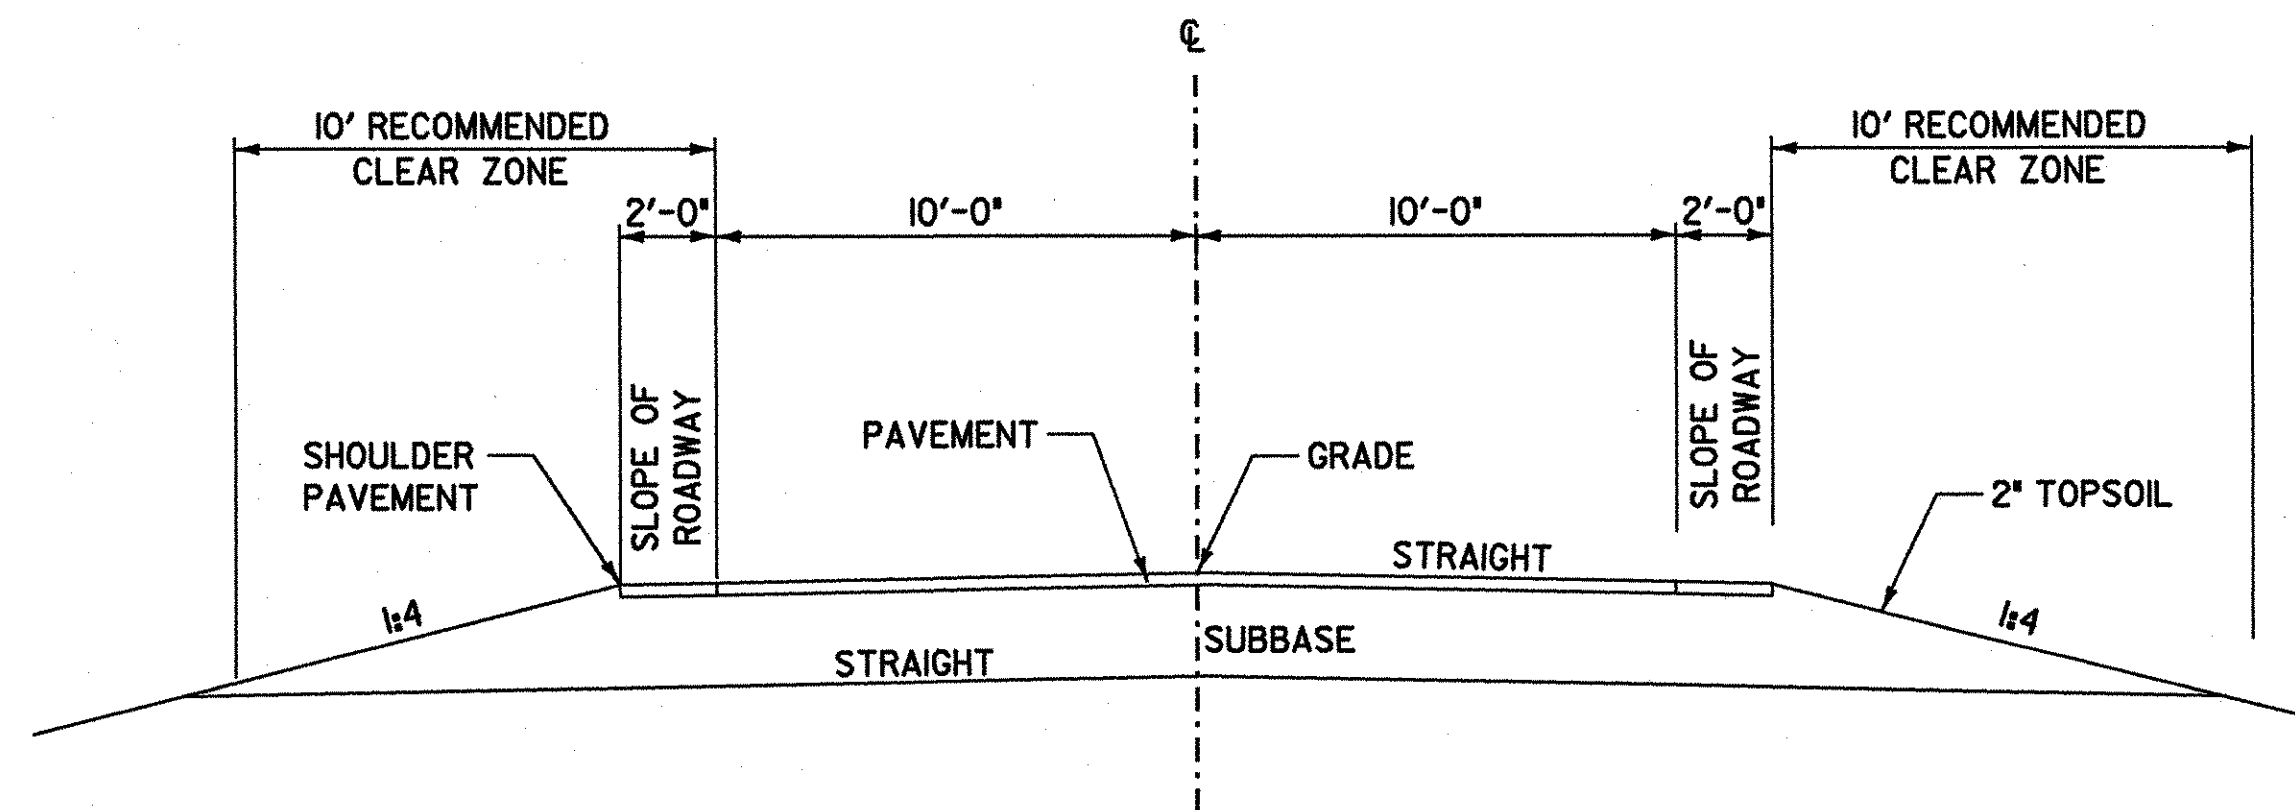


NORMAL CROWN SECTION

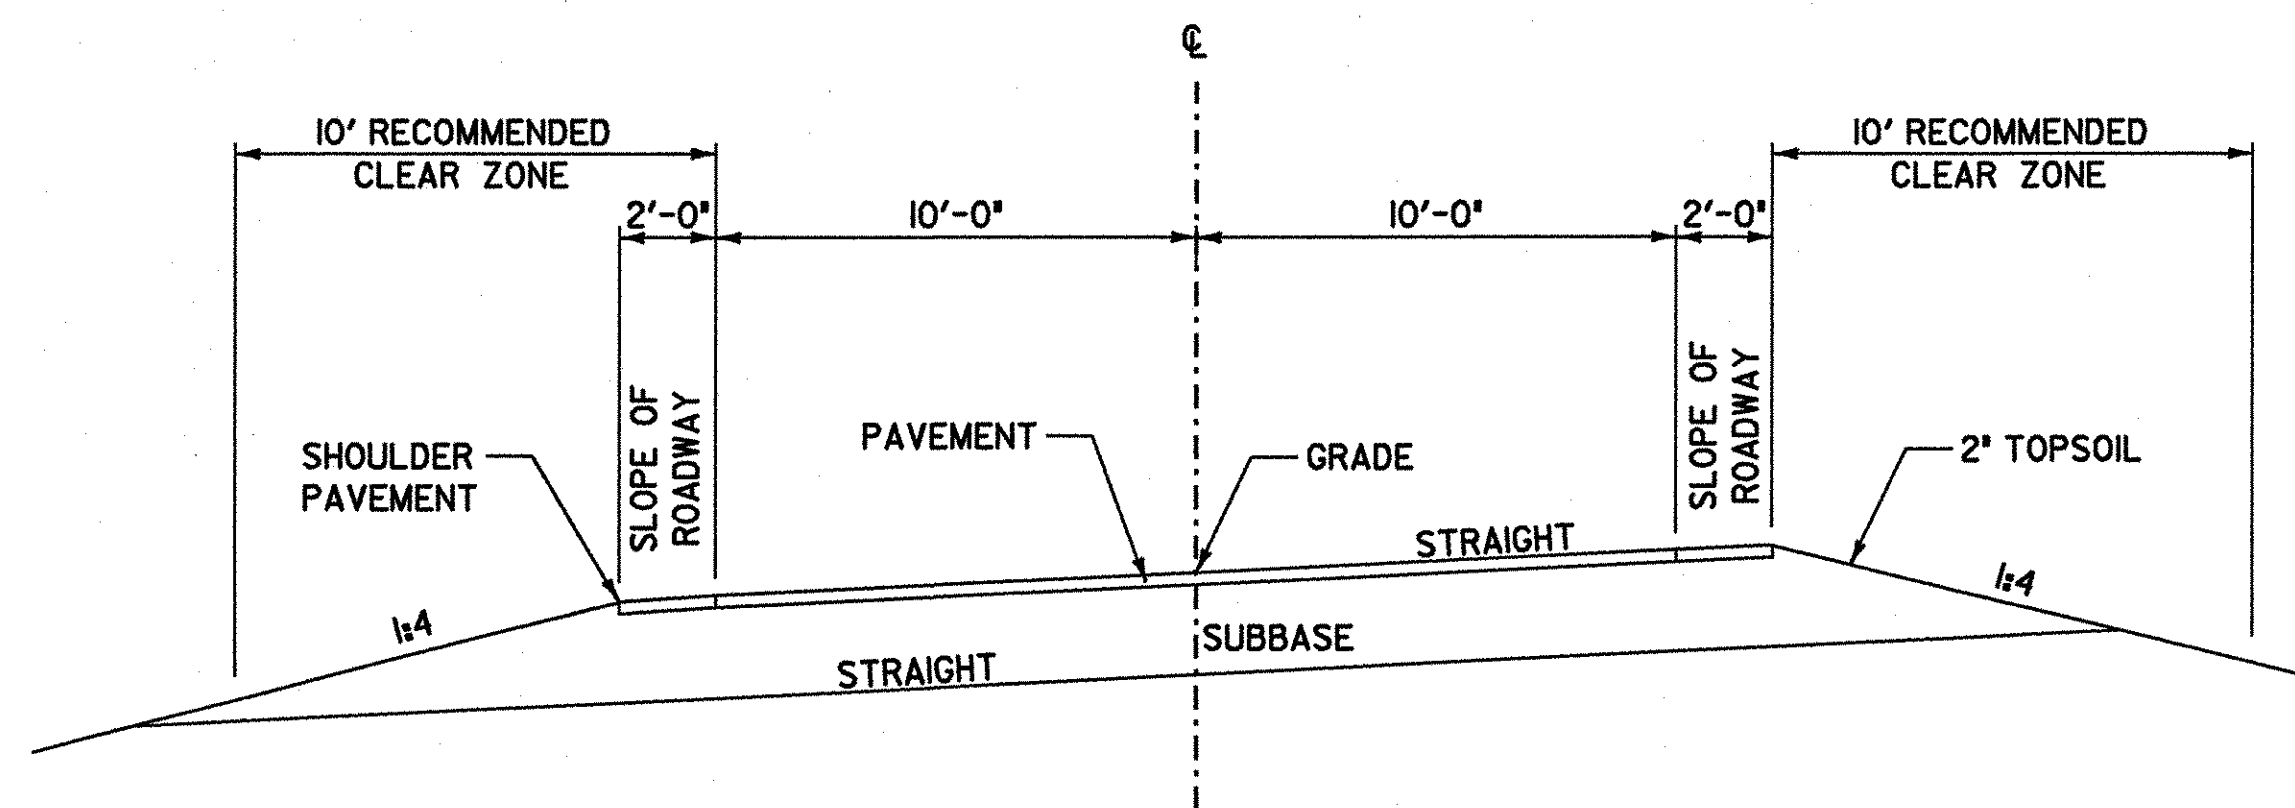


MAXIMUM BANKED SECTION 0.050 FT/FT

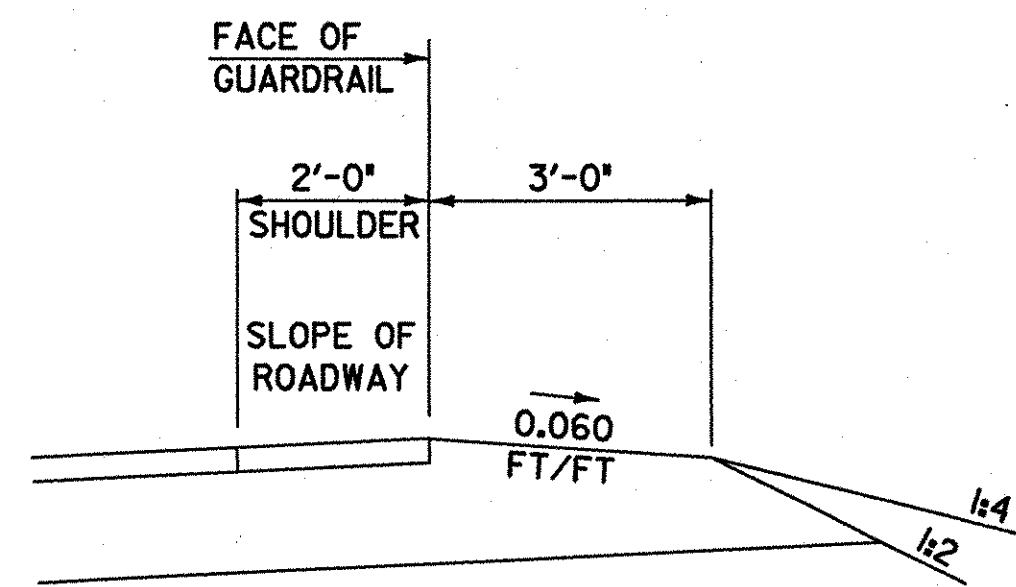

DETAIL OF GUARDRAIL ON HIGH SIDE OF BANKED SECTION

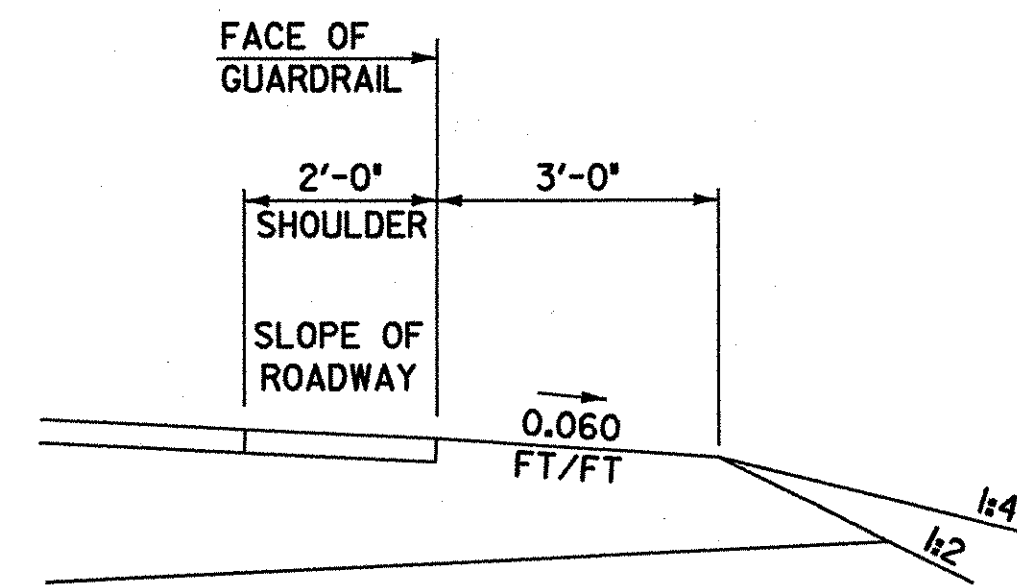

DETAIL OF GUARDRAIL ON LOW SIDE OF BANKED SECTION

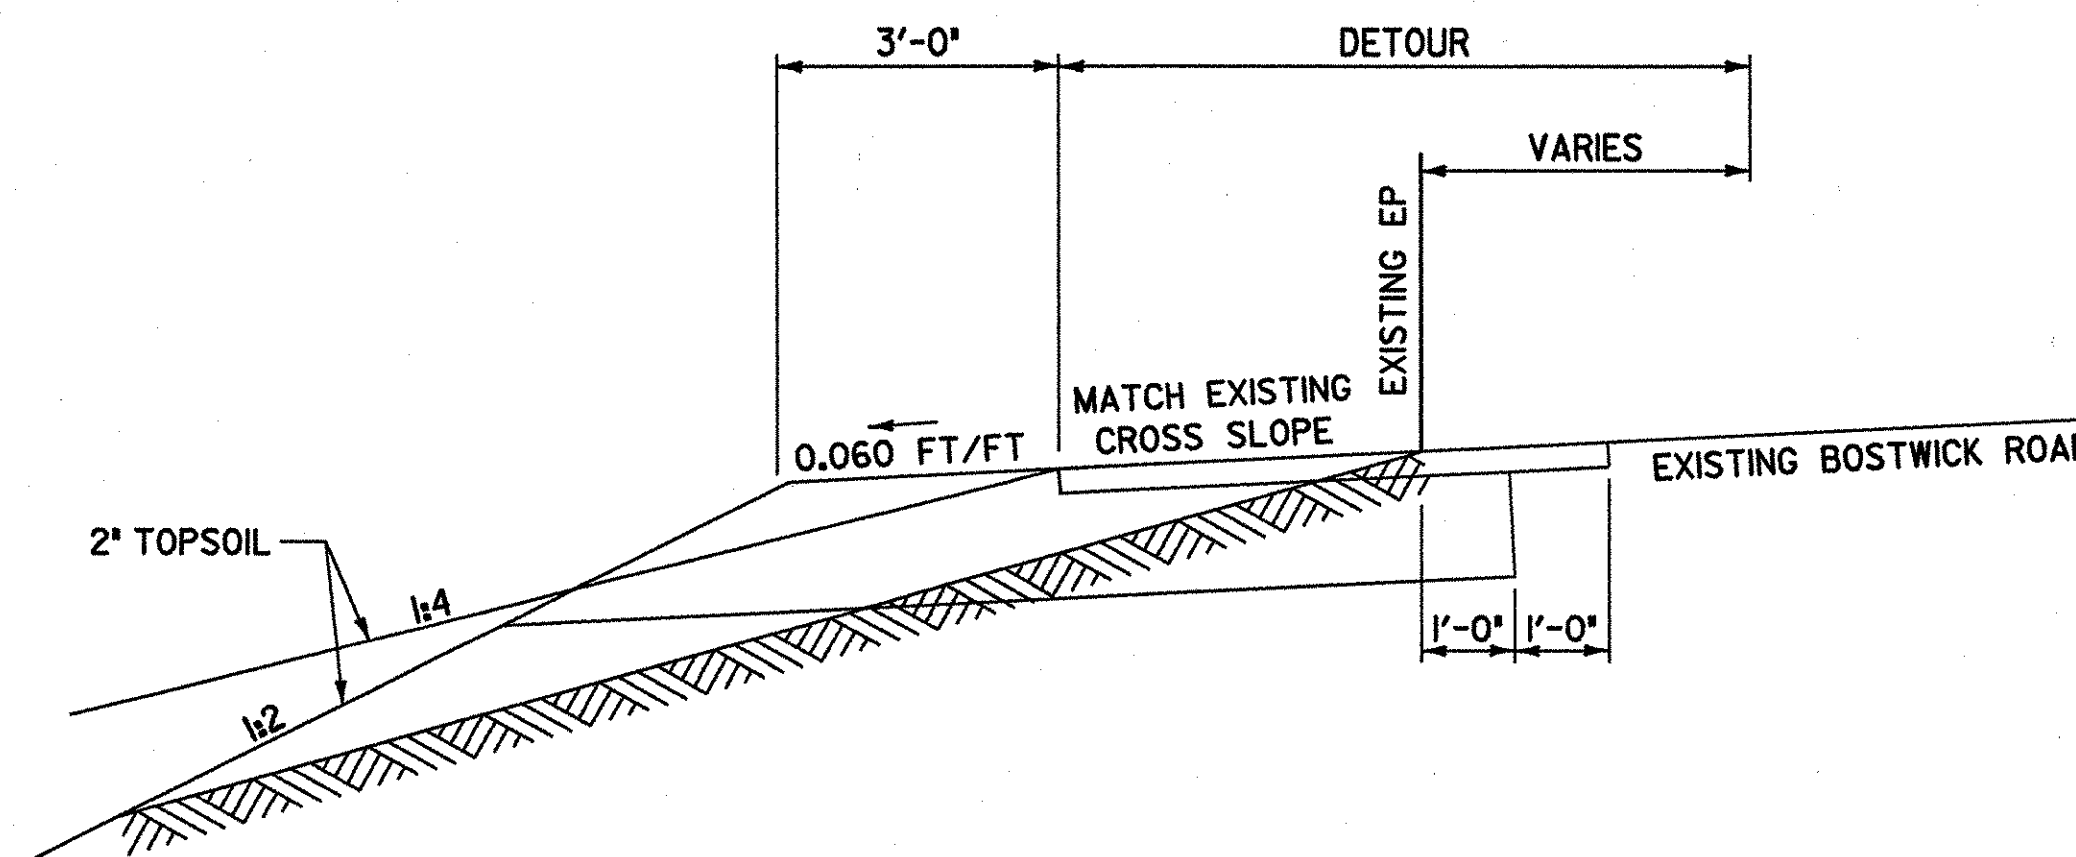

DETOUR MATCH TO EXISTING ROAD
STA 16+25 TO 17+50
STA 24+00 TO 25+50

SEEDING FORMULA RURAL AREAS

% WT.	LBS/A	NAME	PUR %	GERM %
37.5	22.5	CREEPING RED FESCUE	98	85
37.5	22.5	TALL FESCUE	95	90
5.0	3.0	RED TOP	95	90
15.0	9.0	BIRDSFOOT TREFOIL	98	85
5.0	3.0	ANNUAL RYE GRASS	95	85
100.0	60.0			

GENERAL NOTES

SEED MIXTURE: SHALL NOT HAVE A WEED CONTENT EXCEEDING 0.40% BY WEIGHT AND SHALL BE FREE OF ALL NOXIOUS SEED.

SEED: TO BE APPLIED PER SEEDING FORMULAS OR AS DIRECTED BY THE ENGINEER.

FERTILIZER: FORMULA 10-20-10, TO BE USED WITH SEED, APPLIED AT THE RATE OF 1/4 T/AC. (HYDRO SEEDERS MAY USE 19-19-19 FORMULA).

AGRICULTURAL LIMESTONE: TO BE APPLIED AT THE RATE OF 2 T/AC, OR AS DIRECTED BY THE ENGINEER.

HAY MULCH: TO BE PLACED ON EARTH SLOPES AT THE RATE OF 2 T/AC, OR AS DIRECTED BY THE ENGINEER.

TOPSOIL: TO BE USED WITH SEED AS INDICATED ON THE PLANS, OR AS DIRECTED BY THE ENGINEER.

TACK COAT: EMULSIFIED ASPHALT IS TO BE APPLIED AT THE RATE OF 0.15 GAL/SY BETWEEN SUCCESSIVE COURSES OF PAVEMENT AS DIRECTED BY THE ENGINEER.

DETOUR TYPICAL SECTIONS

PROJECT NAME: SHELBURNE
PROJECT NUMBER: BRO 1445(30)

FILE NAME: M:\595402 Bostwick\HWY\DRAW\TYPICALS\dettyp001.dgn
PROJECT LEADER: MBZ PLOT DATE: 01-AUG-2003
DESIGNED BY: DMB DRAWN BY: MJF
CHECKED BY: MDL SHEET 5 OF 73

DATUM
VERTICAL NAVD 88
HORIZONTAL NAD 83 (1996)

FOR SILT FENCE DETAIL, SEE STANDARD SHEET T-1

RIGHT - OF - WAY DETAIL SHEET


TABLE OF PROPERTY ACQUISITION

PARCEL NO.	PROPERTY OWNER	SHEET NO.	BEGINNING STATION	ENDING STATION	TAKE	REMAINDER	RIGHT			RECORDING DATA			REMARKS
							AREA ±	AREA ±	TYPE	(T)/(P)	AREA ±	TOWN / CITY	
1A	MEACH COVE REAL ESTATE TRUST; ANASTASIOS PARAFESTAS, TRUSTEE	16,17,18	13+33.3 LT.	19+36.1 LT.			CONST.	T	3,090 S.F.	SHELBURNE			INCL. EROSION CONTROL
			13+57.1 LT.	18+37.3 LT.			SLOPE	P	0.12A		5,150 S.F. ±; INCL. EROSION CONTROL		
			14+13.1 LT.	14+19.8 LT.			CUL.	P					
			14+17.5 LT.	19+10.9 LT.			DITCH & DRAINAGE	P	2,840 S.F.			STONE LINED DITCH;	
			14+22.57 LT.				REMOVE	T				INCL. EROSION CONTROL	
			14+43.2 LT.				REMOVE	T				BOUND 31.58' LT.	
			14+90.9 LT.				REMOVE	T				TREE	
			15+40.2 LT.				REMOVE	T				TREE	
			15+87.3 LT.				REMOVE	T				TREE	
			16+40.8 LT.				REMOVE	T				TREE	
			16+86.3 LT.				REMOVE	T				TREE	
			17+34.0 LT.				REMOVE	T				TREE	
			17+79.3 LT.				REMOVE	T				TREE	
			17+11.7 LT.	20+16.4 LT.			DETOUR	T	4,000 S.F.			INCL. EROSION CONTROL	
			18+24.5 LT.				REMOVE	T				TREE	
			18+72.4 LT.				REMOVE	T				TREE	
			SL 40+00.00 CL	SL 41+00.00 CL			DRIVE	T					
			19+58.2 LT.	19+61.2 LT.			INSTALL & MAINTAIN	P				GUARDRAIL	
			19+83.33 LT.				REMOVE & RESET	T				BOUND 33.04' LT.	
			19+85.3 LT.				REMOVE & RESET	T				SIGN POST	
19+95.0 LT.	20+15.3 LT.			REMOVE & RESET	T			FENCE					
20+01.51 LT.				REMOVE & RESET	T			BOUND 32.84' LT.					
1B		18,19	21+32.18 LT.				REMOVE & RESET	T		SHELBURNE			BOUND 31.86' LT.
			21+32.2 LT.	26+08.6 LT.			SLOPE	P	0.13A		5,475 S.F. ±; INCL. DRAINAGE SWALE		
			21+32.2 LT.	24+05.1 LT.			DETOUR	T	0.18A		7,930 S.F. ±; INCL. EROSION CONTROL;		
											INCLUDES TEMP. CULVERT		
			21+65.0 LT.	22+17.8 LT.			INSTALL	T	280 S.F.		EROSION CONTROL		
			21+78.0 LT.	21+86 LT.			CUL.	P					
			21+90.0 LT.				REMOVE	T			TREE		
			22+39.5 LT.				REMOVE	T			TREE		
			22+87.2 LT.				REMOVE	T			TREE		
			23+30.3 LT.	26+73.2 LT.			CONST.	T	1,690 S.F.		INCL. EROSION CONTROL		
23+81.3 LT.				REMOVE	T		TREE						
24+22.1 LT.				REMOVE	T		TREE						
1C		16,17,18	12+00.0 RT.	19+60.7 RT.			CONST.	T	0.21A	SHELBURNE			INCL. EROSION CONTROL; 8,990 S.F. ±
			12+86.1 RT.	18+01.2 RT.			SLOPE	T	3,480 S.F.		INCL. EROSION CONTROL		
			13+46.6 RT.	13+61.2 RT.			CUL., DIT. & DR.	P					
			13+53.8 RT.				REMOVE	T			TREE		
			14+22.84 RT.				REMOVE & RESET	T			BOUND 34.47' RT.		
			18+70.0 RT.				DRIVE	T			15' WIDE		
			18+89.0 RT.	19+65.1 RT.			SLOPE	P	290 S.F.				
19+65.11 RT.				REMOVE & RESET	T		BOUND 33.22' RT.						
2	STATE OF VERMONT, LESSOR; VERMONT RAILWAY, INC., LESSEE	18	19+57.1 RT.	20+19.8 RT.			CONST.	T	740 S.F.	SHELBURNE			INCL. EROSION CONTROL
			19+60.7 RT.	20+11.8 RT.			SLOPE	P	600 S.F.				
			19+65.11 RT.	21+32.18 LT.			HWY. CROSSING	P	0.19A		8,440 S.F. ±		
			20+01.5 LT.	21+65.0 LT.			DETOUR	T	3,600 S.F.		INCL. EROSION CONTROL		
			20+22.4 RT.	20+78.8 RT.			CONST.	T	1,110 S.F.		INCL. EROSION CONTROL		
			20+65.8 RT.	20+88.6 RT.			SLOPE	P	200 S.F.				
			21+37.4 LT.	21+70.1 LT.			INSTALL	T	160 S.F.		EROSION CONTROL		
			20+92.7 LT.	21+43.5 LT.			SLOPE	P	436 S.F.		INCL. EROSION CONTROL		
3	WAKE ROBIN CORPORATION	18,19	20+72.1 RT.	24+41.1 RT.			CONST.	T	2,177 S.F.	SHELBURNE			INCL. EROSION CONTROL
			20+78.8 RT.	23+80.7 RT.			SLOPE	P	3,710 S.F.		INCL. EROSION CONTROL		
			20+88.62 RT.				REMOVE & RESET	T			BOUND 33.99' RT.		
			21+12.92 RT.				REMOVE & RESET	T			BOUND 34.45' RT.		
			21+15.2 RT.				REPLACE	T			TREE		
			21+46.1 RT.	21+56.6 RT.			CUL., DIT. & DR.	P					
			24+45 RT.				DRIVE	T					

TABLE OF REVISIONS

REVISION NO.	SHEET NO.	DESCRIPTION	DATE
		ELECTRONIC FILES TO STRUCTURES	07/31/2003
1	15,16 17,18 19	PARCEL NO. 1 CHANGE ALL "REMOVE & RESET (T)" TREES TO "REMOVE." CHANGE "REPLACE (T)" TREE TO "REMOVE." CHANGE REMOVE & RESET (T) "SHRUBS & SIGN POST" TO REMOVE & RESET "SIGN POST" ONLY. PER C.O. 9308	08/06/2003

PLAN LEGEND

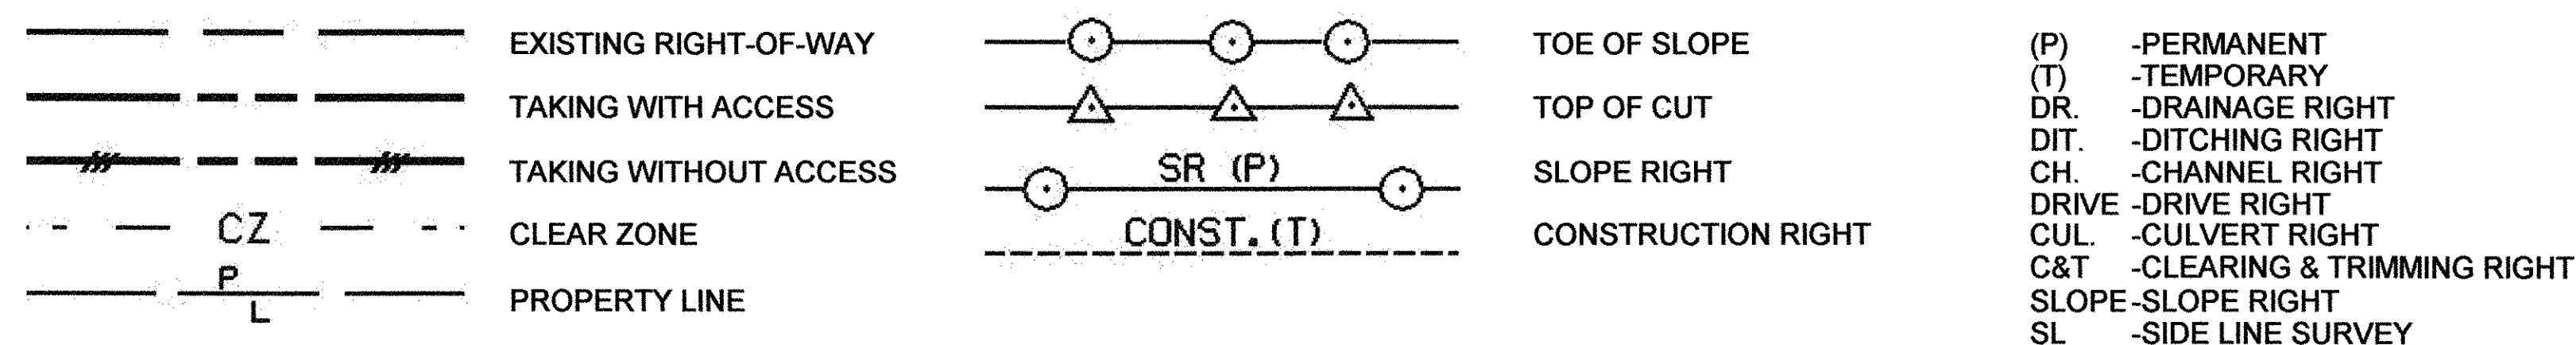


APPROVED: ROGER P. DUMAS DATE: 03-10-03
CHIEF, PLANS & TITLES

PROJECT NAME: **SHELBURNE**
PROJECT NUMBER: **BRO 1445(30)**

FILE NAME: 94J196DET	PLOT DATE: 07/31/03
PROJECT LEADER: MBZ	DRAWN BY: EGP
DESIGNED BY: DMB	CHECKED BY: GJF
R.O.W. SHEET 15 OF 19	SHEET 6 OF 73


GEOTEXTILE FOR SILT FENCE
12+00, RT - 13+50, RT

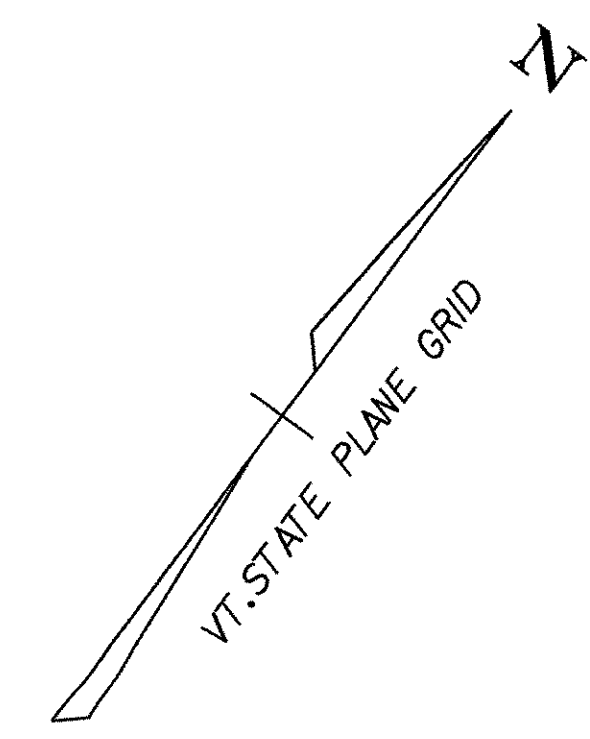

1A

**MEACH COVE REAL ESTATE TRUST;
ANATASIOS PARAFESTAS,
TRUSTEE**

STA 12+00.00
BEGIN APPROACH CONSTRUCTION
MATCH EXISTING PAVEMENT

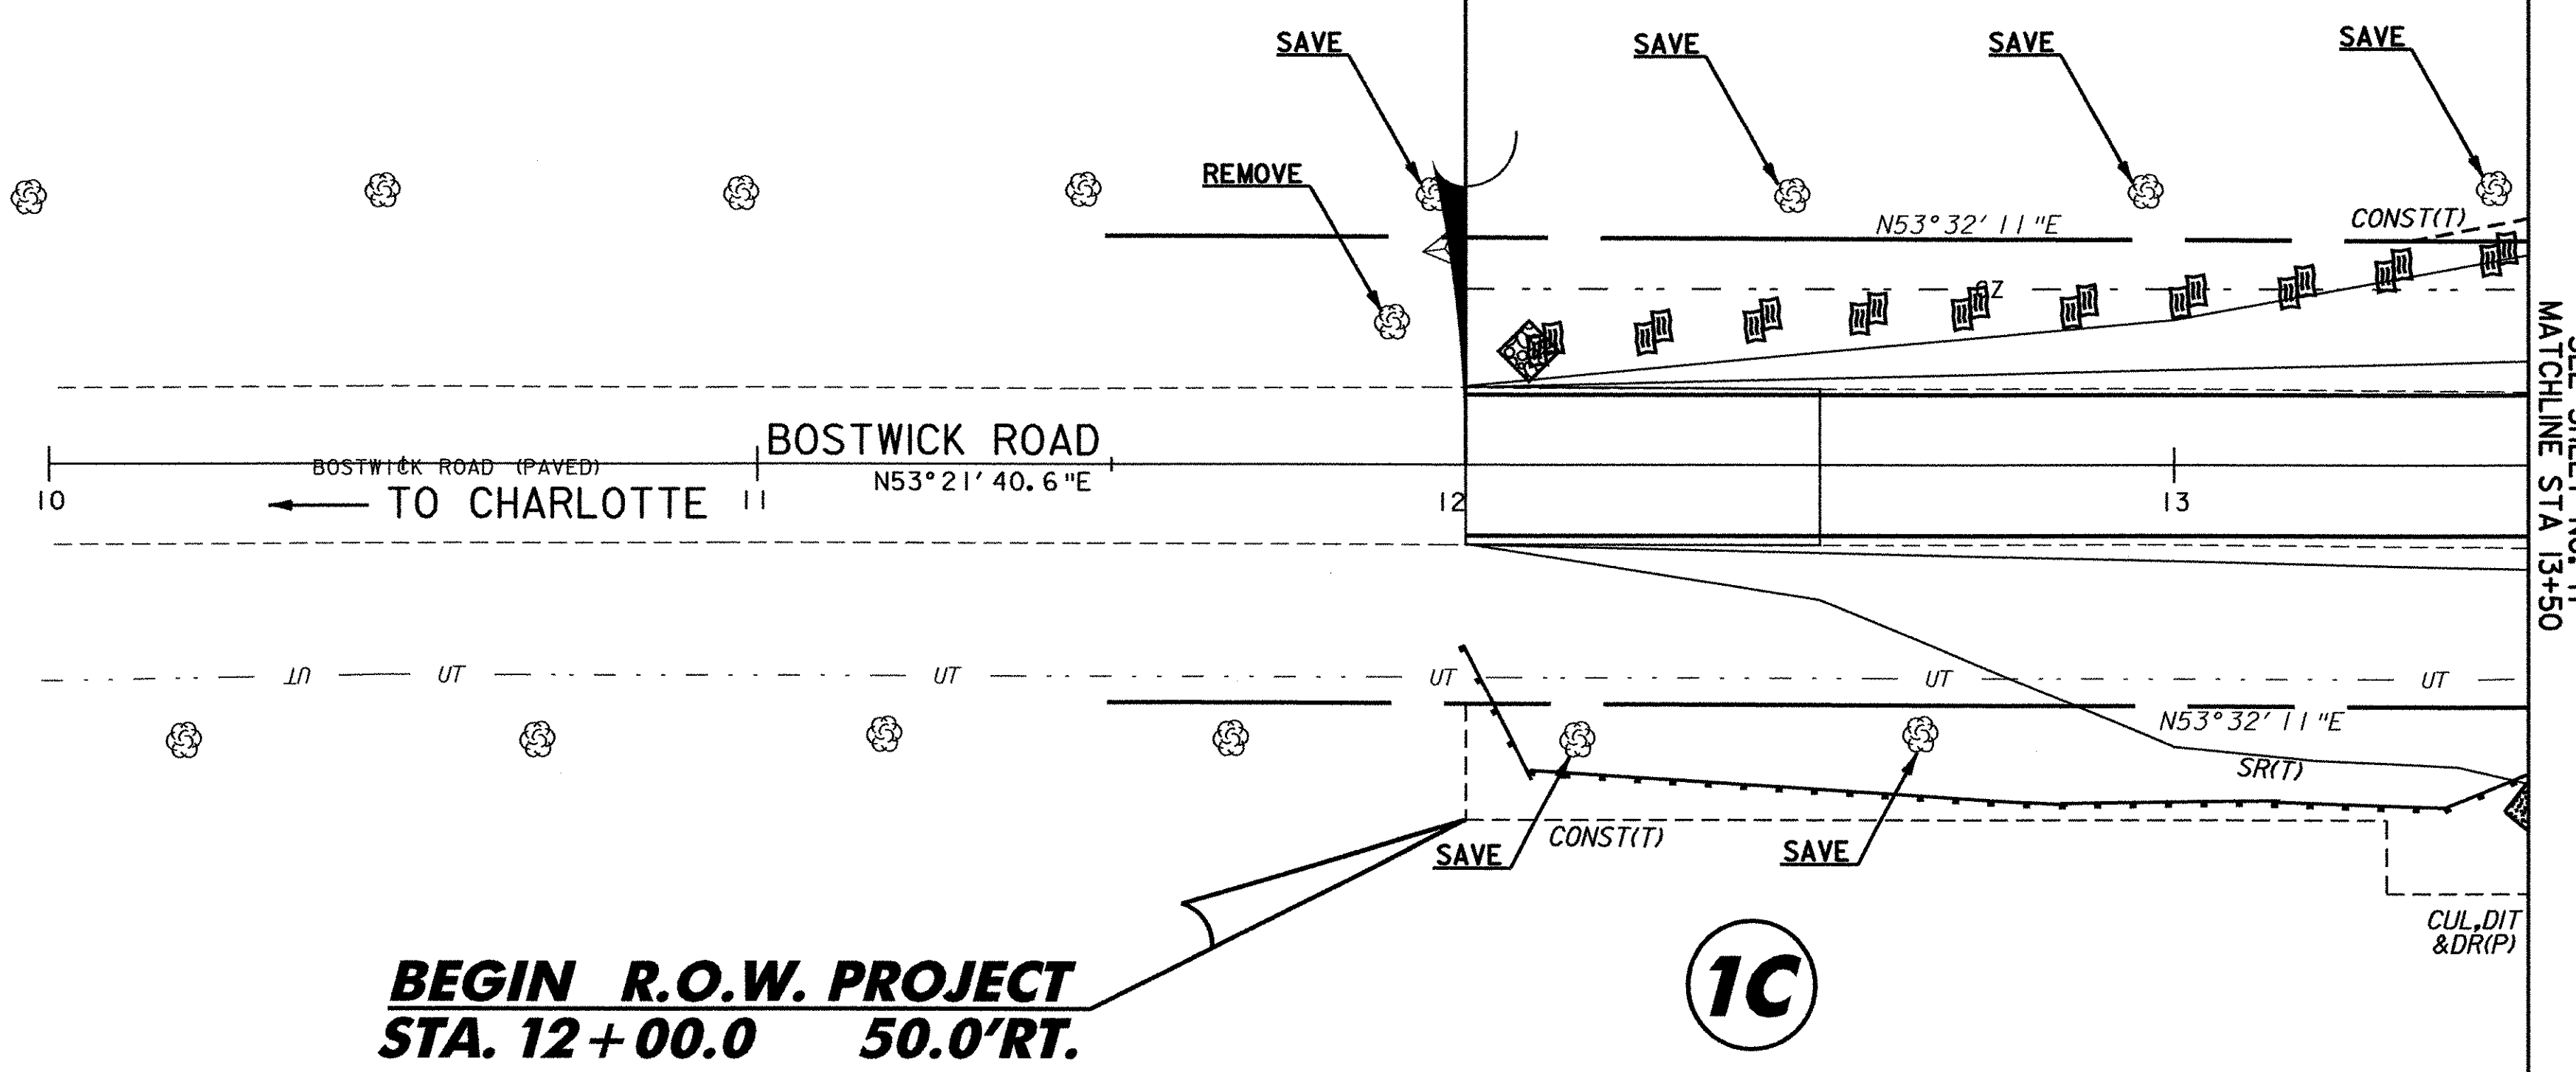






SEE SHEET NO. 17
MATCHLINE STA 13+50


1C

**MEACH COVE REAL ESTATE TRUST;
ANATASIOS PARAFESTAS,
TRUSTEE**

**BEGIN R.O.W. PROJECT
STA. 12+00.0 50.0'RT.**

-  STONE DITCH (PERMANENT)
-  WETLANDS
-  EROSION MATTING (TEMPORARY)
-  HAYBALES (TEMPORARY)
-  STONE CHECK DAM (TEMPORARY)

LINES SHOWN ON THIS PLAN AS EXISTING PROPERTY LINES P/L ARE BELIEVED TO BE ACCURATE BUT SHOULD NOT BE RELIED UPON FOR PURPOSES UNRELATED TO THE TOWN OF SHELBURNE'S ACQUISITION OF LAND AND RIGHTS FOR THIS PROJECT.

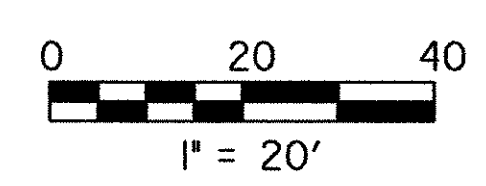

**FOR R.O.W.
USE ONLY**

DATUM
VERTICAL NAVD 88
HORIZONTAL NAD 83 (1996)


LAYOUT SHEET	PROJECT NAME: SHELBURNE
	PROJECT NUMBER: BRO 1445(30)
	FILE NAME: \\vaot_cadd\fillingcabinet\94\96\RightOfWay\layout1.dgn
	PROJECT LEADER: MBZ PLOT DATE: 06-AUG-2003
DESIGNED BY: DMB DRAWN BY: MJF	
CHECKED BY: R.O.W. SHEET 16 OF 19 SHEET 7 OF 73	

GEOTEXTILE FOR SILT FENCE
13+50, RT - 17+50, RT


**MEACH COVE REAL ESTATE TRUST;
ANATASIOS PARAFESTAS, TRUSTEE**

1A

BOSTWICK ROAD CURVE DATA CURVE #1	
PI	= 17+04.97
Δ	= 33°04'46.1"LT
R	= 950.00'
T	= 282.12'
L	= 548.48'
E	= 41.01'
BANK	= 5%

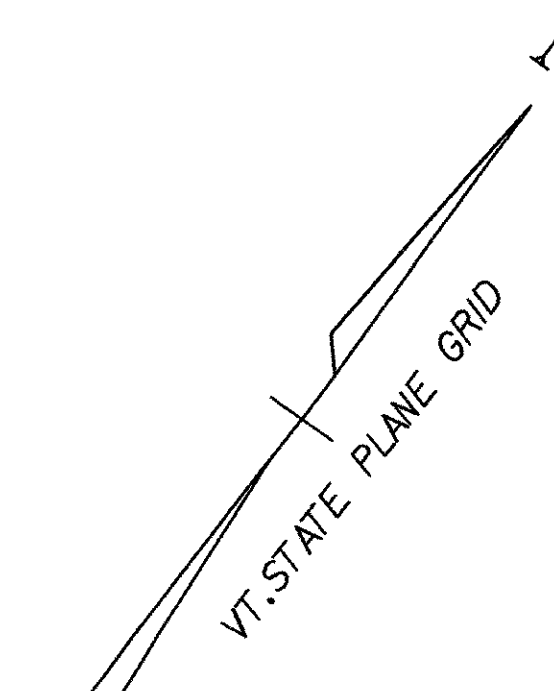

STA 13+60.00
BEGIN PROJECT BRO 1445 (30)
END APPROACH CONSTRUCTION

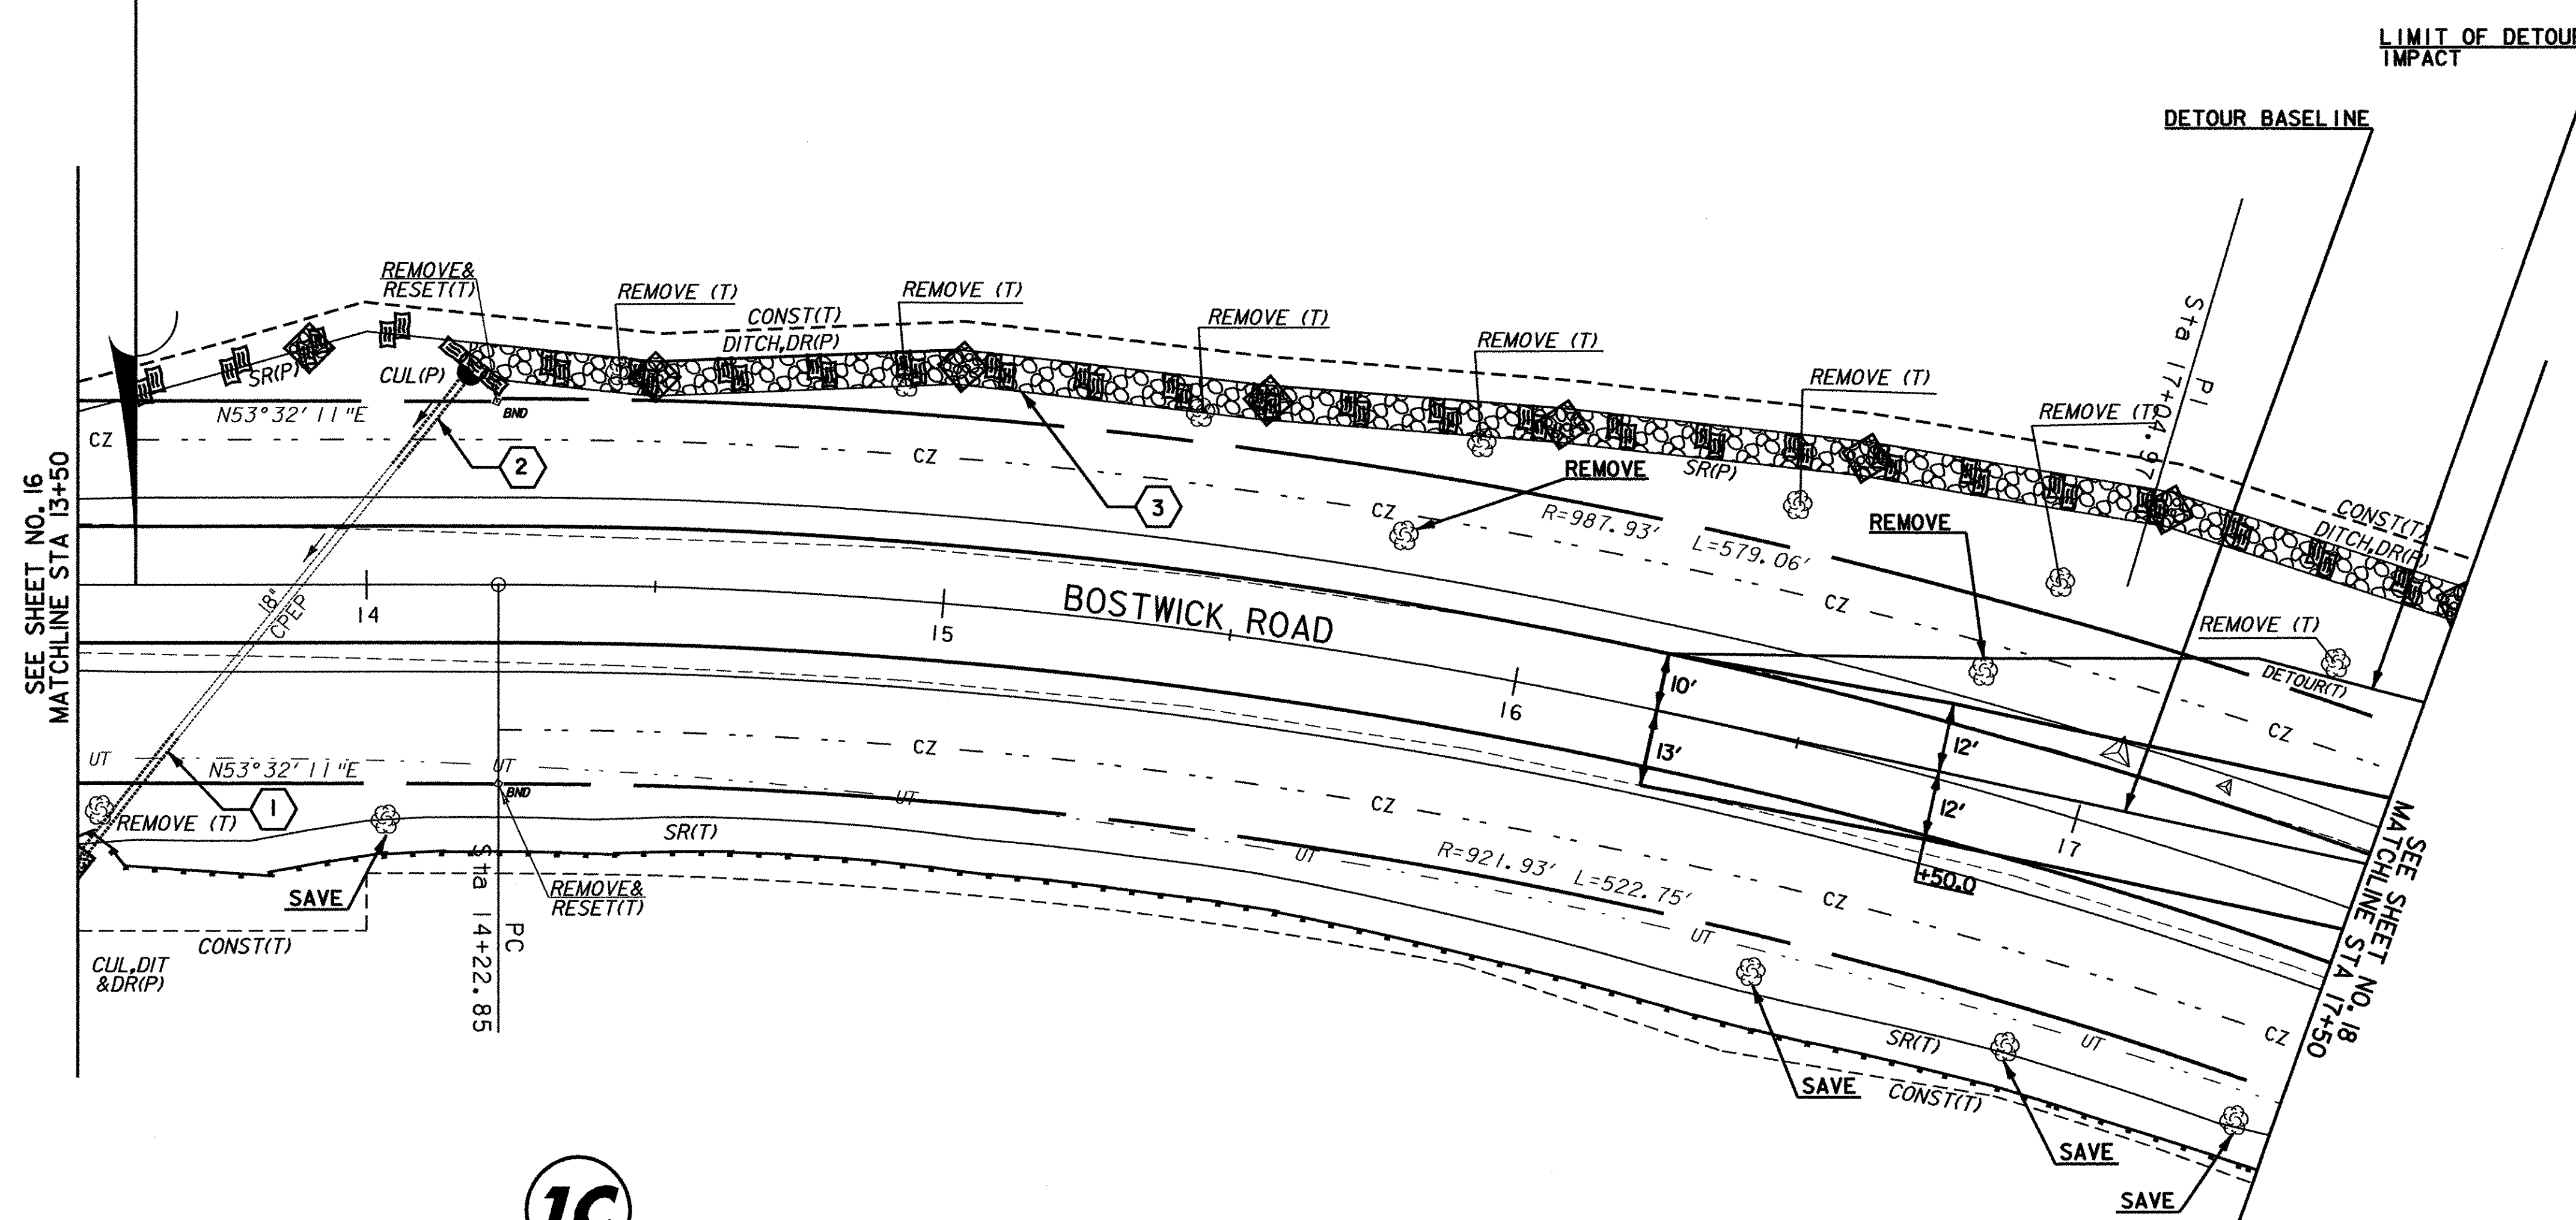

1C

**MEACH COVE REAL ESTATE TRUST;
ANATASIOS PARAFESTAS, TRUSTEE**

- ① STA 13+51.3, RT 46.0 TO STA 13+66.9, RT 26.1
CONSTRUCT 18' x 27' CPEP EXTENSION
CONSTRUCT STONE PAD AT OUTLET
(SEE STONE FILL DETAIL SHEET)
- ② STA 14+05.0, LT 20.4 TO STA 14+22.0, LT 41.4
CONSTRUCT 18' x 24' CPEP EXTENSION
- ③ STA 13+75, LT TO STA 19+25, LT
CONSTRUCT 550' TOE OF SLOPE STONE DITCH
(SEE CROSS SECTIONS AND DRAINAGE DETAIL SHEET)


- STONE DITCH (PERMANENT)
- WETLANDS
- EROSION MATTING (TEMPORARY)
- HAYBALES (TEMPORARY)
- STONE CHECK DAM (TEMPORARY)

LINES SHOWN ON THIS PLAN AS EXISTING
PROPERTY LINES P/L ARE BELIEVED TO
BE ACCURATE BUT SHOULD NOT BE RELIED
UPON FOR PURPOSES UNRELATED TO THE
TOWN OF SHELBURNE'S ACQUISITION OF LAND
AND RIGHTS FOR THIS PROJECT.

**FOR R.O.W.
USE ONLY**

DATUM
VERTICAL NAVD 88
HORIZONTAL NAD 83 (1996)

LAYOUT SHEET

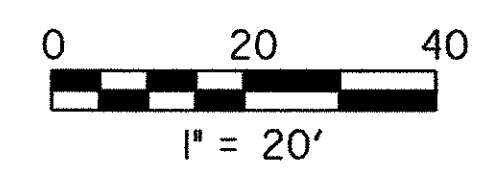

LAYOUT SHEET	PROJECT NAME: SHELBURNE
	PROJECT NUMBER: BRO 1445(30)
	FILE NAME: \\vaot_cadd\flingcabinet\94\96\RightOfWay\layout2.dgn
	PROJECT LEADER: MBZ PLOT DATE: 06-AUG-2003
DESIGNED BY: DMB DRAWN BY: MJF	
R.O.W. SHEET 17 OF 19	SHEET 8 OF 73

GEOTEXTILE FOR SILT FENCE	
3+90, LT - 3+90, RT	
5+20, RT - 6+00, LT	

GEOTEXTILE FOR SILT FENCE	
17+50, RT - 20+37, RT	
20+00, LT - 20+37, LT	
20+67, RT - 21+00, RT	
20+67, LT - 21+40, LT	

EROSION MATTING	
21+80, LT - 33+50, LT	


BOSTWICK FARM ROAD DRIVE CURVE DATA	
CURVE #1	
PI = 40+61.44	
Δ = 20°46'20.0"RT	
R = 200.00'	
T = 36.66'	
L = 72.51'	
E = 3.33'	
BANK = N.C.	

STATE OF VERMONT; LESSOR
MEACH COVE REAL ESTATE TRUST; ANASTASIOS PARAFESTAS, TRUSTEE

STATE OF VERMONT; LESSOR
VERMONT RAILWAY, INC.; LESSEE

STATE OF VERMONT; LESSOR
MEACH COVE REAL ESTATE TRUST; ANASTASIOS PARAFESTAS, TRUSTEE

N
 VT. STATE PLANE GRID

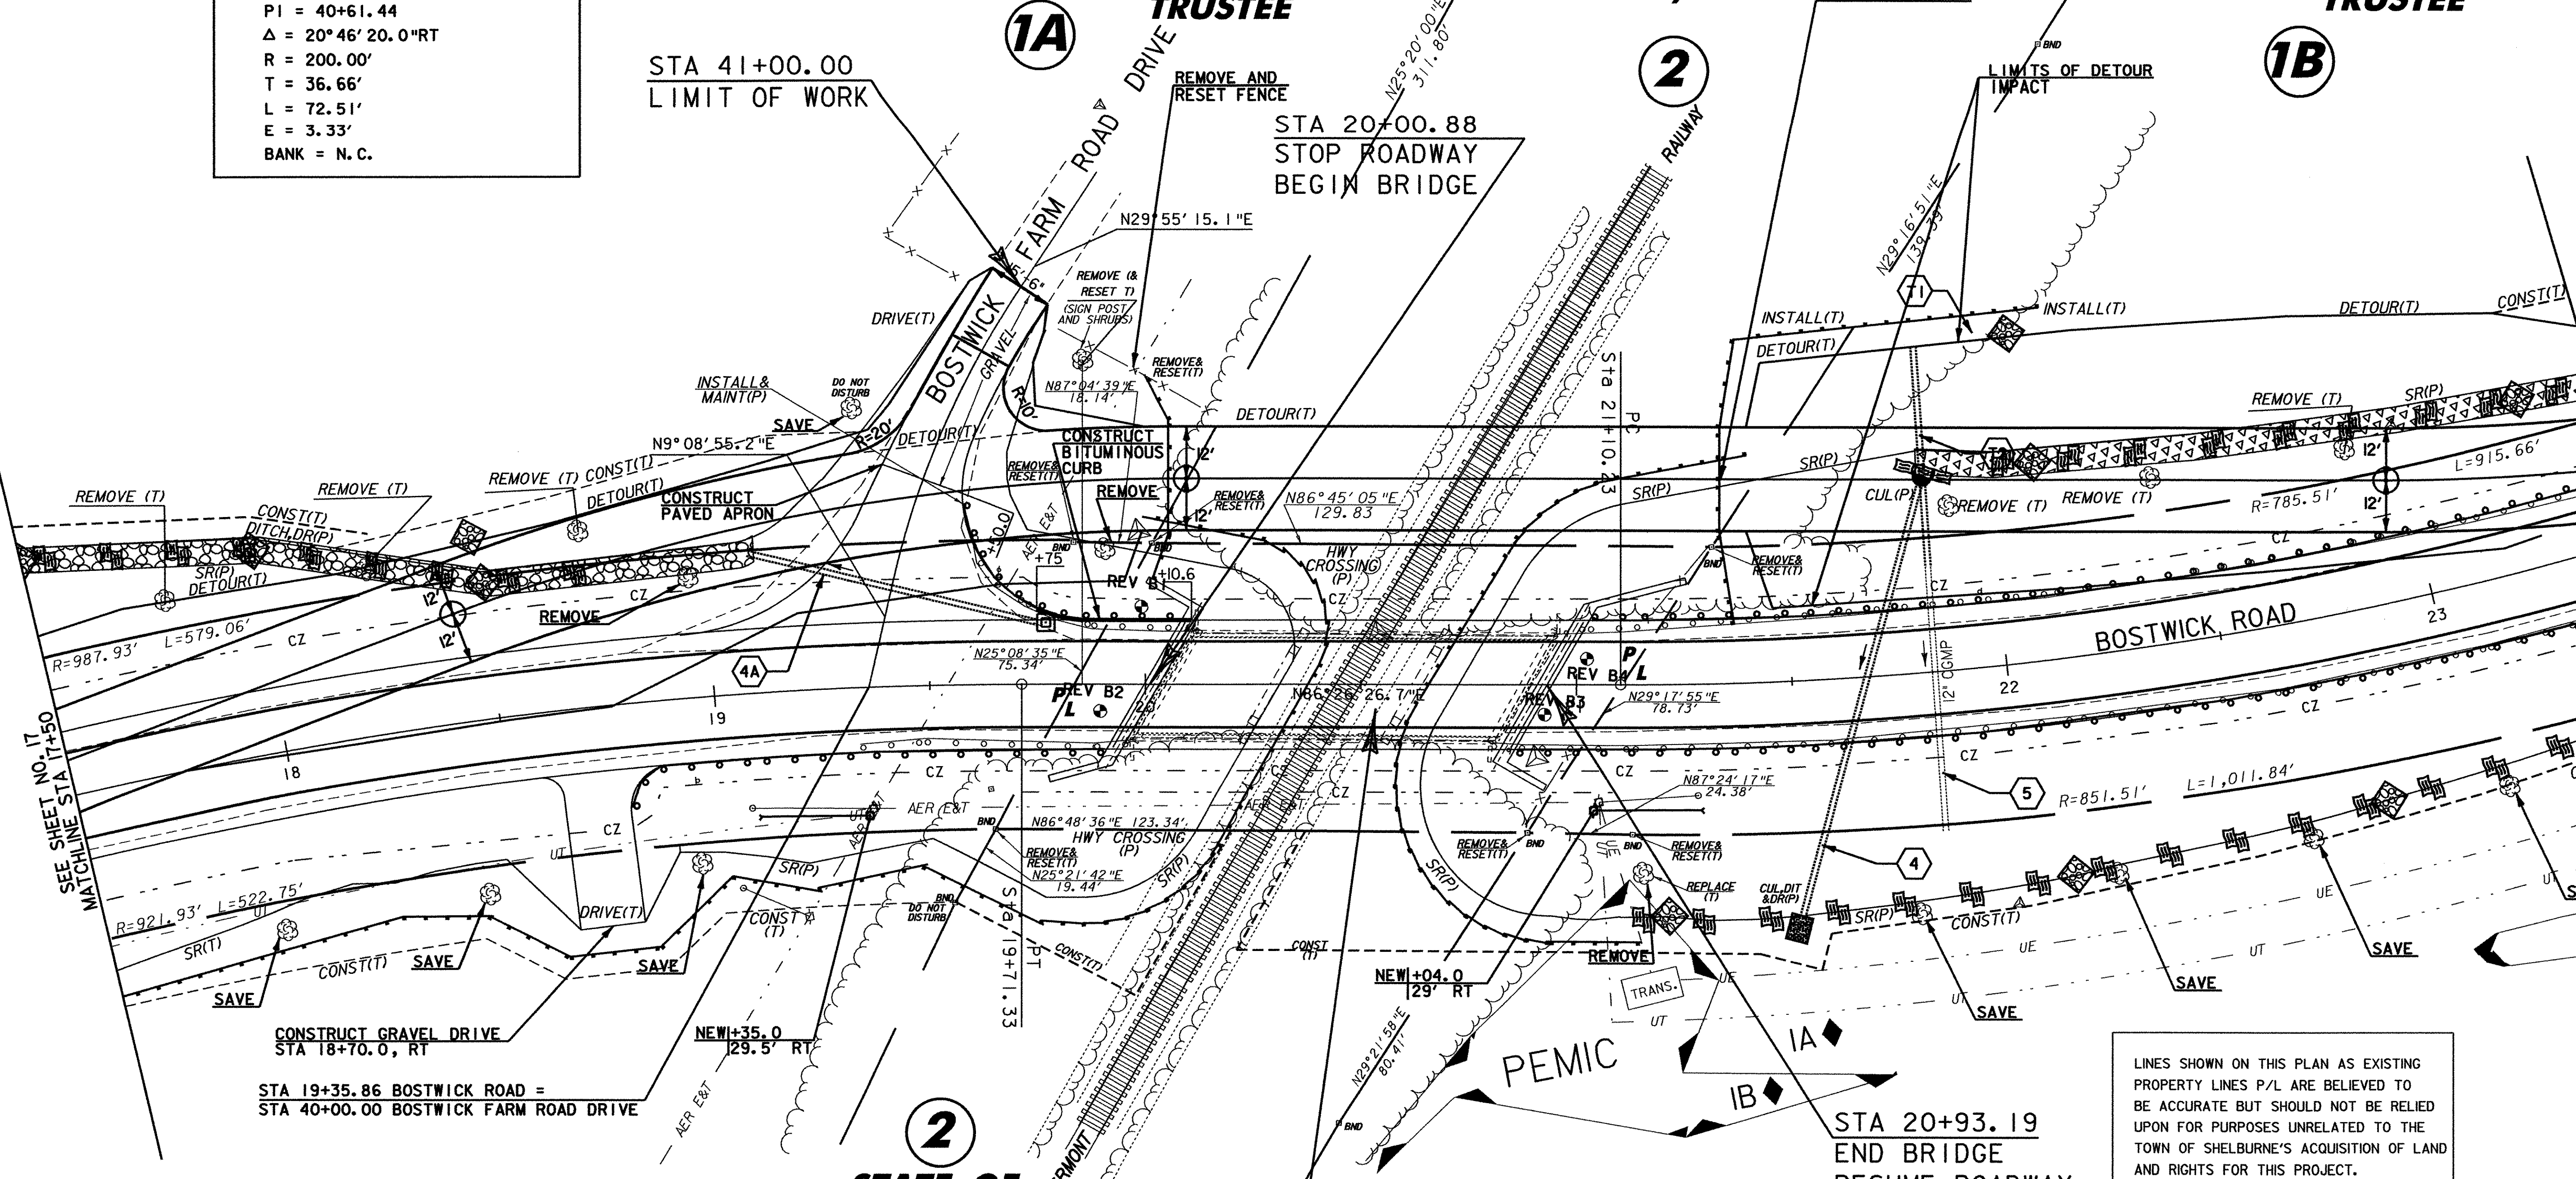


LINES SHOWN ON THIS PLAN AS EXISTING PROPERTY LINES P/L ARE BELIEVED TO BE ACCURATE BUT SHOULD NOT BE RELIED UPON FOR PURPOSES UNRELATED TO THE TOWN OF SHELBURNE'S ACQUISITION OF LAND AND RIGHTS FOR THIS PROJECT.

1C
MEACH COVE REAL ESTATE TRUST; ANASTASIOS PARAFESTAS, TRUSTEE

STATE OF VERMONT; LESSOR
VERMONT RAILWAY, INC.; LESSEE

3
FOR R.O.W. USE ONLY
WAKE ROBIN CORPORATION

	STONE DITCH (PERMANENT)
	WETLANDS
	EROSION MATTING (TEMPORARY)
	HAYBALES (TEMPORARY)
	STONE CHECK DAM (TEMPORARY)

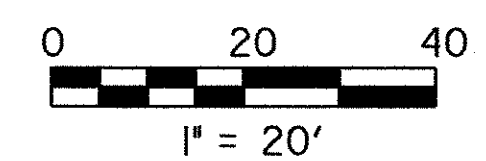

DATUM	
VERTICAL	NAVD 88
HORIZONTAL	NAD 83 (1996)

LAYOUT SHEET	PROJECT NAME:	SHELBURNE	
	PROJECT NUMBER:	BRO 1445(30)	
	FILE NAME:	\\vaot_cadd\flingcabinet\94j96\RightOfWay\layout3.dgn	
	PROJECT LEADER:	MBZ	
DESIGNED BY:	DMB	DRAWN BY:	MJF
CHECKED BY:	R.O.W. SHEET 18 OF 19		SHEET 9 OF 73

EROSION MATTING	
23+50, LT - 25+00, LT	



BOSTWICK ROAD CURVE DATA	
CURVE #2	
PI = 26+63.21	
Δ = 67°20'45.7"LT	
R = 830.00'	
T = 552.98'	
L = 975.59'	
E = 167.34'	
BANK = 5.30%	

STA 26+75.00
END PROJECT BRO 1445 (30)
BEGIN APPROACH CONSTRUCTION

STA 28+25.00
END APPROACH CONSTRUCTION
MATCH EXISTING PAVEMENT

1B MEACH COVE
REAL ESTATE TRUST;
ANASTASIOS PARAFESTAS,
TRUSTEE

END R.O.W. PROJECT
STA. 26+73.2 28.5'LT.

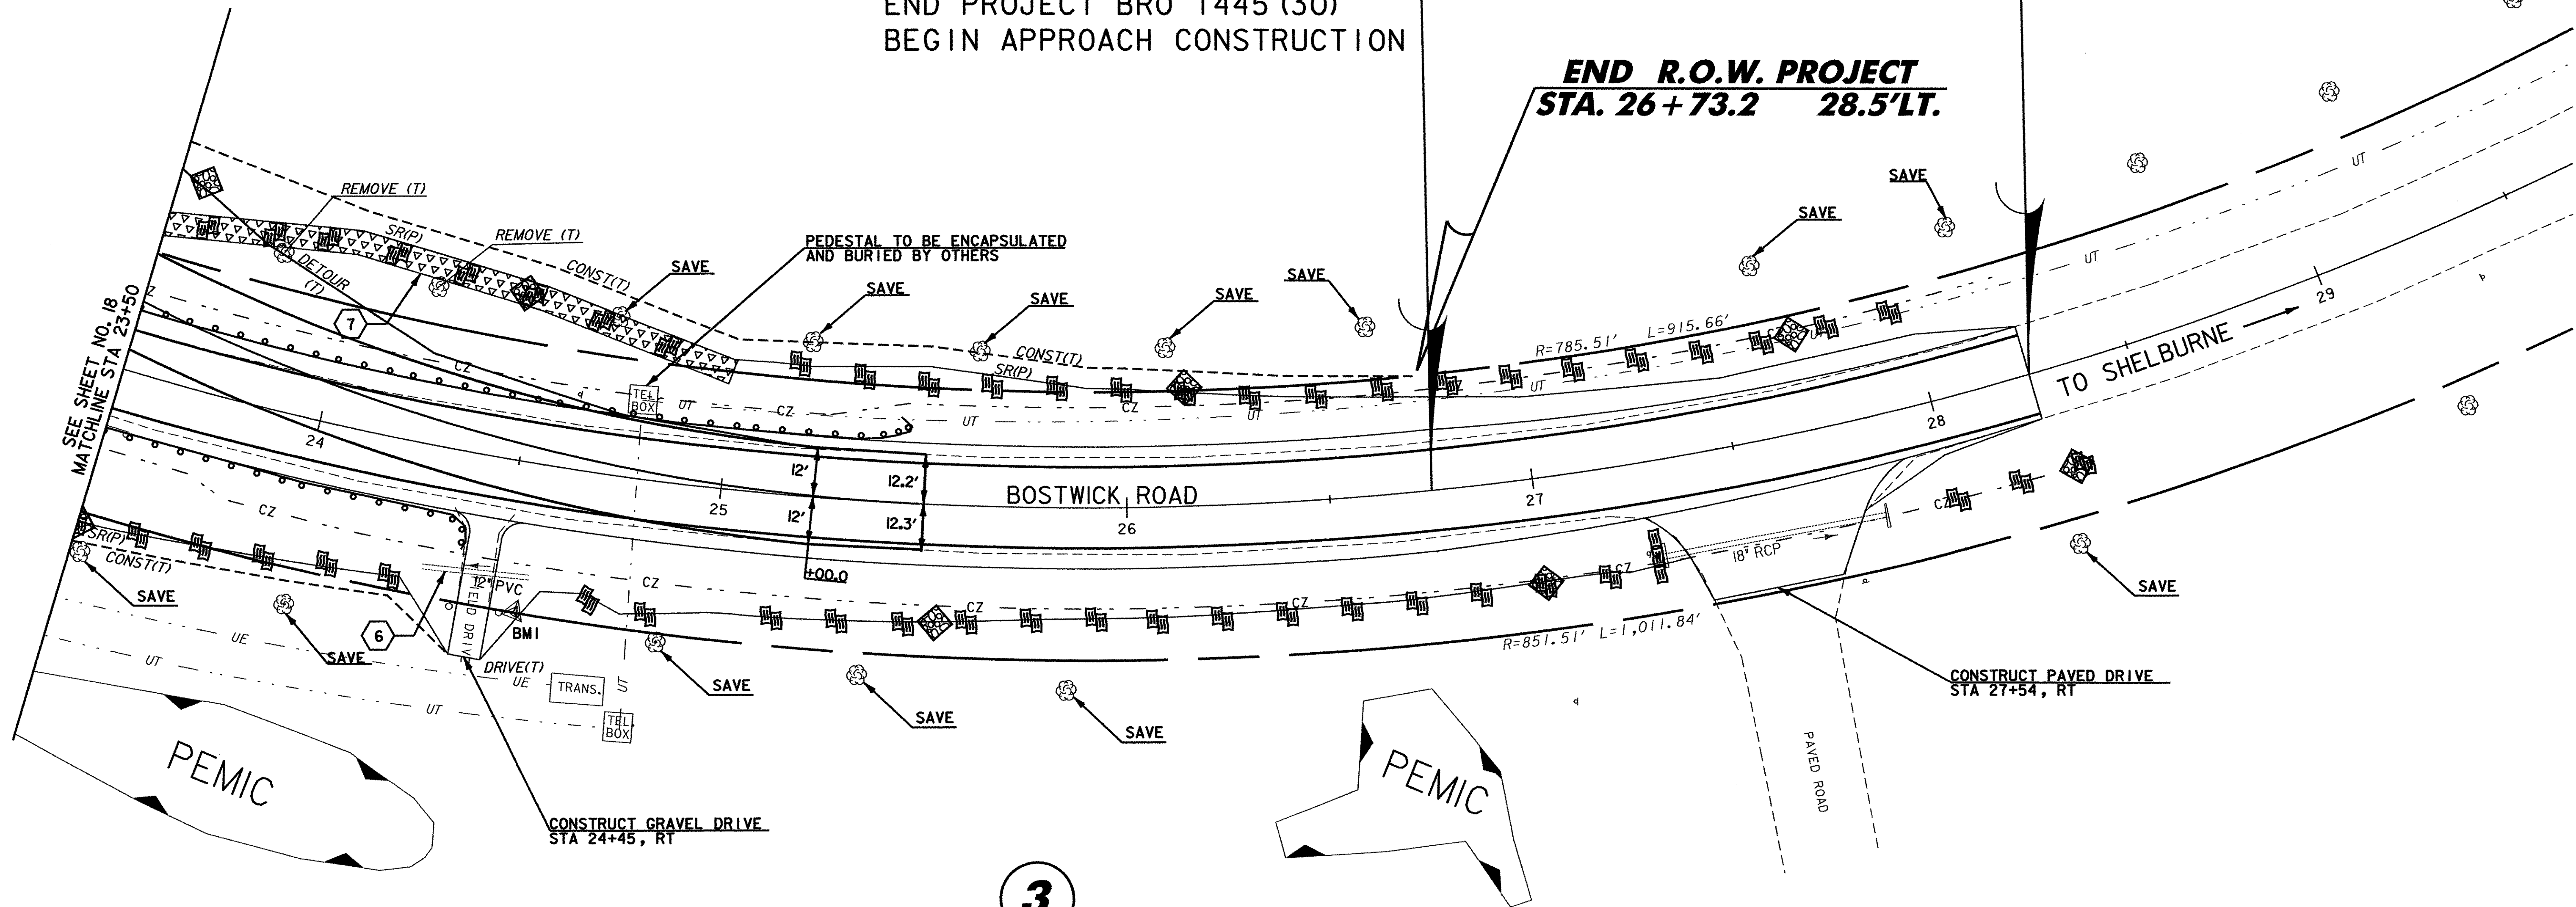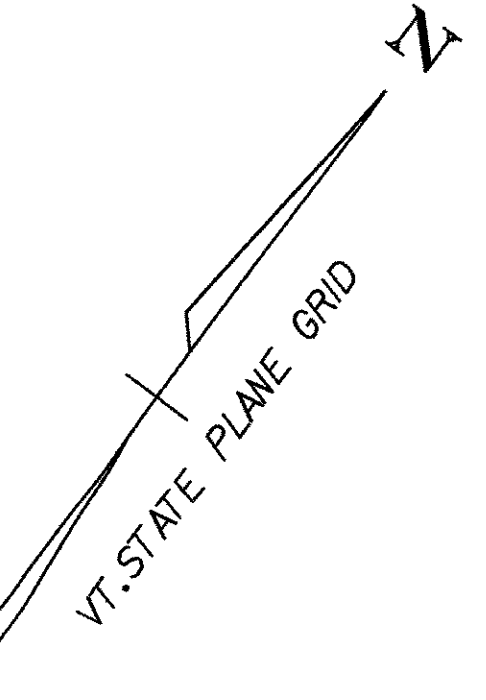

3
WAKE ROBIN CORPORATION

BMI, STA 24+54.6, RT, 37.0'
STEEL REBAR SET IN GROUND
ELEVATION=236.89


- 6 STA 24+31, RT 29.2 TO STA 24+57, RT 28.7
REMOVE EXISTING 12" PVC
- 7 STA 21+80, LT TO STA 25+00, LT
CONSTRUCT 320' TOE OF SLOPE DITCH
(SEE CROSS SECTIONS AND DRAINAGE DETAIL SHEET)

LINES SHOWN ON THIS PLAN AS EXISTING
PROPERTY LINES P/L ARE BELIEVED TO
BE ACCURATE BUT SHOULD NOT BE RELIED
UPON FOR PURPOSES UNRELATED TO THE
TOWN OF SHELBURNE'S ACQUISITION OF LAND
AND RIGHTS FOR THIS PROJECT.

**FOR R.O.W.
USE ONLY**

DATUM	
VERTICAL	NAVD 88
HORIZONTAL	NAD 83 (1996)

- STONE DITCH (PERMANENT)
- WETLANDS
- EROSION MATTING (TEMPORARY)
- HAYBALES (TEMPORARY)
- STONE CHECK DAM (TEMPORARY)

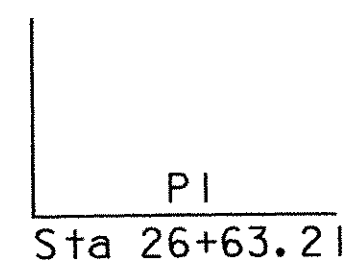

LAYOUT SHEET

PROJECT NAME:	SHELBURNE
PROJECT NUMBER:	BRO 1445(30)
FILE NAME:	\\vaot_cadd\fillngcabin\94196\RightOfWay\layout4.dgn
PROJECT LEADER:	DMB
DESIGNED BY:	DMB
PLOT DATE:	06-AUG-2003
DRAWN BY:	MJF
R.O.W. SHEET	19 OF 19
SHEET	10 OF 73

GPS CONTROL POINTS

F 65

STANDARD DISC STAMPED

F 65

** N = 80139.1286



E = 48455.5447

ELEV. = 266.361


GENERAL LOCATION, SHELBURNE, VT. OWNERSHIP, COUNTRYSIDE MOTEL, SHELBURNE, VT. TO REACH FROM THE METHODIST CHURCH IN SHELBURNE VILLAGE GO SOUTH ALONG U.S. ROUTE 7 FOR 1.0 MI (1.6 KM) TO THE MARK ON THE LEFT IN THE LAWN AT THE COUNTRYSIDE MOTEL. TO REACH FROM THE JUNCTION OF VT ROUTE 22A AND U.S. ROUTE 7 IN VERGENNES GO NORTH ALONG U.S. ROUTE 7 FOR 13.1 MI (21.1 KM) TO THE MARK ON THE RIGHT. THE MARK IS 13.7 METERS (44.9 FT) NORTHEAST OF THE CENTERLINE OF U.S. ROUTE 7, 26.9 METERS (88.3 FT) SOUTH OF THE CENTERLINE OF A DRIVEWAY LEADING TO THE MOTEL, AND 13.5 METERS (44.3 FT) SOUTHWEST OF LIGHT POLE 01.

** TO ALLOW THE AGENCY DESIGN PLANE COORDINATES TO FIT THE STATE PLANE COORDINATES, ADD 600000 TO THE NORTHING & ADD 1400000 TO THE EASTINGS, TO THE ABOVE AND BELOW VALUES.
 * DESCRIPTION PROVIDED BY VERMONT AGENCY OF TRANSPORTATION GEODETIC SURVEY UNIT

TRAVERSE TIES



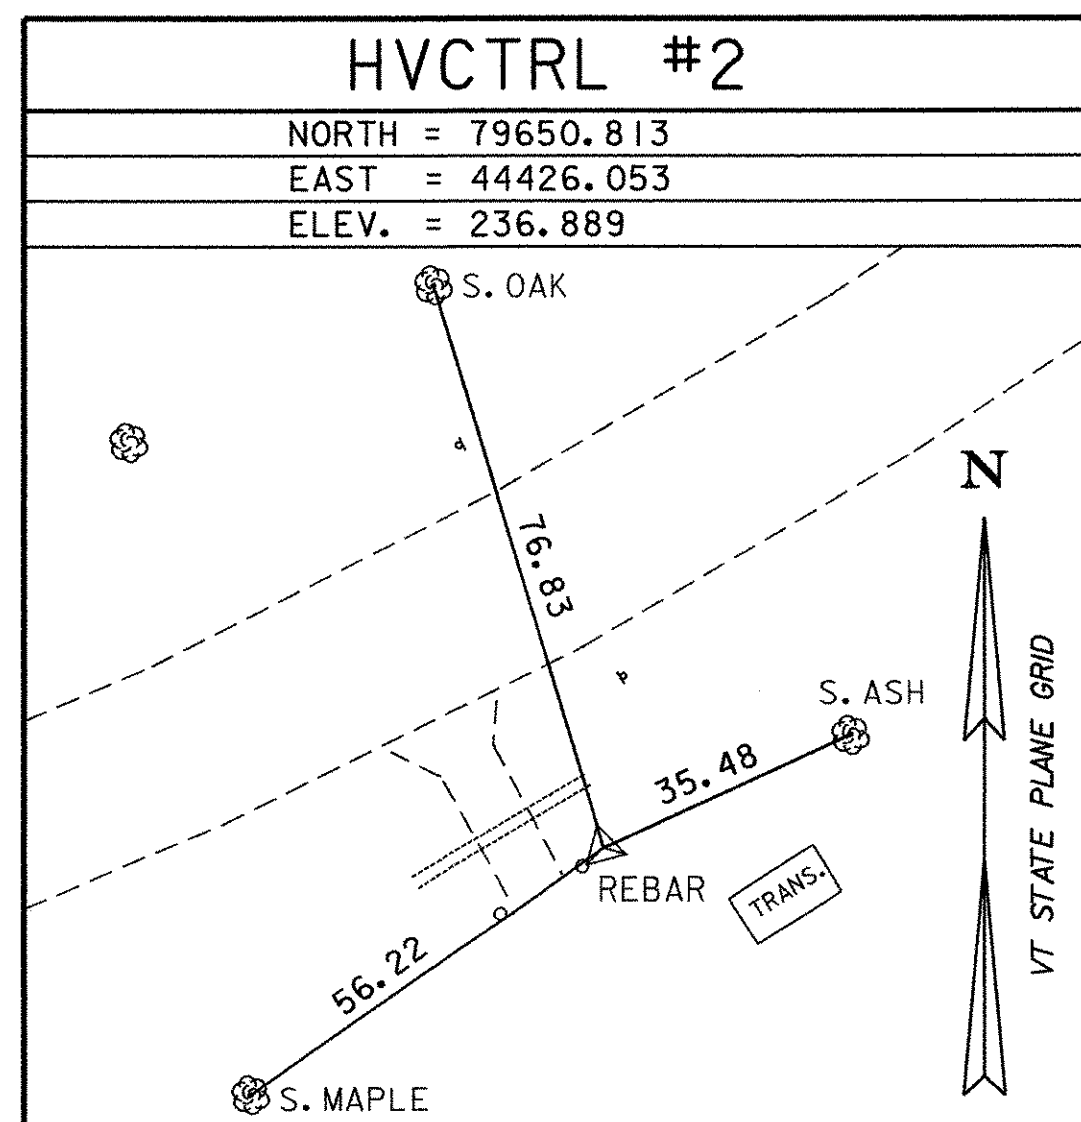
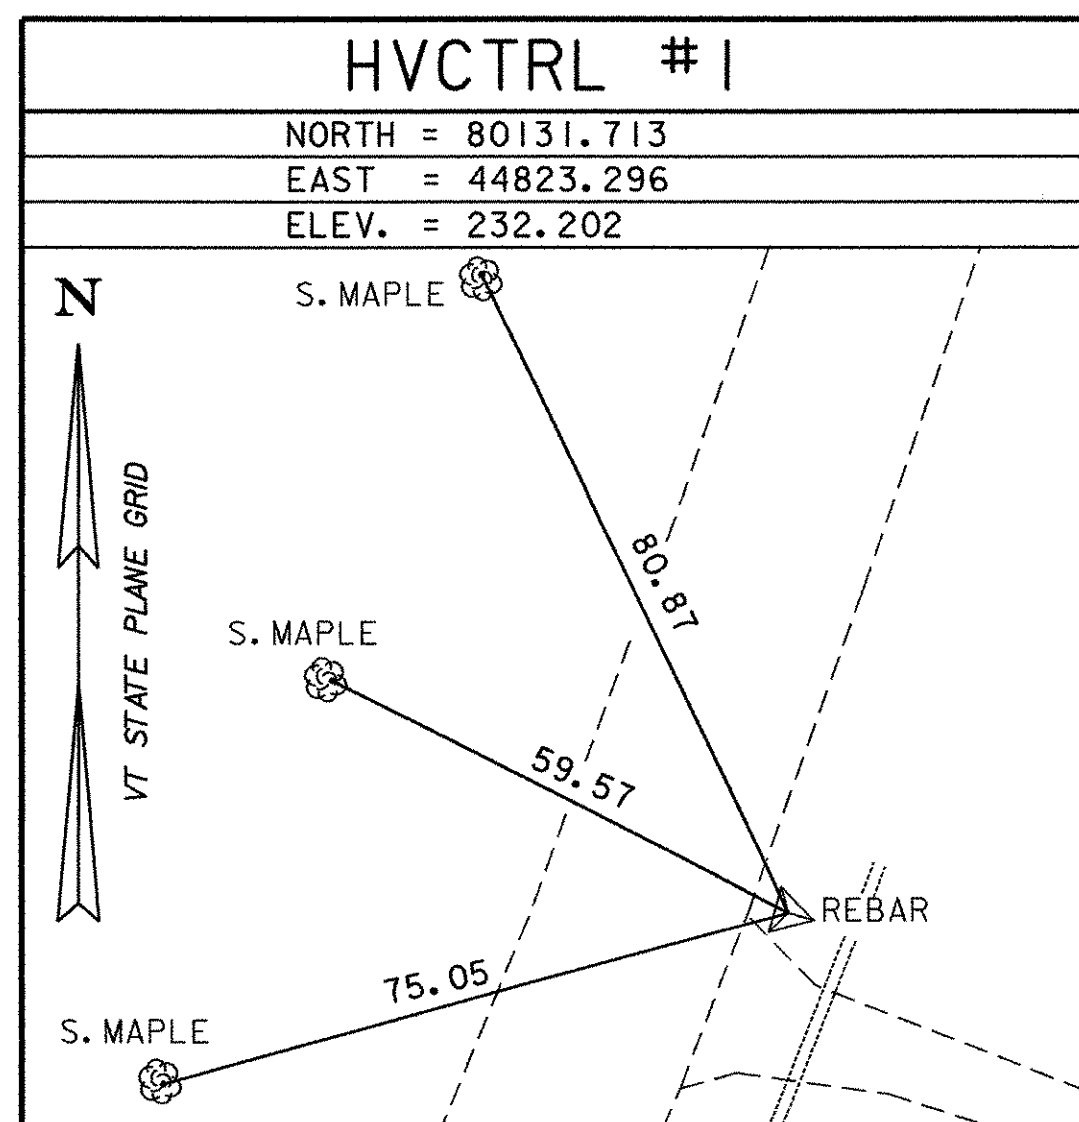


ALIGNMENT TIES

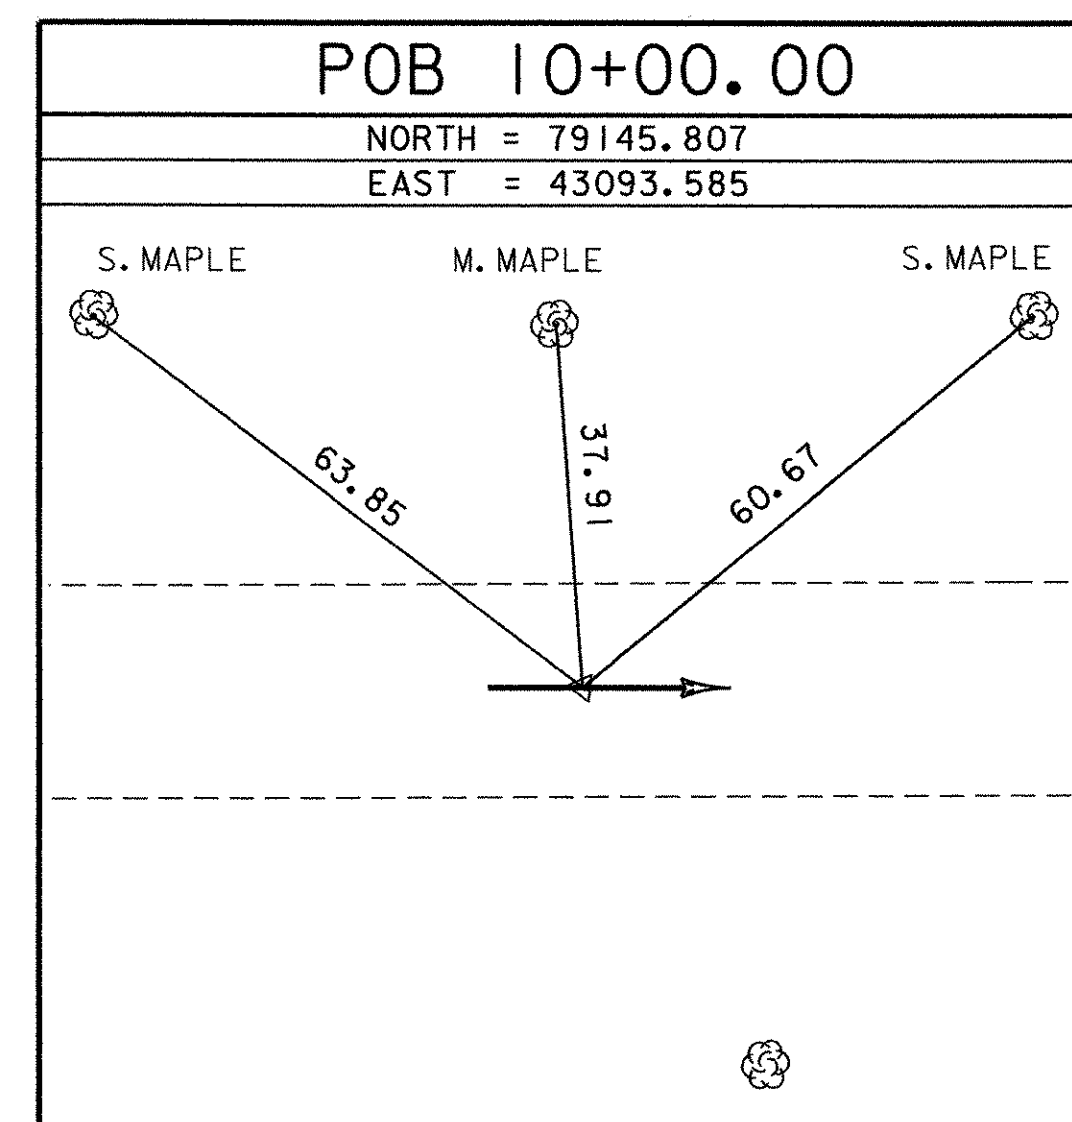

* MAIN TRAVERSE COMPLETED: JULY 1999 BY VS&E

ALIGNMENT TIES

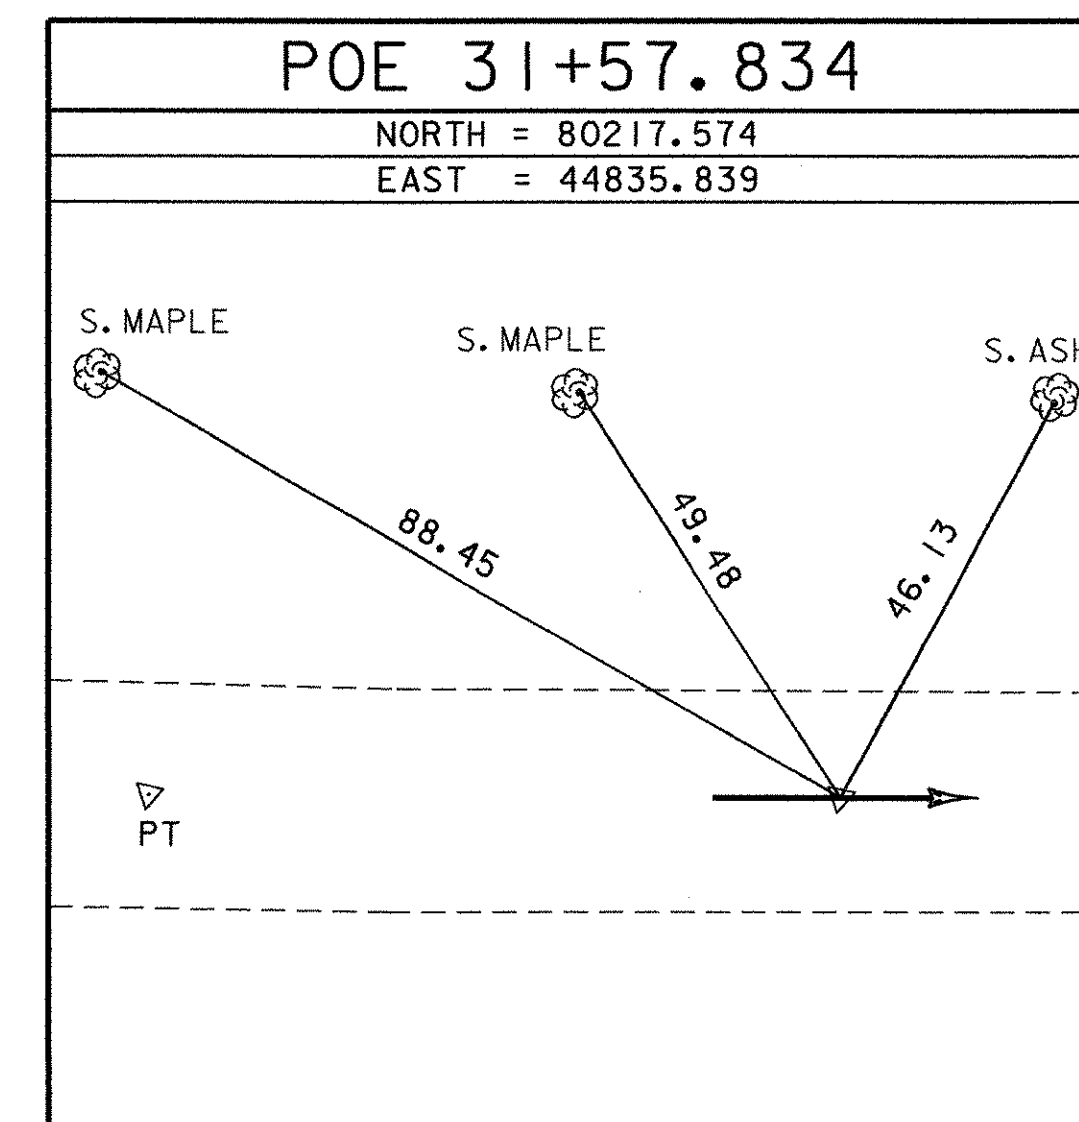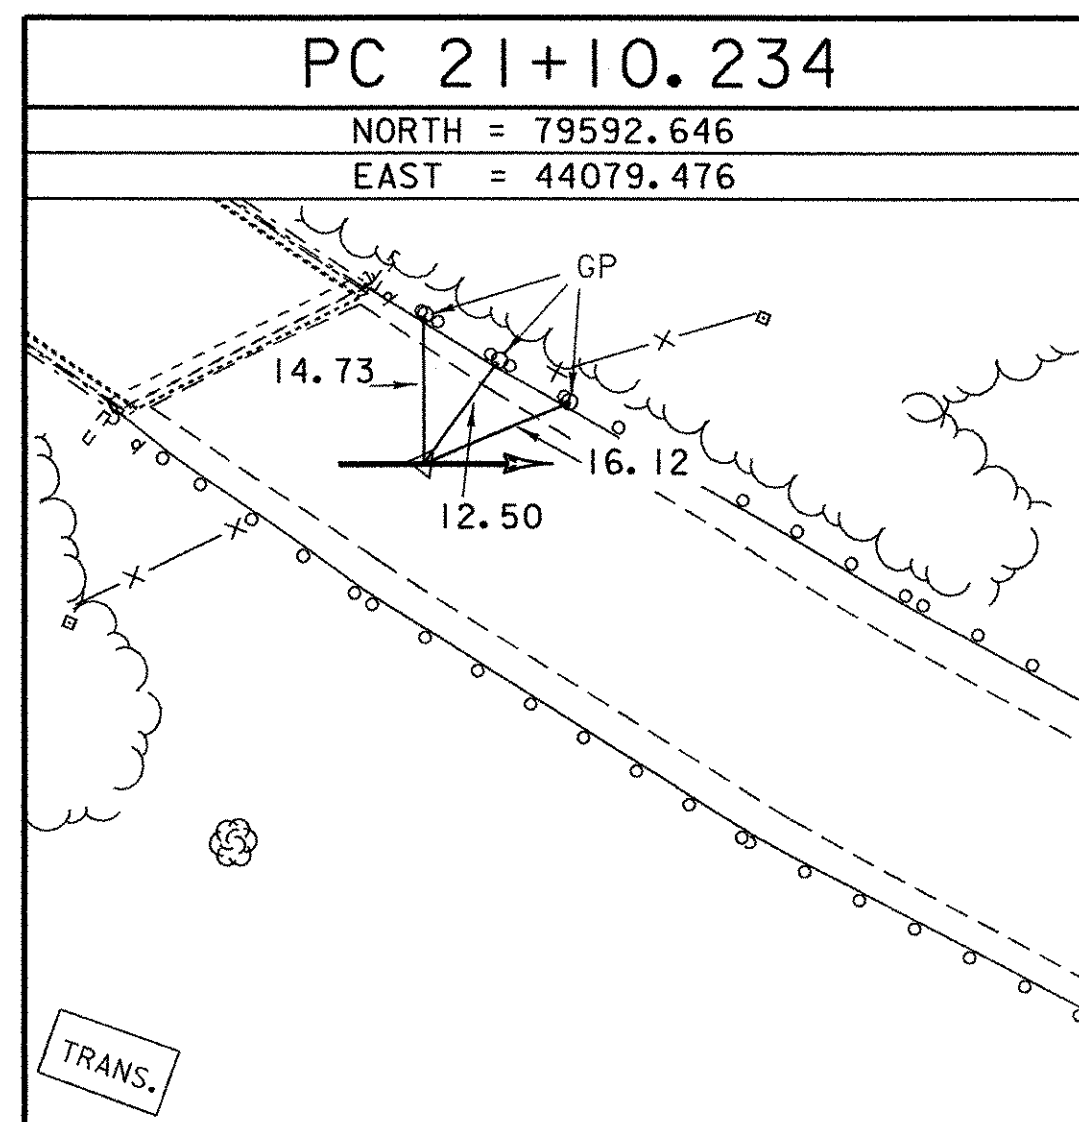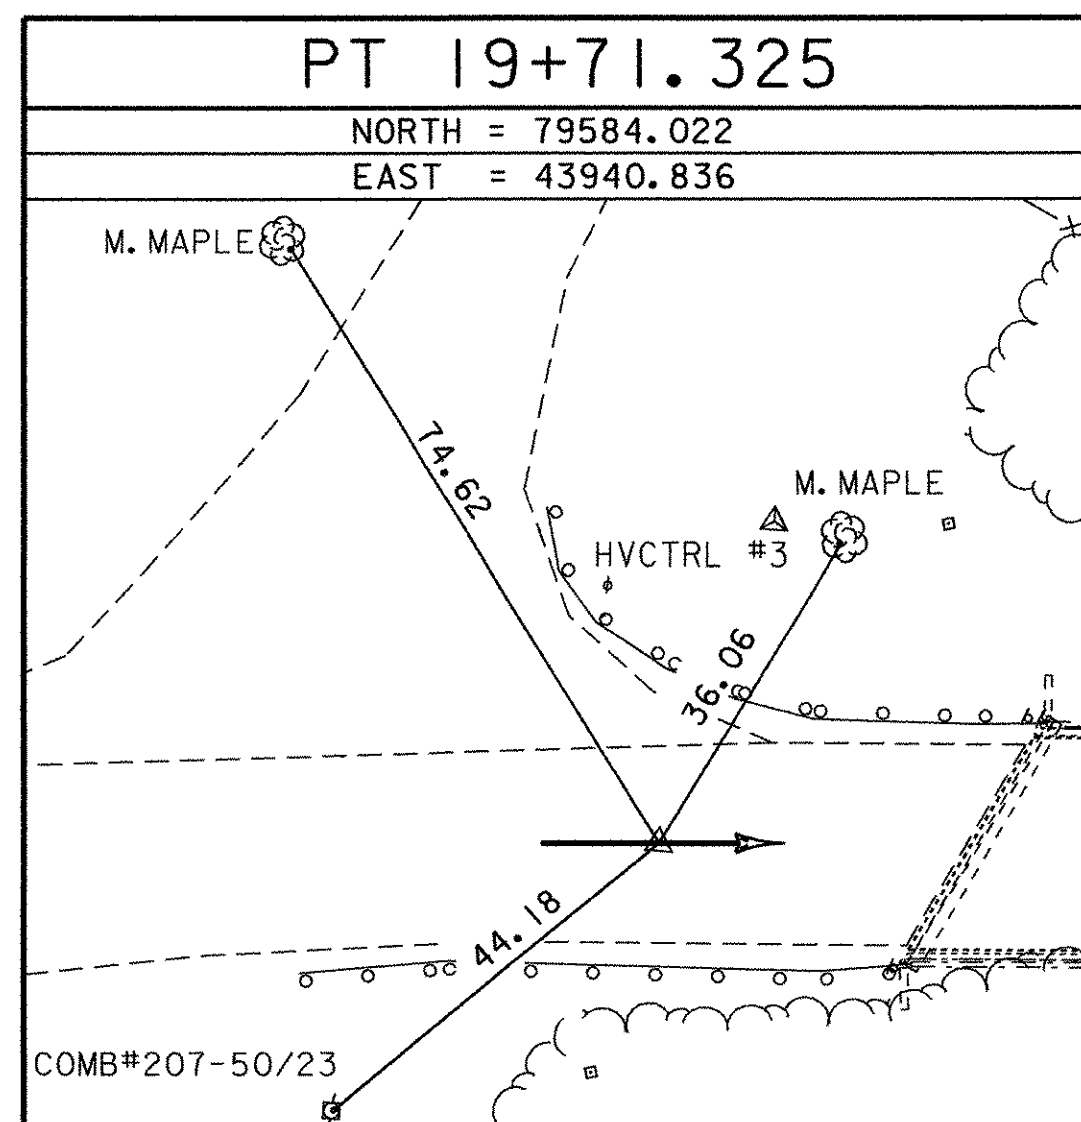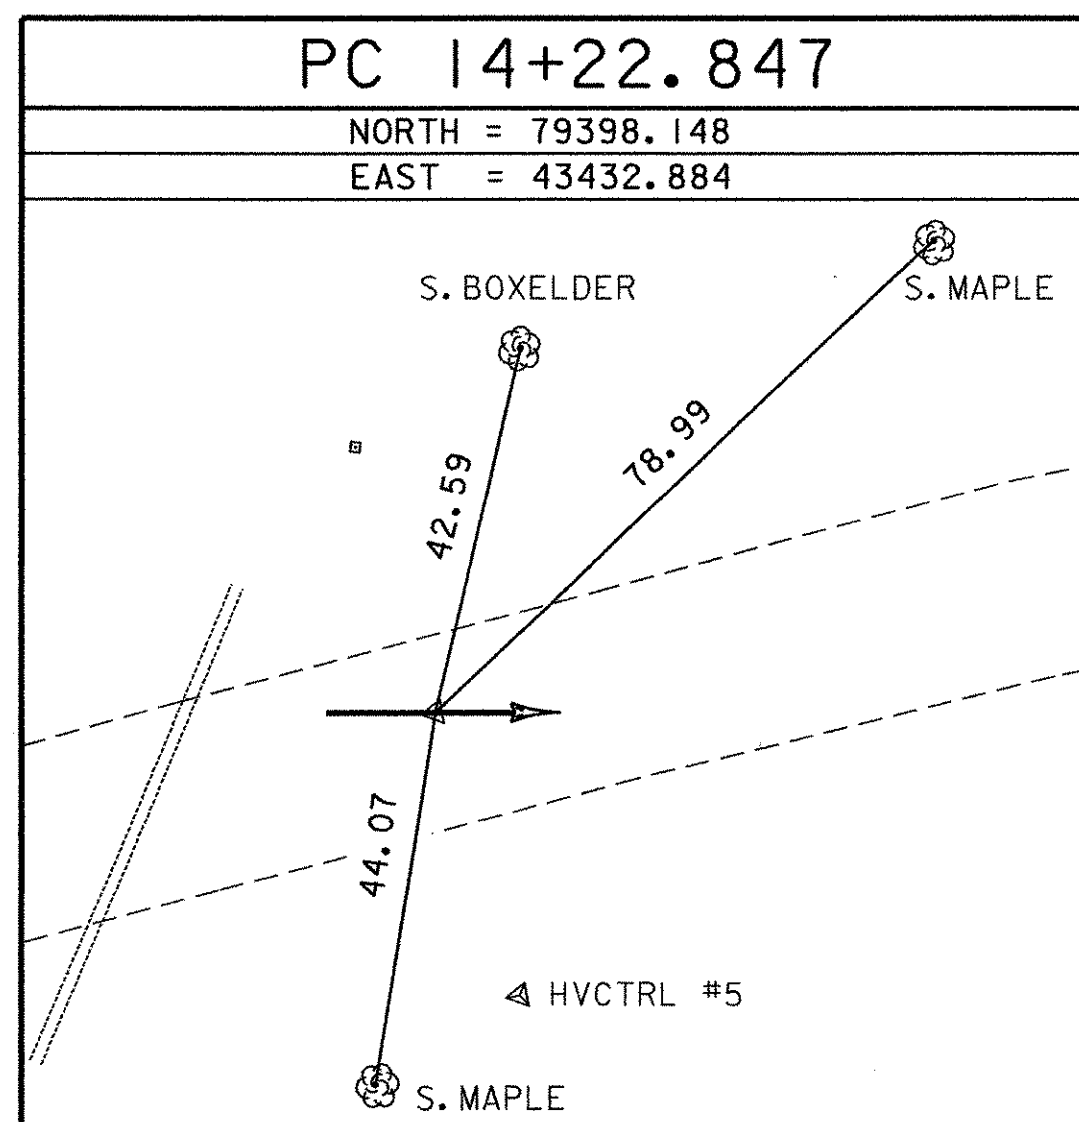

* ALIGNMENT STAKED: OCTOBER 30, 2002 BY: L. ORVIS PC & J. HULETT


DATUM	
VERTICAL	NAVD88
HORIZONTAL	NAD83 (96)
ADJUSTMENT	LEAST SQ.

TIE SHEET


PROJECT NAME: SHELBURNE
 PROJECT NUMBER: BRO 1445(30)



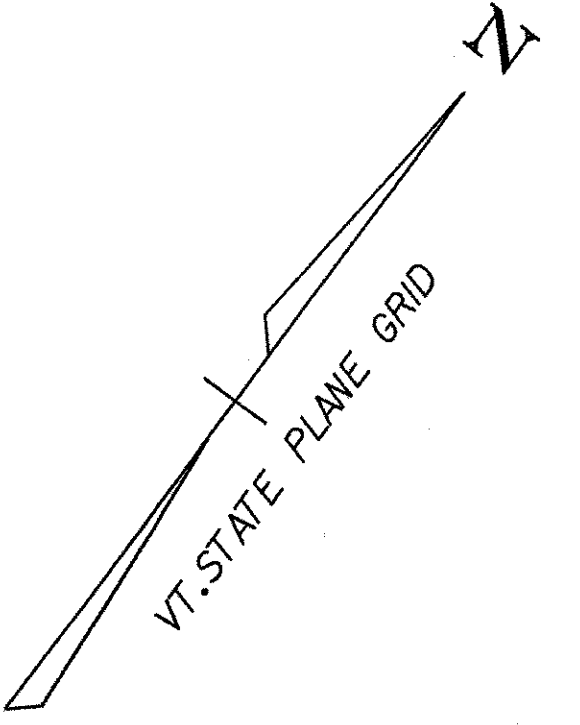


FILE NAME: 94J96/structures/sj96t1.dgn PLOT DATE: 04-AUG-2003
 PROJECT LEADER: MBZ DRAWN BY: J.HULETT
 DESIGNED BY: DMB CHECKED BY: P.HODGE
 TIE SHEET SHEET 11 OF 73


GEOTEXTILE FOR SILT FENCE
 12+00, RT - 13+50, RT

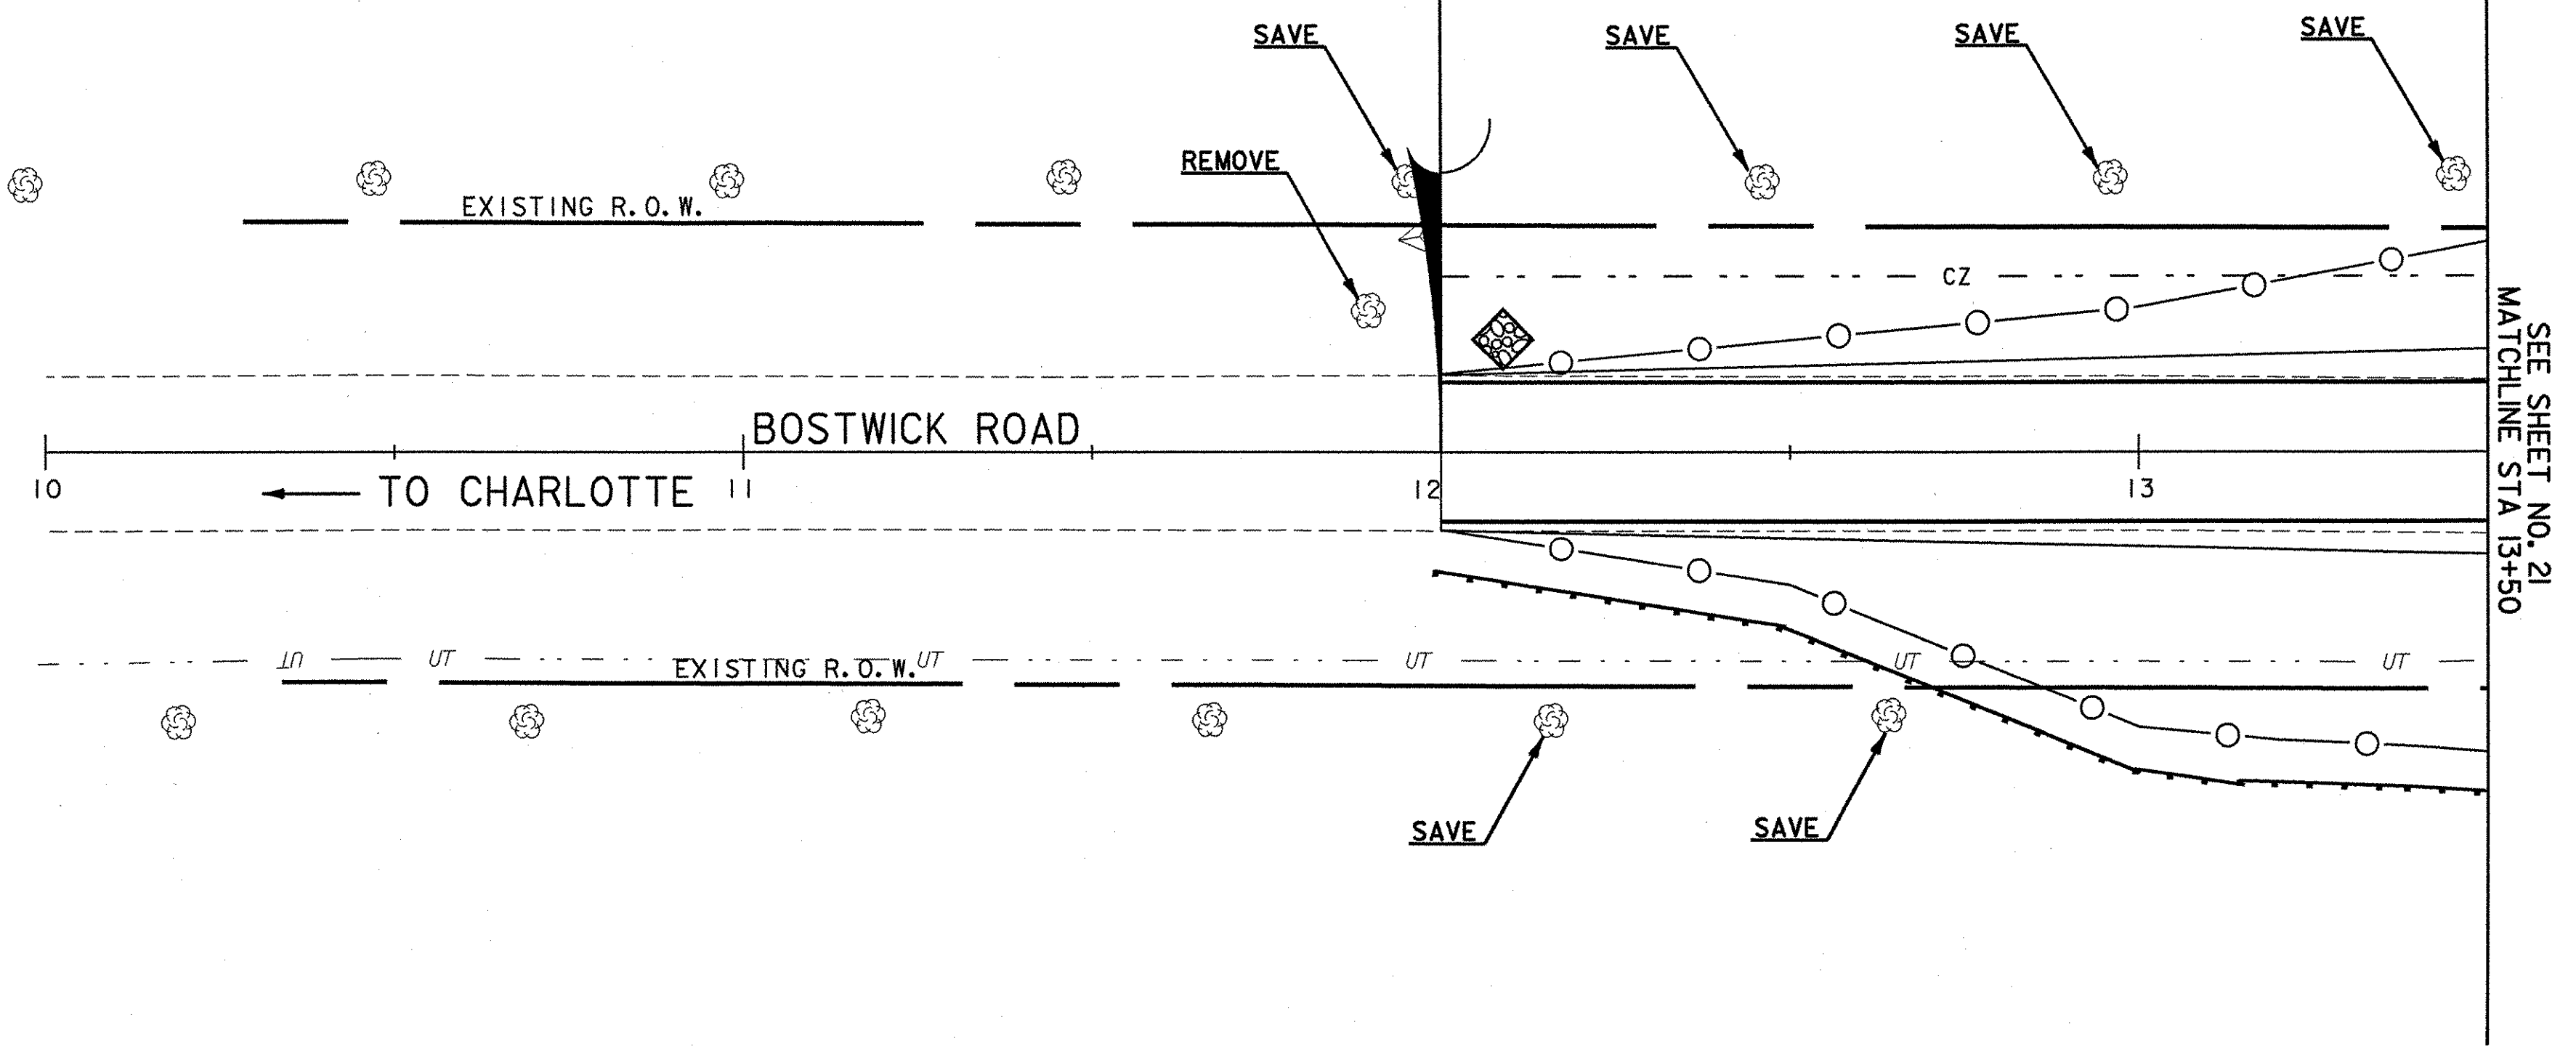

STA 12+00.00
 BEGIN APPROACH CONSTRUCTION
 MATCH EXISTING PAVEMENT



-  STONE DITCH
-  WETLANDS
-  EROSION MATTING
-  HAYBALES
-  STONE CHECK DAM

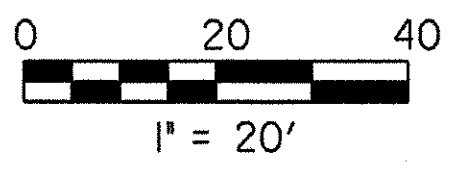


LAYOUT SHEET

PROJECT NAME:	SHELBURNE		
PROJECT NUMBER:	BRO 1445(30)		
FILE NAME:	M:\595402 Bostwick\HWY\DRAW\GENPLN\gen001.dgn		
PROJECT LEADER:	MBZ	PLOT DATE:	01-AUG-2003
DESIGNED BY:	DMB	DRAWN BY:	MJF
CHECKED BY:	MDL	SHEET	20 OF 73


DATUM
 VERTICAL NAVD 88
 HORIZONTAL NAD 83 (1996)

GEOTEXTILE FOR SILT FENCE
13+50, RT - 17+50, RT

BOSTWICK ROAD CURVE DATA CURVE #1	
P1 =	17+04.97
Δ =	33°04'46.1"LT
R =	950.00'
T =	282.12'
L =	548.48'
E =	41.01'
BANK =	5%

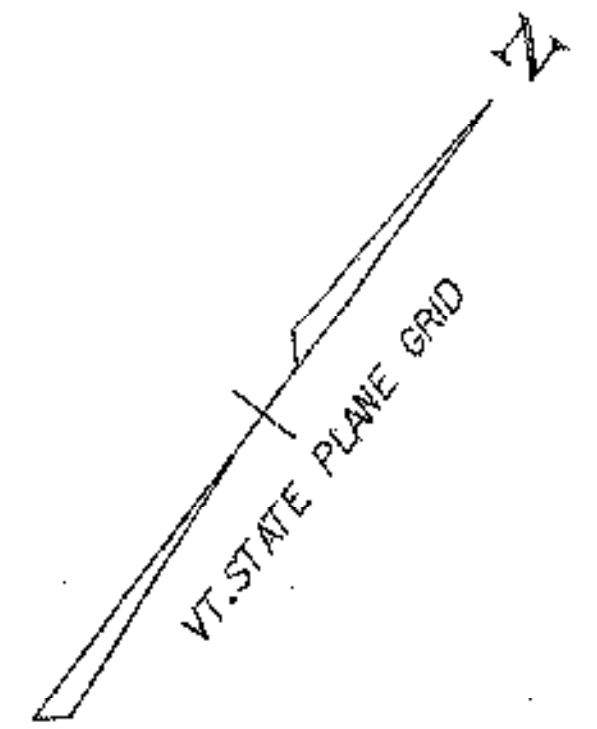


STA 13+60.00
BEGIN PROJECT BRO 1445 (30)
END APPROACH CONSTRUCTION

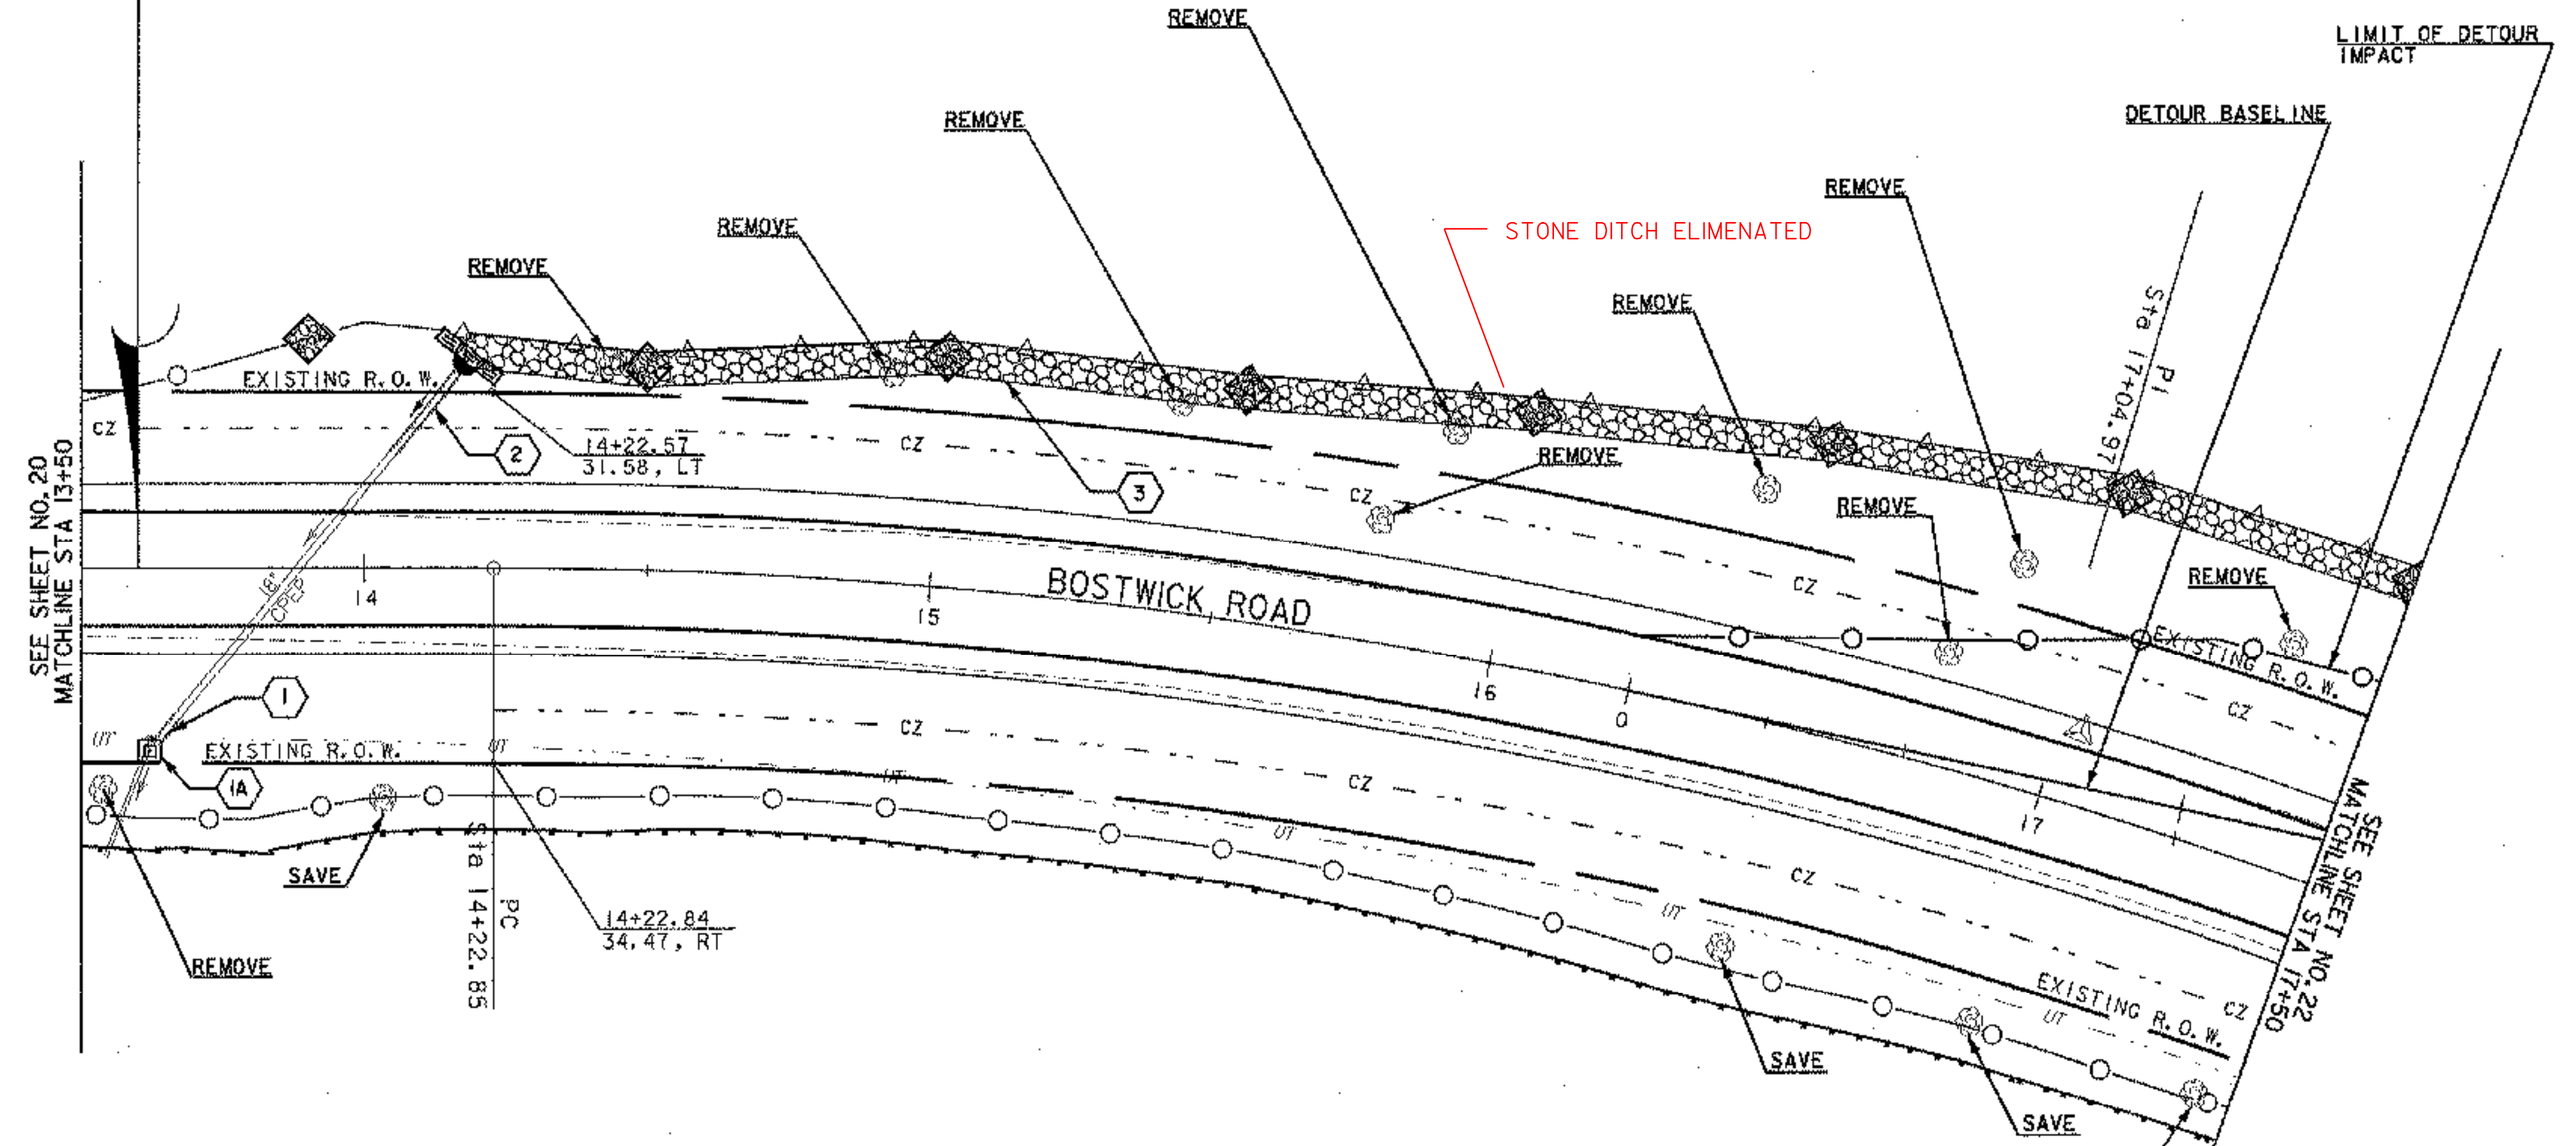

- ① STA 13+63.2, RT 30.8' TO STA 13+66.9, RT 26.1
CONSTRUCT 18" x 6' CPEP EXTENSION
- ①A STA 13+62.4, RT 32.2'
CONSTRUCT DI-A
REMOVE DISTANCE 13+62.4, RT 30.0' (INCIDENTAL)
CONNECT TO EXISTING PIPE
VERIFY INVERT IN FIELD
- ② STA 14+05.0, LT 20.4 TO STA 14+22.0, LT 4.4
CONSTRUCT 18" x 24' CPEP EXTENSION
- ③ STA 14+20, LT TO STA 19+10, LT
CONSTRUCT 490' TOE OF SLOPE STONE DITCH
(SEE CROSS SECTIONS AND DRAINAGE DETAIL SHEET)
STONE DITCH ELIMENATED

- STONE DITCH
- WETLANDS
- EROSION MATTING
- HAYBALES
- STONE CHECK DAM

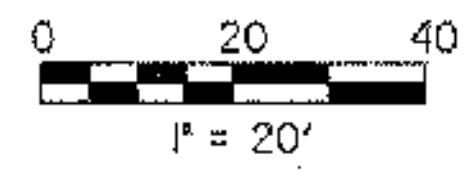

DATUM	
VERTICAL	NAVD 88
HORIZONTAL	NAD 83 (1996)

LAYOUT SHEET	PROJECT NAME:	SHELBURNE		
	PROJECT NUMBER:	BRO 1445(30)		
	FILE NAME:	M:\1595402 Bostwick\HWY\DRAW\GENPLN\gen002.dgn		
	PROJECT LEADER:	MBZ	PLOT DATE:	04-AUG-2003
	DESIGNED BY:	DMB	DRAWN BY:	MJF
CHECKED BY:	MDL	SHEET	21 OF 73	

BOSTWICK FARM ROAD DRIVE CURVE DATA
CURVE #1

PI = 40+61.44
 $\Delta = 20^\circ 46' 20.0''$ RT
 R = 200.00'
 T = 36.66'
 L = 72.51'
 E = 3.33'
 BANK = N.C.

GEOTEXTILE FOR SILT FENCE



17+50, RT - 20+37, RT
 20+00, LT - 20+37, LT
 20+67, RT - 21+00, RT
 20+67, LT - 21+40, LT

EROSION MATTING

21+80, LT - 33+50, LT

SETTLEMENT PLATFORMS, TYPE 1

STATION	OFFSET	NO.
19+50	20' RT	(5)
21+50	20' LT	(5)
21+50	20' RT	(5)

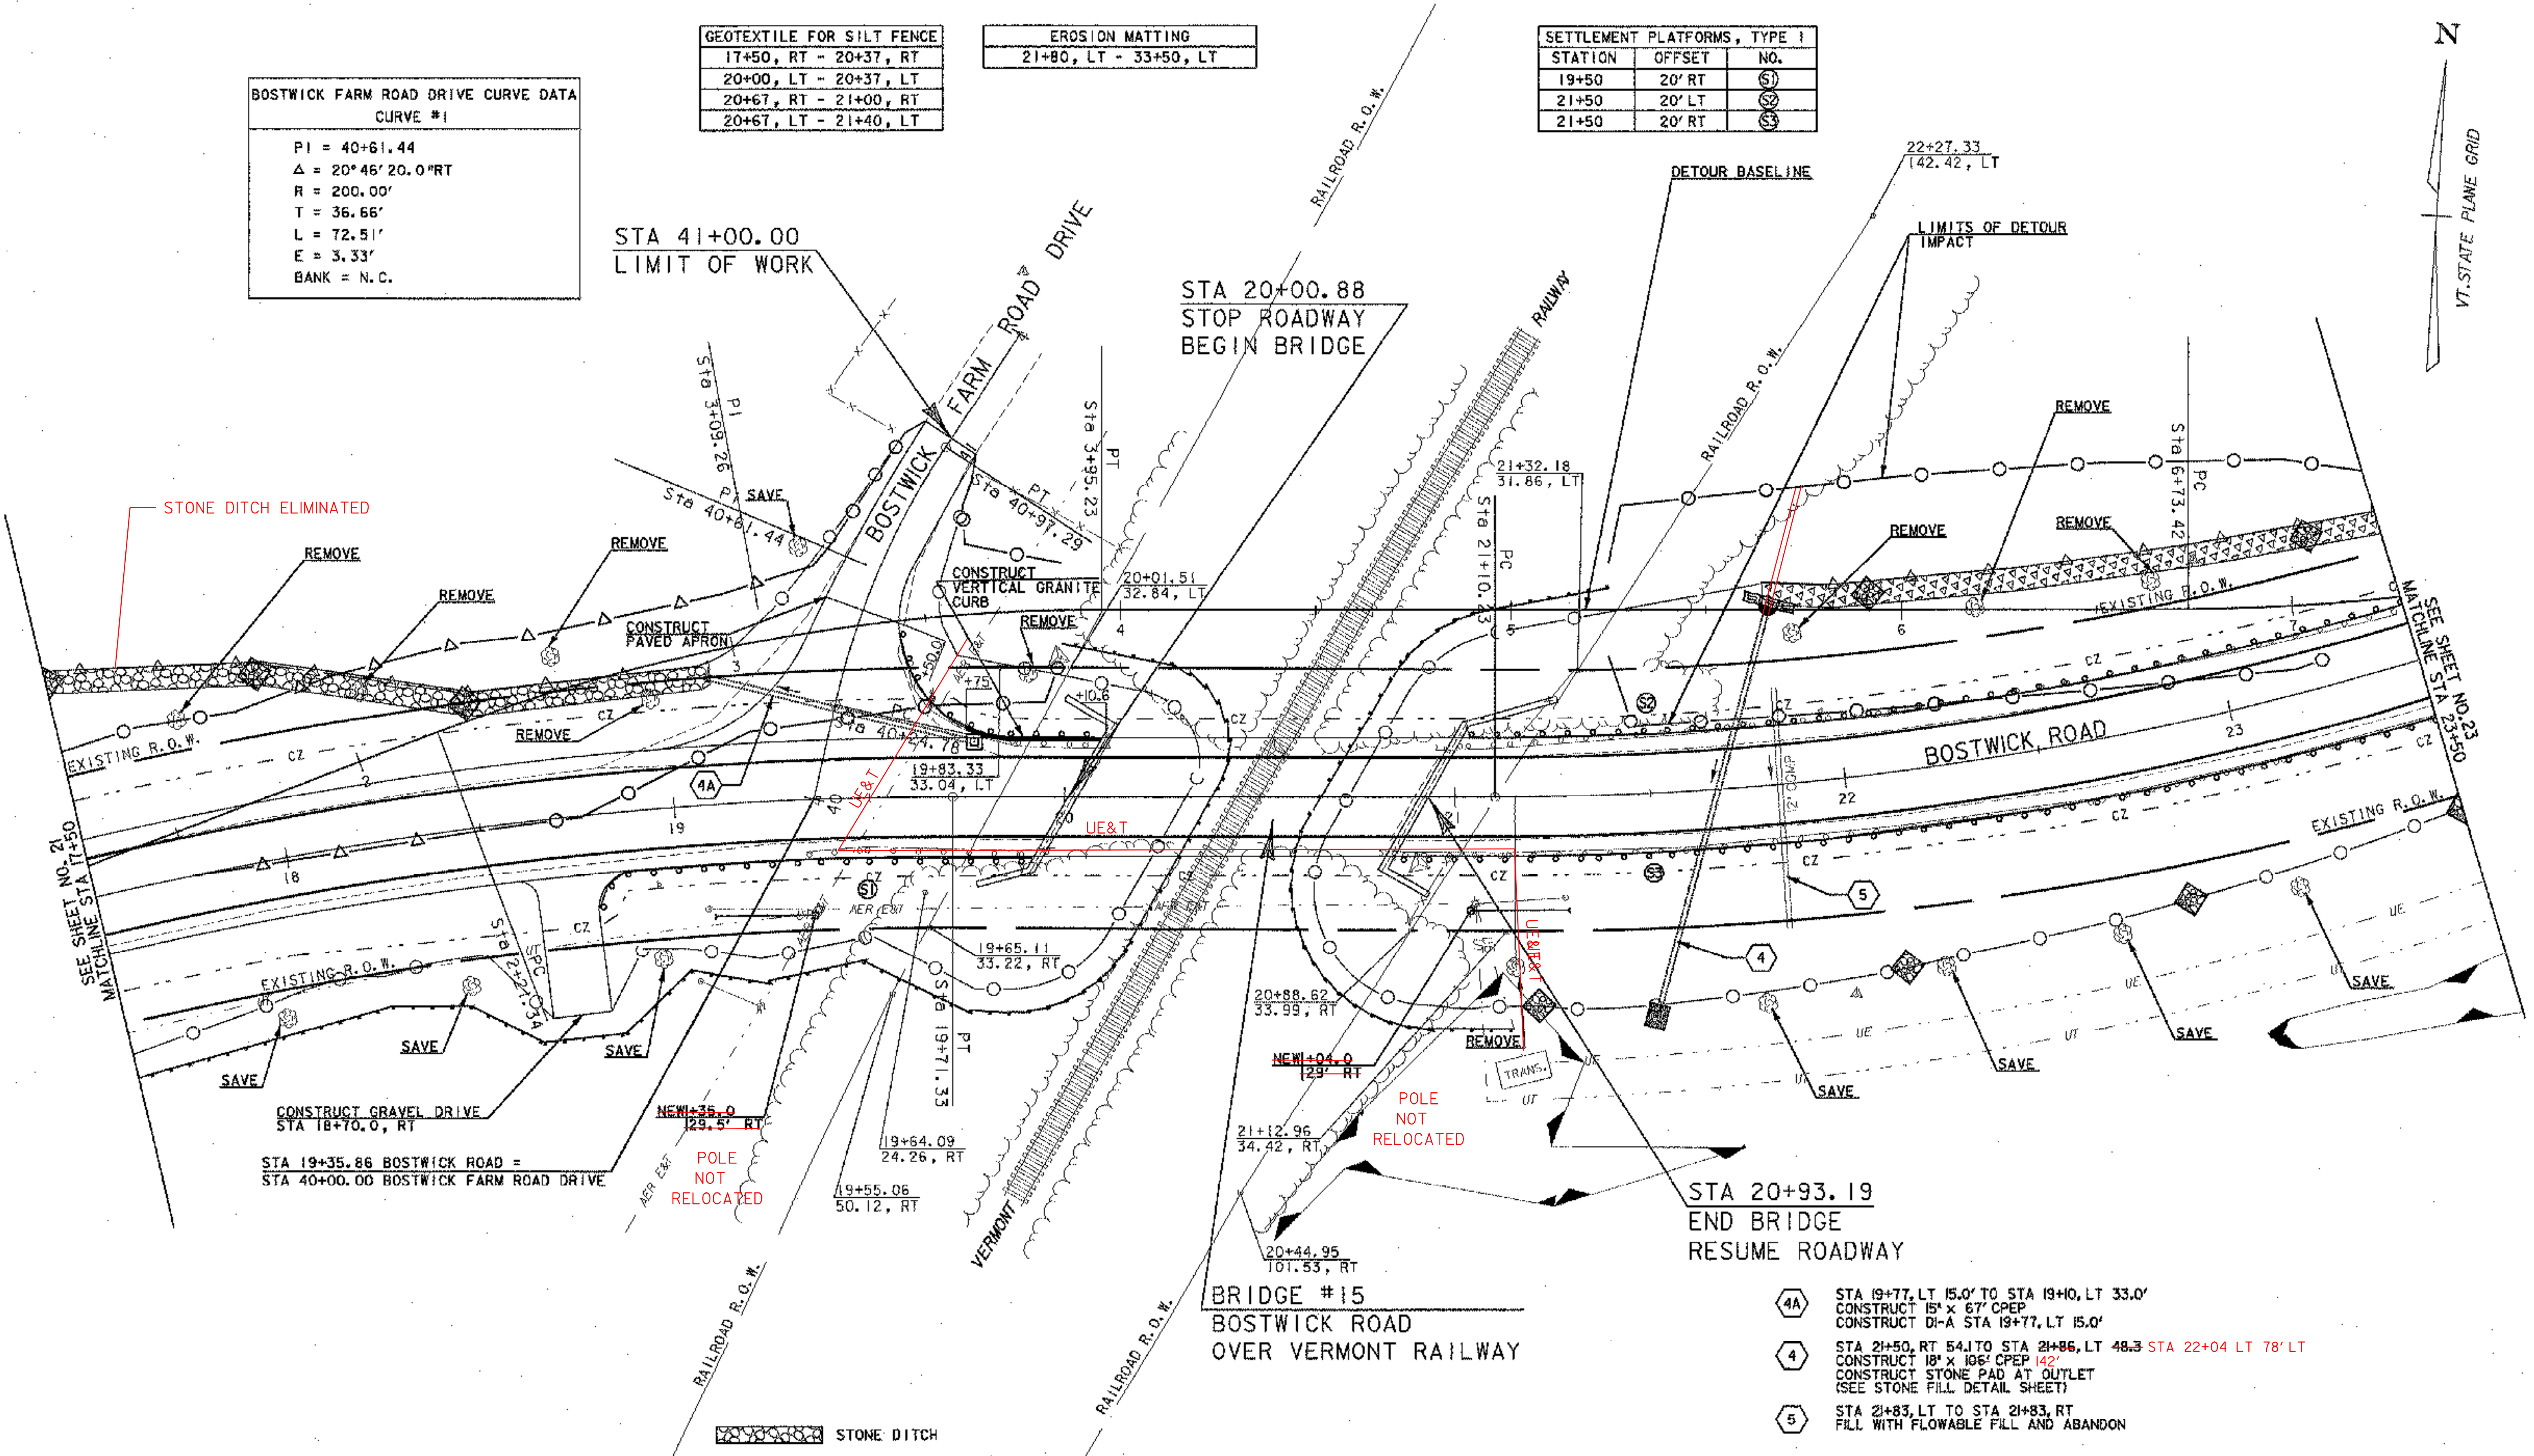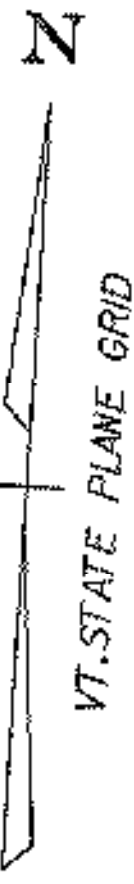

STA 19+35.86 BOSTWICK ROAD =
 STA 40+00.00 BOSTWICK FARM ROAD DRIVE


STA 20+00.88
 STOP ROADWAY
 BEGIN BRIDGE

STA 20+93.19
 END BRIDGE
 RESUME ROADWAY

BRIDGE #15
 BOSTWICK ROAD
 OVER VERMONT RAILWAY

- (4A) STA 19+77, LT 15.0' TO STA 19+40, LT 33.0'
 CONSTRUCT 15' x 67' CPEP
 CONSTRUCT DI-A STA 19+77, LT 15.0'
- (4) STA 21+50, RT 54.1' TO STA 21+86, LT 48.3' STA 22+04, LT 78' LT
 CONSTRUCT 18' x 106' CPEP 142'
 CONSTRUCT STONE PAD AT OUTLET
 (SEE STONE FILL DETAIL SHEET)
- (5) STA 21+83, LT TO STA 21+83, RT
 FILL WITH FLOWABLE FILL AND ABANDON

- STONE DITCH
- WETLANDS
- EROSION MATTING
- HAYBALES
- STONE CHECK DAM

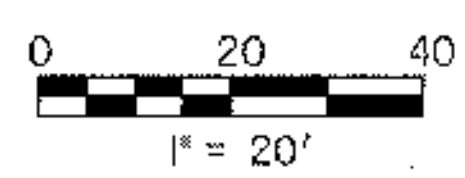


DATUM

VERTICAL	NAVD 88
HORIZONTAL	NAD 83 (1996)

LAYOUT SHEET	PROJECT NAME: SHELBURNE
	PROJECT NUMBER: BRO 1445(30)
	FILE NAME: M:\595402 Bostwick\HWY\DRAW\GENPLN\gen003.dgn
	PROJECT LEADER: MBZ
DESIGNED BY: DMB	PLOT DATE: 04-AUG-2003
CHECKED BY: MDL	DRAWN BY: MJF
	SHEET 22 OF 73


EROSION MATTING	
23+50, LT	- 25+00, LT

BOSTWICK ROAD CURVE DATA	
CURVE #2	
PI = 26+63.21	
$\Delta = 67^{\circ}20'45.7''$ LT	
R = 830.00'	
T = 552.98'	
L = 975.59'	
E = 167.34'	
BANK = 5.30%	

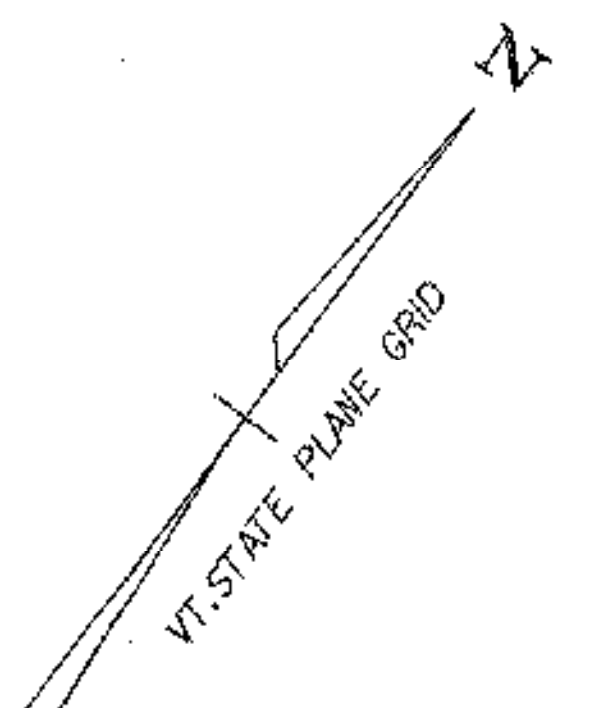

STA 28+25.00
END APPROACH CONSTRUCTION
MATCH EXISTING PAVEMENT

STA 26+75.00
END PROJECT BRO 1445 (30)
BEGIN APPROACH CONSTRUCTION

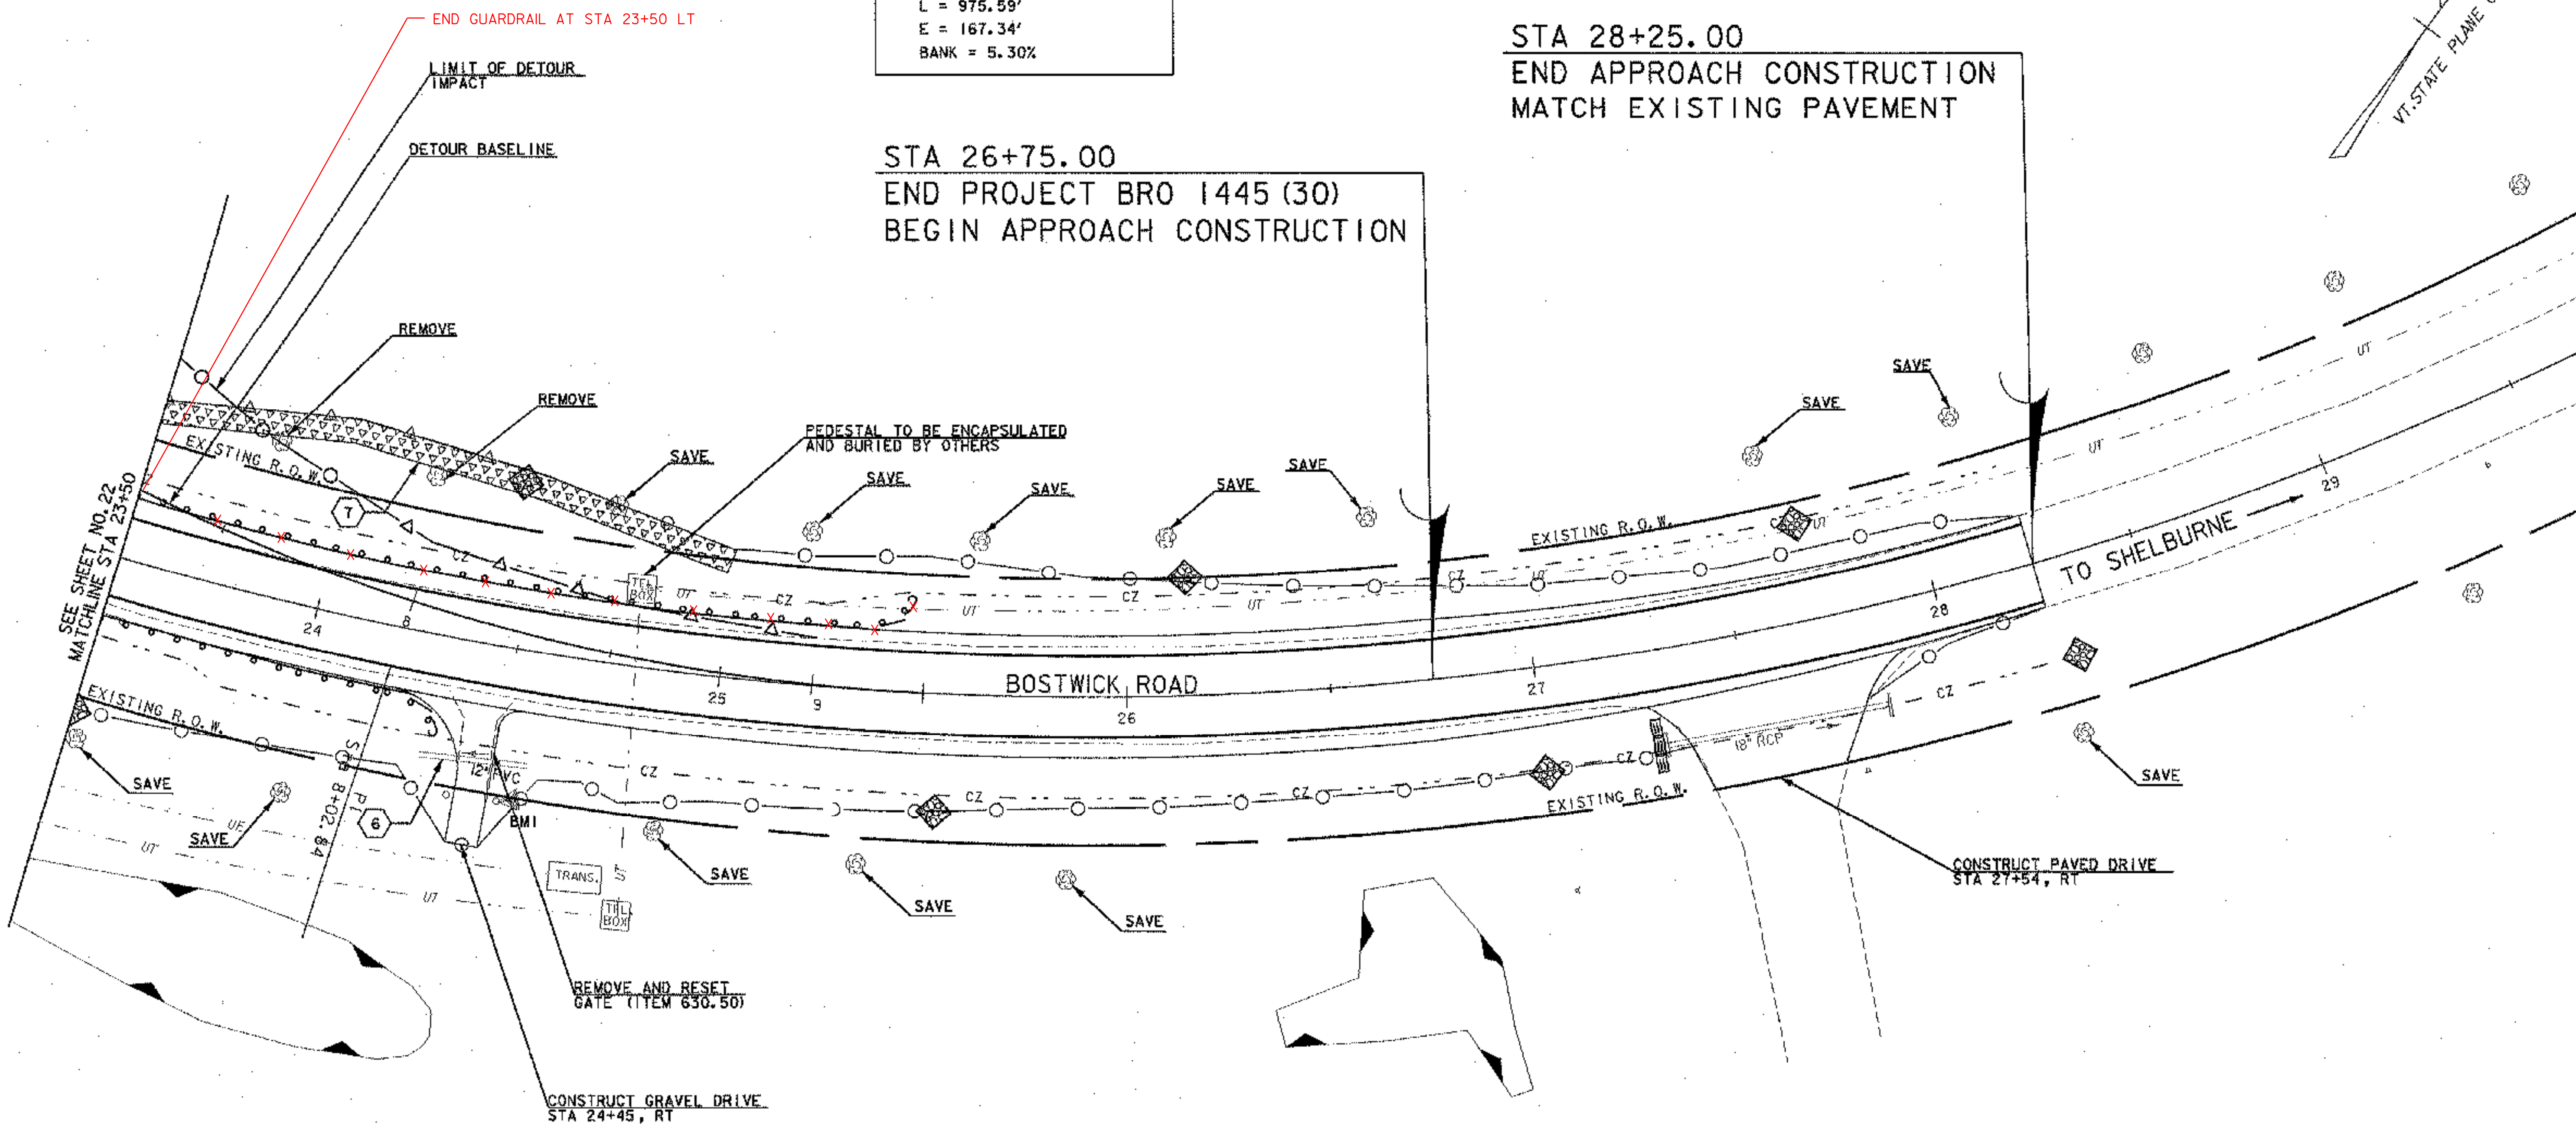

SEE SHEET NO. 22
MATCHLINE STA 23+50


REMOVE AND RESET
GATE (ITEM 630.50)

CONSTRUCT GRAVEL DRIVE
STA 24+45, RT

CONSTRUCT PAVED DRIVE
STA 27+54, RT

- 6 STA 24+31, RT 29.2 TO STA 24+57, RT 28.7
REMOVE EXISTING 12" PVC
- 7 STA 21+80, LT TO STA 25+00, LT
CONSTRUCT 320' TOE OF SLOPE DITCH
(SEE CROSS SECTIONS AND DRAINAGE DETAIL SHEET)


	STONE DITCH
	WETLANDS
	EROSION MATTING
	HAYBALES
	STONE CHECK DAM

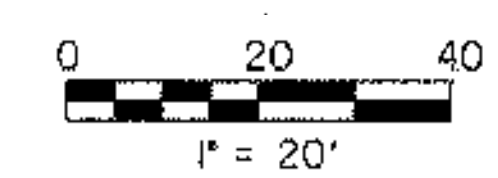


DATUM	
VERTICAL	NAVD 88
HORIZONTAL	NAD 83 (1996)

LAYOUT SHEET	PROJECT NAME: SHELBURNE
	PROJECT NUMBER: BRO 1445(30)
	FILE NAME: M:\1595402 Bostwick\HWY\DRAW\GENPLAN\gen004.dgn
	PROJECT LEADER: MBZ
DESIGNED BY: DMB	PLOT DATE: 01-AUG-2003
CHECKED BY: MDL	DRAWN BY: MJF
	SHEET 23 OF 73

PI
Sta 26+63.21

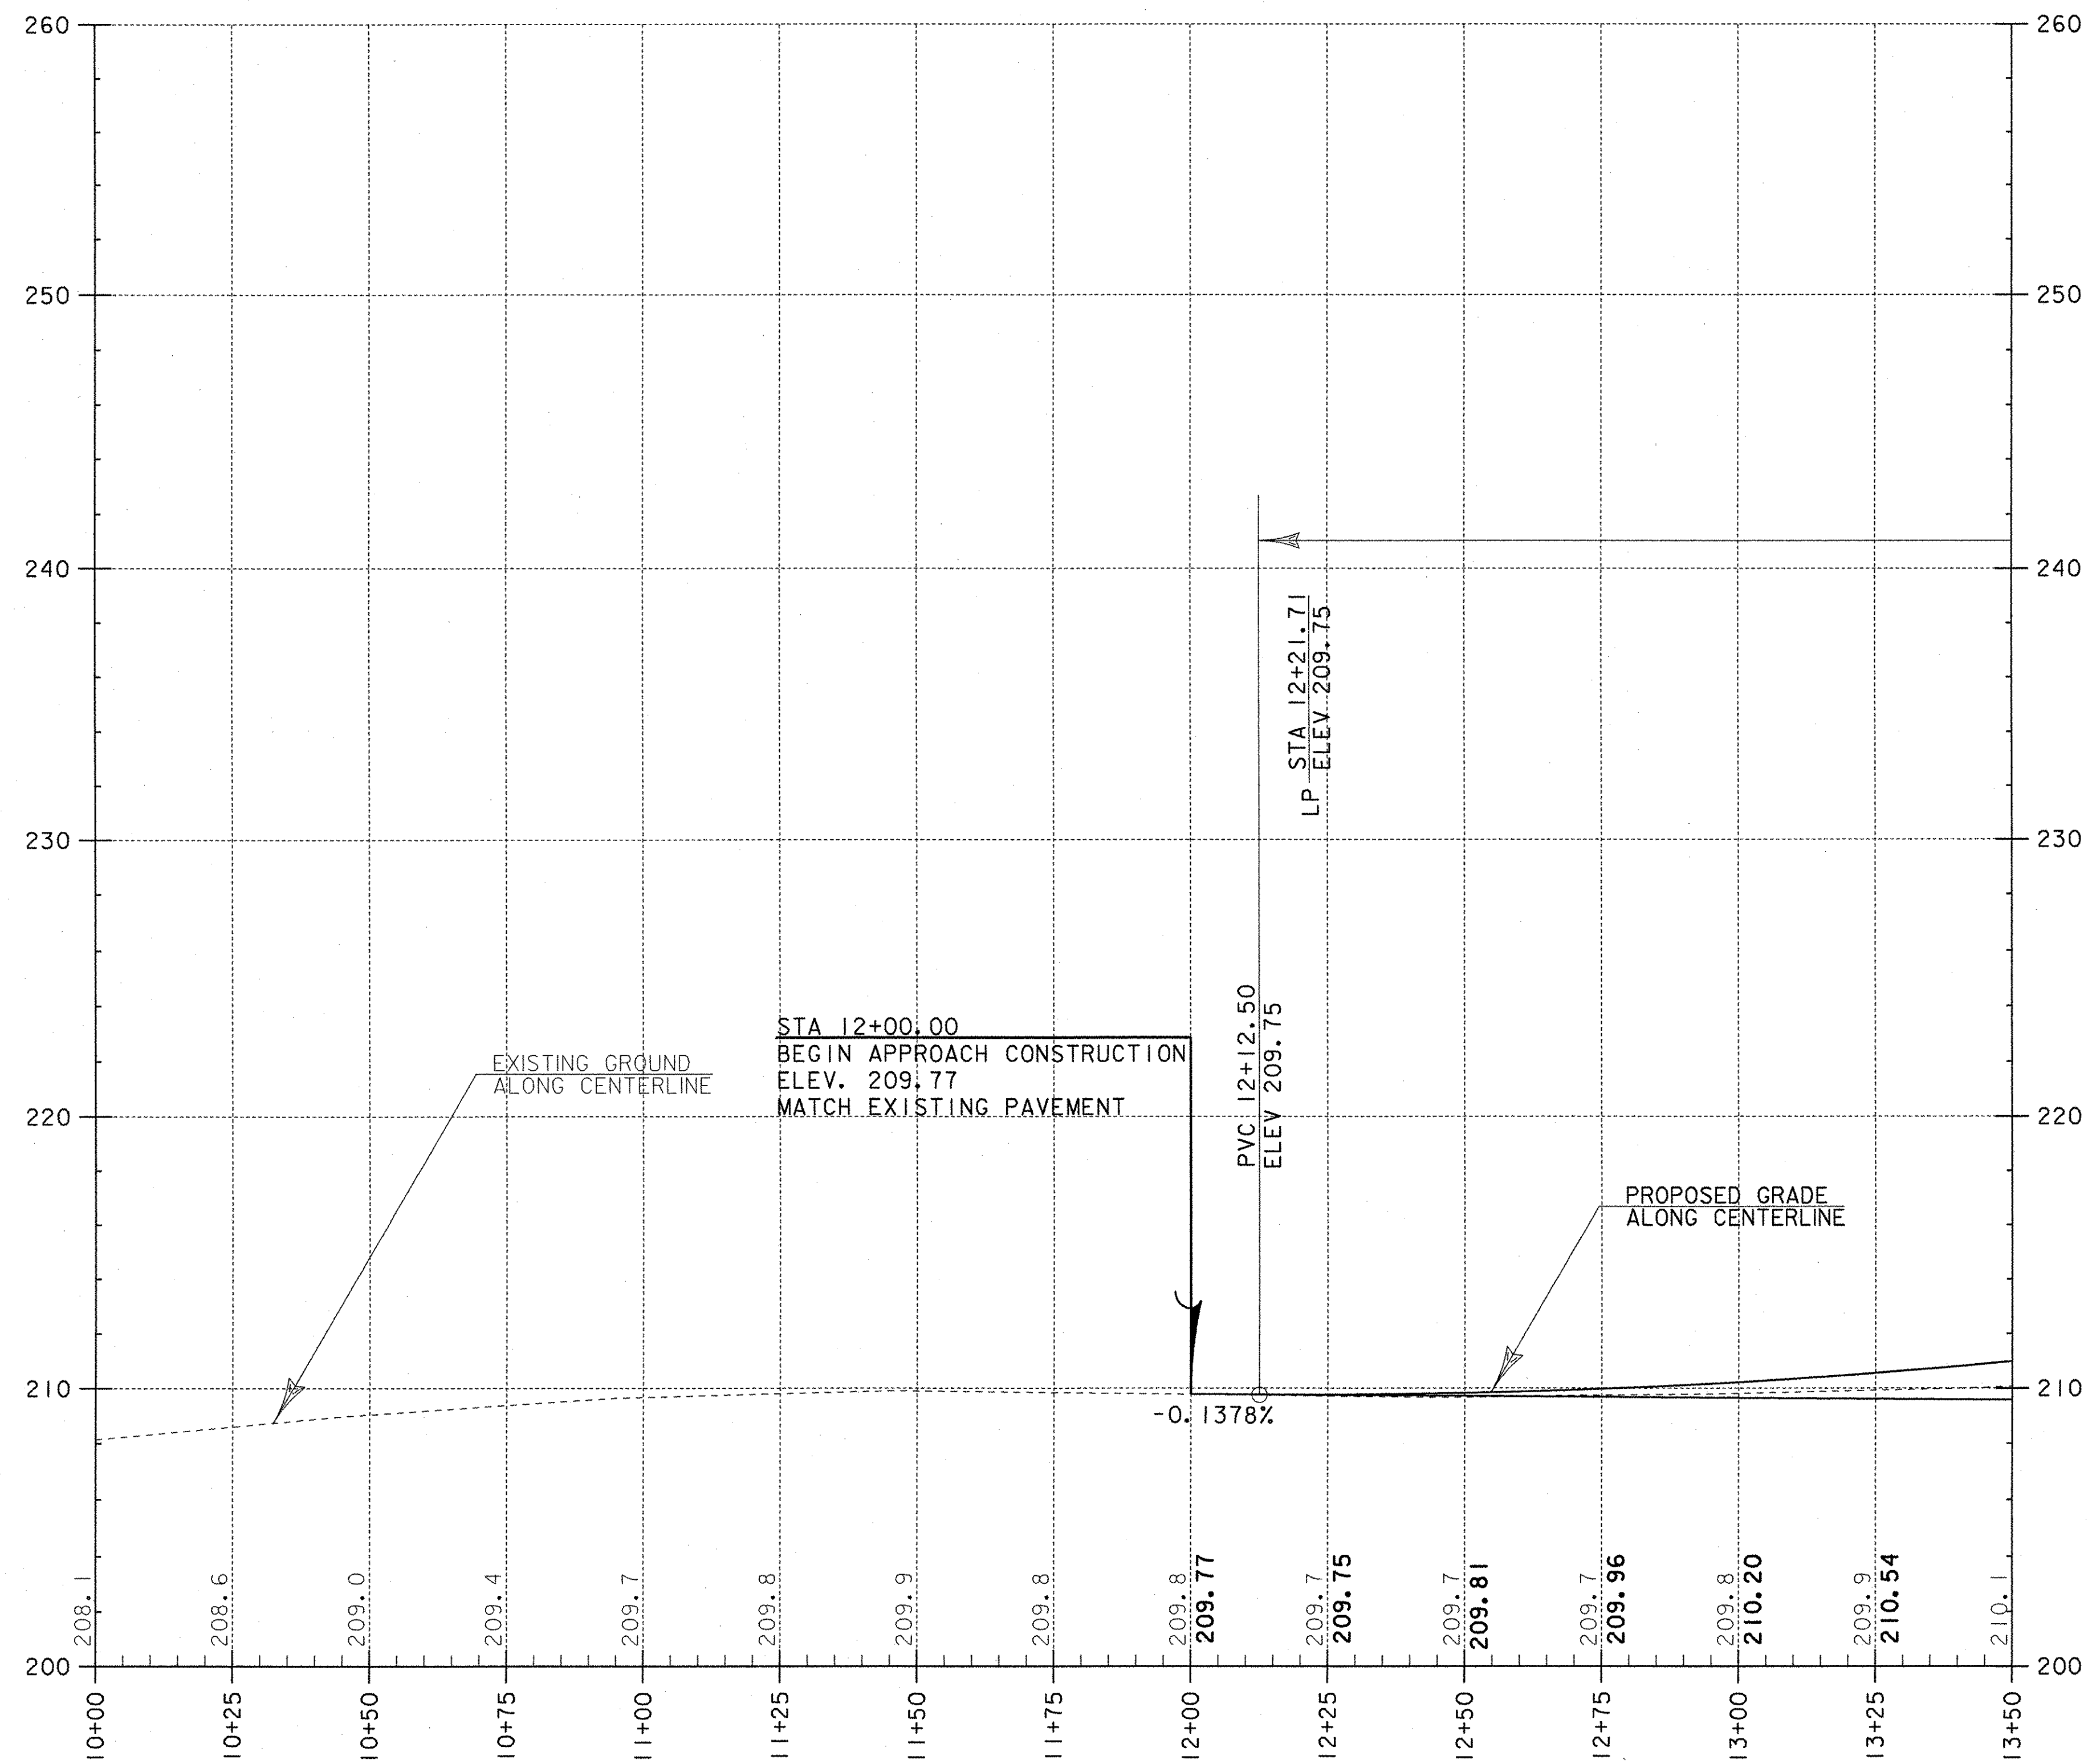


BOSTWICK ROAD

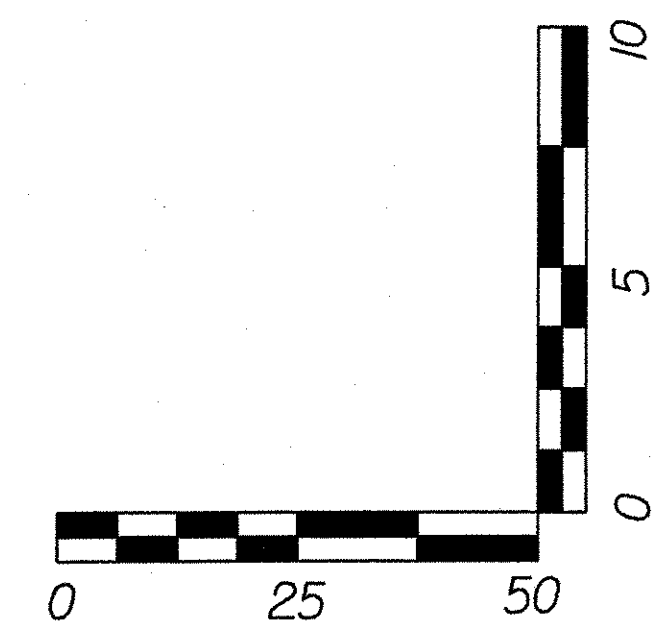

DATUM
 VERTICAL NAVD 88
 HORIZONTAL NAD 83 (1996)

PROFILE	PROJECT NAME: SHELBURNE
	PROJECT NUMBER: BRO 1445(30)
	FILE NAME: m:\595402 Bostwick\HWY\DRAW\PROFILES\prof001.dgn
PROJECT LEADER: MBZ	PLOT DATE: 01-AUG-2003
DESIGNED BY: DMB	DRAWN BY: MJF
CHECKED BY: MDL	SHEET 24 OF 73

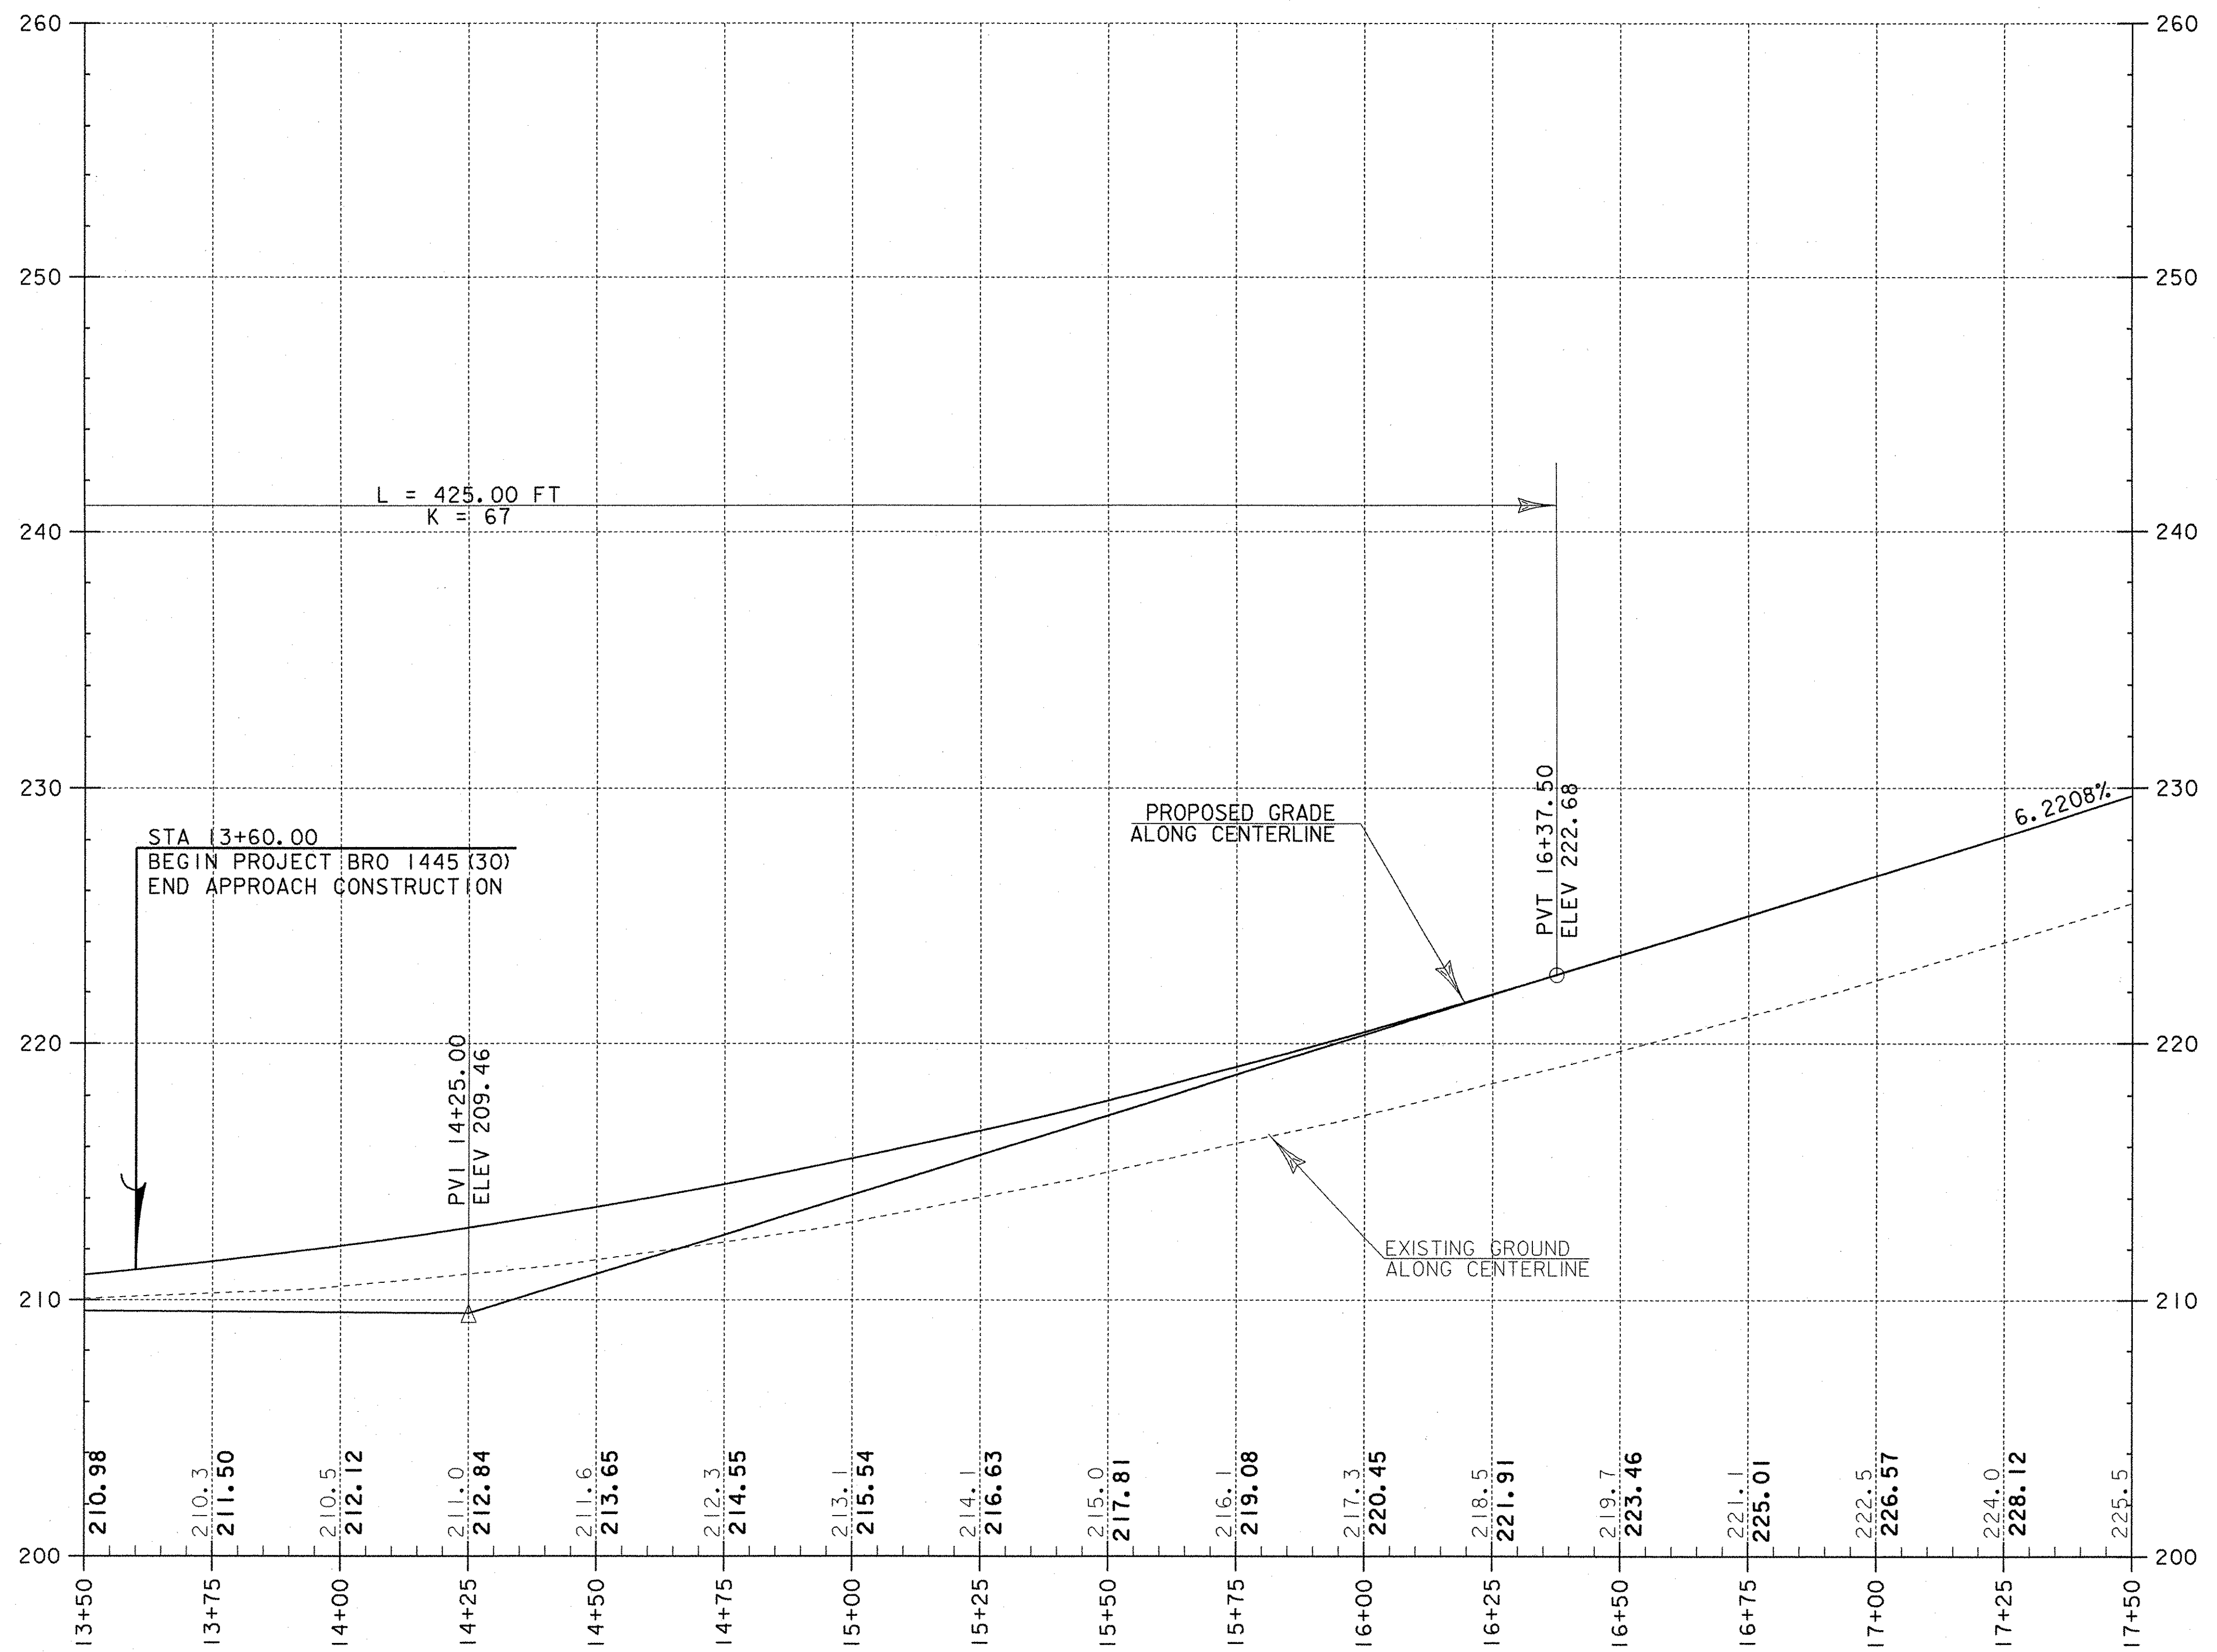


BOSTWICK ROAD

DATUM	
VERTICAL	NAVD 88
HORIZONTAL	NAD 83 (1996)

PROFILE

PROJECT NAME:	SHELBURNE
PROJECT NUMBER:	BRO 1445(30)
FILE NAME:	m:\1595402 Bostwick\HWY\DRAW\PROFILES\prof002.dgn
PROJECT LEADER:	MBZ
DESIGNED BY:	DMB
CHECKED BY:	MDL
PLOT DATE:	01-AUG-2003
DRAWN BY:	MJF
SHEET	25 OF 73

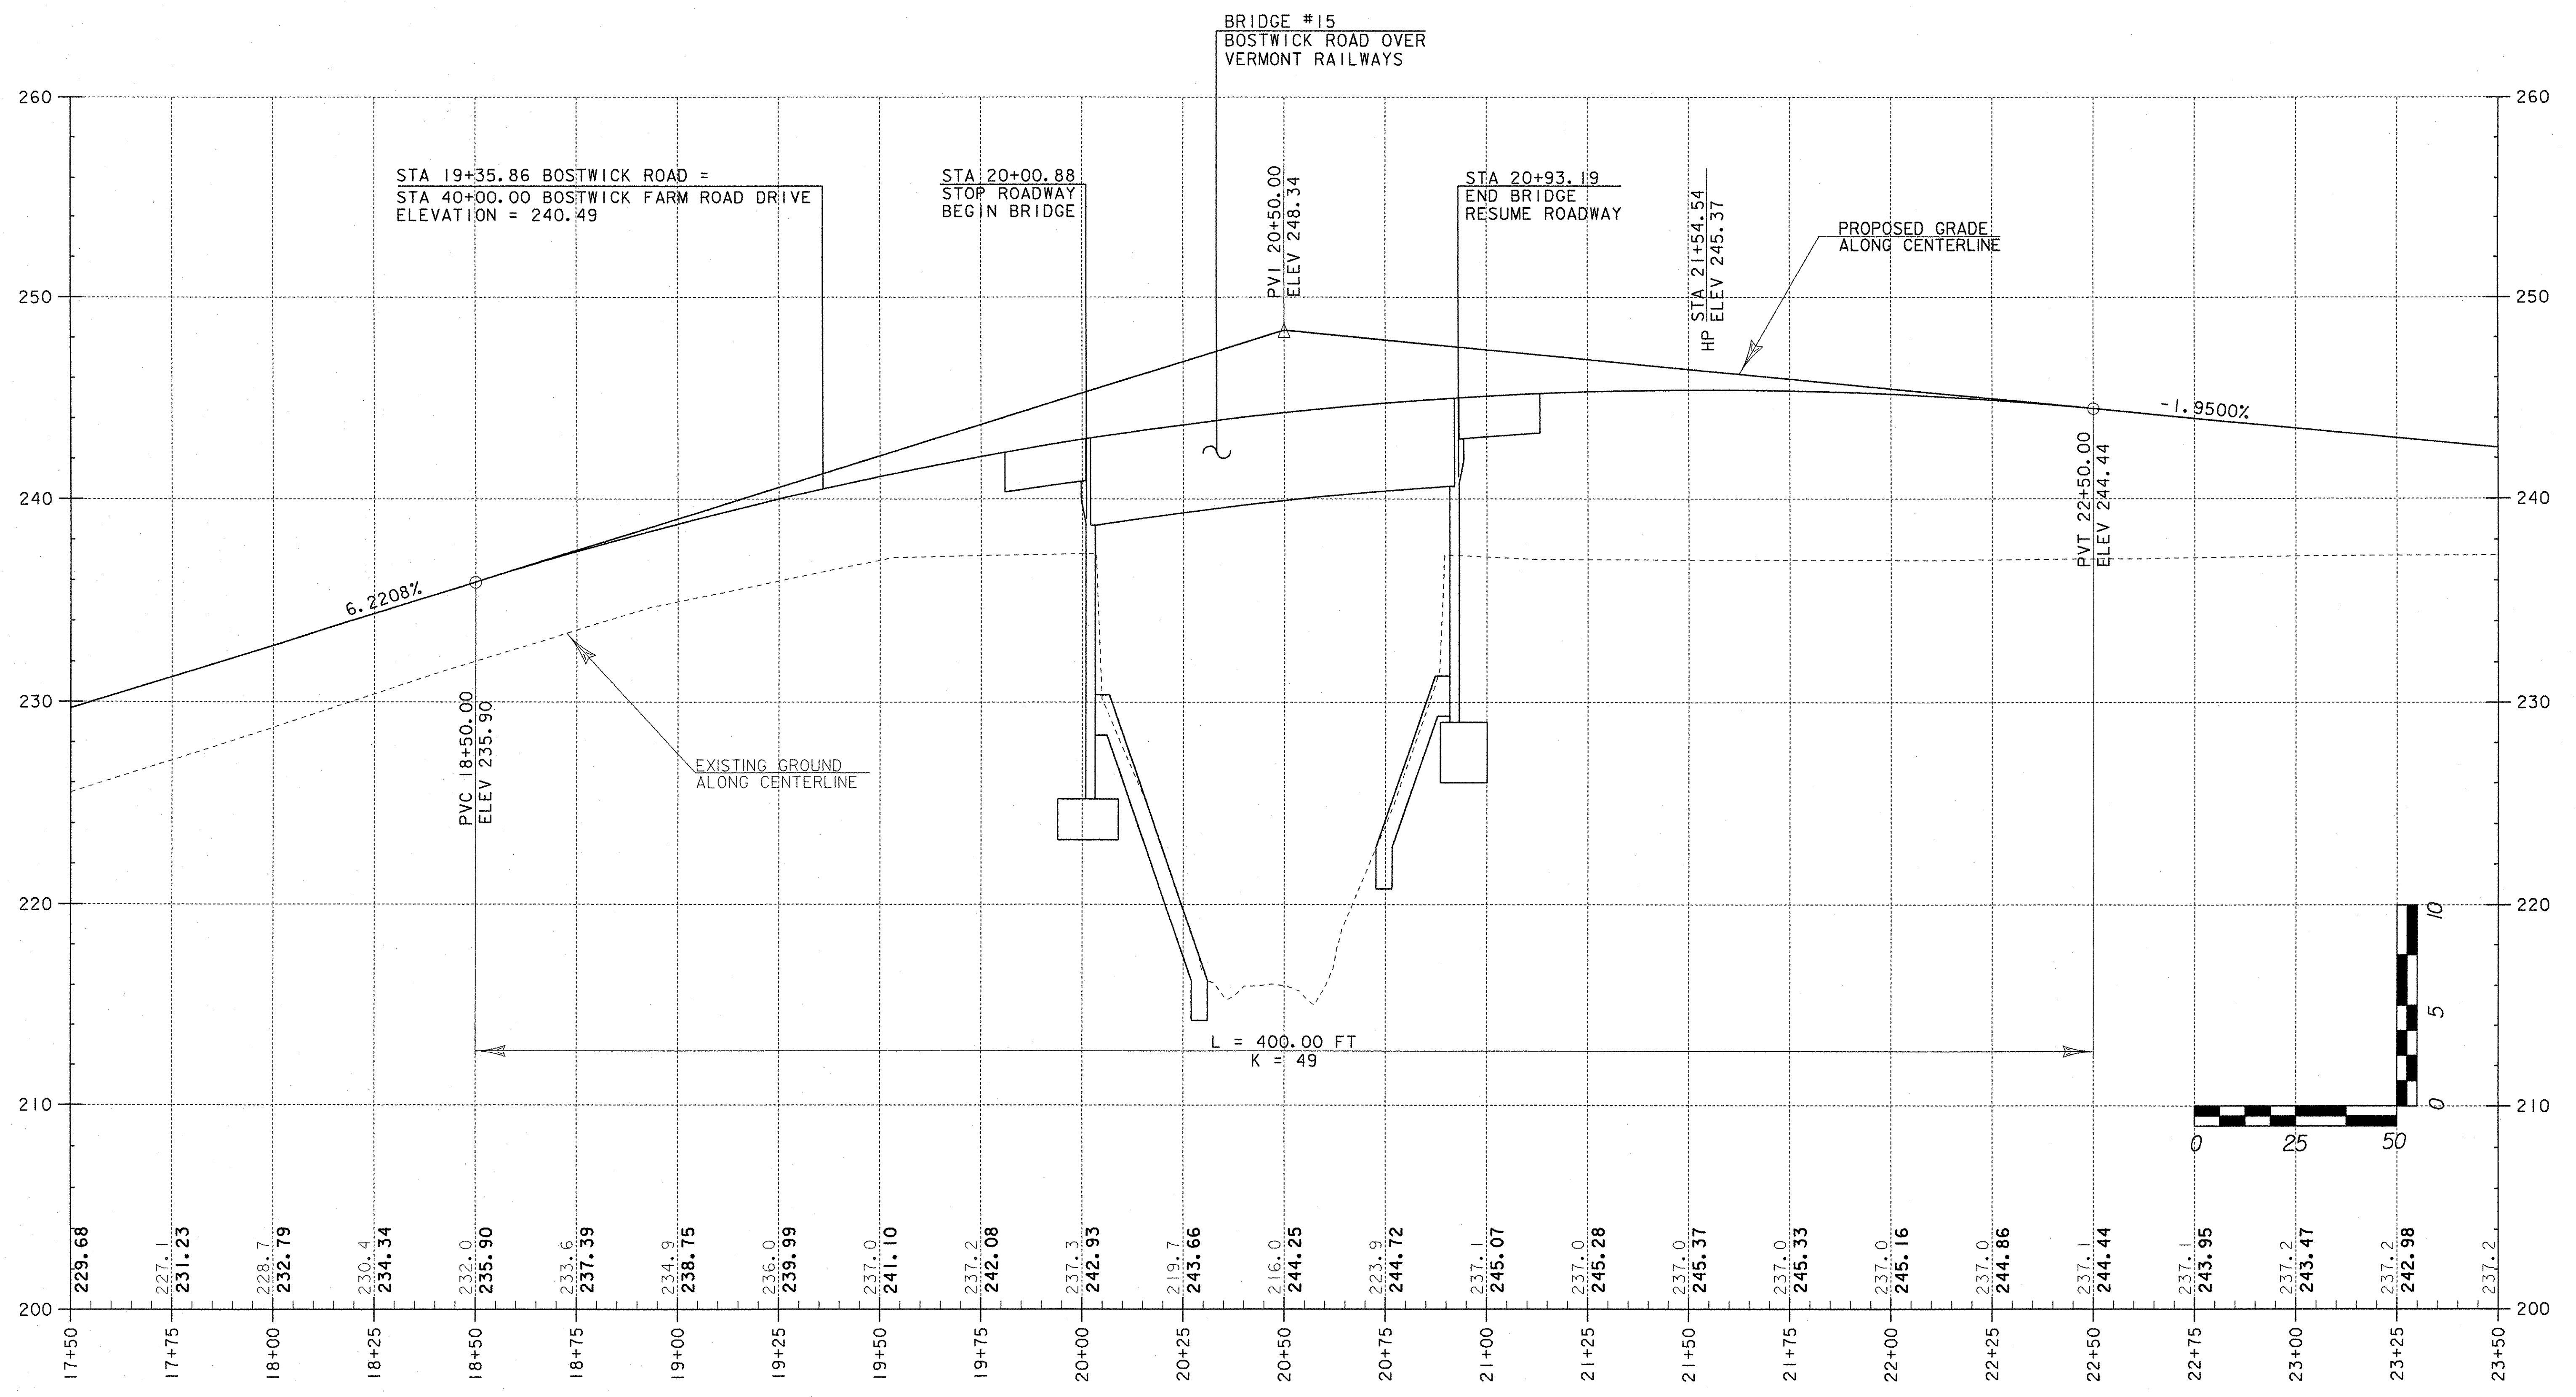

BOSTWICK ROAD

BRIDGE #15
BOSTWICK ROAD OVER
VERMONT RAILWAYS

STA 19+35.86 BOSTWICK ROAD =
STA 40+00.00 BOSTWICK FARM ROAD DRIVE
ELEVATION = 240.49

STA 20+00.88
STOP ROADWAY
BEGIN BRIDGE

STA 20+93.19
END BRIDGE
RESUME ROADWAY

PVI 20+50.00
ELEV 248.34

HP STA 21+54.54
ELEV 245.37

PVT 22+50.00
ELEV 244.44

6.2208%

-1.9500%

EXISTING GROUND
ALONG CENTERLINE

PROPOSED GRADE
ALONG CENTERLINE


L = 400.00 FT
K = 49

0 25 50

DATUM
VERTICAL NAVD 88
HORIZONTAL NAD 83 (1996)

PROFILE

PROJECT NAME: SHELBURNE
PROJECT NUMBER: BRO 1445(30)
FILE NAME: m:\1595402 Bostwick\HWY\DRAW\PROFILES\prof003.dgn
PROJECT LEADER: MBZ PLOT DATE: 01-AUG-2003
DESIGNED BY: DMB DRAWN BY: MJF
CHECKED BY: MDL SHEET 26 OF 73

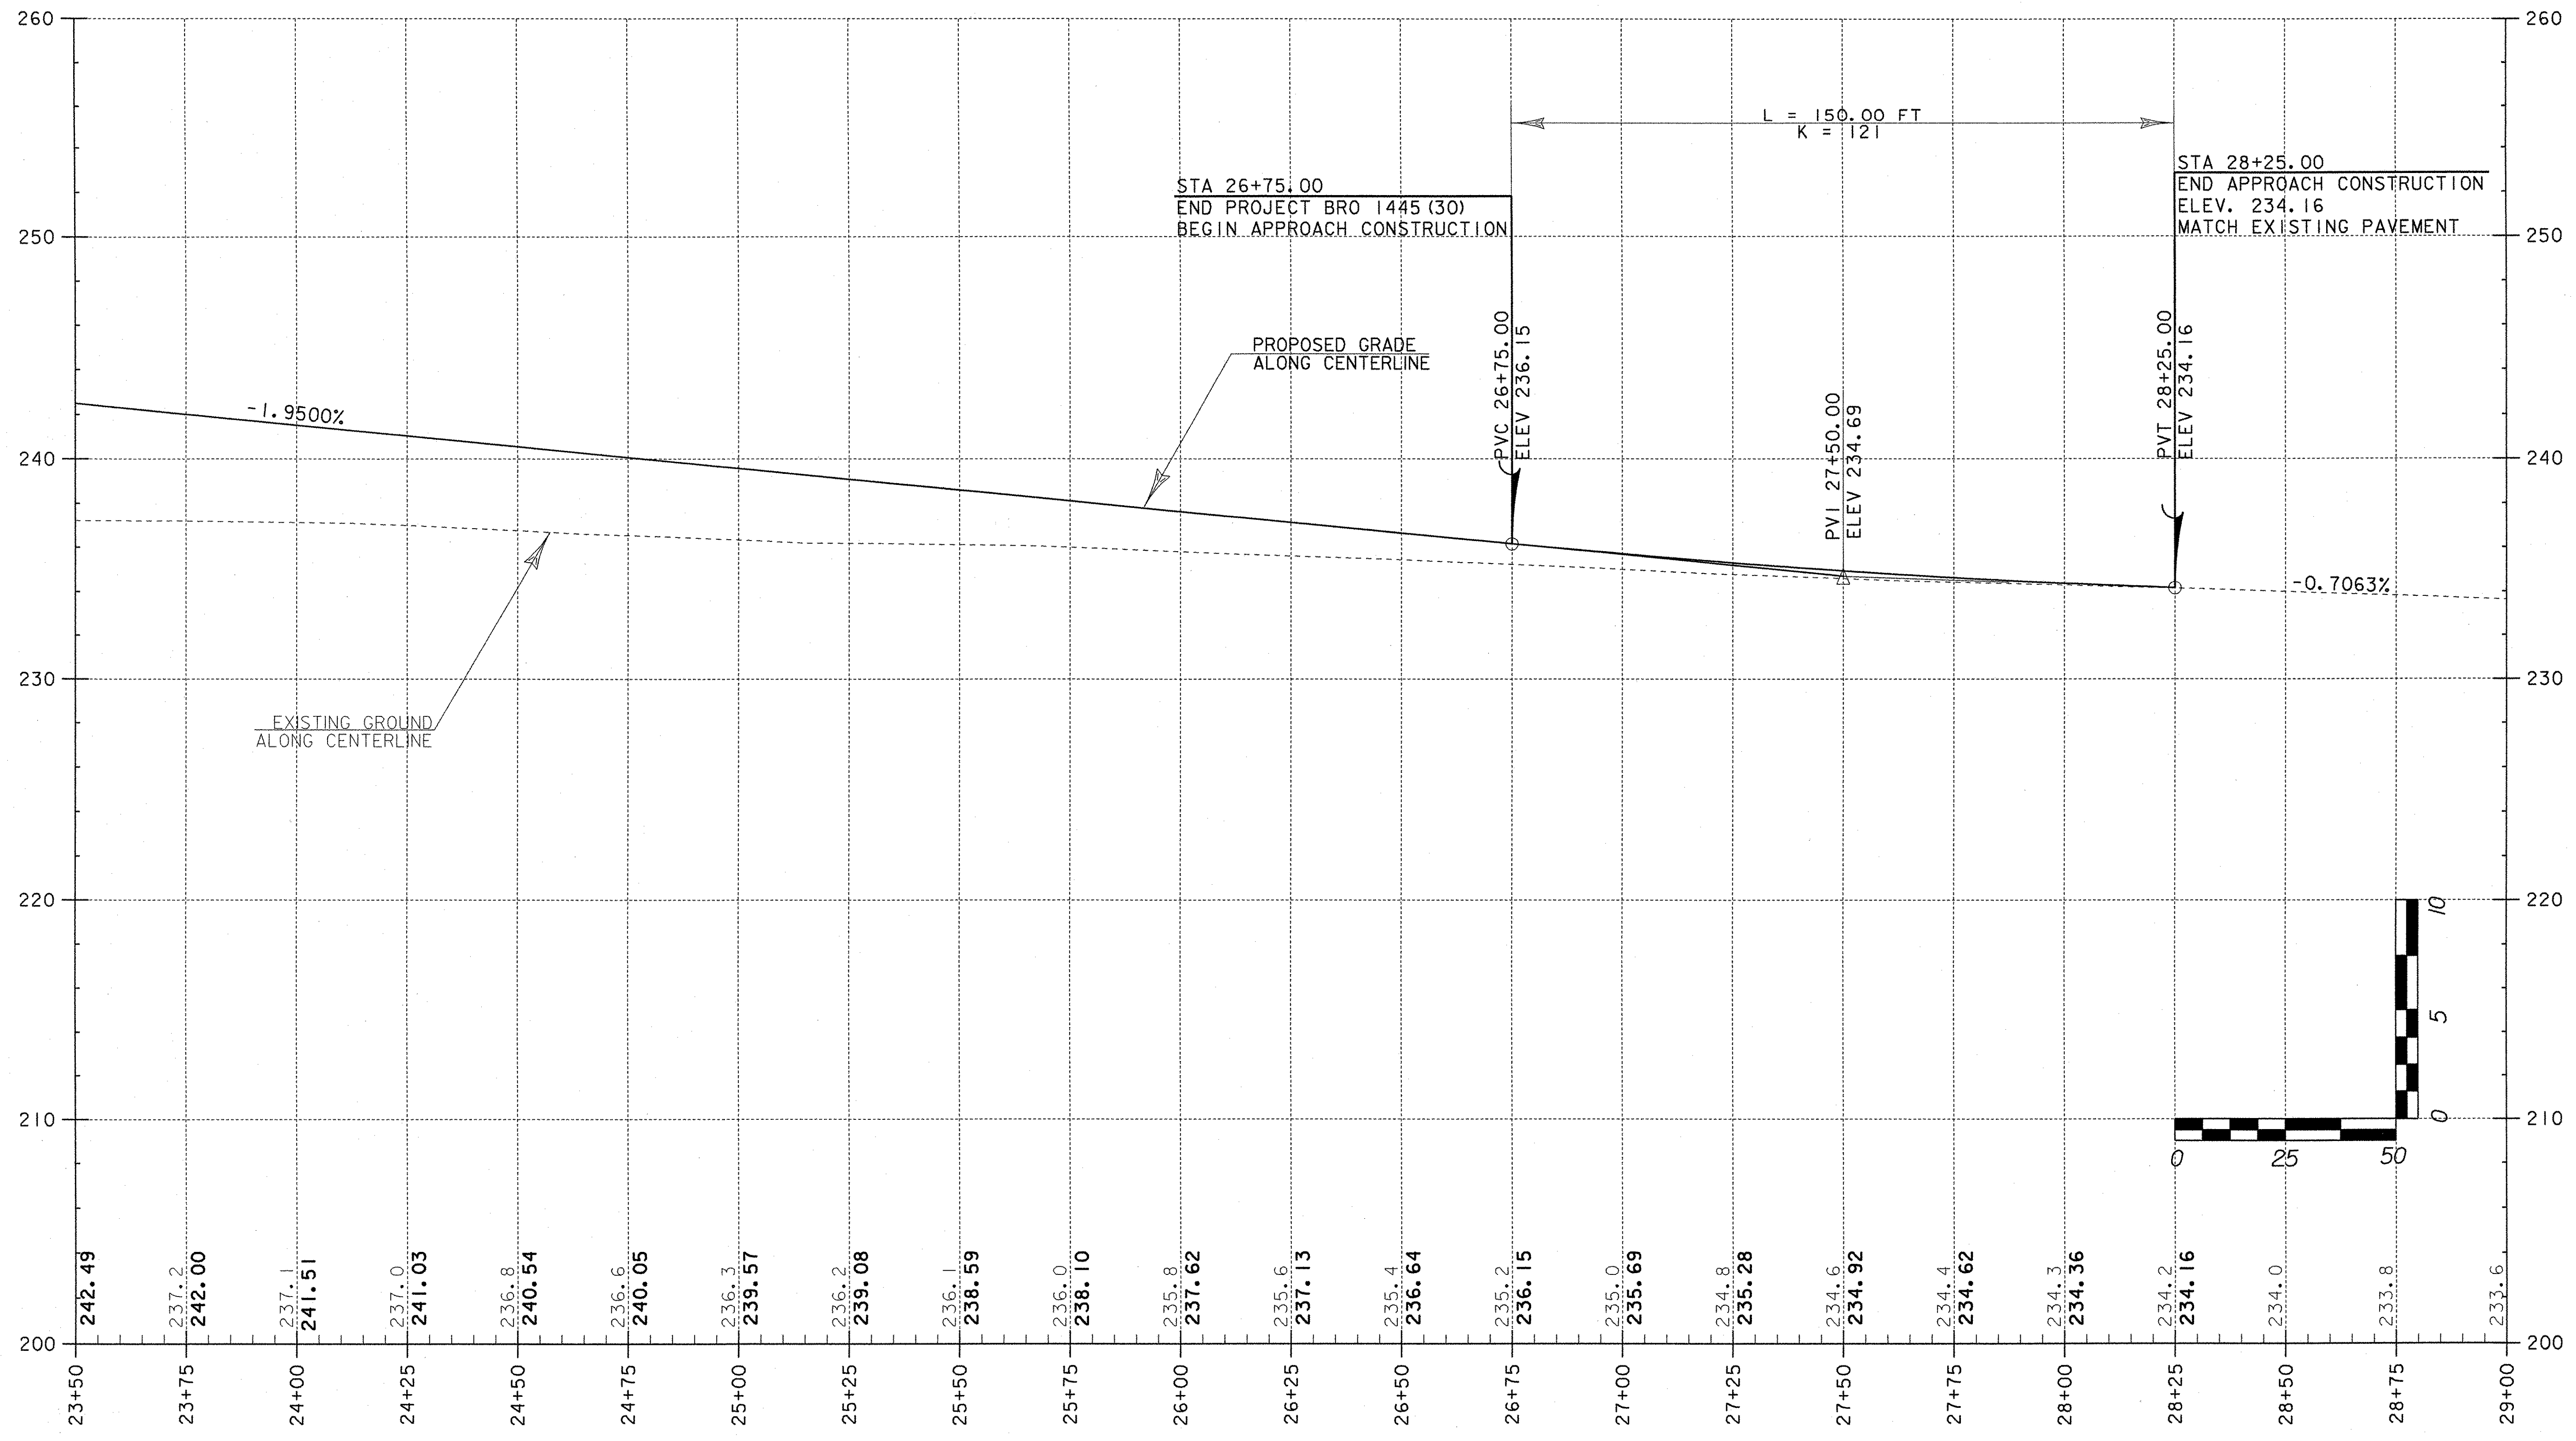


BOSTWICK ROAD


DATUM
 VERTICAL NAVD 88
 HORIZONTAL NAD 83 (1996)

PROFILE

PROJECT NAME: SHELburnE
 PROJECT NUMBER: BRO 1445(30)
 FILE NAME: m:\595402 Bostwick\HWY\DRAW\PROFILES\prof004.dgn
 PROJECT LEADER: MBZ PLOT DATE: 01-AUG-2003
 DESIGNED BY: DMB DRAWN BY: MJF
 CHECKED BY: MDL SHEET 27 OF 73

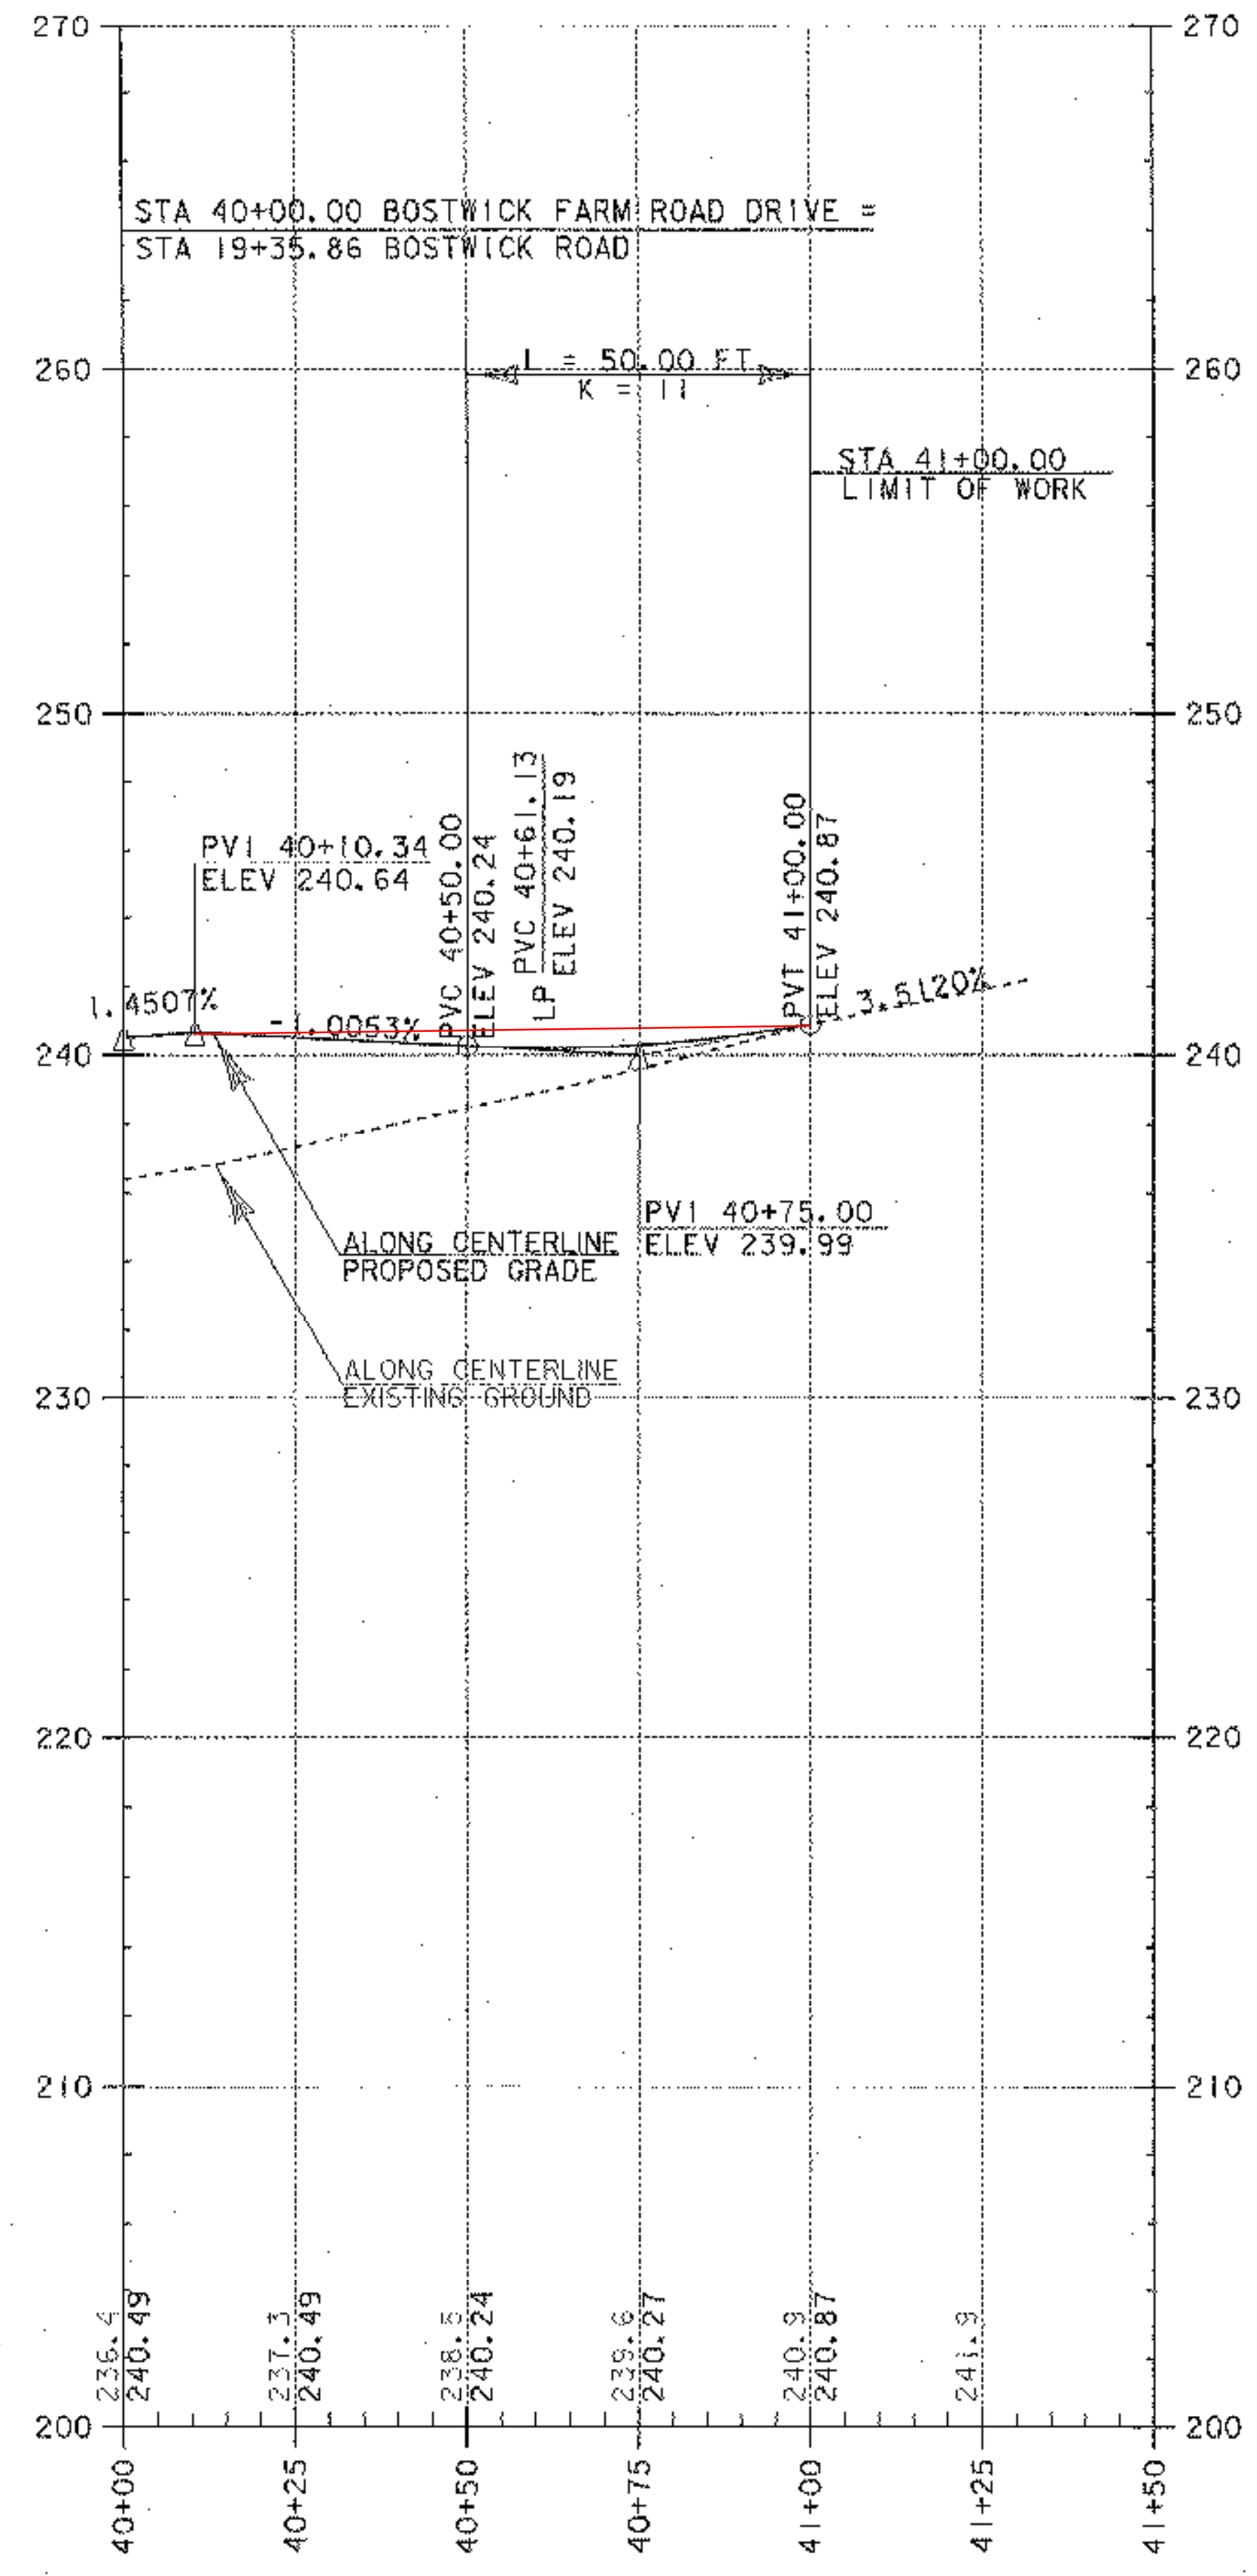


VERTICAL CURVE
ELIMINATED
STRAIGHT GRADE

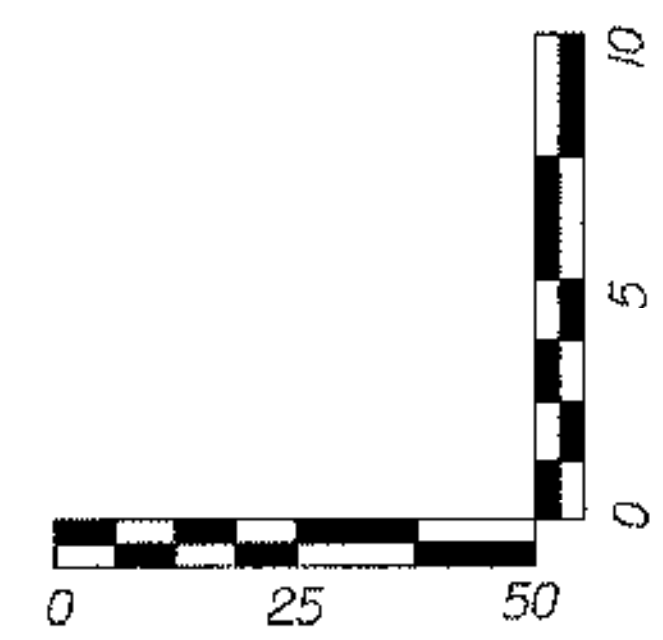


DATUM	
VERTICAL	NAVD 88
HORIZONTAL	NAD 83 (1996)

BOSTWICK FARM ROAD DRIVE

PROFILE	PROJECT NAME:	SHELBURNE		
	PROJECT NUMBER:	BRO 1445(30)		
	FILE NAME:	M:\1595402 Bostwick\HWY\DRAW\PROFILES\prof005.dgn	PLOT DATE:	01-AUG-2003
	PROJECT LEADER:	MBZ	DRAWN BY:	MJF
DESIGNED BY:	DMB	CHECKED BY:	MDL	SHEET 26 OF 73

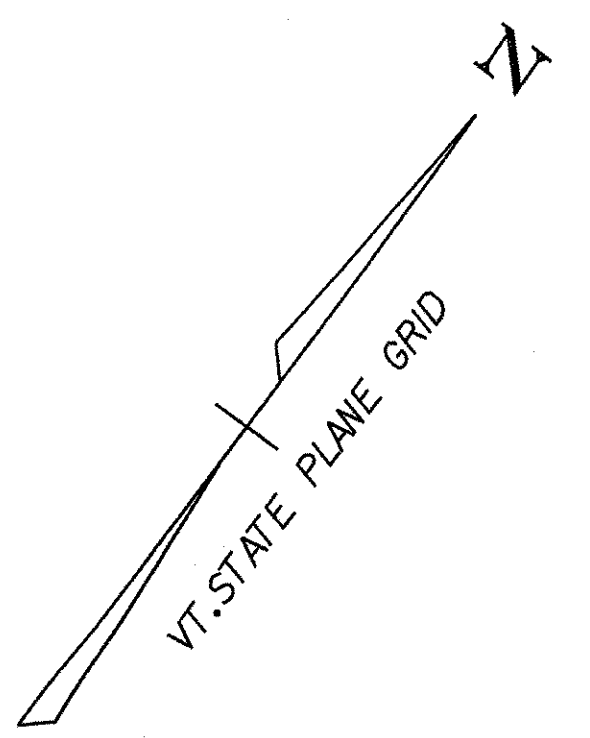


STA 12+00.00
 BEGIN APPROACH CONSTRUCTION
 MATCH EXISTING PAVEMENT

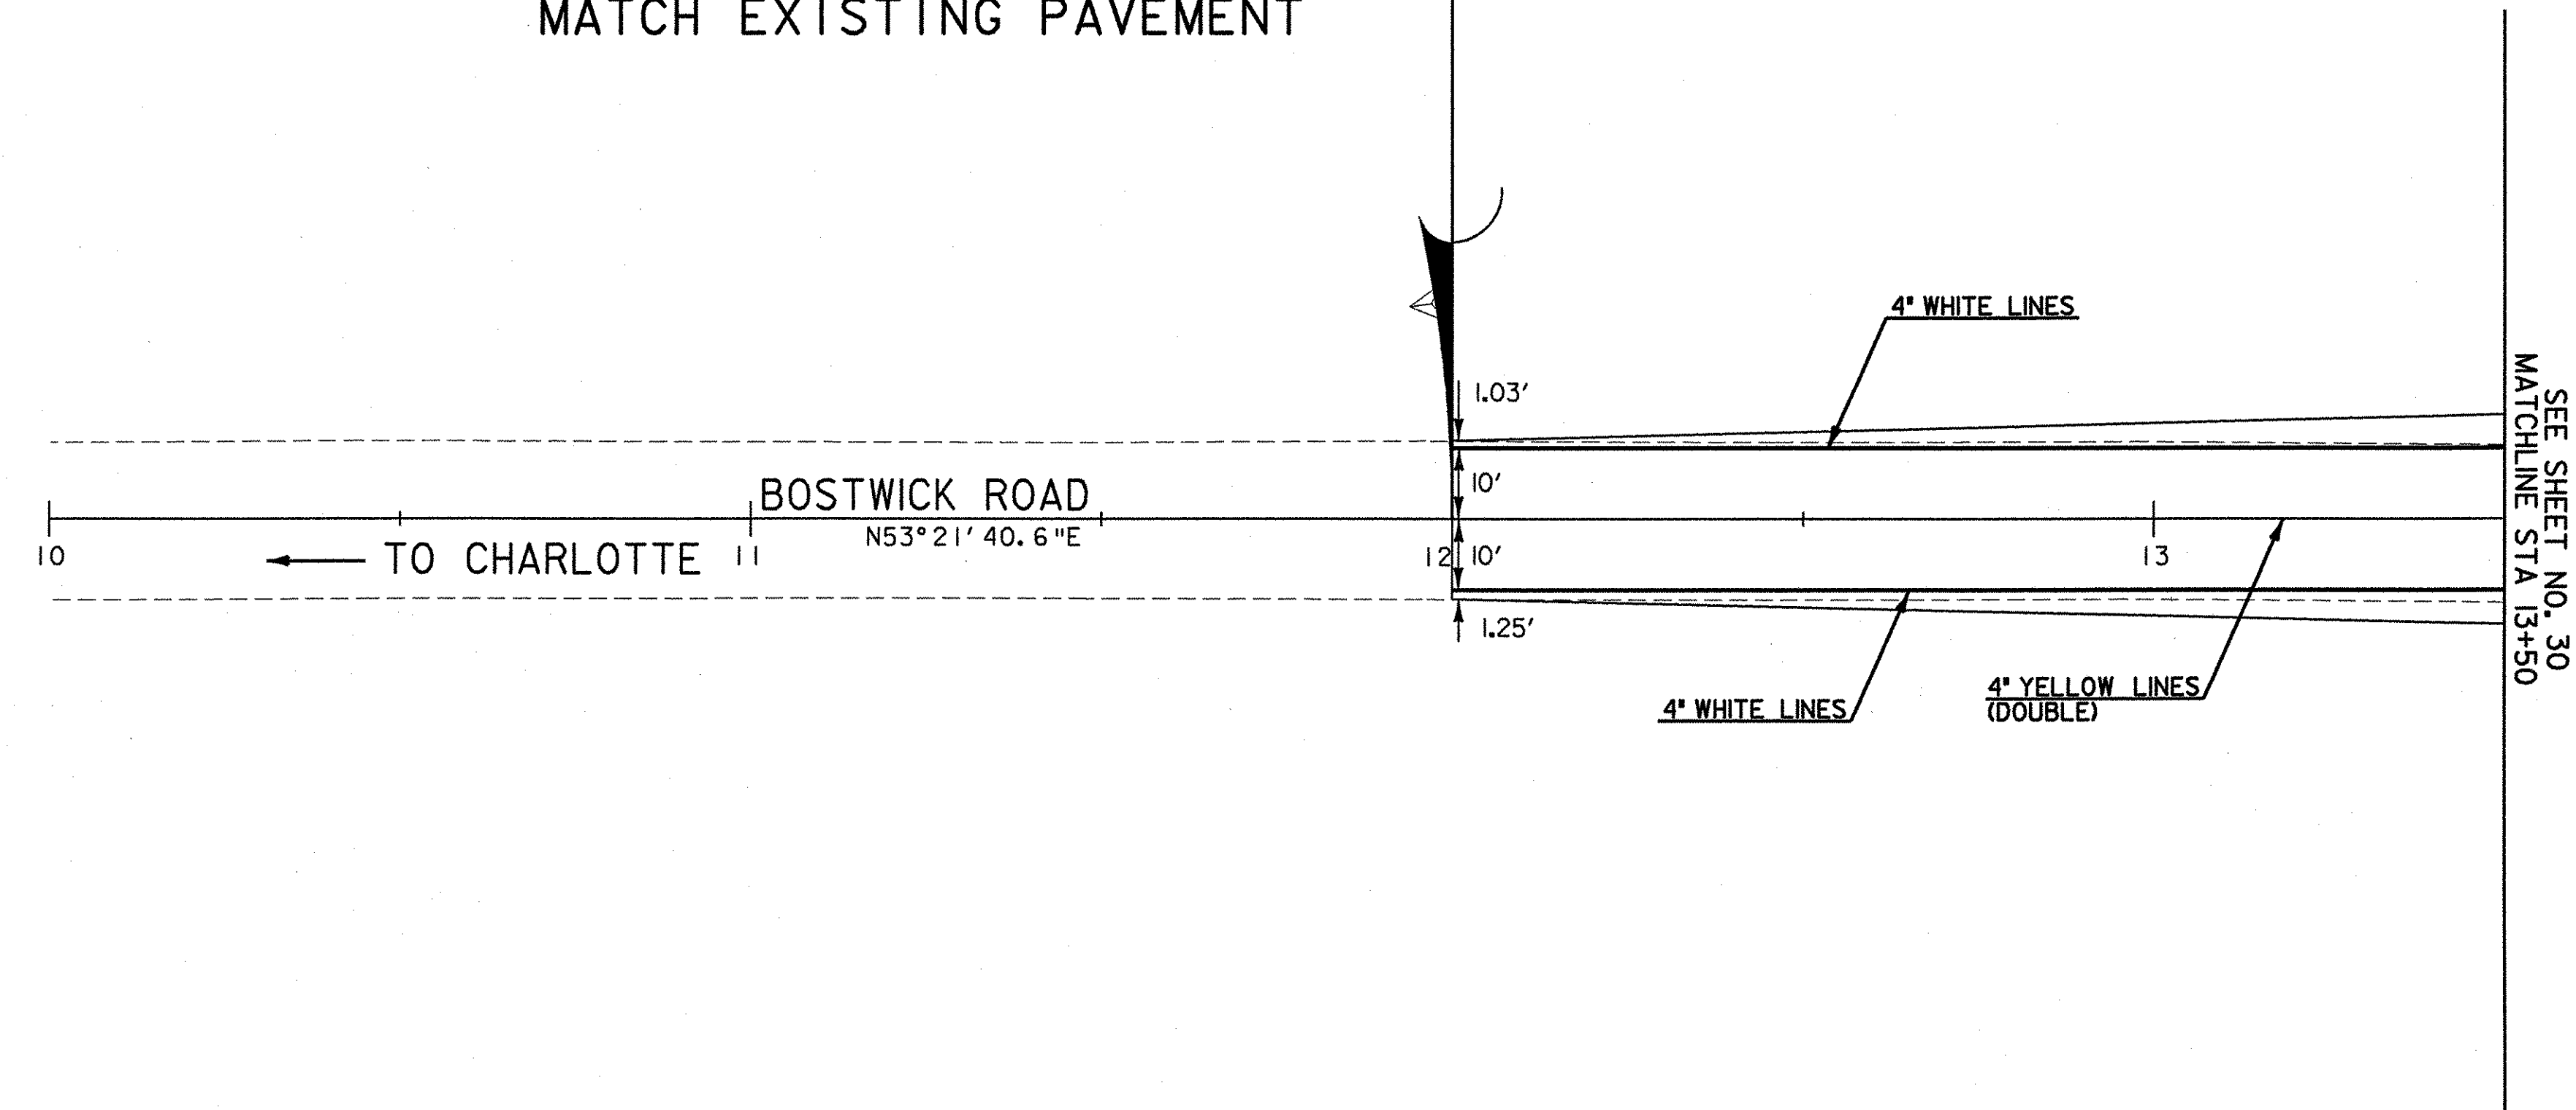


SIGN LEGEND
 R = REMOVE
 S = SALVAGE
 RR = REMOVE AND RESET
 N = NEW
 RET = RETAIN
 B-B = BACK TO BACK
 T-T = THINNING AND TRIMMING
 EXISTING =
 NEW =


DATUM
 VERTICAL NAVD 88
 HORIZONTAL NAD 83 (1996)

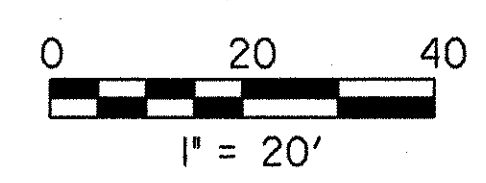

ALIGNMENT SIGNING AND STRIPING	PROJECT NAME: SHELBURNE
	PROJECT NUMBER: BRO 1445(30)
	FILE NAME: M:\595402 Bostwick\HWY\DRAW\SGNPLNS\sgn001.dgn
	PROJECT LEADER: MBZ
DESIGNED BY: DMB	PLOT DATE: 01-AUG-2003
CHECKED BY: MDL	DRAWN BY: MJF
	SHEET 29 OF 73

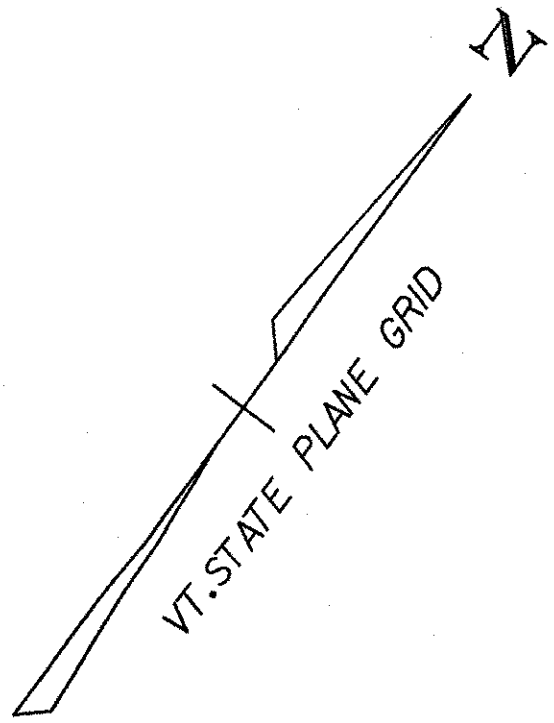


STA 13+60.00
 BEGIN PROJECT BRO 1445 (30)
 END APPROACH CONSTRUCTION

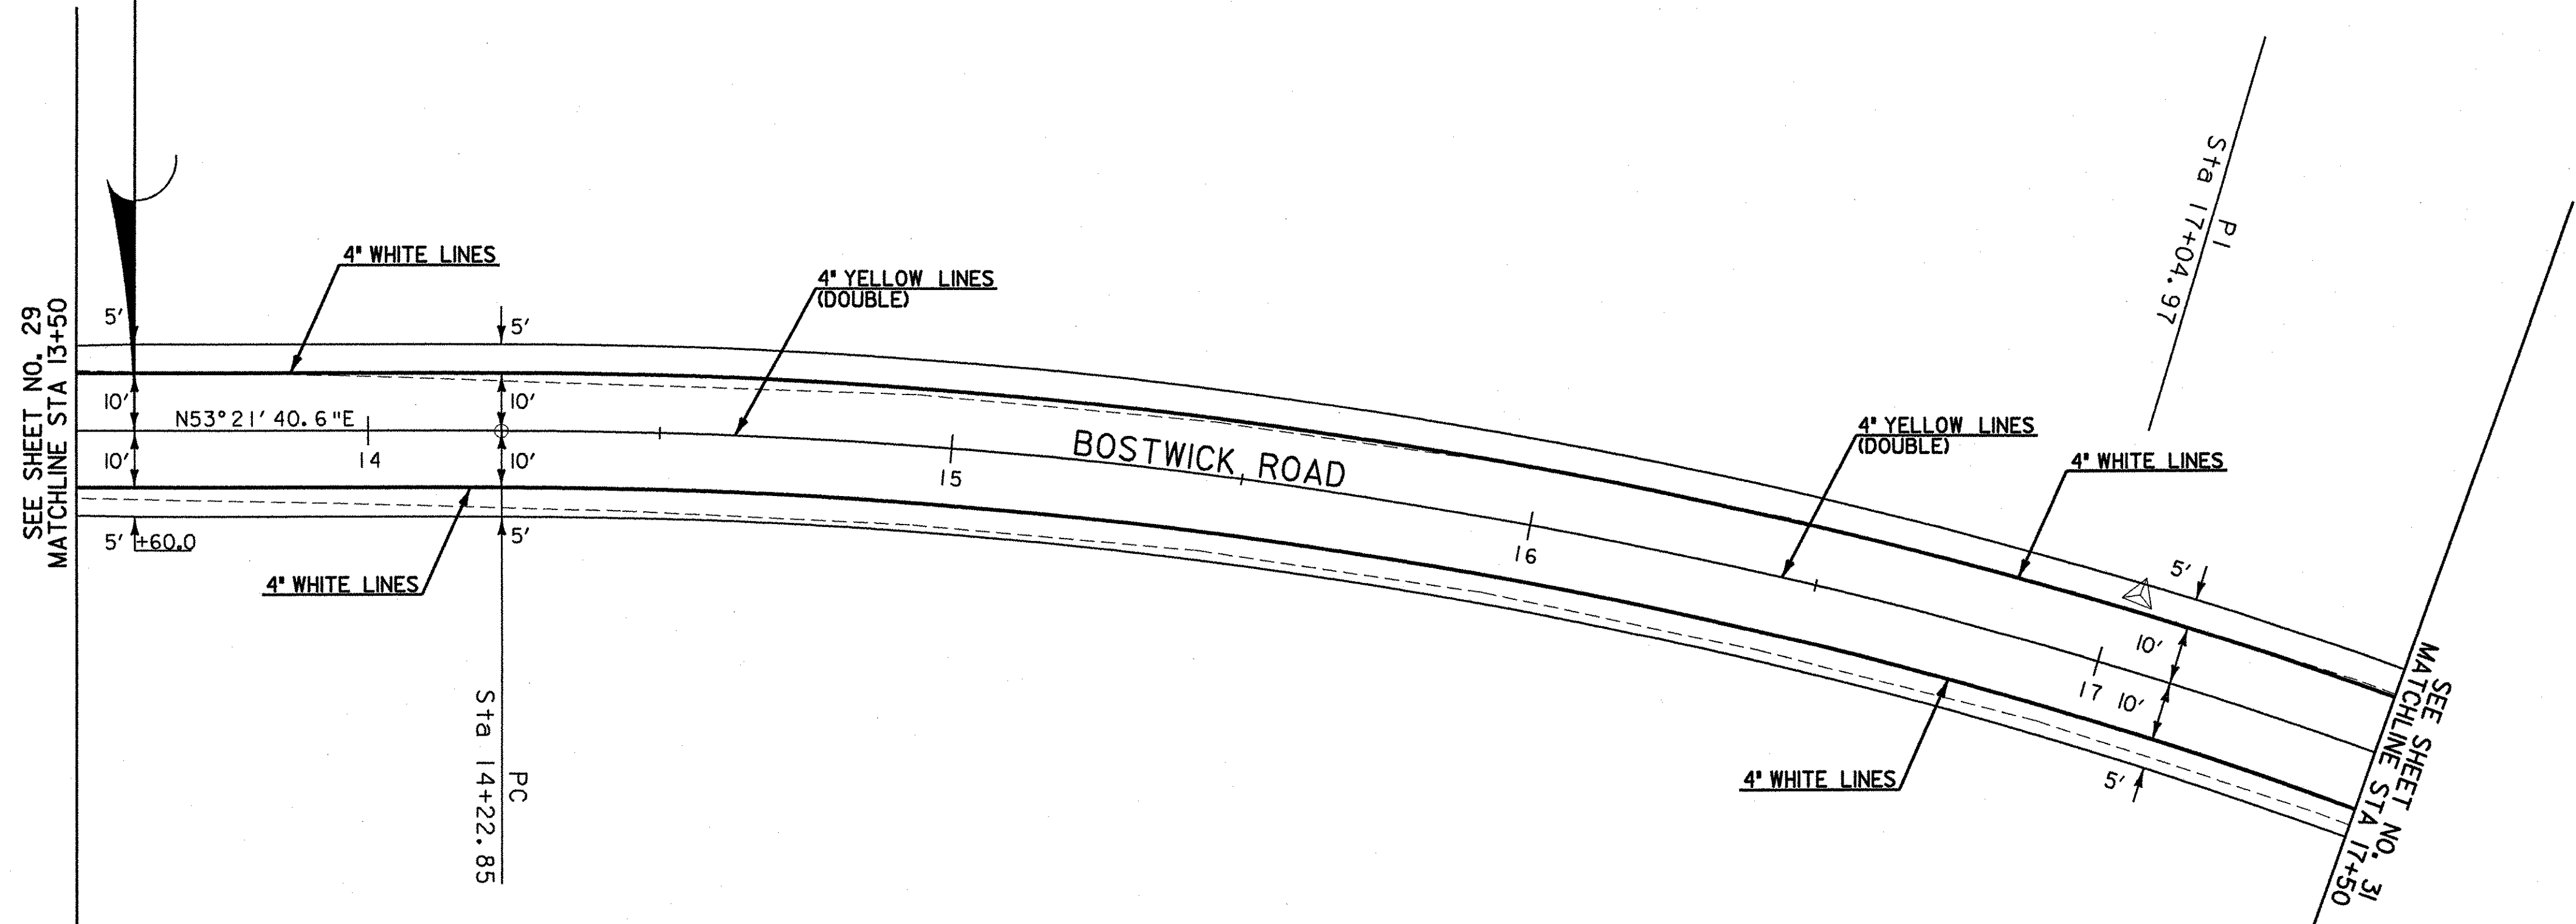


SIGN LEGEND
 R = REMOVE
 S = SALVAGE
 RR = REMOVE AND RESET
 N = NEW
 RET = RETAIN
 B-B = BACK TO BACK
 T-T = THINNING AND TRIMMING
 EXISTING =
 NEW =

DATUM
 VERTICAL NAVD 88
 HORIZONTAL NAD 83 (1996)

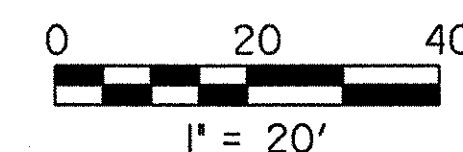


ALIGNMENT SIGNING AND STRIPING	PROJECT NAME: SHELBURNE
	PROJECT NUMBER: BRO 1445(30)
	FILE NAME: M:\595402 Bostwick\HWY\DRAW\SGNPLNS\sgn002.dgn
	PROJECT LEADER: MBZ PLOT DATE: 01-AUG-2003
DESIGNED BY: DMB DRAWN BY: MJF	
CHECKED BY: MDL SHEET 30 OF 73	

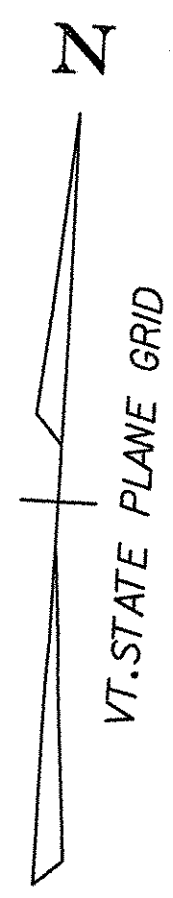

STA 41+00.00
LIMIT OF WORK

STA 20+00.88
STOP ROADWAY
BEGIN BRIDGE

STA 20+93.19
END BRIDGE
RESUME ROADWAY

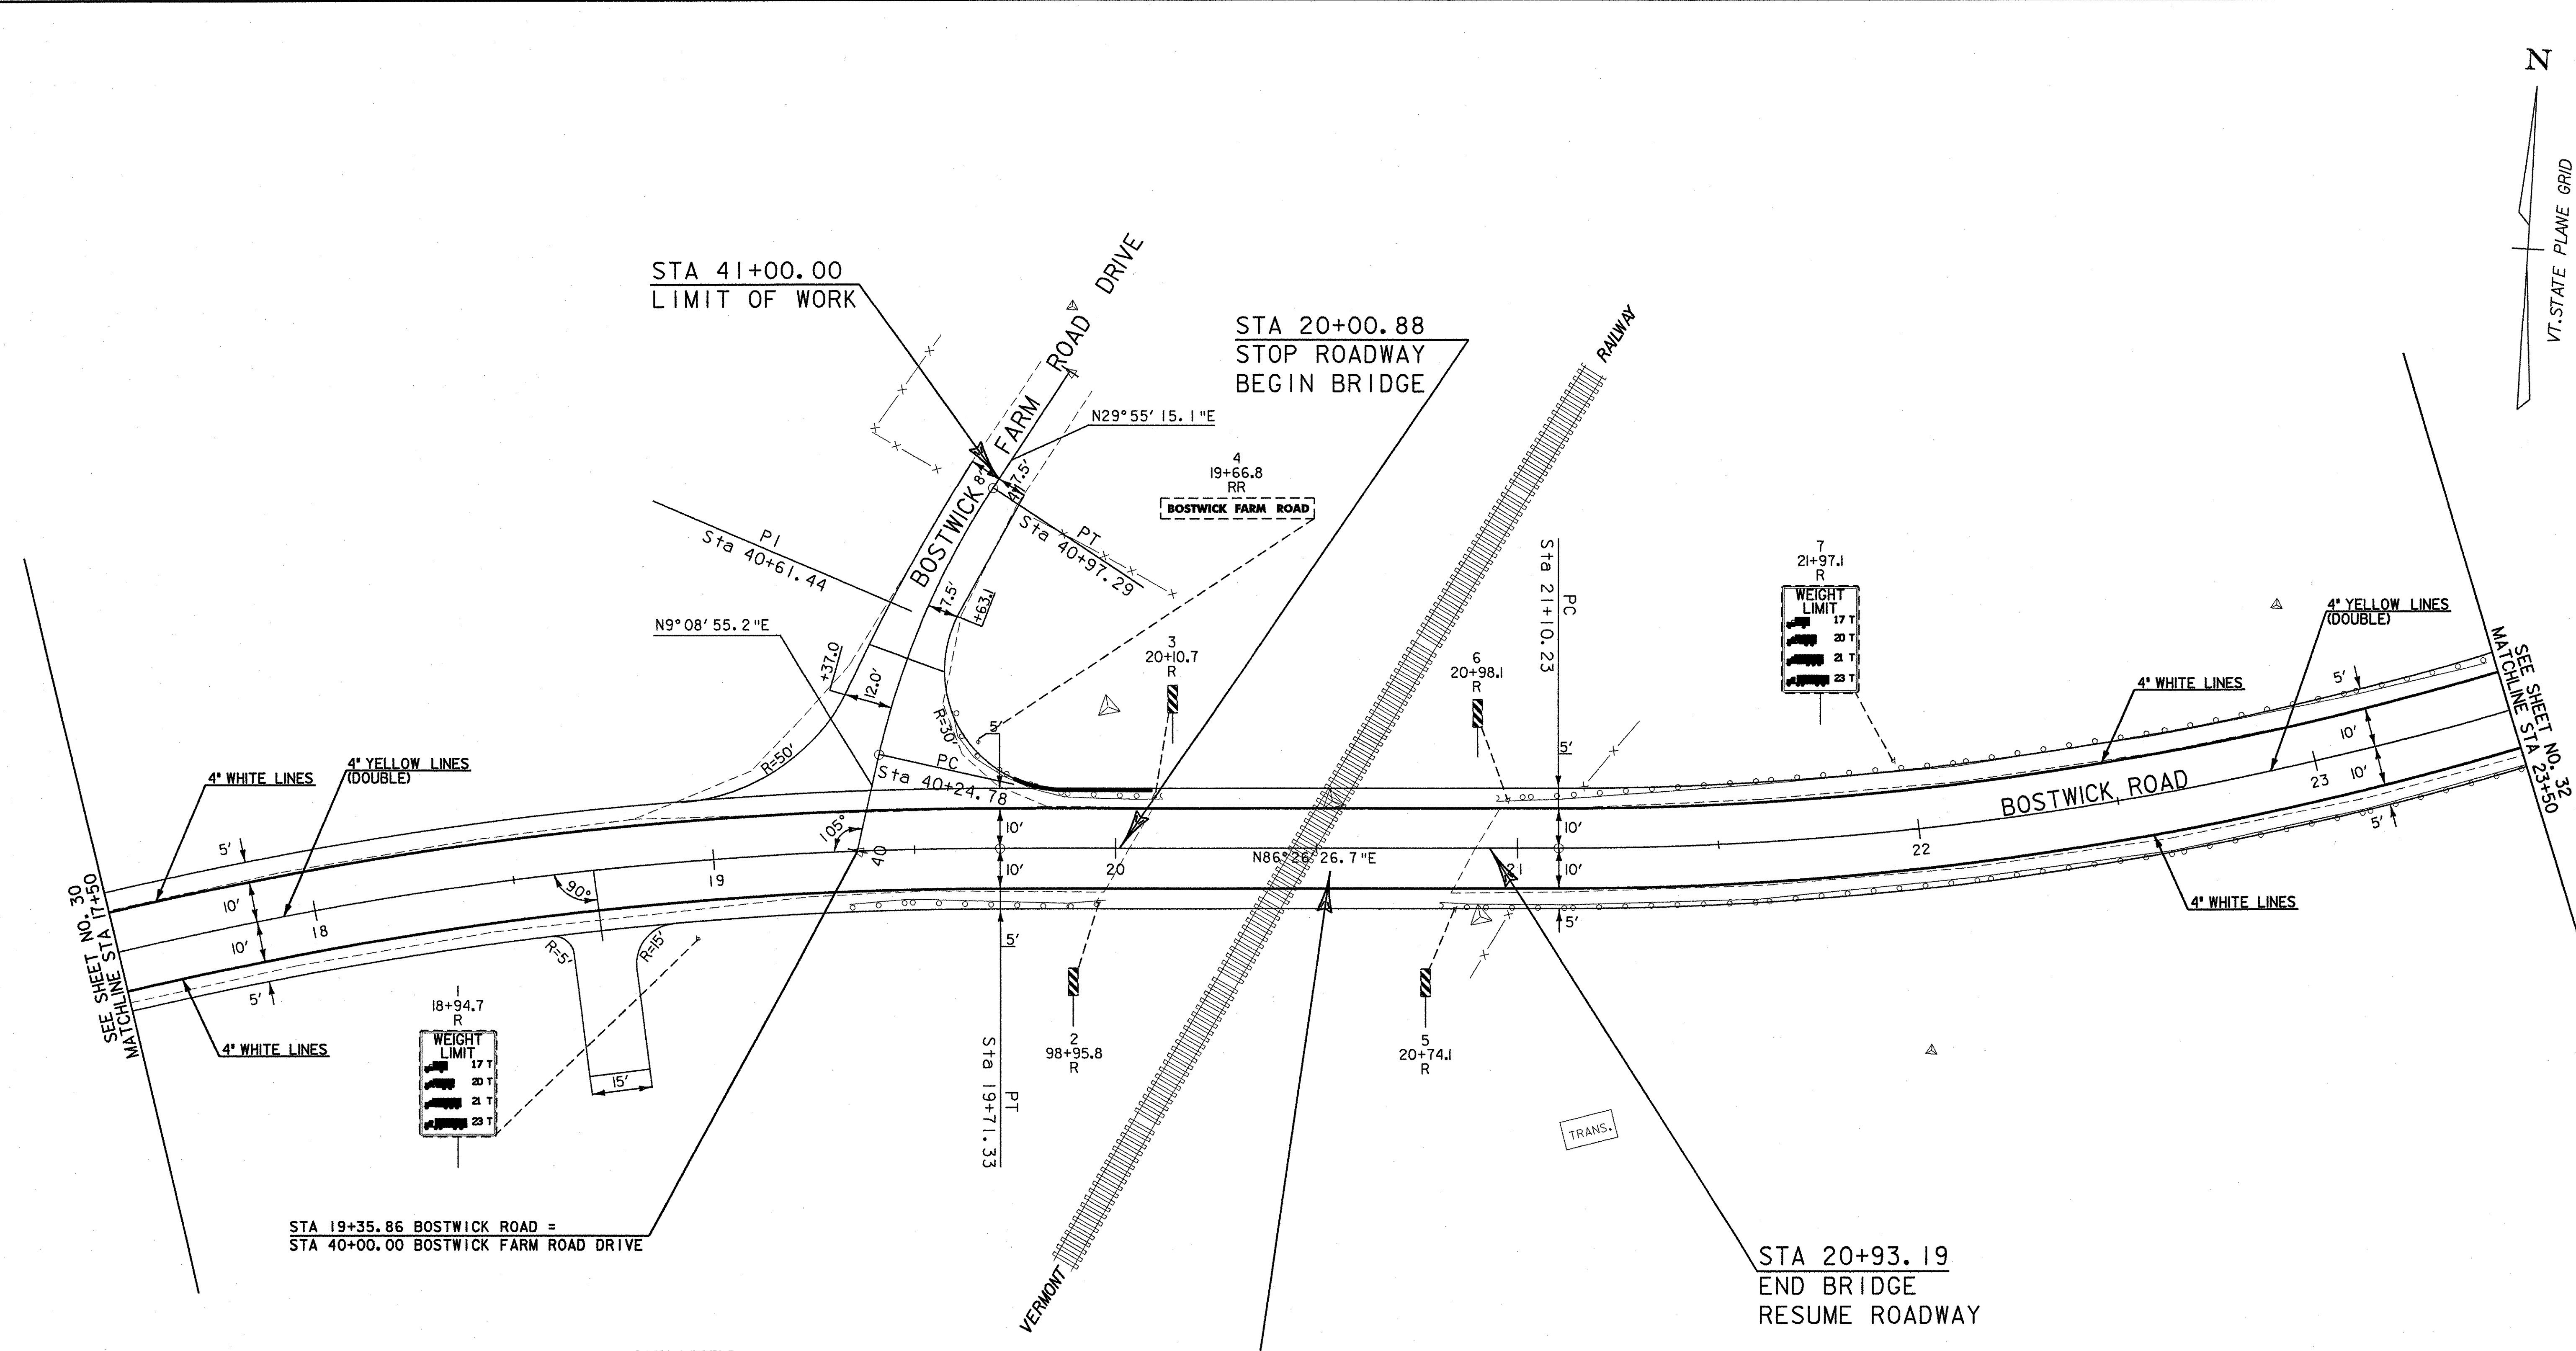

SEE SHEET NO. 30
MATCHLINE STA 17+50


SEE SHEET NO. 32
MATCHLINE STA 23+50

STA 19+35.86 BOSTWICK ROAD =
STA 40+00.00 BOSTWICK FARM ROAD DRIVE

- SIGN LEGEND**
- R = REMOVE
 - S = SALVAGE
 - RR = REMOVE AND RESET
 - N = NEW
 - RET = RETAIN
 - B-B = BACK TO BACK
 - T-T = THINNING AND TRIMMING
- EXISTING =
- NEW =

WEIGHT LIMIT	
17 T	
20 T	
21 T	
23 T	


WEIGHT LIMIT	
17 T	
20 T	
21 T	
23 T	

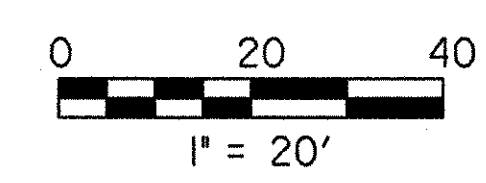

**ALIGNMENT
SIGNING
AND
STRIPING**


PROJECT NAME:	SHELBURNE		
PROJECT NUMBER:	BRO 1445(30)		
FILE NAME:	M:\1595402 Bostwick\HWY\DRAW\SGNPLNS\sgn003.dgn	PROJECT LEADER:	MBZ
DESIGNED BY:	DMB	DESIGNED BY:	DMB
CHECKED BY:	MDL	DESIGNED BY:	DMB
		PLOT DATE:	01-AUG-2003
		DRAWN BY:	MJF
		CHECKED BY:	MDL
		SHEET	31 OF 73

DATUM	
VERTICAL	NAVD 88
HORIZONTAL	NAD 83 (1996)

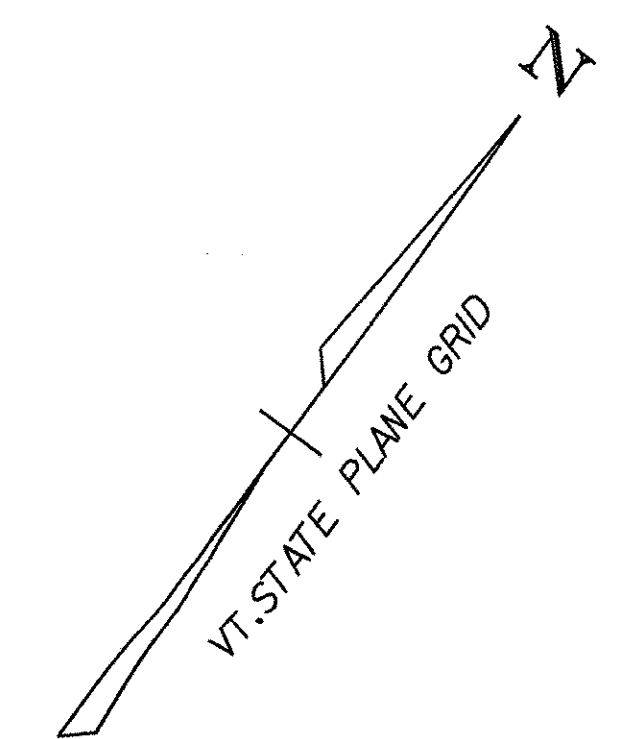


STA 28+25.00
 END APPROACH CONSTRUCTION
 MATCH EXISTING PAVEMENT

STA 26+75.00
 END PROJECT BRO 1445 (30)
 BEGIN APPROACH CONSTRUCTION

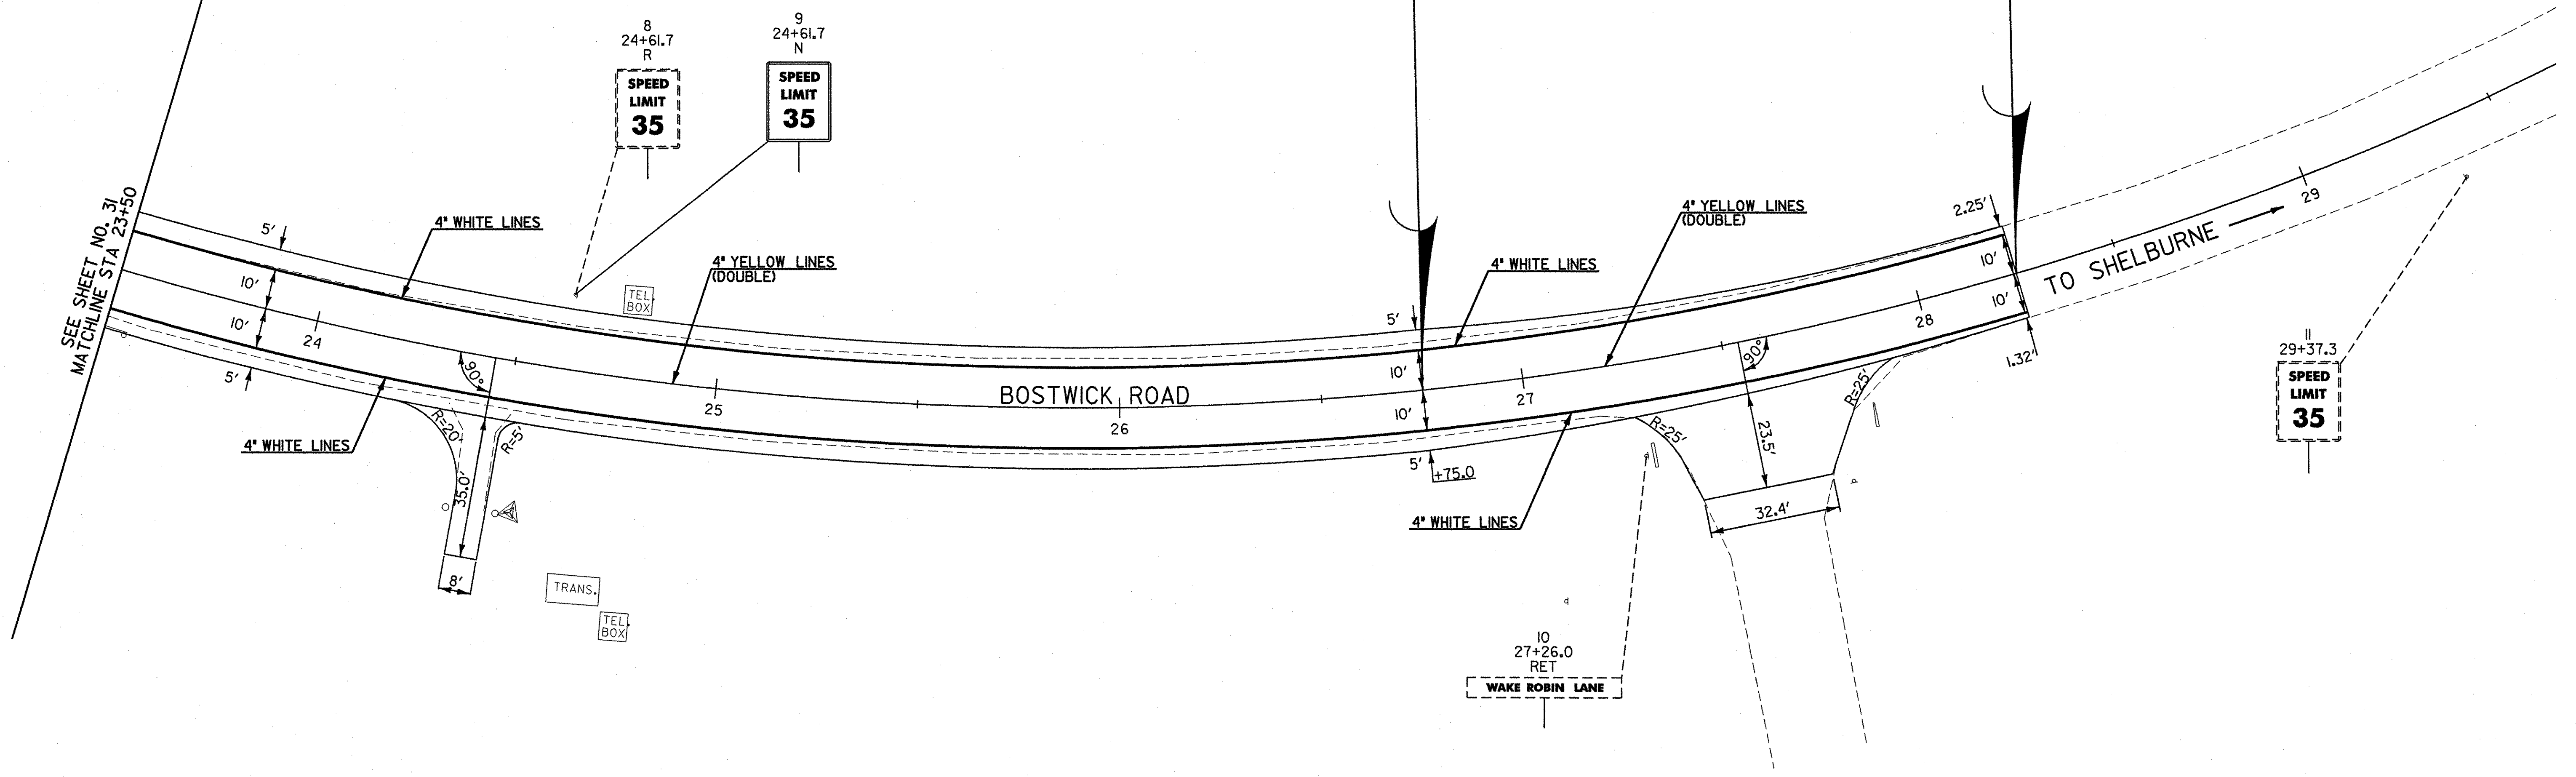

SIGN LEGEND
 R = REMOVE
 S = SALVAGE
 RR = REMOVE AND RESET
 N = NEW
 RET = RETAIN
 B-B = BACK TO BACK
 T-T = THINNING AND TRIMMING
 EXISTING =
 NEW =

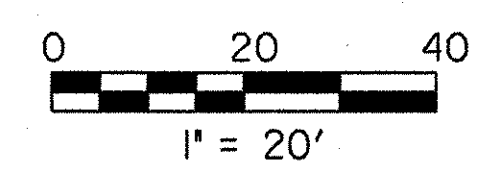


PI
 Sta 26+63.21

DATUM
 VERTICAL NAVD 88
 HORIZONTAL NAD 83 (1996)

ALIGNMENT
 SIGNING
 AND
 STRIPING

PROJECT NAME:	SHELBURNE
PROJECT NUMBER:	BRO 1445(30)
FILE NAME:	M:\1595402 Bostwick\HWY\DRAW\SGNPLNS\sgn004.dgn
PROJECT LEADER:	MBZ
DESIGNED BY:	DMB
CHECKED BY:	MDL
PLOT DATE:	01-AUG-2003
DRAWN BY:	MJF
SHEET	32 OF 73



STATE OF VERMONT
 AGENCY OF TRANSPORTATION **TRAFFIC SIGN SUMMARY SHEET**






MILEMARKER, STATION, OR SIGN NUMBER	SIGN LEGEND	SIGN DIMENSIONS		NEW & SALVAGED SIGNS				EXISTING POST	NO. OF POSTS	NEW SIGN POSTS																		REMARKS	SIGN DETAIL	
		WIDTH (in)	HEIGHT (in)	"A"	"B"	SALV SIGN	SALV TIS			FLANGED CHANNEL			SQUARE STEEL (in)			TUBULAR ALUMINUM (in)			TUBULAR STEEL (in)			W-SHAPE STEEL			DETAIL ON SHEET NUMBER	STD. SHEET NUMBER				
										LW2	2.0	3.0	L75	2.0	2.5	3.0	4.0	4.0	3.0	3.5	4.0	5.0	FTG. SIZE	WEIGHT			POST SIZE			
60 24+61.7, LT		24	30	5				I																		R2-1	E-142M			
00 19+66.8, LT	BOSTWICK FARM ROAD							I																						
29 27+26.0, RT	WAKE ROBIN LANE							I																						
										OPTION ITEMS																				
										FT	FT	FT	FT	FT	FT	EA	LB	LB	LB	LB	LB	LB	EA	EA	LB					
										TOTALS	SF	SF	EA	SF		FT	FT	LB	EA	LB	EA	EA	LB							
											5	2			35															

FINAL POST LENGTHS ARE TO BE DETERMINED IN THE FIELD. POST SIZES ARE COMPUTED BASED ON INFORMATION FURNISHED ON THE STANDARD SHEETS AND THE TRAFFIC & SAFETY DIVISION'S 'SIGN POST DESIGN GUIDELINE.'

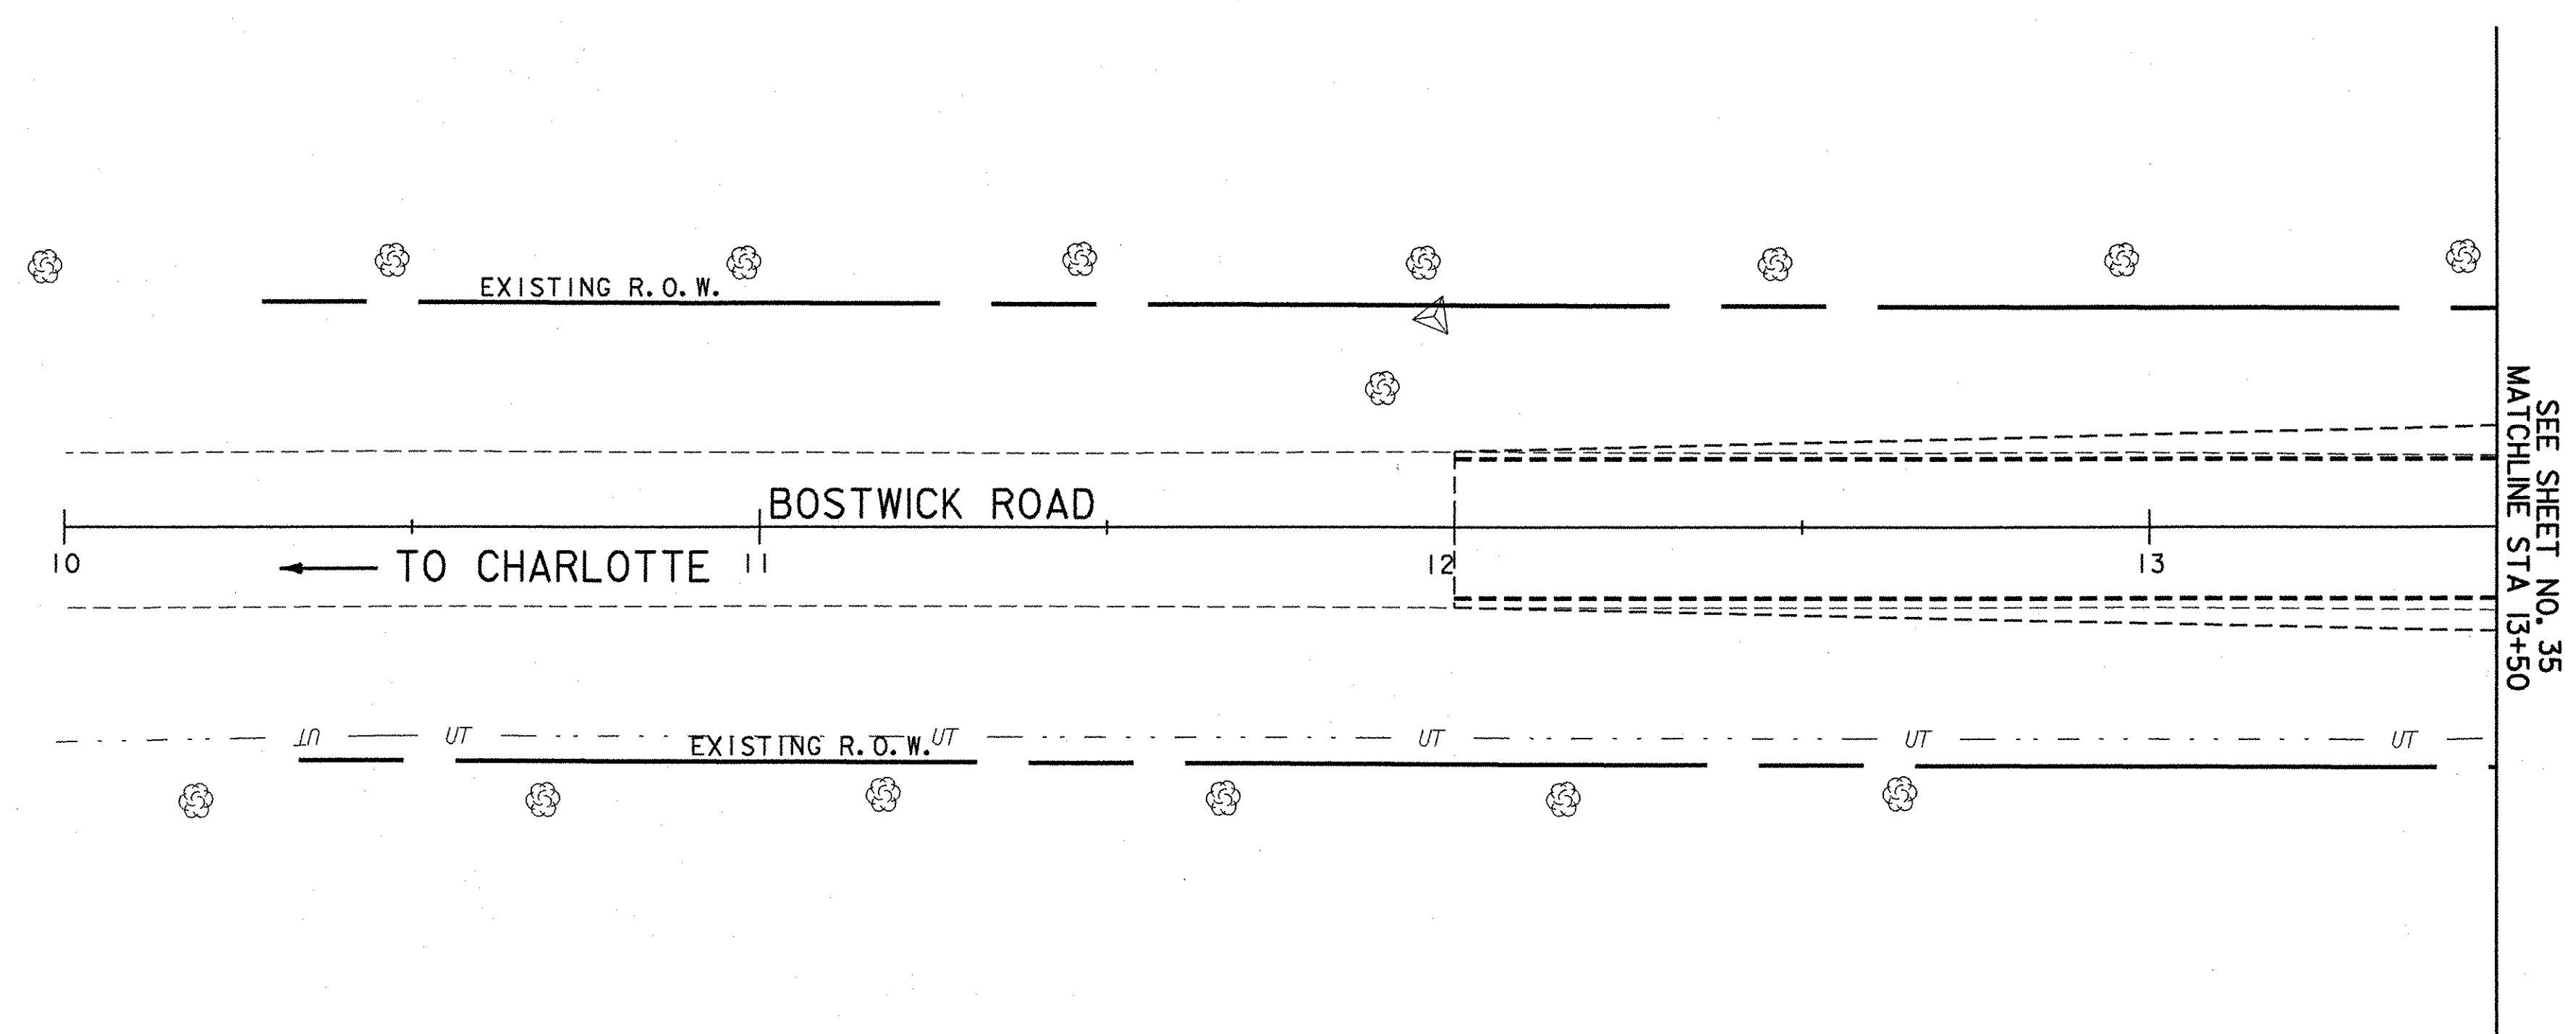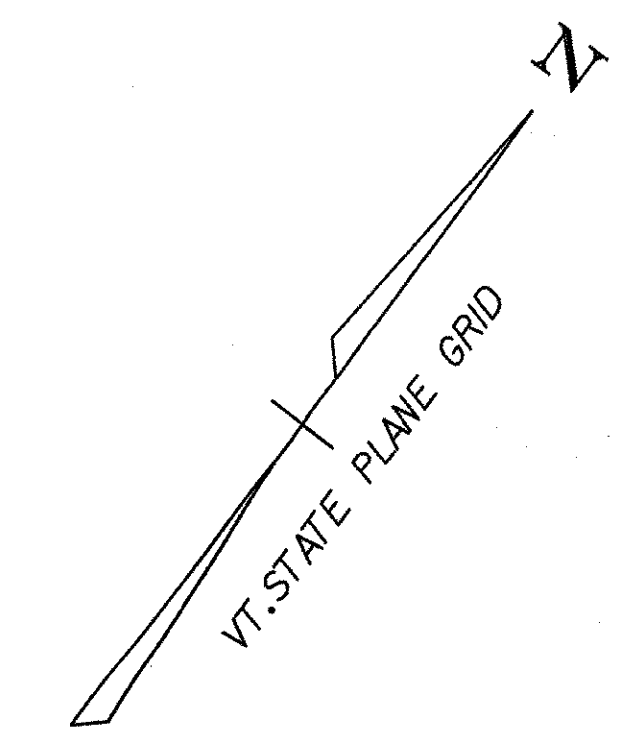
DATUM
 VERTICAL NAVD 88
 HORIZONTAL NAD 83 (1996)

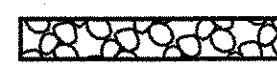QUANTITY SHEET
 PROJECT NAME: SHELBURNE
 PROJECT NUMBER: BRO 1445(30)
 FILE NAME: M:\1595402 Bostwick\HWY\DRAW\SGNPLNS\signsum.dgn
 PROJECT LEADER: MBZ
 DESIGNED BY: DMB
 CHECKED BY: MDL
 PLOT DATE: 01-AUG-2003
 DRAWN BY: MJF
 SHEET 33 OF 73





-  STONE DITCH
-  WETLANDS
-  EROSION MATTING
-  HAYBALES
-  STONE CHECK DAM


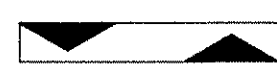


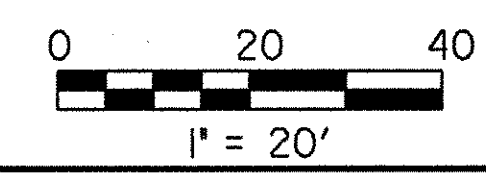
DATUM
 VERTICAL NAVD 88
 HORIZONTAL NAD 83 (1996)




DETOUR LAYOUT SHEET	PROJECT NAME: SHELBURNE
	PROJECT NUMBER: BRO 1445(30)
	FILE NAME: M:\595402 Bostwick\HWY\DRAW\DETPLN\det001.dgn
	PROJECT LEADER: MBZ
DESIGNED BY: DMB	PLOT DATE: 01-AUG-2003
CHECKED BY: MDL	DRAWN BY: MJF
	SHEET 34 OF 73

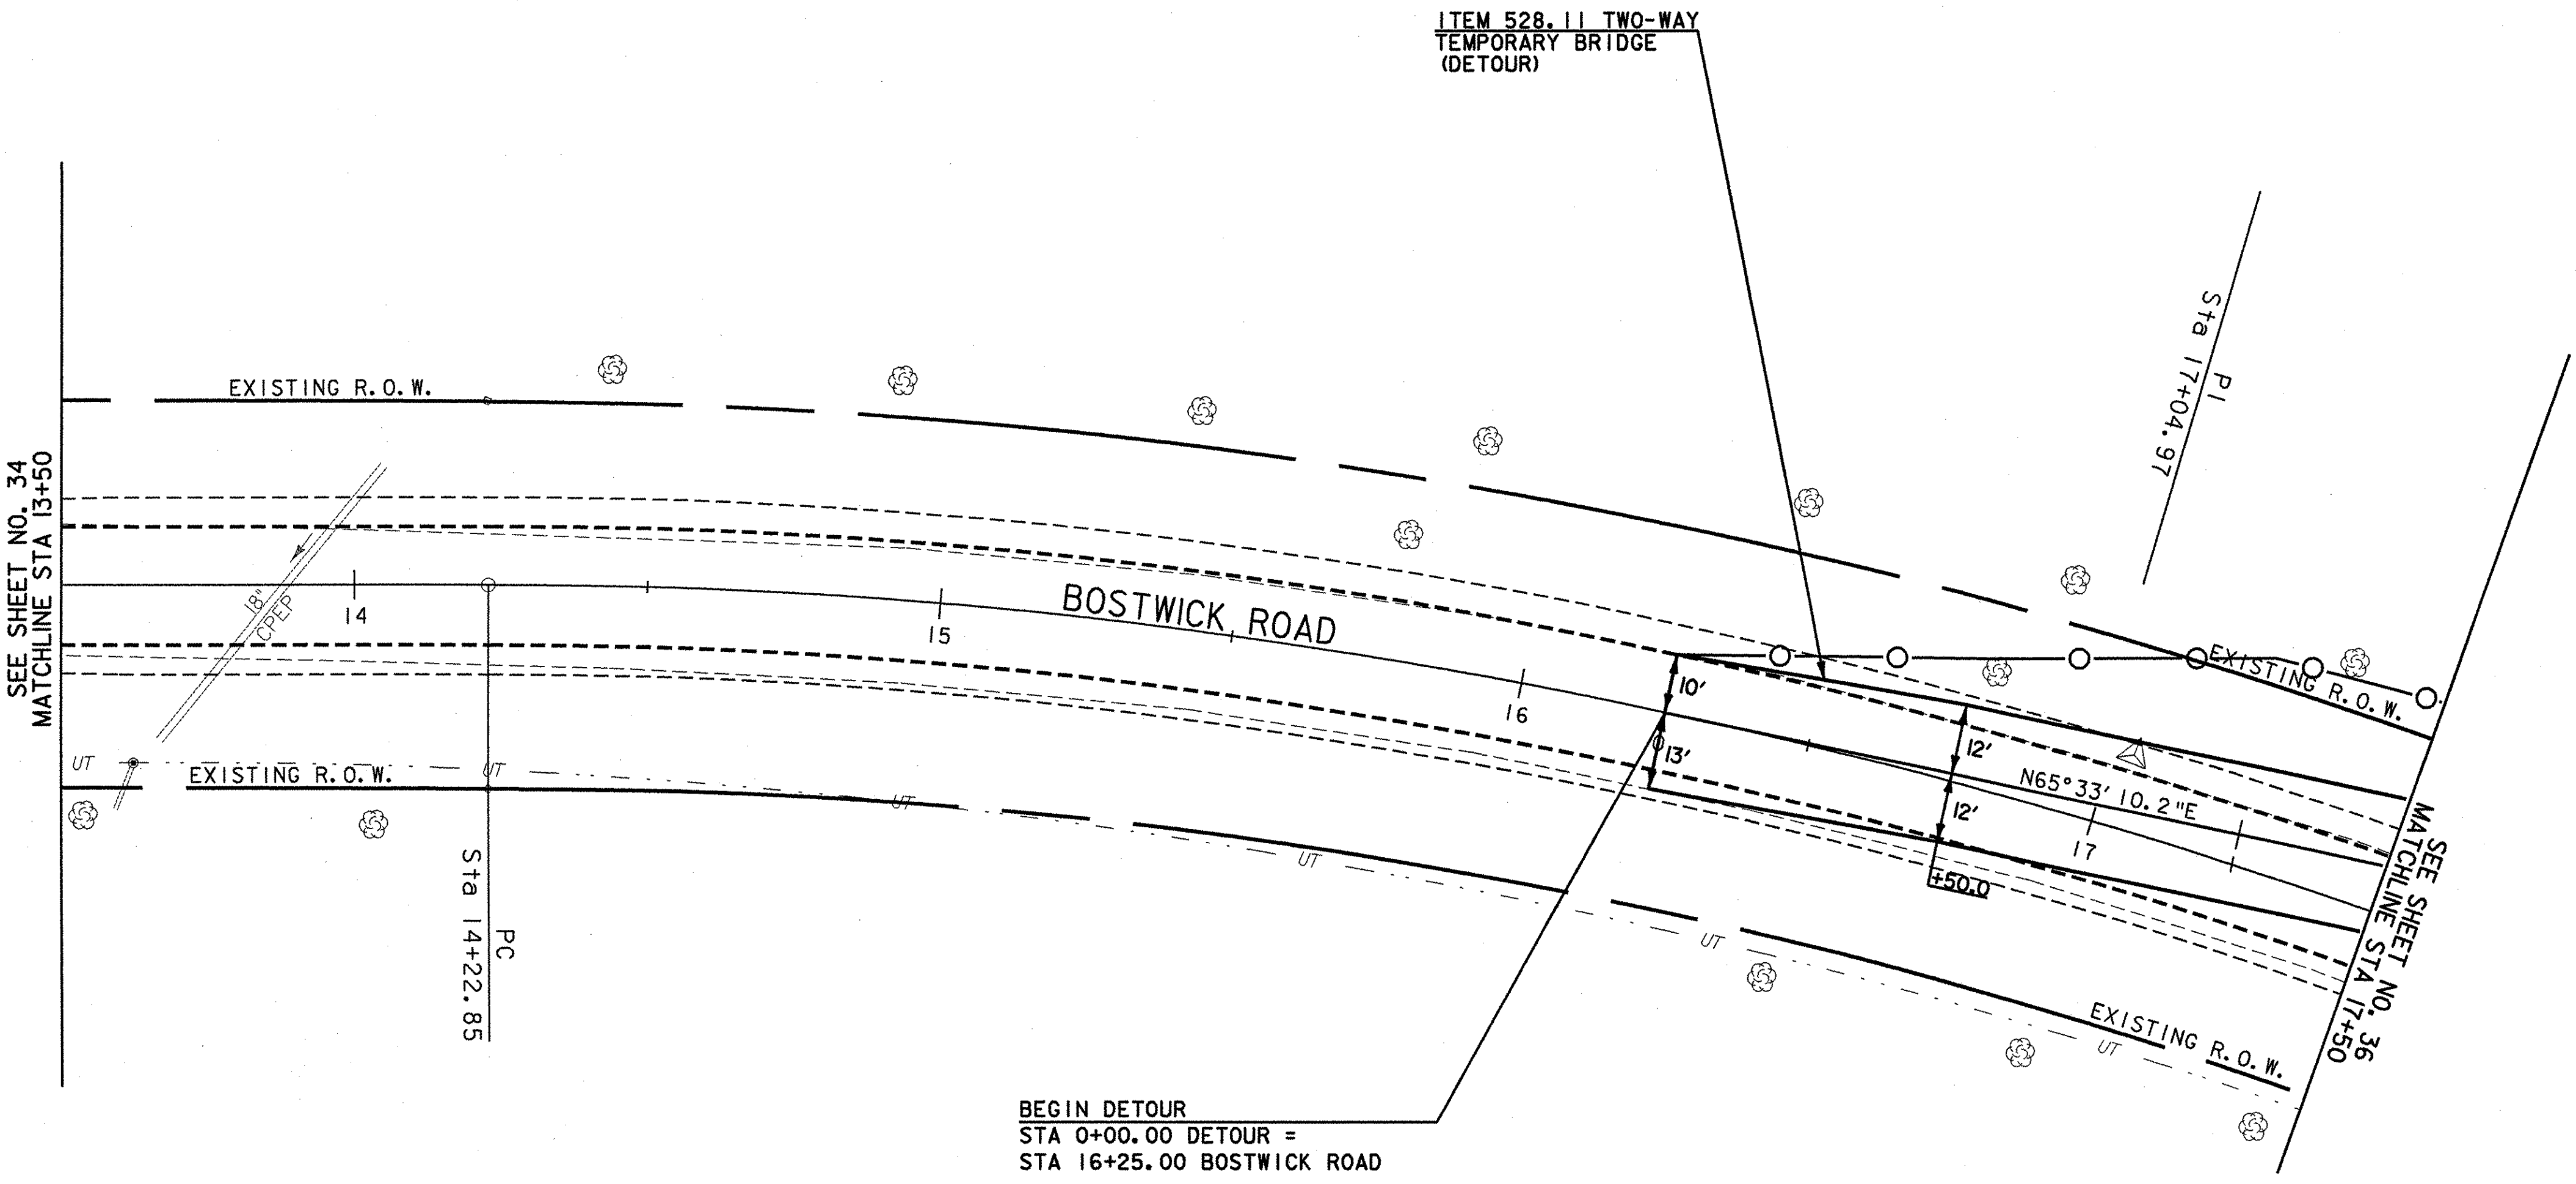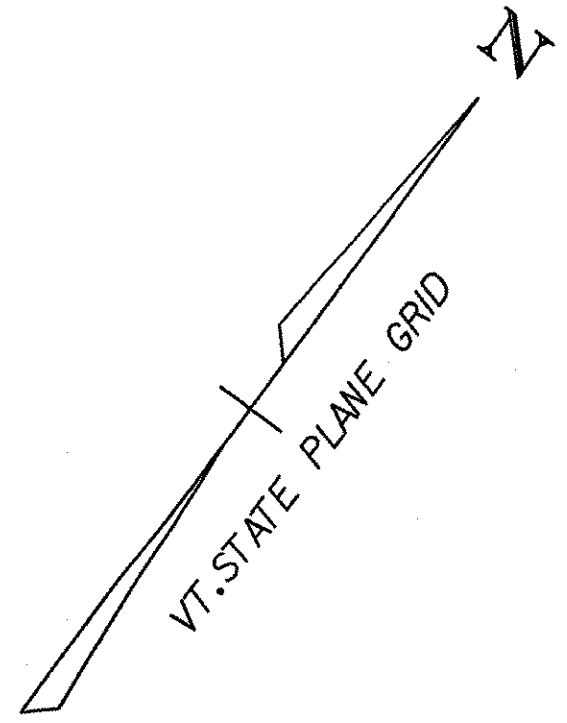DETOUR CURVE DATA	
CURVE #1	
PI	= 3+09.26
Δ	= 20°53' 16.6"RT
R	= 477.00'
T	= 87.92'
L	= 173.90'
E	= 8.04'
BANK	= NONE



-  STONE DITCH
-  WETLANDS
-  EROSION MATTING
-  HAYBALES
-  STONE CHECK DAM



DATUM	
VERTICAL	NAVD 88
HORIZONTAL	NAD 83 (1996)

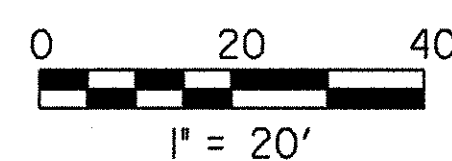

DETOUR LAYOUT SHEET	PROJECT NAME: SHELBURNE
	PROJECT NUMBER: BRO 1445(30)
	FILE NAME: M:\1595402 Bostwick\HWY\DRAW\DETPLN\det002.dgn
	PROJECT LEADER: MBZ
DESIGNED BY: DMB	PLOT DATE: 01-AUG-2003
CHECKED BY: MDL	DRAWN BY: MJF
	SHEET 35 OF 73

GEOTEXTILE FOR SILT FENCE	
3+90, LT - 3+90, RT	
5+20, RT - 6+00, LT	

DETOUR CURVE DATA	
CURVE #2	
PI = 8+02.84	
$\Delta = 30^{\circ}21'31.7''$ LT	
R = 477.00'	
T = 129.41'	
L = 252.74'	
E = 17.24'	
BANK = VARIES	

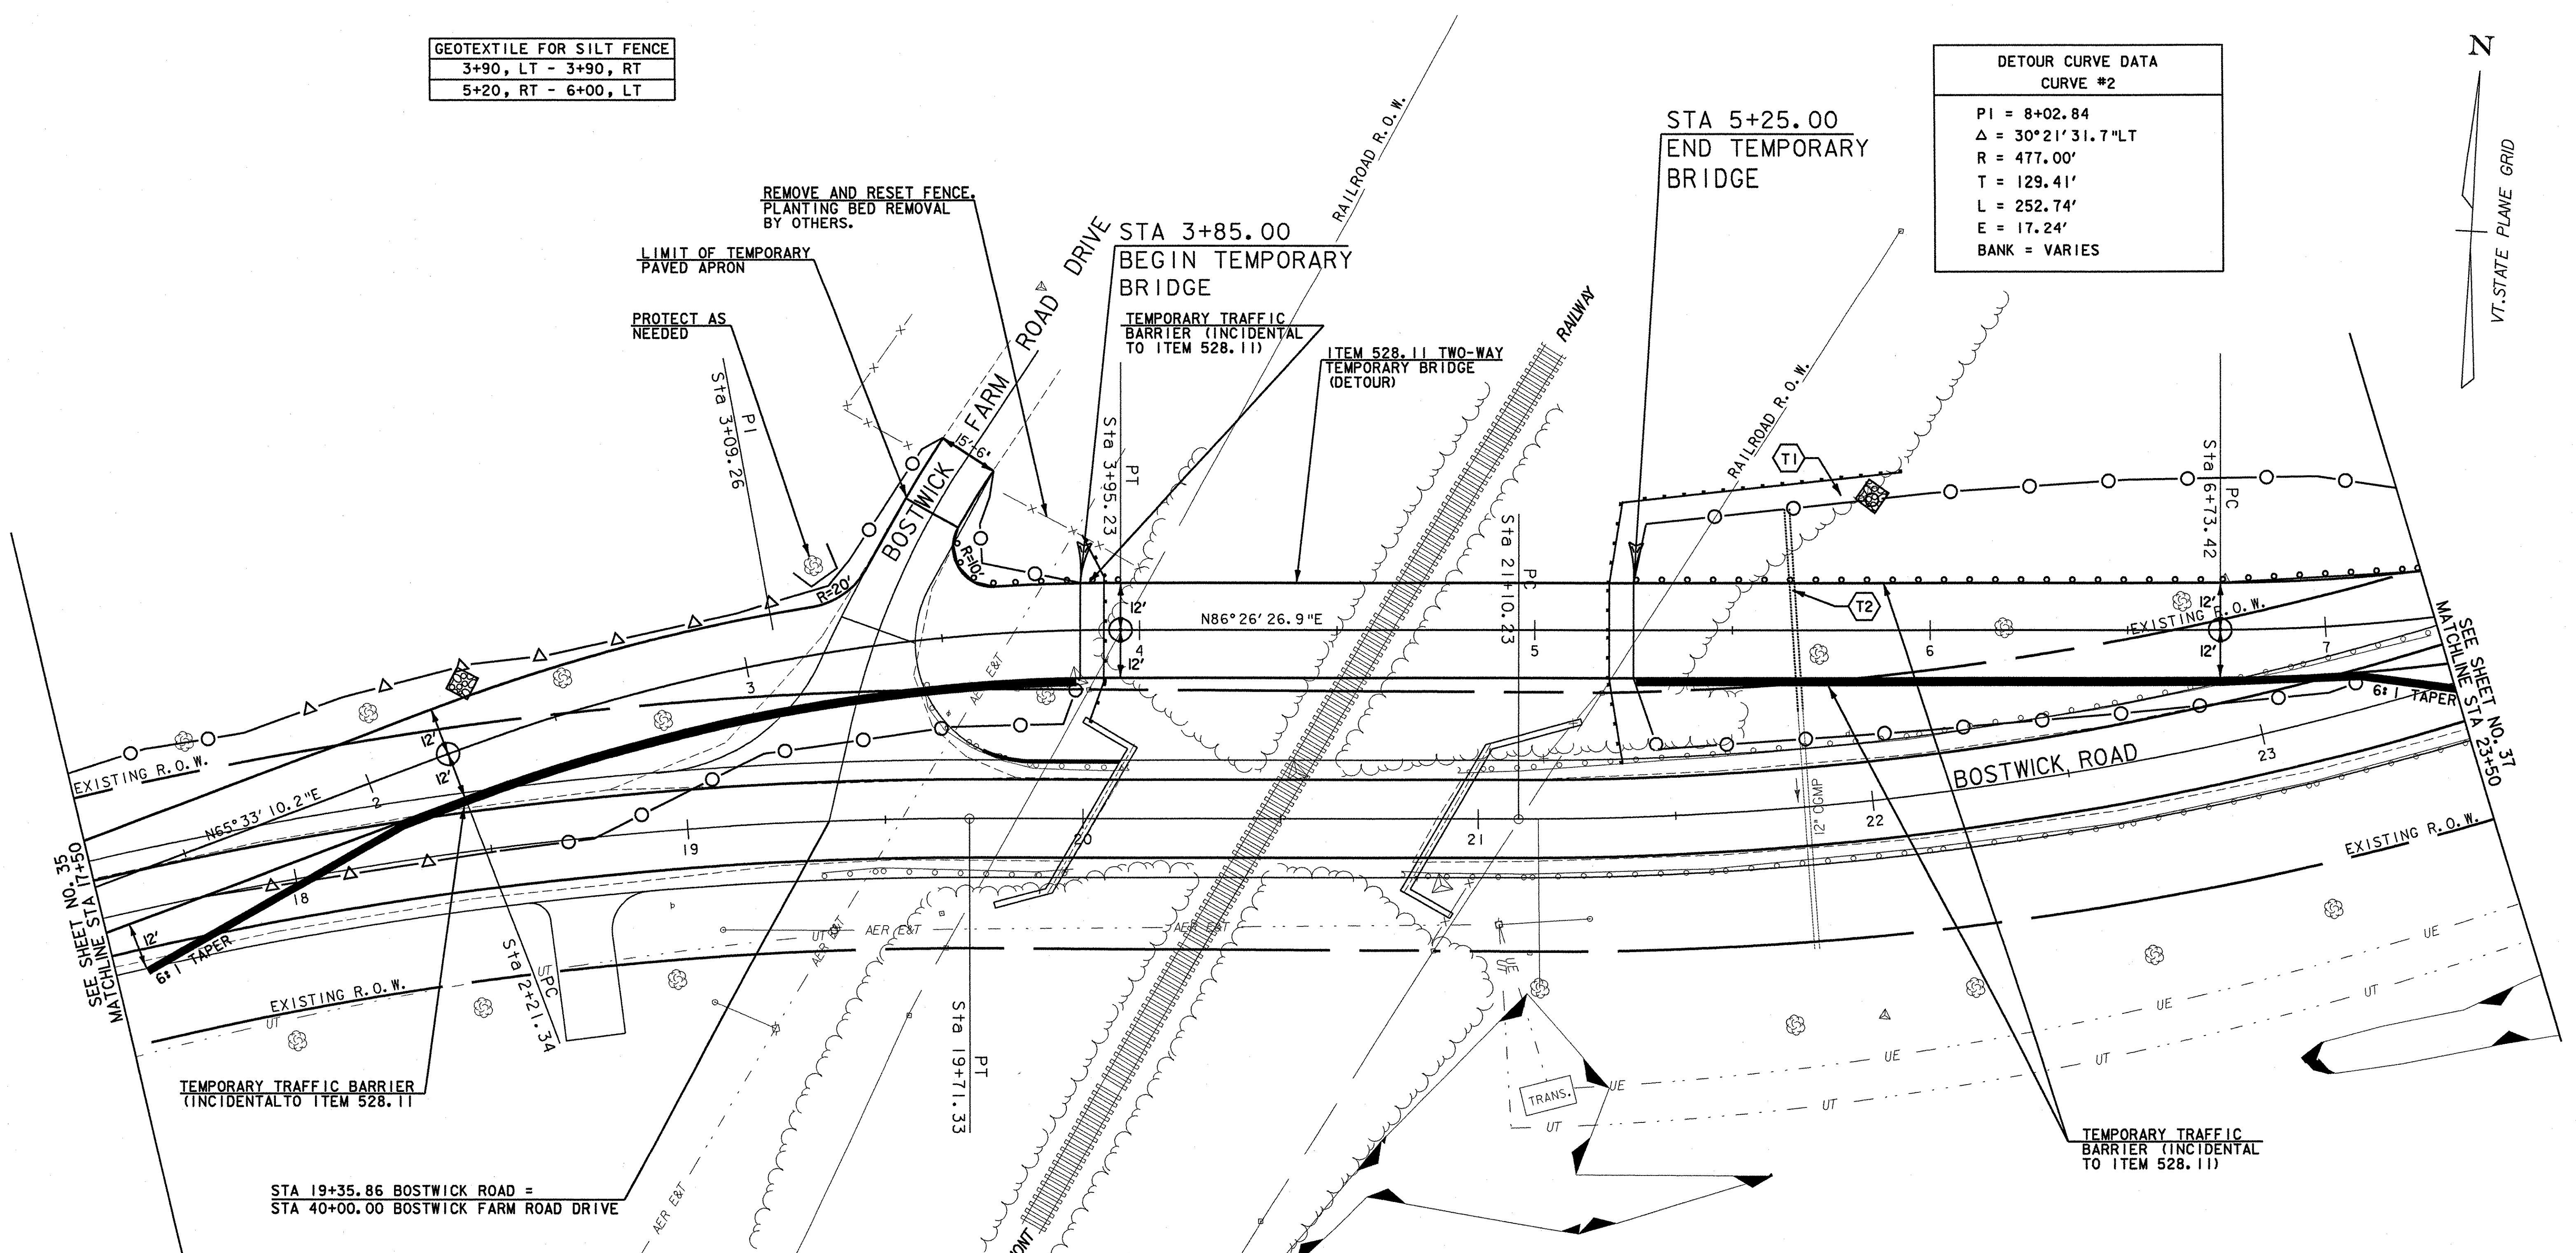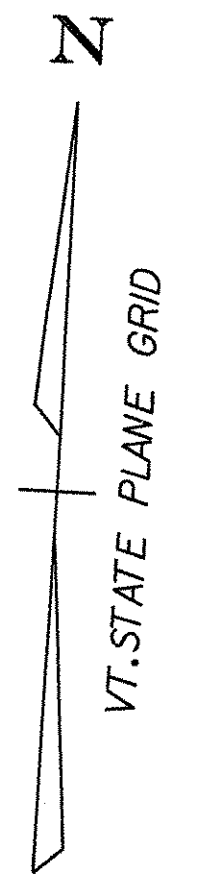


- (T1) STA 21+75, LT TO STA 22+75, LT
CONSTRUCT 100' OF TOE OF SLOPE DITCH
(SEE CROSS SECTIONS AND DRAINAGE DETAIL SHEET)
INCIDENTAL TO ITEM 528.11
- (T2) STA 21+84, LT 34.5 TO STA 21+85, LT 75.6
CONSTRUCT 12' x 5' CGMP EXTENSION
INCIDENTAL TO ITEM 528.11

- STONE DITCH
- WETLANDS
- EROSION MATTING
- HAYBALES
- STONE CHECK DAM

GENERAL NOTES:



1. THE EXISTING BRIDGE HAS BEEN RECONFIGURED TO OPERATE AS A SIGNALIZED ALTERNATING ONE-WAY ROAD. THIS WORK IS NOT REFLECTED IN THE EXISTING DETAIL SHOWN ON THE LAYOUT PLANS.
2. VTTRANS DISTRICT 5 FORCES WILL REMOVE THE TEMPORARY TRAFFIC SIGNALS AFTER THE TWO-WAY TEMPORARY BRIDGE IS OPENED. THE CONTRACTOR SHALL CONTACT THE DISTRICT 5 ADMINISTRATOR TWO WEEKS PRIOR TO THE OPENING OF THE TEMPORARY BRIDGE.
3. THE CONTRACTOR SHALL SALVAGE ALL SIGNS AND TEMPORARY BARRIER INSTALLED BY THE DISTRICT AND RETURN IT TO THE DISTRICT 5 OFFICE AT 5 BARNES AVENUE IN COLCHESTER. THE CONTRACTOR SHALL SALVAGE ALL PLYWOOD AND DIMENSIONAL LUMBER TO DISTRICT 5 (REPLACING ANY MATERIALS DAMAGED DURING DEMOLITION). CONTRACTOR HAS THE OPTION OF PROVIDING AN EQUIVALENT AMOUNT OF LUMBER TO THE DISTRICT. THESE TASKS WILL BE INCIDENTAL TO ITEM 529.15 - REMOVAL OF STRUCTURE.
4. SEE LAYOUT PLANS FOR ADDITIONAL EROSION CONTROL MEASURES.
5. SEE LAYOUT PLANS FOR LANDSCAPING SAVE AND REMOVAL INFORMATION.
6. DETOUR TRAFFIC CONTROL TO FOLLOW STANDARD E-107, UNLESS OTHERWISE SHOWN ON THESE DRAWINGS. DETOUR DESIGN SPEED IS 25 MPH.
7. INCIDENTAL TO ITEM 528.11 IS THE ACQUISITION AND PLACEMENT OF APPROXIMATELY 2000 CUBIC YARDS OF EARTH BORROW AND THE EXCAVATION AND REMOVAL OF APPROXIMATELY 1540 CUBIC YARDS OF THAT MATERIAL AFTER THE COMPLETION OF THE PROJECT. (SEE CROSS SECTIONS).
8. MATERIAL PLACED AT THE ENDS OF THE TEMPORARY CONCRETE BARRIER BY THE DISTRICT WILL BE REMOVED BY THE CONTRACTOR. ITEM 203.15 - COMMON EXCAVATION.

DATUM	
VERTICAL	NAVD 88
HORIZONTAL	NAD 83 (1996)

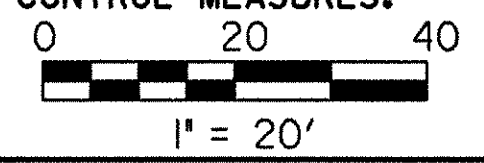
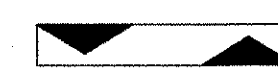





DETOUR LAYOUT SHEET

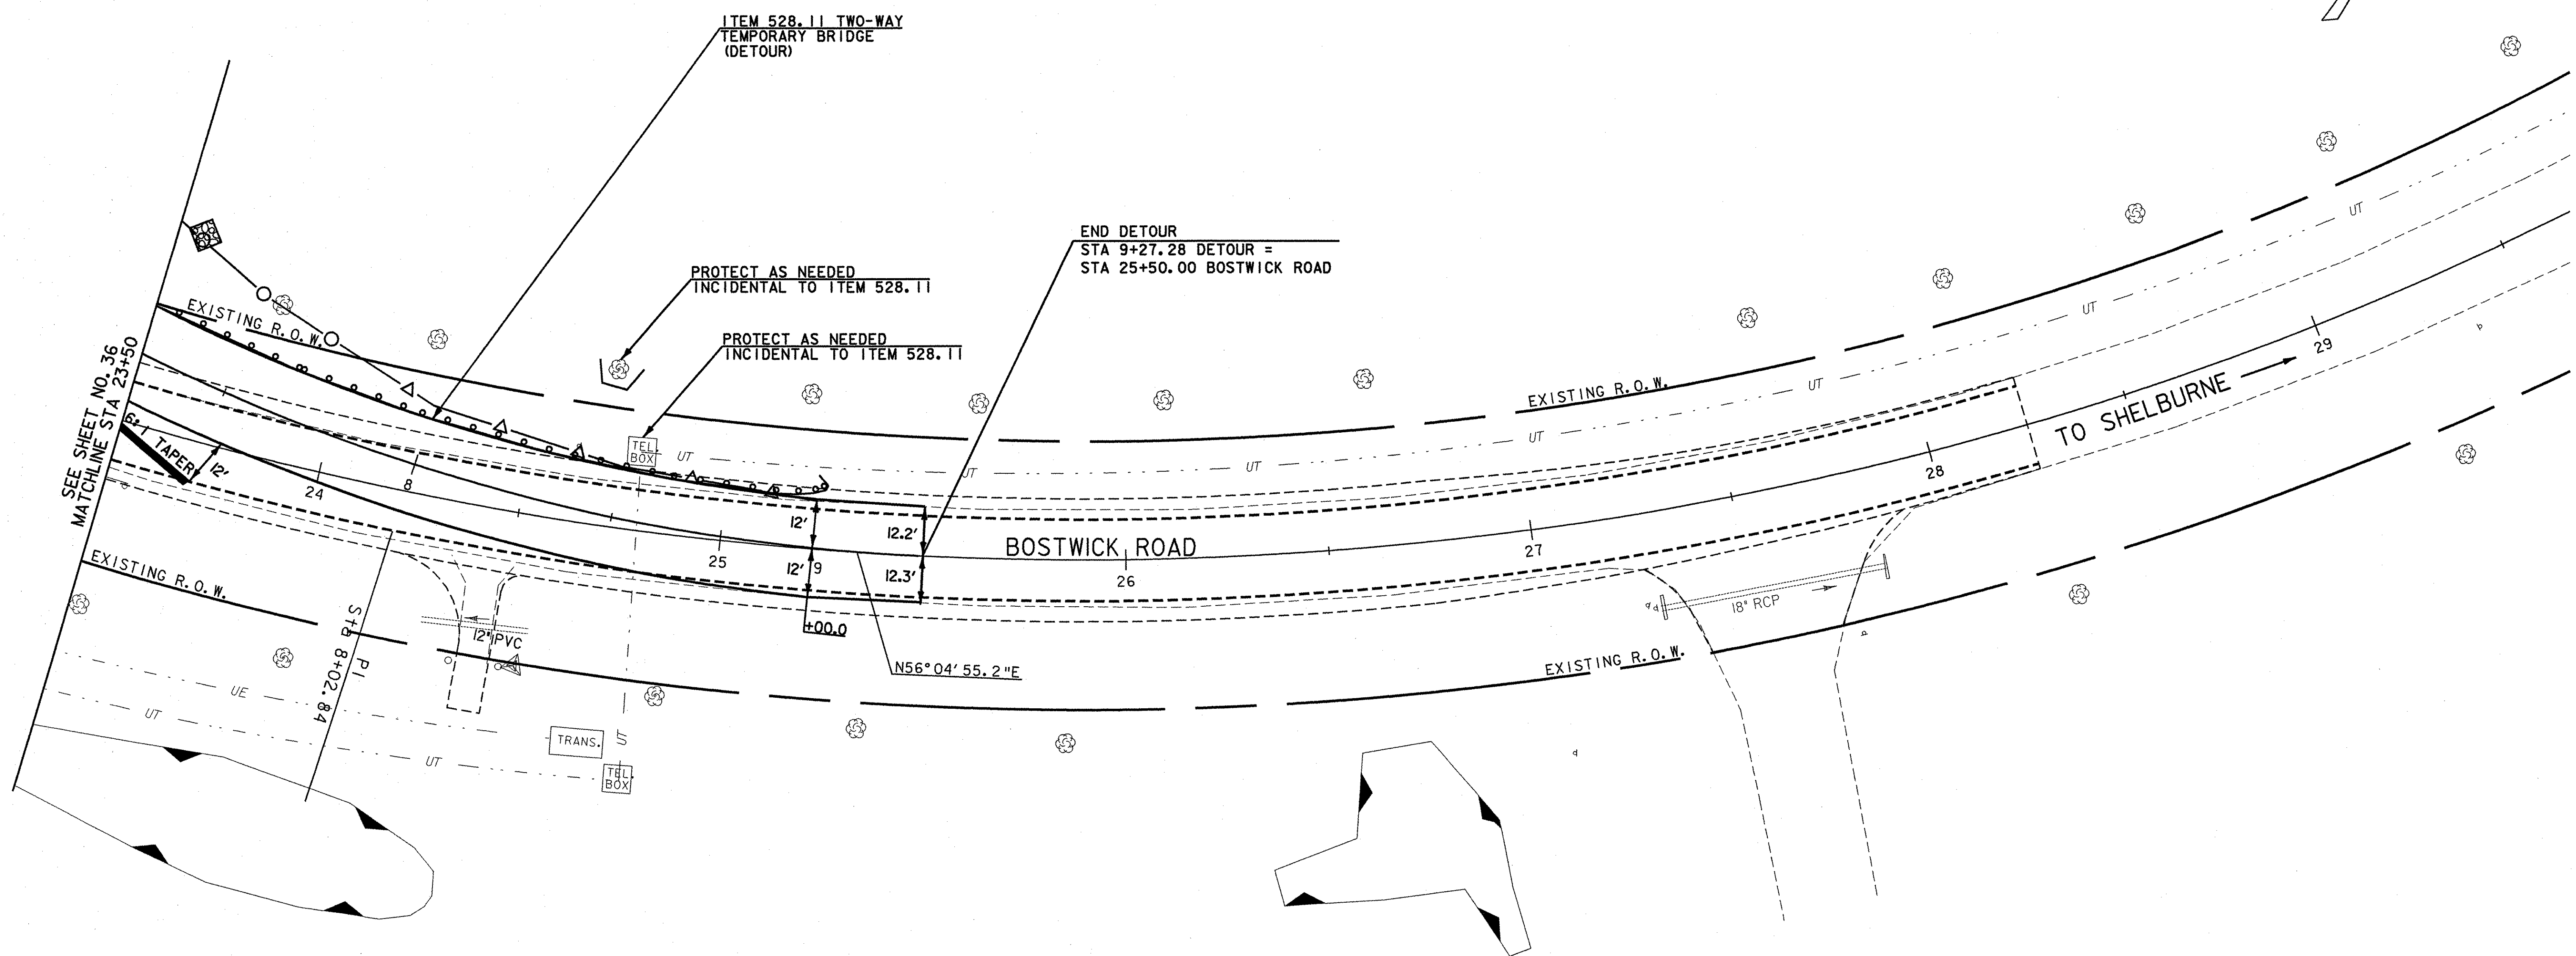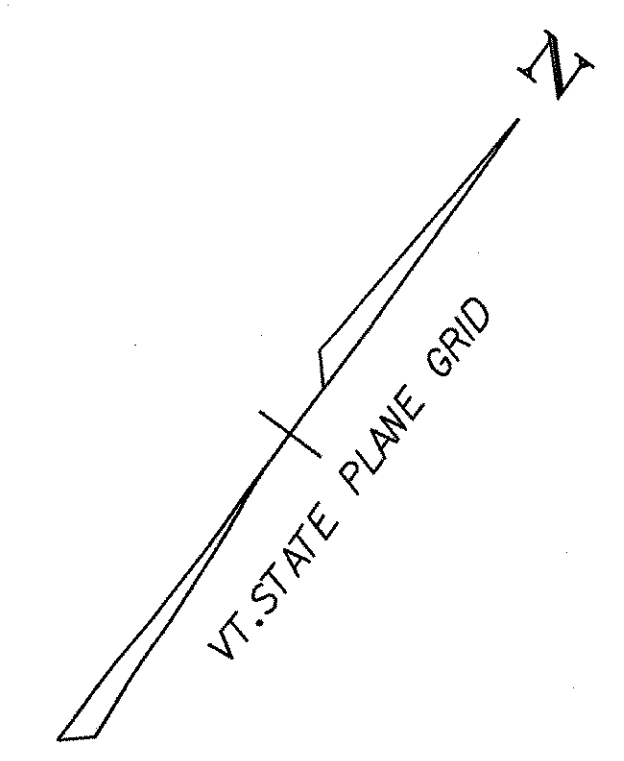
PROJECT NAME:	SHELBURNE
PROJECT NUMBER:	BRO 1445(30)
FILE NAME:	m:\595402 bostwick\hwy\DRAW\DETPN\det003.dgn
PROJECT LEADER:	MBZ
DESIGNED BY:	DMB
CHECKED BY:	MDL
PLOT DATE:	04-AUG-2003
DRAWN BY:	MJF
SHEET	36 OF 73



DATUM
 VERTICAL NAVD 88
 HORIZONTAL NAD 83 (1996)



-  STONE DITCH
-  WETLANDS
-  EROSION MATTING
-  HAYBALES
-  STONE CHECK DAM

PI
 Sta 26+63.21

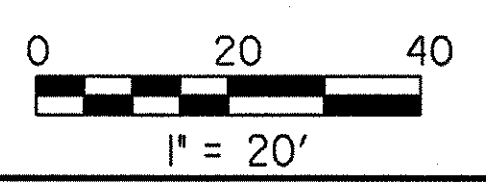

DETOUR
 LAYOUT
 SHEET

PROJECT NAME:	SHELBURNE
PROJECT NUMBER:	BRO 1445(30)
FILE NAME:	M:\1595402 Bostwick\HWY\DRAW\DETPN\de+004.dgn
PROJECT LEADER:	MBZ
DESIGNED BY:	DMB
CHECKED BY:	MDL
PLOT DATE:	01-AUG-2003
DRAWN BY:	MJF
SHEET	37 OF 73

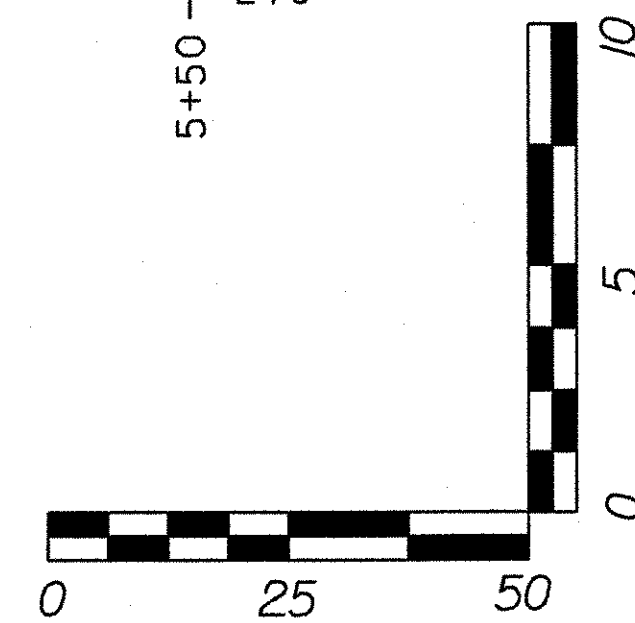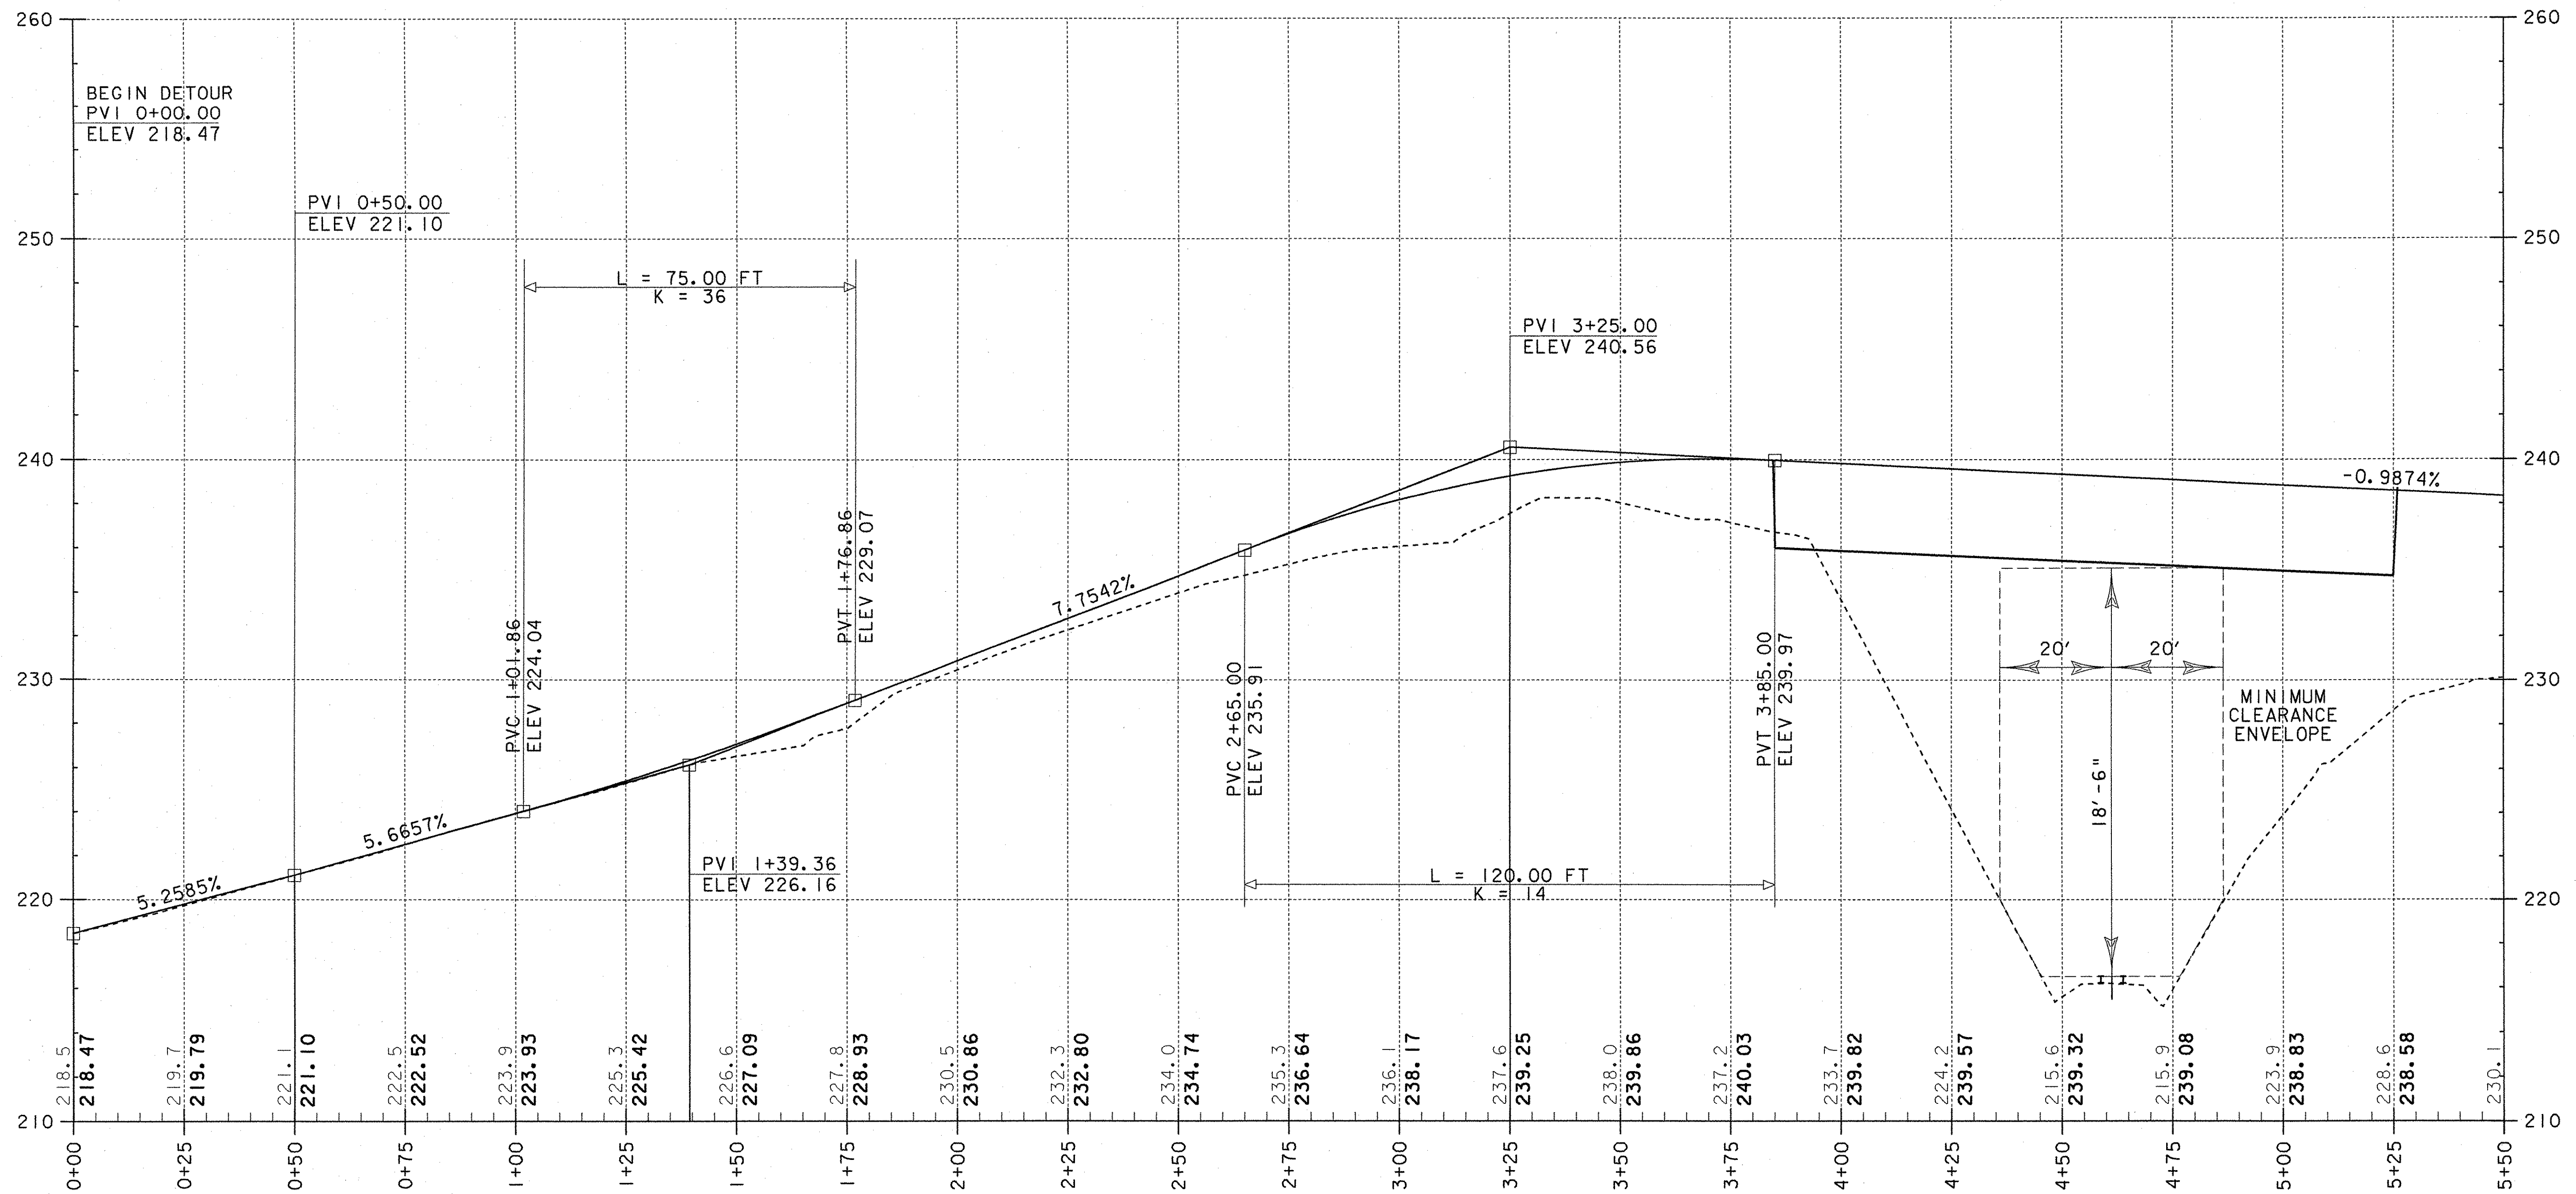


BOSTWICK ROAD DETOUR


DATUM	
VERTICAL	NAVD 88
HORIZONTAL	NAD 83 (1996)

DETOUR
PROFILE

PROJECT NAME:	SHELBURNE
PROJECT NUMBER:	BRO 1445(30)
FILE NAME:	M:\1595402 Bostwick\HWY\DRAW\PROFILES\detprof001.dgn
PROJECT LEADER:	MBZ
DESIGNED BY:	DMB
CHECKED BY:	MDL
PLOT DATE:	01-AUG-2003
DRAWN BY:	MJF
SHEET	38 OF 73

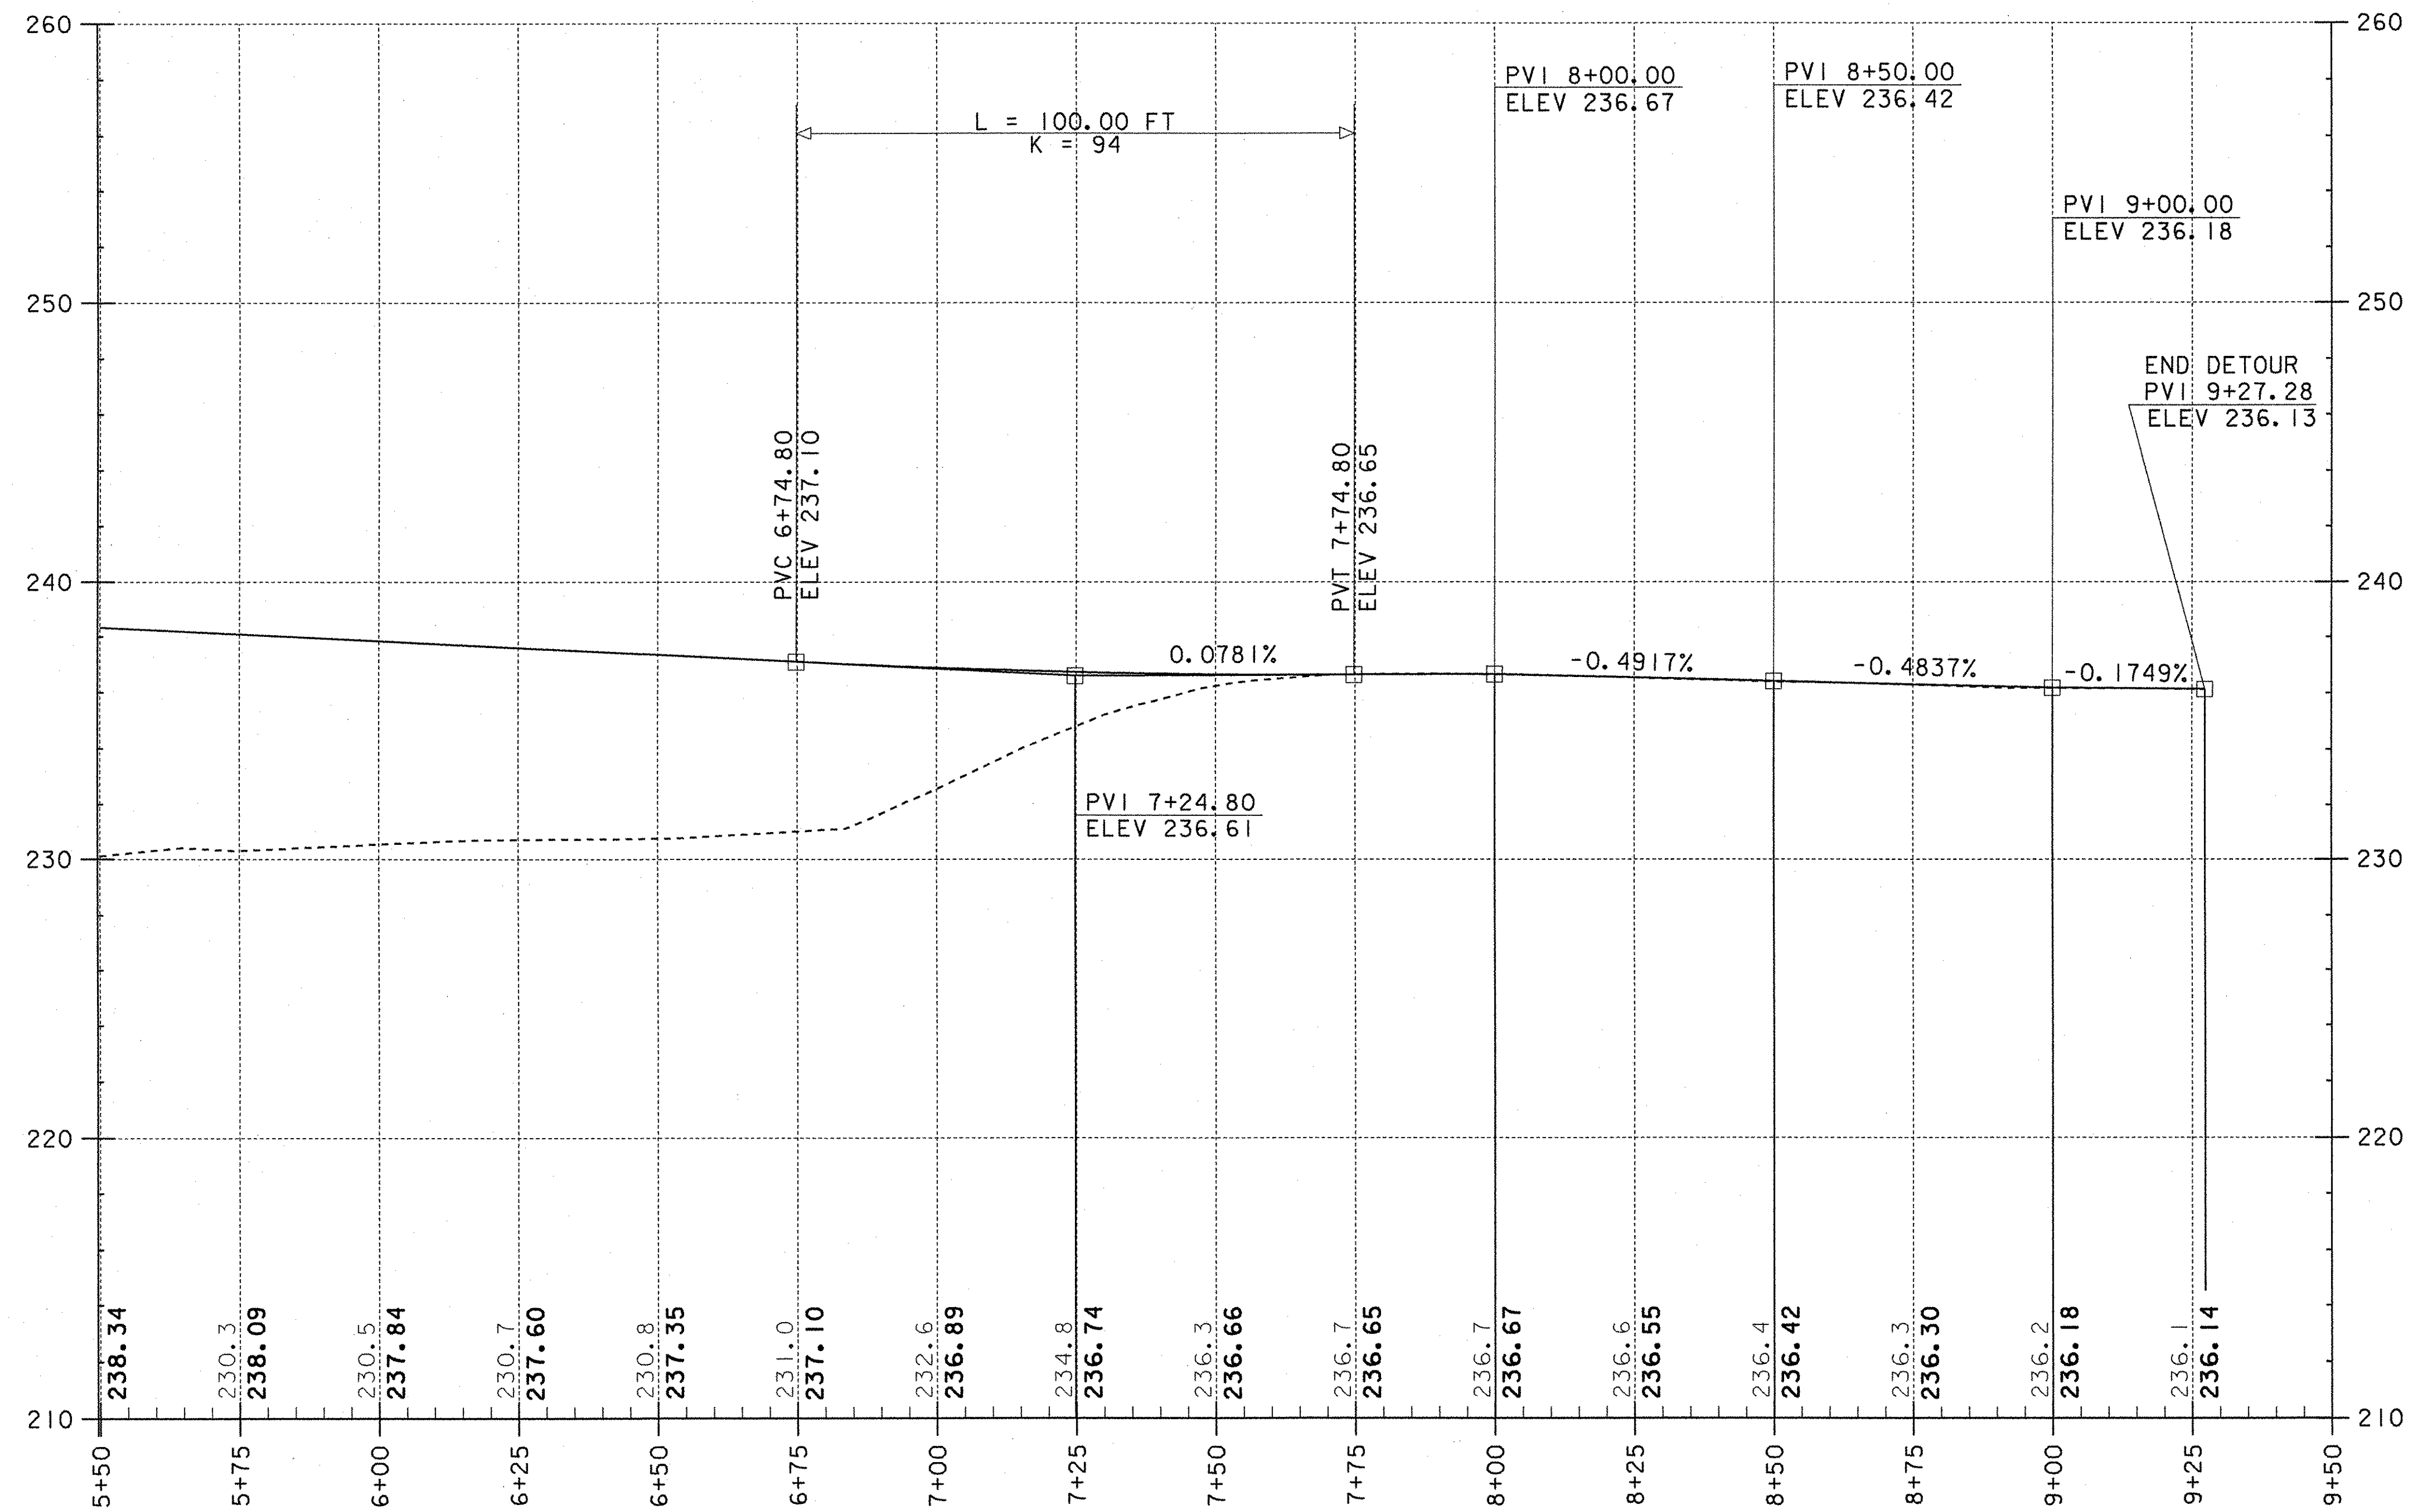

BOSTWICK ROAD DETOUR

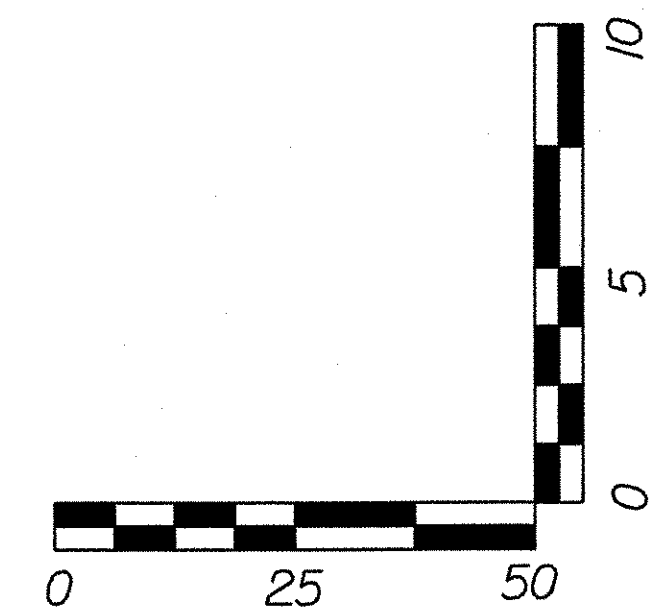

DETOUR
PROFILE

PROJECT NAME:	SHELBURNE
PROJECT NUMBER:	BRO 1445(30)
FILE NAME:	M:\1595402 Bostwick\HWY\DRAW\PROFILES\detprof002.dgn
PROJECT LEADER:	MBZ
DESIGNED BY:	DMB
CHECKED BY:	MDL
PLOT DATE:	01-AUG-2003
DRAWN BY:	MJF
SHEET	39 OF 73

DATUM	
VERTICAL	NAVD 88
HORIZONTAL	NAD 83 (1996)

FINAL HYDRAULICS REPORT

HYDROLOGIC DATA

DRAINAGE AREA = _____
 CHARACTER OF TERRAIN: _____
 CHARACTER & TYPE OF STREAM: _____
 NATURE OF STREAMBED: _____
 Q2.33 = _____ Q50 = _____
 Q10 = _____ Q100 = _____
 Q25 = _____ Q500 = _____
 DATE OF FLOOD OF RECORD: _____
 WATER SURFACE ELEV. ESTIMATED DISCHARGE: _____
 NATURAL STREAM VELOCITY @ Q = _____
 ICE CONDITIONS: _____ DEBRIS: _____
 DOES THE STREAM REACH MAXIMUM HIGHWATER ELEVATION RAPIDLY? _____
 IS ORDINARY RISE RAPID? _____
 IS STAGE AFFECTED BY UPSTREAM OR DOWNSTREAM CONDITIONS? _____
 IF YES, DESCRIBE: _____
 WATERSHED STORAGE _____ HEADWATERS _____ UNIFORM THROUGHOUT WATERSHED _____
 IMMEDIATELY ABOVE SITE _____

EXISTING STRUCTURE

STRUCTURE TYPE: THREE SPAN CONTINUOUS STEEL BEAM WITH CONCRETE DECK YEAR BUILT: 1954
 CLEAR SPAN (NORMAL TO STREAM): 689 FEET
 VERTICAL CLEARANCE ABOVE STREAMBED: _____
 WATERWAY OF FULL OPENING: _____
 DISPOSITION OF STRUCTURE: BRIDGE TO BE REPLACED
 TYPE OF MATERIAL UNDER SUBSTRUCTURE: _____
 WATER SURFACE ELEV. @ Q2.33 = _____ VELOCITY = _____
 Q10 = _____ " _____
 Q25 = _____ " _____
 Q50 = _____ " _____
 Q100 = _____ " _____

LONG TERM STREAM BED CHANGES: _____
 IS THE ROADWAY OVERTOPPED BELOW THE Q100? _____ FREQUENCY: _____
 RELIEF ELEVATION: _____ DISCHARGE OVER ROAD @ Q100: _____

UPSTREAM STRUCTURE: TOWN: _____ DISTANCE: _____
 HIGHWAY NO.: _____ STRUCTURE NO.: _____
 STRUCTURE TYPE: _____ CLEAR HEIGHT: _____
 CLEAR SPAN: _____ FULL WATERWAY: _____
 YEAR BUILT: _____

DOWNSTREAM STRUCTURE: TOWN: _____ DISTANCE: _____
 HIGHWAY NO.: _____ STRUCTURE NO.: _____
 STRUCTURE TYPE: _____ CLEAR HEIGHT: _____
 CLEAR SPAN: _____ FULL WATERWAY: _____
 YEAR BUILT: _____

PROPOSED STRUCTURE

STRUCTURE TYPE: SINGLE SPAN STEEL BEAM WITH CONCRETE DECK
 CLEAR SPAN (NORMAL TO RAILROAD): 762 FEET
 VERTICAL CLEARANCE ABOVE RAILROAD: 23 FEET
 WATERWAY OF FULL OPENING: _____
 WATER SURFACE ELEV. @ Q2.33 = _____ VELOCITY = _____
 Q10 = _____ " _____
 Q25 = _____ " _____
 Q50 = _____ " _____
 Q100 = _____ " _____
 IS THE ROADWAY OVERTOPPED BELOW THE Q100? _____ FREQUENCY: _____
 RELIEF ELEVATION: _____ DISCHARGE OVER ROAD @ Q100: _____
 AVERAGE LOW ELEVATION OF SUPERSTRUCTURE: _____
 VERTICAL CLEARANCE @ Q = _____
 SCOUR: _____
 REQUIRED CHANNEL PROTECTION: _____

PERMIT INFORMATION

STRUCTURE TYPE: _____ YEAR BUILT: _____
 AVERAGE DAILY FLOW: _____ DEPTH: _____
 ORDINARY LOW WATER: _____ DEPTH: _____
 ORDINARY HIGH WATER: _____ DEPTH: _____

ADDITIONAL COMMENTS

TRAFFIC DATA

YEAR	ADT	DHV	% D	% T	ADTT
2004	2300	230	50	3	80
2024	3100	300	50	3	100

18 kip ESAL for flexible pavement from 2004 to 2024: 250,000
 18 kip ESAL for flexible pavement from 2004 to 2044: 350,000
 Design speed: 35 mph

DESIGN CRITERIA:

- DESIGN LIVE LOAD AASHTO HS 25-44
- DESIGN SPAN 900 FEET
- ALLOWABLE LOAD FOR SPREAD FOOTINGS ON SOIL 375 KSF (WEST) ON LEDGE N/A
- ALLOWABLE LOAD FOR PILING 300 KIPS PER PILE TYPE HP 12 X 74 ESTIMATED LENGTH 25 FEET
- STRUCTURAL STEEL AASHTO GRADE M270, GRADE 50M
- REINFORCING STEEL GRADE 60
- CONCRETE CLASS A (HPC-A) $f'_c = 4000$ PSI
 CONCRETE CLASS B (HPC-B) $f'_c = 3500$ PSI

TRAFFIC MAINTENANCE:

- IS TRAFFIC TO BE MAINTAINED? YES IF YES, ON EXISTING STRUCTURE NO OR ON TEMPORARY BRIDGE YES
- TEMPORARY BRIDGE REQUIREMENTS: ONE OR TWO WAY TWO WAY TRAFFIC CONTROL SIGNALS REQUIRED NO
 BRIDGE DETOUR TO BE DESIGNED BY OTHERS

ARE SIDEWALKS REQUIRED? NO IF SO, ON WHAT SIDE? N/A


LOAD FACTOR LOAD RATING (TONS)

LOADING LEVELS (LOAD FACTOR)	TRUCK						
	H	HS	3S2	6 AXLE	3A. STR.	4A. STR.	5A. SEMI
INVENTORY	48	68					
A=2.17; B=1.00							
POSTED							
A=1.55; B=1.40	67	95	110		87	89	102
OPERATING							
A=1.30; B=1.67			113	131	153	104	106

STRENGTH RF = $\frac{\phi M_N - 1.3 M_{DL}}{A \times M_{LL+I}}$ SERVICEABILITY RF = $B \left[.95 F_y S_{LL+I} - M_{DL} \frac{S_{LL+I}}{S_{DL}} - M_{SDL} \frac{S_{LL+I}}{S_{SDL}} \right] / 1.67 M_{LL+I}$


STATE OF VERMONT AGENCY OF TRANSPORTATION

Town Of SHELBURNE Bridge No. 15
 Highway No. TH 3 Log Sta. _____
 Surv. Sta. _____
BOSTWICK ROAD OVER VERMONT RAILWAY
PRELIMINARY INFORMATION SHEET
 Designed By L. WIXSON Drawn By B. COLBURN
 Checked By R. JOY Date 05/03 Bridge Design Supervisor M. ZYDEL Date 05/03
 PROJECT SHELBURNE PROJECT NO. BRO 1445(30)
 I.G.C. Info. m:\595402_Bostwick\BRIDGE\6m\lar\z\196pl.dgn
 Bridge Sheet No. BR100 Sheet 40 of 73

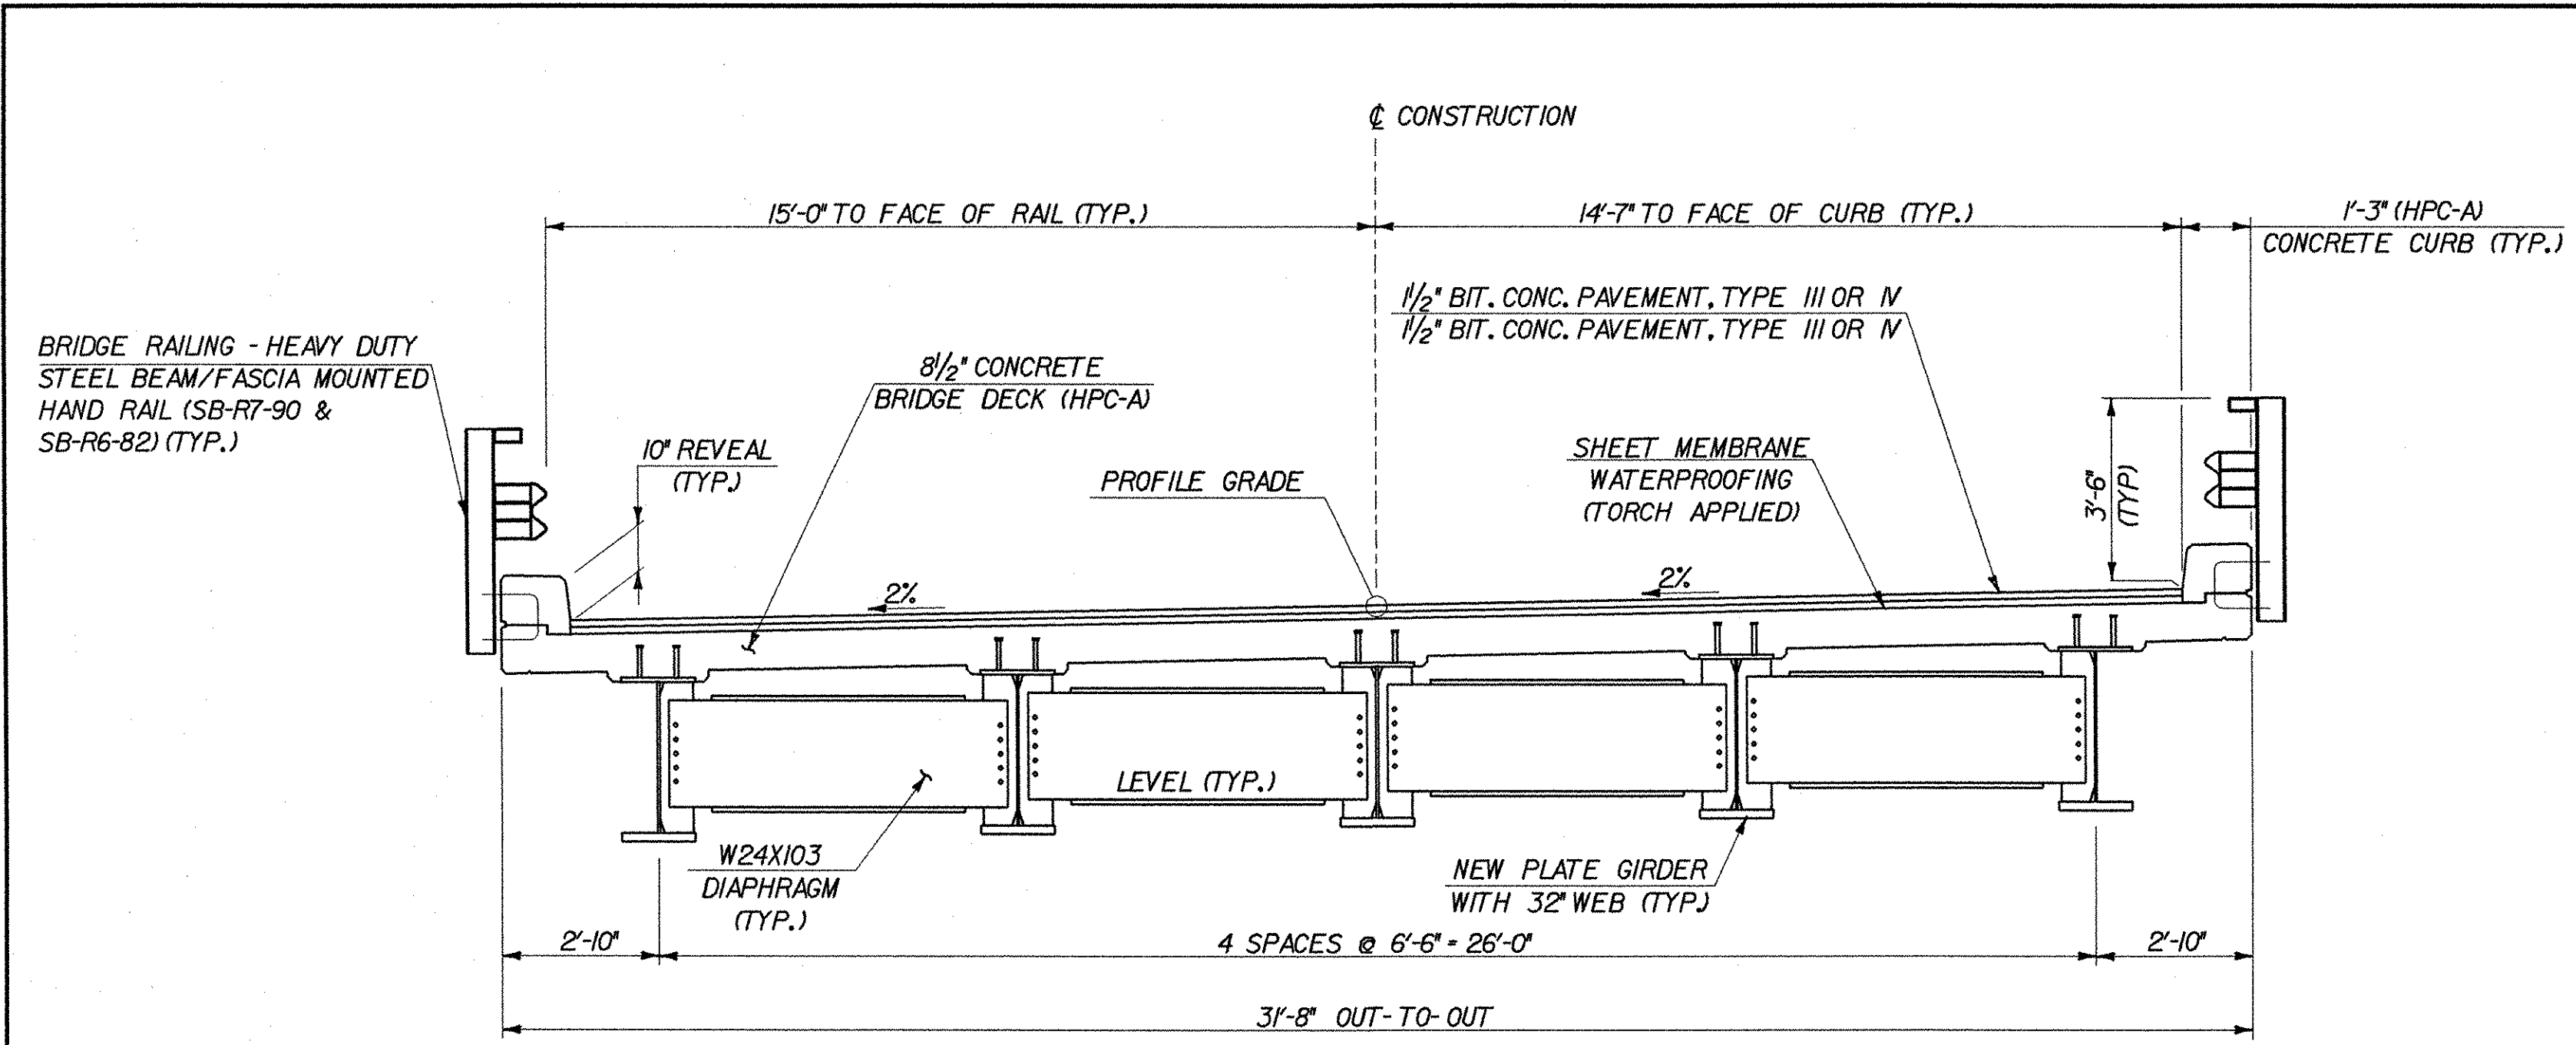


TYPICAL BRIDGE SECTION

SCALE: 3/8" = 1'-0"

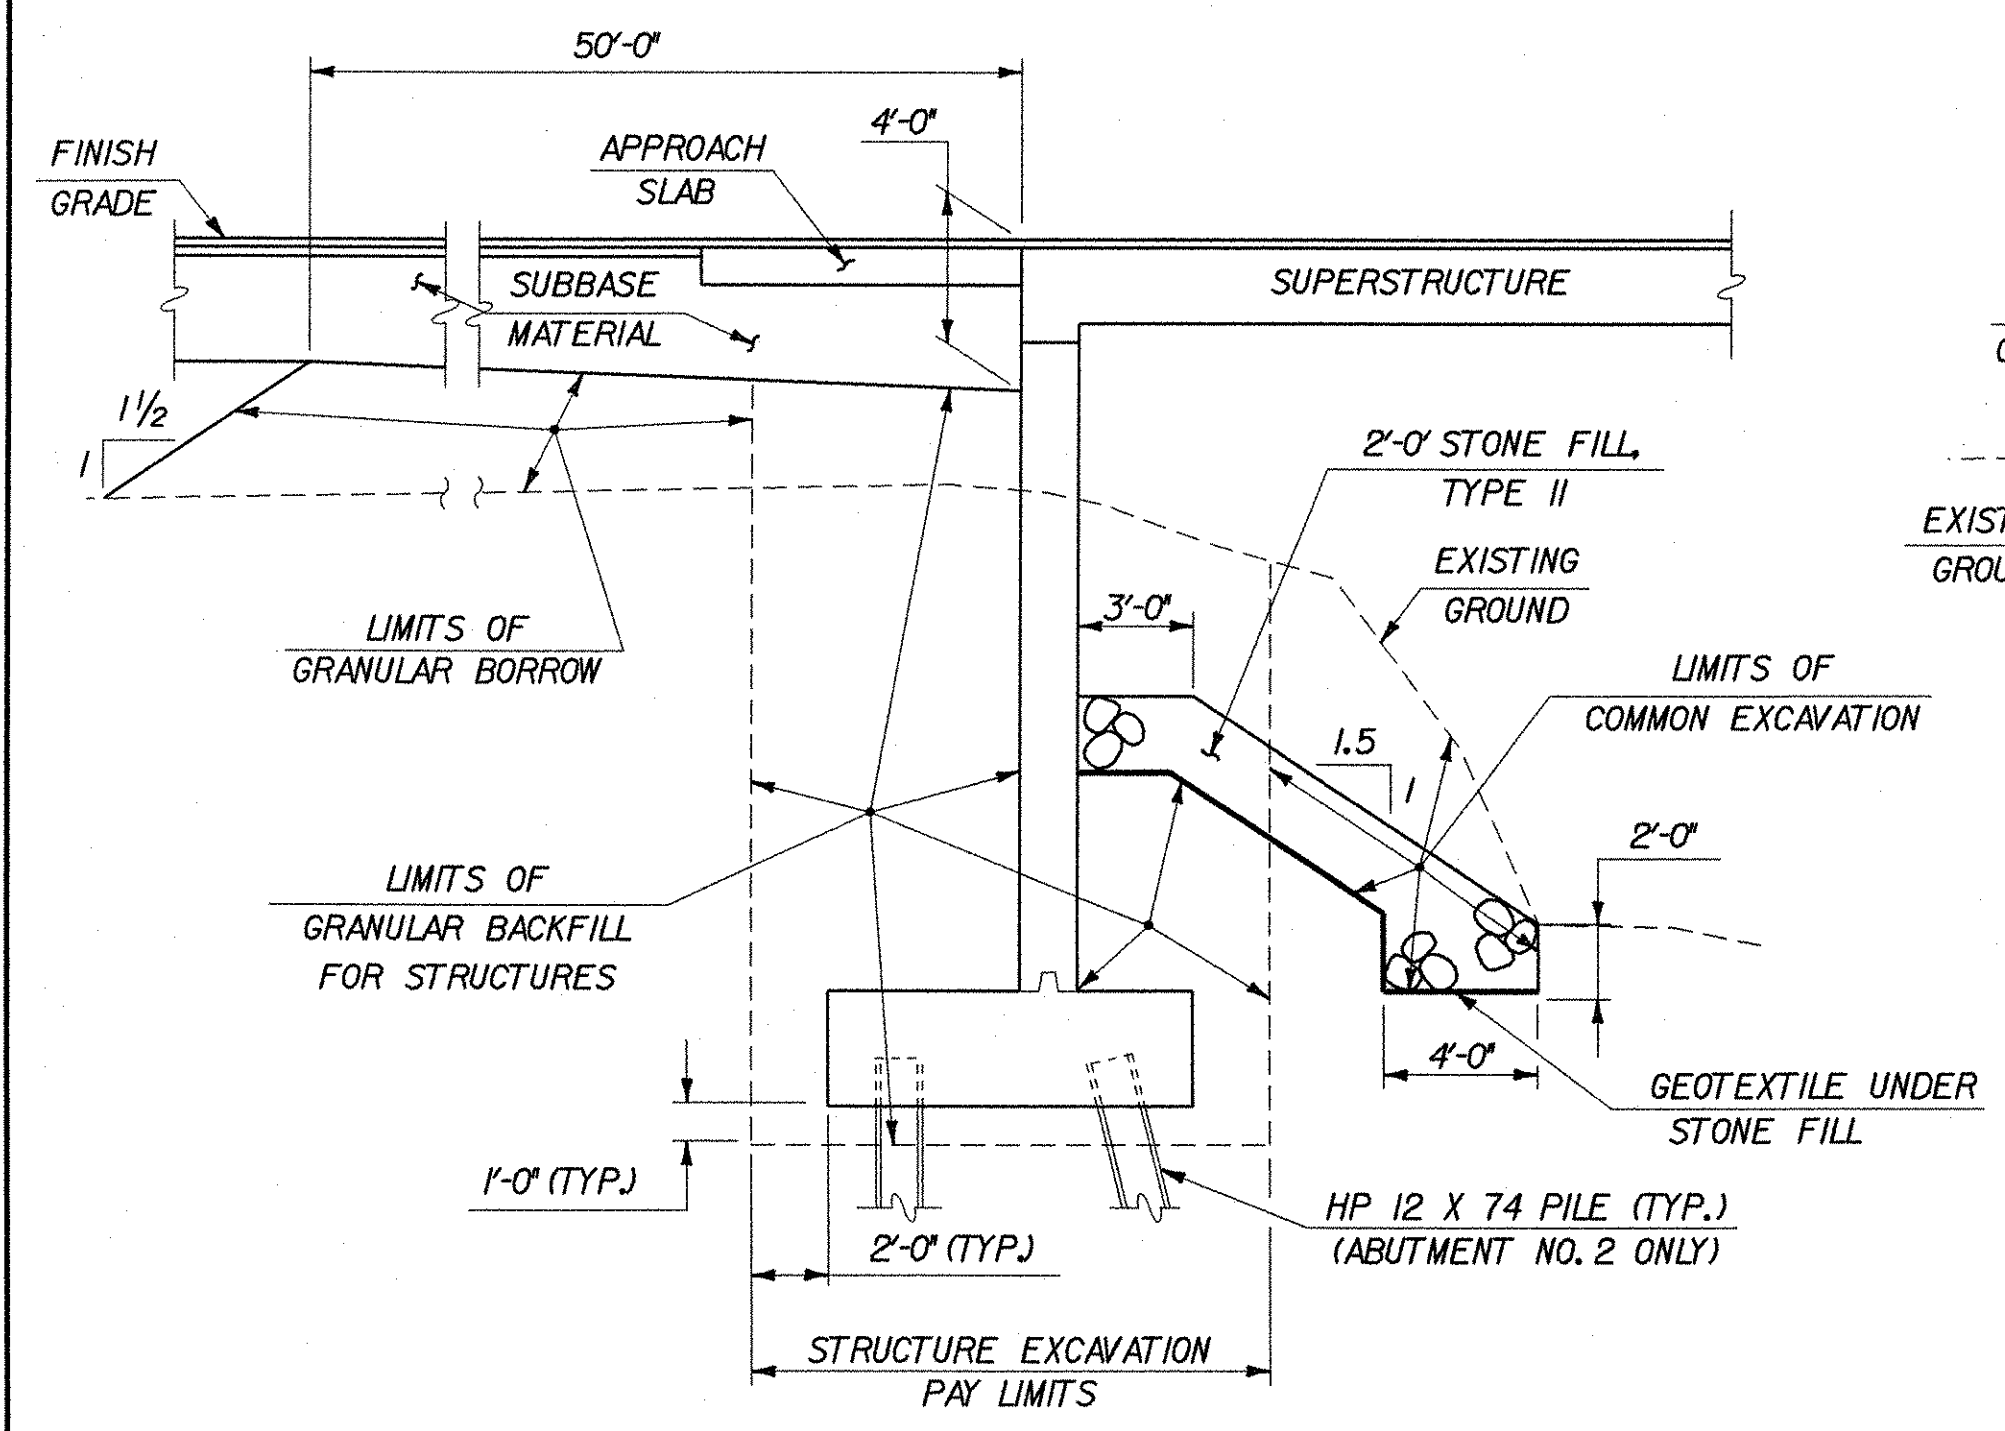

TYPICAL ABUTMENT SECTION

(NOT TO SCALE)

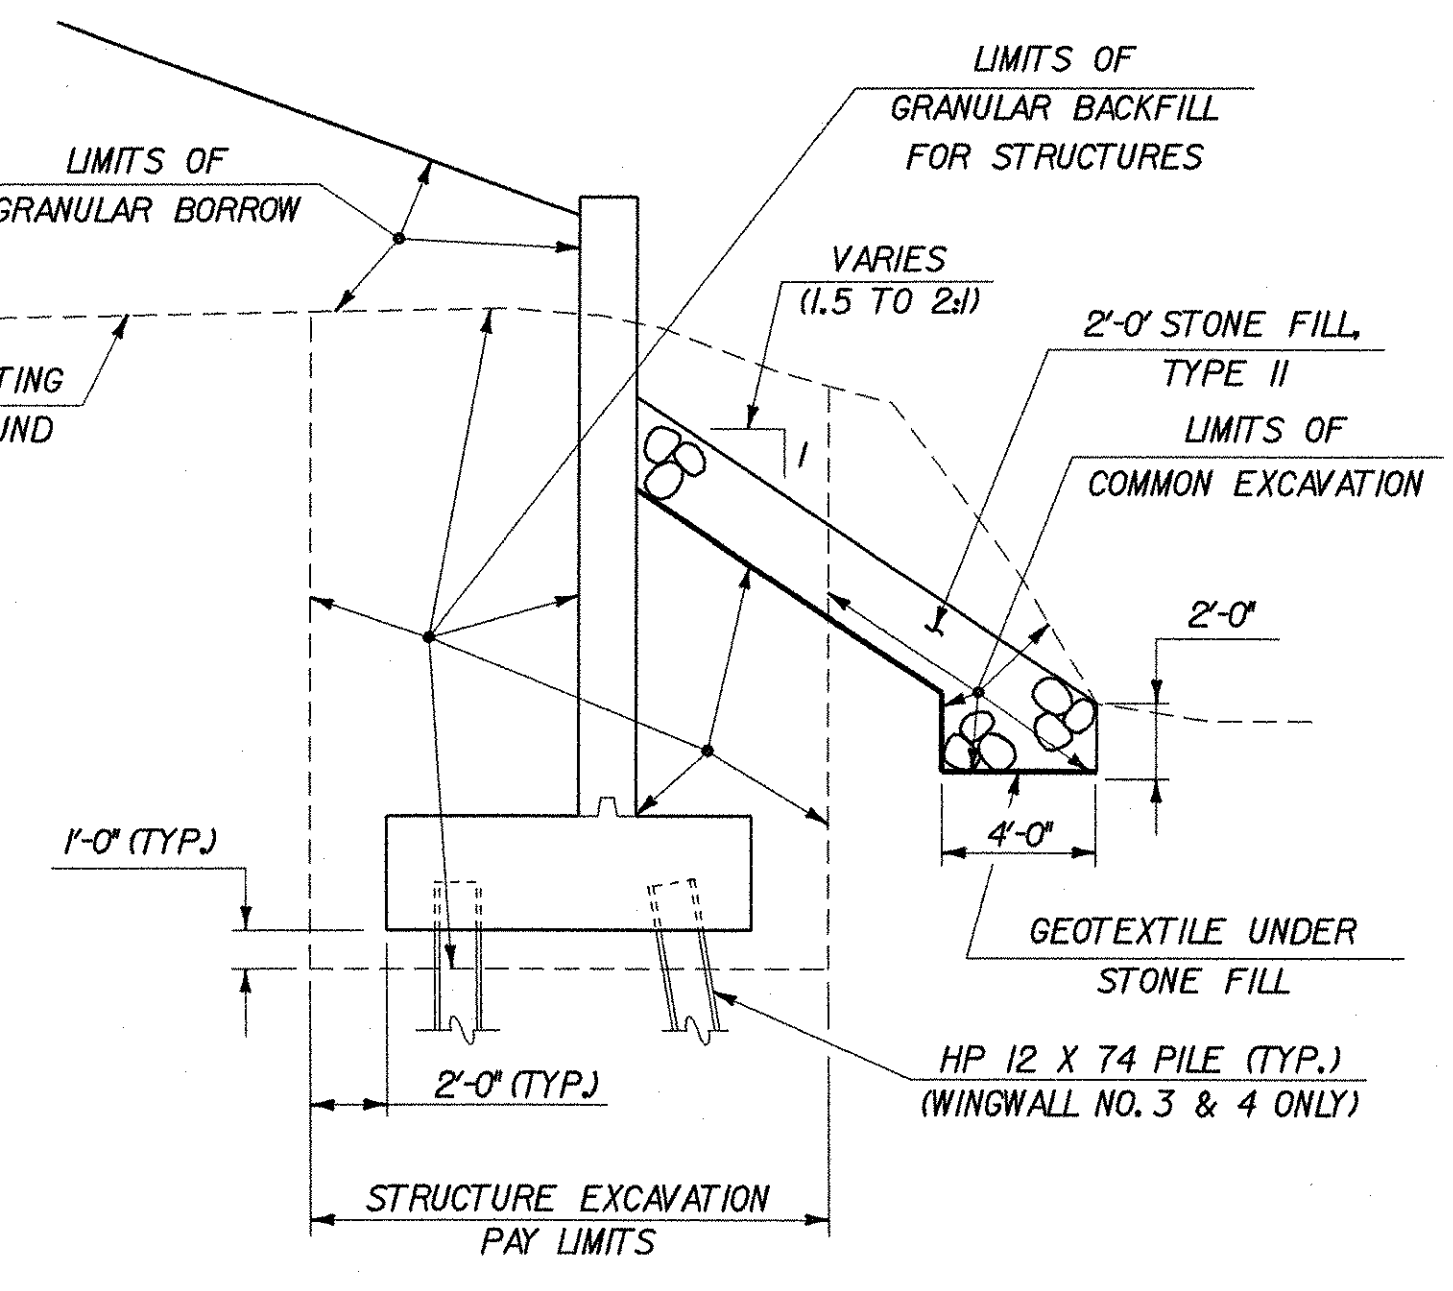

TYPICAL WINGWALL SECTION

(NOT TO SCALE)

NOTE

- FOR TYPICAL ROADWAY SECTION AND MATERIAL TOLERANCES, SEE SHEETS 3-5 OF 73.



PLOTTED 05-AUG-2003

SOIL CLASSIFICATION

AASHTO

A1	Gravel and Sand
A3	Fine Sand
A2	Silty or Clayey Gravel and Sand
A4	Silty Soil - Low Compressibility
A5	Silty Soil - Highly Compressible
A6	Clayey Soil - Low Compressibility
A7	Clayey Soil - Highly Compressible

ROCK QUALITY DESIGNATION

R.Q.D. (%)	ROCK DESCRIPTION
<25	Very Poor
25 to 50	Poor
51 to 75	Fair
76 to 90	Good
>90	Excellent

SHEAR STRENGTH

UNDRAINED SHEAR STRENGTH IN P.S.F.	CONSISTENCY
<250	Very Soft
250-500	Soft
500-1000	Med. Stiff
1000-2000	Stiff
2000-4000	Very Stiff
>4000	Hard

CORRELATION GUIDE OF "N" TO DENSITY/CONSISTENCY


DENSITY (GRANULAR SOILS)		CONSISTENCY (COHESIVE SOILS)	
N	DESCRIPTIVE TERM	N	DESCRIPTIVE TERM
<5	Very Loose	<2	Very Soft
5-10	Loose	2-4	Soft
11-24	Med. Dense	5-8	Med. Stiff
25-50	Dense	9-15	Stiff
>50	Very Dense	16-30	Very Stiff
		31-60	Hard
		>60	Very Hard

COMMONLY USED SYMBOLS

- ▼ Water Elevation
- ⊕ Standard Penetration Boring
- ⊗ Auger Boring
- ⊙ Rod Sounding
- S Sample
- N Standard Penetration Test Blow Count Per Foot For: 2" O.D. Sampler 1 3/8" I.D. Sampler Hammer Weight Of 140 Lbs. Hammer Fall Of 30"
- VS Field Vane Shear Test
- US Undisturbed Soil Sample
- B Blast
- DC Diamond Core
- MD Mud Drill
- WA Wash Ahead
- HSA Hollow Stem Auger
- AX Core Size 1 1/8"
- BX Core Size 1 3/8"
- NX Core Size 2 1/8"
- M Double Tube Core Barrel Used
- LL Liquid Limit
- PL Plastic Limit
- PI Plasticity Index
- NP Non Plastic
- w Moisture Content (Dry Wgt. Basis)
- D Dry
- M Moist
- MTW Moist To Wet
- W Wet
- Sat Saturated
- Bo Boulder
- Gr Gravel
- Sa Sand
- SI Silt
- Cl Clay
- HP Hardpan
- Le Ledge
- NLTD No Ledge To Depth
- CNPF Can Not Penetrate Further
- TLOB To Ledge Or Boulder
- NR No Recovery
- Rec. Recovery
- %Rec. Percent Recovery
- ROD Rock Quality Designation
- CBR California Bearing Ratio
- < Less Than
- > Greater Than
- R Refusal (N > 100)

COLOR

blk	Black	prk	Pink
bl	Blue	pu	Purple
brn	Brown	rd	Red
dk	Dark	tn	Tan
gry	Gray	wh	White
gn	Green	yel	Yellow
lt	Light	mtc	Multicolored
or	Orange		

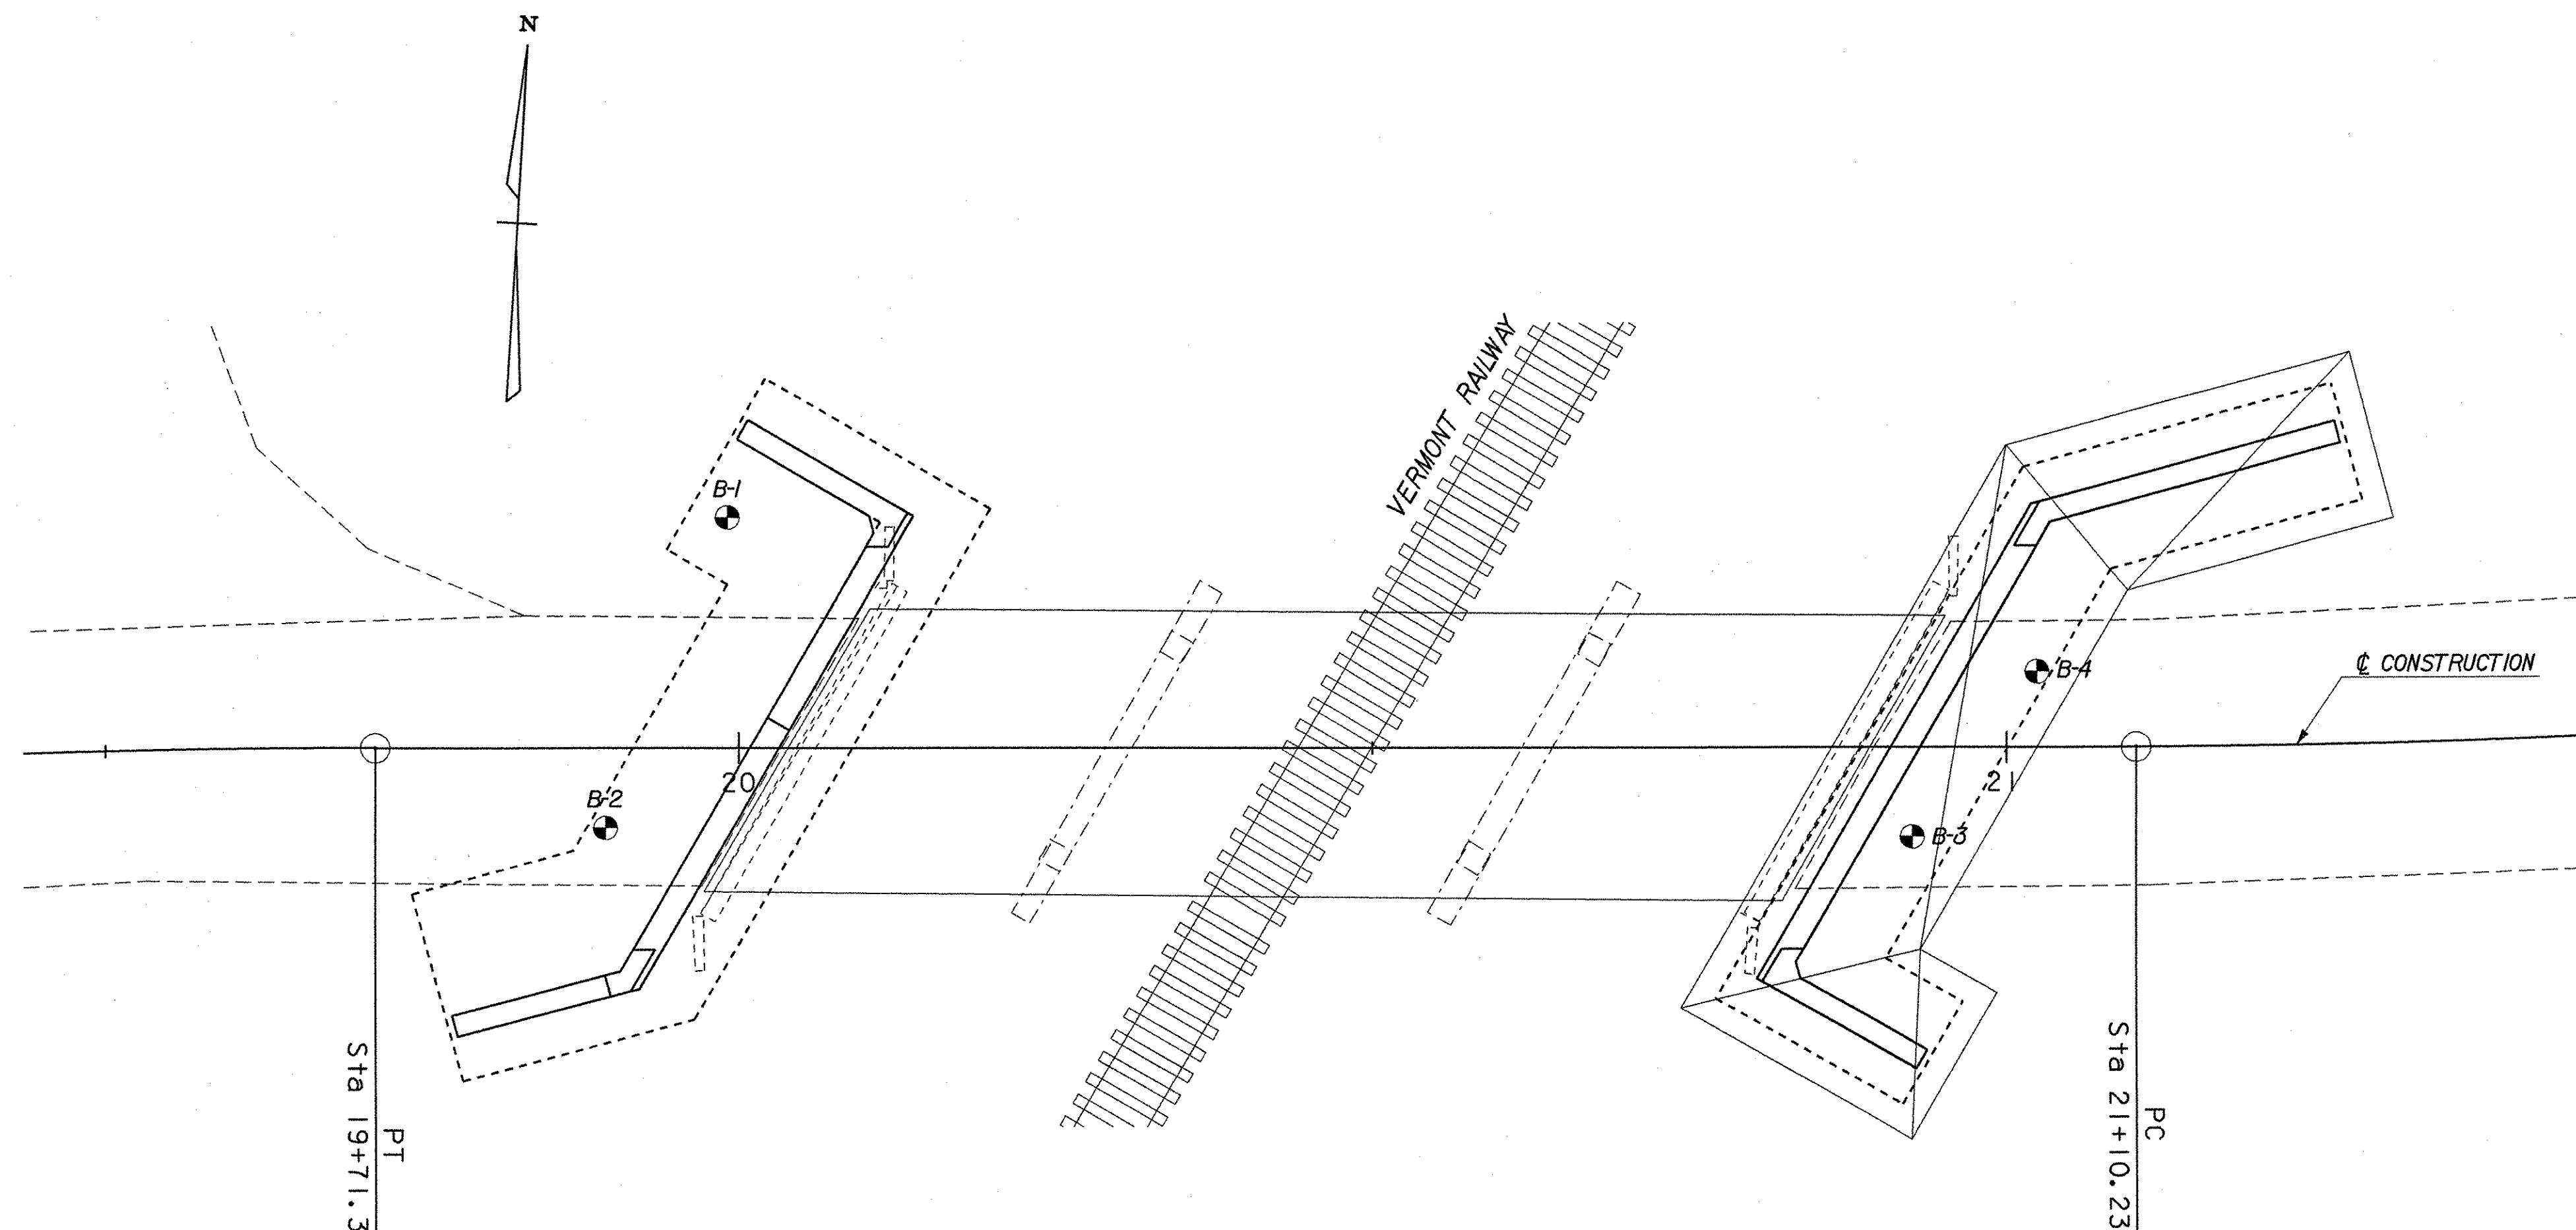

BORING LAYOUT

SCALE 1" = 10'-0"

BORING CHART

BORING NO.	STATION	OFFSET	BEDROCK ELEV.
B-1	19+99.10	LT 18.16'	216.92
B-2	19+89.53	RT 6.25'	218.74
B-3	20+92.59	RT 7.00'	204.14
B-4	21+02.41	LT 6.00'	201.05

DEFINITIONS (AASHTO)


- BEDROCK (LEDGE)** - Rock in its native location of indefinite thickness.
- BOULDER** - A rock fragment with an average dimension > 12 inches.
- COBBLE** - Rock fragments with an average dimension between 3 and 12 inches.
- GRAVEL** - Rounded particles of rock < 3" and > 0.075" (#10 sieve).
- SAND** - Particles of rock < 0.075" (#10 sieve) and > 0.0029" (#200 sieve).
- SILT** - Soil < 0.0029" (#200 sieve), non or slightly plastic and exhibits no strength when air-dried.
- CLAY** - Fine grained soil, exhibits plasticity when moist and considerable strength when air-dried.
- VARVED** - Alternate layers of silt and clay.
- HARDPAN** - Extremely dense soil, cemented layer, not softened when wet.
- MUCK** - Soft organic soil (containing > 10% organic material).
- MOISTURE CONTENT** - Weight of water divided by dry weight of soil.
- FLOWING SAND** - Granular soil so saturated (loose) that it flows into drill casing during extraction of wash rod.
- STRIKE** - Angle from magnetic north to line of intersection of bed with a horizontal plane.
- DIP** - Inclination of bed with a horizontal plane.

GENERAL NOTES

- The subsurface explorations shown herein were made between 10/7/02 and 10/9/02 by SJB Services, Inc.
- Soil and rock classifications, properties and descriptions are based on engineering interpretation from available subsurface information by the Agency and may not necessarily reflect actual variations in subsurface conditions that may be encountered between individual boring or sample locations.
- Observed water levels and/or conditions indicated are as recorded at the time of exploration and may vary according to the prevailing rainfall, methods of exploration and other factors.
- Engineering judgement was exercised in preparing the subsurface information presented herein. Analysis and interpretation of subsurface data was performed and interpreted for Agency design and estimating purposes. Presentation of the information in the Contract is intended to provide the Contractor access to the same data available to the Agency. The subsurface information is presented in good faith and is not intended as a substitute for personal investigation, independent interpretation, independent analysis or judgement by the Contractor.
- Pictorial structure details shown on the boring plan layout or soils profile are for illustrative purposes only and may not accurately portray final contract details.
- Terminology used on boring logs to describe the hardness, degree of weathering, and spacing of fractures, joints and other discontinuities in the bedrock is defined in the AASHTO Manual on Subsurface Investigations, 1988.

STATE OF VERMONT AGENCY OF TRANSPORTATION

Town Of	SHELBURNE	Bridge No.	15
Highway No.	TH 3	Log Sta.	
		Surv. Sta.	
BOSTWICK ROAD OVER VERMONT RAILWAY			
BORING INFORMATION SHEET			
Designed By	SJB SERVICES, INC.	Drawn By	S.MERKMAN
Checked By	Date	Bridge Design Supervisor	Date
	L.WIXSON 05/03	M.ZYDEL	05/03
PROJECT	SHELBURNE	PROJECT NO.	BRO 1445(30)
I.C.C. Info. MA595402 BostwickBRIDGE6mylar2/196bpl.dgn			
Bridge Sheet No.	BRO1	Sheet	41 of 73

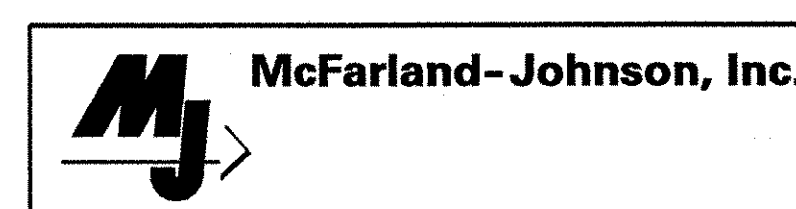

SOIL CLASSIFICATION

AASHTO	
A1	Gravel and Sand
A3	Fine Sand
A2	Silty or Clayey Gravel and Sand
A4	Silty Soil - Low Compressibility
A5	Silty Soil - Highly Compressible
A6	Clayey Soil - Low Compressibility
A7	Clayey Soil - Highly Compressible

ROCK QUALITY DESIGNATION

R.O.D. (%)	ROCK DESCRIPTION
<25	Very Poor
25 to 50	Poor
51 to 75	Fair
76 to 90	Good
>90	Excellent

SHEAR STRENGTH

UNDRAINED SHEAR STRENGTH IN P.S.F.	CONSISTENCY
<250	Very Soft
250-500	Soft
500-1000	Med. Stiff
1000-2000	Stiff
2000-4000	Very Stiff
>4000	Hard

CORRELATION GUIDE OF 'N' TO DENSITY/CONSISTENCY


DENSITY (GRANULAR SOILS)		CONSISTENCY (COHESIVE SOILS)	
N	DESCRIPTIVE TERM	N	DESCRIPTIVE TERM
<5	Very Loose	<2	Very Soft
5-10	Loose	2-4	Soft
11-24	Med. Dense	5-8	Med. Stiff
25-50	Dense	9-15	Stiff
>50	Very Dense	16-30	Very Stiff
		31-60	Hard
		>60	Very Hard

COMMONLY USED SYMBOLS

- ▼ Water Elevation
- ⊕ Standard Penetration Boring
- ⊗ Auger Boring
- ⊙ Rod Sounding
- S Sample
- N Standard Penetration Test
- Blow Count Per Foot For:
- 2" O.D. Sampler
- 1 3/8" I.D. Sampler
- Hammer Weight Of 140 Lbs.
- Hammer Fall Of 30"
- VS Field Vane Shear Test
- US Undisturbed Soil Sample
- B Blast
- DC Diamond Core
- MD Mud Drill
- WA Wash Ahead
- HSA Hollow Stem Auger
- AX Core Size 1 1/8"
- BX Core Size 1 3/8"
- NX Core Size 2 1/8"
- M Double Tube Core Barrel Used
- LL Liquid Limit
- PL Plastic Limit
- PI Plasticity Index
- NP Non Plastic
- w Moisture Content (Dry Wgt. Basis)
- D Dry
- M Moist
- MTW Moist To Wet
- W Wet
- Sat Saturated
- Bo Boulder
- Gr Gravel
- Sa Sand
- SI Silt
- Cl Clay
- HP Hardpan
- Le Ledge
- NLTD No Ledge To Depth
- CNPF Can Not Penetrate Further
- TLOB To Ledge Or Boulder
- NR No Recovery
- Rec. Recovery
- %Rec. Percent Recovery
- RQD Rock Quality Designation
- CBR California Bearing Ratio
- < Less Than
- > Greater Than
- R Refusal (N > 100)

COLOR

blk	Black	pnk	Pink
bl	Blue	pu	Purple
brn	Brown	rd	Red
dk	Dark	tn	Tan
gry	Gray	wh	White
gn	Green	yel	Yellow
lt	Light	mltc	Multicolored
or	Orange		

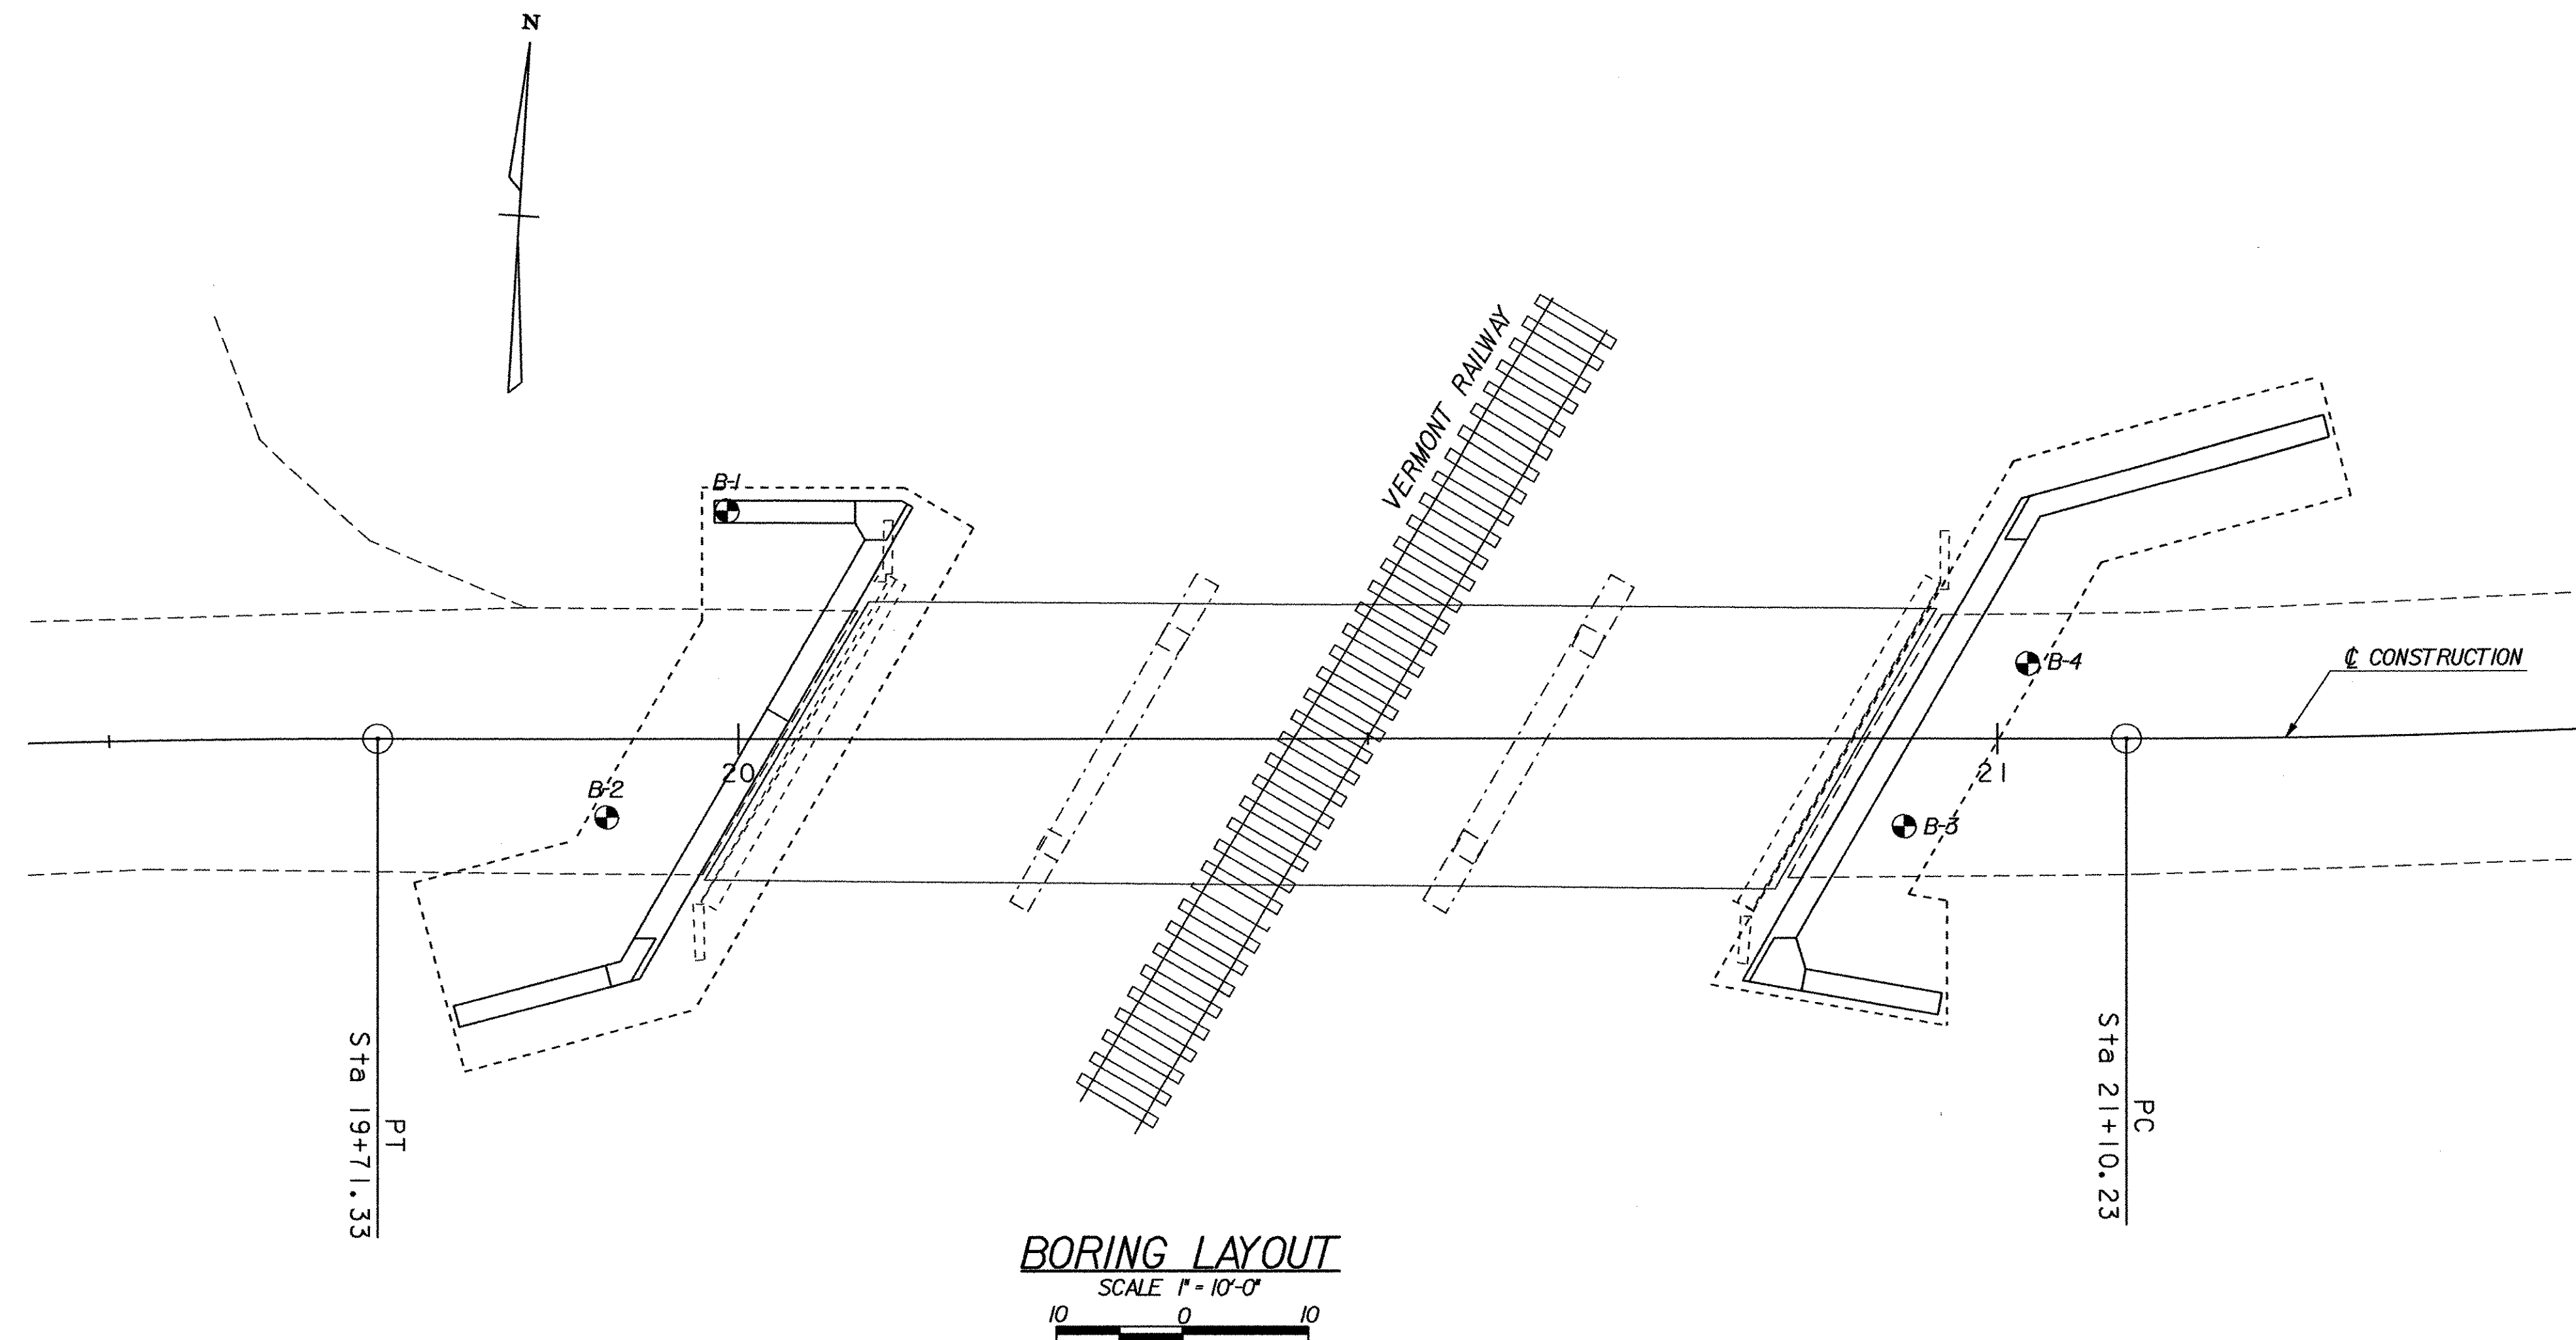

BORING CHART

BORING NO.	STATION	OFFSET	BEDROCK ELEV.
B-1	19+99.10	LT 18.16'	216.92
B-2	19+89.53	RT 6.25'	218.74
B-3	20+92.59	RT 7.00'	204.14
B-4	21+02.41	LT 6.00'	201.05

DEFINITIONS (AASHTO)

- BEDROCK (LEDGE)** - Rock in its native location of indefinite thickness.
- BOULDER** - A rock fragment with an average dimension > 12 inches.
- COBBLE** - Rock fragments with an average dimension between 3 and 12 inches.
- GRAVEL** - Rounded particles of rock < 3" and > 0.075" (#10 sieve).
- SAND** - Particles of rock < 0.075" (#10 sieve) and > 0.0025" (#200 sieve).
- SILT** - Soil < 0.0025" (#200 sieve), non or slightly plastic and exhibits no strength when air-dried.
- CLAY** - Fine grained soil, exhibits plasticity when moist and considerable strength when air-dried.
- VARVED** - Alternate layers of silt and clay.
- HARDPAN** - Extremely dense soil, cemented layer, not softened when wet.
- MUCK** - Soft organic soil (containing > 10% organic material).
- MOISTURE CONTENT** - Weight of water divided by dry weight of soil.
- FLOWING SAND** - Granular soil so saturated (loose) that it flows into drill casing during extraction of wash rod.
- STRIKE** - Angle from magnetic north to line of intersection of bed with a horizontal plane.
- DIP** - Inclination of bed with a horizontal plane.

GENERAL NOTES

- The subsurface explorations shown herein were made between 10/7/02 and 10/9/02 by SJB Services, Inc.
- Soil and rock classifications, properties and descriptions are based on engineering interpretation from available subsurface information by the Agency and may not necessarily reflect actual variations in subsurface conditions that may be encountered between individual boring or sample locations.
- Observed water levels and/or conditions indicated are as recorded at the time of exploration and may vary according to the prevailing rainfall, methods of exploration and other factors.
- Engineering judgement was exercised in preparing the subsurface information presented herein. Analysis and interpretation of subsurface data was performed and interpreted for Agency design and estimating purposes. Presentation of the information in the Contract is intended to provide the Contractor access to the same data available to the Agency. The subsurface information is presented in good faith and is not intended as a substitute for personal investigation, independent interpretation, independent analysis or judgement by the Contractor.
- Pictorial structure details shown on the boring plan layout or soils profile are for illustrative purposes only and may not accurately portray final contract details.
- Terminology used on boring logs to describe the hardness, degree of weathering, and spacing of fractures, joints and other discontinuities in the bedrock is defined in the AASHTO Manual on Subsurface Investigations, 1988.



WINGWALL NO. 1 AND NO. 4 LAYOUT REVISED

STATE OF VERMONT AGENCY OF TRANSPORTATION

Town Of	SHELBURNE	Bridge No.	15	
Highway No.	TH 3	Log Sta.		
		Surv. Sta.		
BOSTWICK ROAD OVER VERMONT RAILWAY				
BORING INFORMATION SHEET (REVISED)				
Designed By	SJB SERVICES, INC.	Drawn By	S.MERKMAN	
Checked By		Bridge Design Supervisor		
	L. WIXSON	Date	03/04	
		M. ZYDEL	Date	03/04
PROJECT	SHELBURNE	PROJECT NO.	BRO 1445(30)	
I.G.C. Info. G:\Structures\STR3_Roger Whitcomb\Consultants\McFarland-Johnson\Shelburne				
Bridge Sheet No.	BRI01A	Sheet	41A of 73	

B.F.
ABUT.
NO. 1

DATE:		SUBSURFACE LOG		PJT. NO. AD-02-069	
START 10/7/2002				HOLE NO. B-1	
FINISH 10/7/2002				SURF. ELEV. 236.92	
SHEET 1 OF 1				GW. DEPTH See Notes	
PROJECT: Bridge Reconstruction		LOCATION: Bostwick Rd. over Vermont Railway			
STATION: 19-99.103		OFFSET: 18.155' LT			
DEPTH FT.	SAMPL. NO.	BLOWS ON SAMPLER	REC. (FT)	SOIL OR ROCK CLASSIFICATION	NOTES
	1	2 4 4 4 8		TOPSOIL	North side of west abutment.
				Possible Fill; Brown SILT with embedded SHALE FRAGMENTS (Moist - Medium)	No water present in hole prior to introducing water for core drilling.
	2	4 4 5 5 9 15		Similar; rootlets noted	At completion of core drilling, water level at ground surface (introduced water).
				Brown, laminated SILT & CLAY (Moist - Medium)	Hard auger advance at approx. 18'.
	3	5 5 6 4 11 15		Similar, with partings of fine sand; stiff, moist	Drilled from 19.2' to 20.0' with tricone bit.
	4	3 11 14 7 25		Gray SHALE FRAGMENTS (Damp - Very Compact) Iversville Shale; Gray, hard, weathered, laminated SLATE (weakly metamorphosed shale) with very hard, bedded siltstone layers. Veined with calcite and cut by 60 degree fractures (slaty cleavage) roughly parallel to relic bedding. Fracture surfaces frequently rust-stained. Completely shattered zones noted in recovered core, and as blockages wedged in core barrel washed away by drilling operation.	Core drilled from 20.0' to 30.0'. Run 1: 20.0' - 25.0' 3.2' Recovery (64%) ROD = 26%. Run 2: 25.0' - 30.0' 3.4' Recovery (68%) ROD = 28%. NX Core
	5	50/2		Boring Terminated @ 30.0'	No losses of water noted while coring.
<small>N = NO. BLOWS TO DRIVE 2-INCH SPOON 12-INCHES WITH A 140 LB. PIN WT. FALLING 30-INCHES PER BLOW DRILLER: Mike Leshgan DRILL RIG TYPE: CME 75 METHOD OF INVESTIGATION: #25 ID. Hollow Stem Auger, NX Diamond Core</small>					

B.F.
ABUT.
NO. 2

DATE:		SUBSURFACE LOG		PJT. NO. AD-02-069	
START 10/8/2002				HOLE NO. B-2	
FINISH 10/8/2002				SURF. ELEV. 237.14	
SHEET 1 OF 1				GW. DEPTH See Notes	
PROJECT: Bridge Reconstruction		LOCATION: Bostwick Rd. over Vermont Railway			
STATION: 20-92.594		OFFSET: 7.000' RT			
DEPTH FT.	SAMPL. NO.	BLOWS ON SAMPLER	REC. (FT)	SOIL OR ROCK CLASSIFICATION	NOTES
	1	4 8 8 7 6		ASPHALT	South side of east abutment.
				Fill: Brown SHALE FRAGMENTS in SILT, SAND and GRAVEL matrix (Moist - Stiff)	Samples above 20' are "wet" due to introduction of water for casing advance and cleanout.
	2	1 2 3 2 5 10		No recovery; loose material, washed away by drilling operation	No recovery; loose material, washed away by drilling operation
				Brown SILT with embedded SHALE FRAGMENTS (Moist/Wet - Medium)	No recovery; cuttings similar to Sample 1
	3	4 3 3 2 6 10			
	4	2 2 4 3 6 12		Brown fine SAND & SILT with seams of silt & clay; conformed bedding (?) (Wet - Loose)	Samples become wet with groundwater at approx. 17'. At completion of core drilling, water level at ground surface (introduced water).
	5	1 2 3 6 5 10		Gray fine SAND & SILT with gray clay seams (Wet - Firm)	
	6	9 10 10 11 20 15		Gray laminated SILT & CLAY (Wet - Stiff)	Core drilled from 33.0' to 43.0'
	7	8 10 7 5 17 20		Iversville Shale; Gray, hard, weathered, laminated SLATE (weakly metamorphosed shale) with very hard, bedded siltstone layers. Veined with calcite and cut by 60 degree fractures (slaty cleavage) roughly parallel to relic bedding. Fracture surfaces frequently rust-stained. Completely shattered zones noted in recovered core, and as blockages wedged in core barrel washed away by drilling operation.	Run 1: 33.0' - 38.0' 3.5' Recovery (70%) ROD = 16%. Run 2: 38.0' - 43.0' 4.8' Recovery (96%) ROD = 22%. NX Core
				Run 1 highly weathered and fractured throughout, with very frequent calcite veins and slickensided surfaces. Run 2 less weathered and veined, with slickensided surfaces throughout.	No losses of water noted while coring.
				Boring Terminated @ 43.0'	
<small>N = NO. BLOWS TO DRIVE 2-INCH SPOON 12-INCHES WITH A 140 LB. PIN WT. FALLING 30-INCHES PER BLOW DRILLER: Mike Leshgan DRILL RIG TYPE: CME 75 METHOD OF INVESTIGATION: # Flush Joint Casing, NX Diamond Core</small>					

B.F.
ABUT.
NO. 2

DATE:		SUBSURFACE LOG		PJT. NO. AD-02-069	
START 10/9/2002				HOLE NO. B-4	
FINISH 10/9/2002				SURF. ELEV. 237.05	
SHEET 1 OF 1				GW. DEPTH See Notes	
PROJECT: Bridge Reconstruction		LOCATION: Bostwick Rd. over Vermont Railway			
STATION: 21-02.408		OFFSET: 6.000' LT			
DEPTH FT.	SAMPL. NO.	BLOWS ON SAMPLER	REC. (FT)	SOIL OR ROCK CLASSIFICATION	NOTES
	1	8 7 5 6 12 05		ASPHALT	North side of east abutment.
				Fill: Brown rounded fine to medium GRAVEL and fine to coarse SAND, some silt (Moist - Firm)	
	2	2 2 2 2 4 08		Brown SILT with embedded SHALE FRAGMENTS (Moist - Soft)	
				Similar to Sample 2	
	3	2 3 2 1 5 08		Brown SILT & CLAY, trace fine sand as matrix material and as partings (Wet - Very Soft)	Samples become wet with groundwater at approx. 15'. At completion of core drilling, water level at ground surface (introduced water).
	4	2 1 1 1 2 10		Brown, grading gray, interbedded SILT & CLAY (Wet - Very Soft)	
	5	1 1 1 1 2 10		Gray SILT & very fine SAND with partings of clay & fine sand (Wet - Medium)	
	6	2 7 6 4 13 15		Gray fine SAND & SILT (Wet - Hard)	
	7	11 14 12 13 26 15		Gray SILT & fine to medium SAND with embedded rounded medium GRAVEL & SHALE FRAGMENTS (Wet)	Core drilled from 36.0' to 41.0'. Run 1: 36.0' - 41.0' 2.8' Recovery (56%) ROD = 8%. NX Core
	8	8 6		Iversville Shale; Gray, hard, weathered, laminated SLATE (weakly metamorphosed shale) with very hard, bedded siltstone layers. Veined with calcite and cut by 60 degree fractures (slaty cleavage) roughly parallel to relic bedding. Fracture surfaces frequently rust-stained. Completely shattered zones noted in recovered core, and as blockages wedged in core barrel washed away by drilling operation.	No losses of water noted while coring.
				Boring Terminated @ 41.0'	
<small>N = NO. BLOWS TO DRIVE 2-INCH SPOON 12-INCHES WITH A 140 LB. PIN WT. FALLING 30-INCHES PER BLOW DRILLER: Mike Leshgan DRILL RIG TYPE: CME 75 METHOD OF INVESTIGATION: # Flush Joint Casing, NX Diamond Core</small>					

NOTES

- BOTTOM OF FOOTING ELEVATION AT ABUTMENT NO. 1 = 223.20
- BOTTOM OF FOOTING ELEVATION AT ABUTMENT NO. 2 = 226.00

LEGEND

B.F. BOTTOM OF FOOTING ELEVATION

B.F.
ABUT.
NO. 1


DATE:		SUBSURFACE LOG		PJT. NO. AD-02-069	
START 10/8/2002				HOLE NO. B-2	
FINISH 10/8/2002				SURF. ELEV. 237.24	
SHEET 1 OF 1				GW. DEPTH See Notes	
PROJECT: Bridge Reconstruction		LOCATION: Bostwick Rd. over Vermont Railway			
STATION: 19-89.525		OFFSET: 6.250' RT			
DEPTH FT.	SAMPL. NO.	BLOWS ON SAMPLER	REC. (FT)	SOIL OR ROCK CLASSIFICATION	NOTES
	1	5 5 4 4 9 15		ASPHALT	South side of west abutment.
				Possible Fill; Brown SILT with embedded SHALE FRAGMENTS (Moist - Medium)	Samples 1 & 2 are "wet" due to introduction of water for casing advance and cleanout.
	2	2 1 1 2 2 10		Similar, very soft	
				Brown laminated SILT & CLAY (Moist - Medium)	
	3	2 7 7 9 14 15		Similar, with partings of fine sand; stiff, wet	Drilled from 17.5' to 18.5' with tricone bit.
	4	9 12 15 14 27 15		Iversville Shale; Gray, hard, weathered, laminated SLATE (weakly metamorphosed shale) with very hard, bedded siltstone layers. Veined with calcite and cut by 60 degree fractures (slaty cleavage) roughly parallel to relic bedding. Fracture surfaces frequently rust-stained. Completely shattered zones noted in recovered core, and as blockages wedged in core barrel washed away by drilling operation.	Core drilled from 18.5' to 28.5'. Run 1: 18.5' - 23.5' 3.0' Recovery (60%) ROD = 0%. Run 2: 23.5' - 28.5' 3.0' Recovery (60%) ROD = 16%. NX Core
				Run 1 very fractured throughout, as are uppermost and lowermost portions of Run 2. Slickensided surfaces noted at base of Run 1.	No losses of water noted while coring.
				Boring Terminated @ 28.5'	Samples become wet at approx. 18'. Prior to core drilling, water level inside casing at 18' below ground surface.
<small>N = NO. BLOWS TO DRIVE 2-INCH SPOON 12-INCHES WITH A 140 LB. PIN WT. FALLING 30-INCHES PER BLOW DRILLER: Mike Leshgan DRILL RIG TYPE: CME 75 METHOD OF INVESTIGATION: # Flush Joint Casing, NX Diamond Core</small>					




McFarland-Johnson, Inc.

**STATE OF VERMONT
AGENCY OF TRANSPORTATION**

Town Of	SHELBURNE	Bridge No.	15
Highway No.	TH 3	Log Sta.	
		Surv. Sta.	
BOSTWICK ROAD OVER VERMONT RAILWAY			
BORING LOGS			
Designed By	SJB SERVICES, INC.	Drawn By	S. MERKMAN
Checked By	L. WIXSON	Bridge Design Supervisor	M. ZYDEL
PROJECT	SHELBURNE	PROJECT NO.	BRO 1445(30)
I.G.C. Info. MNS95402_BostwickBRIDGE.dwg			
Bridge Sheet No.	BRO2	Sheet	42 of 73

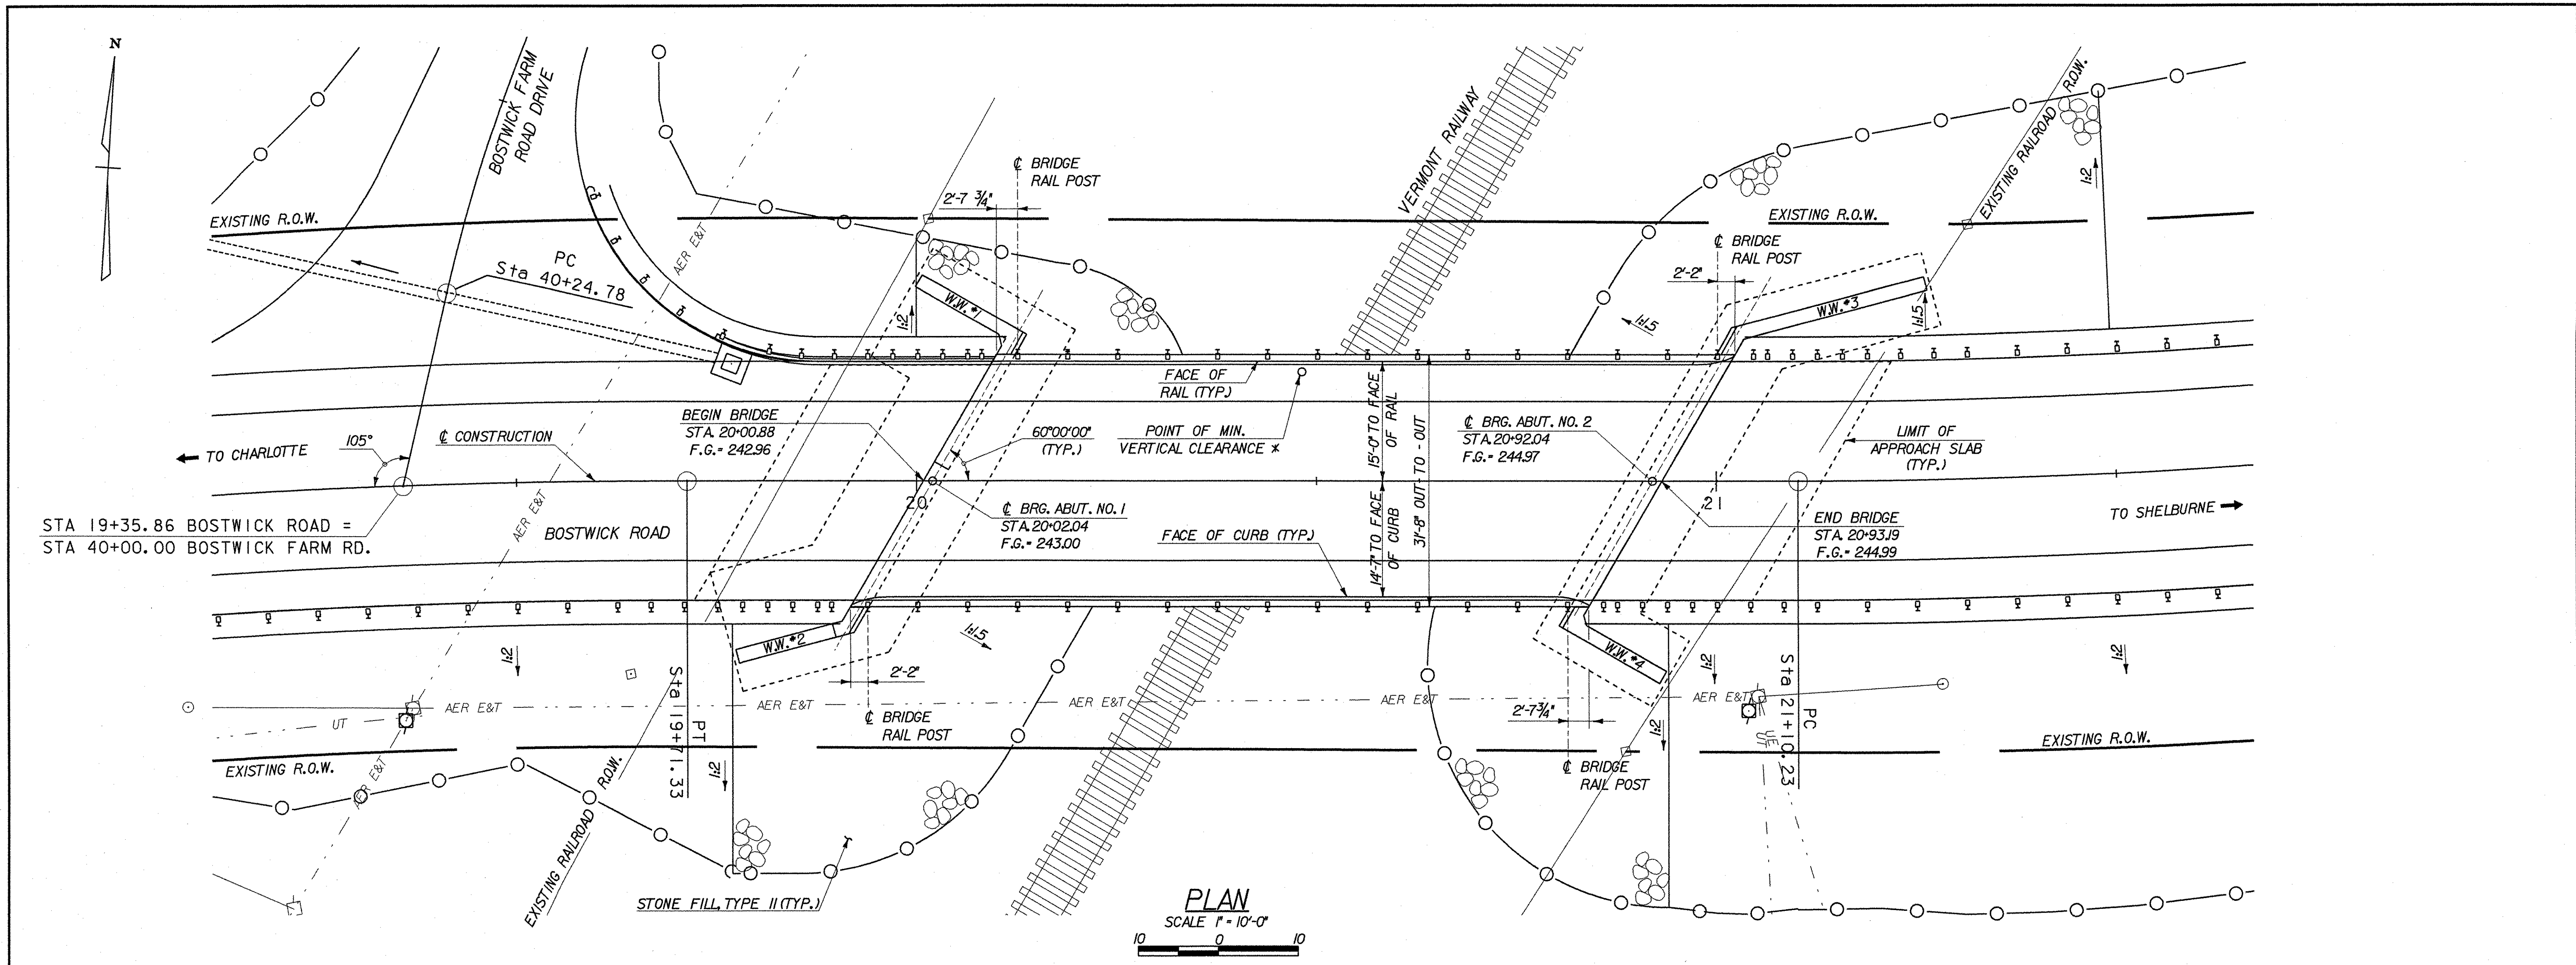

PLAN
SCALE 1" = 10'-0"

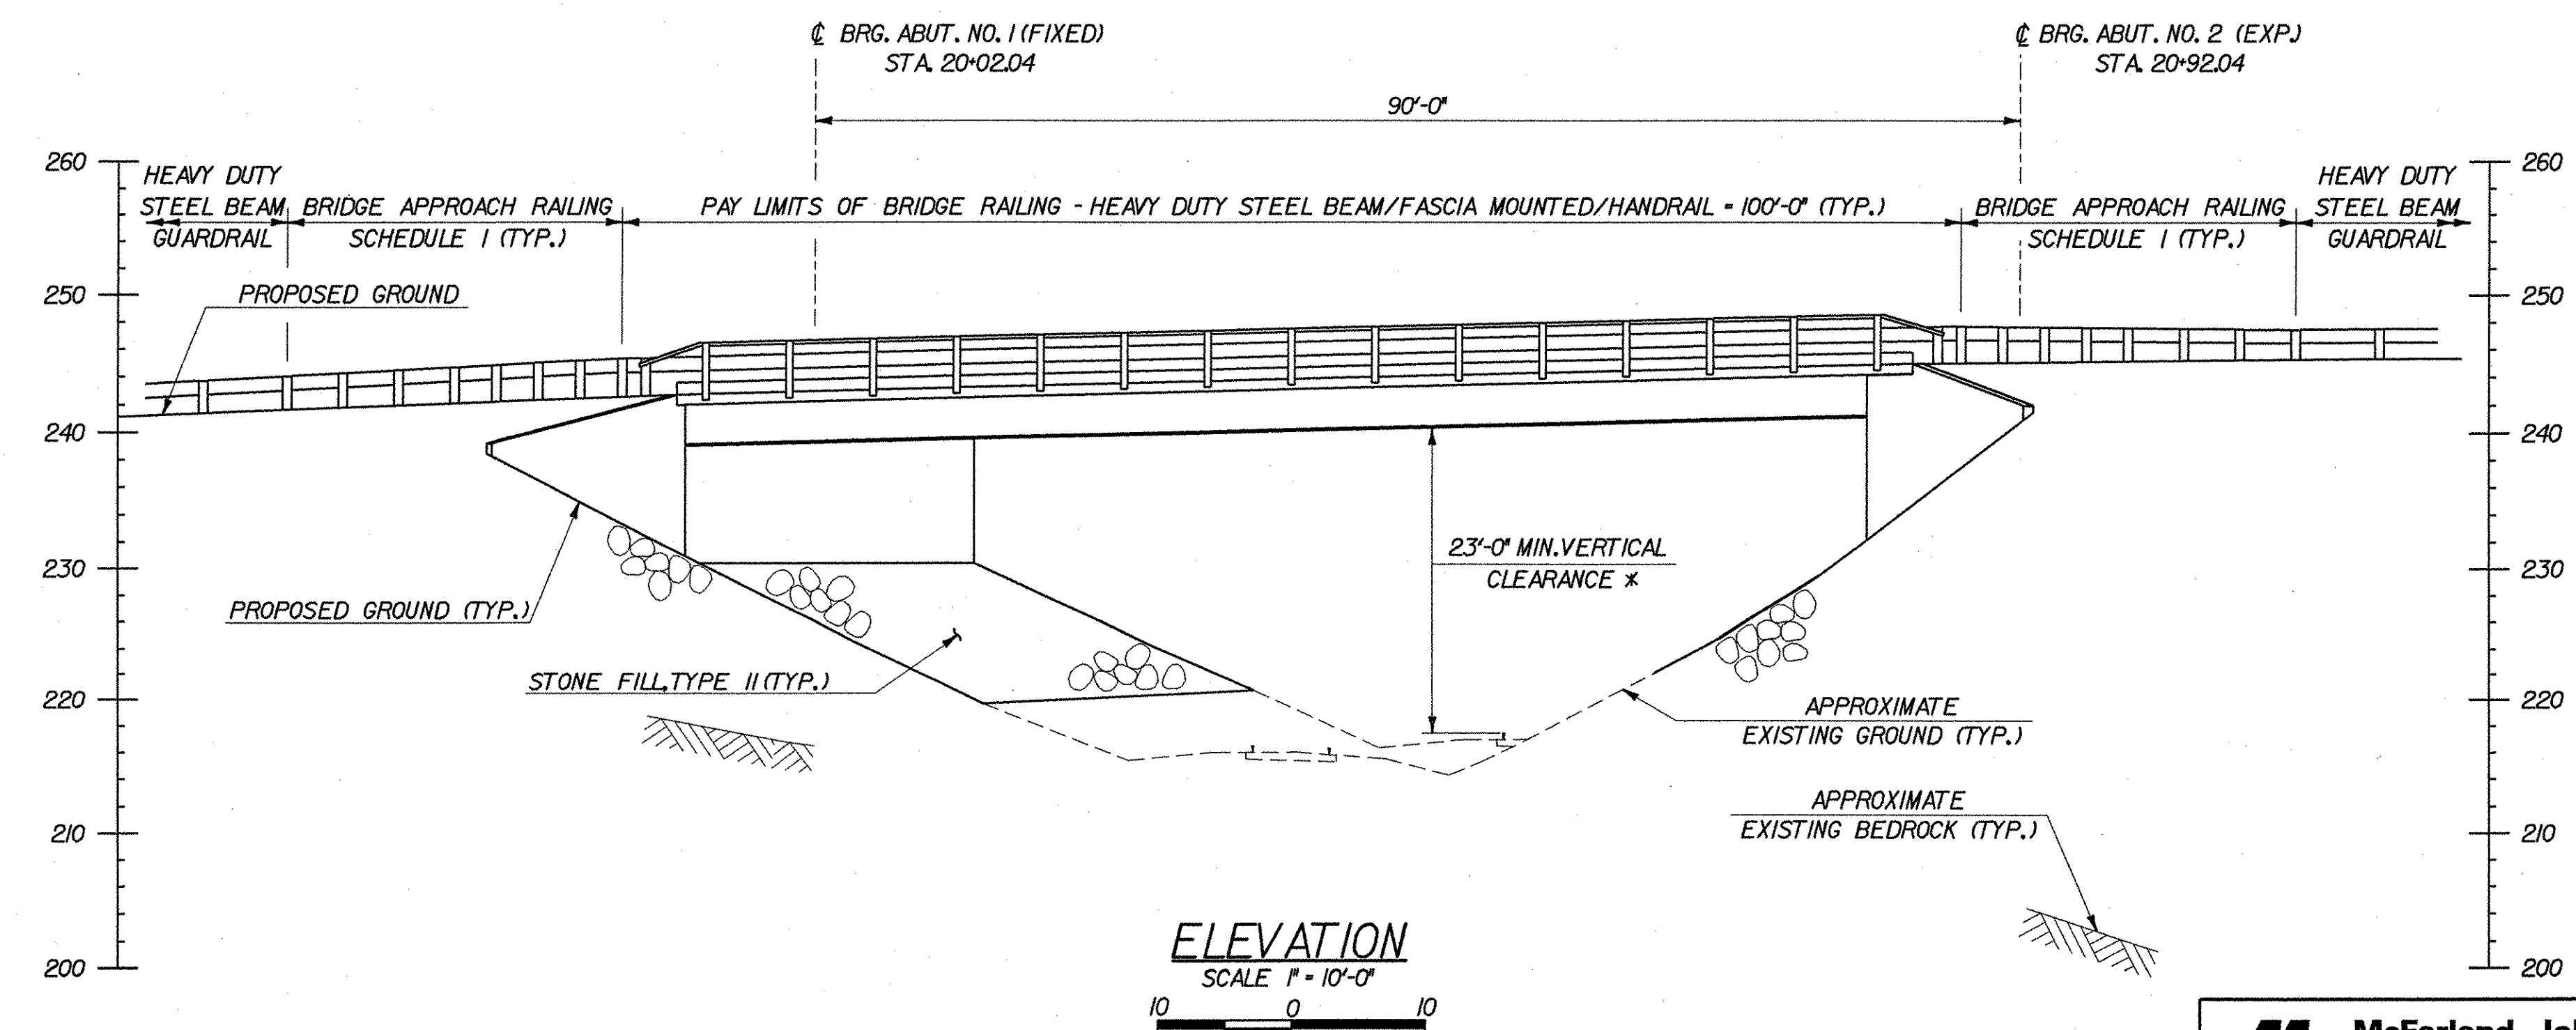



ELEVATION
SCALE 1" = 10'-0"

* VERTICAL CLEARANCE WAS CALCULATED AT A POINT 6'-1/2" FROM THE CENTERLINE OF TRACK AT TOP OF RAIL. EXISTING TRACK SUPERELEVATION WAS CONSIDERED.

STATE OF VERMONT AGENCY OF TRANSPORTATION	
Town Of SHELBURNE	Bridge No. 15
Highway No. TH 3	Log Sta. Surv. Sta.
BOSTWICK ROAD OVER VERMONT RAILWAY	
PLAN AND ELEVATION	
Designed By L. WIXSON	Drawn By B. COLBURN
Checked By R. JOY	Date 05/03 M. ZYDEL Date 05/03
PROJECT SHELBURNE	PROJECT NO. BRO 1445(30)
I.G.C. Info. M:\595402_Bostwick\BRIDGE\6m\larz\196gpe.dgn	
Bridge Sheet No. BRI03	Sheet 43 of 73



PLOTTED 01-AUG-2003

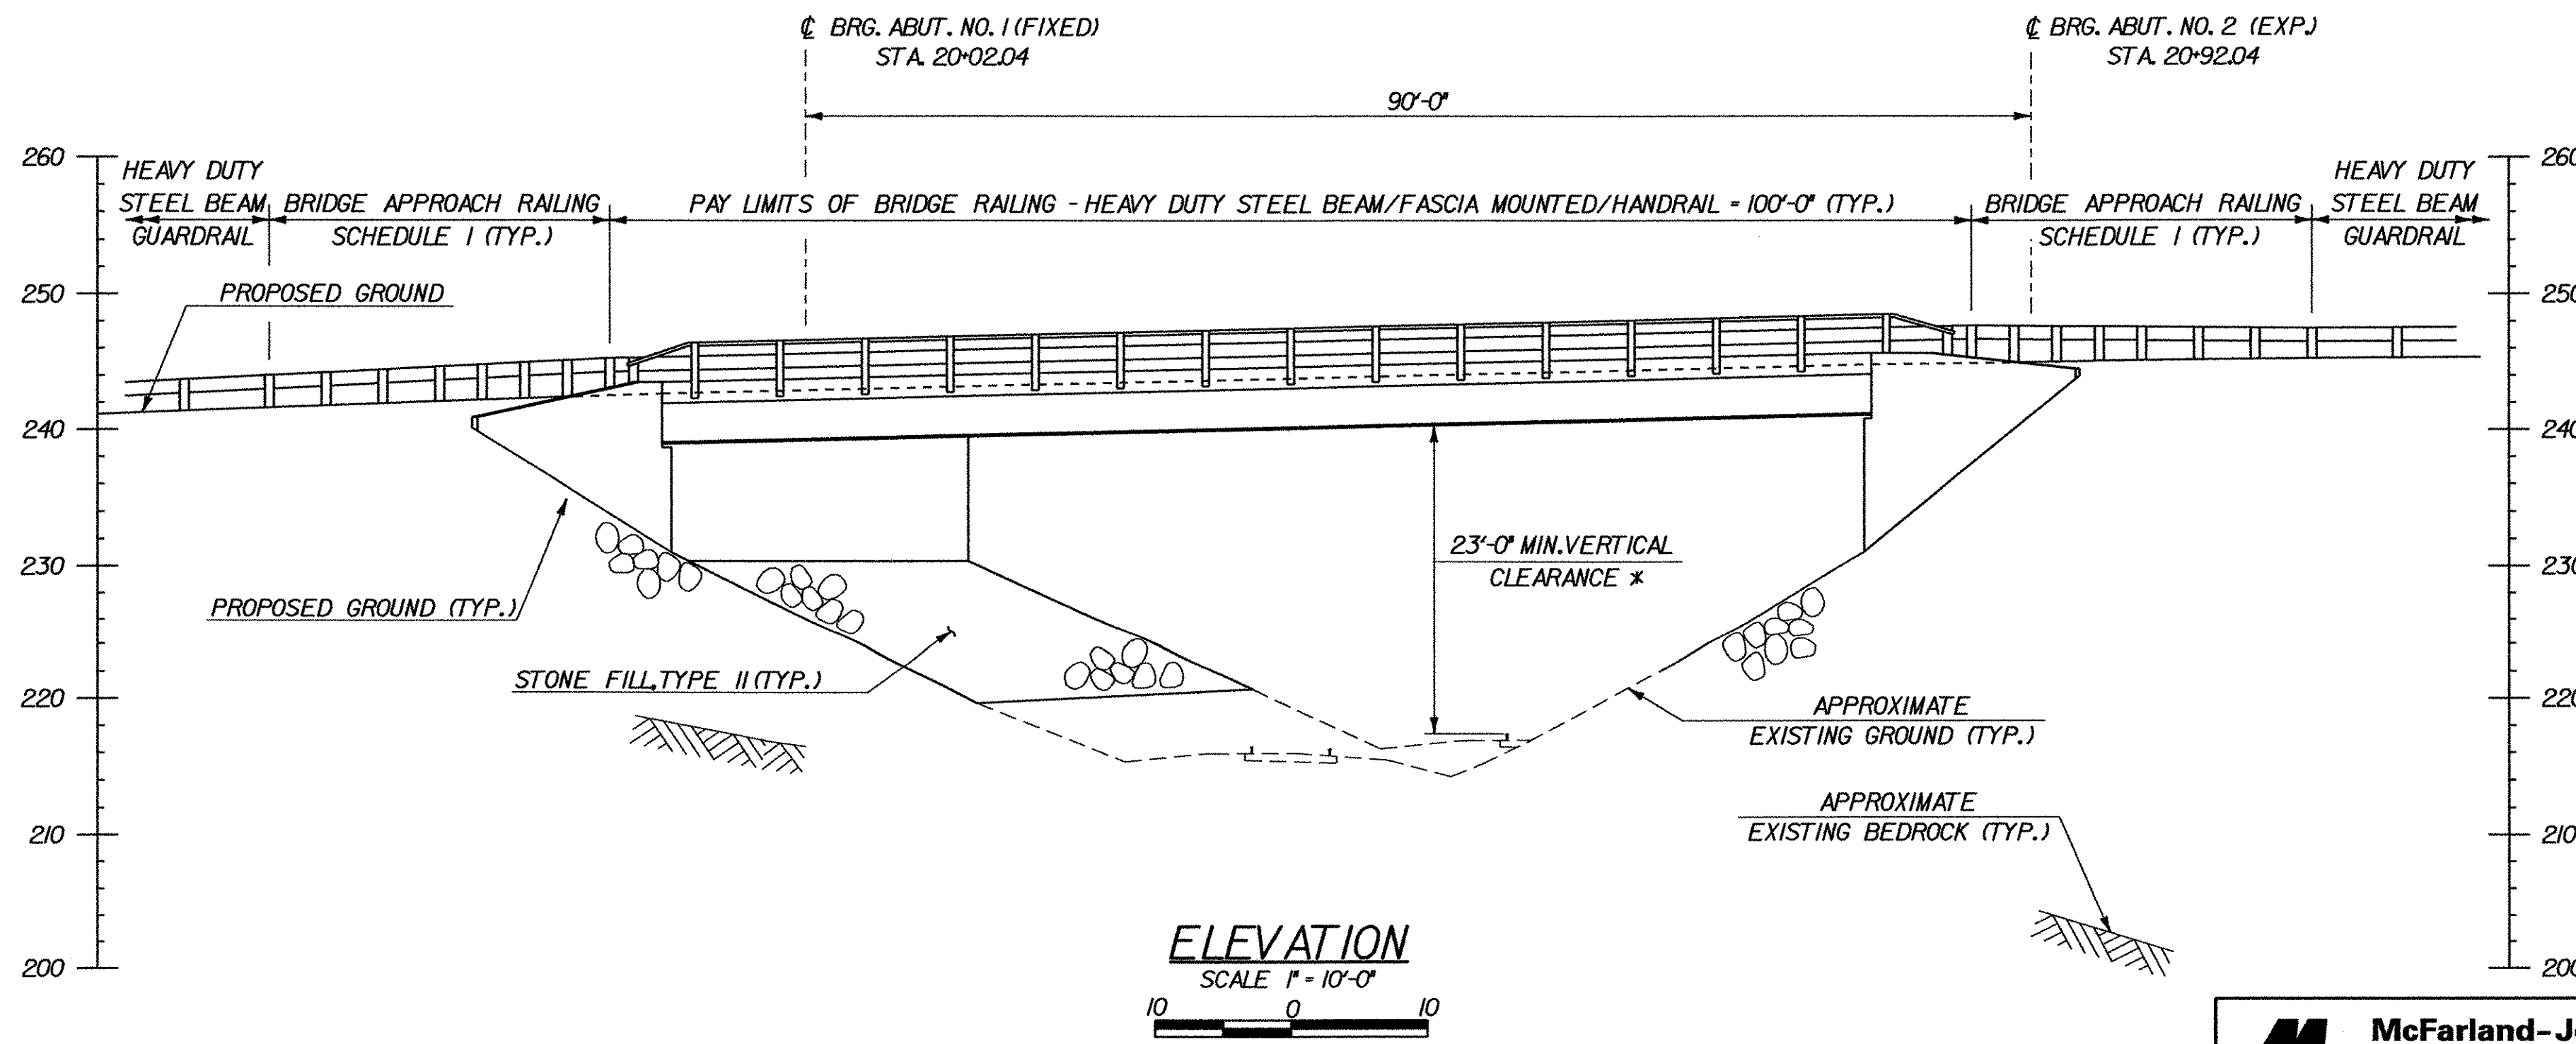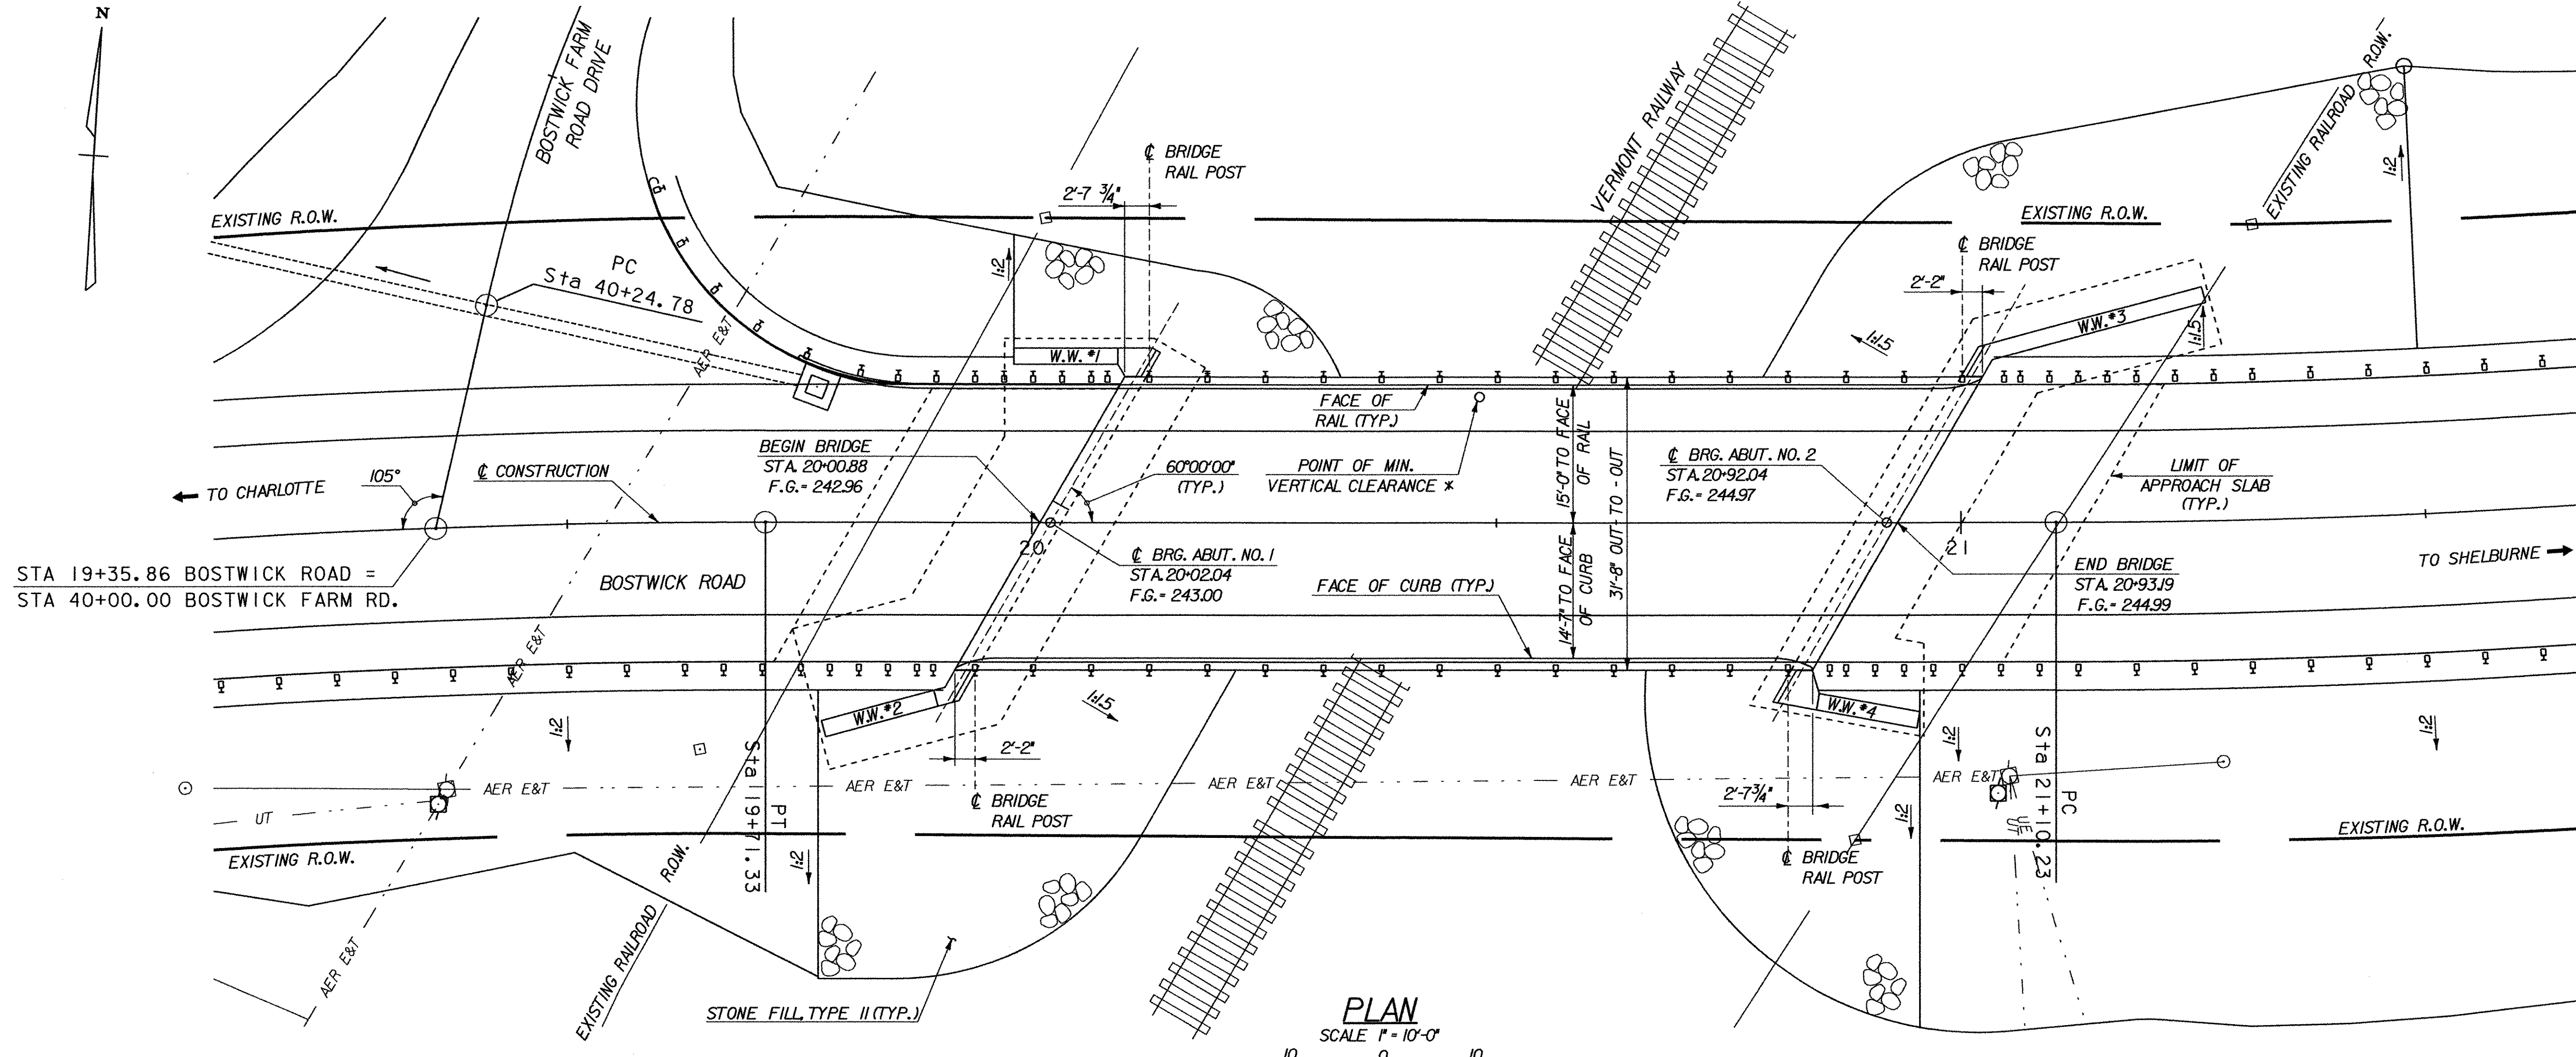

* VERTICAL CLEARANCE WAS CALCULATED AT A POINT 6'-1/2" FROM THE CENTERLINE OF TRACK AT TOP OF RAIL. EXISTING TRACK SUPERELEVATION WAS CONSIDERED.

- ▲ WINGWALL NO. 4 LAYOUT REVISED
- ▲ WINGWALL NO. 1 LAYOUT REVISED

STATE OF VERMONT AGENCY OF TRANSPORTATION	
Town Of SHELBURNE	Bridge No. 15
Highway No. TH 3	Log Sta. Surv. Sta.
BOSTWICK ROAD OVER VERMONT RAILWAY PLAN AND ELEVATION (REVISED)	
Designed By L. WIXSON	Drawn By S. MERKMAN
Checked By R. JOY	Bridge Design Supervisor Date 03/04
PROJECT SHELBURNE	PROJECT NO. BRO 1445(30)
I.G.C. Info. G:\Structures\STR3_Roger Whitcomb\Consultants\McFarland-Johnson\Shelburne	
Bridge Sheet No. BRO3B	Sheet 43B of 73



PLOTTED 24-MAR-2004

GENERAL NOTES

1. ALL MATERIALS AND CONSTRUCTION SHALL CONFORM TO STATE OF VERMONT, AGENCY OF TRANSPORTATION STANDARD SPECIFICATIONS FOR HIGHWAY AND BRIDGE CONSTRUCTION, DATED 2001, AND ITS LATEST REVISIONS, AND THE AASHTO STANDARD SPECIFICATIONS FOR HIGHWAY BRIDGES, AND ITS LATEST REVISIONS.
2. DESIGN IS FOR HS25 LOADING, USING LOAD FACTOR METHOD.
3. ALL STRUCTURAL STEEL SHALL BE DETAILED AND FABRICATED USING PROCEDURES AND TOLERANCES IN ACCORDANCE WITH SECTION 506.03 OF THE STANDARD SPECIFICATIONS.
4. AFTER SUPERSTRUCTURE STEEL HAS BEEN ERECTED, ELEVATIONS ALONG THE TOP OF THE GIRDERS SHALL BE TAKEN AS DIRECTED BY THE ENGINEER FOR USE IN DETERMINING FINAL GRADE.
5. ANY BOLT HOLES IN THE WEB OF THE FASCIA GIRDERS NOT OTHERWISE FILLED SHALL BE FILLED WITH BUTTON HEAD OR HEX HEAD BOLTS COMPATIBLE WITH THE GIRDER STEEL. THE BOLTS SHALL BE TIGHTENED IN ACCORDANCE WITH SUBSECTION 506.19.
6. FASCIA OVERHANG BRACKETS SHALL BE SPACED AT A MAXIMUM OF 4 FEET AND SHALL BE DESIGNED BY THE CONTRACTOR.
7. ALL FIELD CONNECTIONS SHALL BE MADE USING $\frac{7}{8}$ INCH DIAMETER BOLTS MEETING ASTM DESIGNATION A 325 (AASHTO M 164). HOLES SHALL BE $\frac{9}{16}$ INCH DIAMETER. ANY CONNECTIONS NOT DESIGNATED SHALL BE DETAILED BY THE FABRICATOR.
8. ALL WELDING AND DIMENSIONAL TOLERANCES OF WELDED MEMBERS SHALL CONFORM TO THE LATEST ANSI/AASHTO/AWS D1.5 - 95 CODE AND LATEST REVISIONS.
9. THE UNIT WEIGHT OF SOIL SHALL BE TAKEN AS 140 PCF.
10. ALL REINFORCING STEEL IN THE CONCRETE DECK, CURBS AND APPROACH SLABS SHALL BE EPOXY COATED AND PAID FOR UNDER ITEM 507. IF WHEN EPOXY COATED REBAR IS CUT, THE UNCOATED ENDS SHALL BE REPAIRED WITH MATERIALS AND PROCEDURES APPROVED BY THE COATING MANUFACTURER. FLAME CUTTING OF EPOXY COATED REBAR WILL NOT BE PERMITTED.
11. REINFORCING PLACEMENT TOLERANCES SHALL BE:
SPACING: +/- 1 INCH
CLEARANCE: +/- $\frac{1}{4}$ INCH
12. MINIMUM COVER FOR REINFORCING STEEL IN SUBSTRUCTURES SHALL BE 2" ALONG BACK FACES OF WALLS AGAINST EARTH AND 3" ELSEWHERE, UNLESS OTHERWISE DESIGNATED ON PLANS.
13. DECK AND CURBS SHALL BE "CONCRETE, HPC CLASS A". ALL OTHER CONCRETE SHALL BE "CONCRETE, HPC CLASS B" UNLESS OTHERWISE DESIGNATED ON THE PLANS.
14. ALL EXPOSED EDGES OF CONCRETE SHALL BE CHAMFERED 1" x 1".
15. THE FOLLOWING THICKNESS TOLERANCES SHALL BE ADHERED TO:

MATERIAL	THICKNESS TOLERANCE
BIT. CONC. PAVEMENT (ON BRIDGE)	+/- $\frac{1}{8}$ "
BIT. CONC. PAVEMENT (OFF BRIDGE)	+/- $\frac{1}{4}$ " LIFT
GRANULAR BORROW	+/- 1"
SUBBASE	+/- 1"
16. WATER REPELLENT SHALL BE APPLIED TO ALL EXPOSED CONCRETE SURFACES EXCEPT THE UNDERSIDE OF THE DECK BETWEEN DRIP BEADS.
17. ALL DIMENSIONS ARE HORIZONTAL OR VERTICAL AND ARE GIVEN AT 68°F.
18. TRAFFIC WILL BE DETOURED, DURING CONSTRUCTION OF THE BRIDGE.
19. TRAFFIC SHALL BE ALLOWED ON THE NEW BRIDGE ONLY AFTER THE SPECIFIED CURE PERIOD HAS EXPIRED AND THE 28 DAY DESIGN STRENGTH HAS BEEN REACHED, AS EVIDENCED BY TEST CYLINDERS CURED UNDER FIELD CONDITIONS.
20. JOINTS AND SCORE MARKS IN CONCRETE SHALL BE CONSTRUCTED AS INDICATED ON THE PLANS OR AS DIRECTED BY THE ENGINEER.
21. THE KEY IN CONSTRUCTION JOINTS SHALL BE MONOLITHIC AND CONTINUOUS FOR THE FULL LENGTH OF THE JOINT.
22. ITEM 529.15, "REMOVAL OF STRUCTURE", SHALL INCLUDE THE REMOVAL OF THE SUPERSTRUCTURE, ABUTMENTS AND PIERS TO 1 FOOT BELOW EXISTING GROUND LINE OR AS REQUIRED FOR THE NEW SUBSTRUCTURE ELEMENTS. THE STRUCTURAL STEEL SHALL REMAIN THE PROPERTY OF THE STATE AND SHALL BE DELIVERED TO AND OFF-LOADED AT THE DISTRICT 5 HEADQUARTERS IN COLCHESTER. DTA RICHARD HOSKING SHALL BE NOTIFIED TWO WEEKS PRIOR TO DELIVERY TO MAKE FINAL ARRANGEMENTS FOR DISPOSITION OF BEAMS.
23. DECK POURS ARE TO BE CONSTRUCTED IN ONE CONTINUOUS OPERATION WITH A MAXIMUM DURATION OF 8 HOURS. IF CIRCUMSTANCES BEYOND THE CONTRACTOR'S CONTROL PREVENT THIS FROM BEING ACCOMPLISHED, A 96 HOUR DELAY BETWEEN THE COMPLETION OF ONE DAY'S POUR AND THE BEGINNING OF ANOTHER DECK POUR SHALL BE OBSERVED.
24. STEEL HP12 x 74 (GRADE 50) PILES SHALL BE DRIVEN TO A REQUIRED ULTIMATE CAPACITY EQUAL TO 825 KIPS. PILE TIP REINFORCEMENT SHALL CONFORM TO SUBSECTION 505.04(D). STEEL PILING SHALL CONFORM TO ASTM A572.

STRUCTURAL STEEL NOTES

1. ALL NEW STEEL SHALL BE AASHTO M270 GRADE 50W.
2. CONNECTION PLATES SHALL BE PERPENDICULAR TO FLANGES.
3. ENDS OF GIRDERS SHALL BE FABRICATED TO BE PLUMB UNDER FULL DEAD LOAD AND SUPERIMPOSED DEAD LOAD.
4. ALL TENSION FLANGES, AND WEBS SHALL HAVE "CHARPY V-NOTCH TEST" PERFORMED AS SPECIFIED IN SUBSECTION 714.01 AND 714.03.
5. SHEAR CONNECTORS SHALL BE FIELD WELDED USING AUTOMATICALLY TIMED STUD WELDING EQUIPMENT AND SHALL BE PAID AS ITEM 508.15, SHEAR CONNECTORS.
6. ITEM 506.55, STRUCTURAL STEEL (PLATE GIRDER), SHALL INCLUDE GIRDERS, CONNECTION PLATES, AND DIAPHRAGMS.

SPECIAL NOTE

1. ABUTMENT NO. 1, INCLUDING WINGWALLS, SHALL BE CONSTRUCTED TO BEAM SEAT ELEVATION AT LEAST 30 DAYS PRIOR TO PLACEMENT OF STRUCTURAL STEEL.

STATE OF VERMONT AGENCY OF TRANSPORTATION

Town Of	SHELBURNE	Bridge No.	15
Highway No.	TH 3	Log Sta.	
		Surv. Sta.	

BOSTWICK ROAD OVER VERMONT RAILWAY

GENERAL NOTES


Designed By	L. WIXSON	Drawn By	S. MERKMAN
Checked By	R. JOY	Bridge Design Supervisor	M. ZYDEL
Date	05/03	Date	05/03

PROJECT	SHELBURNE	PROJECT NO.	BRO 1445(30)
---------	-----------	-------------	--------------


I.G.C. Info. M:\585402_Bostwick\BRIDGE\6m\larz\1196gnt.dgn

Bridge Sheet No. BR104 Sheet 44 of 73



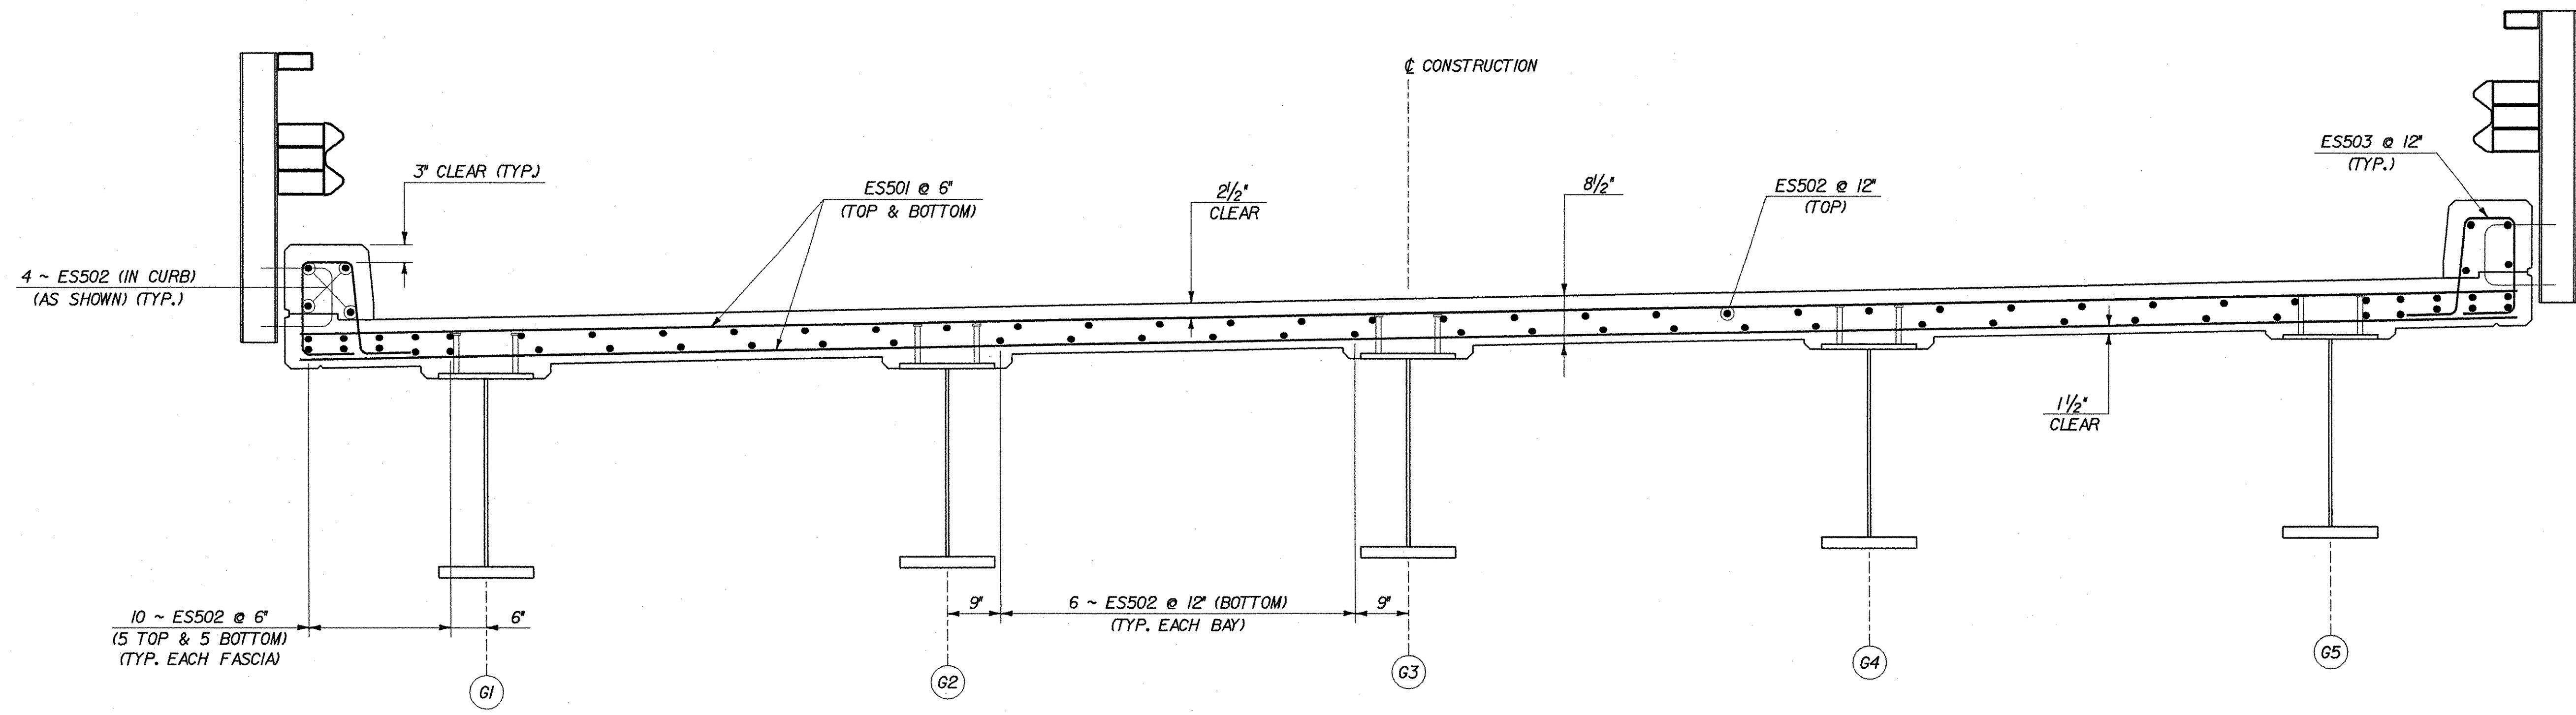

DECK TYPICAL SECTION
SCALE: 3/4" = 1'-0"

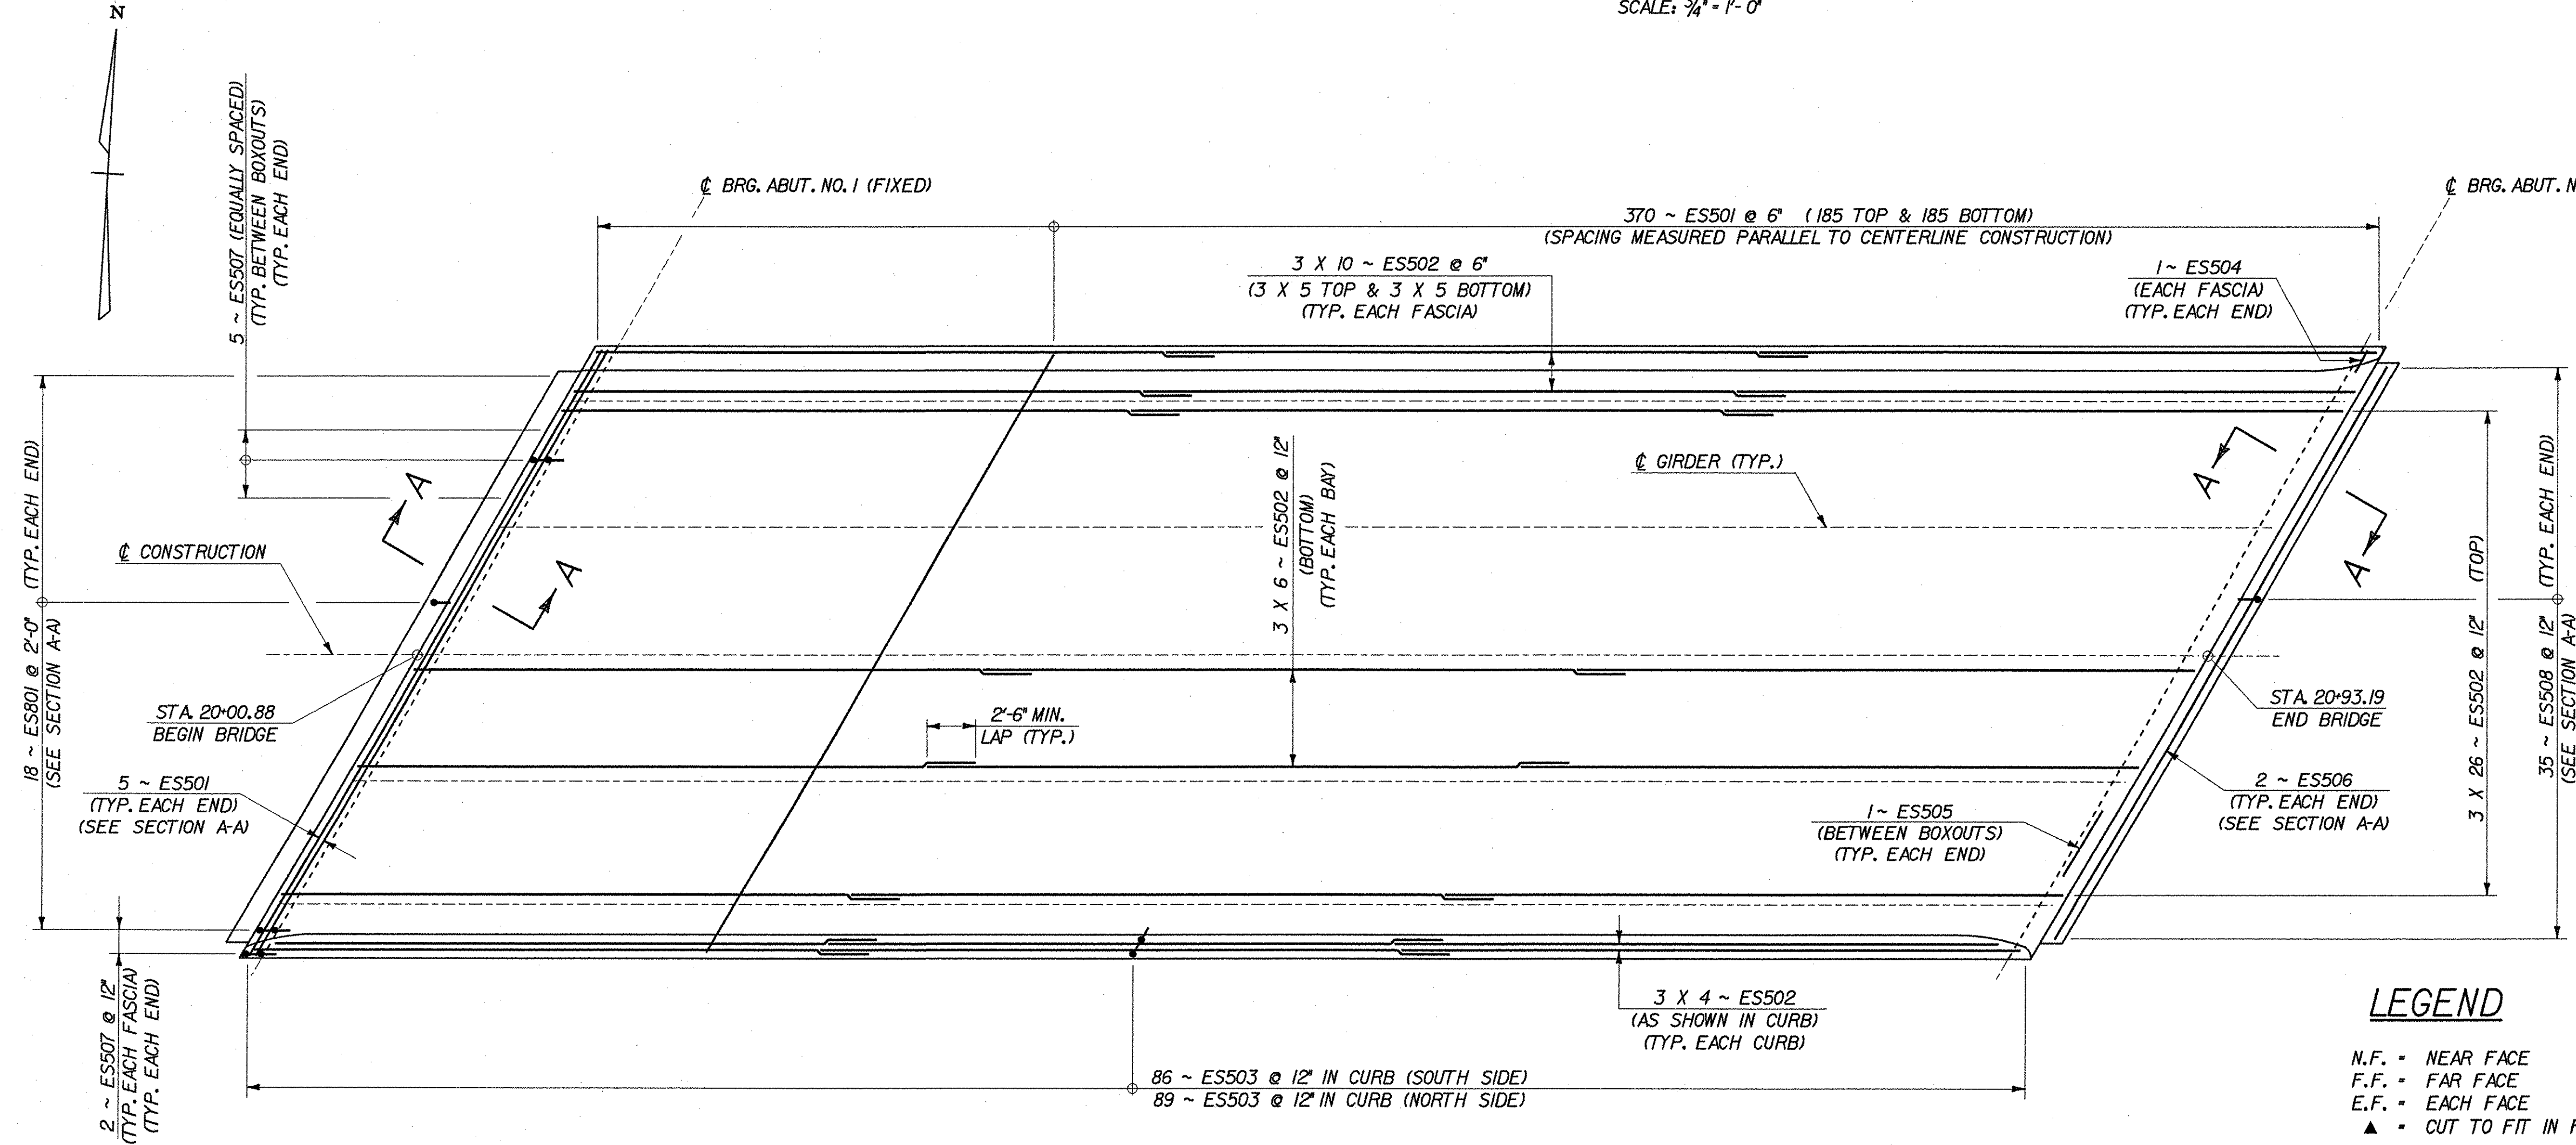

PLAN
SCALE: 7/16" = 1'-0"

NOTES

1. FOR SECTION A-A, SEE BRIDGE SHEET BR107.


LEGEND

- N.F. - NEAR FACE
- F.F. - FAR FACE
- E.F. - EACH FACE
- ▲ - CUT TO FIT IN FIELD


STATE OF VERMONT AGENCY OF TRANSPORTATION			
Town Of	<i>SHELBURNE</i>	Bridge No.	15
Highway No.	<i>TH 3</i>	Log Sta.	
		Surv. Sta.	
BOSTWICK ROAD OVER VERMONT RAILWAY DECK REINFORCEMENT DETAILS			
Designed By	<i>L. WIXSON</i>	Drawn By	<i>S. MERKMAN</i>
Checked By	<i>R. JOY</i>	Bridge Design Supervisor	<i>M. ZYDEL</i>
Date	<i>05/03</i>	Date	<i>05/03</i>
PROJECT	<i>SHELBURNE</i>	PROJECT NO.	<i>BR0 1445(30)</i>
I.G.C. Info. <i>M:\595402_Bostwick\BRIDGE\mrylar\z\196dbr.dgn</i>			
Bridge Sheet No.	<i>BR105</i>	Sheet	45 of 73




PLOTTED 01-AUG-2003

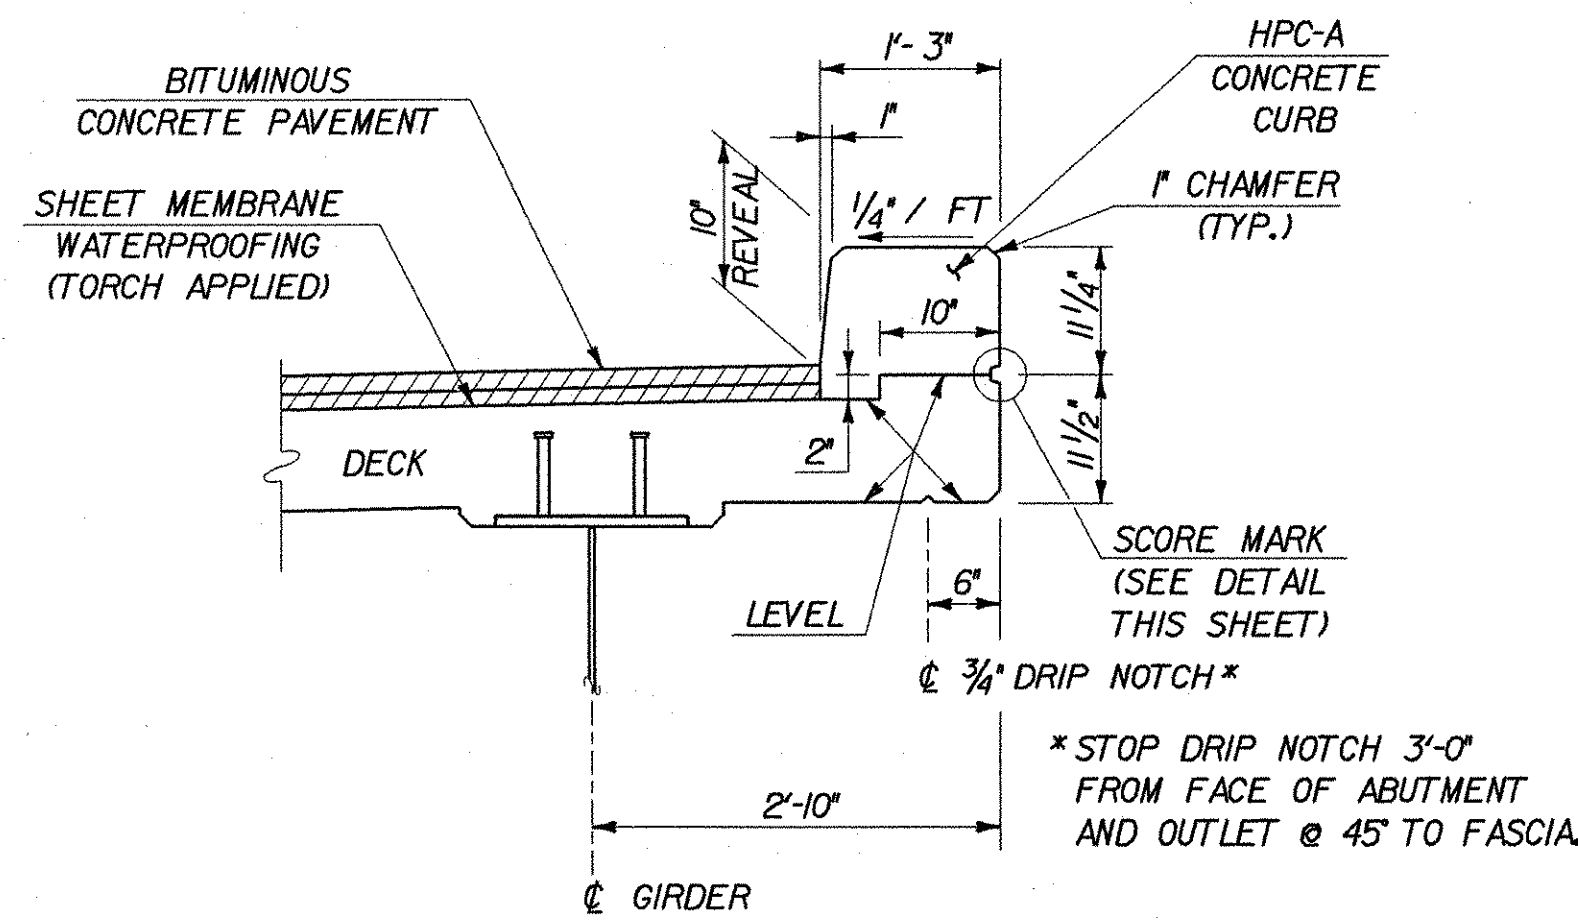

TYPICAL CURB DETAIL
SCALE: 3/4" = 1'-0"

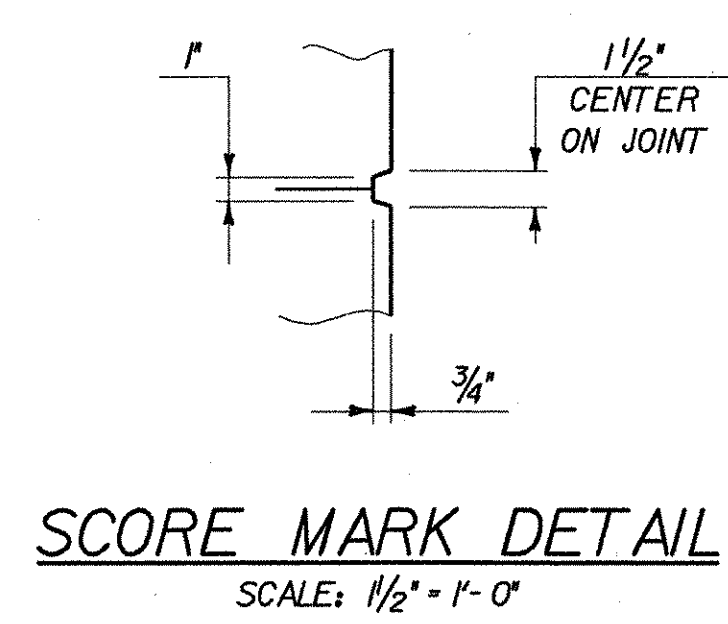


SCORE MARK DETAIL
SCALE: 1/2" = 1'-0"

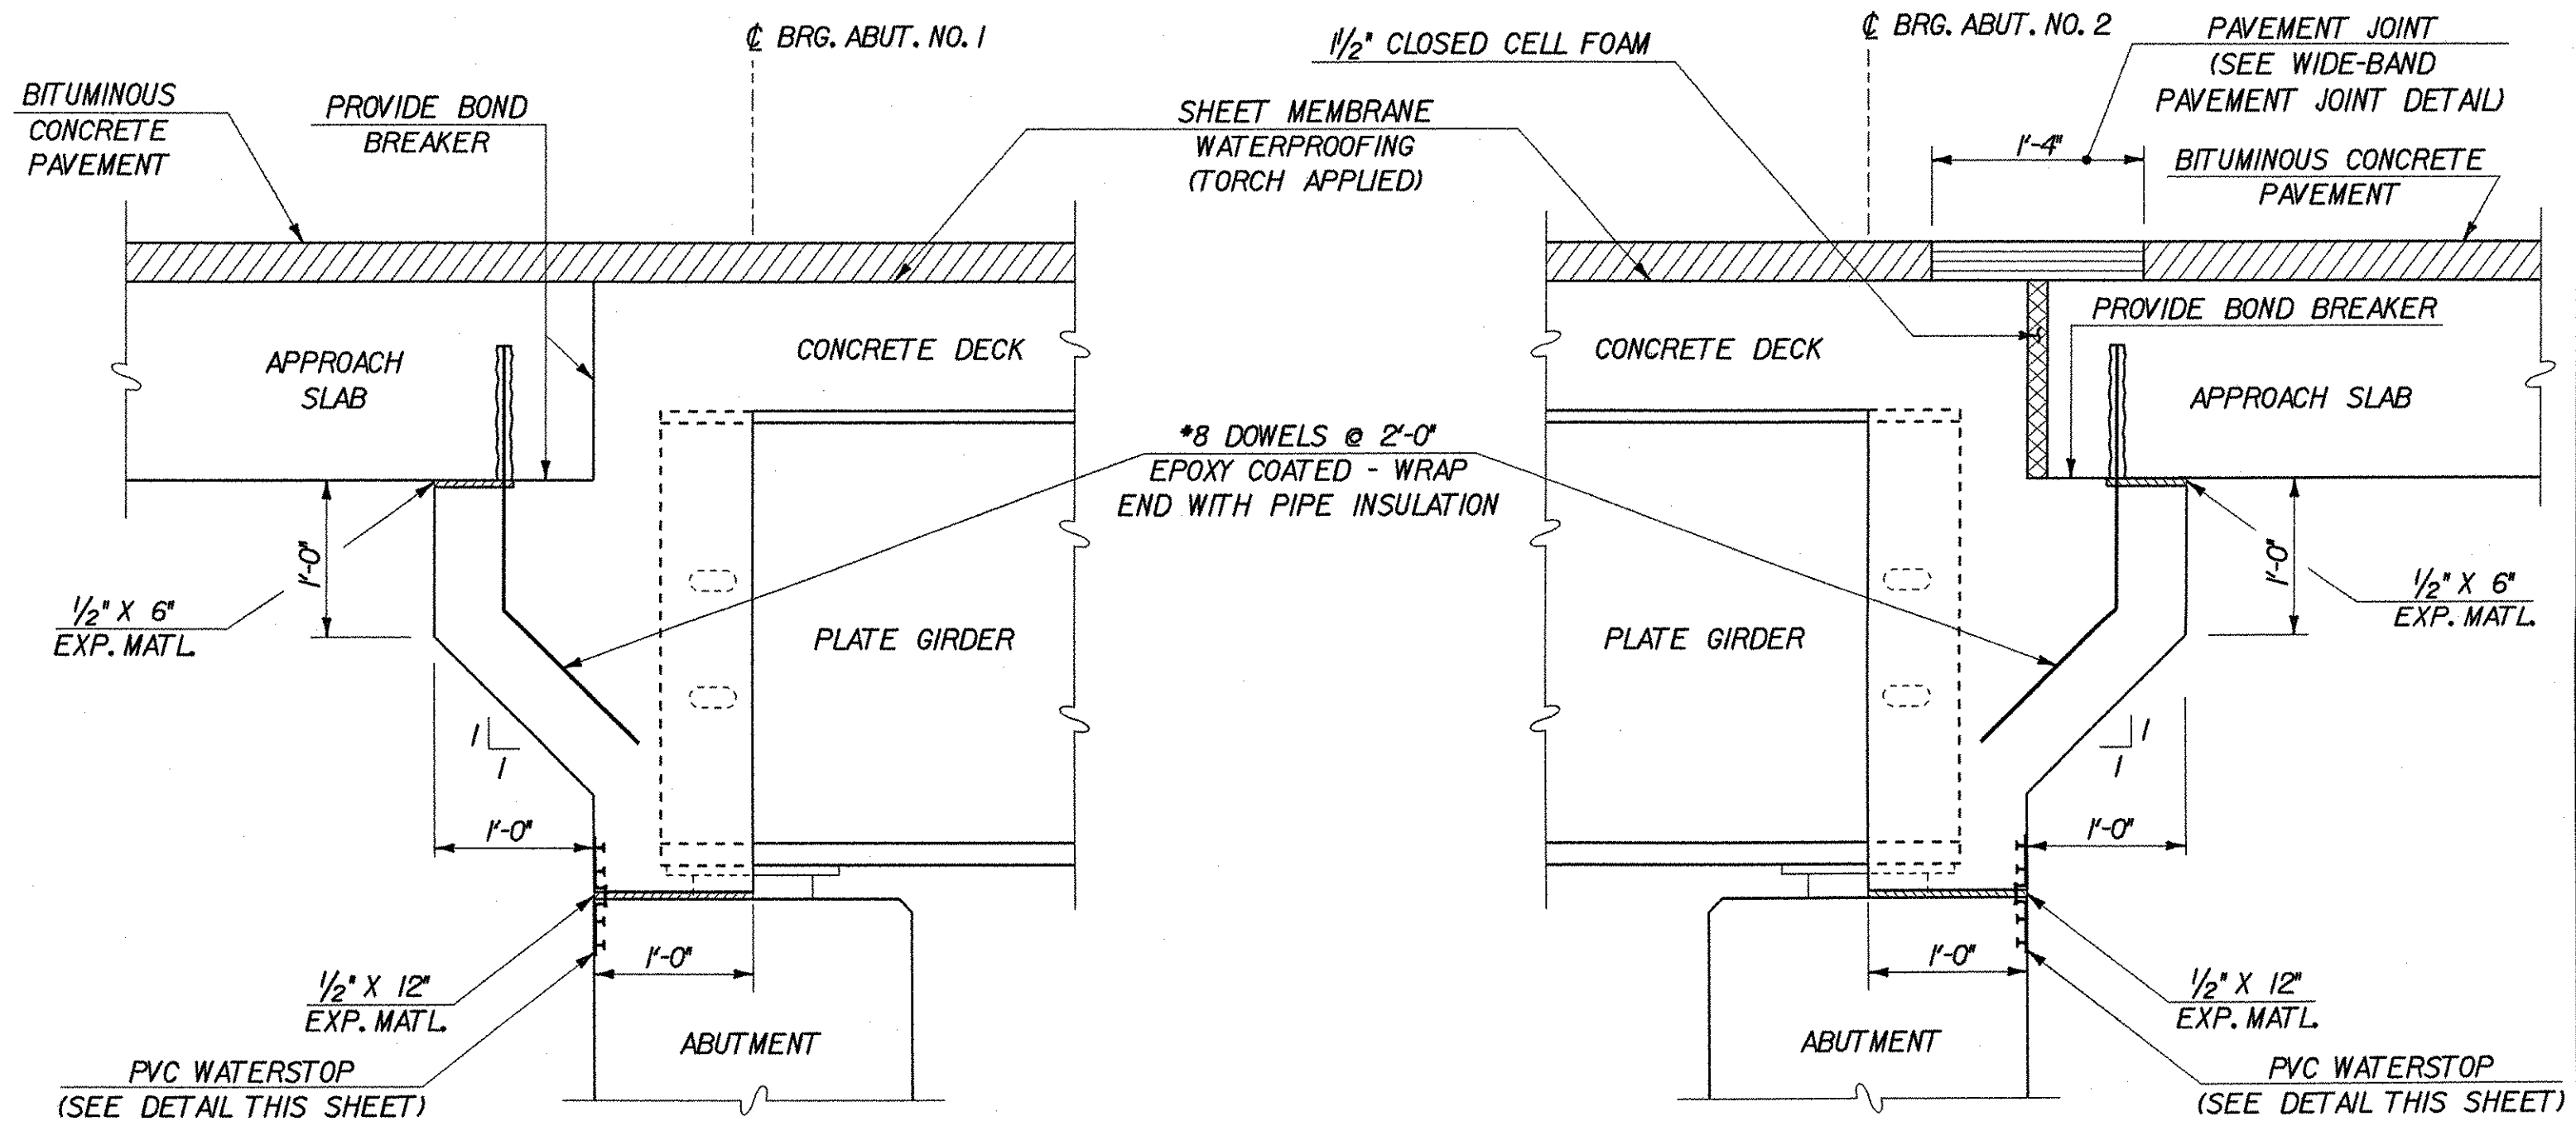


DECK END DETAIL (FIXED)
SCALE: 1" = 1'-0"


DECK END DETAIL (EXPANSION)
SCALE: 1" = 1'-0"

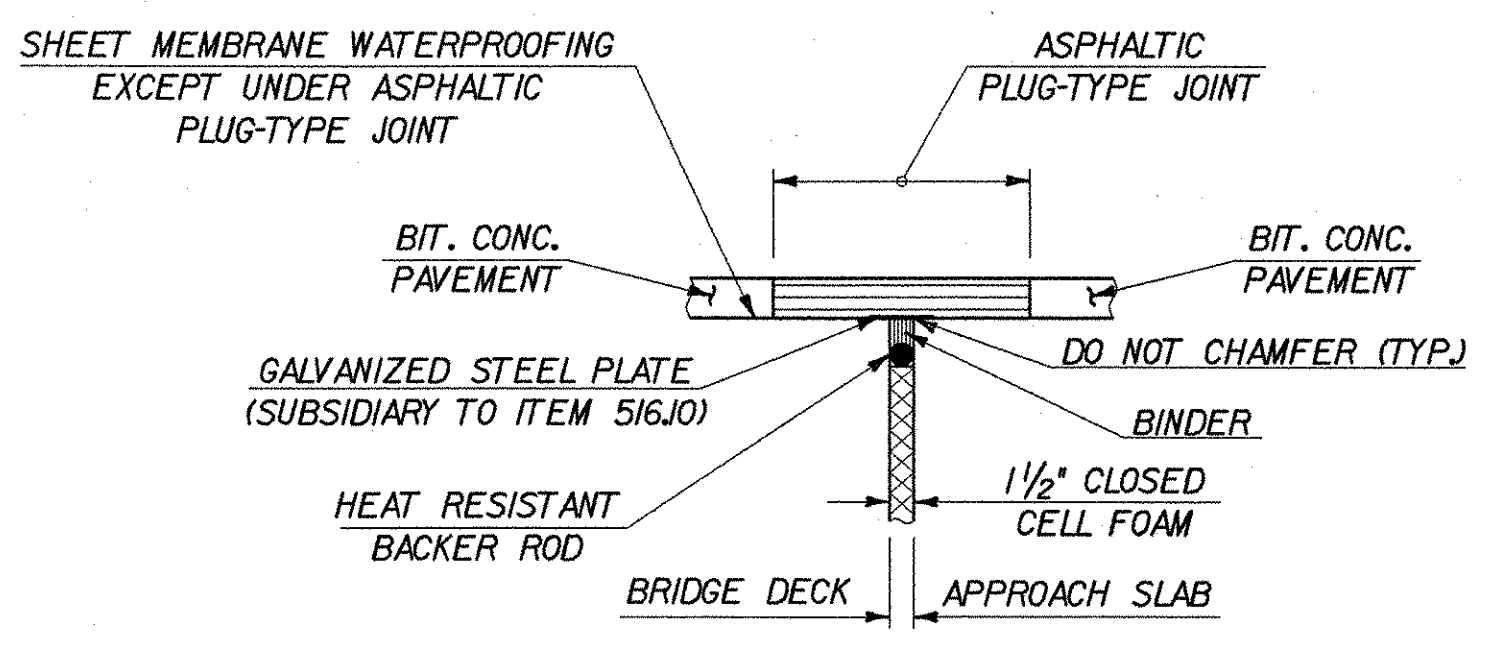


WIDE-BAND PAVEMENT JOINT DETAIL
NOT TO SCALE

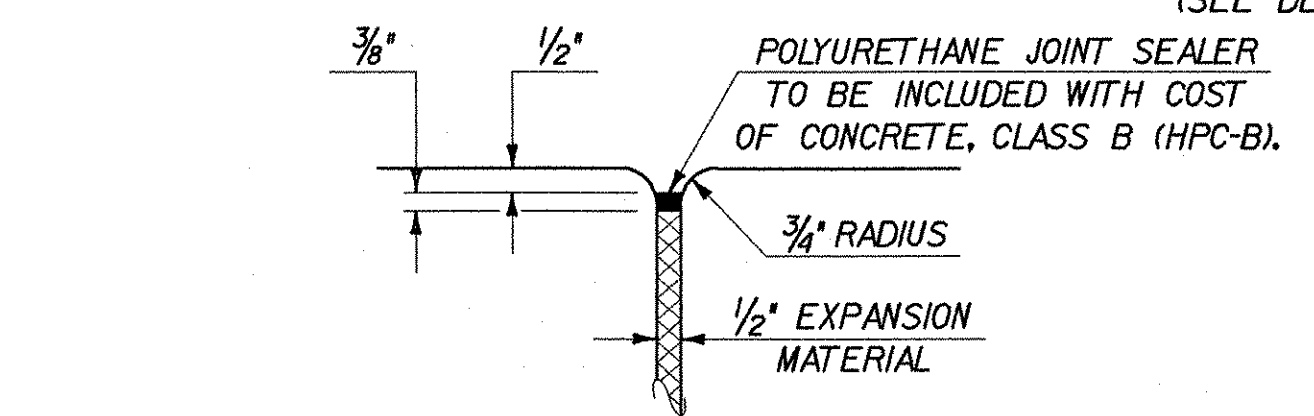


JOINT BETWEEN FASCIA AND WINGWALL
SCALE: 3" = 1'-0"

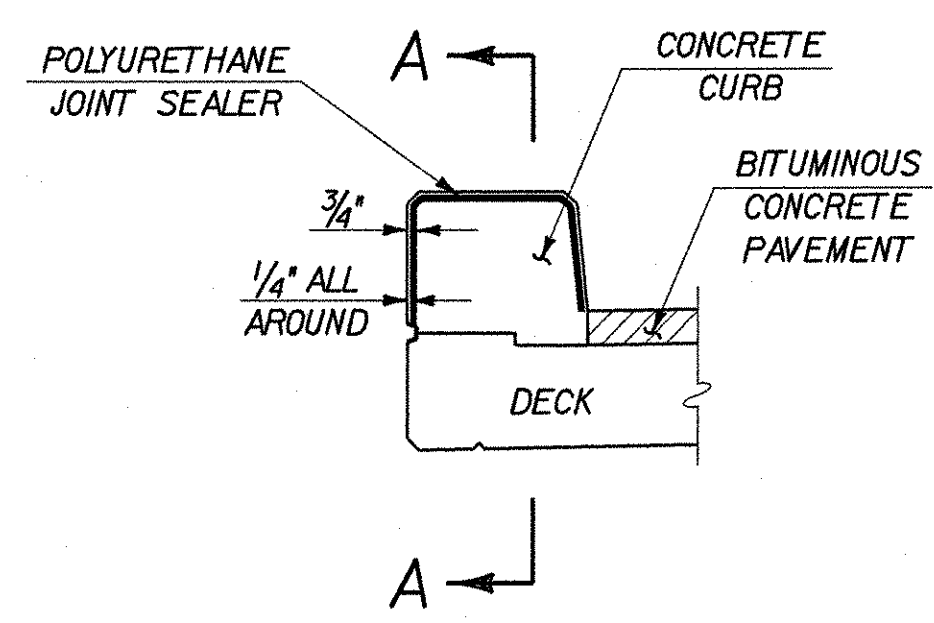


CONCRETE CURB CONSTRUCTION JOINT
SCALE: 3/4" = 1'-0"

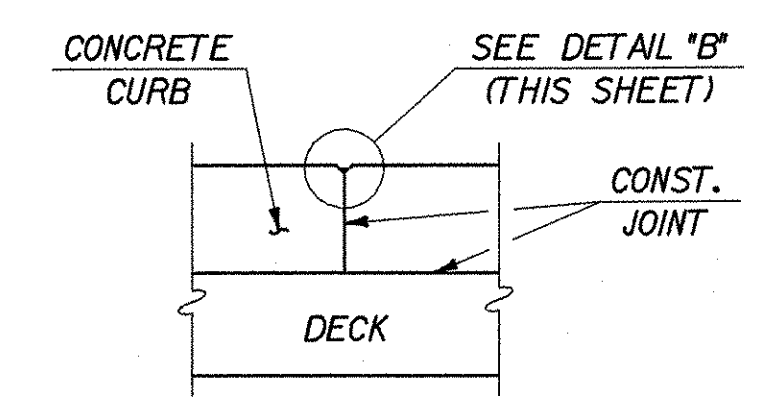

SECTION A-A
SCALE: 3/4" = 1'-0"

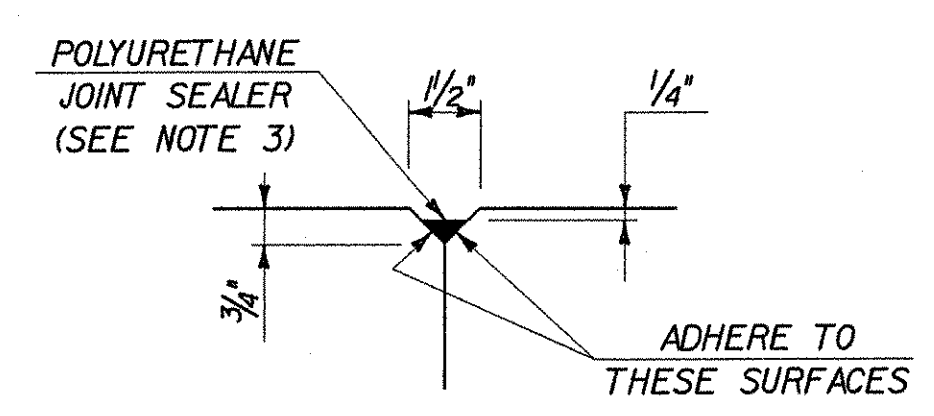


DETAIL "B"
SCALE: 3" = 1'-0"

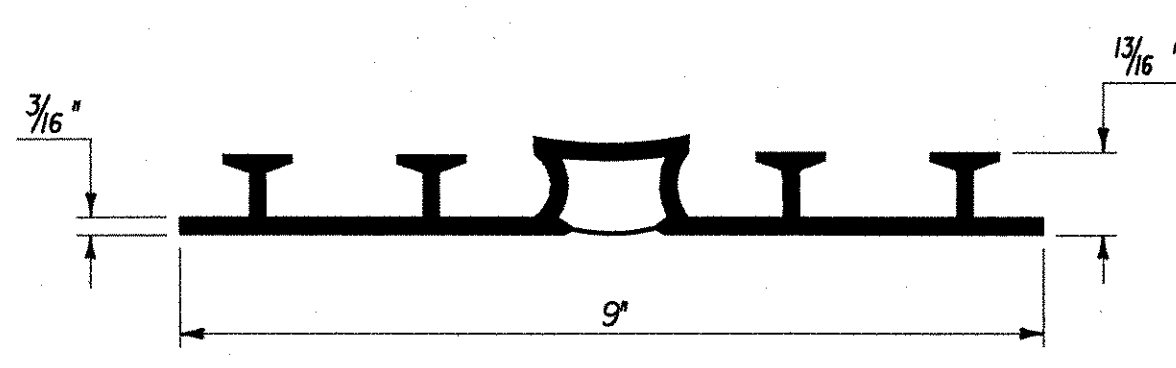

P.V.C. WATERSTOP

THE COSTS FOR P.V.C. WATERSTOP SHALL BE INCLUDED IN THE UNIT PRICE BID FOR CONCRETE. OTHER CONFIGURATIONS MAY BE USED UPON APPROVAL OF THE STRUCTURES ENGINEER.
SCALE: 6" = 1'-0"

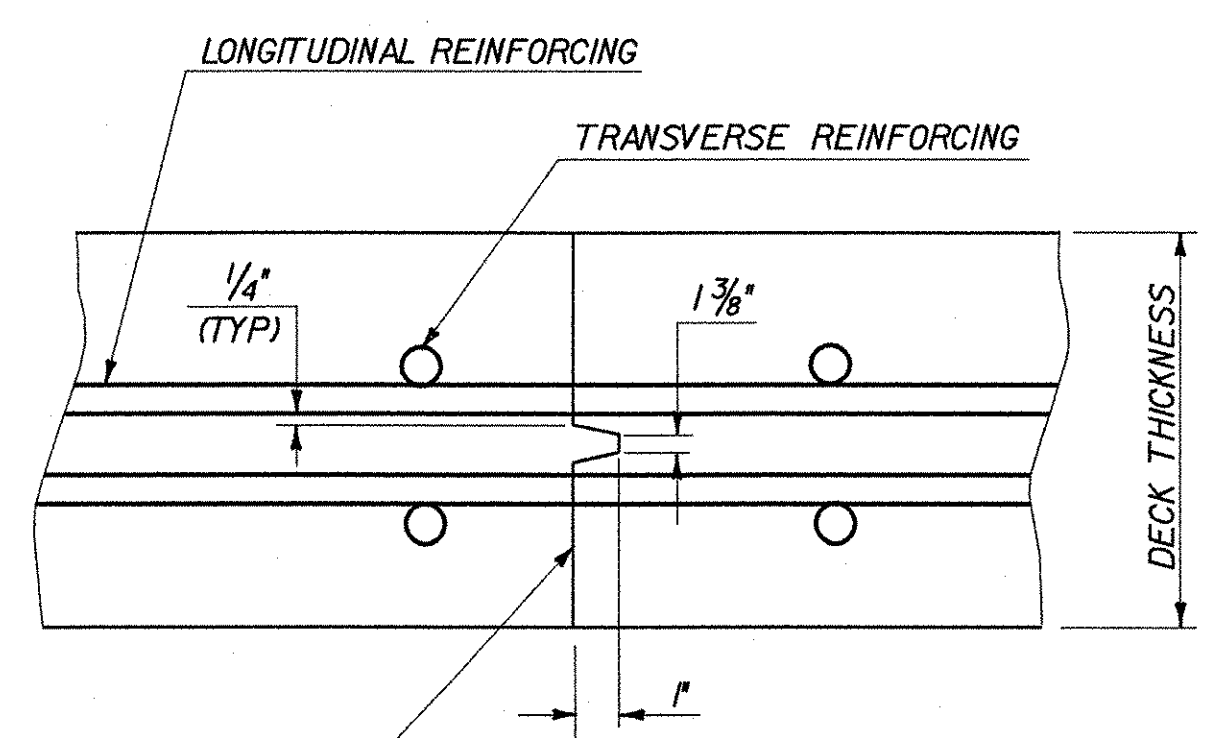


TRANSVERSE BRIDGE SLAB CONSTRUCTION JOINT DETAILS
SCALE: 3" = 1'-0"

CURB CONSTRUCTION JOINT NOTES


- CONSTRUCTION JOINTS THROUGH CONCRETE CURBS SHALL BE SPACED MAXIMUM 15'-0" CENTER TO CENTER AND SHALL BE 1'-6" MINIMUM FROM THE CENTER OF THE NEAREST BRIDGE RAIL POST. CONCRETE SHALL BE PLACED IN ALTERNATING SECTIONS WITH A MINIMUM OF 48 HOURS DELAY BETWEEN ADJACENT POURS.
- LONGITUDINAL REINFORCING SHALL PASS THROUGH CONCRETE CURB CONSTRUCTION JOINTS.
- POLYURETHANE JOINT SEALER PER SUBSECTION 524.06C COLOR TO MATCH CONCRETE. COST TO BE INCLUDED IN THE UNIT PRICE BID FOR CONCRETE.

STATE OF VERMONT AGENCY OF TRANSPORTATION


Town Of	SHELBURNE	Bridge No.	15
Highway No.	TH 3	Log Sta.	
		Surv. Sta.	
BOSTWICK ROAD OVER VERMONT RAILWAY			
DECK DETAILS (1 OF 2)			
Designed By	L. WIXSON	Drawn By	S. MERKMAN
Checked By	R. JOY	Date	05/03
		Bridge Design Supervisor	M. ZYDEL
PROJECT	SHELBURNE	PROJECT NO.	BRO 1445(30)
I.G.C. Info. M:\595402_Bostwick\BRIDGE\6m\ar_zj196dfl.dgn			
Bridge Sheet No.	BR106	Sheet	46 of 73

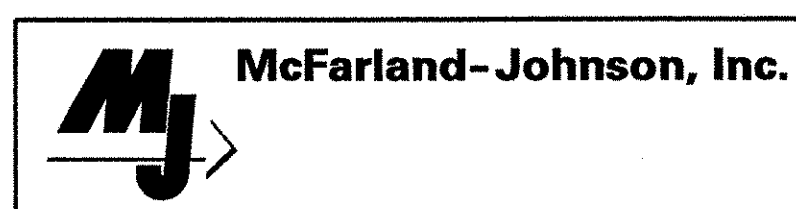

PLOTTED 01-AUG-2003

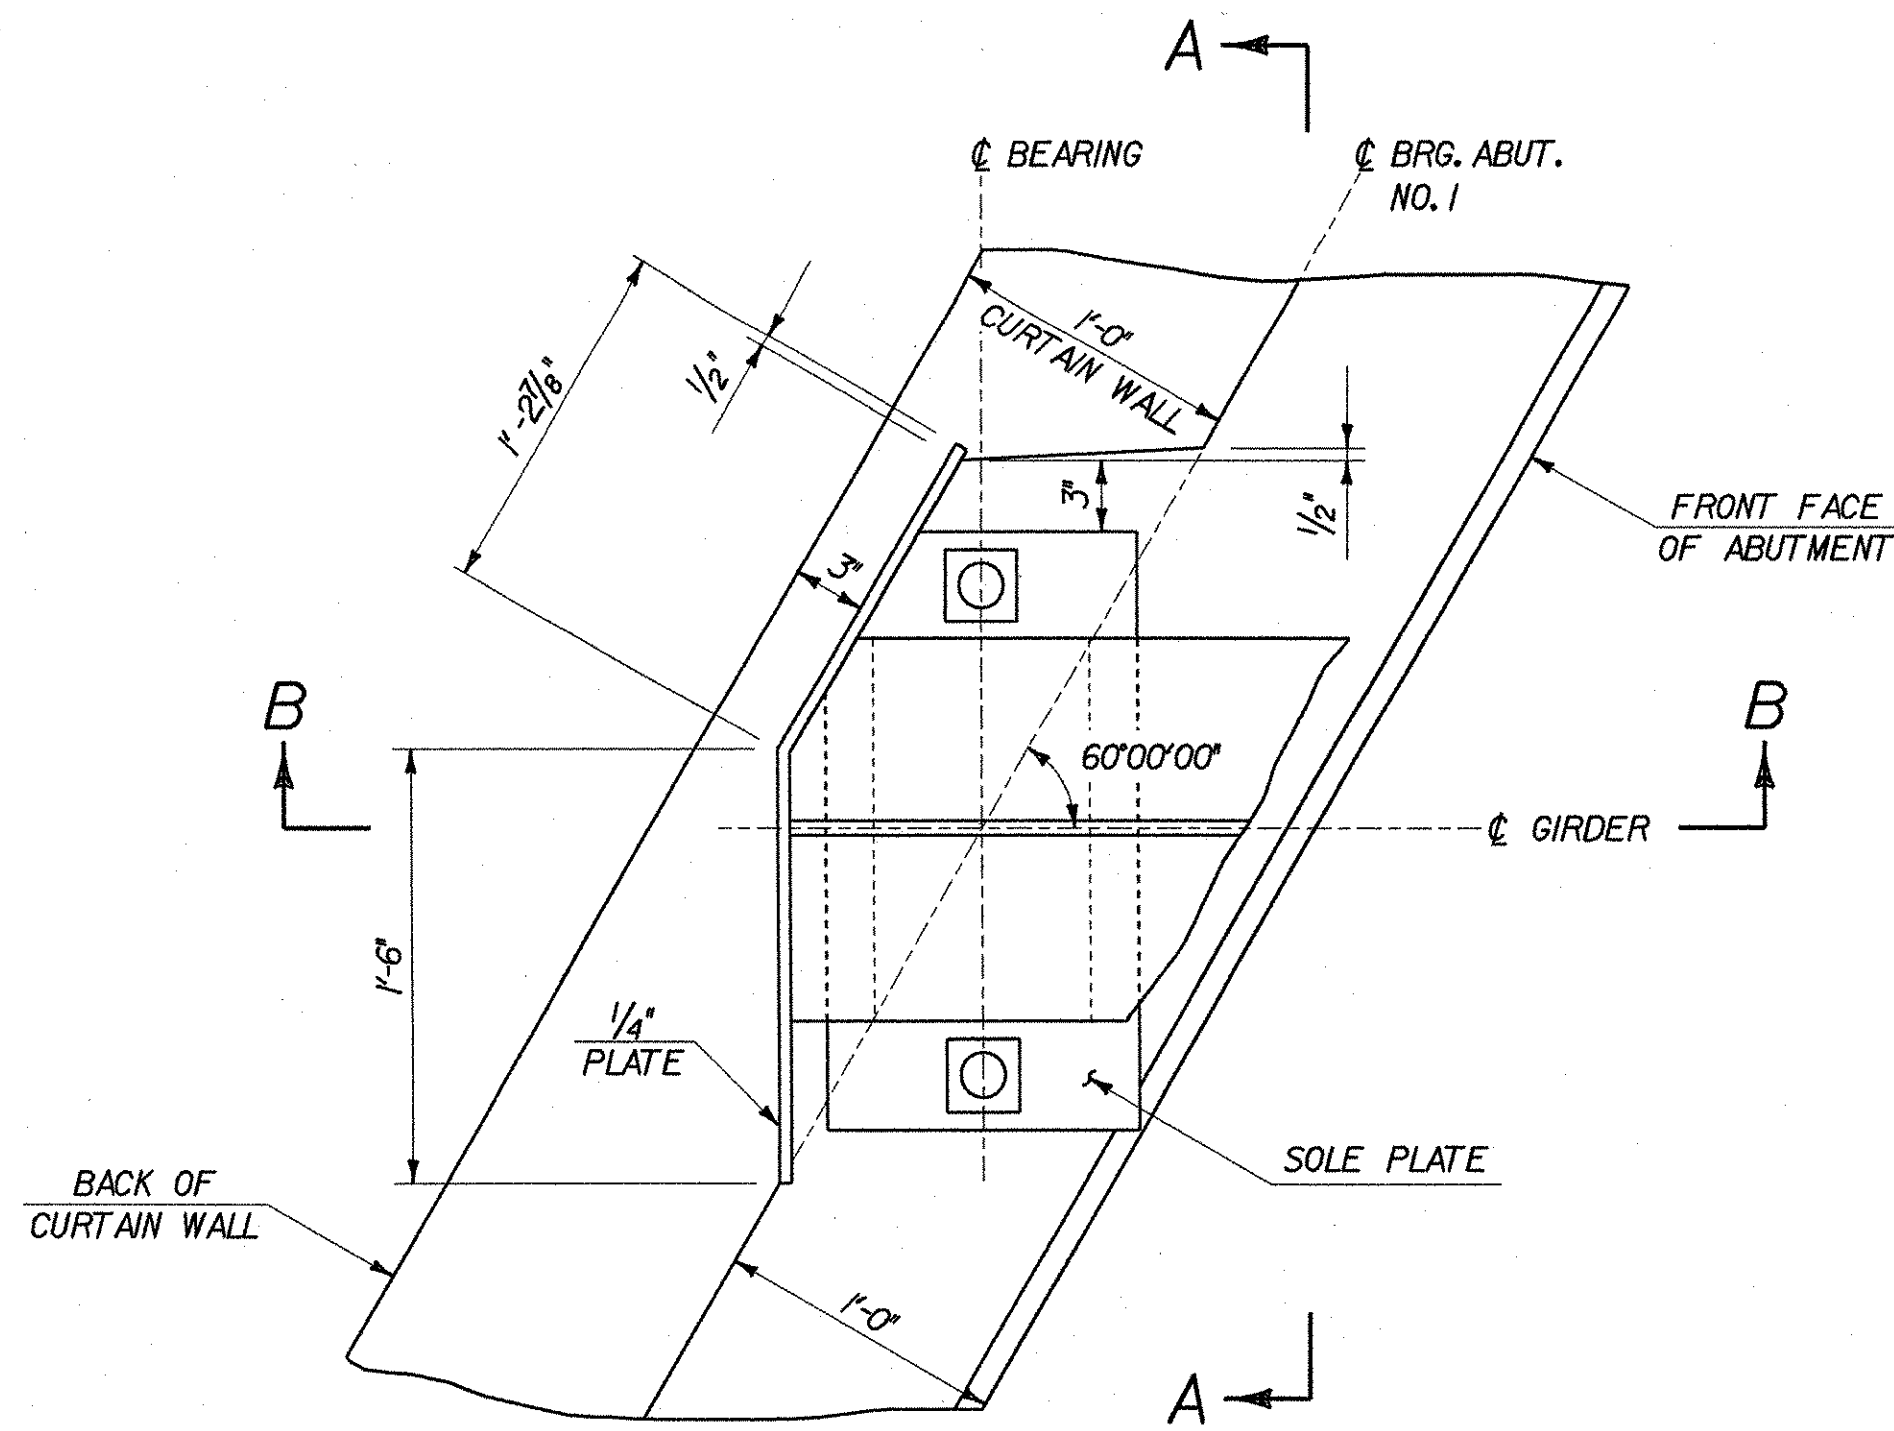


PLAN

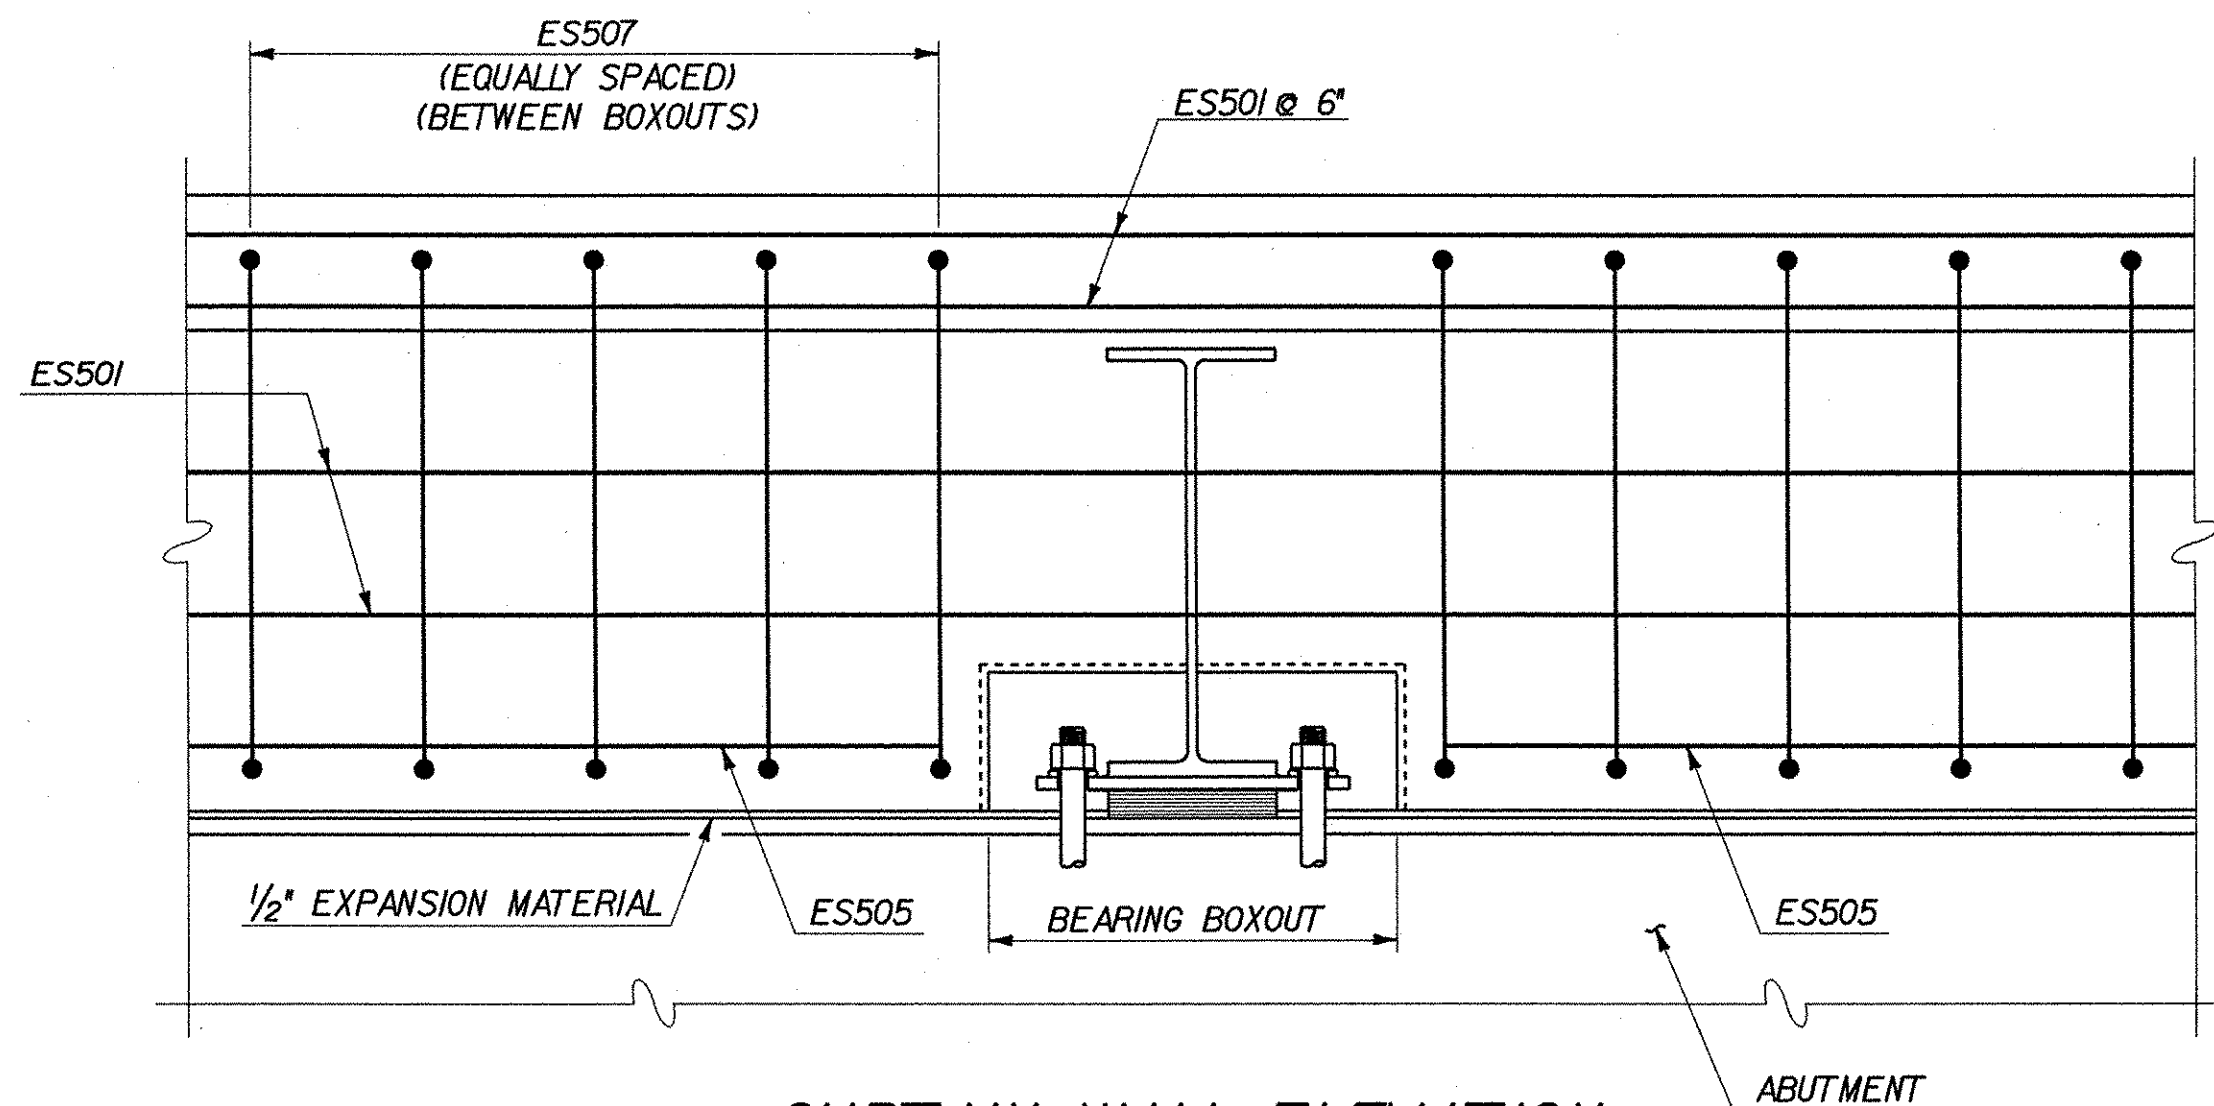


CURTAIN WALL ELEVATION

SCALE: 1" = 1'-0"

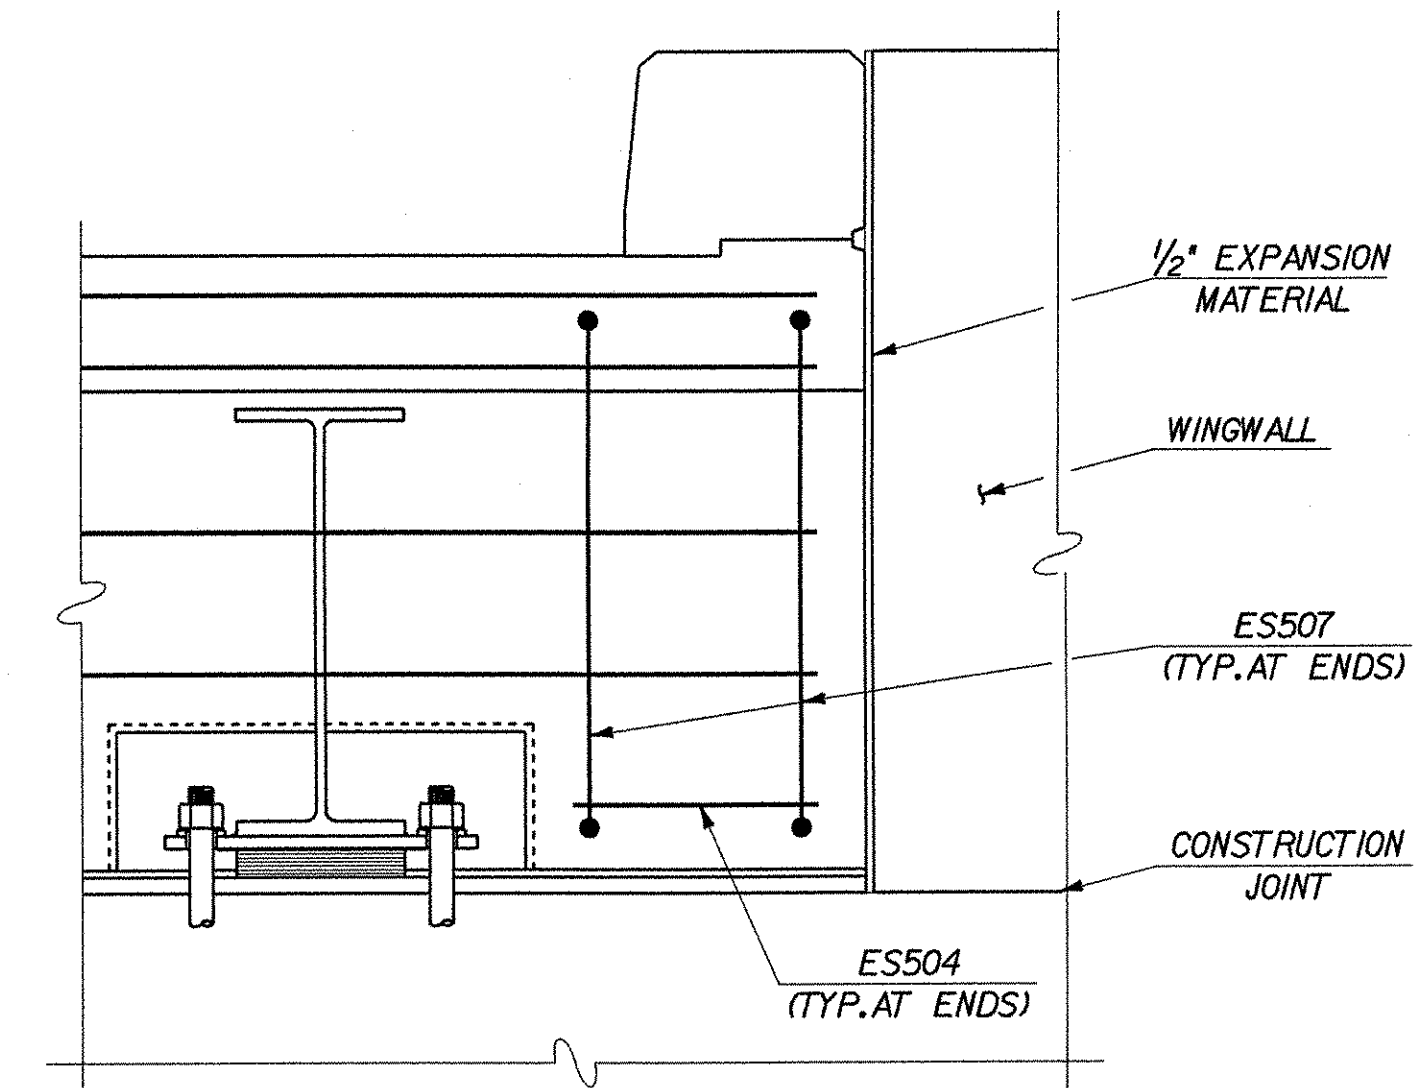


SECTION A-A

SCALE: 1" = 1'-0"

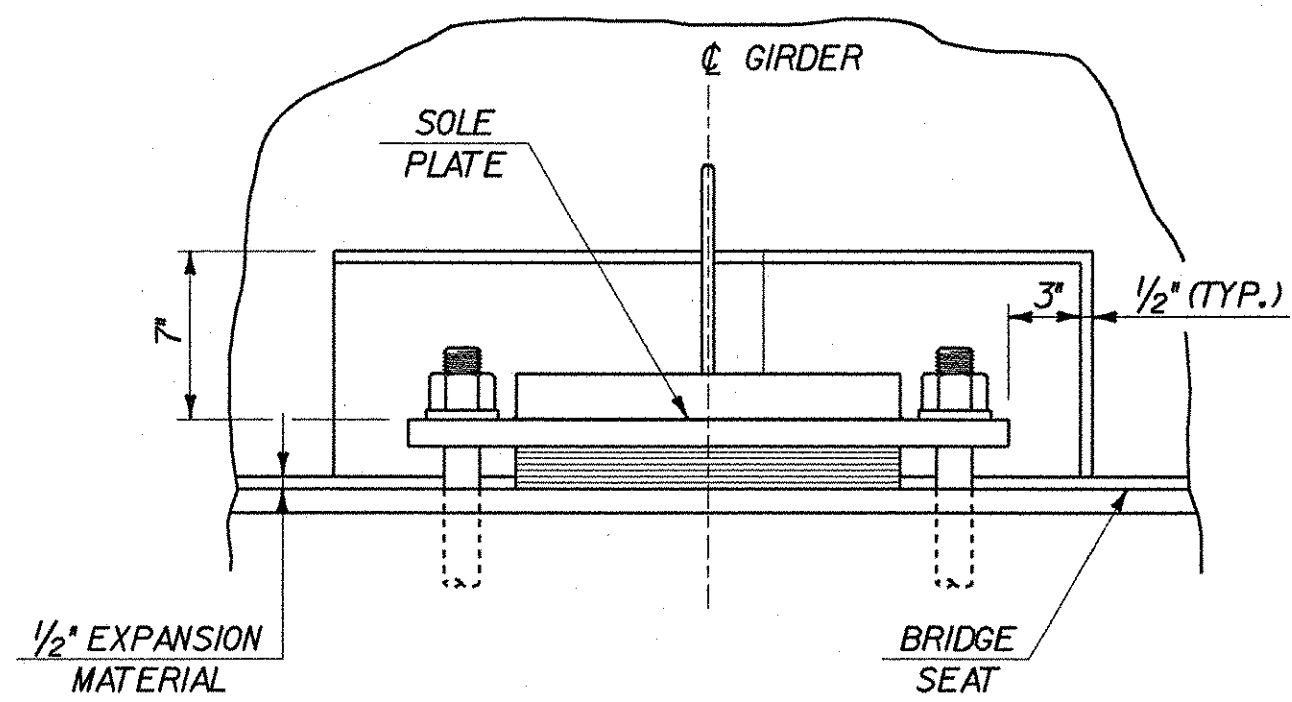


VIEW A-A

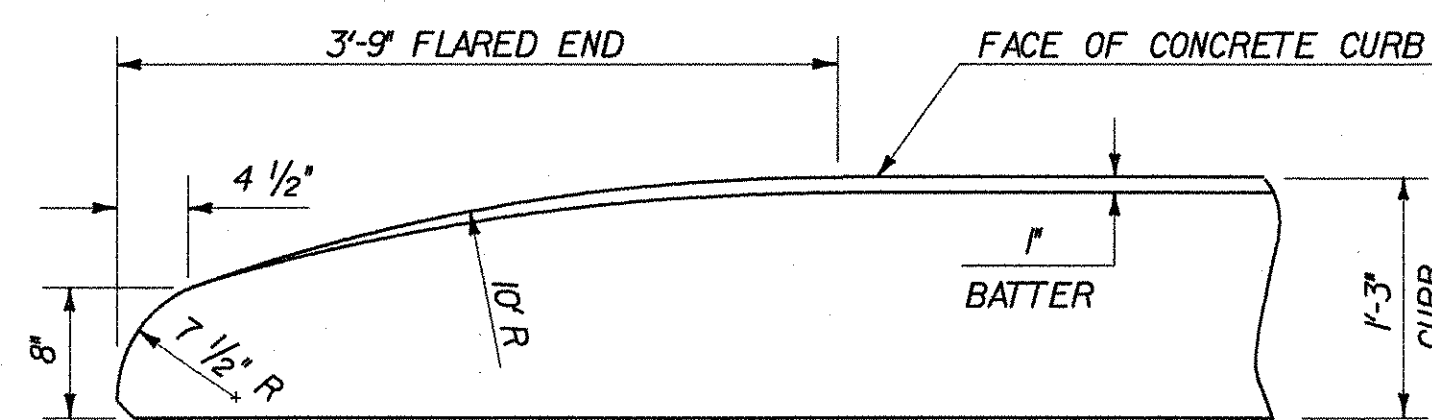

CURB REINFORCING STIRRUP BARS SHALL BE TURNED AS REQUIRED TO FIT FLARED ENDS.


FLARED END DETAIL FOR 1'-3" CURB

NOT TO SCALE

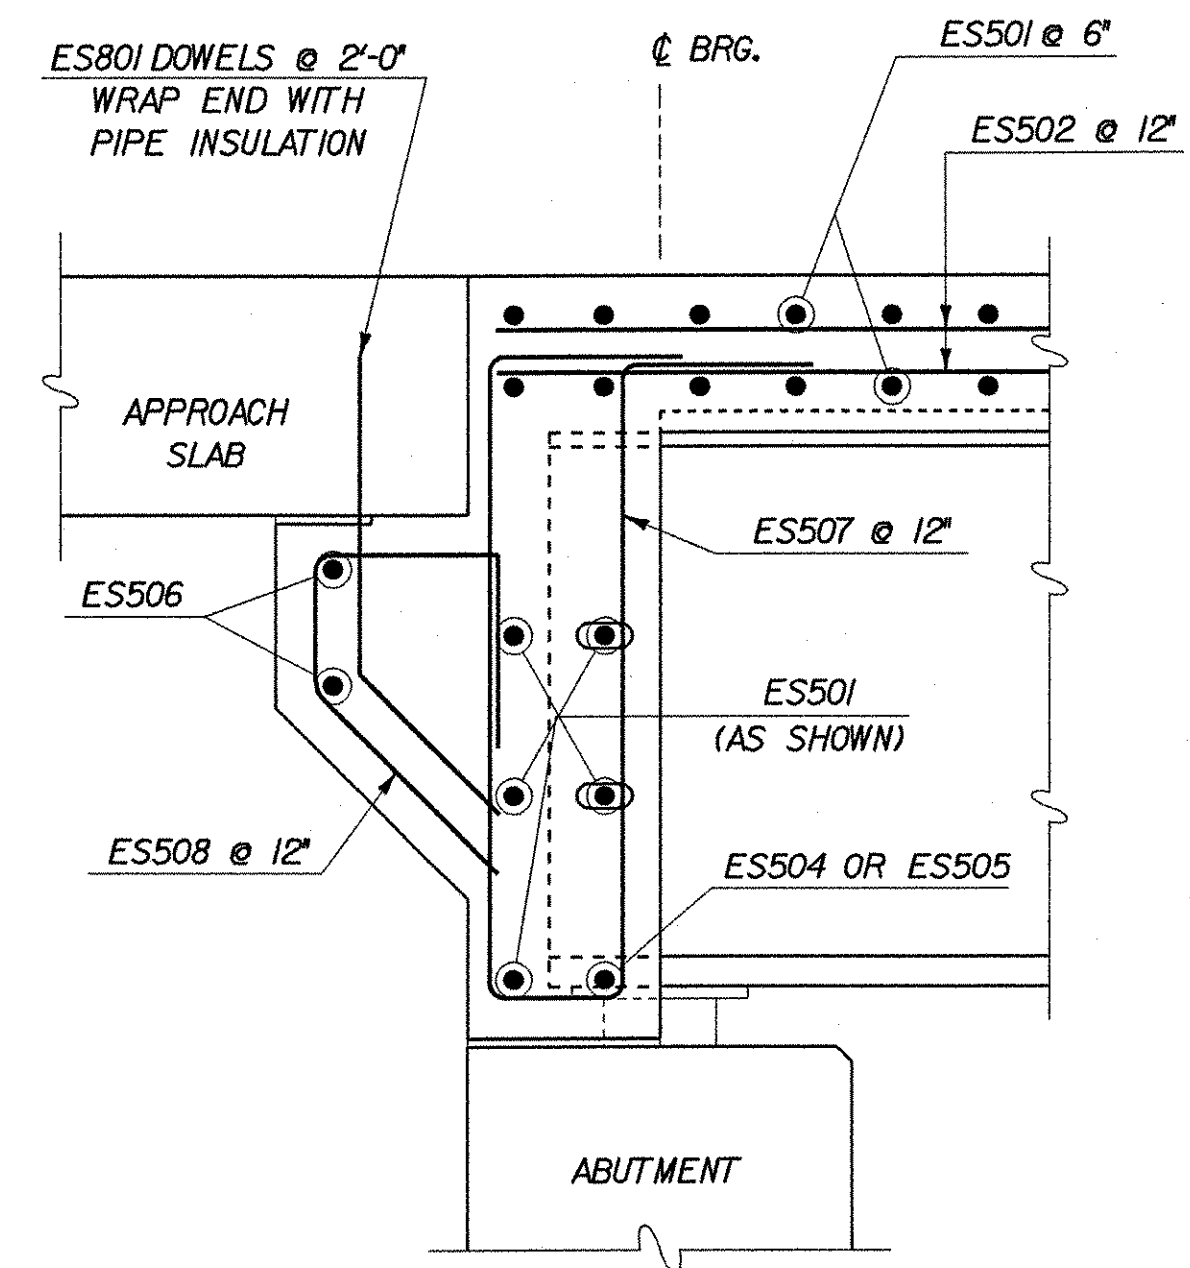

SECTION A-A


SCALE: 1" = 1'-0"

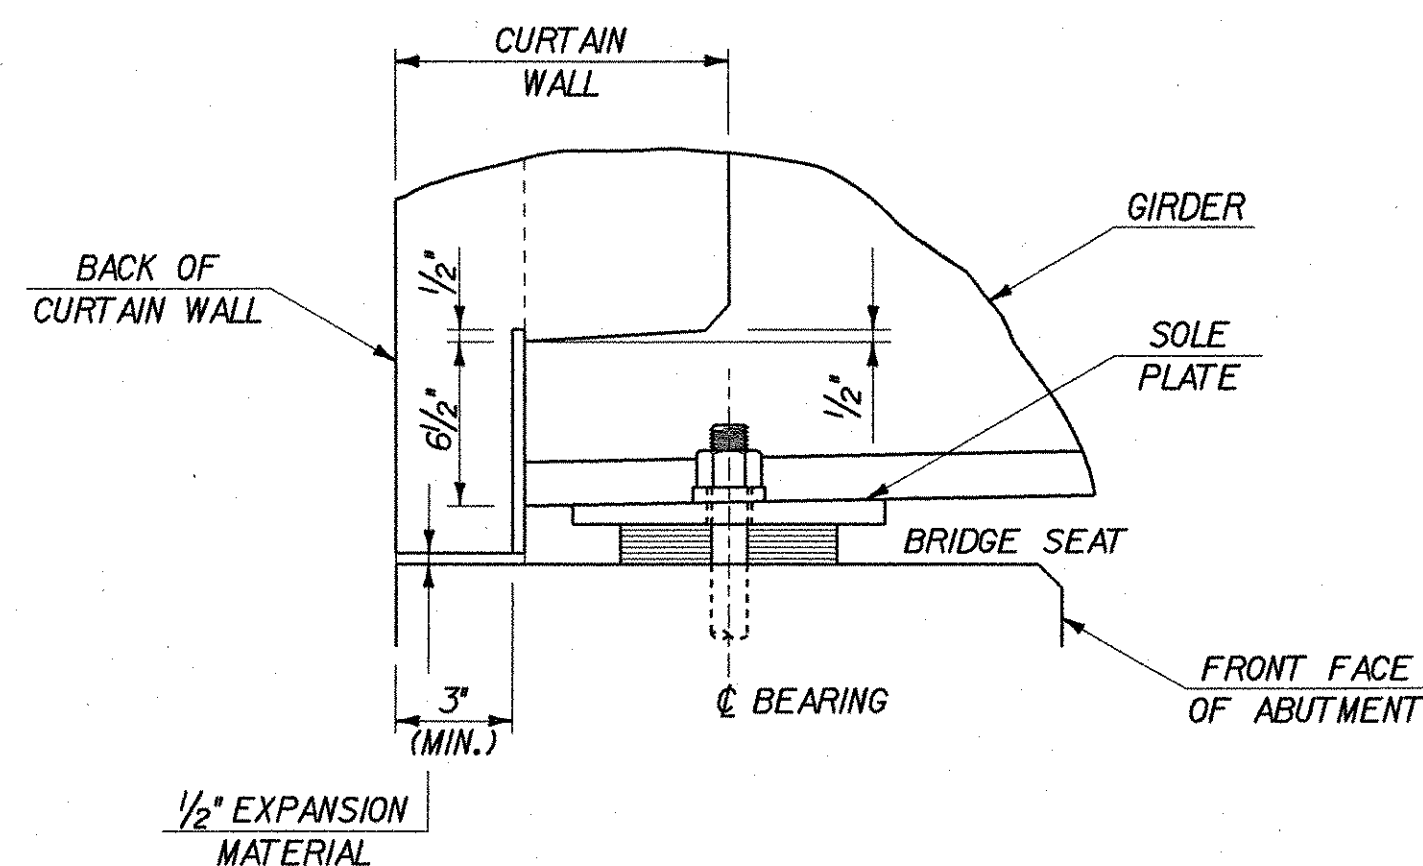

SECTION B-B

BEARING BOXOUT DETAILS

SCALE: 1/2" = 1'-0"

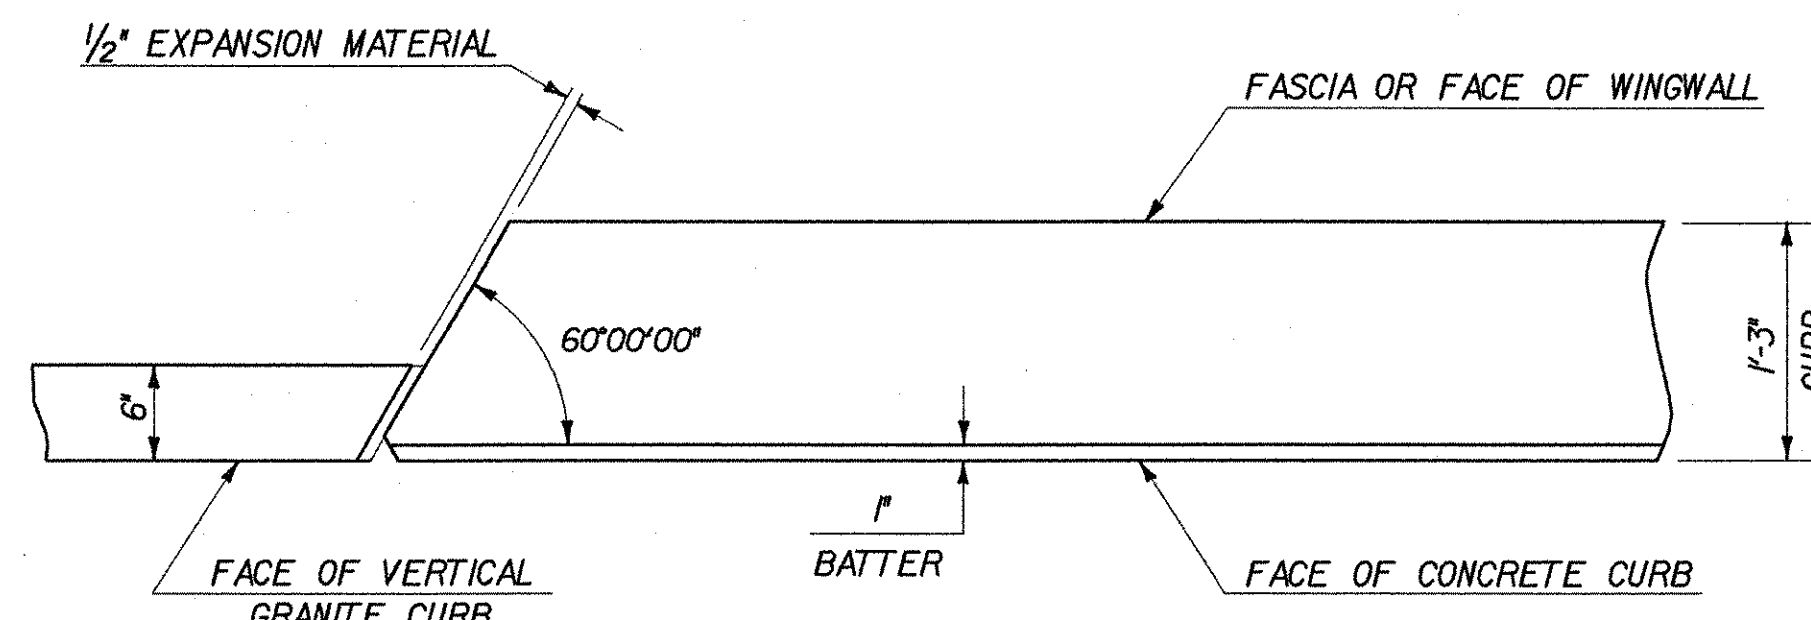

NOTE: TYPICAL AT WWI ONLY

END DETAIL FOR 1'-3" CURB




NOT TO SCALE

STATE OF VERMONT
AGENCY OF TRANSPORTATION


Town Of	SHELBURNE	Bridge No.	15
Highway No.	TH 3	Log Sta.	
		Surv. Sta.	
BOSTWICK ROAD OVER VERMONT RAILWAY			
DECK DETAILS (2 OF 2)			
Designed By	L. WIXSON	Drawn By	S. MERKMAN
Checked By	R. JOY	Date	05/03
		Bridge Design Supervisor	M. ZYDEL
		Date	05/03
PROJECT	SHELBURNE	PROJECT NO.	BRO 1445(30)
I.G.C. Info. MA\595402_Bostwick\BRIDGE\6m\ar\2\1196dt2.dgn			
Bridge Sheet No.	BR107	Sheet	47 of 73




PLOTTED 01-AUG-2003

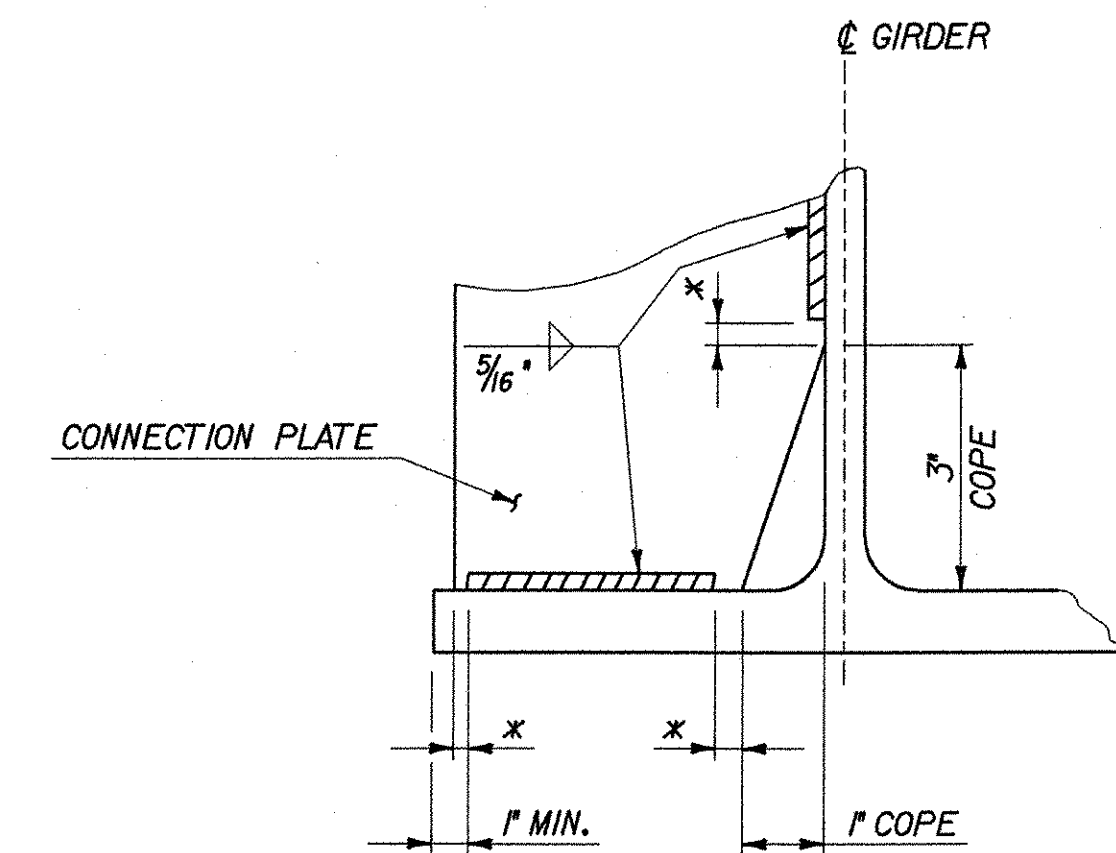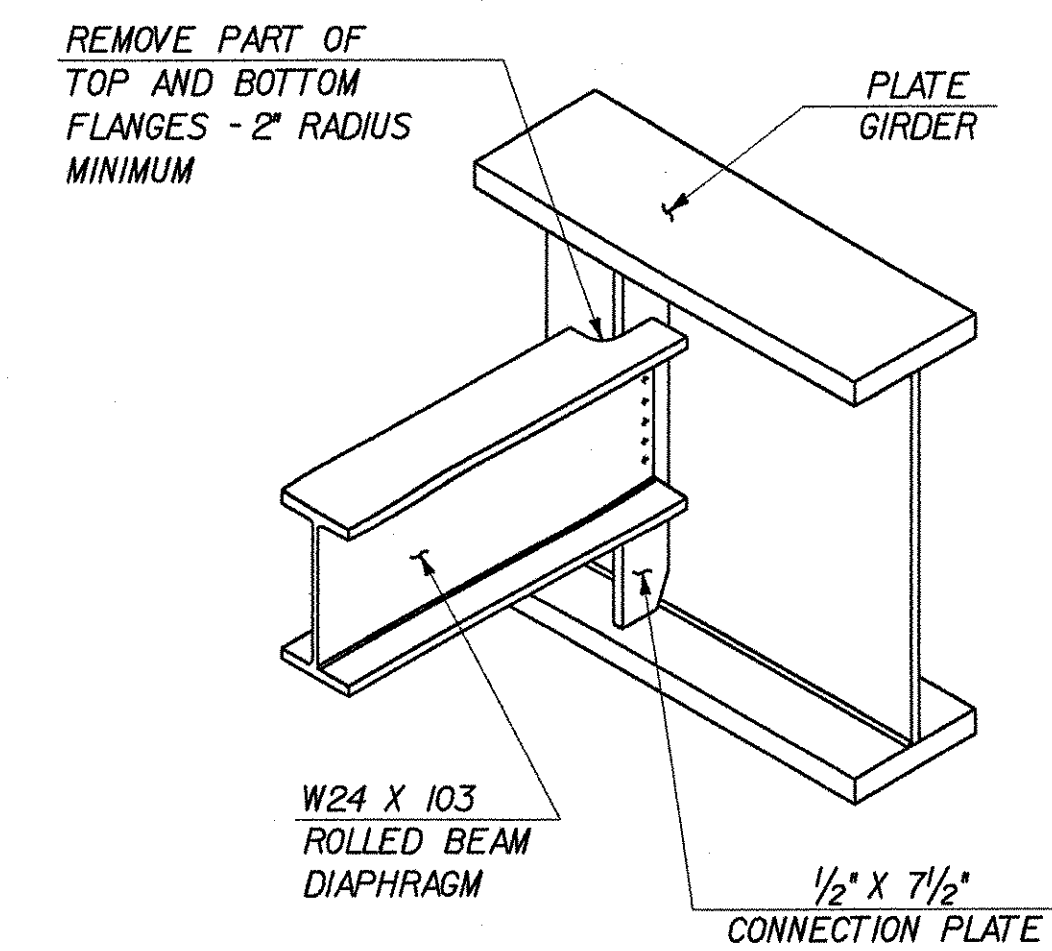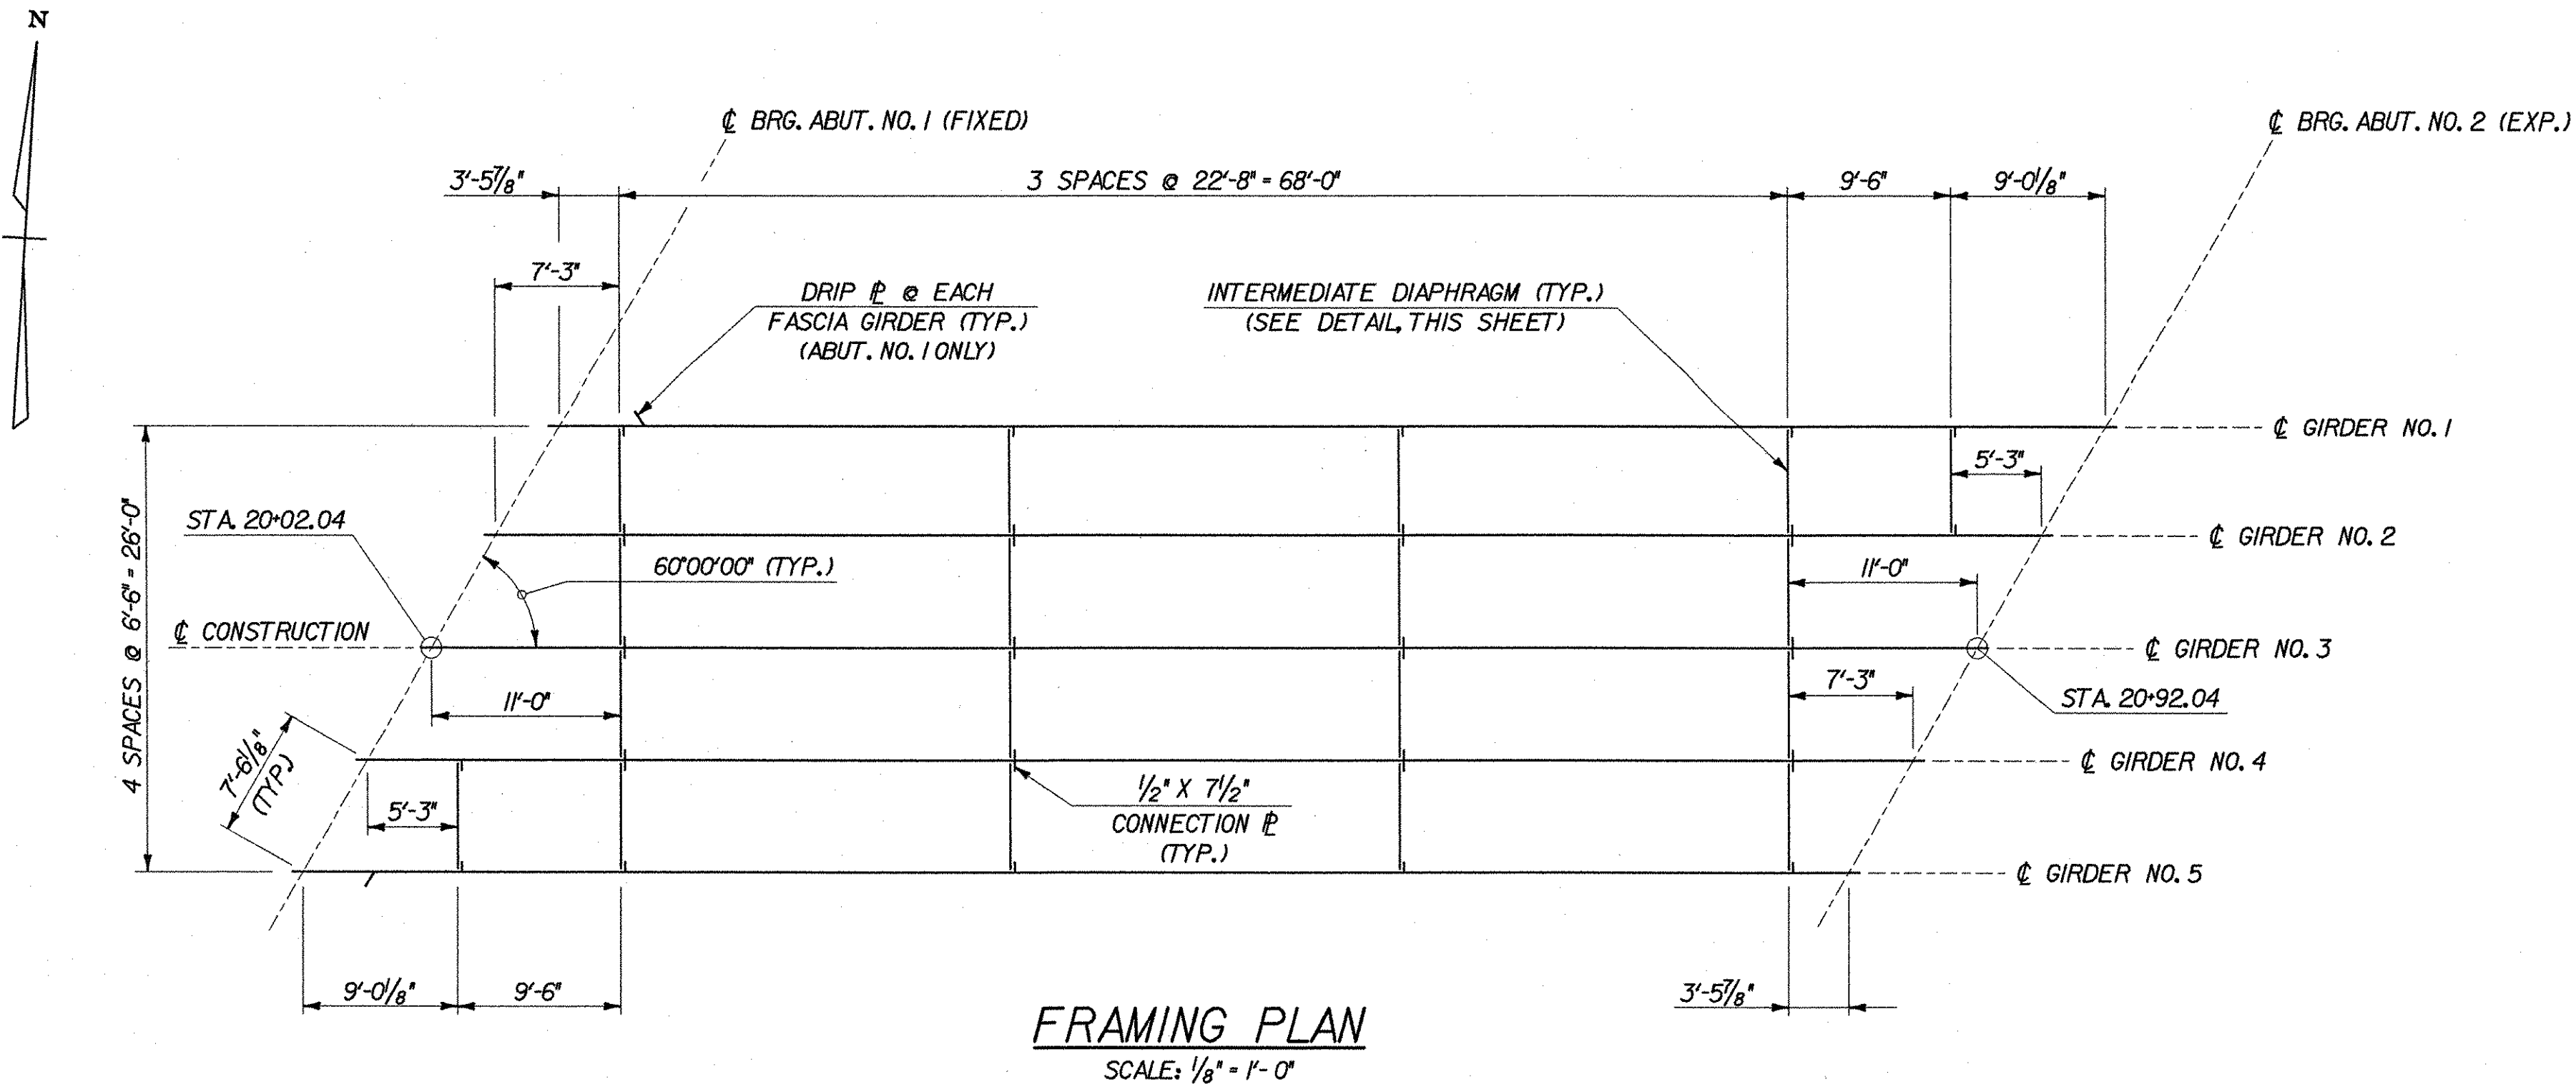

* NO WELD FOR 1/4" MIN. 1/2" MAX.
(EXCEPT MUST MAINTAIN 1" MIN. FROM EDGE OF FLANGE)

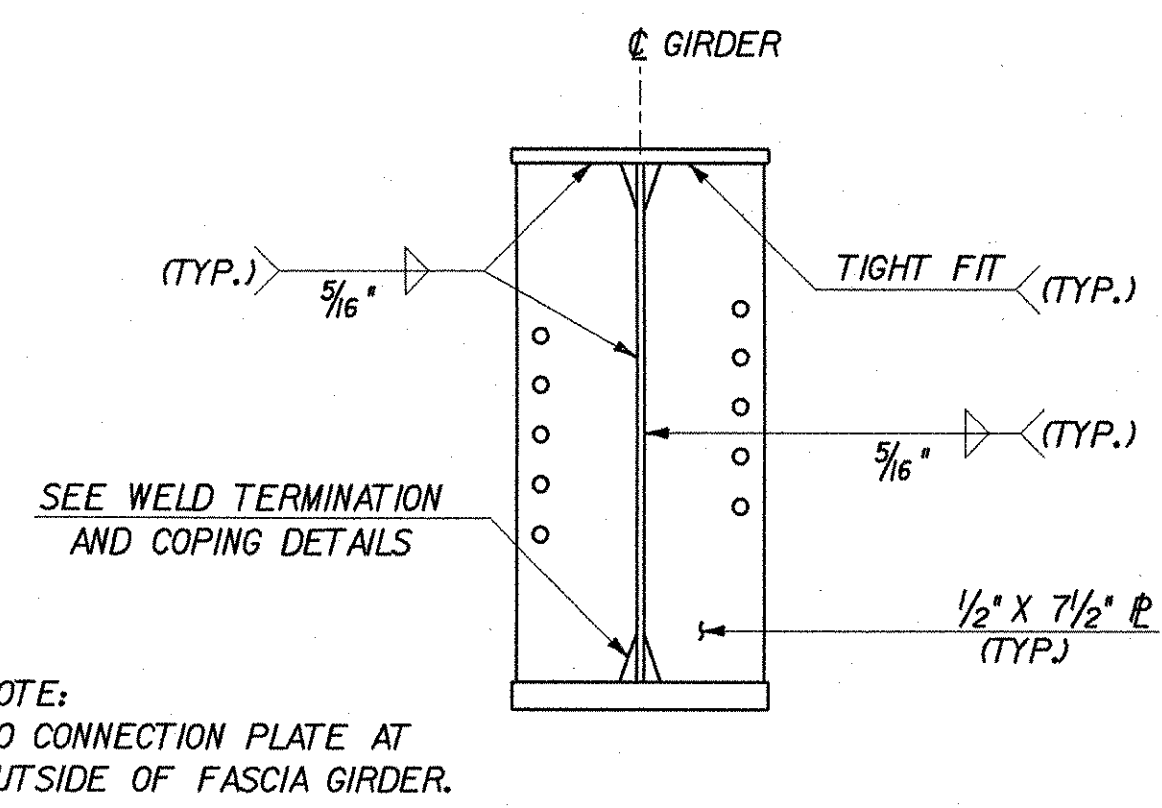



NOTE:
NO CONNECTION PLATE AT
OUTSIDE OF FASCIA GIRDER.

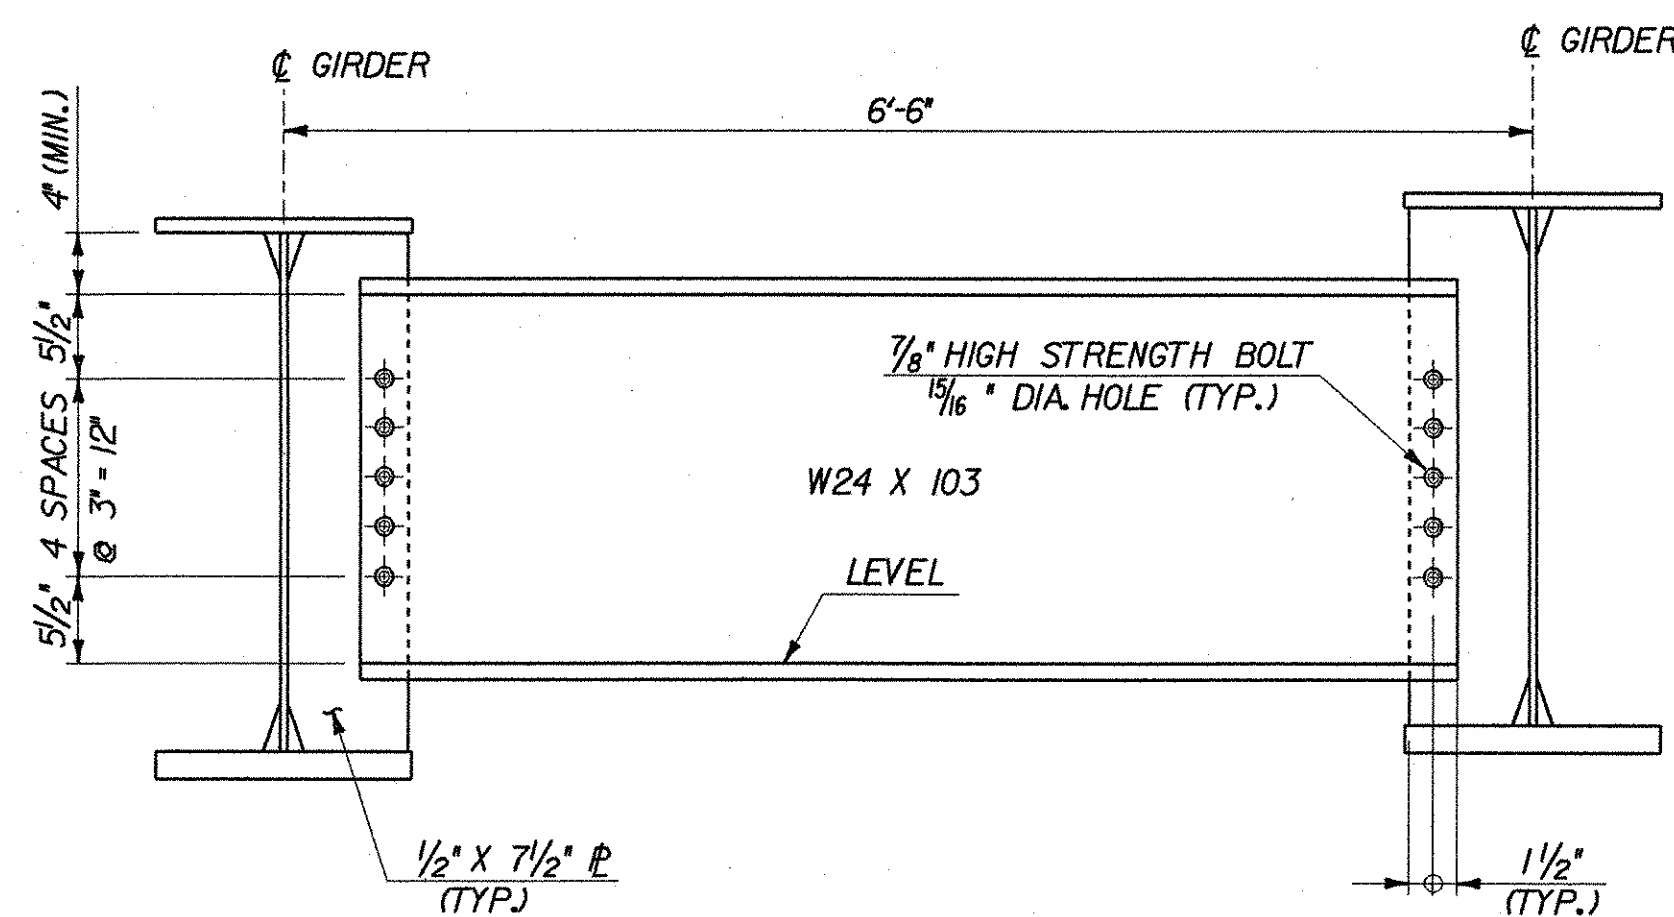


**STATE OF VERMONT
AGENCY OF TRANSPORTATION**

Town Of	SHELBURNE	Bridge No.	15
Highway No.	TH 3	Log Sta.	
		Surv. Sta.	
BOSTWICK ROAD OVER VERMONT RAILWAY FRAMING PLAN AND DETAILS			
Designed By	L. WIXSON	Drawn By	S. MERKWAN
Checked By	R. JOY	Date	05/03
		Bridge Design Supervisor	M. ZYDEL
		Date	05/03
PROJECT	SHELBURNE	PROJECT NO.	BRO 1445(30)
I.G.C. Info. MN595402 Bostwick\BRIDGE\6m\1445(30)\1961.pl.dgn			
Bridge Sheet No.	BR108	Sheet	48 of 73

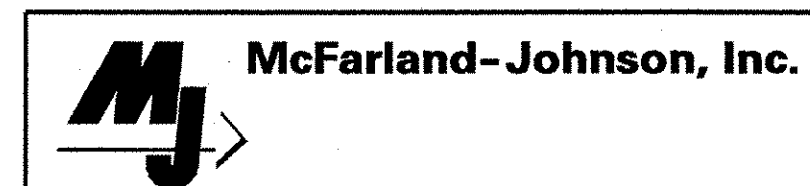

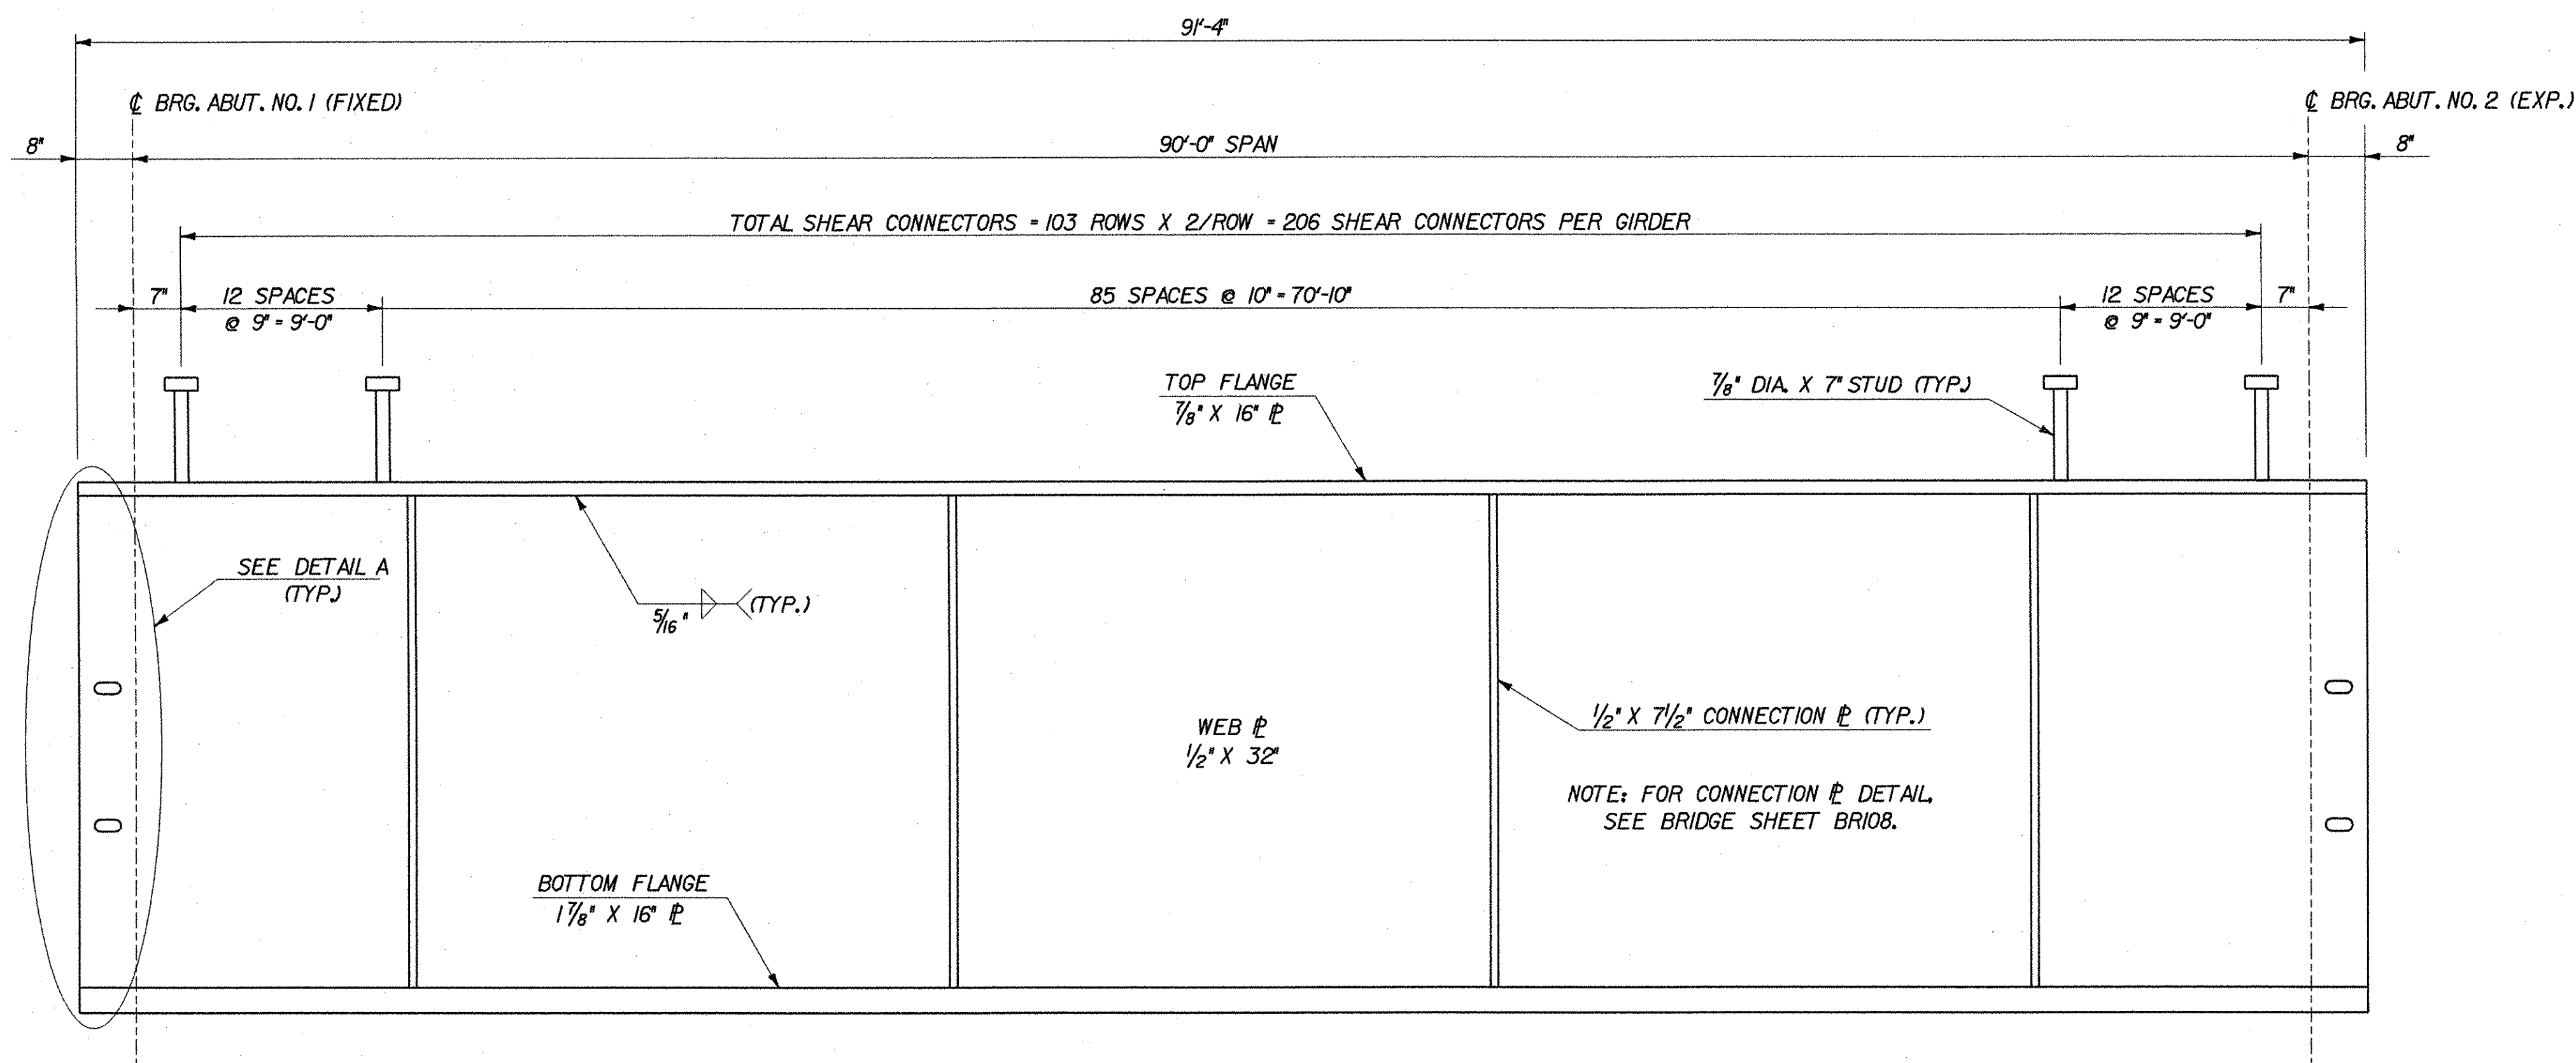

GIRDER ELEVATION
NOT TO SCALE

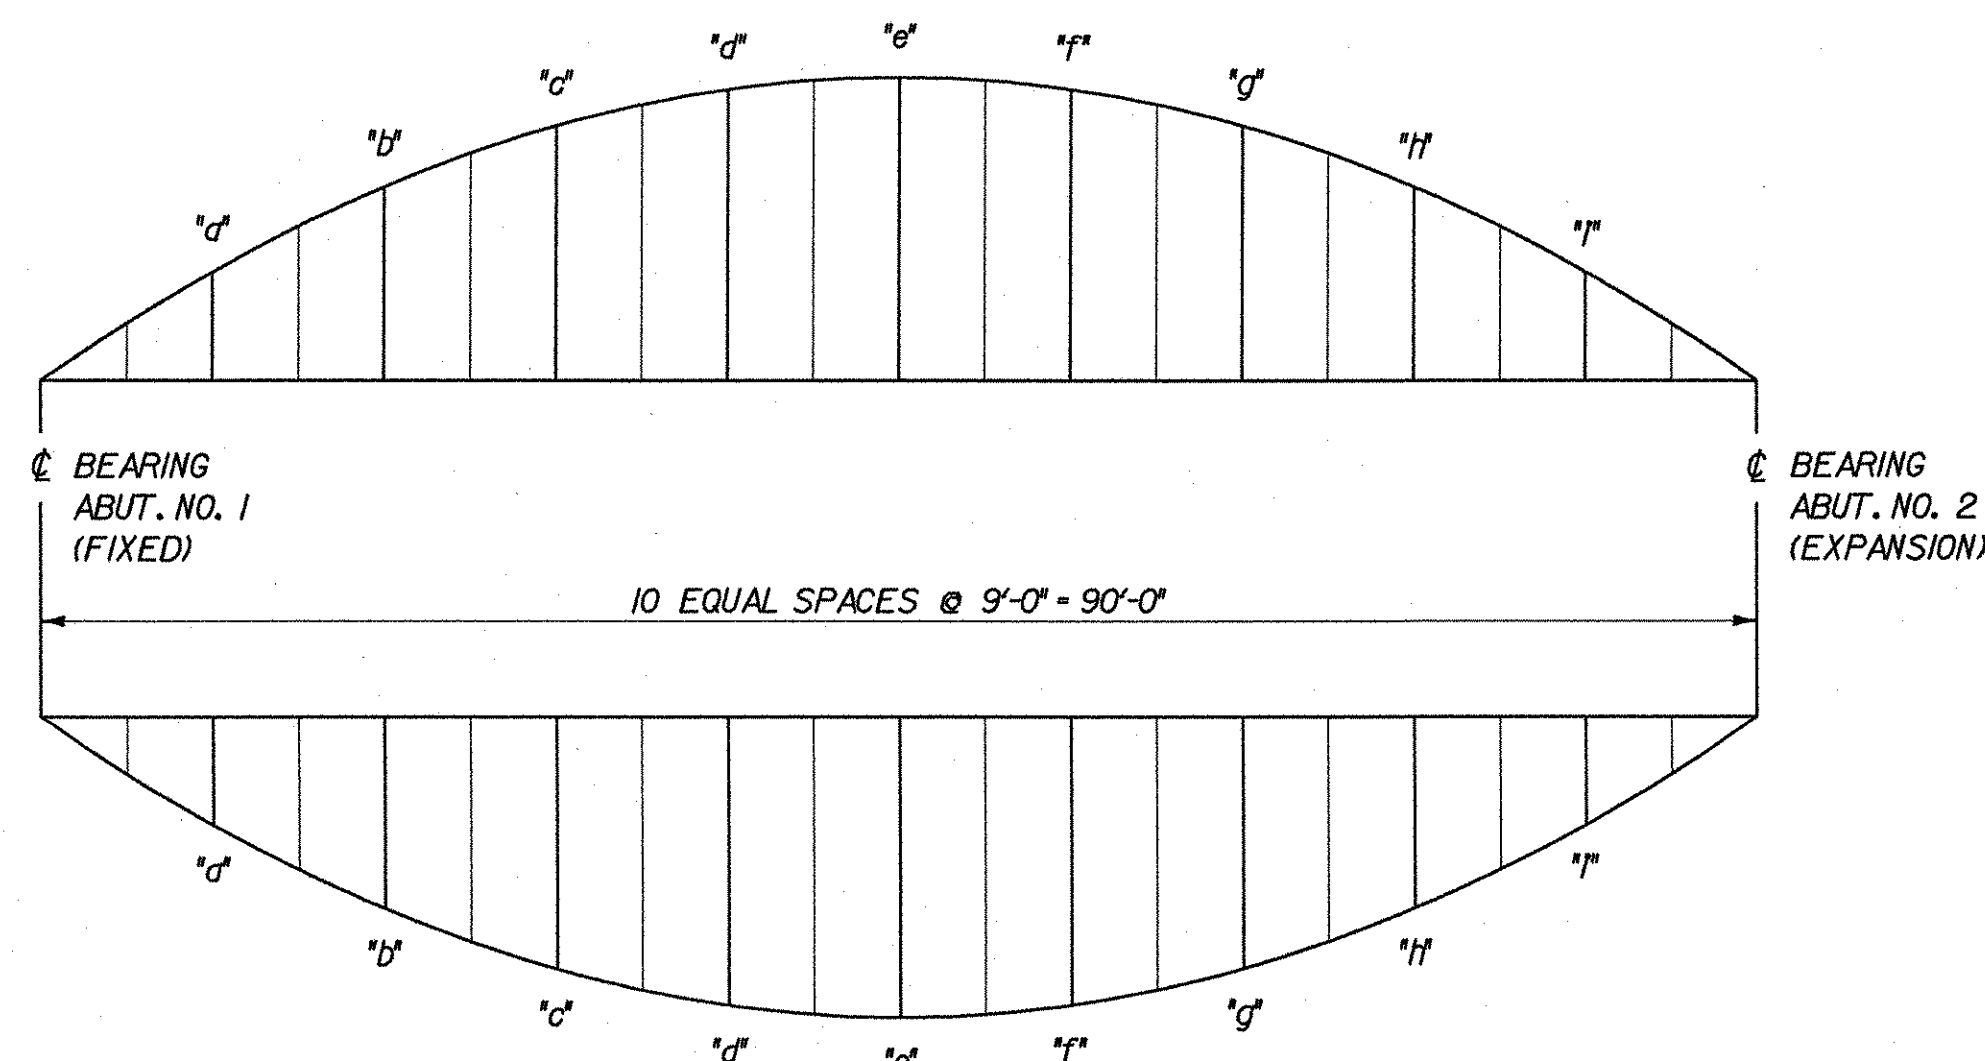


DL DEFLECTION AND CAMBER DIAGRAM
NOT TO SCALE

CAMBER AND DEFLECTION MEASUREMENTS ARE GIVEN IN INCHES AT TENTH POINTS

CAMBER AND DL DEFLECTION ORDINATE SCHEDULE

L = TOTAL LENGTH ϕ BRG. ABUT. NO. 1 TO ϕ BRG. ABUT. NO. 2 = 90'-0"


GIRDER NO.	ϕ BRG. ABUT. NO. 1	0.10L	0.20L	0.30L	0.40L	0.50L	0.60L	0.70L	0.80L	0.90L	ϕ BRG. ABUT. NO. 2	
1 THRU 5	CAMBER	0"	2 7/8"	4 7/16"	6"	6 15/16"	7 1/4"	6 15/16"	6"	4 7/16"	2 7/8"	0"
1 THRU 5	DL DEFLECTION	0"	1 1/2"	2 7/8"	3 7/8"	4 9/16"	4 3/4"	4 9/16"	3 7/8"	2 7/8"	1 1/2"	0"

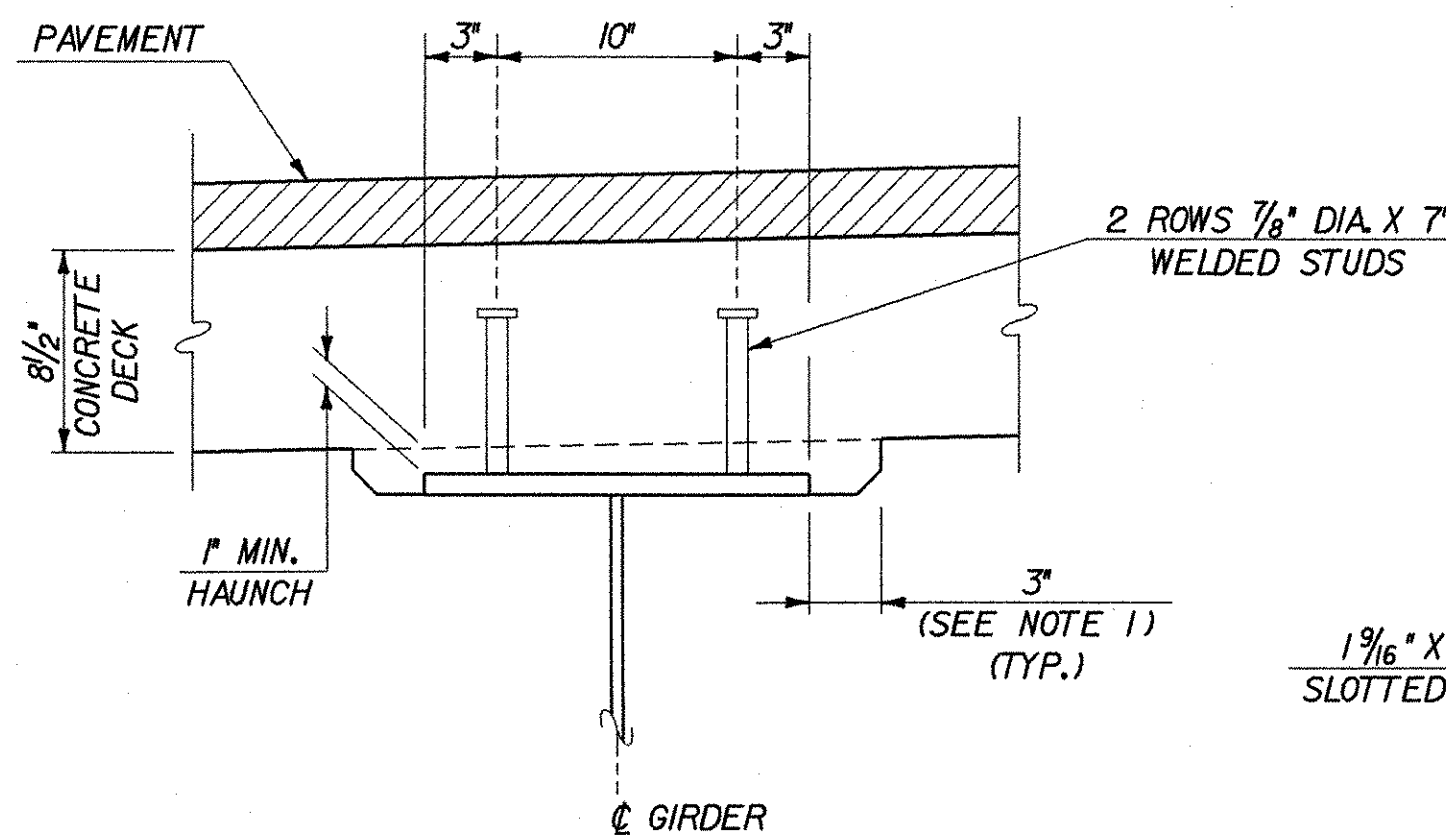


HAUNCH AND SHEAR CONNECTOR DETAIL
SCALE: 1/2" = 1'-0"

NOTES

1. THE 3" HORIZONTAL SECTION MAY BE ELIMINATED FOR FORMING SYSTEMS DESIGNED FOR THE CONSTRUCTION OF VERTICAL HAUNCHES. SYSTEMS SHALL BE SUBMITTED FOR APPROVAL TO THE STRUCTURES ENGINEER. ALL VOIDS SHALL BE FILLED WITH MORTAR, TYPE M OR AN EQUIVALENT PRODUCT FROM THE APPROVED PRODUCTS LIST.

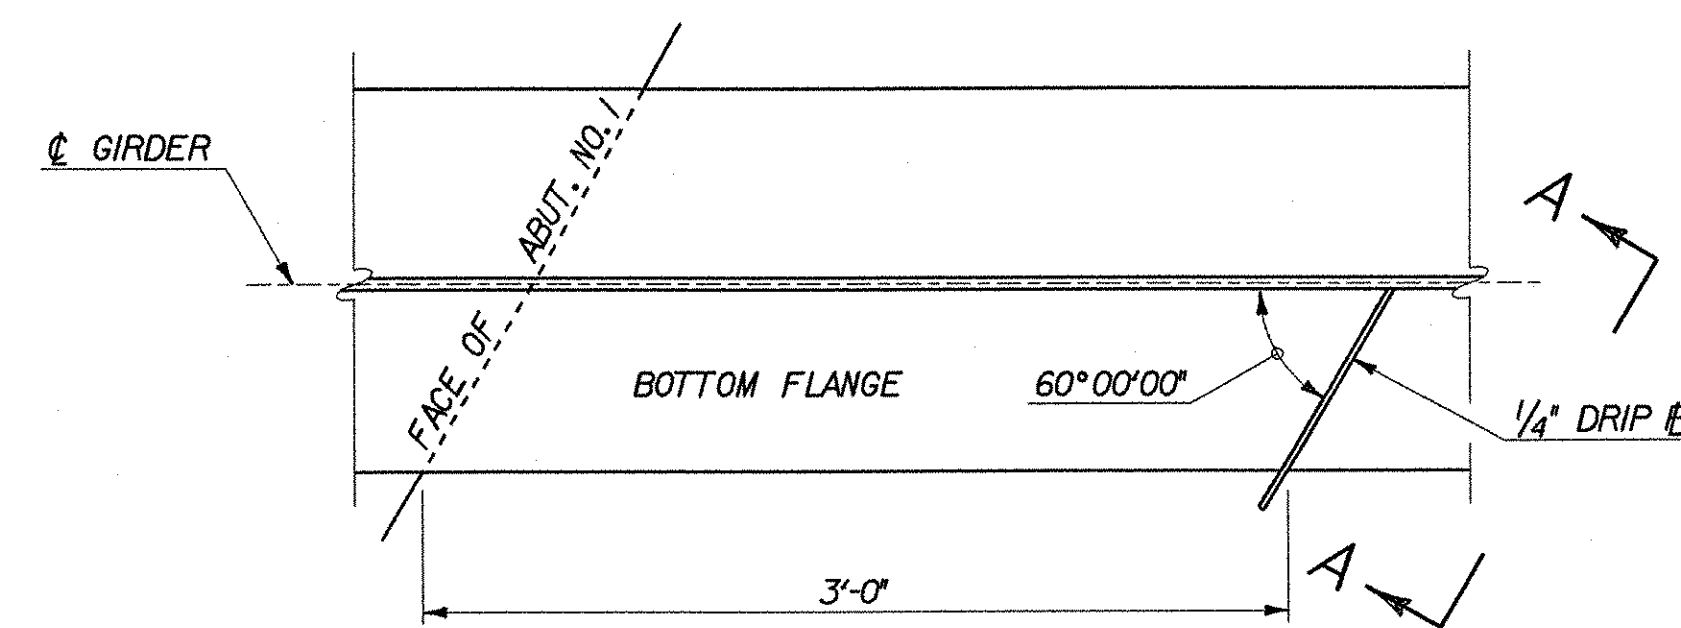


DRIP PLATE PLAN
SCALE: 1/2" = 1'-0"

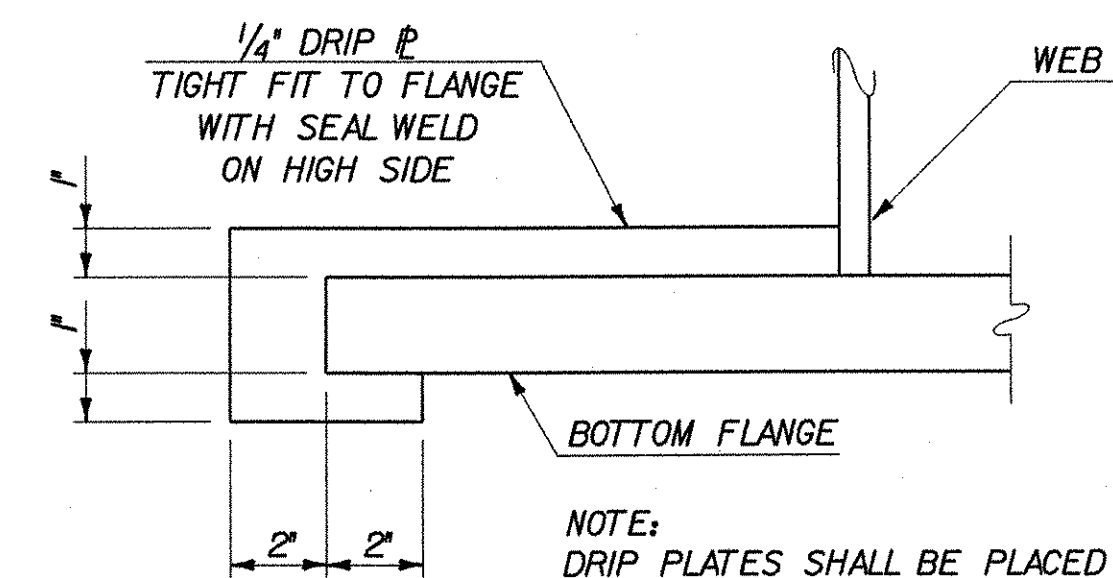


NOTE: DRIP PLATES SHALL BE PLACED ON THE OUTSIDE EDGE OF FASCIA GIRDERS ON THE ABUTMENT NO. 1 END. SEE FRAMING PLAN FOR LOCATION, BRIDGE SHEET BR108.

DRIP PLATE SECTION A-A
SCALE: 3" = 1'-0"

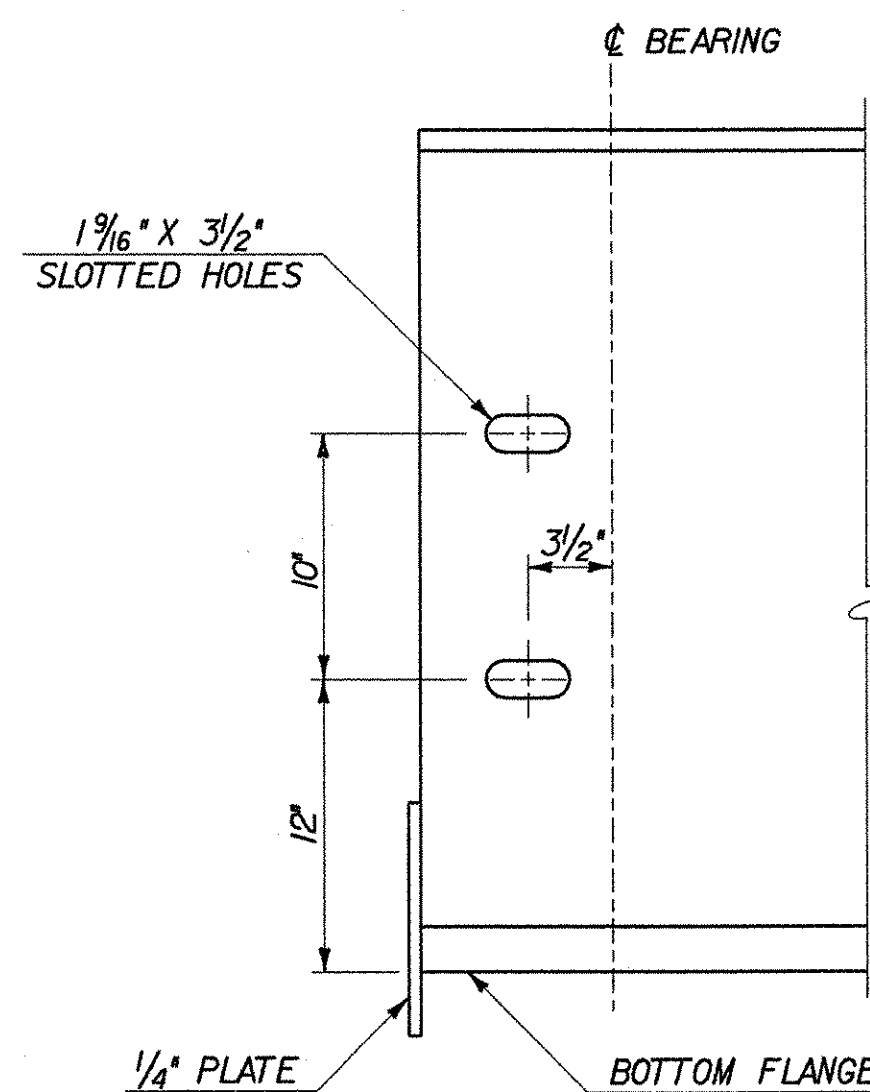


DETAIL A
SCALE: 1/2" = 1'-0"

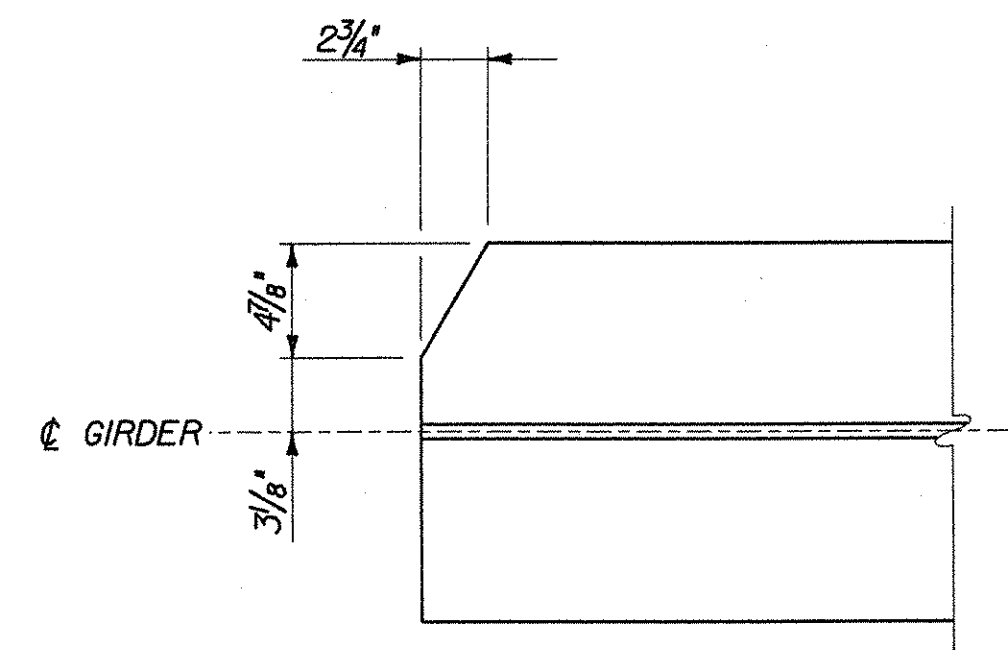



TOP & BOTTOM FLANGE CLIP DETAIL
SCALE: 1/2" = 1'-0"

STATE OF VERMONT AGENCY OF TRANSPORTATION





Town Of	SHELBURNE	Bridge No.	15
Highway No.	TH 3	Log Sta.	
		Surv. Sta.	
BOSTWICK ROAD OVER VERMONT RAILWAY			
GIRDER DETAILS			
Designed By	L. WIXSON	Drawn By	S. MERKMAN
Checked By	R. JOY	Date	05/03
		Bridge Design Supervisor	M. ZYDEL
		Date	05/03
PROJECT	SHELBURNE	PROJECT NO.	BRO 1445(30)
I.G.C. Info. M:\535402_Bostwick\BRIDGE\6m\1d\2\196gdt.dgn			
Bridge Sheet No.	BR109	Sheet	49 of 73

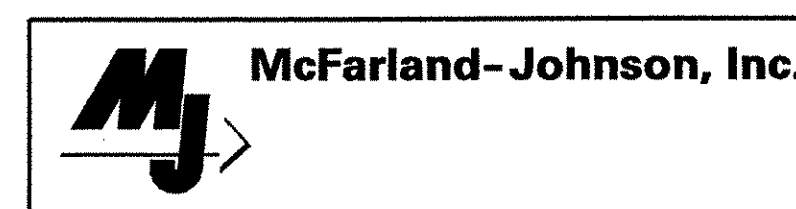

PLOTTED 01-AUG-2003

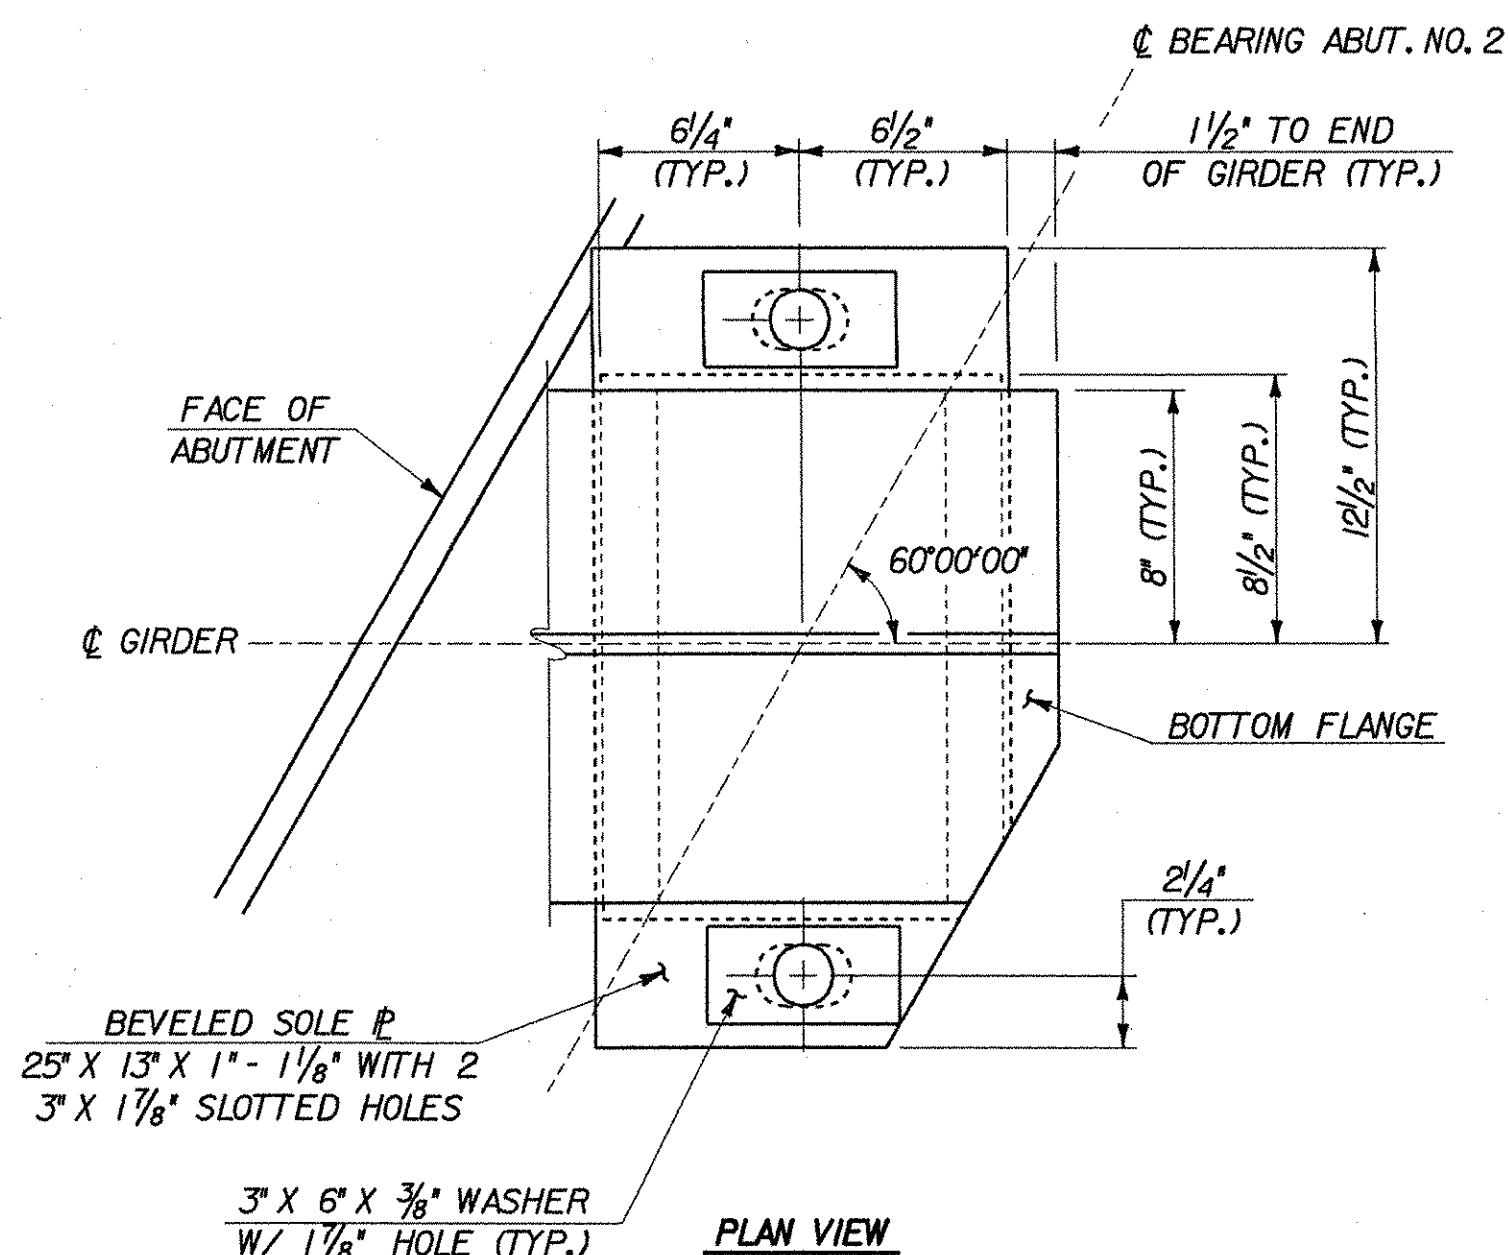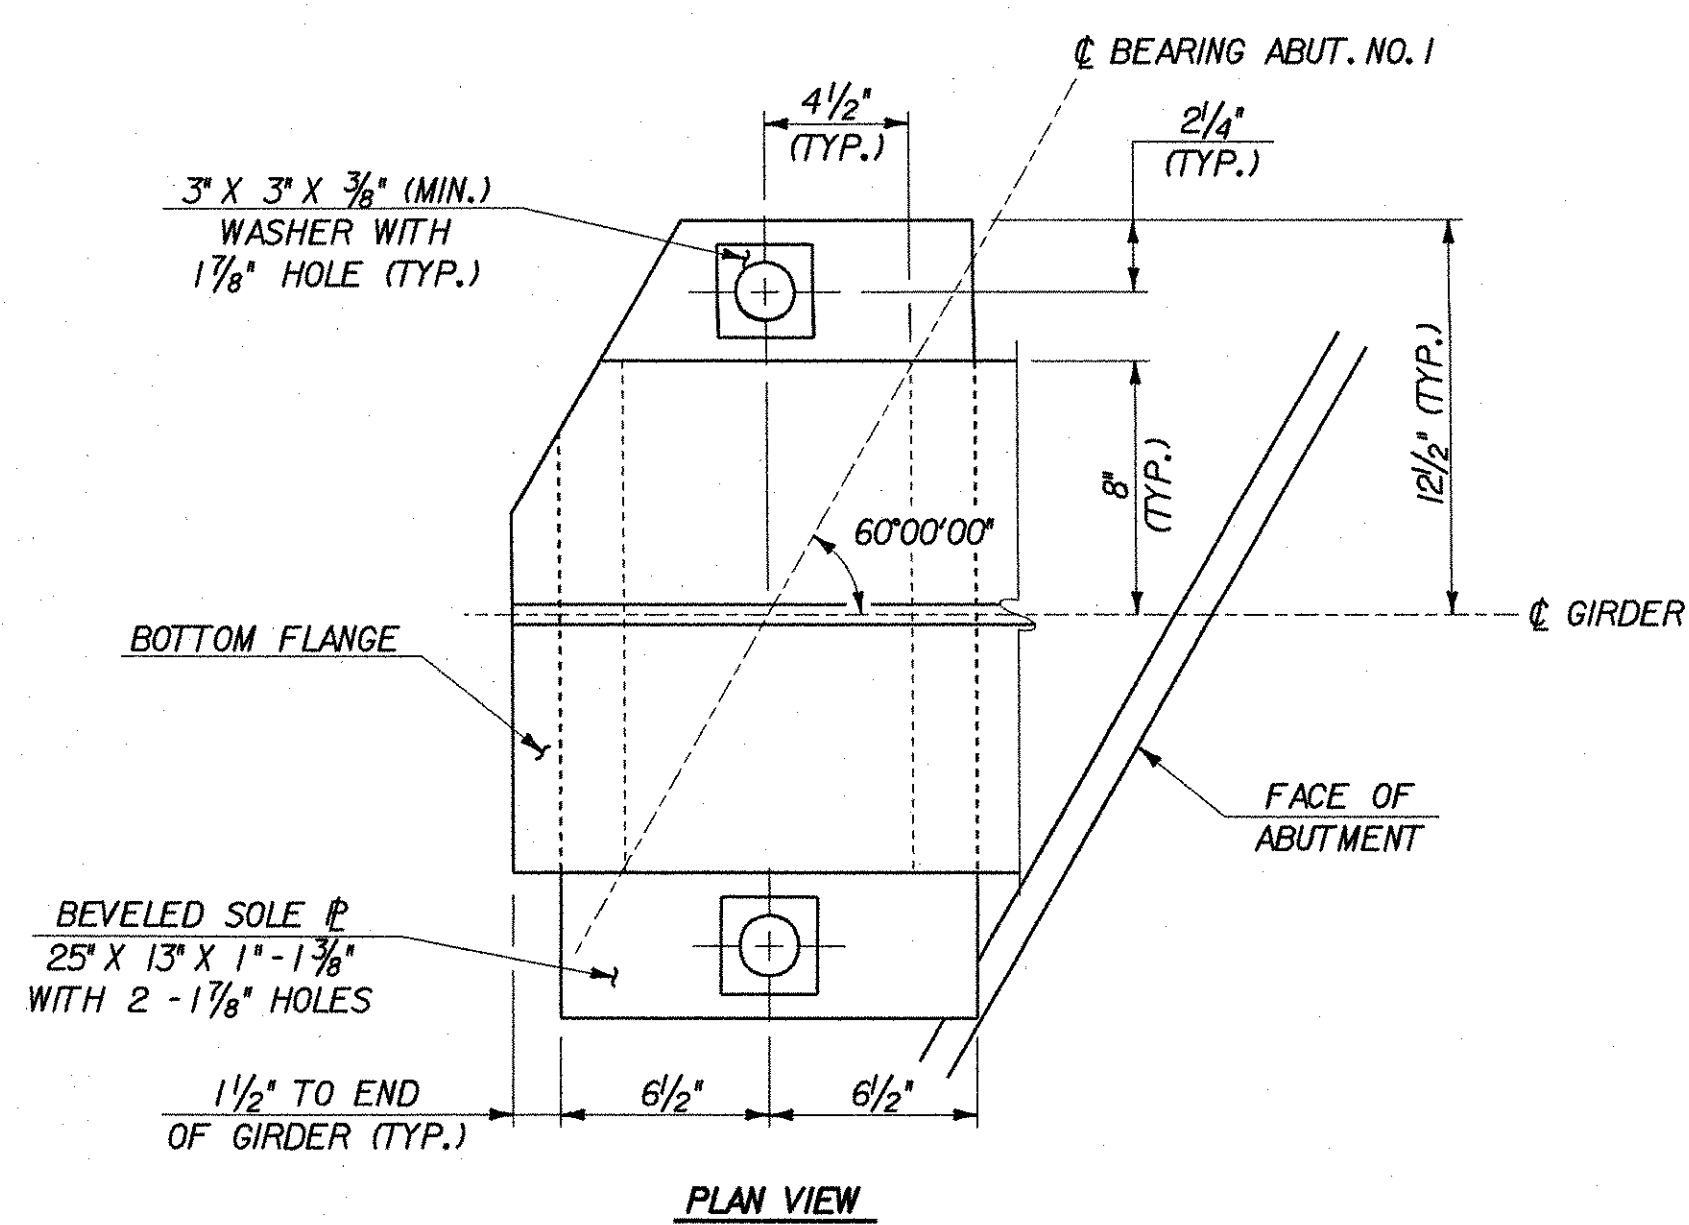

NOTE: FOR CURTAIN WALL BOXOUT DETAILS, SEE BRIDGE SHEET BR107.

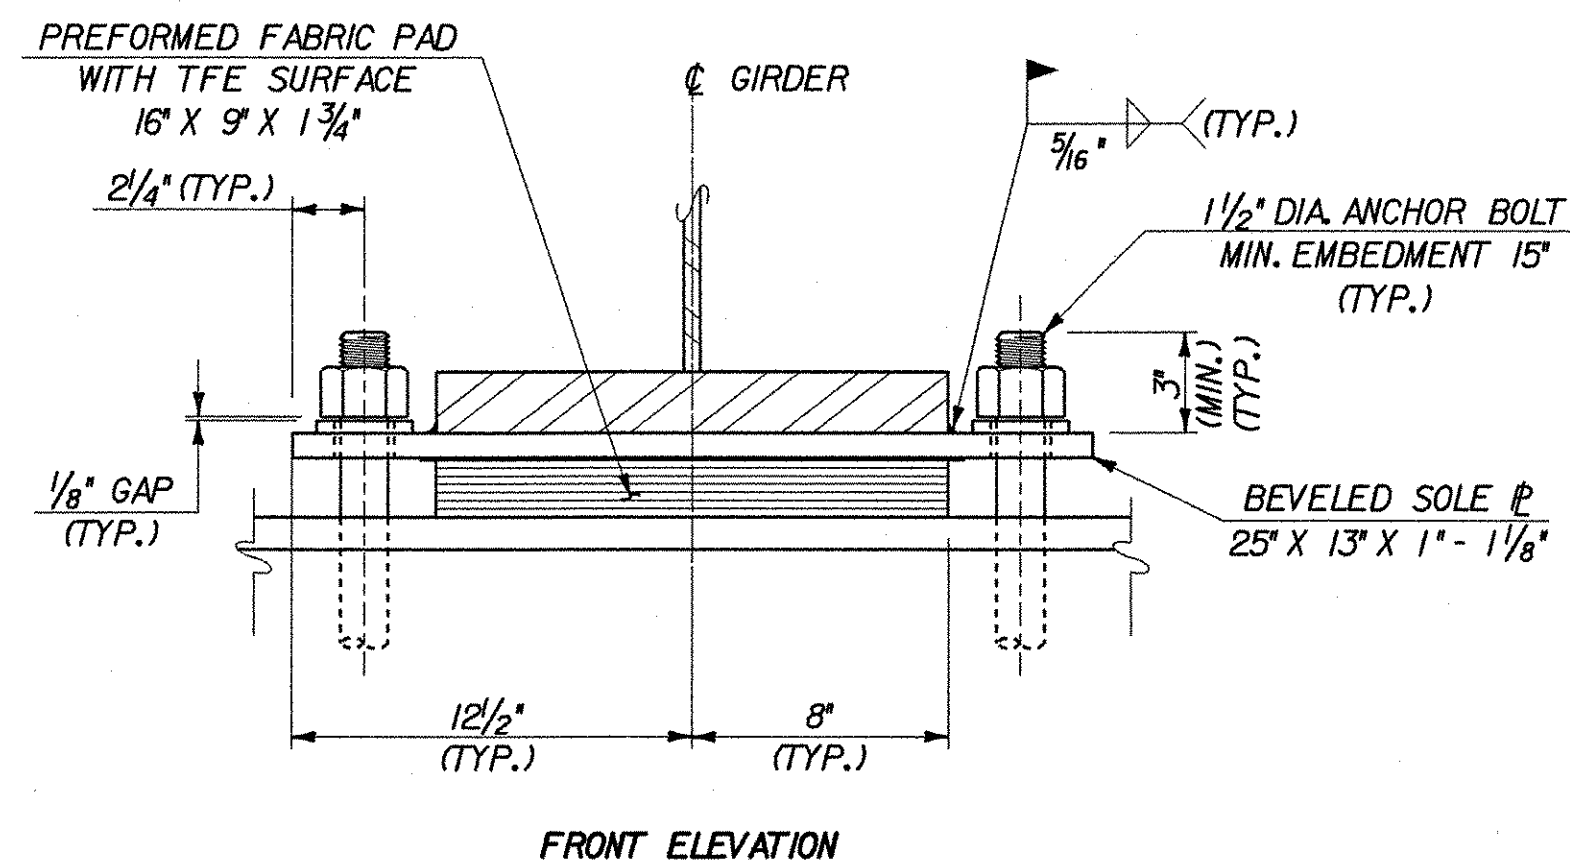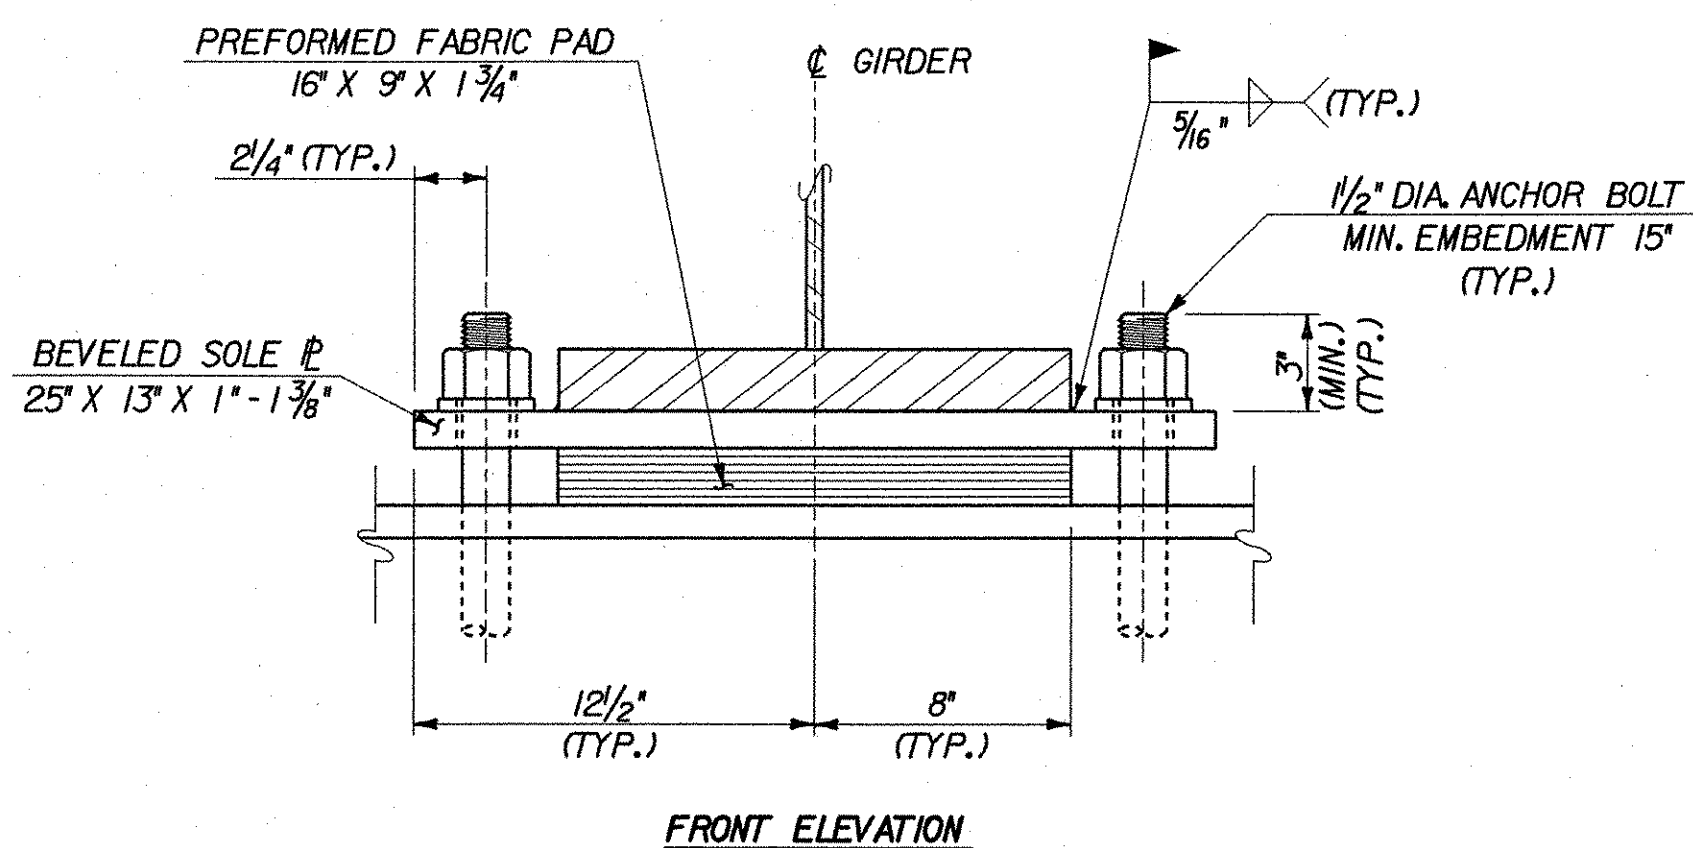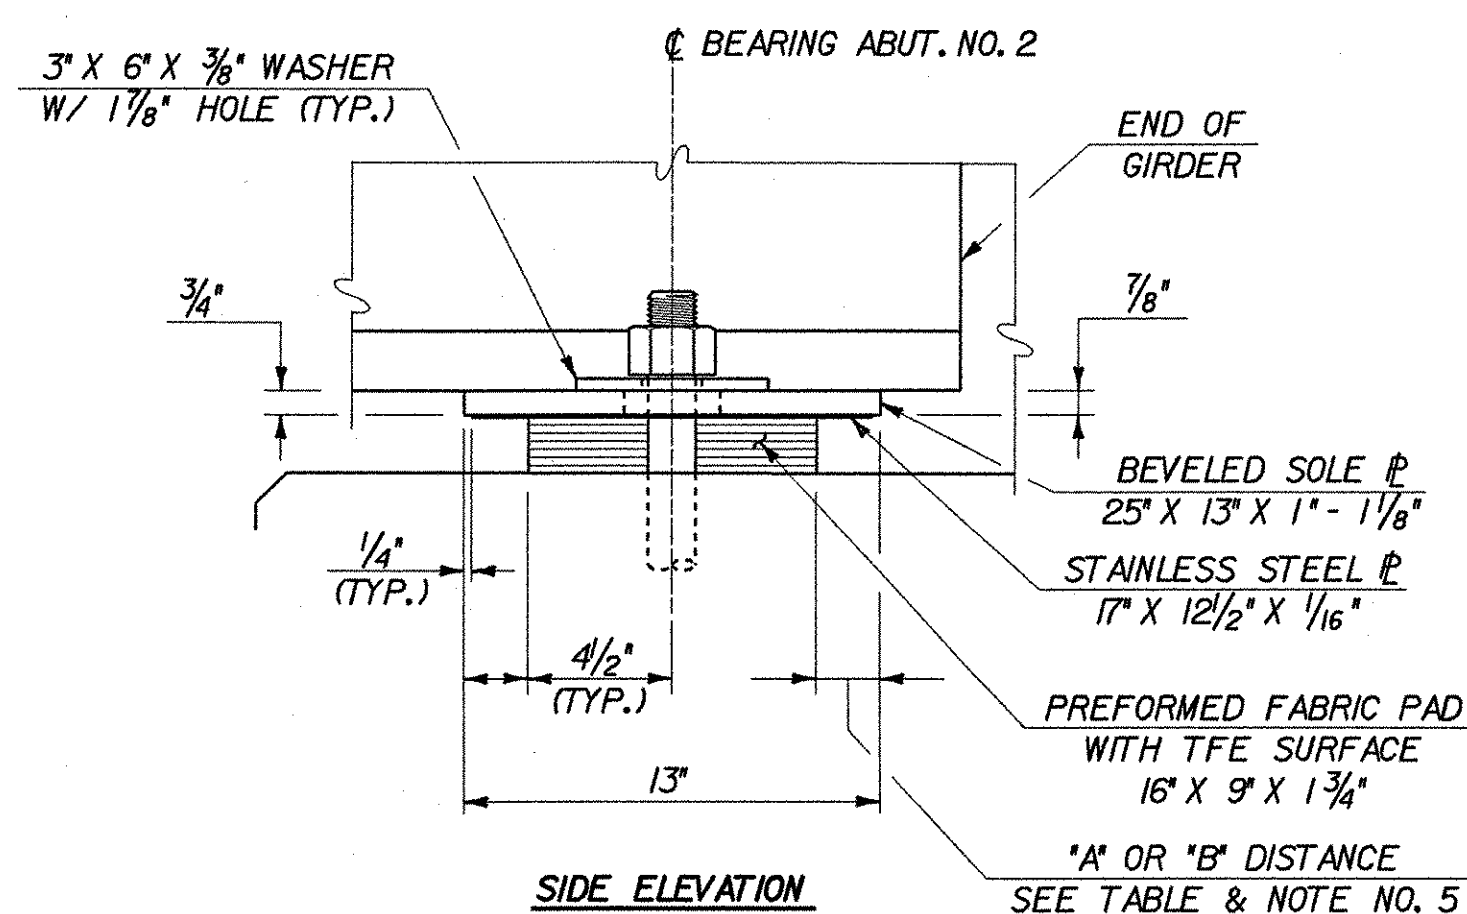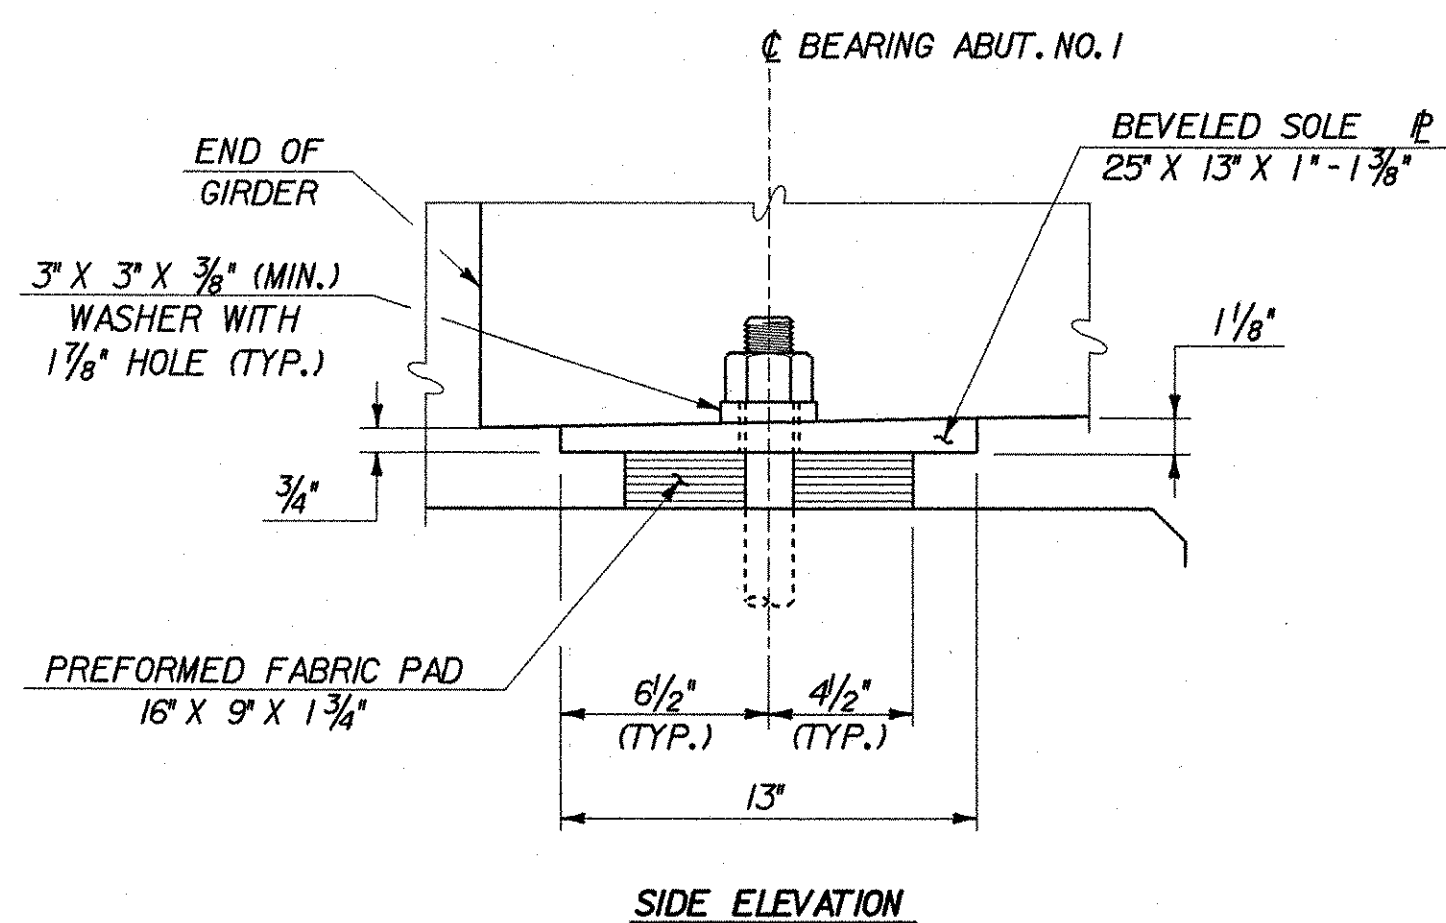

FIXED BEARING @ ABUTMENT NO. 1
SCALE: 2" = 1'-0"


EXPANSION BEARING @ ABUTMENT NO. 2
SCALE: 2" = 1'-0"

BEARING NOTES

- BEARINGS SHALL CONFORM TO APPLICABLE SUBSECTIONS OF SECTION 531 & 731.
- BEARINGS SHALL BE PAID FOR UNDER ITEM 531.10 'BEARING DEVICE ASSEMBLY'.
- SHOP DRAWINGS CONFORMING TO SUBSECTION 531.03 SHALL BE SUBMITTED TO INCLUDE WELDING AND BONDING PROCEDURES.
- THE CONCRETE SURFACE UNDER THE BEARING DEVICE SHALL BE LEVEL.
- *'A' DISTANCE IS THE FINAL SETTING FOR THE BEARING PAD AFTER ALL DEAD LOAD HAS BEEN APPLIED. THE FINAL 'A' DISTANCE, AS SHOWN IN THE TABLE, MUST BE ATTAINED WITHIN 1/8 INCH. 'B' DISTANCE IS FOR SETTING THE BEARING AFTER THE STRUCTURAL STEEL IS ERECTED AND BEFORE THE CONCRETE DECK IS POURED.
- DESIGN CRITERIA:
 A. BASE PLATE TO CONCRETE DESIGN PRESSURE = 1000 PSI MAXIMUM.
 B. MINIMUM DESIGN ROTATION = 0.015 RADIAN.
 C. HORIZONTAL CAPACITY SHALL BE A MINIMUM OF 6% VERTICAL LOAD.
 D. DESIGN LOAD PER BEARING @ ABUTMENTS NO. 1 & 2 (UNFACTORED).
 $R_{DL+SD} = 57$ KIPS
 $R_{LL-1} = 73$ KIPS
- ALL STEEL IN BEARING DEVICES (EXCEPT STAINLESS STEEL) SHALL BE AASHTO M-270, GRADE 36.
- ANCHOR BOLTS SHALL BE SWEDGED AND GALVANIZED WITH 4 OF THREAD. EXPANSION BEARING NUTS ARE TO BE DRAWN UP FINGER TIGHT AND THEN BACKED OFF 1/8 INCH. THREADS SHALL BE BURRED TO PREVENT NUT REMOVAL. ANCHOR BOLTS SHALL HAVE A MINIMUM OF 15" EMBEDMENT INTO THE CONCRETE. ANCHOR BOLTS, NUTS AND WASHERS SHALL MEET THE REQUIREMENTS OF SECTION 714.08.
- ALL BEARING DEVICES SHALL BE GALVANIZED OR METALLIZED. AREAS OF GALVANIZING OR METALLIZING DAMAGED BY THE FIELD WELDS OR HANDLING SHALL BE REPAIRED PER SECTION 513 OF THE SUPPLEMENTAL SPECIFICATIONS.
- ALL HORIZONTAL DIMENSIONS SHOWN @ 45° ARE FINAL CONDITION DIMENSIONS.
- FOR TOP & BOTTOM FLANGE CLIP DETAIL, SEE BRIDGE SHEET BR109.

TEMPERATURE SETTING TABLE

ABUTMENT NO. 2		
TEMP	'A' DIST	'B' DIST
0° F	2 5/16"	1 13/16"
15° F	2 3/16"	1 11/16"
30° F	2 1/8"	1 7/8"
45° F	2"	1 1/2"
60° F	1 7/8"	1 3/8"
75° F	1 13/16"	1 5/16"
90° F	1 11/16"	1 3/16"
105° F	1 9/16"	1 1/16"

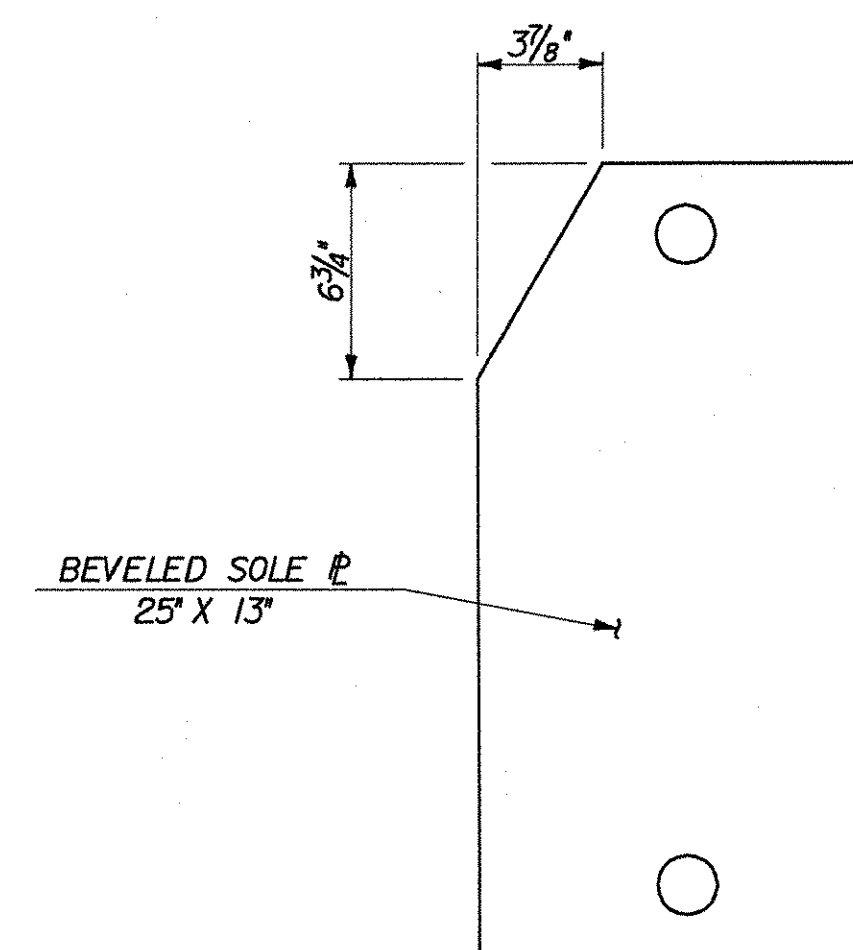

SOLE PLATE CLIP DETAIL


SCALE: 2" = 1'-0"

NOTE: FIXED BEARING SHOWN. EXPANSION BEARING SIMILAR.


STATE OF VERMONT AGENCY OF TRANSPORTATION

Town Of	SHELBURNE	Bridge No.	15
Highway No.	TH 3	Log Sta.	
		Surv. Sta.	
BOSTWICK ROAD OVER VERMONT RAILWAY			
BEARING DETAILS			
Designed By	L. WIXSON	Drawn By	S. MERKMAN
Checked By	R. JOY	Date	05/03
		Bridge Design Supervisor	M. ZYDEL
		Date	05/03
PROJECT	SHELBURNE	PROJECT NO.	BRO 1445(30)
I.C.C. Info. M:\595402_Bostwick\BRIDGE\6m\ar\z\196brg.dgn			
Bridge Sheet No. BR110		Sheet 50 of 73	




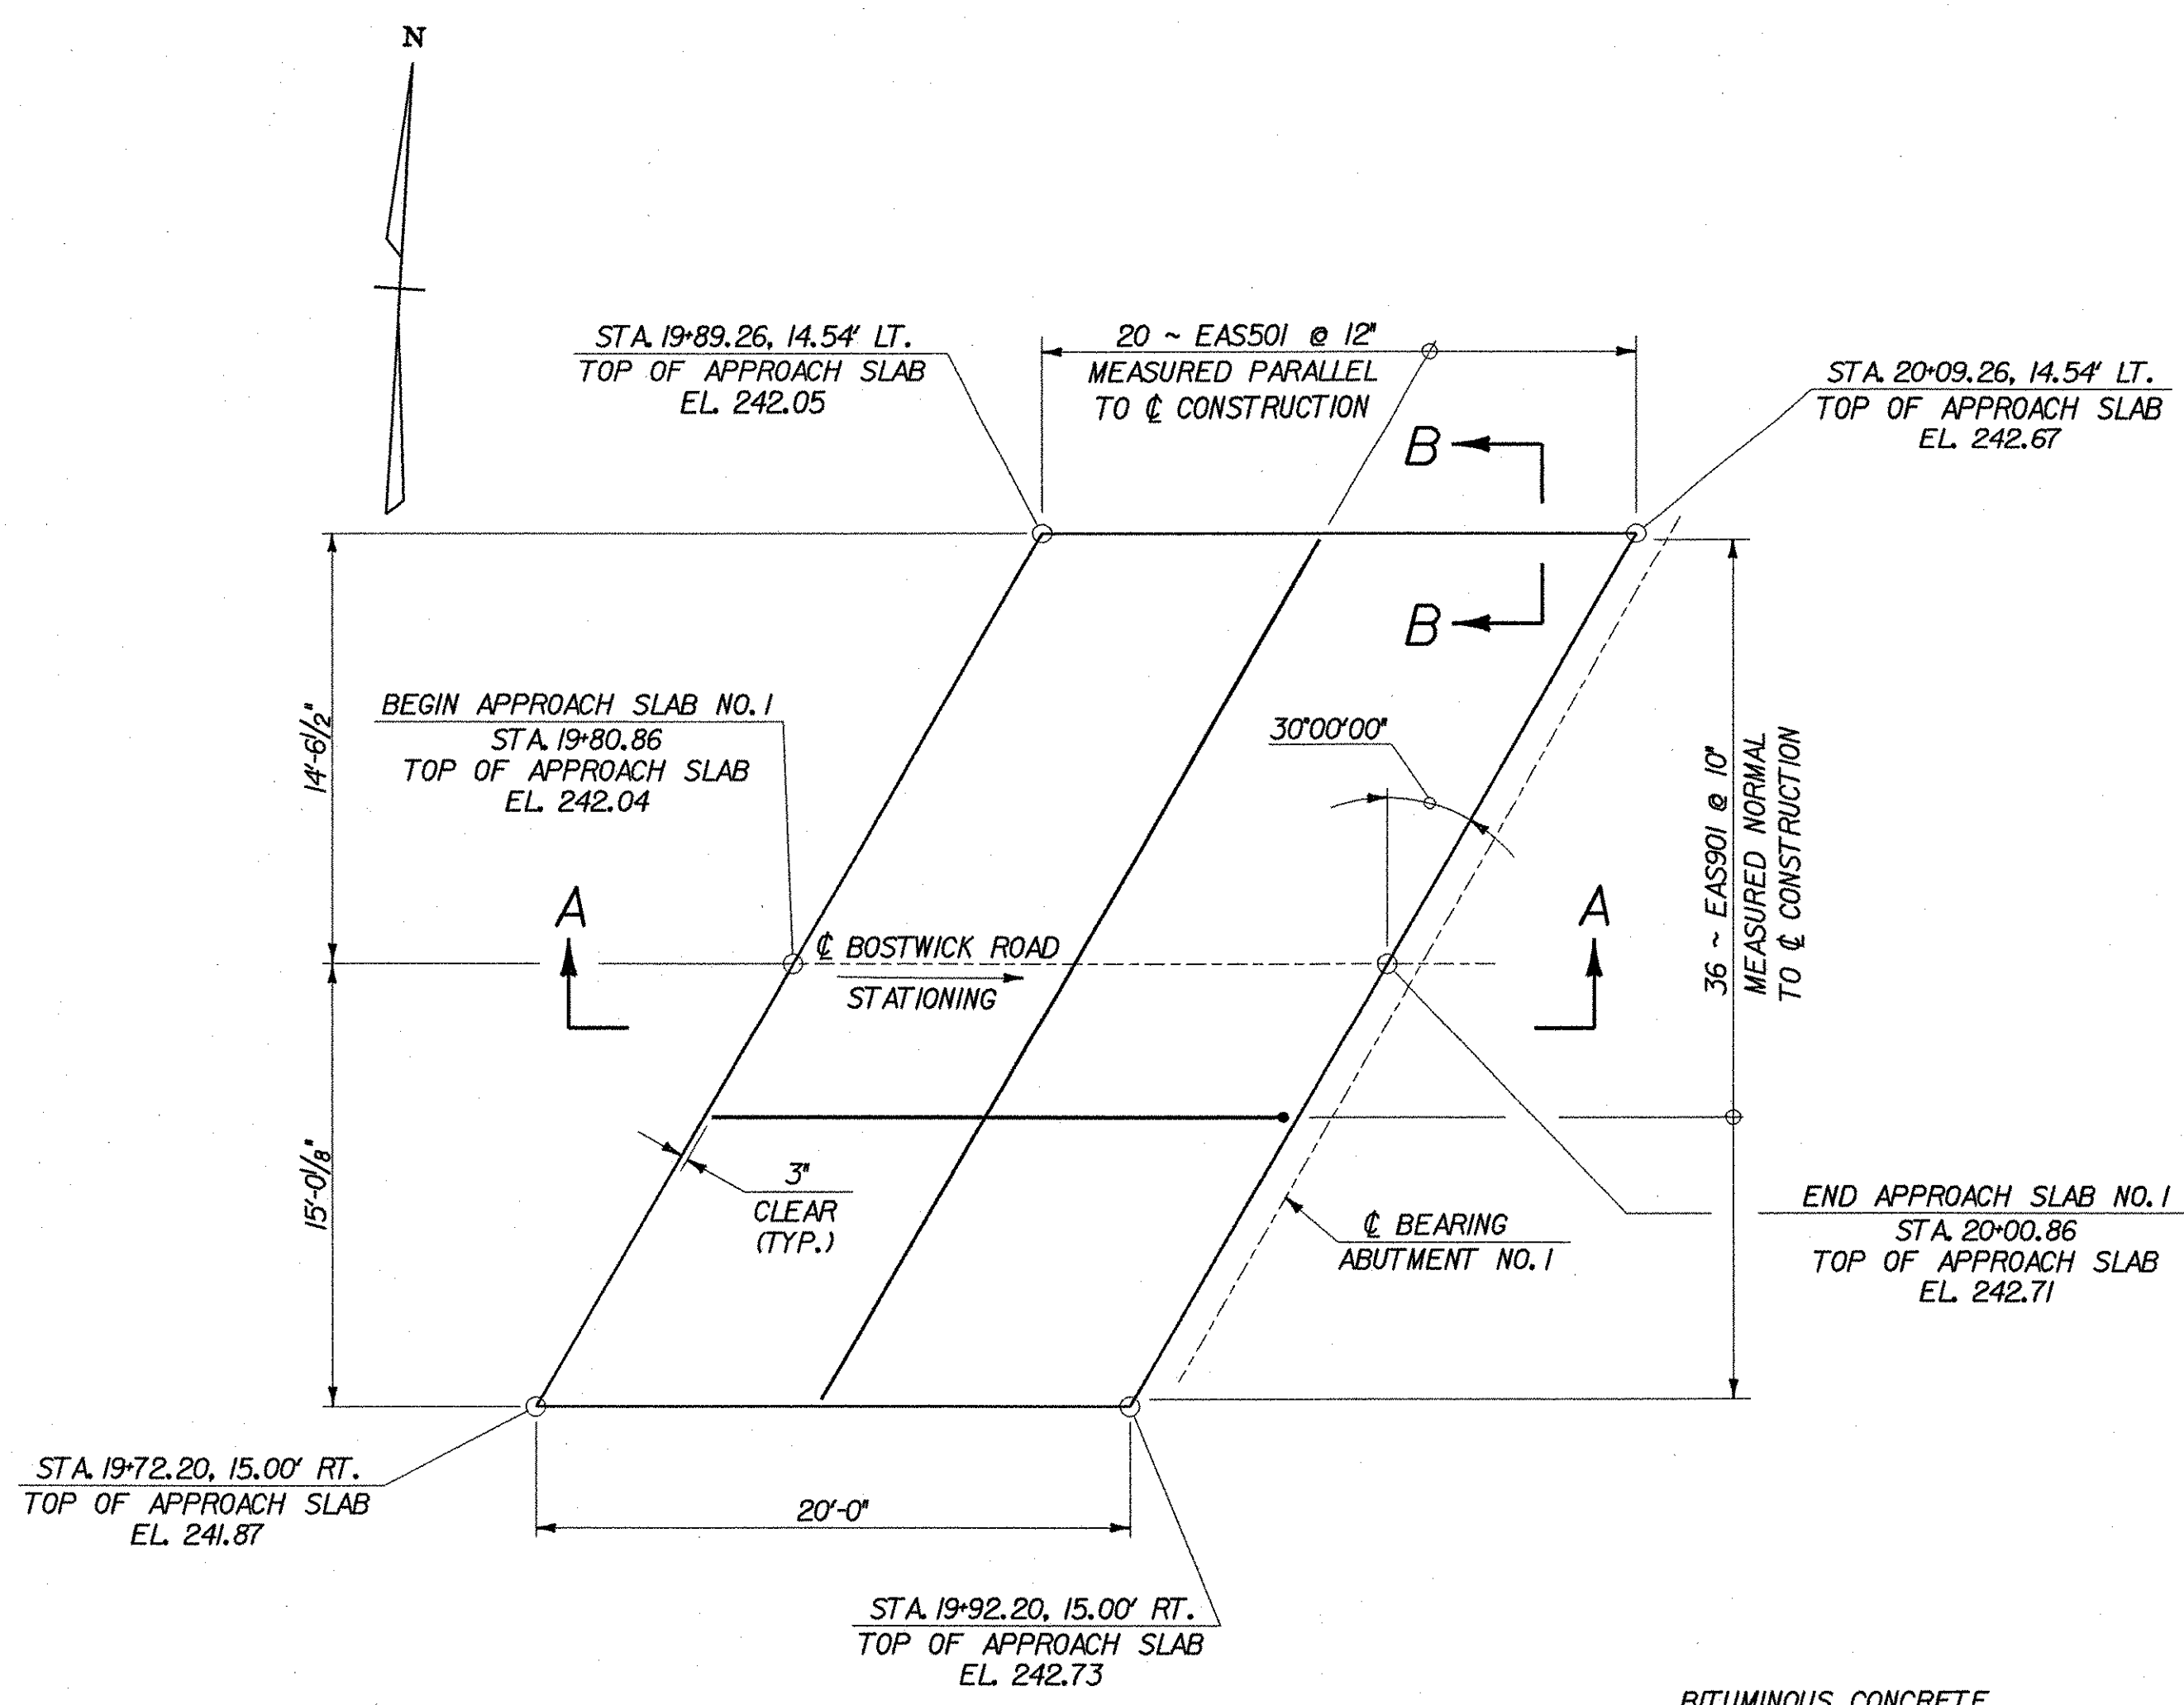


APPROACH SLAB NO. 1 PLAN
SCALE: 3/16" = 1'-0"

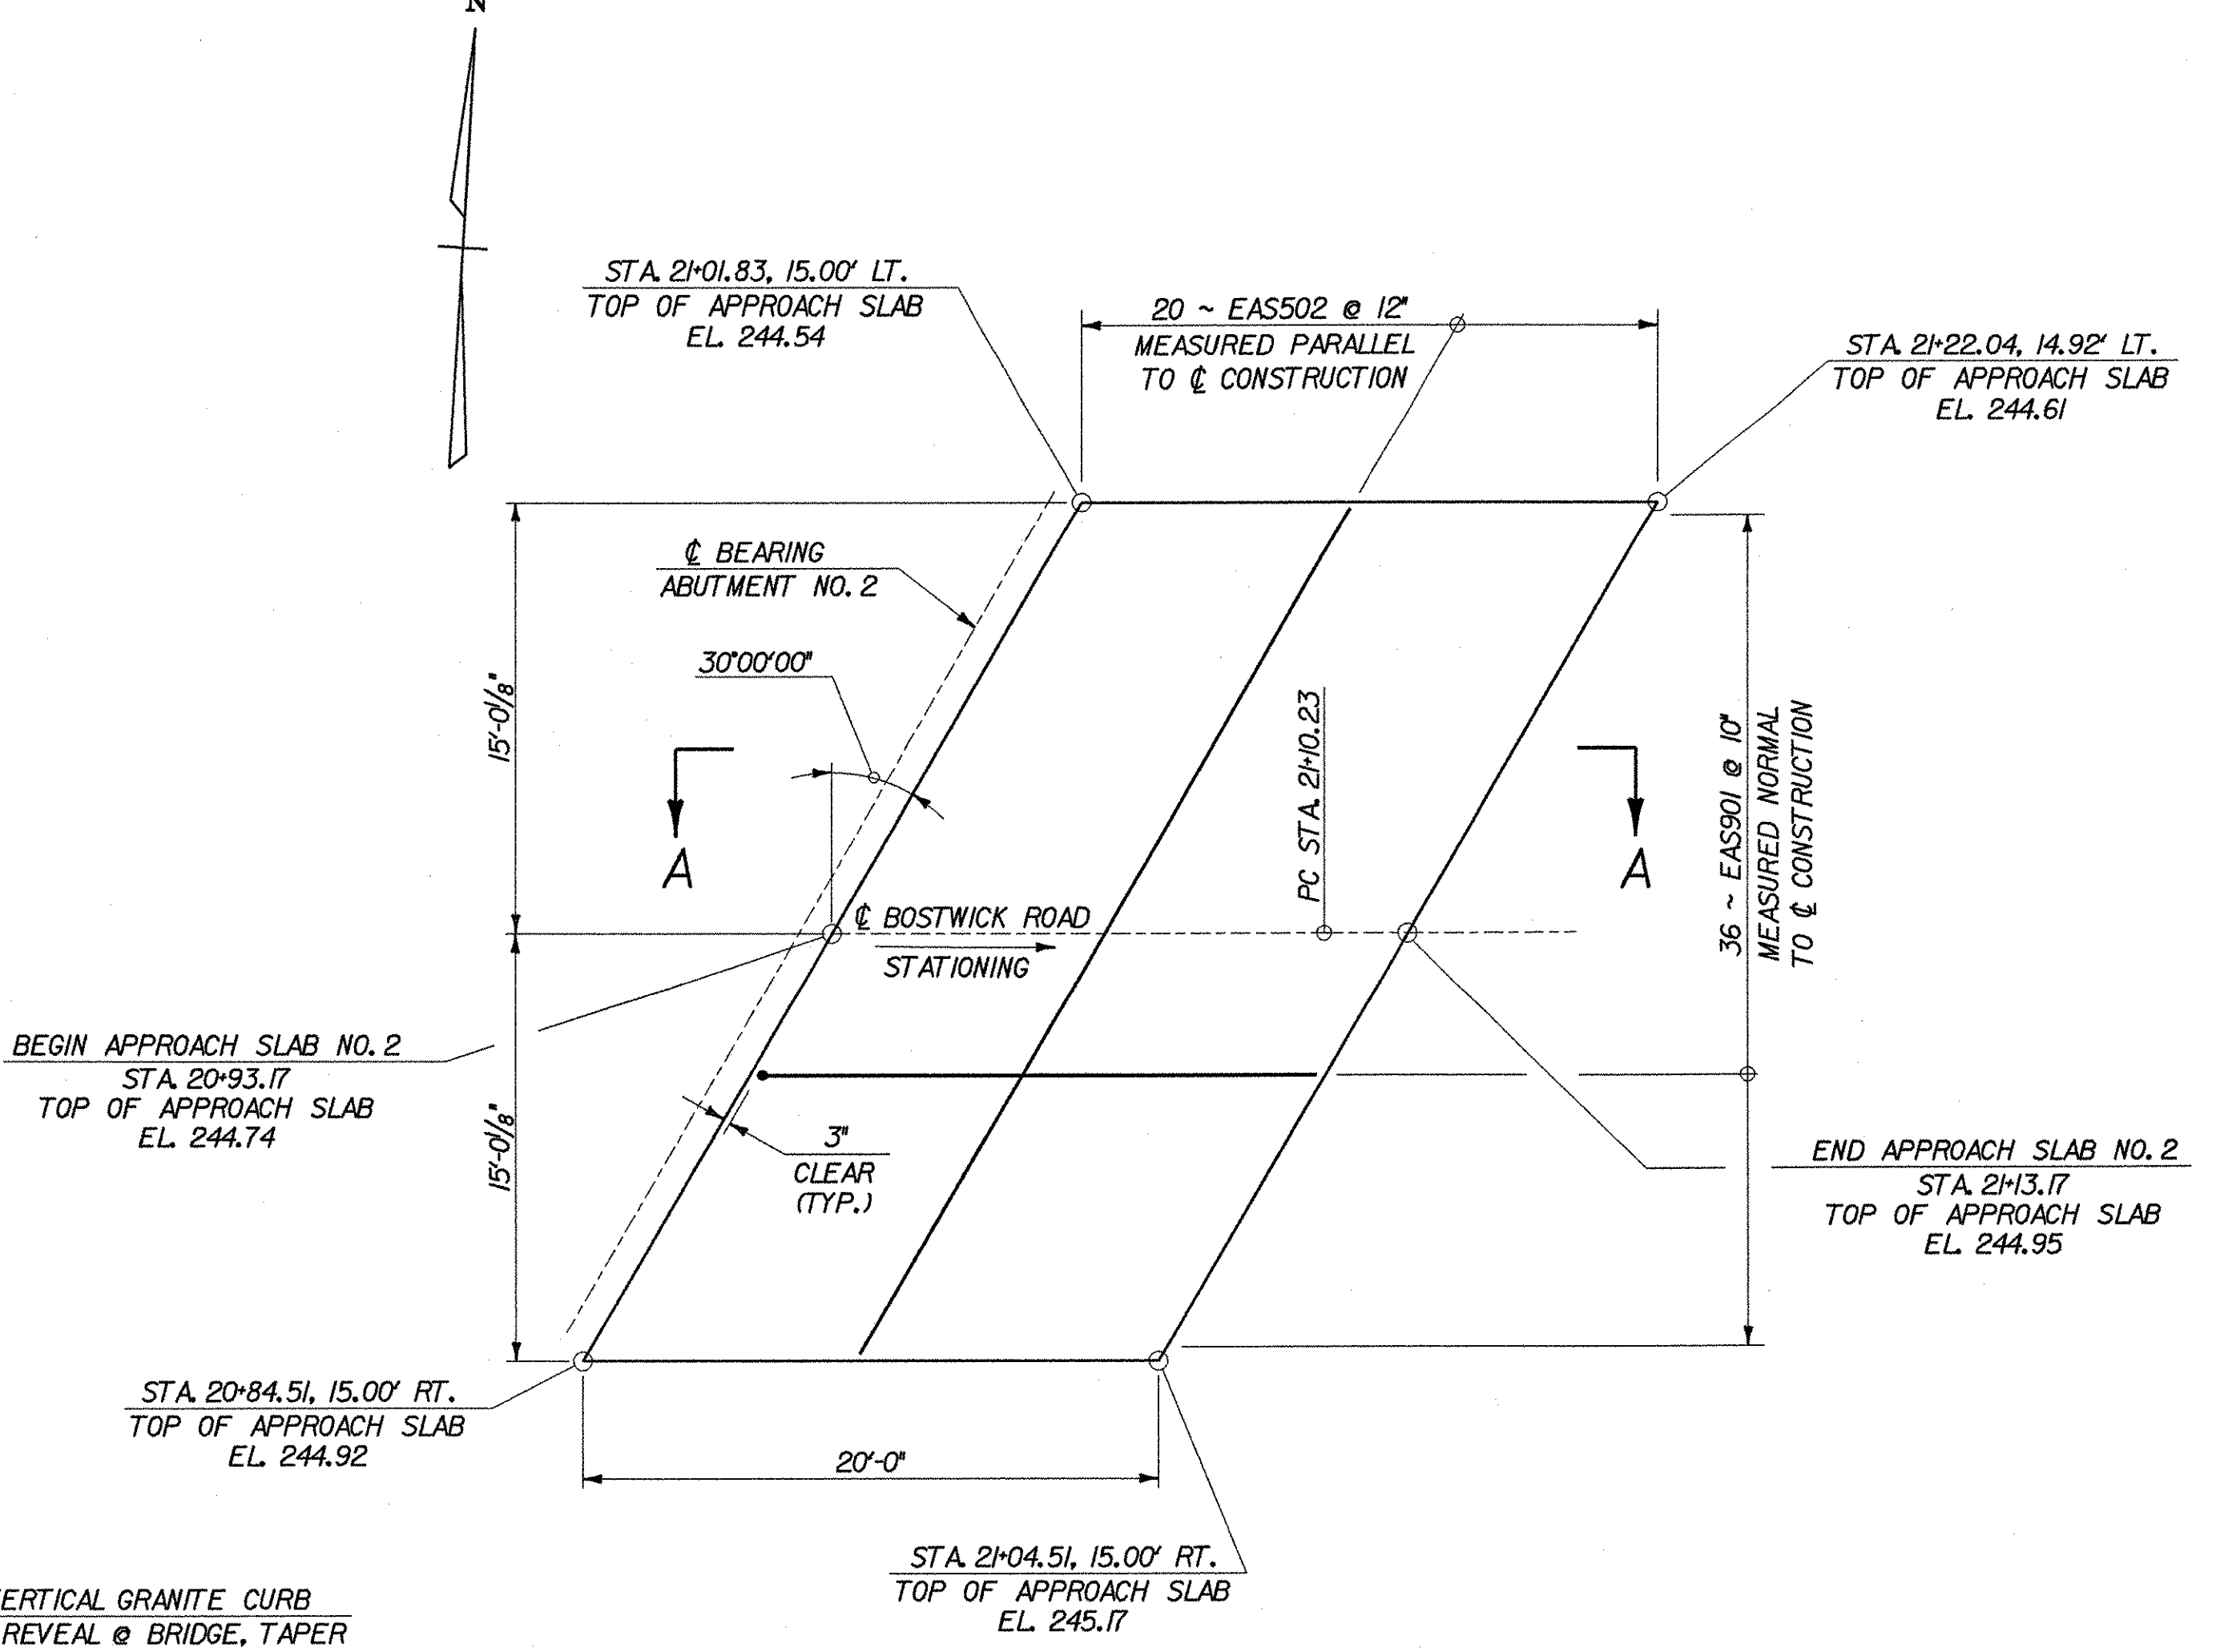

APPROACH SLAB NO. 2 PLAN
SCALE: 3/16" = 1'-0"

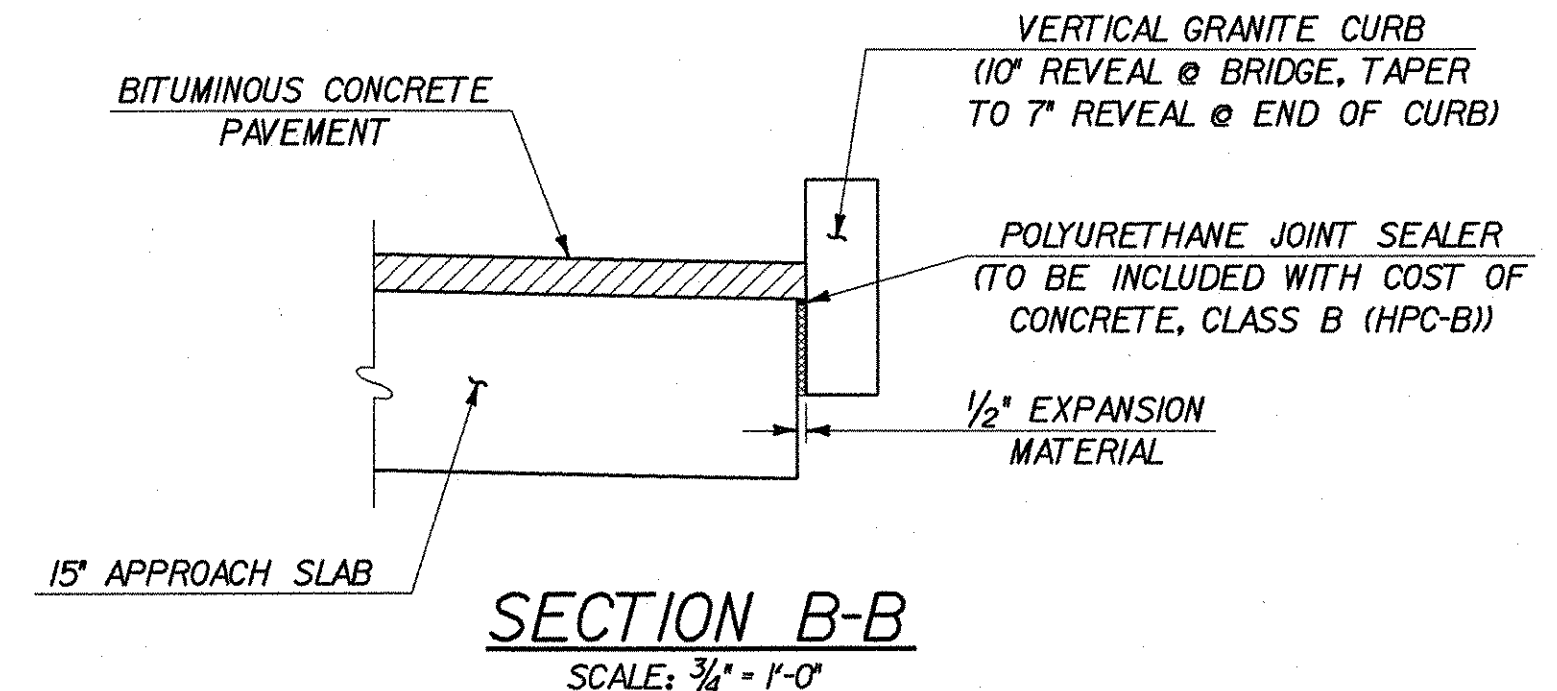


SECTION B-B
SCALE: 3/4" = 1'-0"

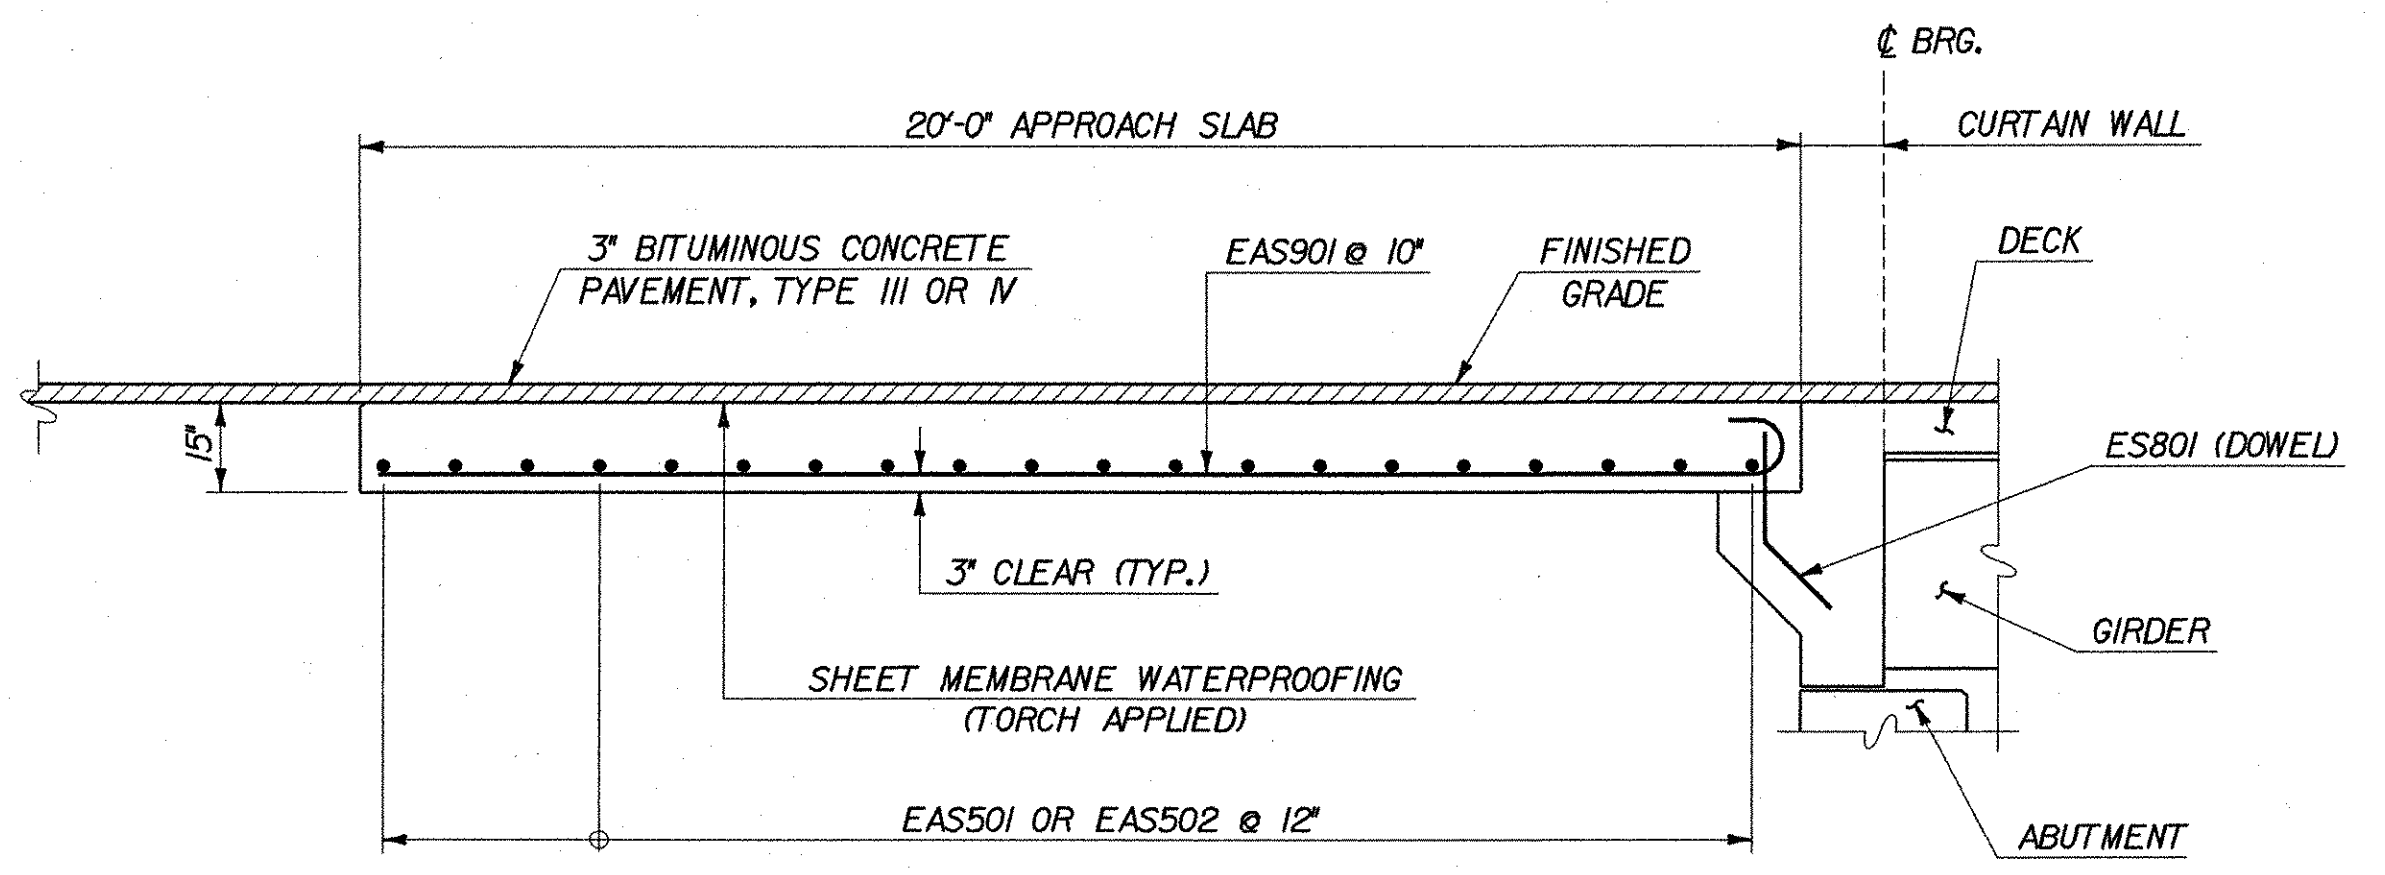

SECTION A-A
SCALE: 3/8" = 1'-0"

NOTE: DECK JOINT NOT SHOWN FOR CLARITY

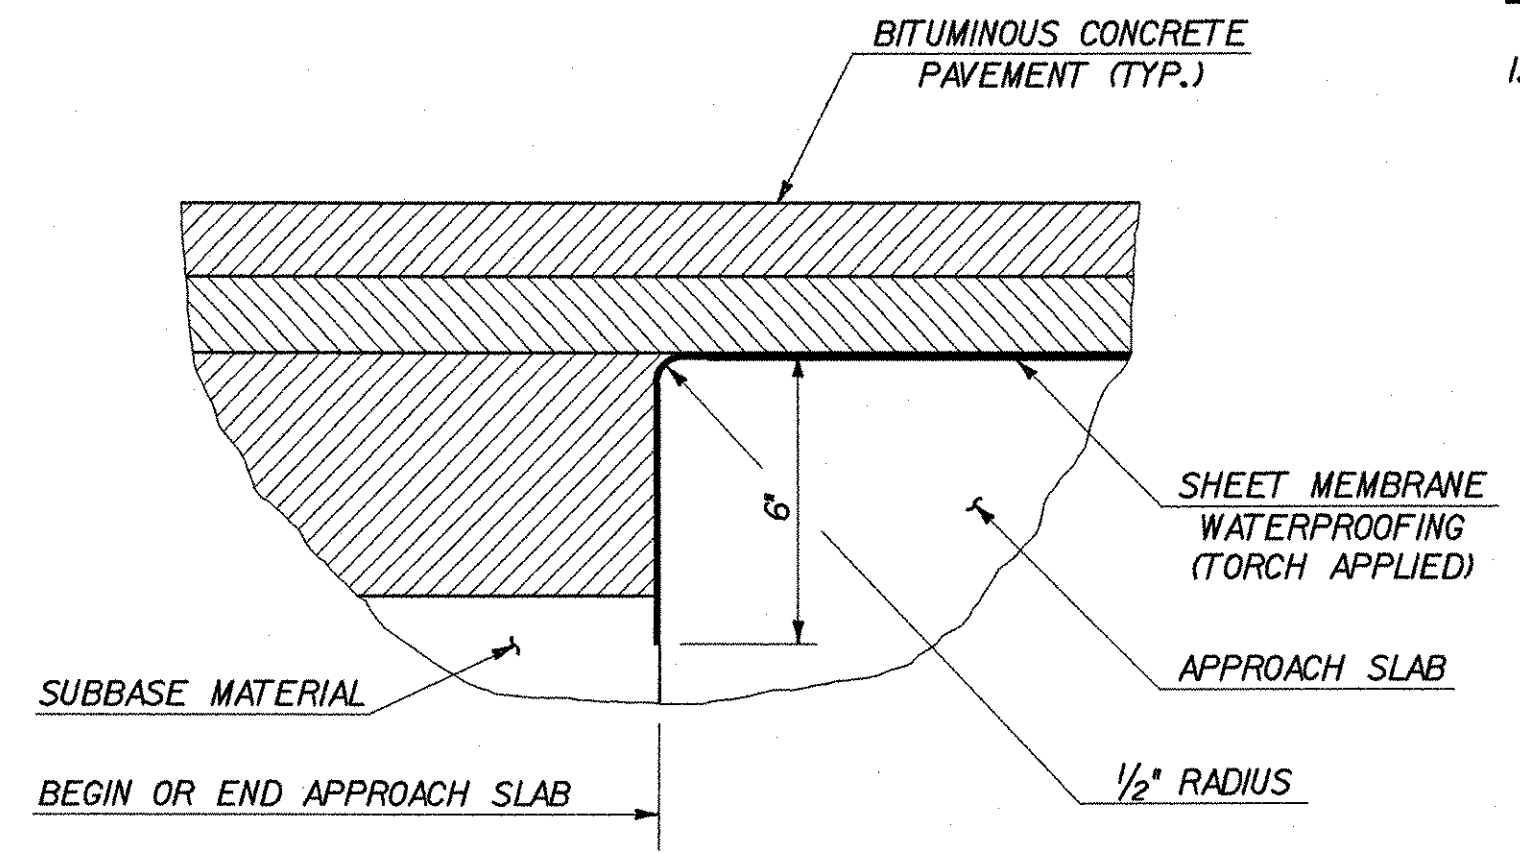

SHEET MEMBRANE DETAIL
SCALE: 3" = 1'-0"


NOTES

1. ACUTE ANGLES IN APPROACH SLABS SHALL BE CLIPPED 6" X 6".


STATE OF VERMONT AGENCY OF TRANSPORTATION			
Town Of	SHELBURNE	Bridge No.	15
Highway No.	TH 3	Log Sta.	
		Surv. Sta.	
BOSTWICK ROAD OVER VERMONT RAILWAY APPROACH SLABS			
Designed By	L. WIXSON	Drawn By	S. MERKMAN
Checked By	R. JOY	Date	05/03
		Bridge Design Supervisor	M. ZYDEL
		Date	05/03
PROJECT	SHELBURNE	PROJECT NO.	BRO 1445(30)
I.C.C. Info. M:\595402 Bostwick\BRIDGE\6m\ar\z\196asd.dgn			
Bridge Sheet No.	BR111	Sheet	51 of 73




PLOTTED 01-AUG-2003

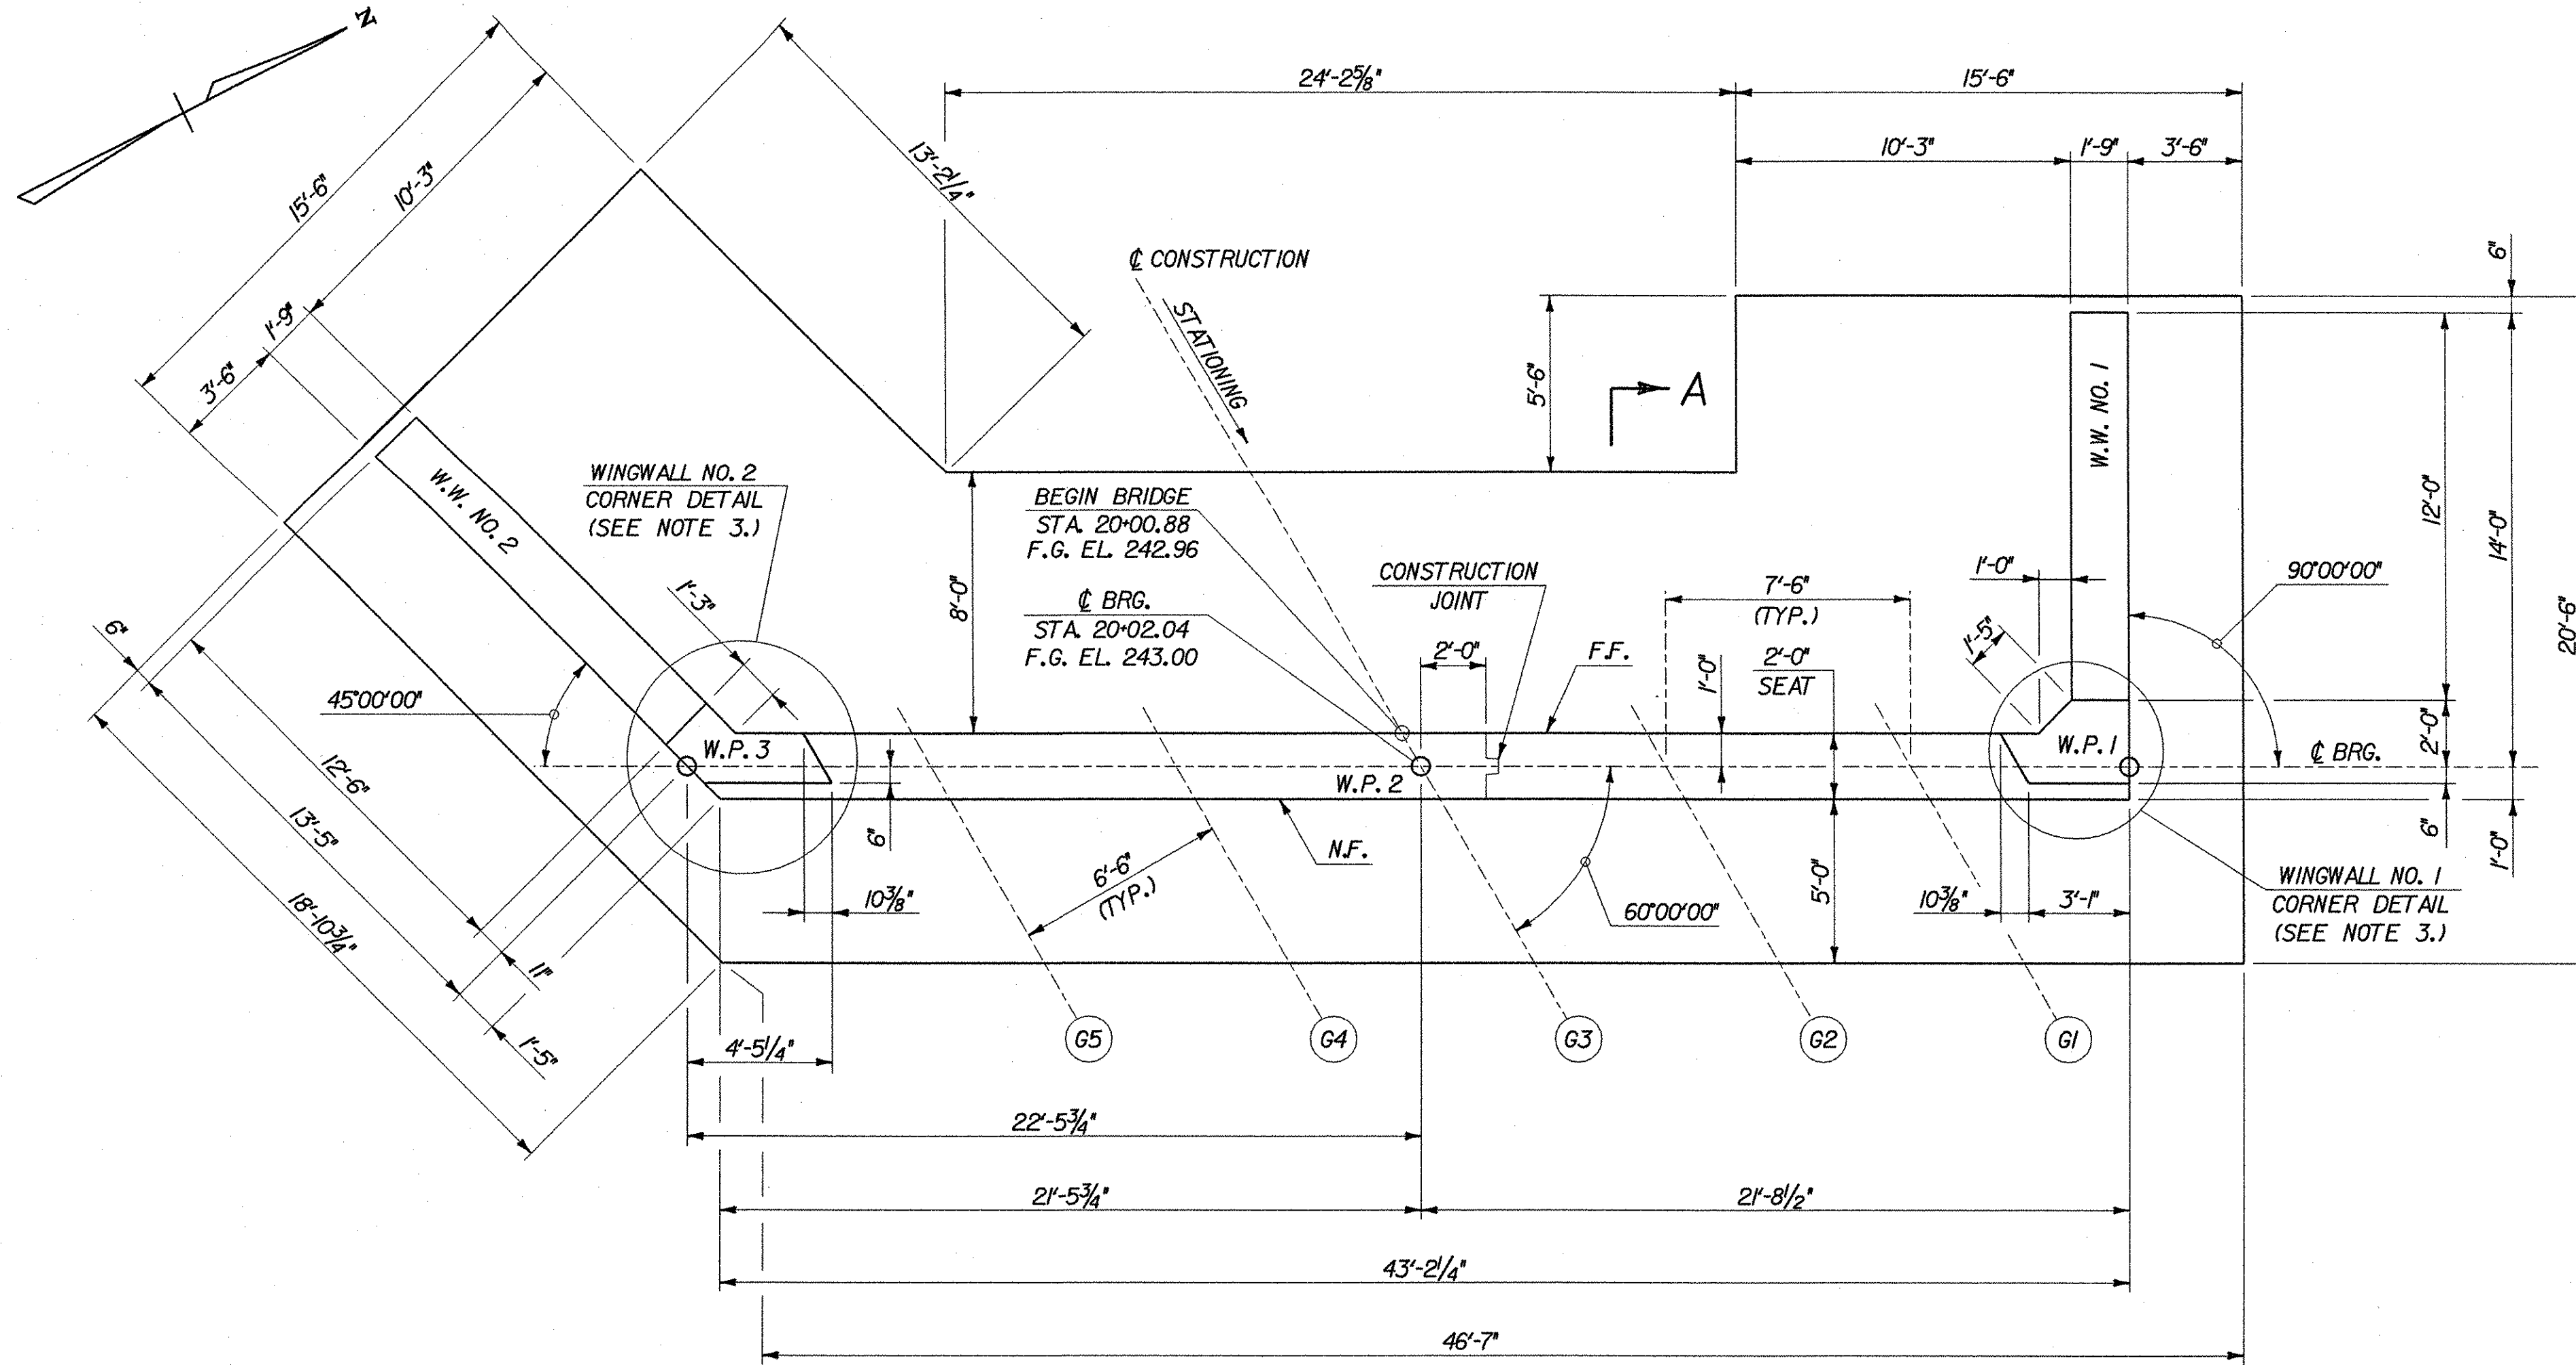

WORKING POINTS		
LOCATION	NORTHING	EASTING
W.P. 1	79605.3640	43981.1337
W.P. 2	79585.9275	43971.4687
W.P. 3	79565.7961	43961.4580

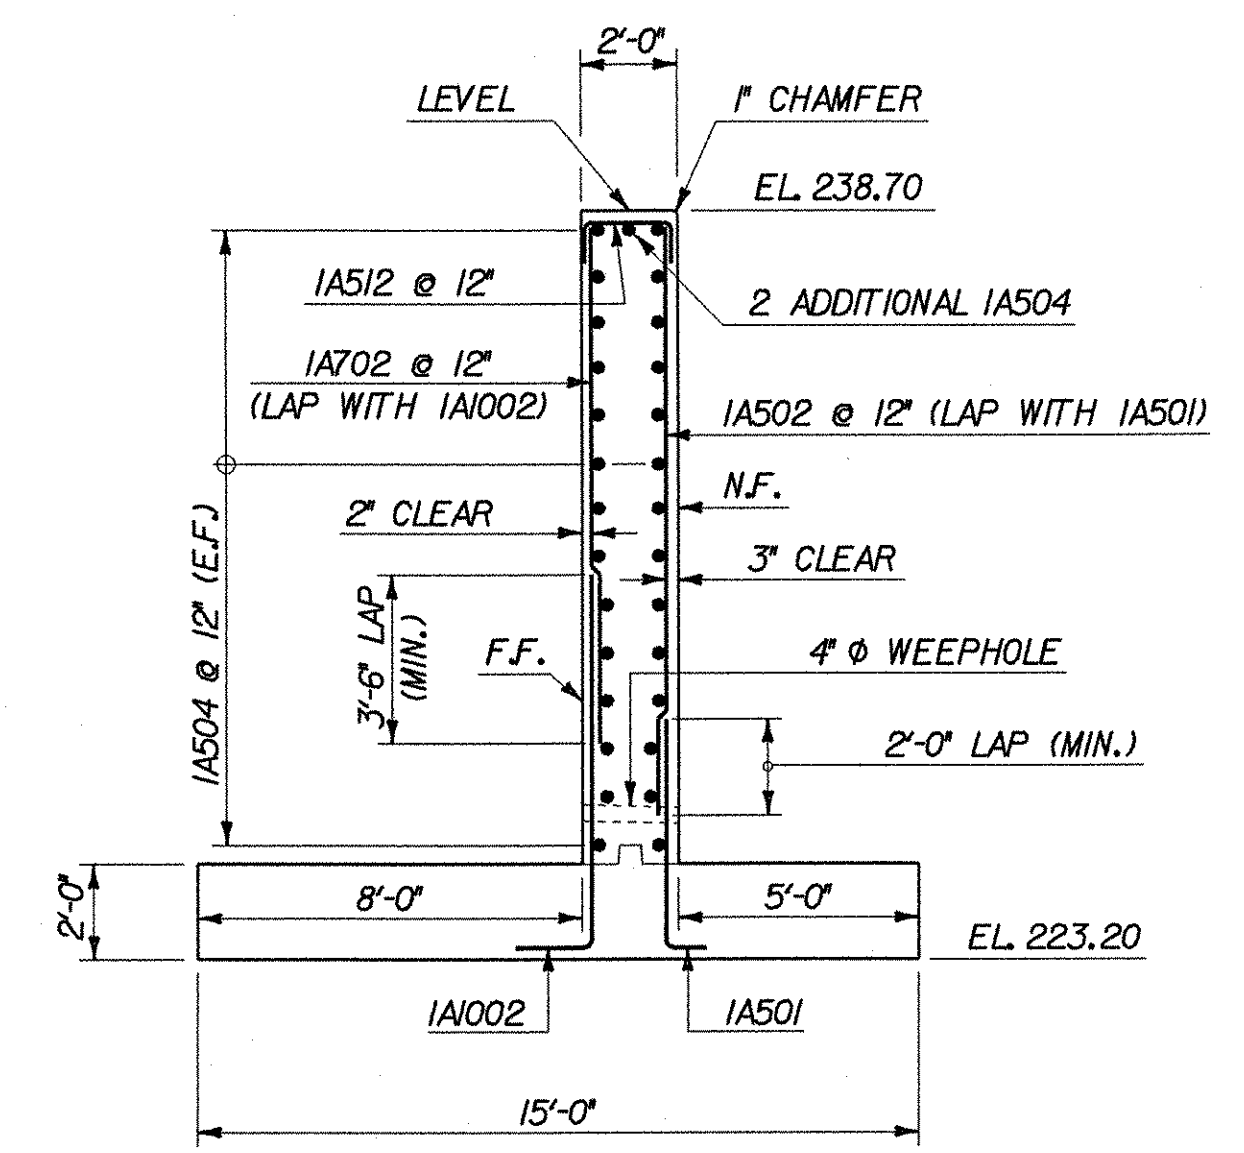


- NOTES**
- FOR FOOTING DETAILS, SEE BRIDGE SHEET BRII3.
 - FOR WINGWALL DETAILS, SEE BRIDGE SHEET BRII7.
 - FOR WINGWALL CORNER DETAILS, SEE BRIDGE SHEET BRII6.

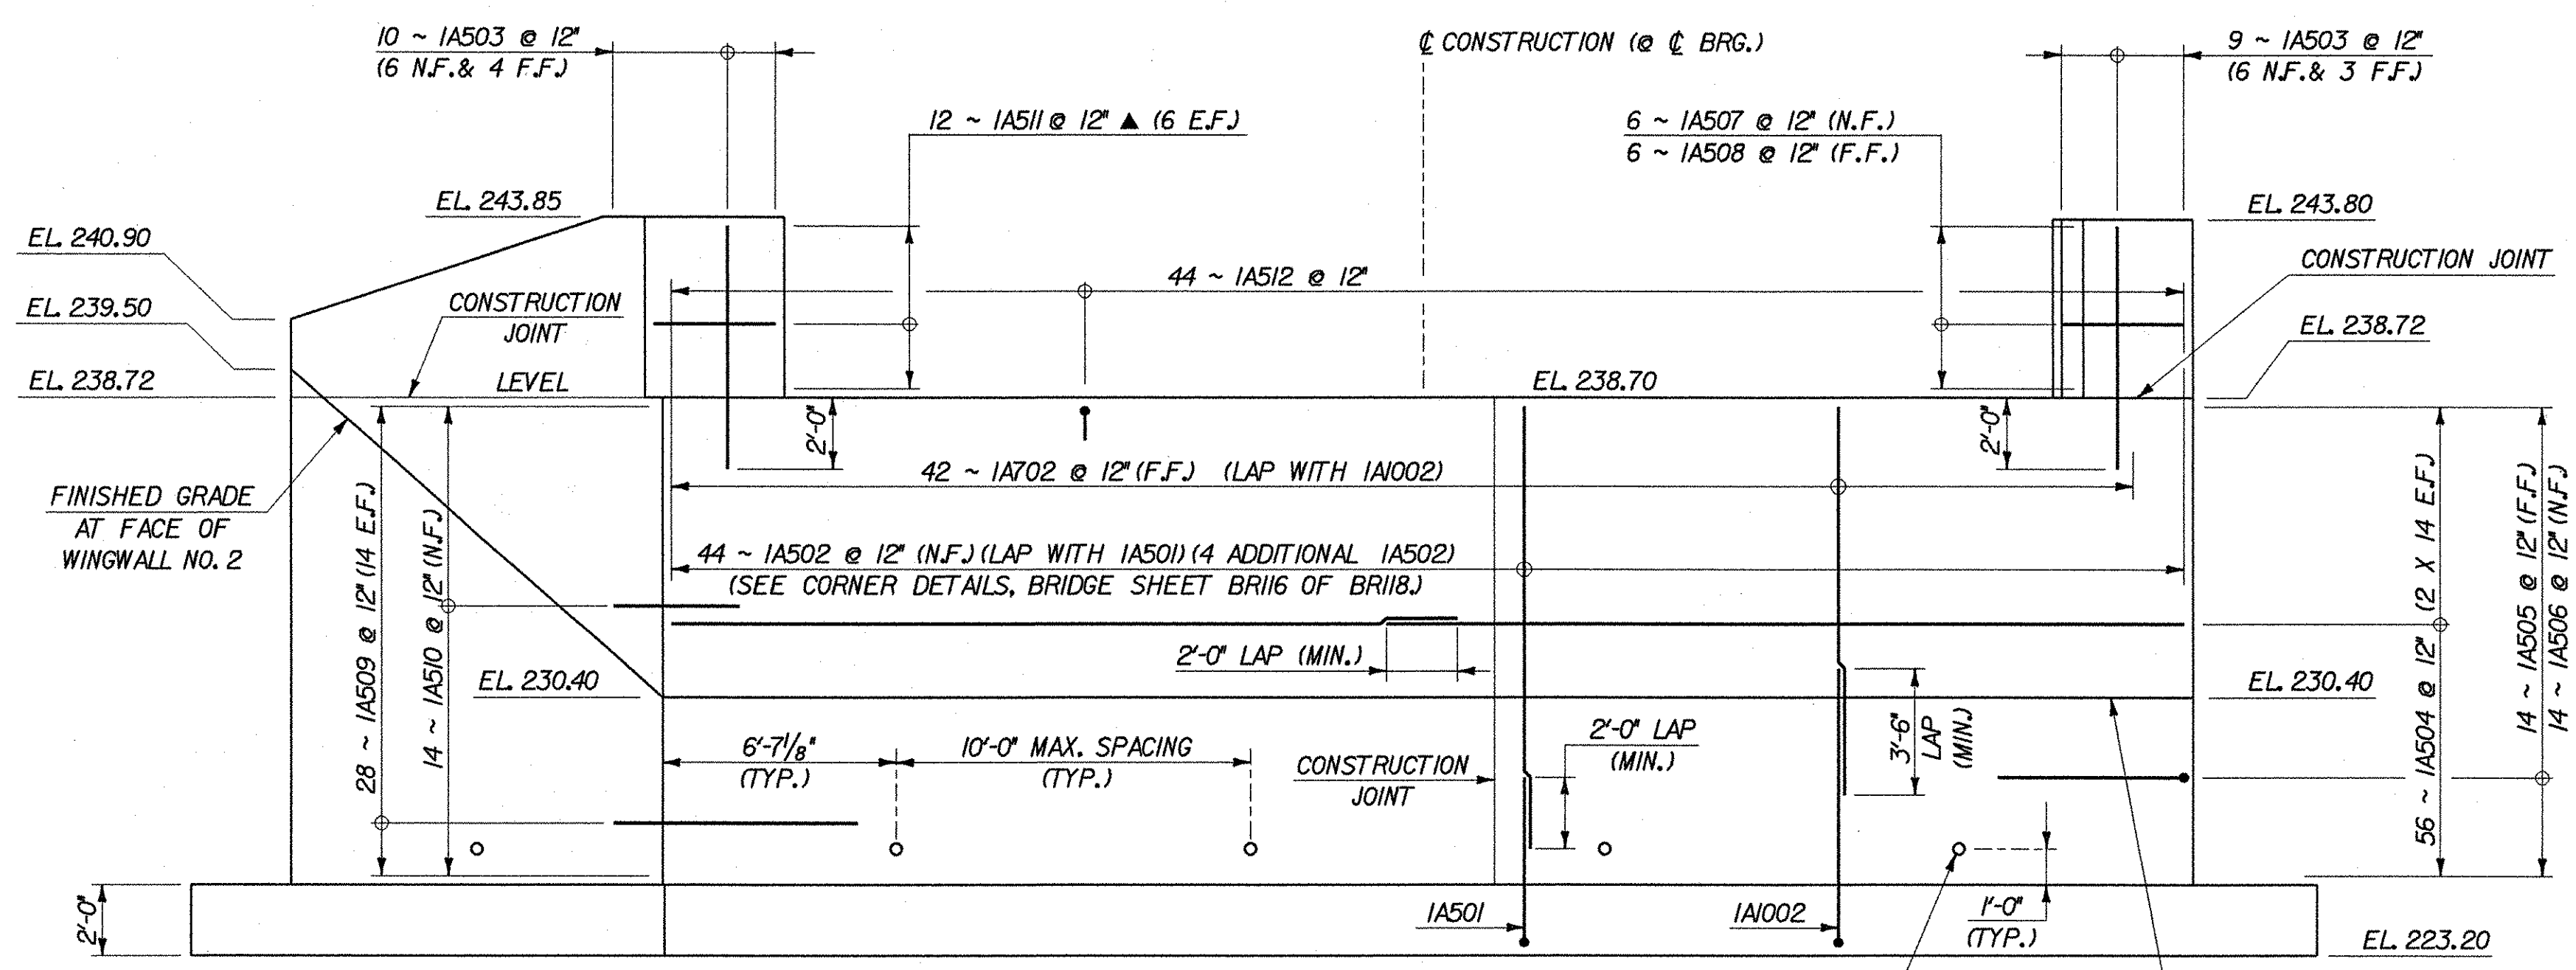


LEGEND

- N.F. - NEAR FACE
- F.F. - FAR FACE
- E.F. - EACH FACE
- ▲ - CUT TO FIT IN FIELD



STATE OF VERMONT AGENCY OF TRANSPORTATION	
Town Of SHELBURNE	Bridge No. 15
Highway No. TH 3	Log Sta. Surv. Sta.
BOSTWICK ROAD OVER VERMONT RAILWAY ABUTMENT NO. 1	
Designed By L. WIXSON	Drawn By S. MERKMAN
Checked By R. JOY	Date 05/03 Bridge Design Supervisor M. ZYDEL Date 05/03
PROJECT SHELBURNE	PROJECT NO. BRO 1445(30)
I.G.C. Info. M:\595402_Bostwick\BRIDGE\6m\lar\z\1196abl.dgn	
Bridge Sheet No. BRII2	Sheet 52 of 73

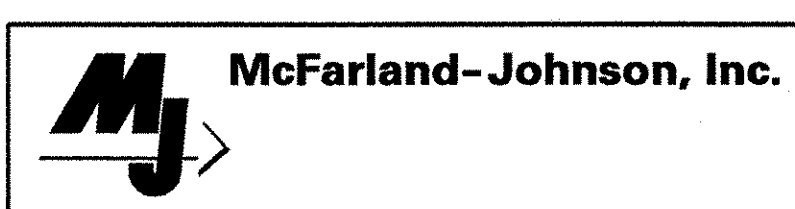

PLOTTED 01-AUG-2003

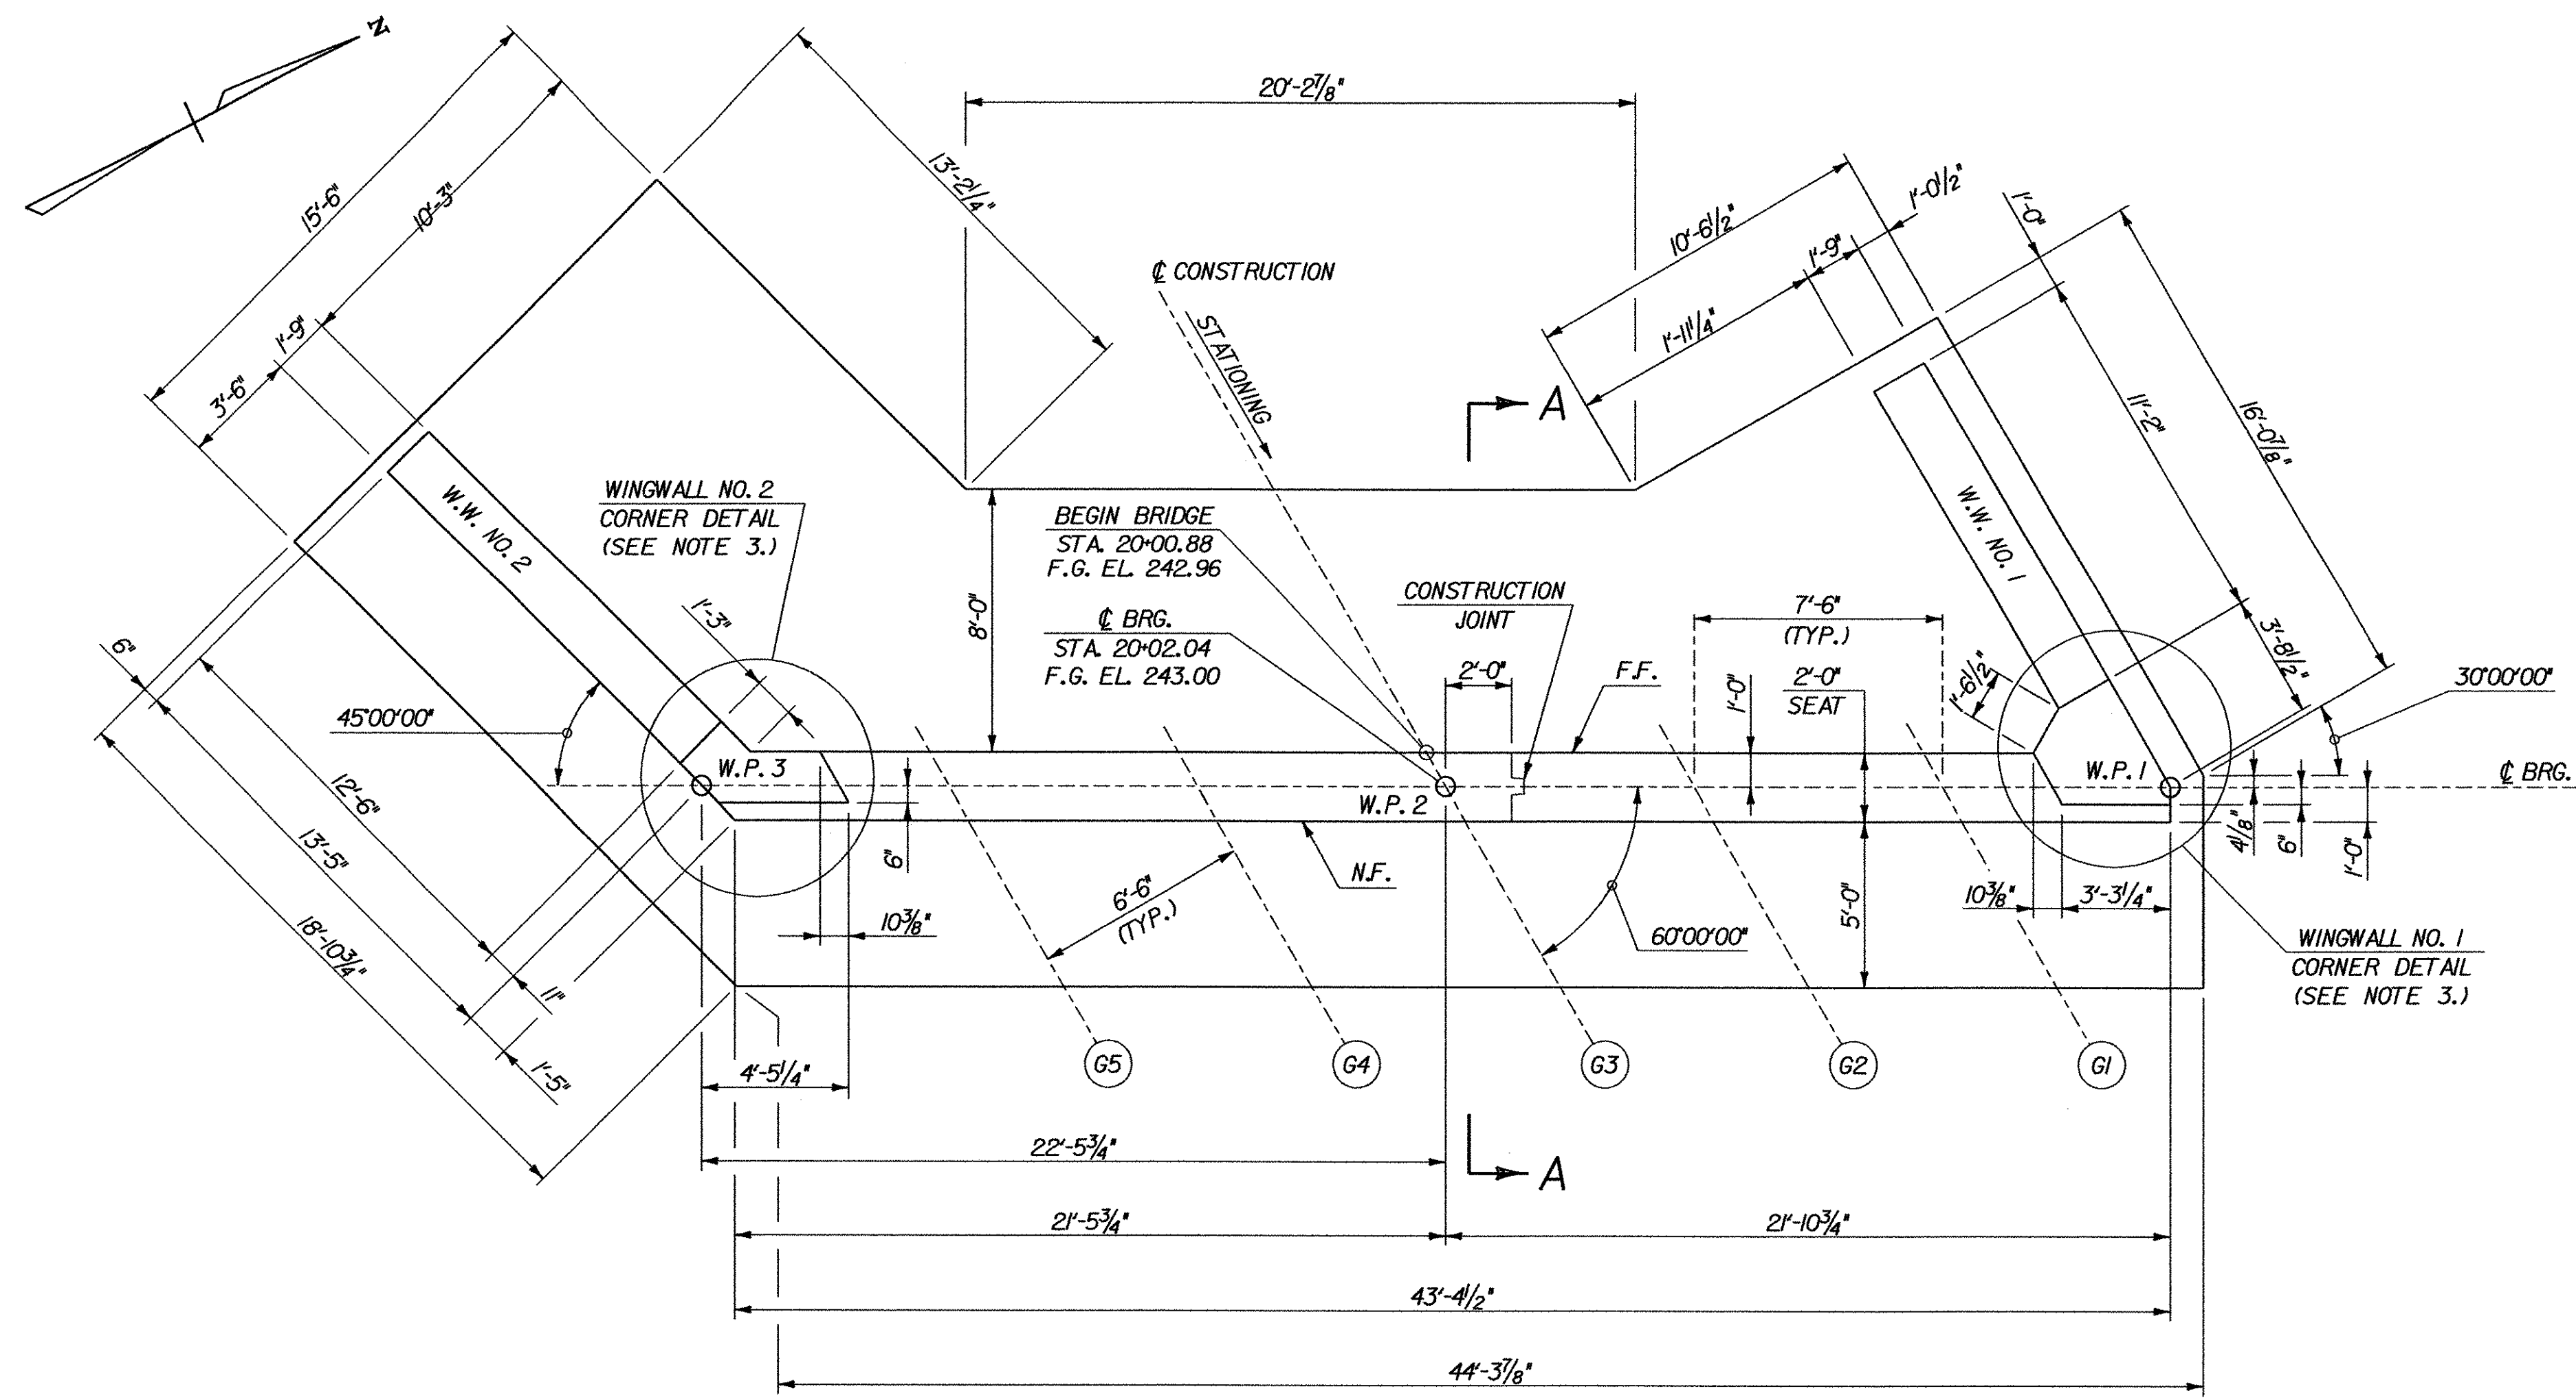

WORKING POINTS		
LOCATION	NORTHING	EASTING
W.P. 1	79605.5322	43981.2174
W.P. 2	79585.9275	43971.4687
W.P. 3	79565.7961	43961.4580

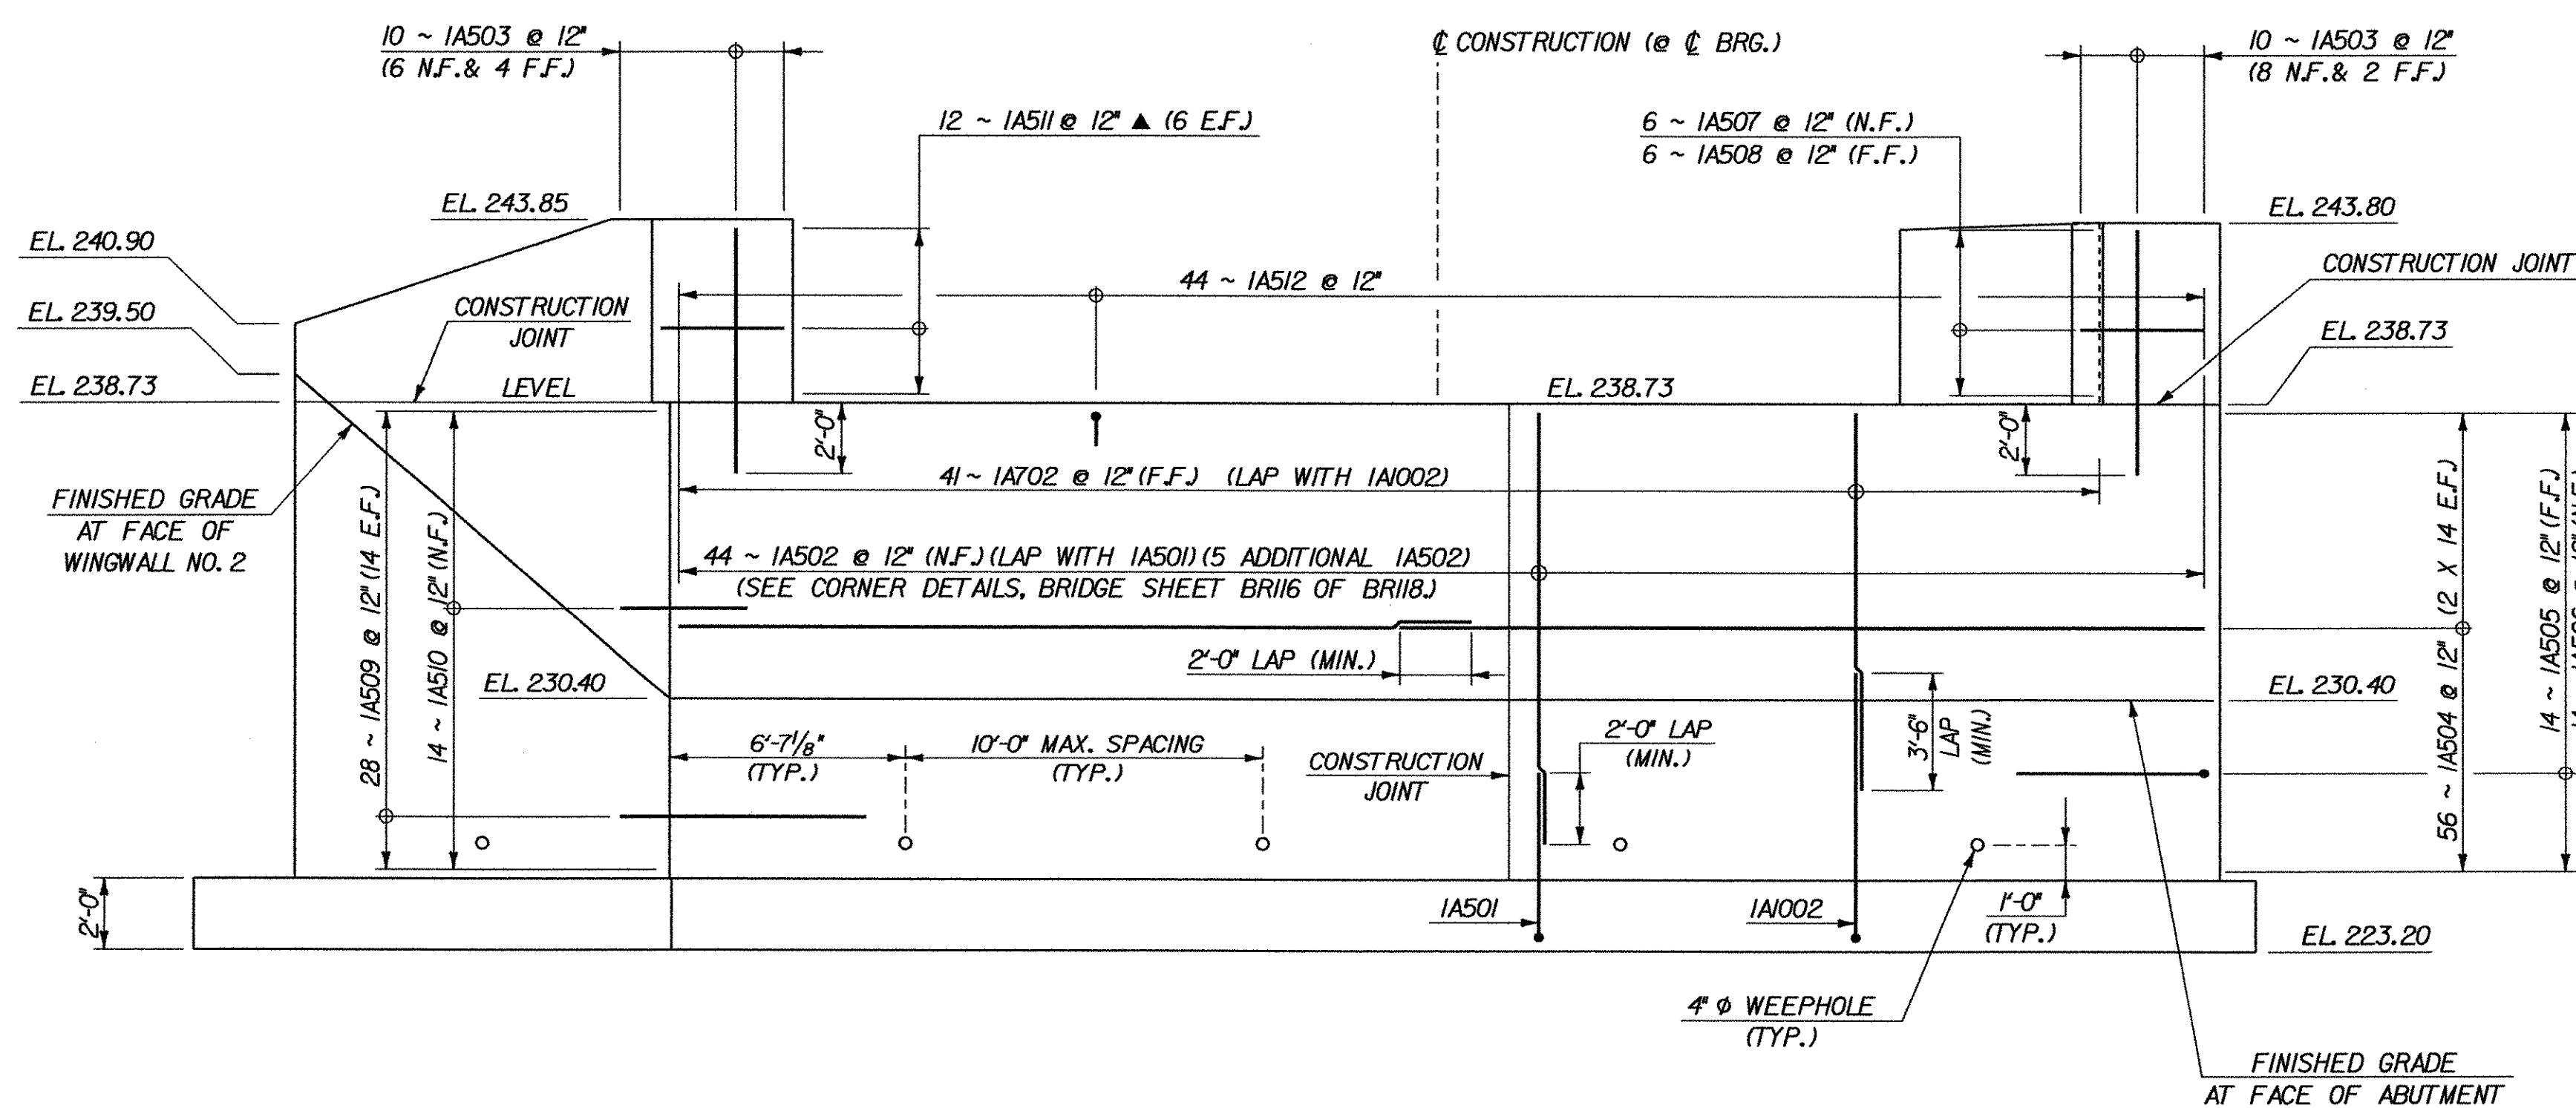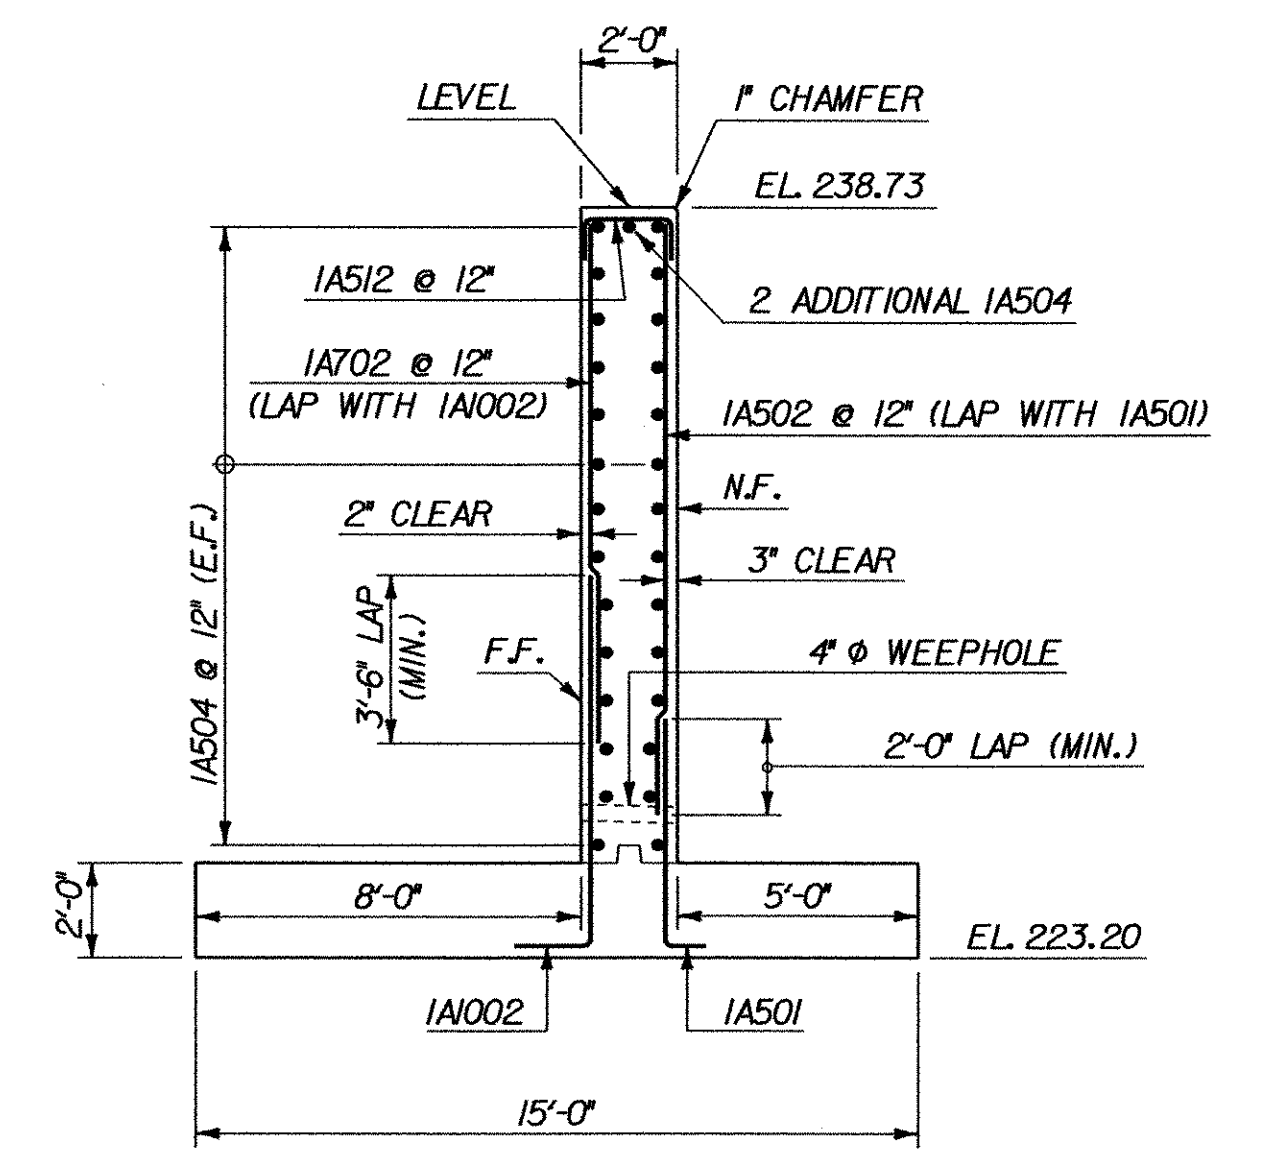

- NOTES**
- FOR FOOTING DETAILS, SEE BRIDGE SHEET BRI13A.
 - FOR WINGWALL DETAILS, SEE BRIDGE SHEET BRI17B.
 - FOR WINGWALL CORNER DETAILS, SEE BRIDGE SHEET BRI18B.

LEGEND

- N.F. = NEAR FACE
- F.F. = FAR FACE
- E.F. = EACH FACE
- ▲ = CUT TO FIT IN FIELD


- ▲ REVISE THE BEARING SEAT ELEVATION
- ▲ WINGWALL NO. 1 LAYOUT REVISED

**STATE OF VERMONT
AGENCY OF TRANSPORTATION**


Town Of	SHELBURNE	Bridge No.	15
Highway No.	TH 3	Log Sta.	
		Surv. Sta.	
BOSTWICK ROAD OVER VERMONT RAILWAY			
ABUTMENT NO. 1 (REVISED)			
Designed By	L. WIXSON / S. DELIA	Drawn By	S. MERKMAN / S. DELIA
Checked By	R. JOY	Bridge Design Supervisor	M. ZYDEL
Date	03/04	Date	03/04
PROJECT	SHELBURNE	PROJECT NO.	BRO 1445(30)
I.G.C. Info. G:\Structures\STR3_Roger Whitcomb\Consultants\McFarland-Johnson\Shelburne			
Bridge Sheet No.	BRI12A	Sheet	52A of 73




PLOTTED 24-MAR-2004

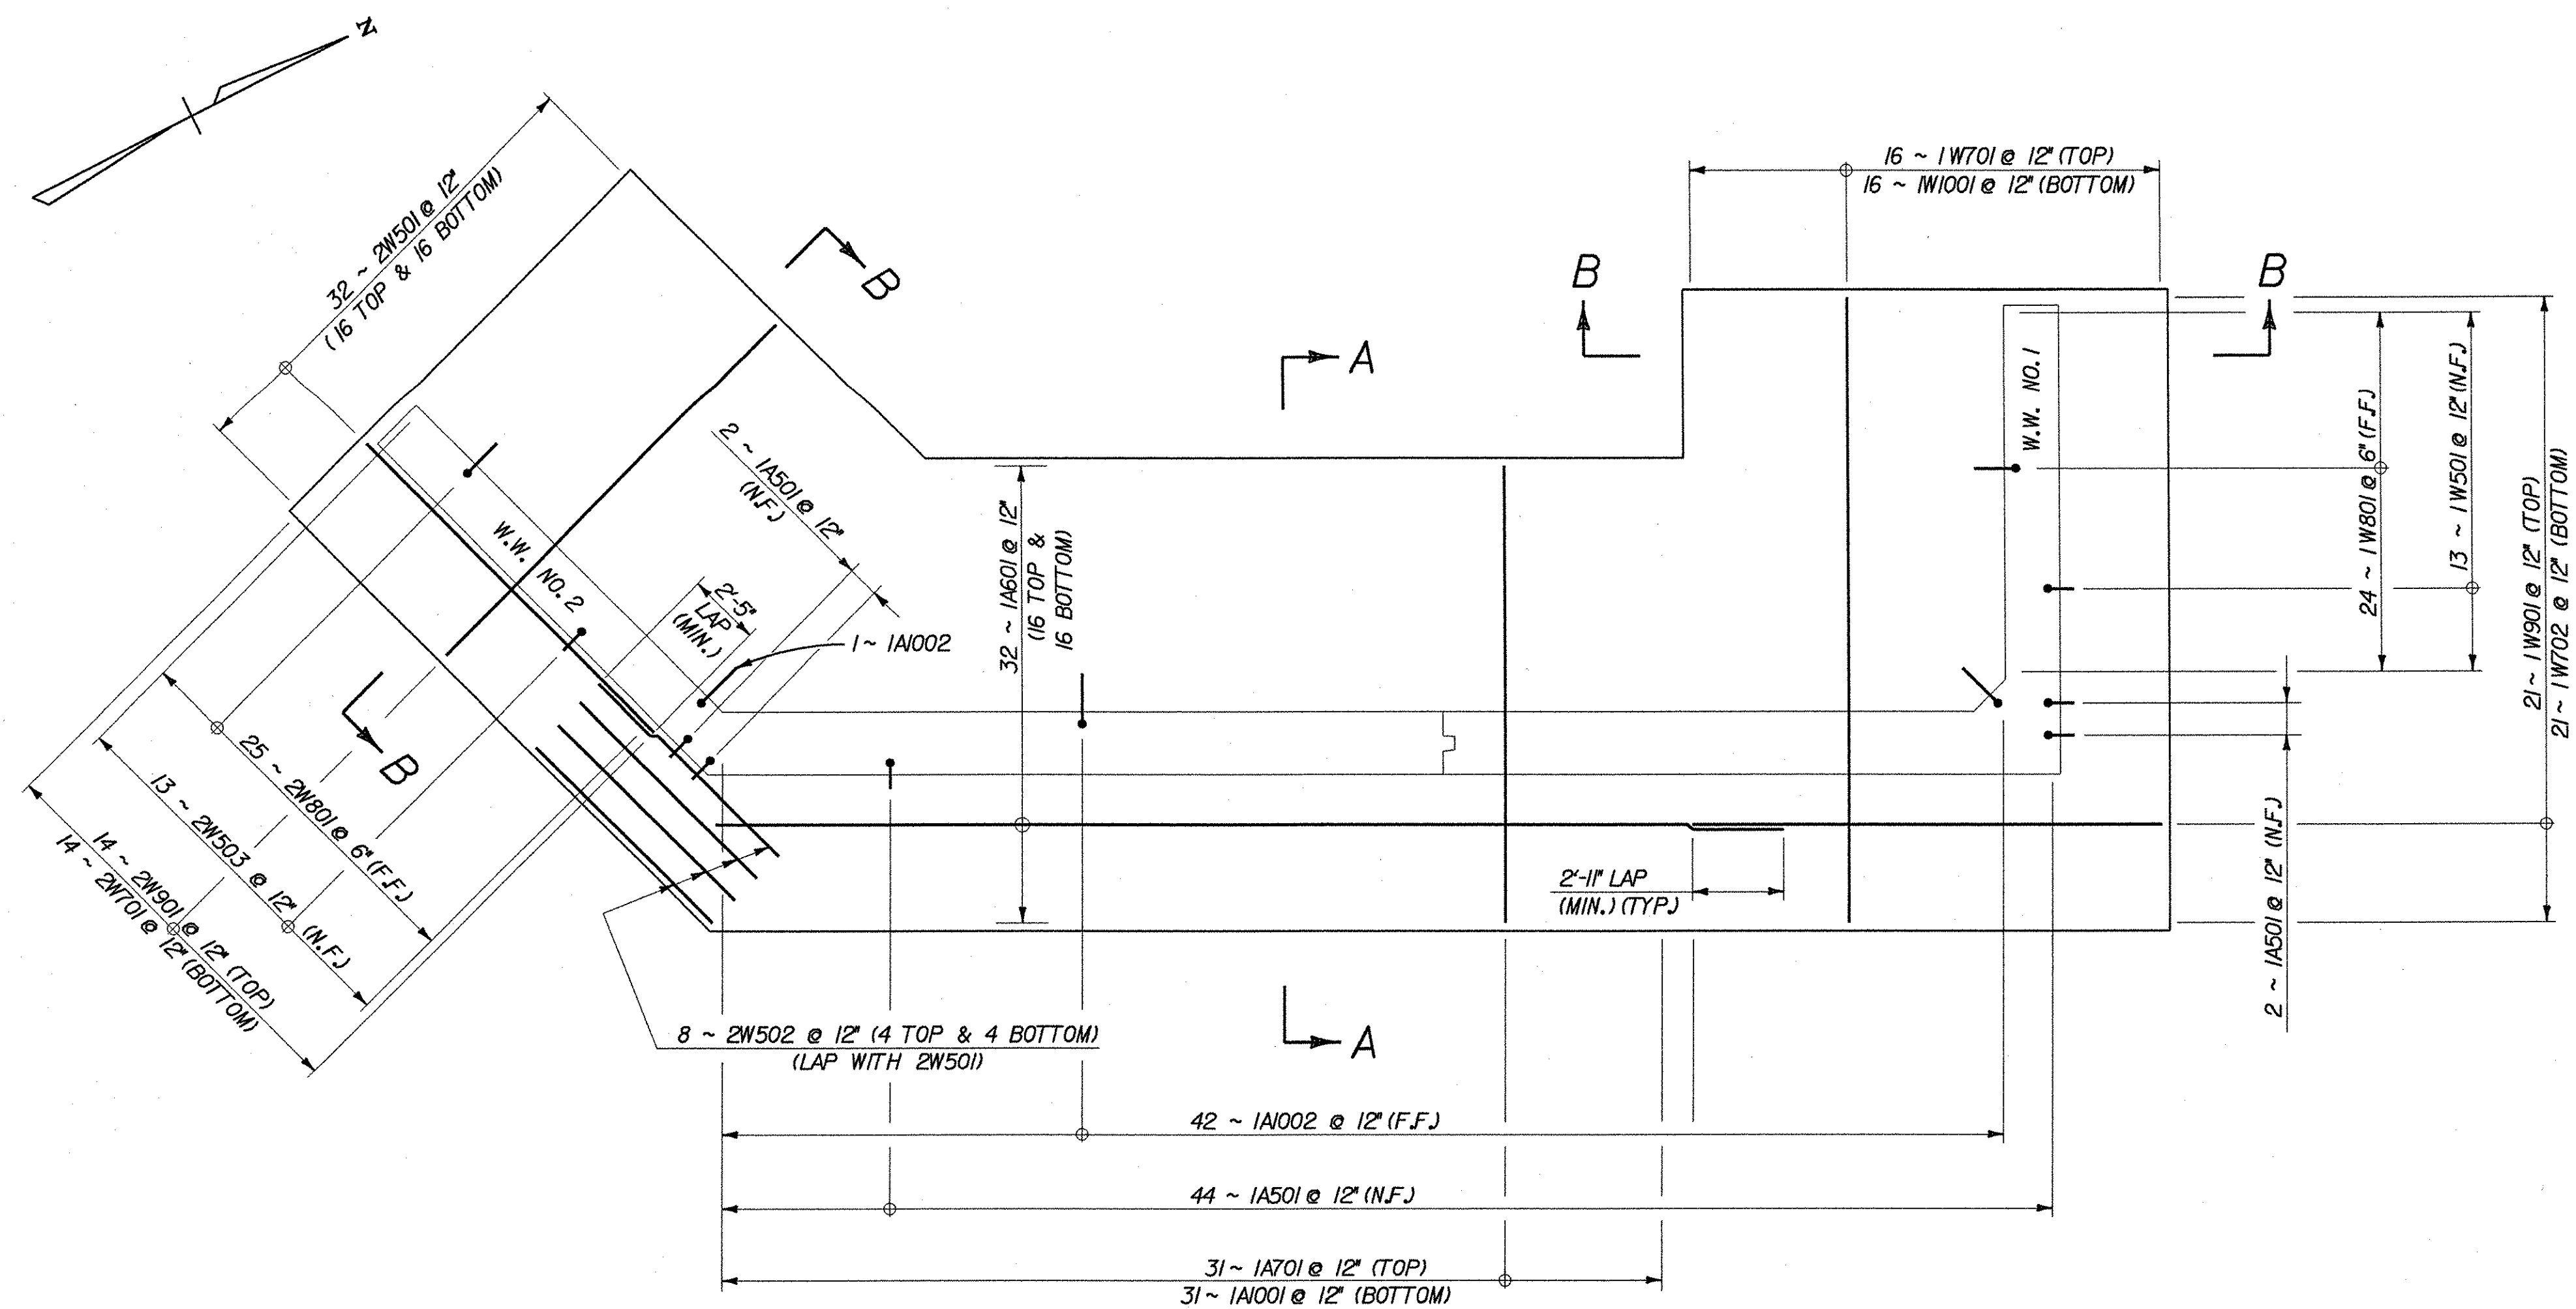

PLAN (REINFORCING)
SCALE: 1/4" = 1'-0"

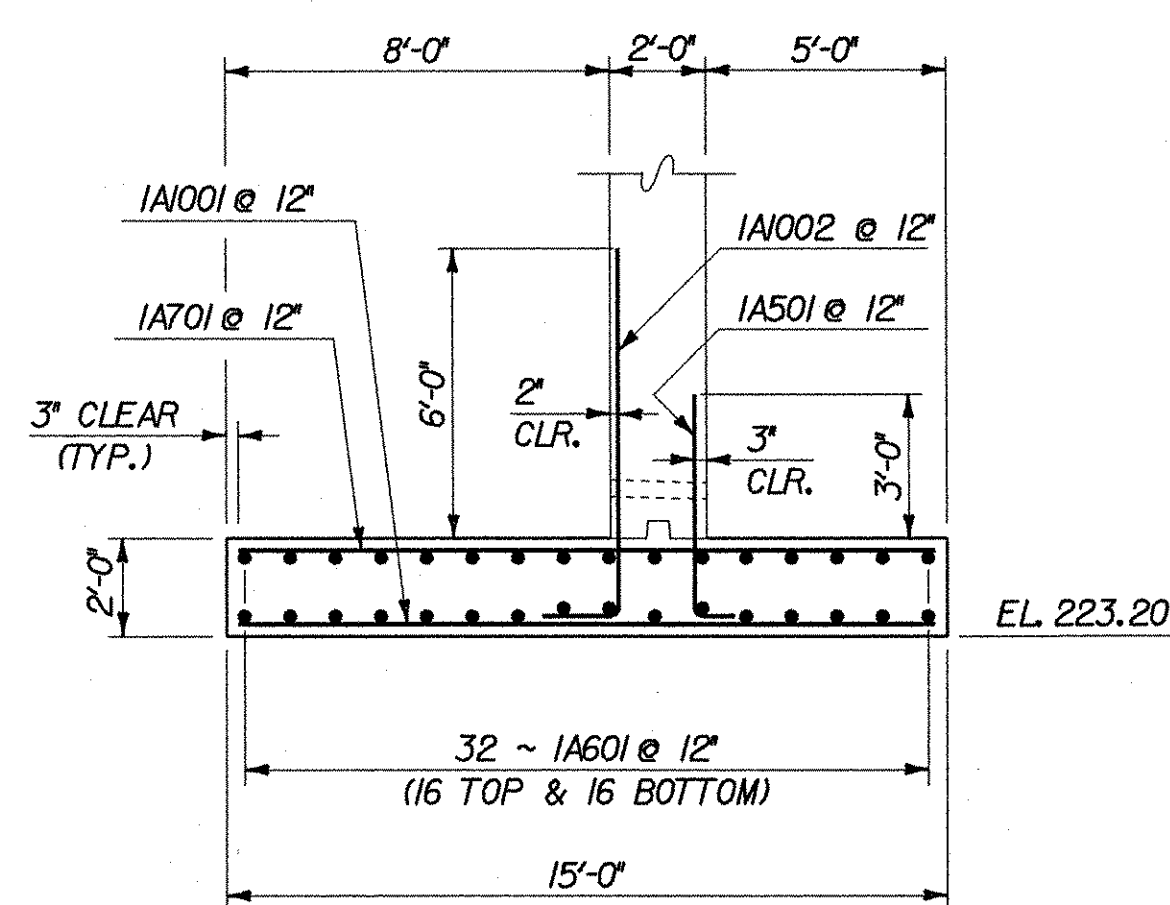

SECTION A-A
SCALE: 1/4" = 1'-0"

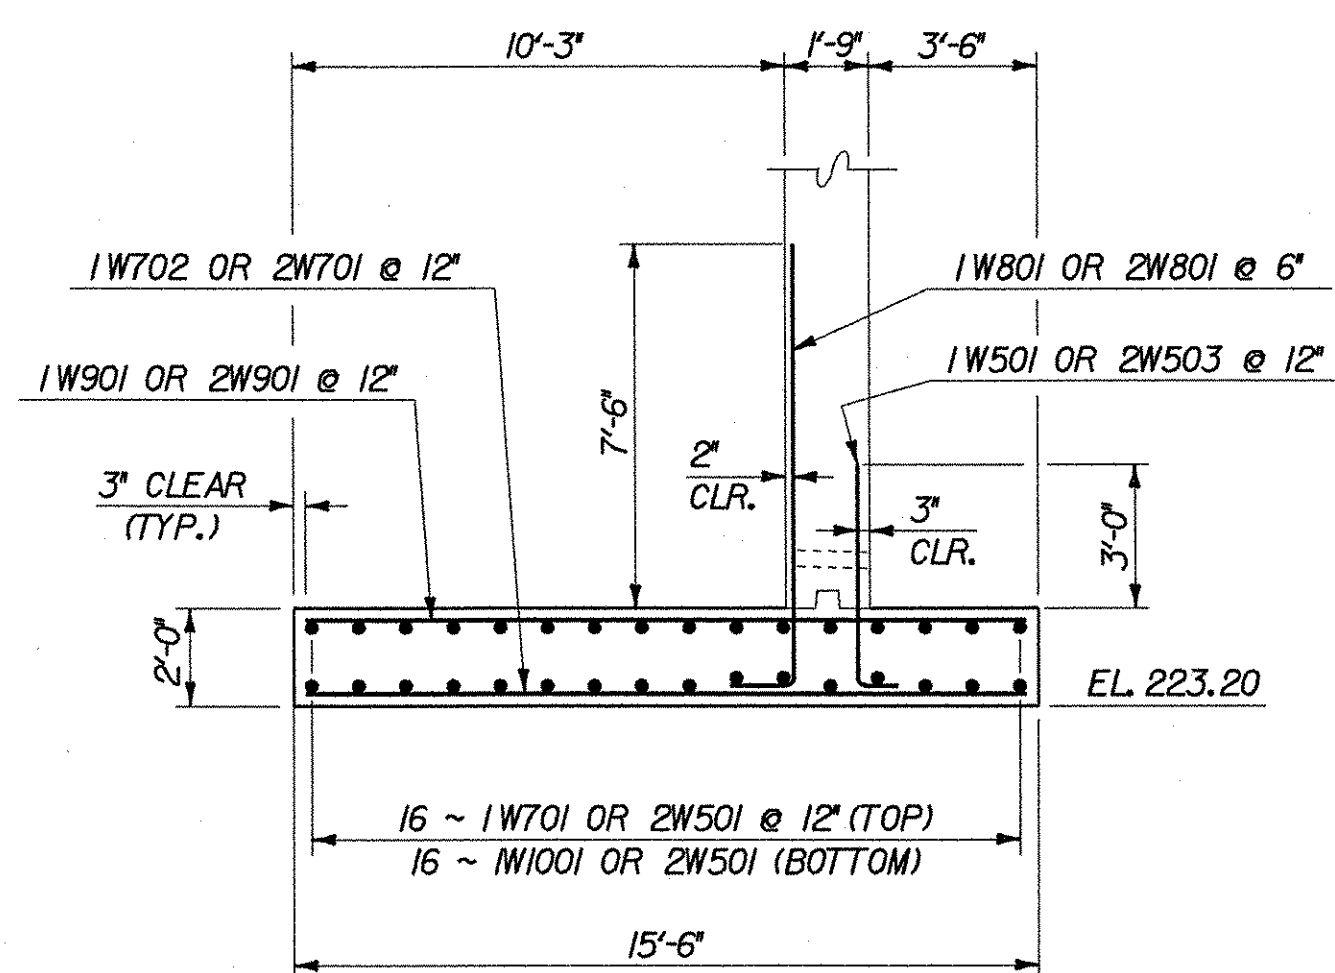

SECTION B-B
SCALE: 1/4" = 1'-0"

NOTES


1. MINIMUM COVER FOR REINFORCING STEEL IN FOOTING SHALL BE 3".

LEGEND


- N.F. = NEAR FACE
- F.F. = FAR FACE
- E.F. = EACH FACE
- ▲ = CUT TO FIT IN FIELD

STATE OF VERMONT AGENCY OF TRANSPORTATION	
Town Of SHELBURNE	Bridge No. 15
Highway No. TH 3	Log Sta. Surv. Sta.
BOSTWICK ROAD OVER VERMONT RAILWAY ABUTMENT NO. 1 FOOTING	
Designed By L. WIXSON	Drawn By S. MERKMAN
Checked By R. JOY	Bridge Design Supervisor
Date 05/03	Date 05/03
PROJECT SHELBURNE	PROJECT NO. BRO 1445(30)
I.C.C. Info. MN595402 Bostwick\BRIDGE\mjt\ar\z\196alf.dgn	
Bridge Sheet No. BRI/3	Sheet 53 of 73




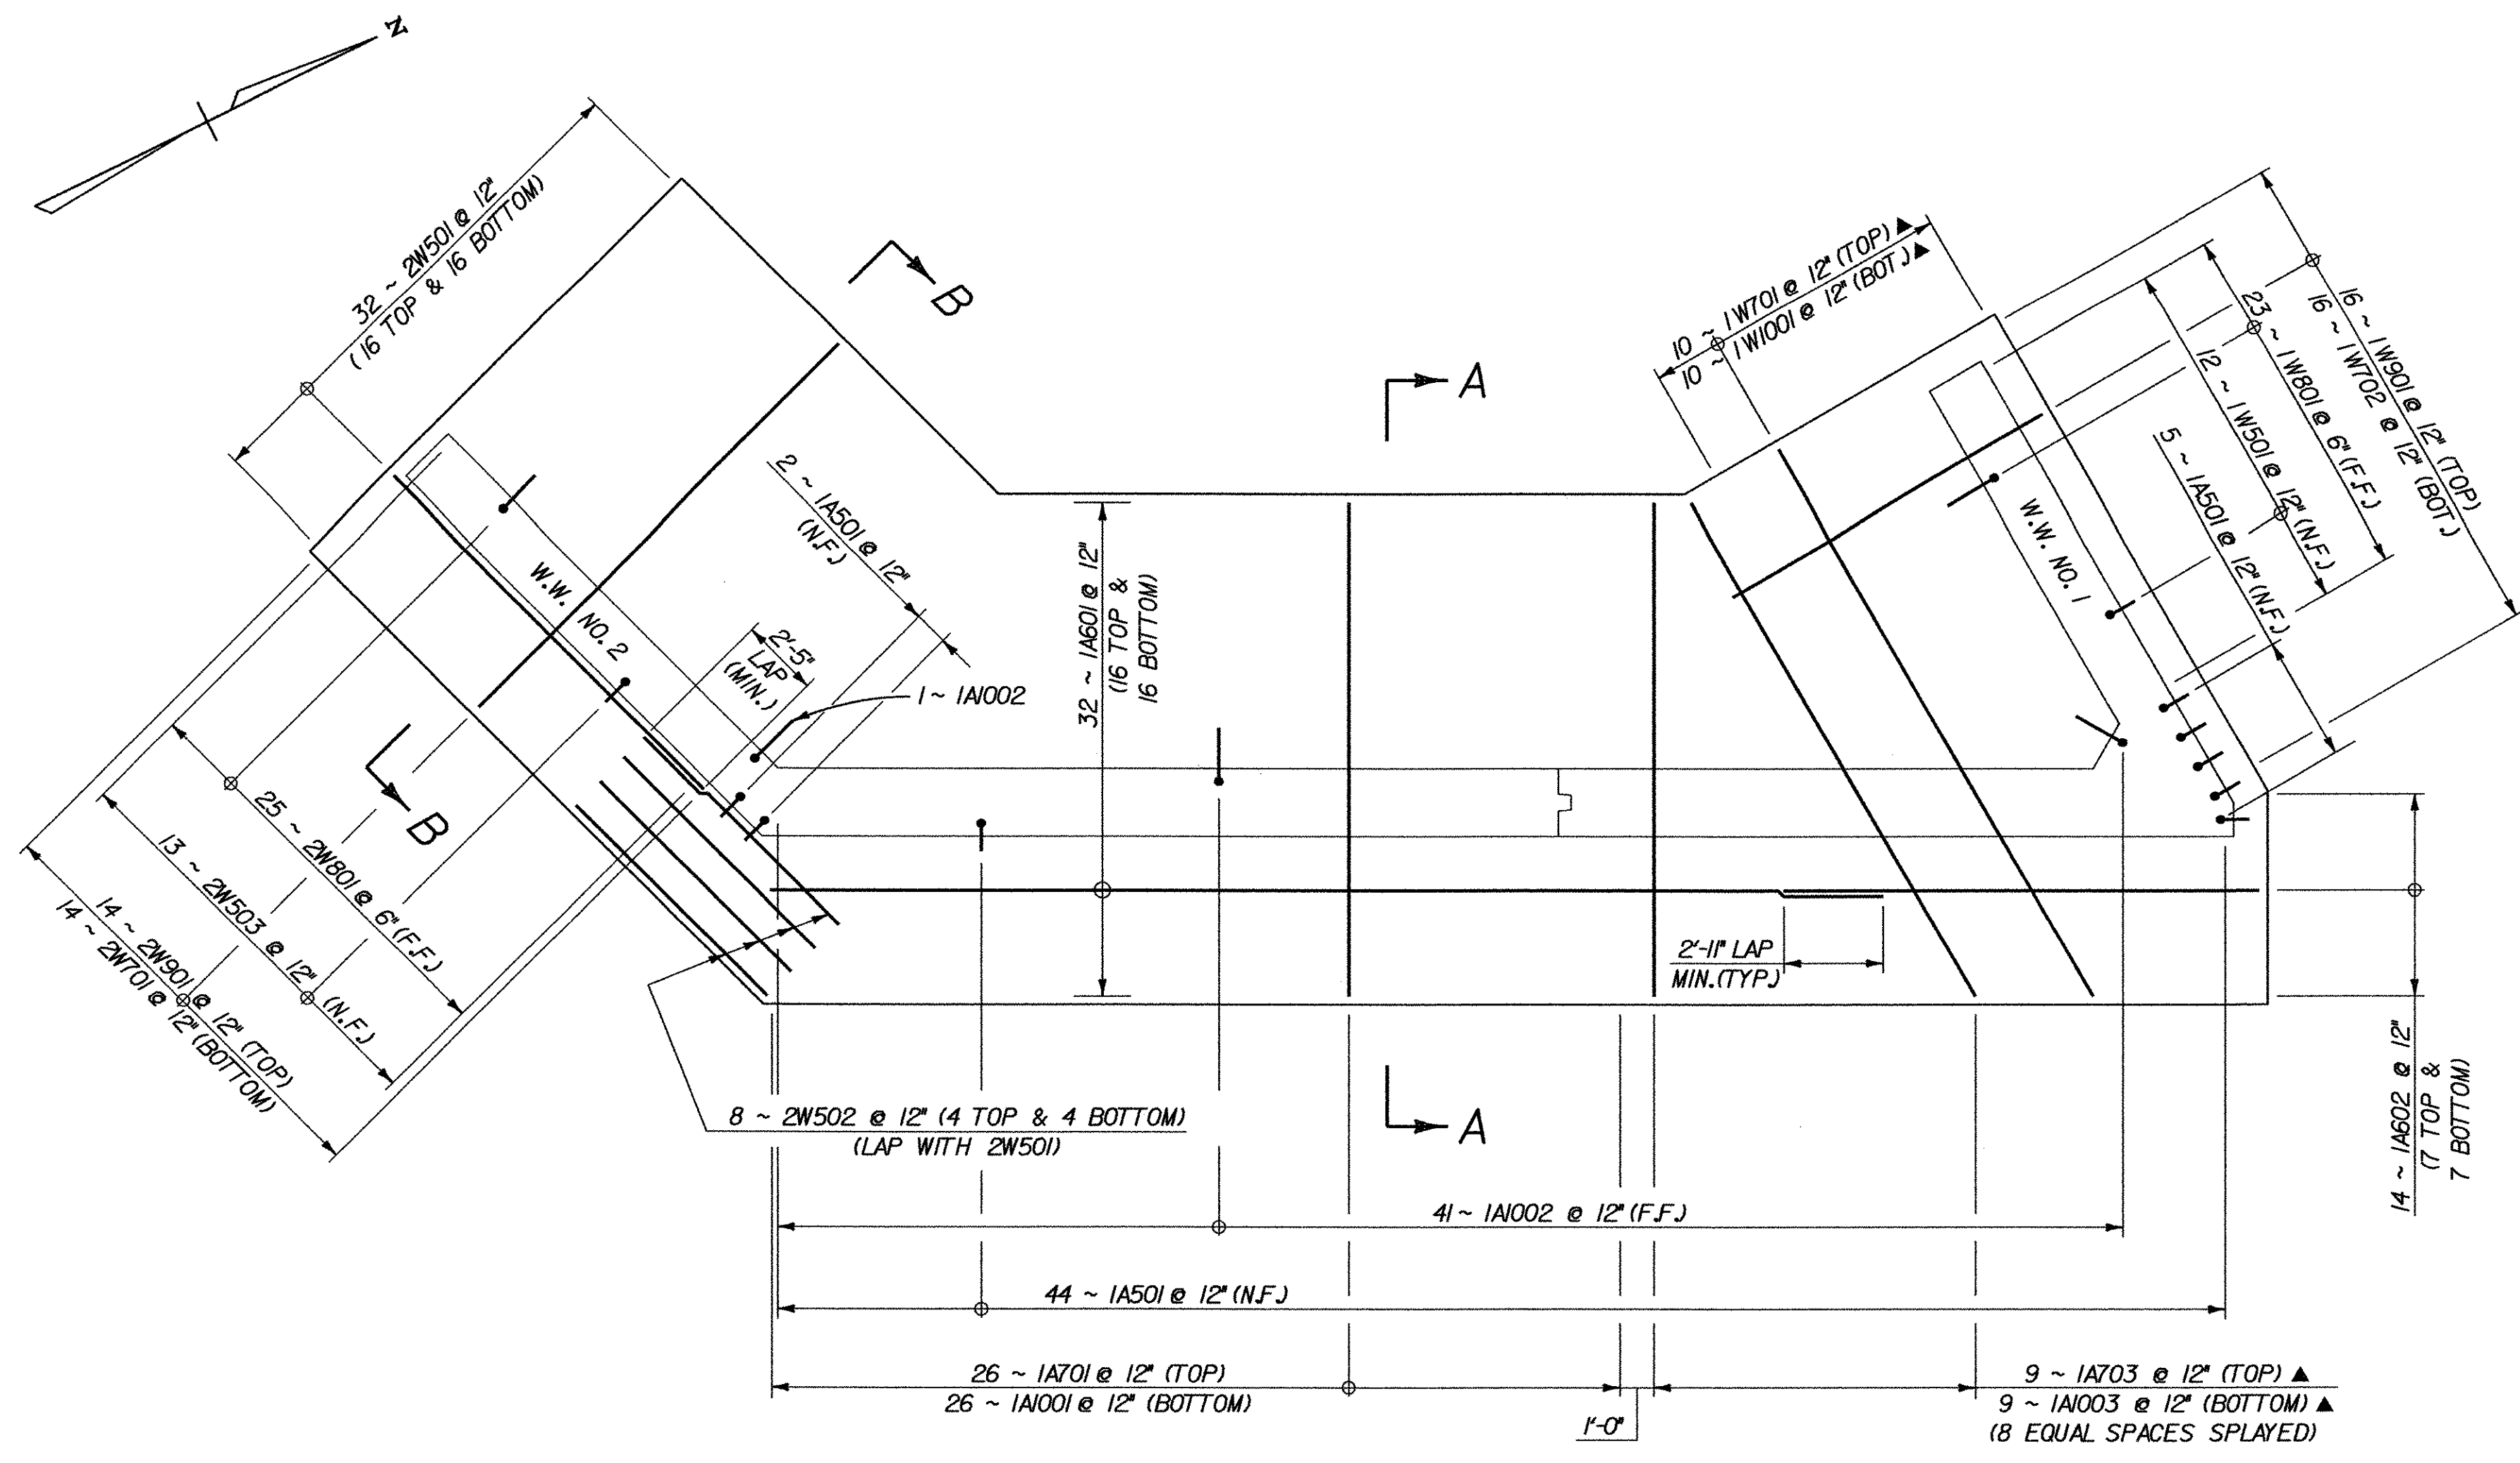

PLAN (REINFORCING)
SCALE: 1/4" = 1'-0"

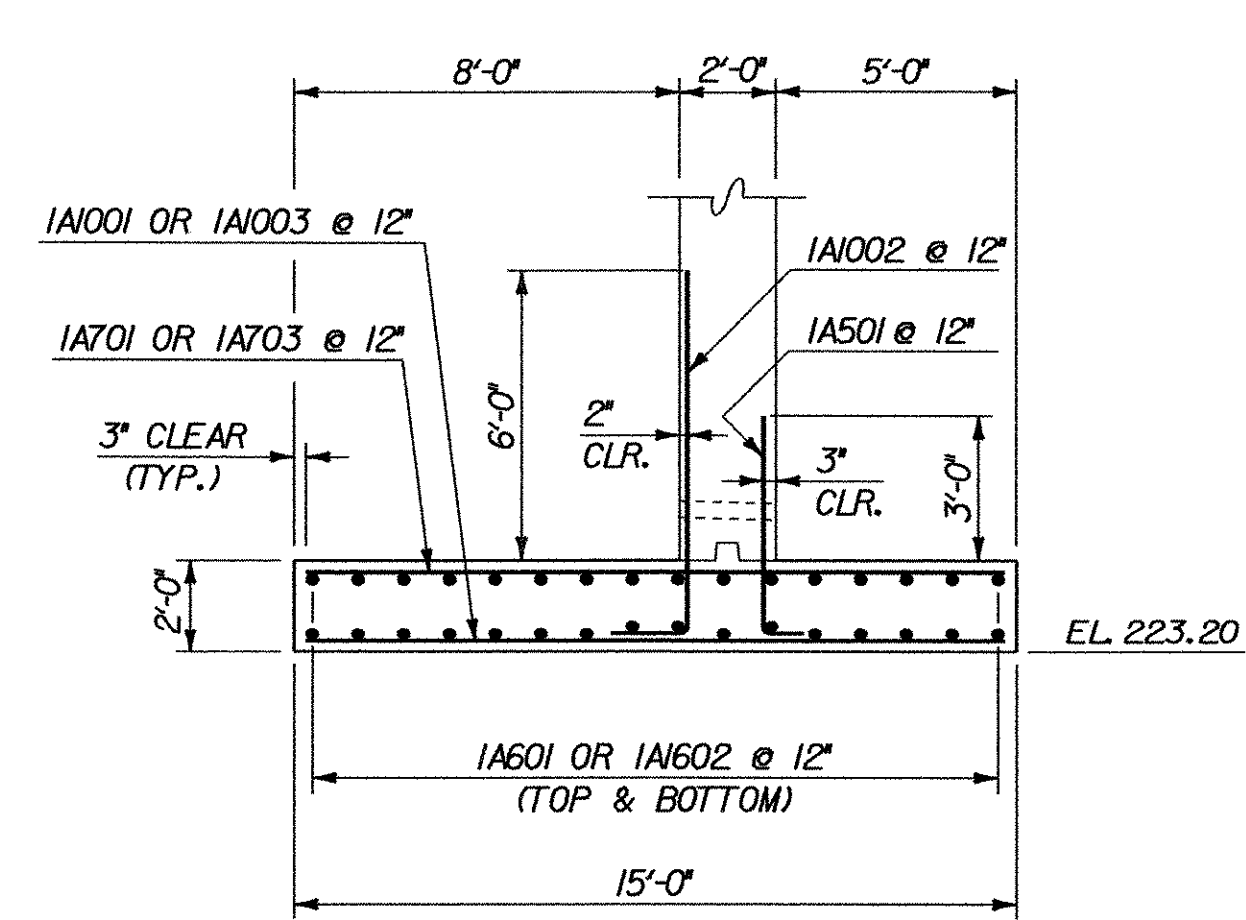

SECTION A-A
SCALE: 1/4" = 1'-0"

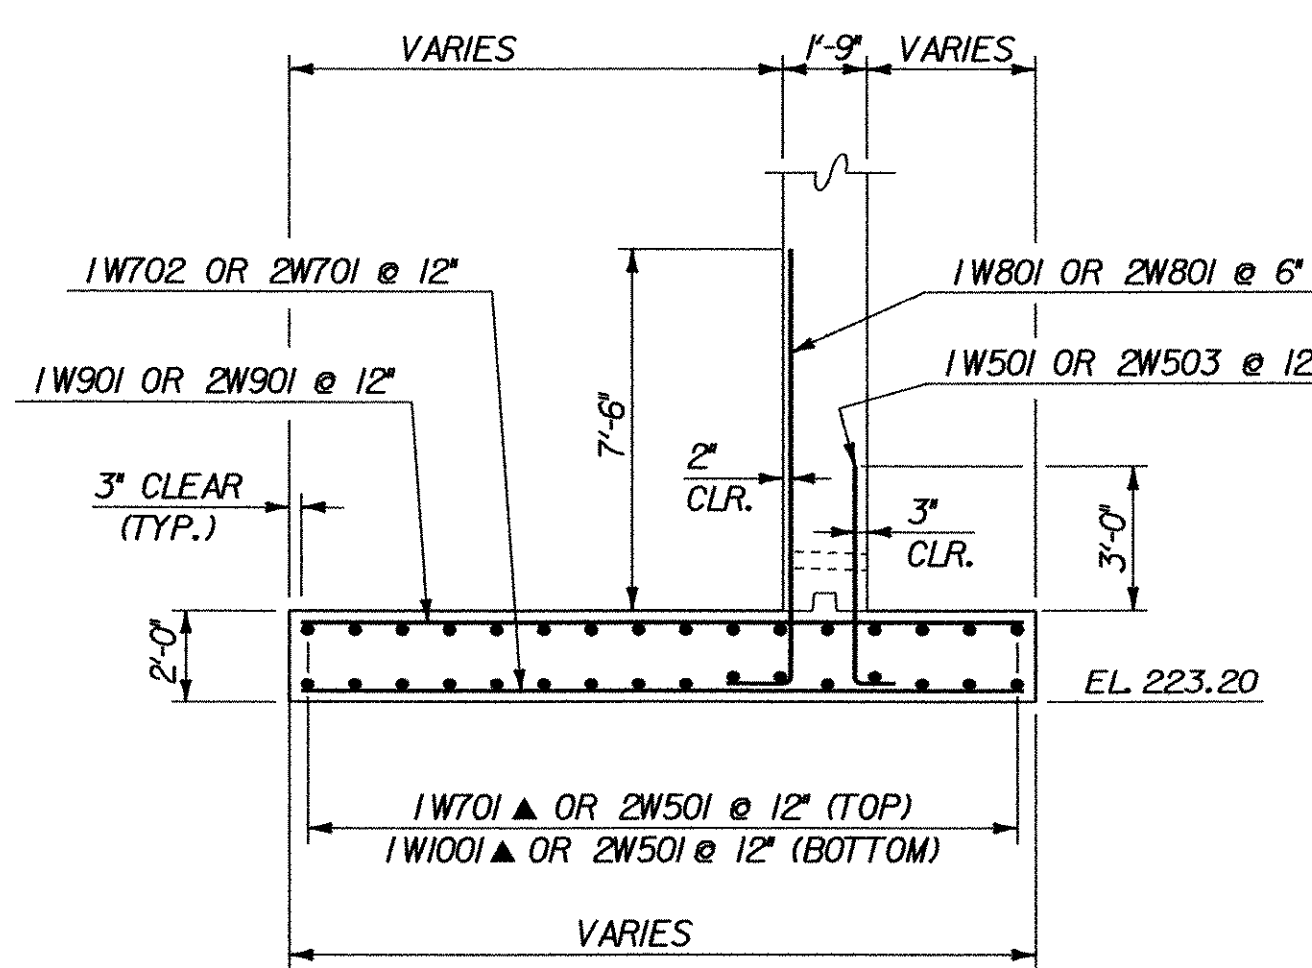

SECTION B-B
SCALE: 1/4" = 1'-0"

NOTES

1. MINIMUM COVER FOR REINFORCING STEEL IN FOOTING SHALL BE 3".

LEGEND

- N.F. = NEAR FACE
- F.F. = FAR FACE
- E.F. = EACH FACE
- ▲ = CUT TO FIT IN FIELD

△ WINGWALL NO. 1 LAYOUT REVISED

**STATE OF VERMONT
AGENCY OF TRANSPORTATION**

Town Of **SHELBURNE** Bridge No. **15**
Highway No. **TH 3** Log Sta. _____
Surv. Sta. _____

**BOSTWICK ROAD OVER VERMONT RAILWAY
ABUTMENT NO. 1 FOOTING (REVISED)**

Designed By **L.WIXSON / S.DELIA** Drawn By **S.MERKMAN / S.DELIA**
Checked By **R. JOY** Date **03/04** Bridge Design Supervisor **M. ZYDEL** Date **03/04**


PROJECT **SHELBURNE** PROJECT NO. **BRO 1445(30)**

L.G.C. Info. G:\Structures\STR3_Roger Whitcomb\Consultants\McFarland-Johnson\Shelburne
Bridge Sheet No. **BRI13A** Sheet **53A** of **73**




PLOTTED 24-MAR-2004

WORKING POINTS		
LOCATION	NORTHING	EASTING
W.P. 4	79571.4281	44051.3054
W.P. 5	79591.5147	44061.2936
W.P. 6	79611.6462	44071.3042

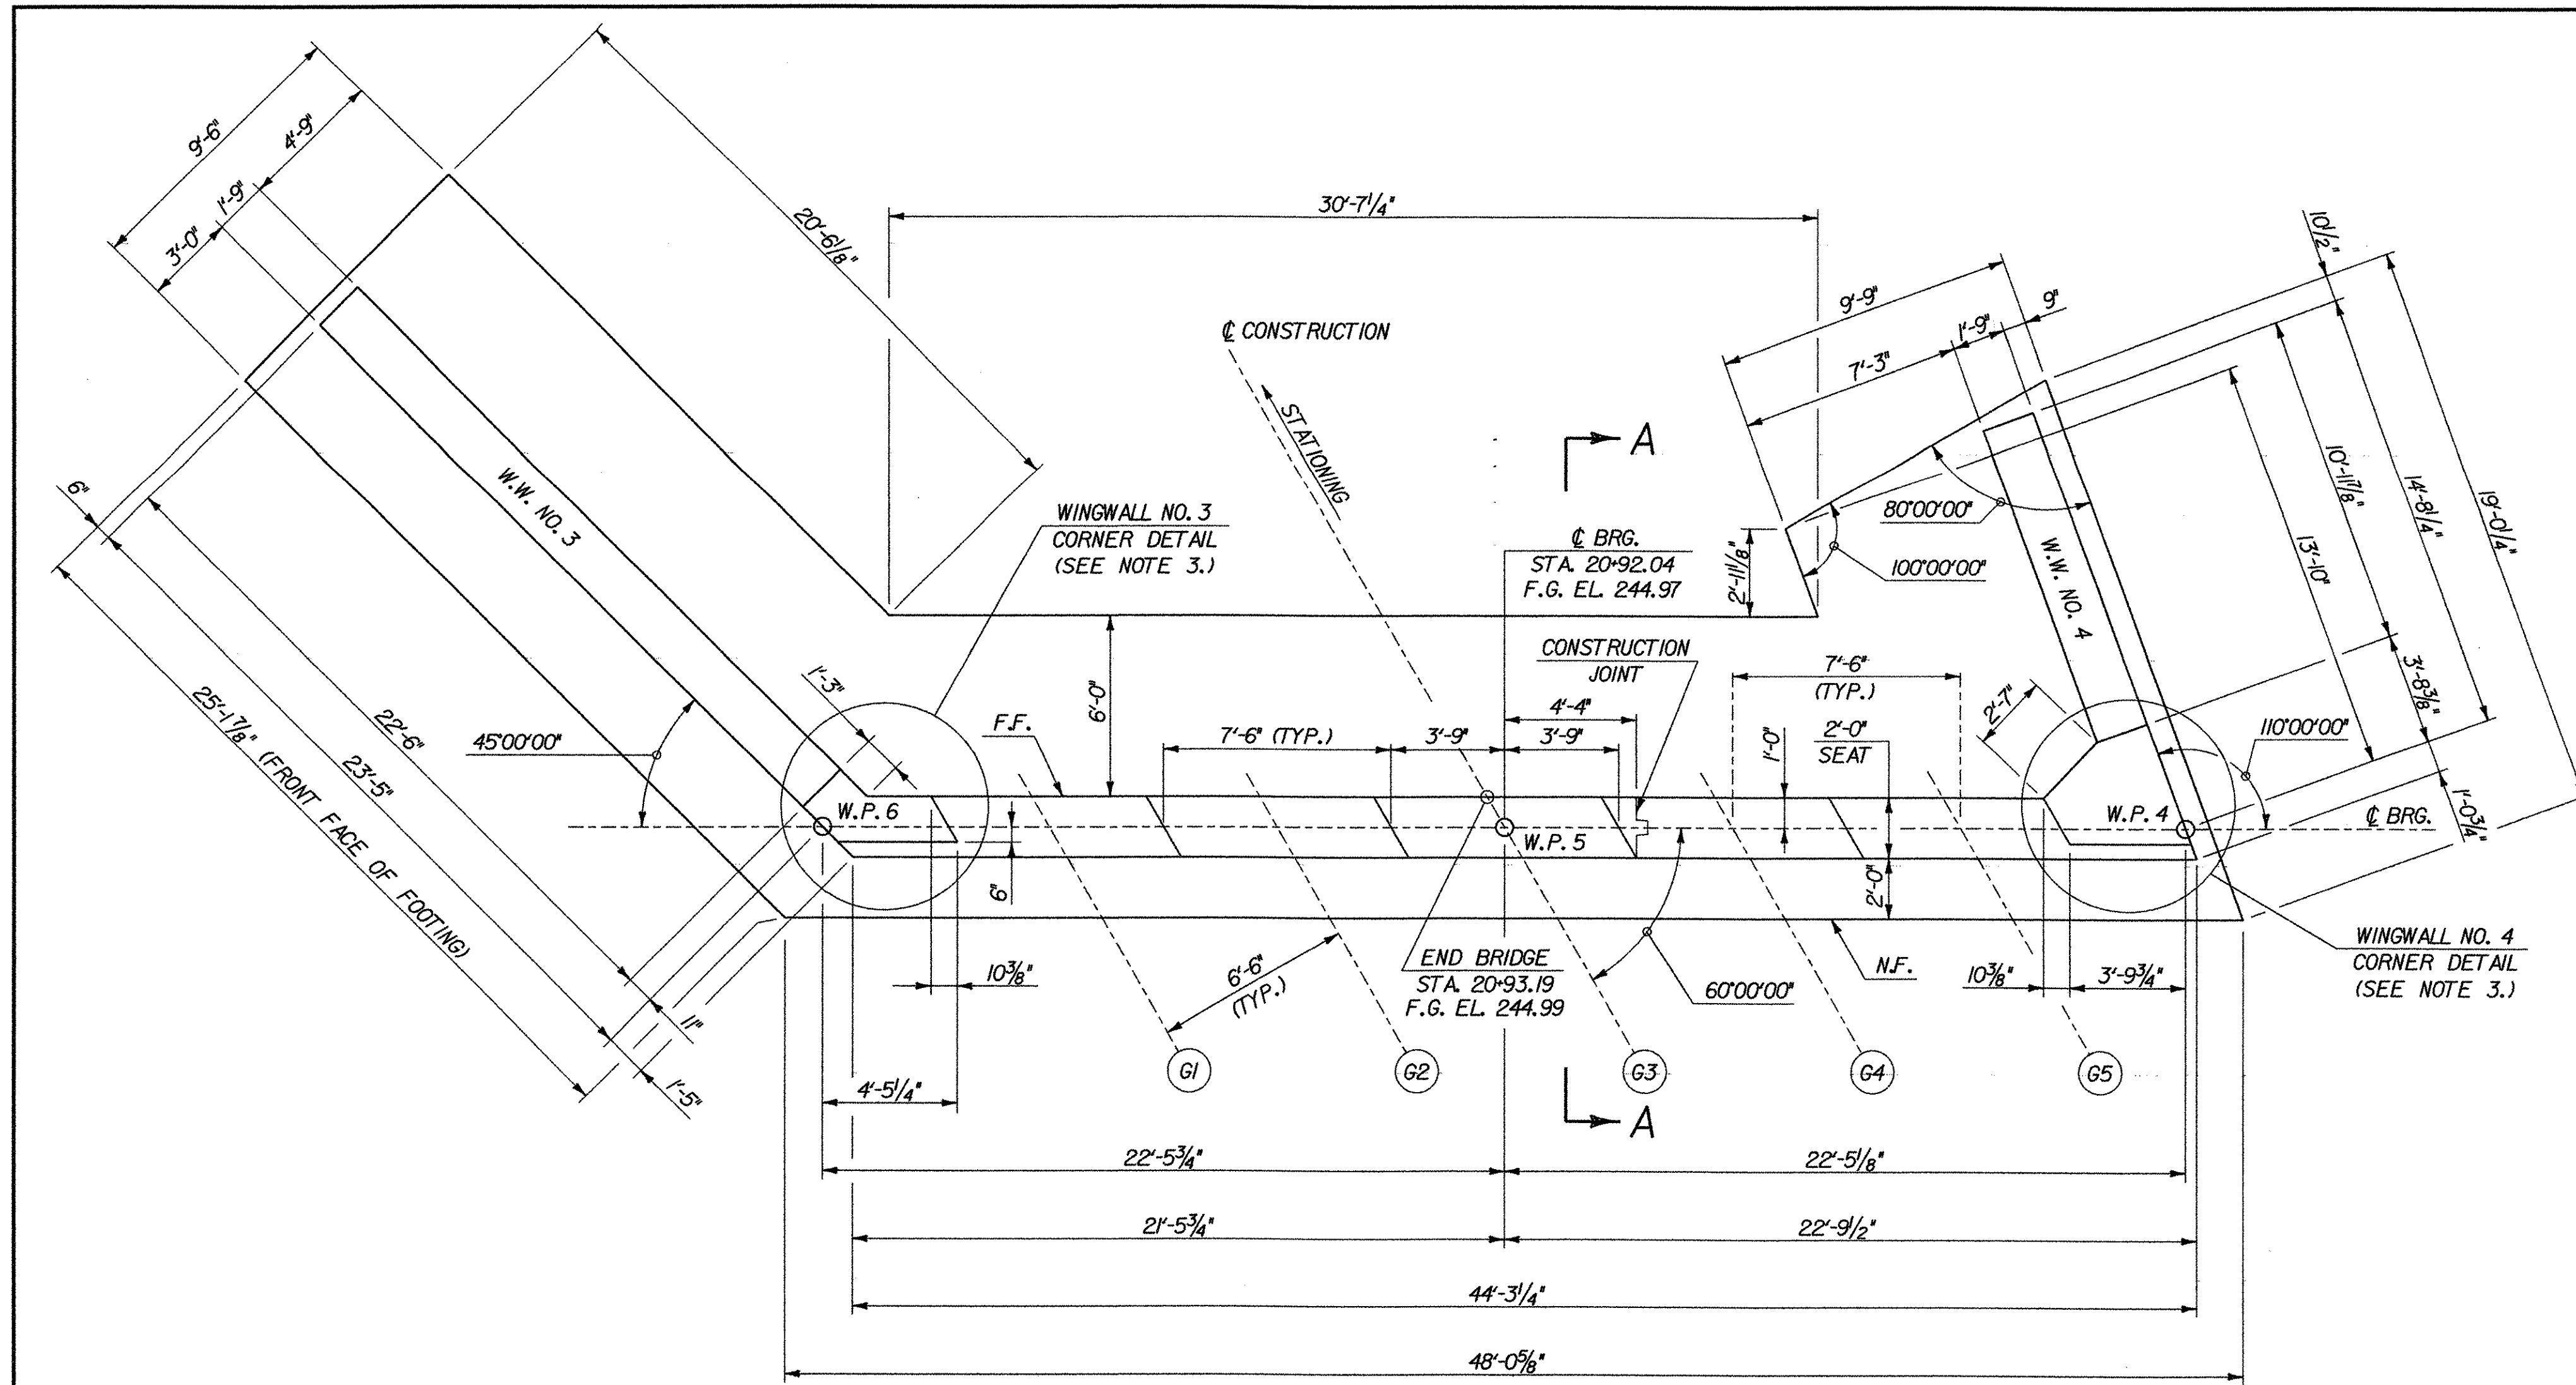

PLAN
SCALE: 1/4" = 1'-0"

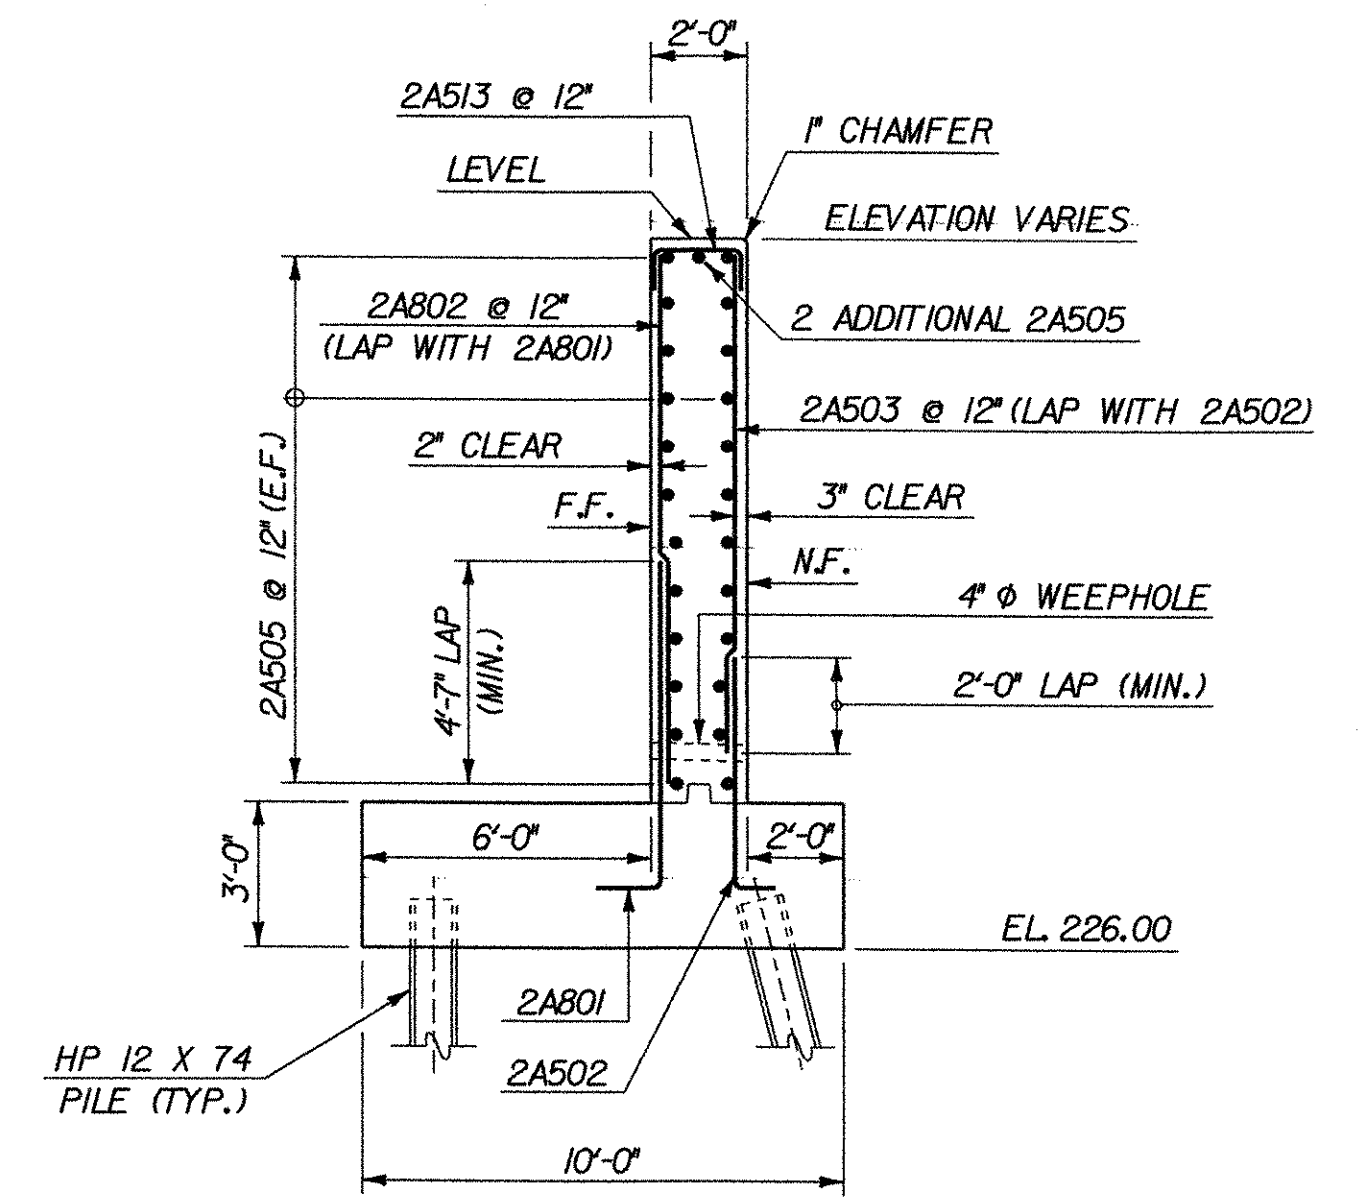


SECTION A-A
SCALE: 1/4" = 1'-0"

NOTES

- FOR FOOTING DETAILS, SEE BRIDGE SHEET BRI15A.
- FOR WINGWALL DETAILS, SEE BRIDGE SHEET BRI1A.
- FOR WINGWALL CORNER DETAILS, SEE BRIDGE SHEET BRI16A.

- ▲ REVISE THE BEARING SEAT STEPS TO FOLLOW THE SKEW OF THE BRIDGE (11/12/03)
- ▲ RELOCATE THE VERTICAL CONSTRUCTION JOINT (11/12/03)
- ▲ WINGWALL NO. 4 LAYOUT REVISED

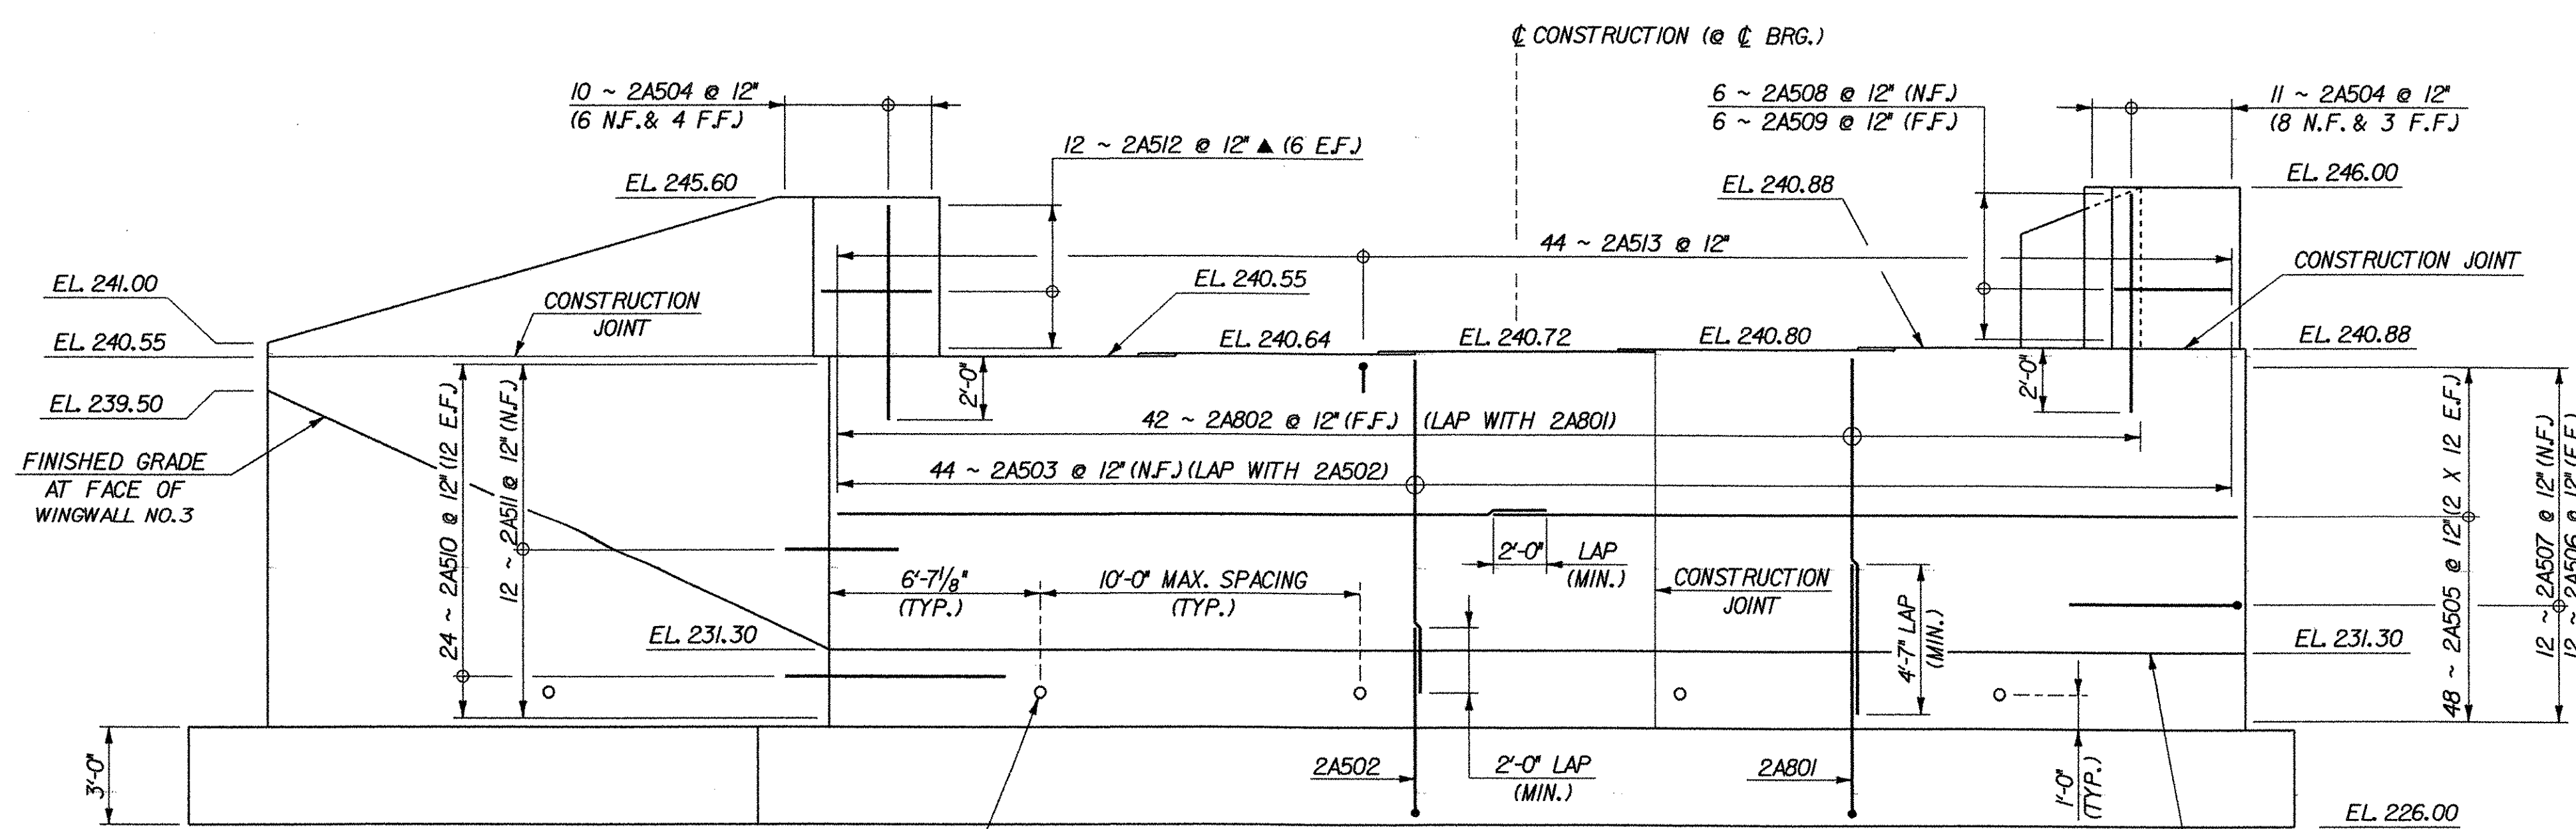

ELEVATION
SCALE: 1/4" = 1'-0"

LEGEND


- N.F. = NEAR FACE
- F.F. = FAR FACE
- E.F. = EACH FACE
- ▲ = CUT TO FIT IN FIELD




**STATE OF VERMONT
AGENCY OF TRANSPORTATION**

Town Of SHELBURNE	Bridge No. 15
Highway No. TH 3	Log Sta.
BOSTWICK ROAD OVER VERMONT RAILWAY	
ABUTMENT NO. 2 (REVISED)	
Designed By L. WIXSON	Drawn By S. MERKMAN
Checked By R. JOY Date 03/04	Bridge Design Supervisor M. ZYDEL Date 03/04
PROJECT SHELBURNE	PROJECT NO. BRO 1445(30)
I.G.C. Info. G:\Structures\STR3_Roger Whitcomb\Consultants\McFarland-Johnson\Shelburne	
Bridge Sheet No. BRI14A	Sheet 54A of 73


PLOTTED 15-MAR-2004

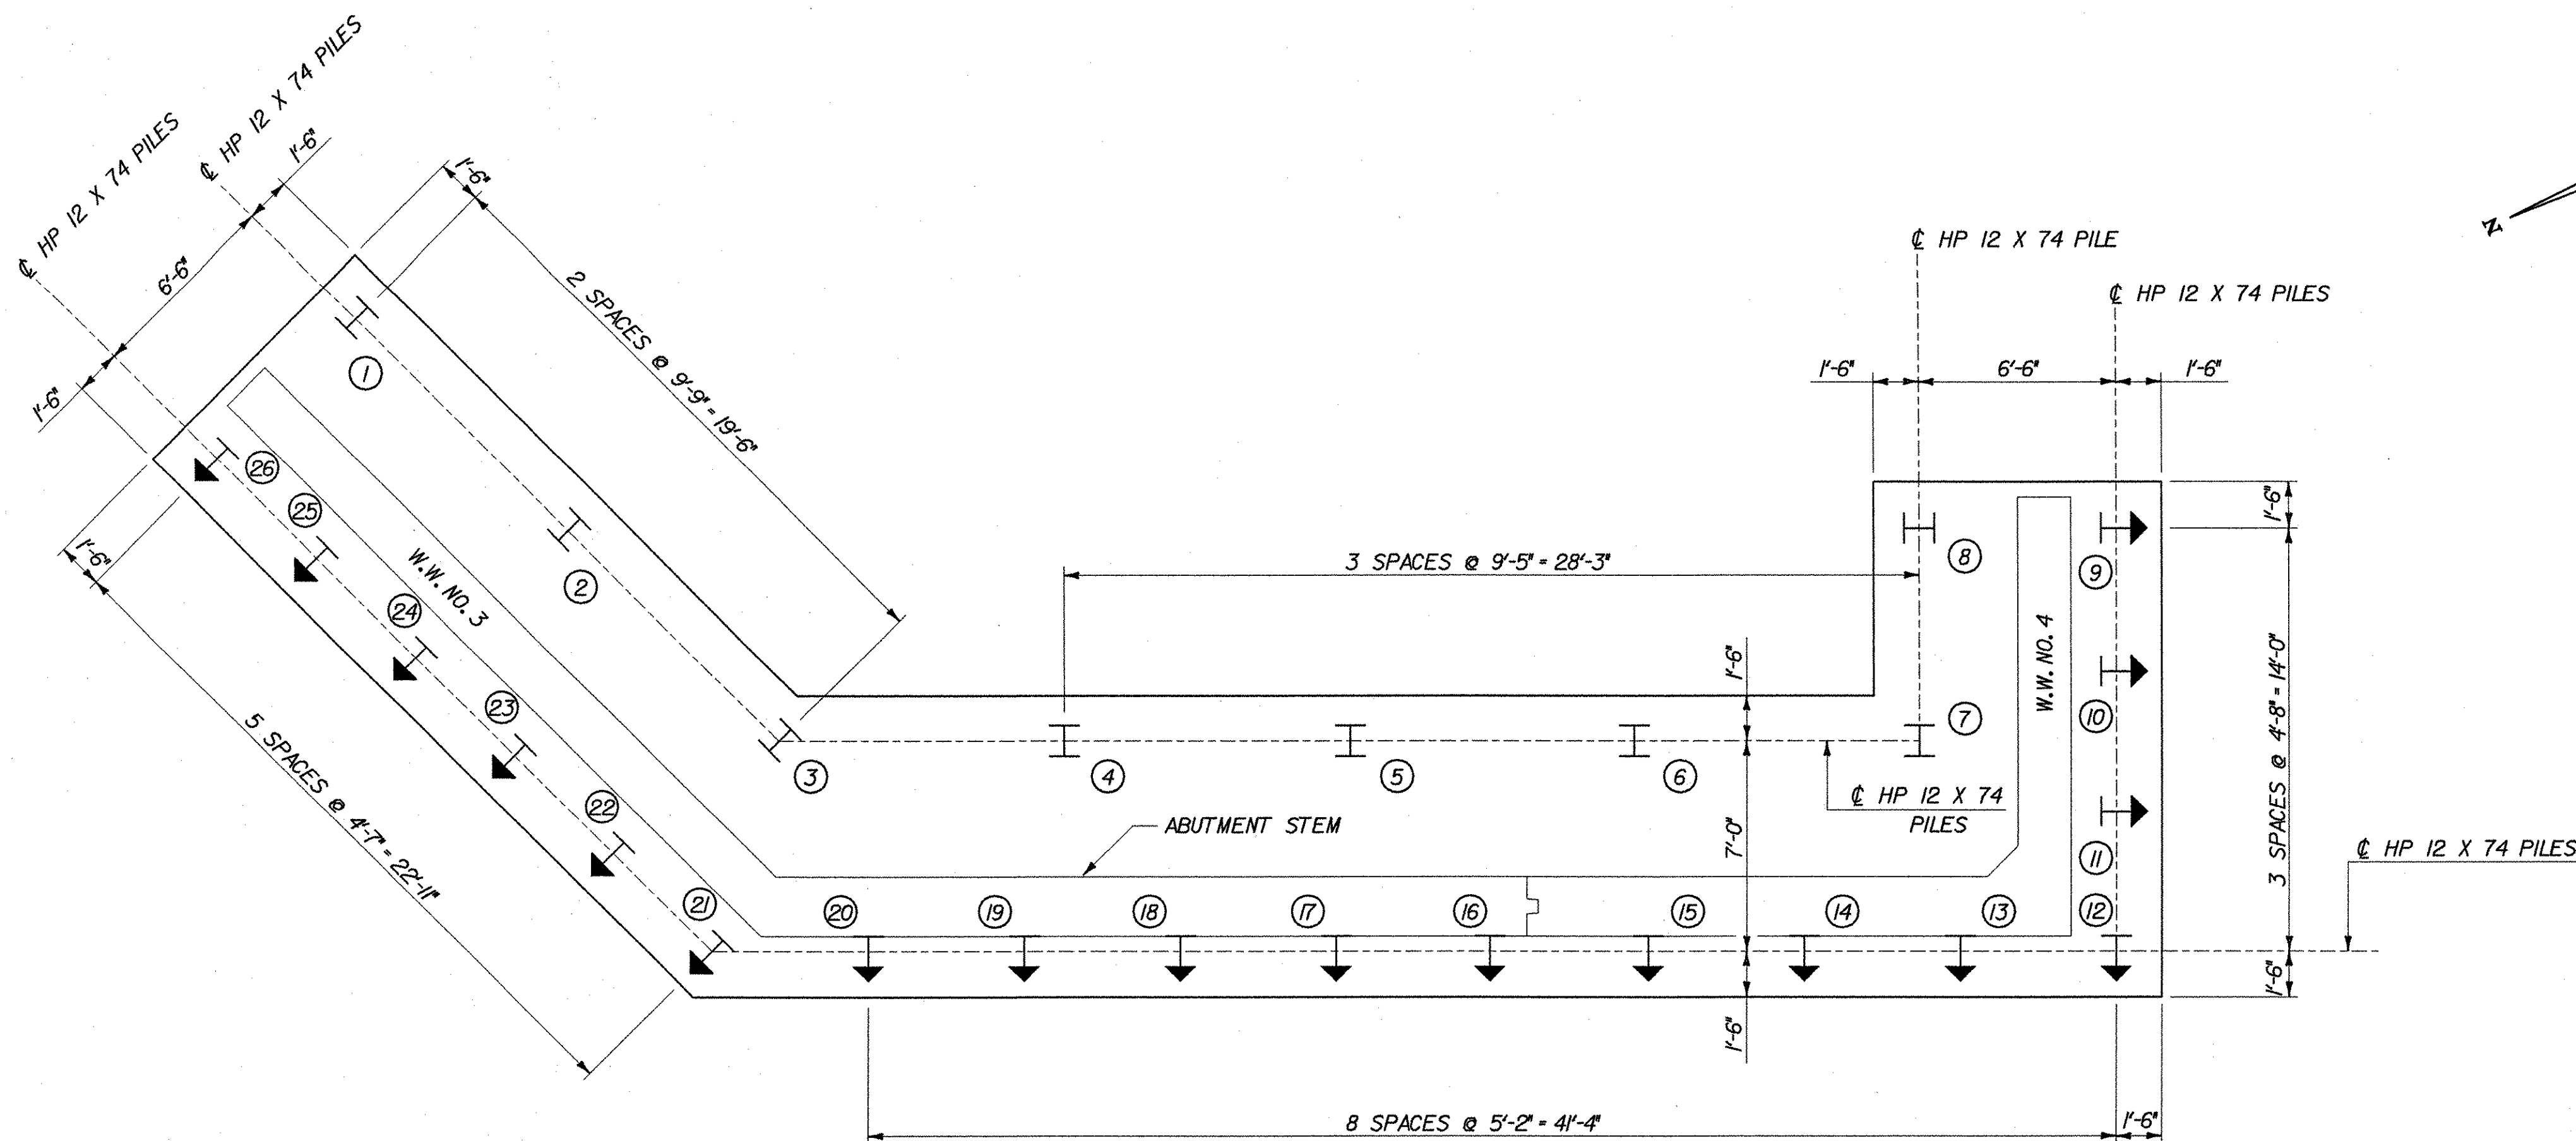


PILE LAYOUT PLAN
SCALE: 1/4" = 1'-0"

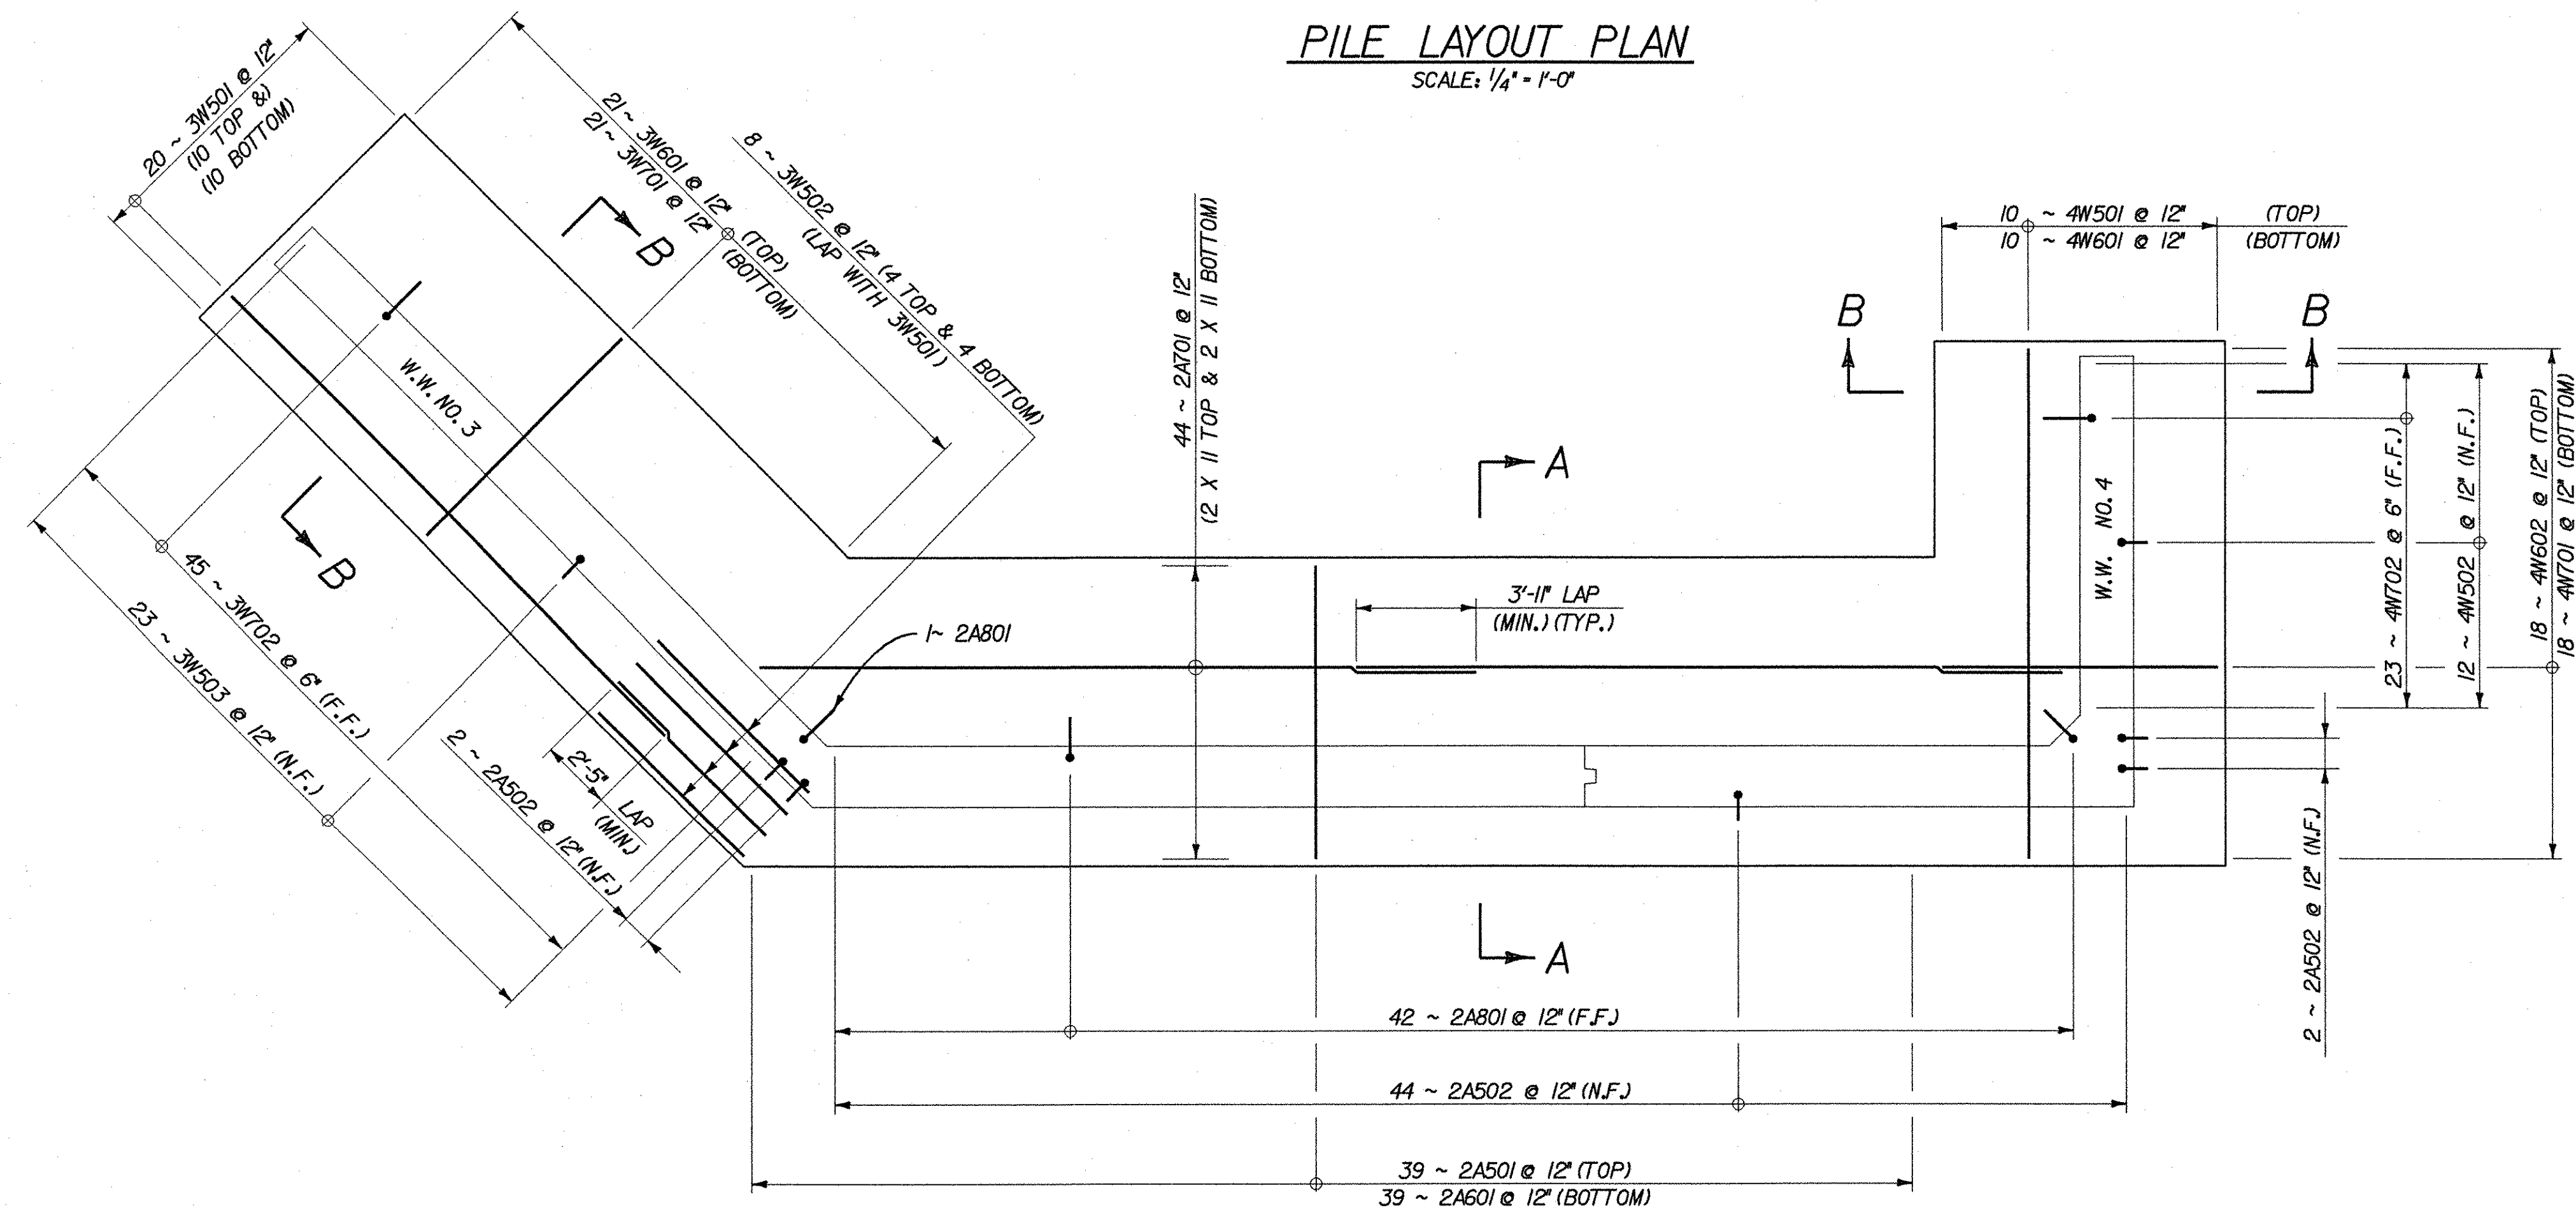

PLAN (REINFORCING)
SCALE: 1/4" = 1'-0"

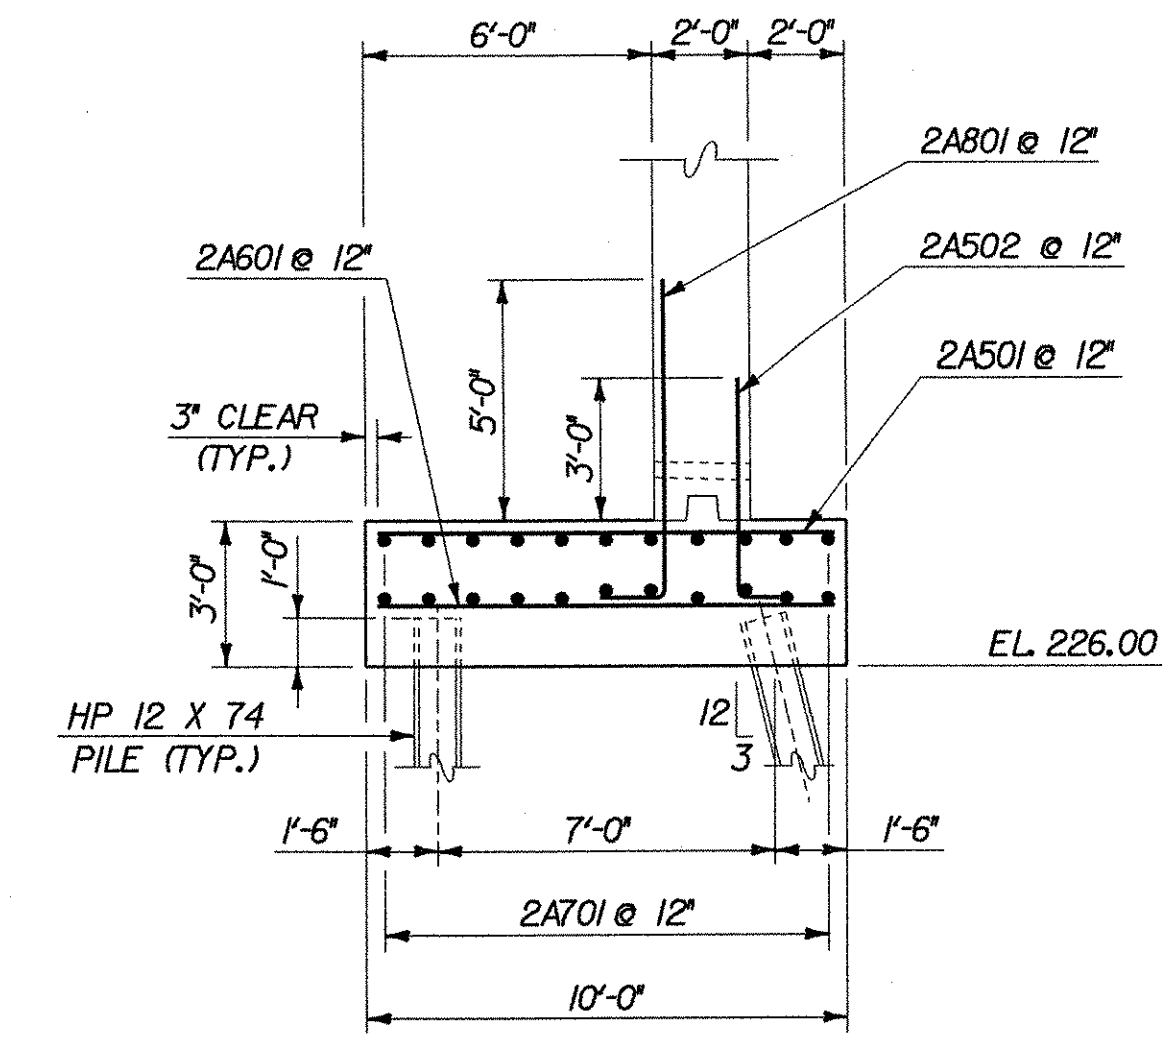

SECTION A-A
SCALE: 1/4" = 1'-0"

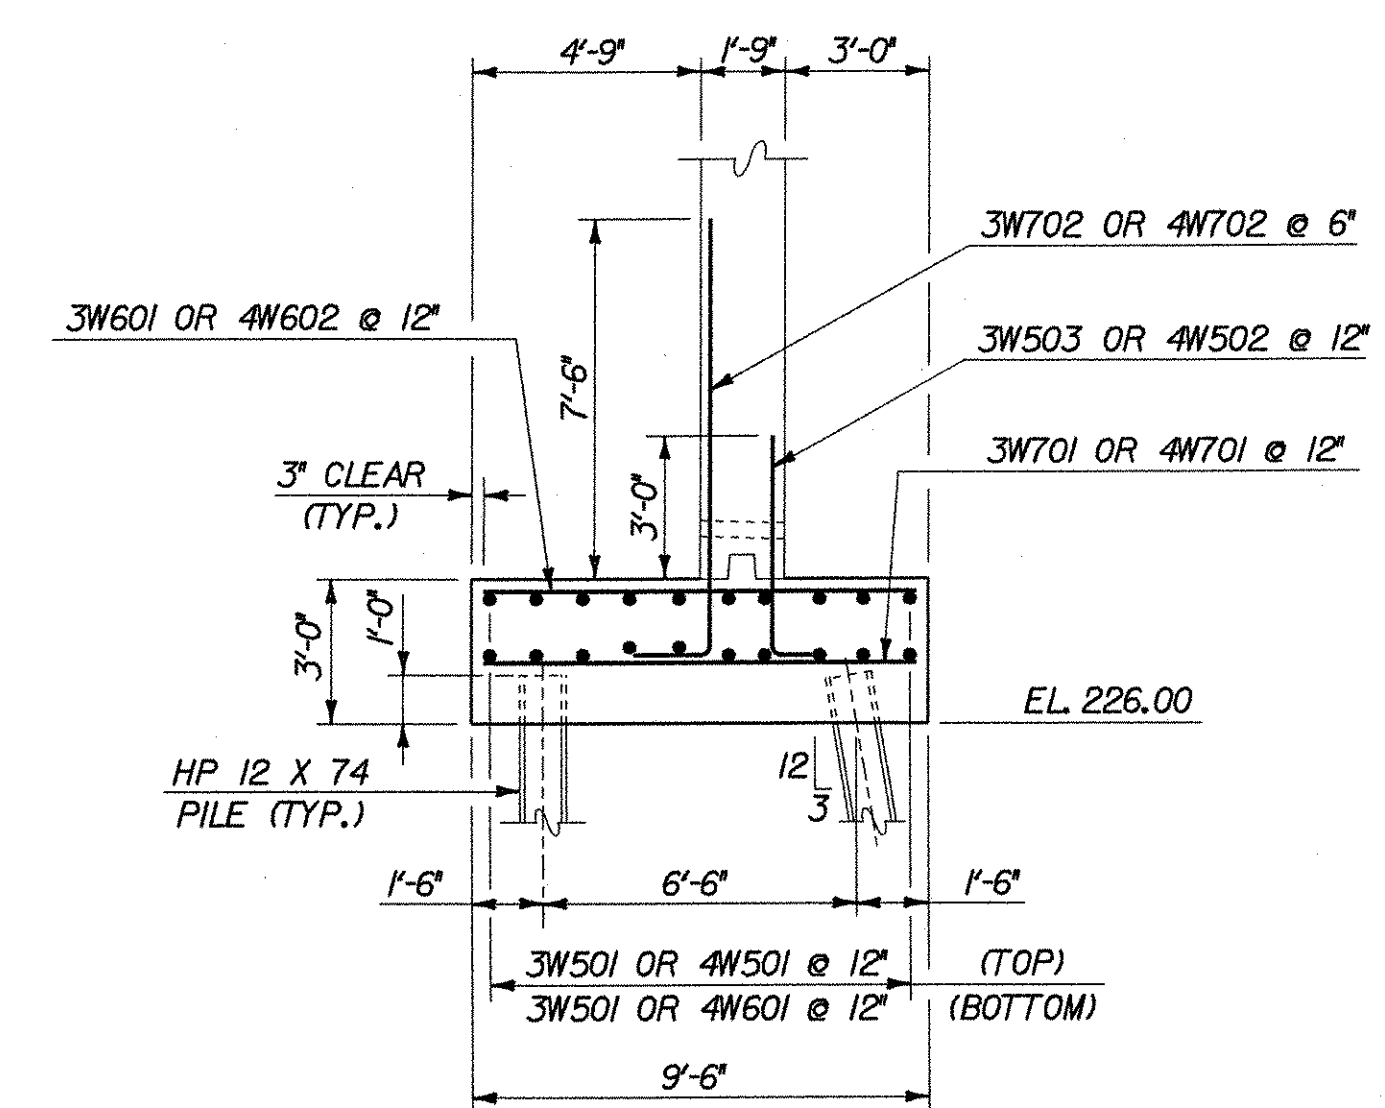

SECTION B-B
SCALE: 1/4" = 1'-0"

NOTES

1. MINIMUM COVER FOR REINFORCING STEEL IN FOOTING SHALL BE 3".

LEGEND


- N.F. = NEAR FACE
- F.F. = FAR FACE
- E.F. = EACH FACE
- ▲ = CUT TO FIT IN FIELD
- ⊥ = VERTICAL PILE
- ↘ = PILE BATTERED 3:12

**STATE OF VERMONT
AGENCY OF TRANSPORTATION**


Town Of	SHELBURNE	Bridge No.	15
Highway No.	TH 3	Log Sta.	
		Surv. Sta.	
BOSTWICK ROAD OVER VERMONT RAILWAY ABUTMENT NO. 2 FOOTING			
Designed By	L. WIXSON	Drawn By	S. MERKMAN
Checked By	R. JOY	Date	05/03
		Bridge Design Supervisor	M. ZYDEL
		Date	05/03
PROJECT	SHELBURNE	PROJECT NO.	BRO 1445(30)
I.G.C. Info. M:\595402 Bostwick\BRIDGE\6m\1445\196a2f.dgn			
Bridge Sheet No.	BRI/5	Sheet	55 of 73




PLOTTED 01-AUG-2003

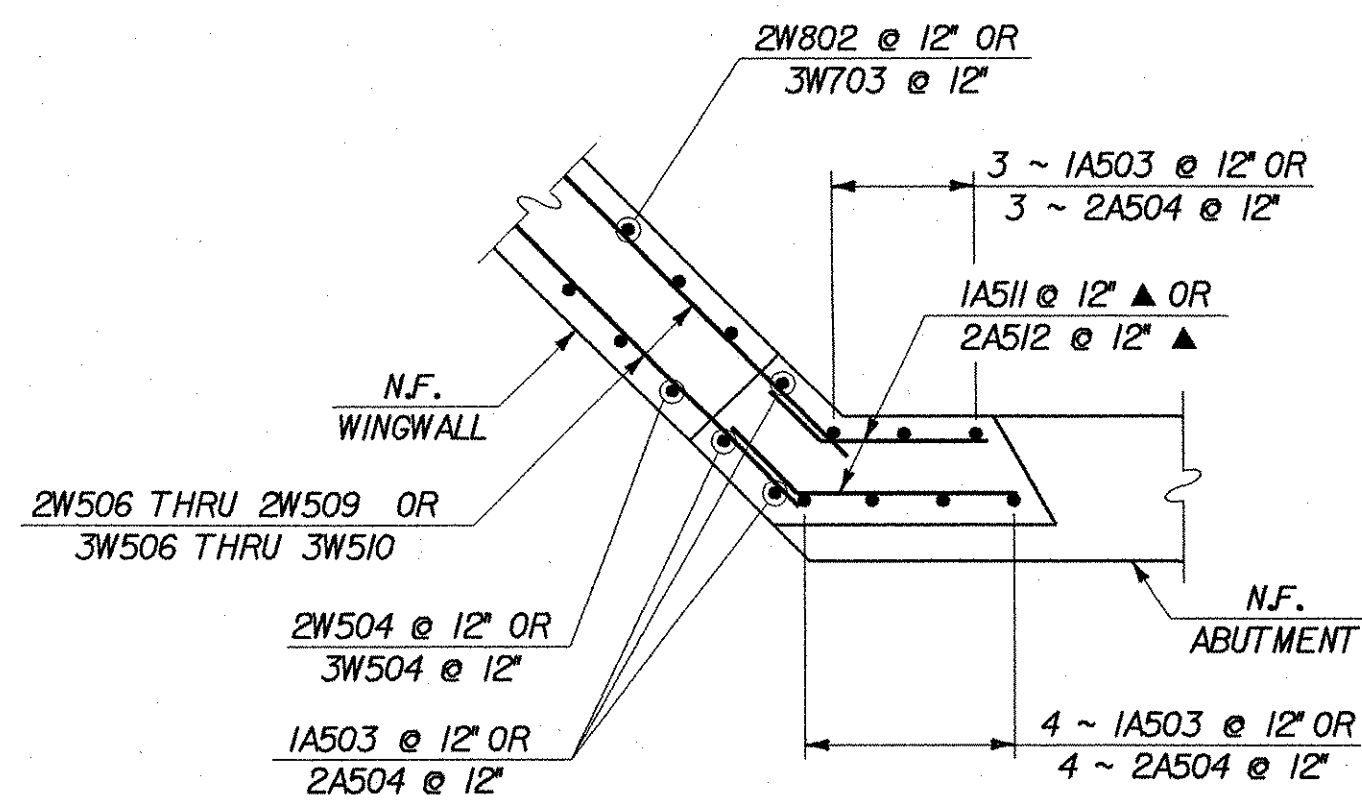


ABOVE BRIDGE SEAT

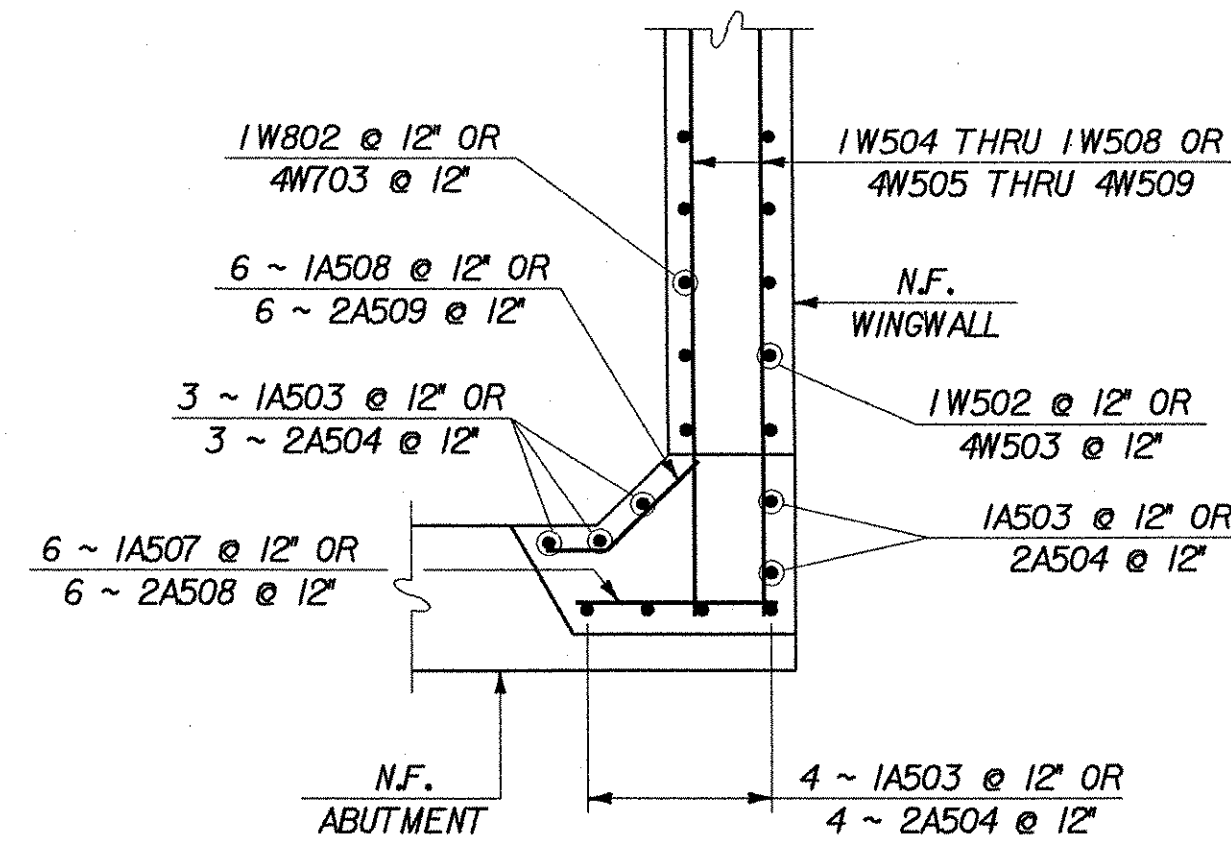

ABOVE BRIDGE SEAT

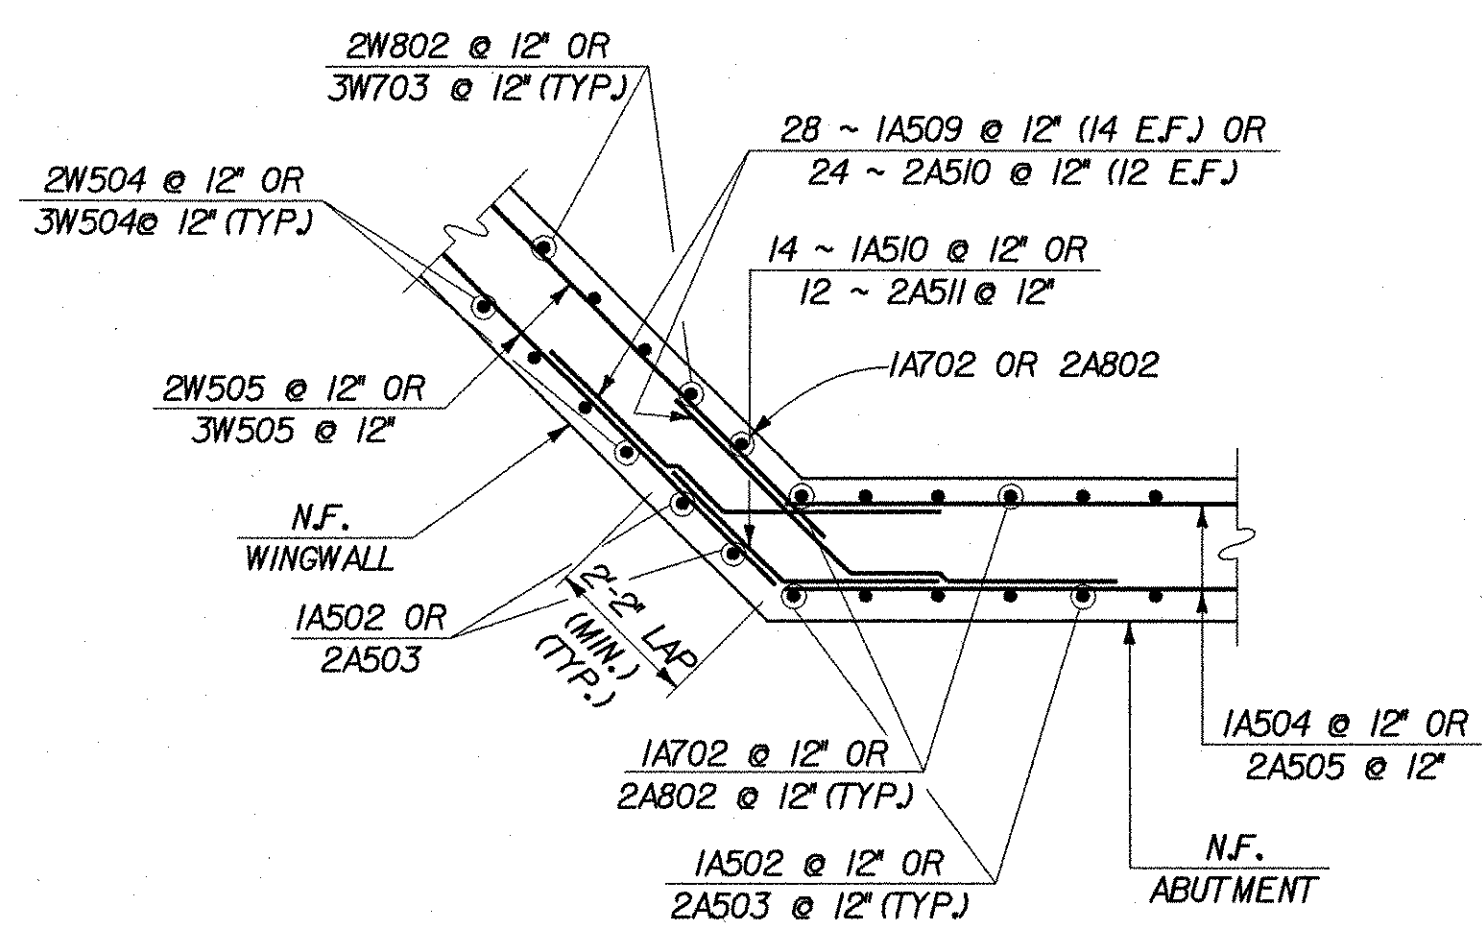

AT ABUTMENT STEM

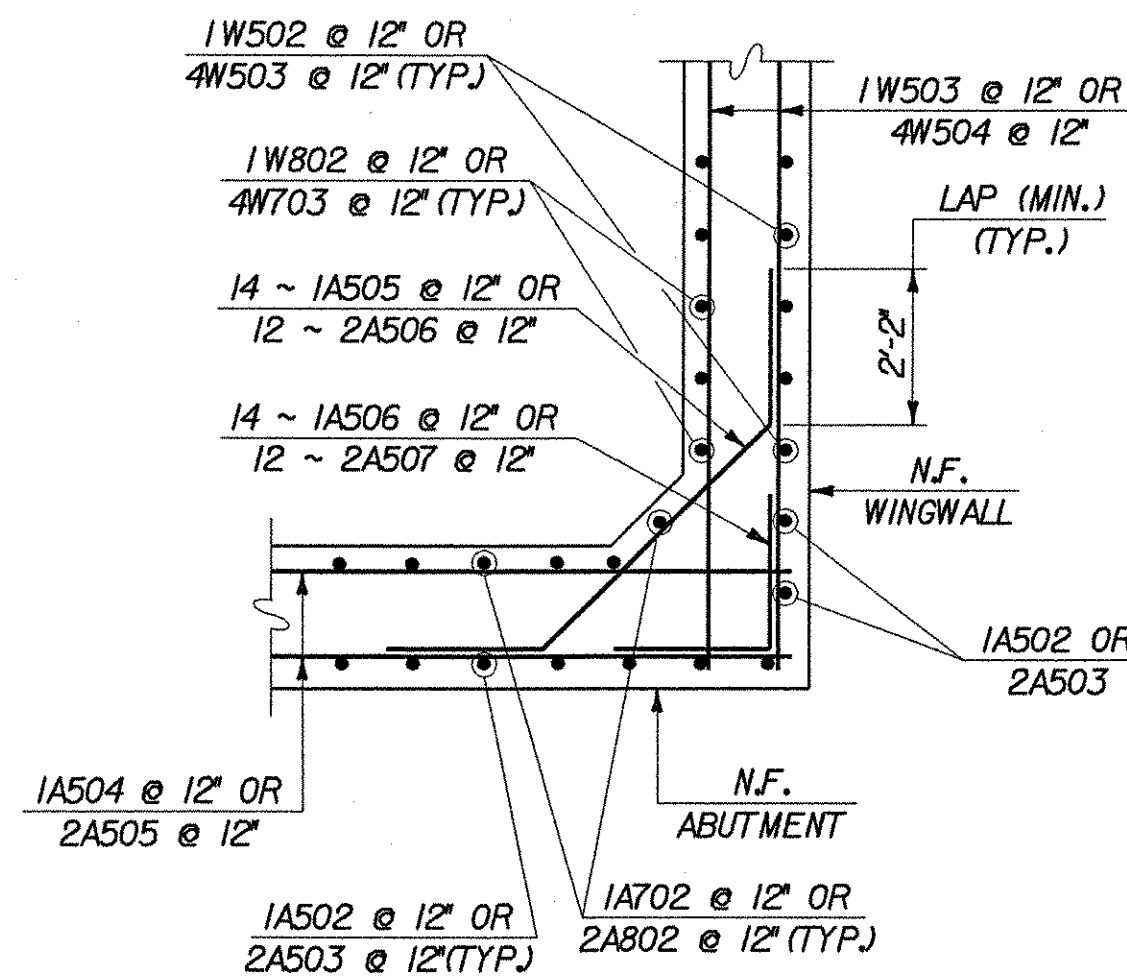


AT ABUTMENT STEM

WINGWALL NO. 2 & NO. 3 CORNER DETAILS

SCALE: 3/8" = 1'-0"


WINGWALL NO. 1 & NO. 4 CORNER DETAILS

SCALE: 3/8" = 1'-0"

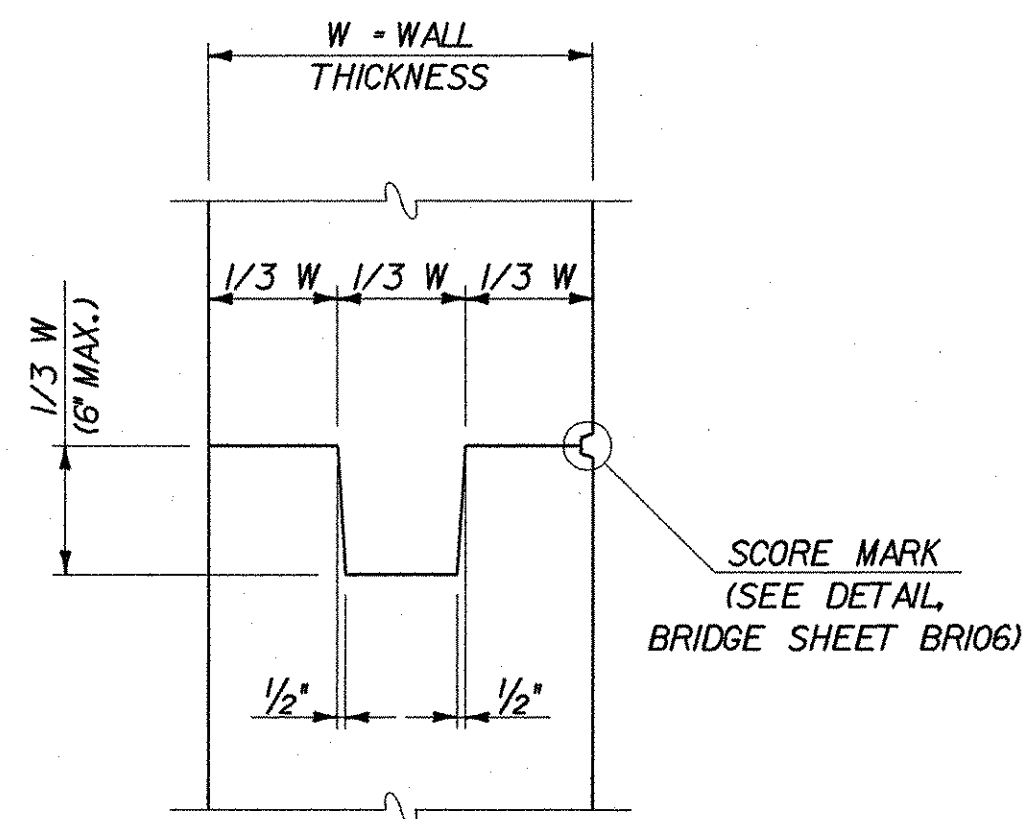


TYPICAL CONCRETE CONSTRUCTION JOINT

SCALE: 1" = 1'-0"

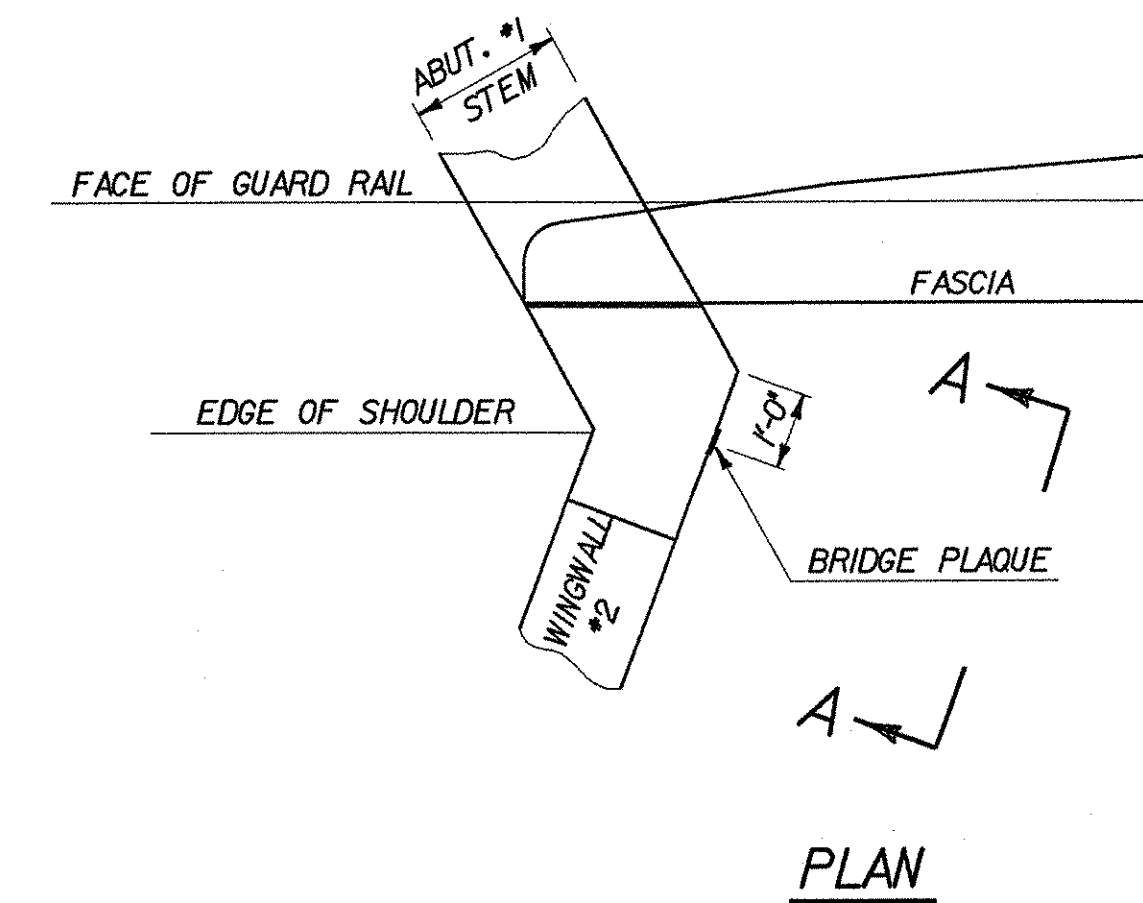

PLAN

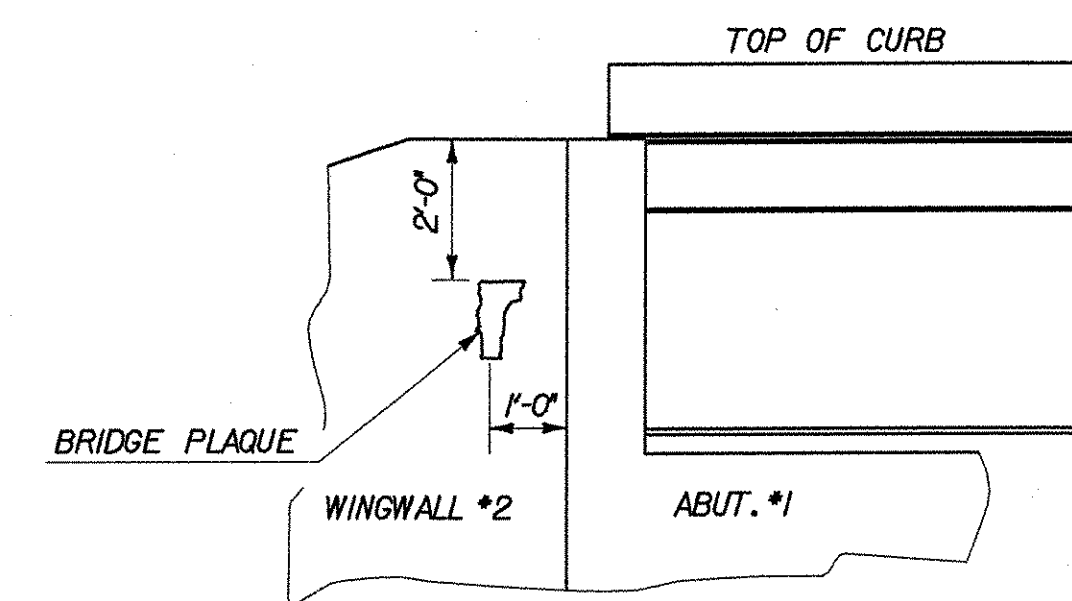

VIEW "A - A"

LOCATE BRIDGE PLAQUE

THE BRIDGE PLAQUE WILL BE SUPPLIED BY THE AGENCY OF TRANSPORTATION AND SHALL BE INSTALLED BY THE CONTRACTOR AT ABUTMENT #1 ON THE RIGHT SIDE AS SHOWN OR AS DIRECTED BY THE ENGINEER.

NOTES

- FOR FOOTINGS DETAILS, SEE BRIDGE SHEETS BR113 AND BR115.
- FOR WINGWALL DETAILS, SEE BRIDGE SHEET BR117.


LEGEND

- N.F. - NEAR FACE
- F.F. - FAR FACE
- E.F. - EACH FACE
- ▲ - CUT TO FIT IN FIELD




STATE OF VERMONT AGENCY OF TRANSPORTATION


Town Of	SHELBURNE	Bridge No.	15
Highway No.	TH 3	Log Sta.	
		Surv. Sta.	
BOSTWICK ROAD OVER VERMONT RAILWAY			
ABUTMENT DETAILS			
Designed By	L. WIXSON	Drawn By	S. MERKMAN
Checked By	R. JOY	Date	05/03
		Bridge Design Supervisor	M. ZYDEL
		Date	05/03
PROJECT	SHELBURNE	PROJECT NO.	BRO 1445(30)
I.G.C. Info. MN595402 Bostwick\BRIDGE\Gm\lar\z\196abd.dgn			
Bridge Sheet No.	BR116	Sheet	56 of 73

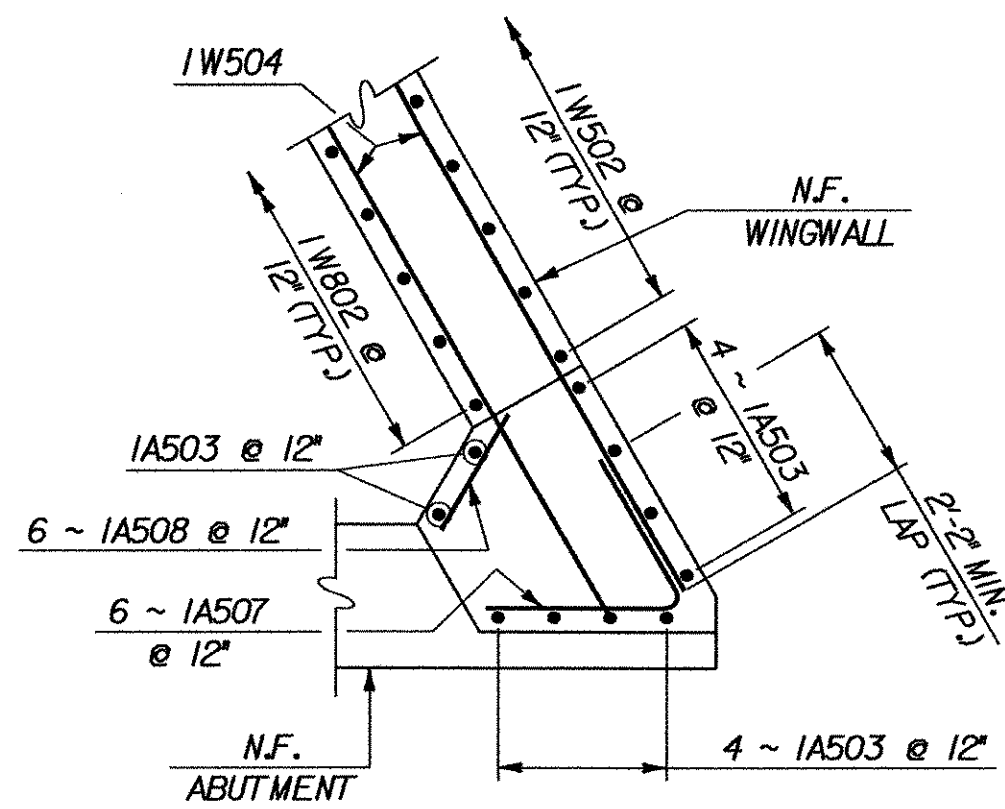


ABOVE BRIDGE SEAT

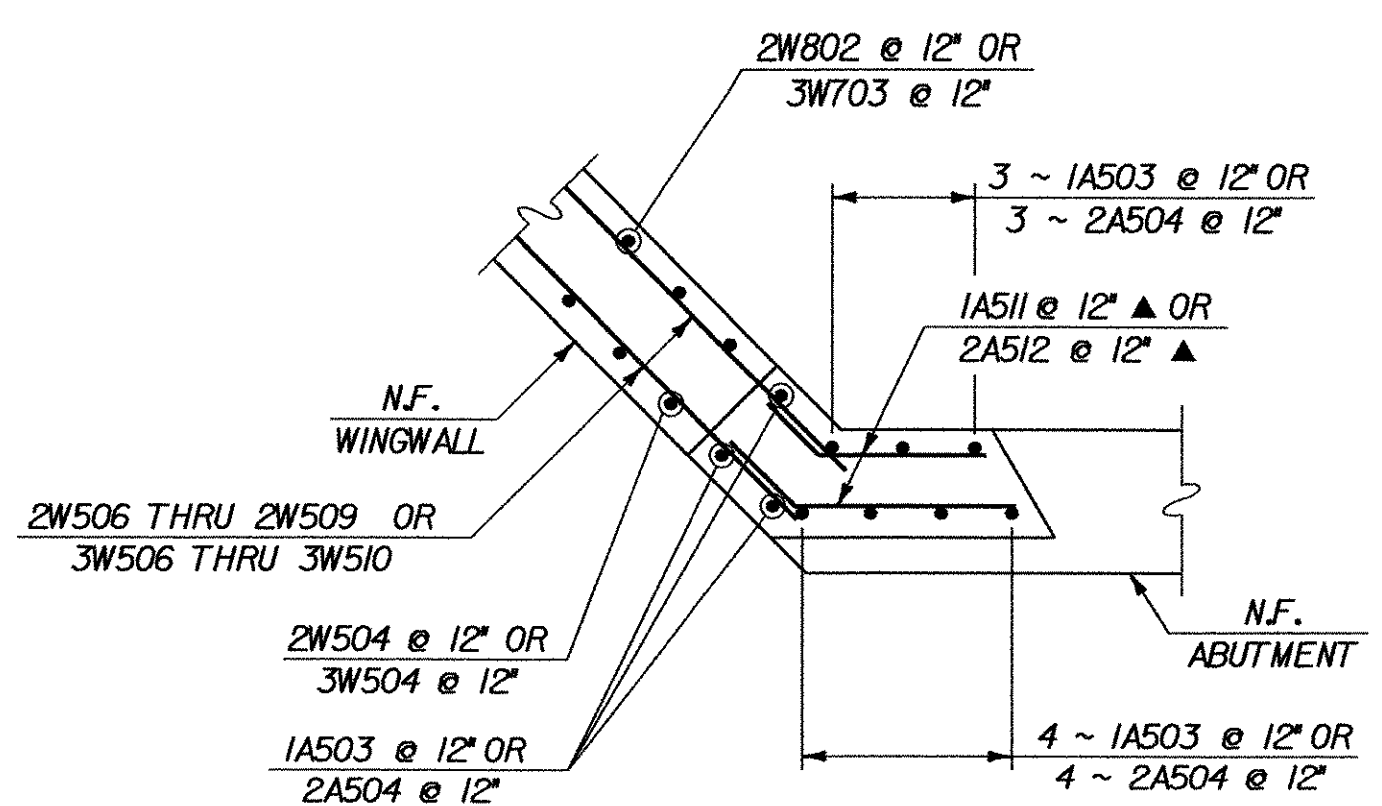


ABOVE BRIDGE SEAT

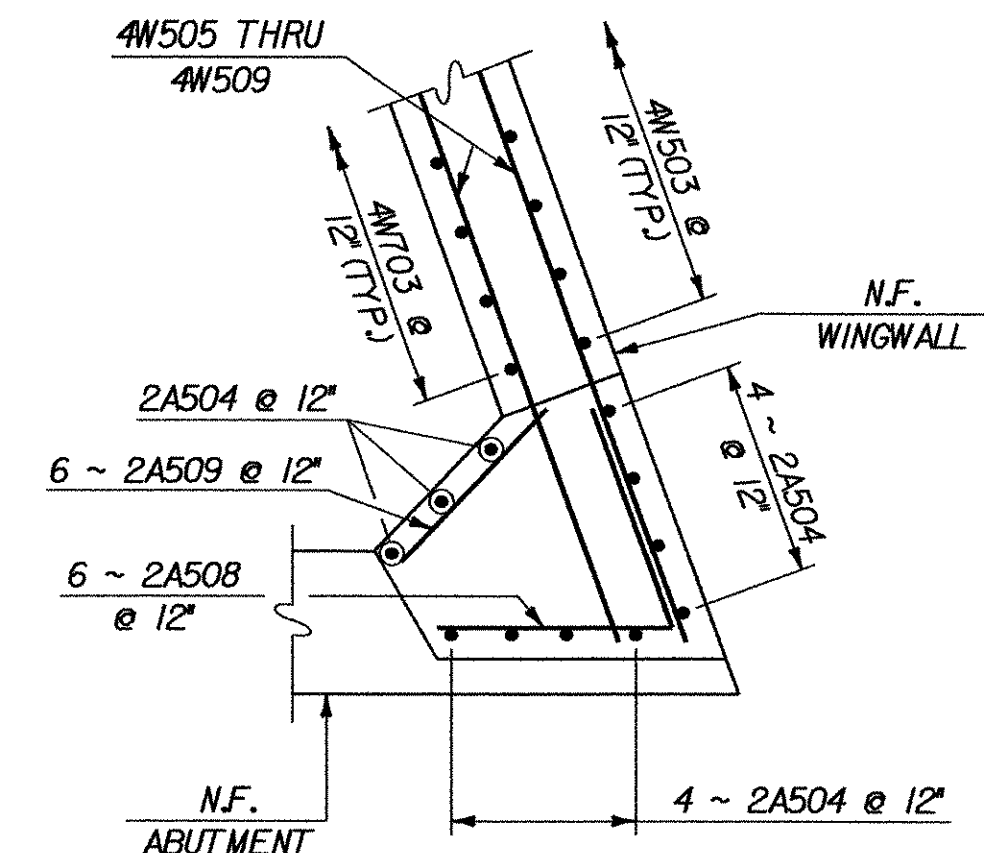


ABOVE BRIDGE SEAT

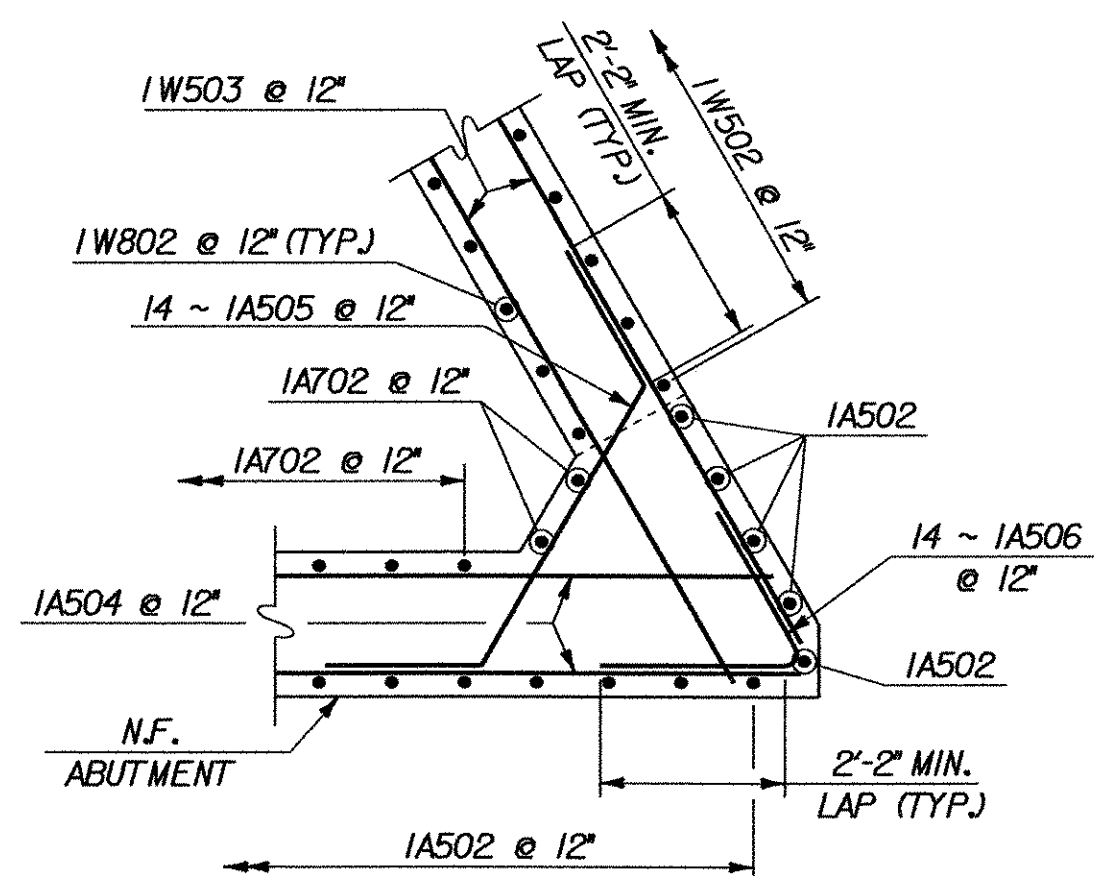

AT ABUTMENT STEM

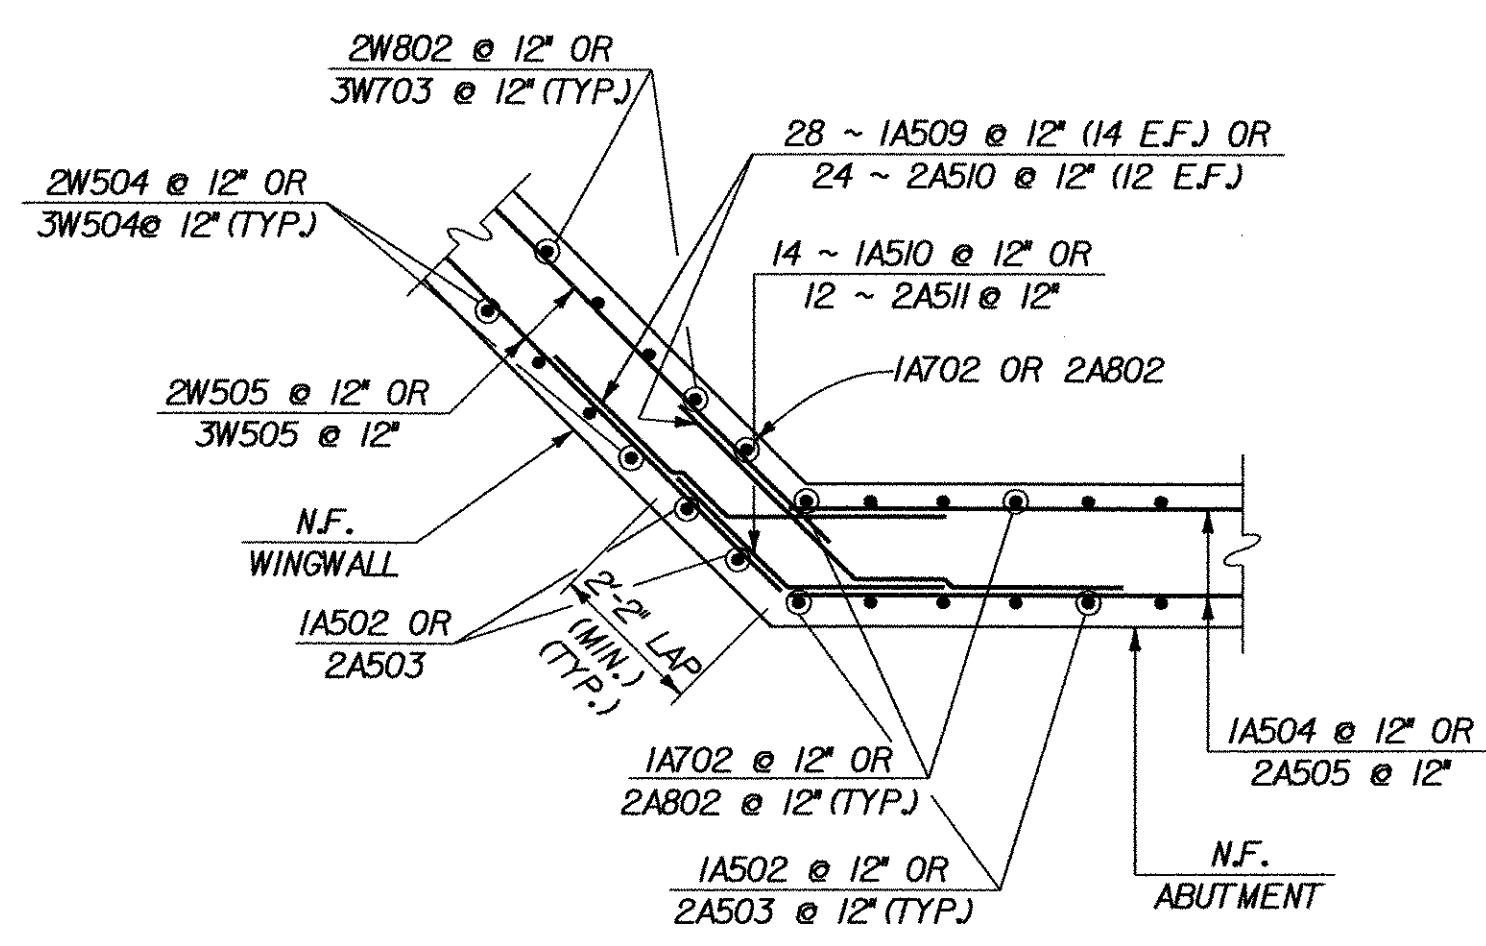

AT ABUTMENT STEM

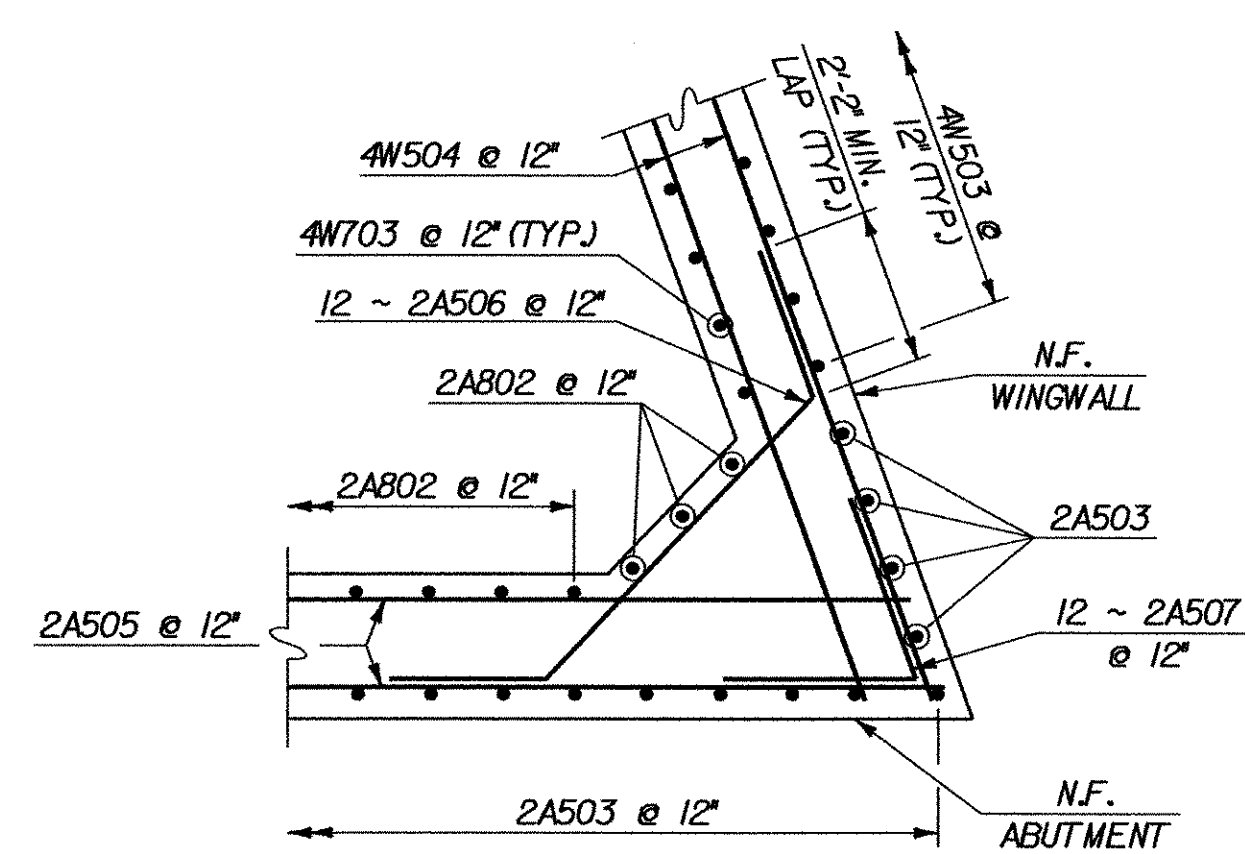

AT ABUTMENT STEM


WINGWALL NO. 1 CORNER DETAILS
SCALE: 3/8" = 1'-0"

WINGWALL NO. 2 & NO. 3 CORNER DETAILS
SCALE: 3/8" = 1'-0"

WINGWALL NO. 4 CORNER DETAILS
SCALE: 3/8" = 1'-0"

NOTES

1. FOR FOOTINGS DETAILS, SEE BRIDGE SHEETS BR113A AND BR115A.
2. FOR WINGWALL DETAILS, SEE BRIDGE SHEET BR117B.

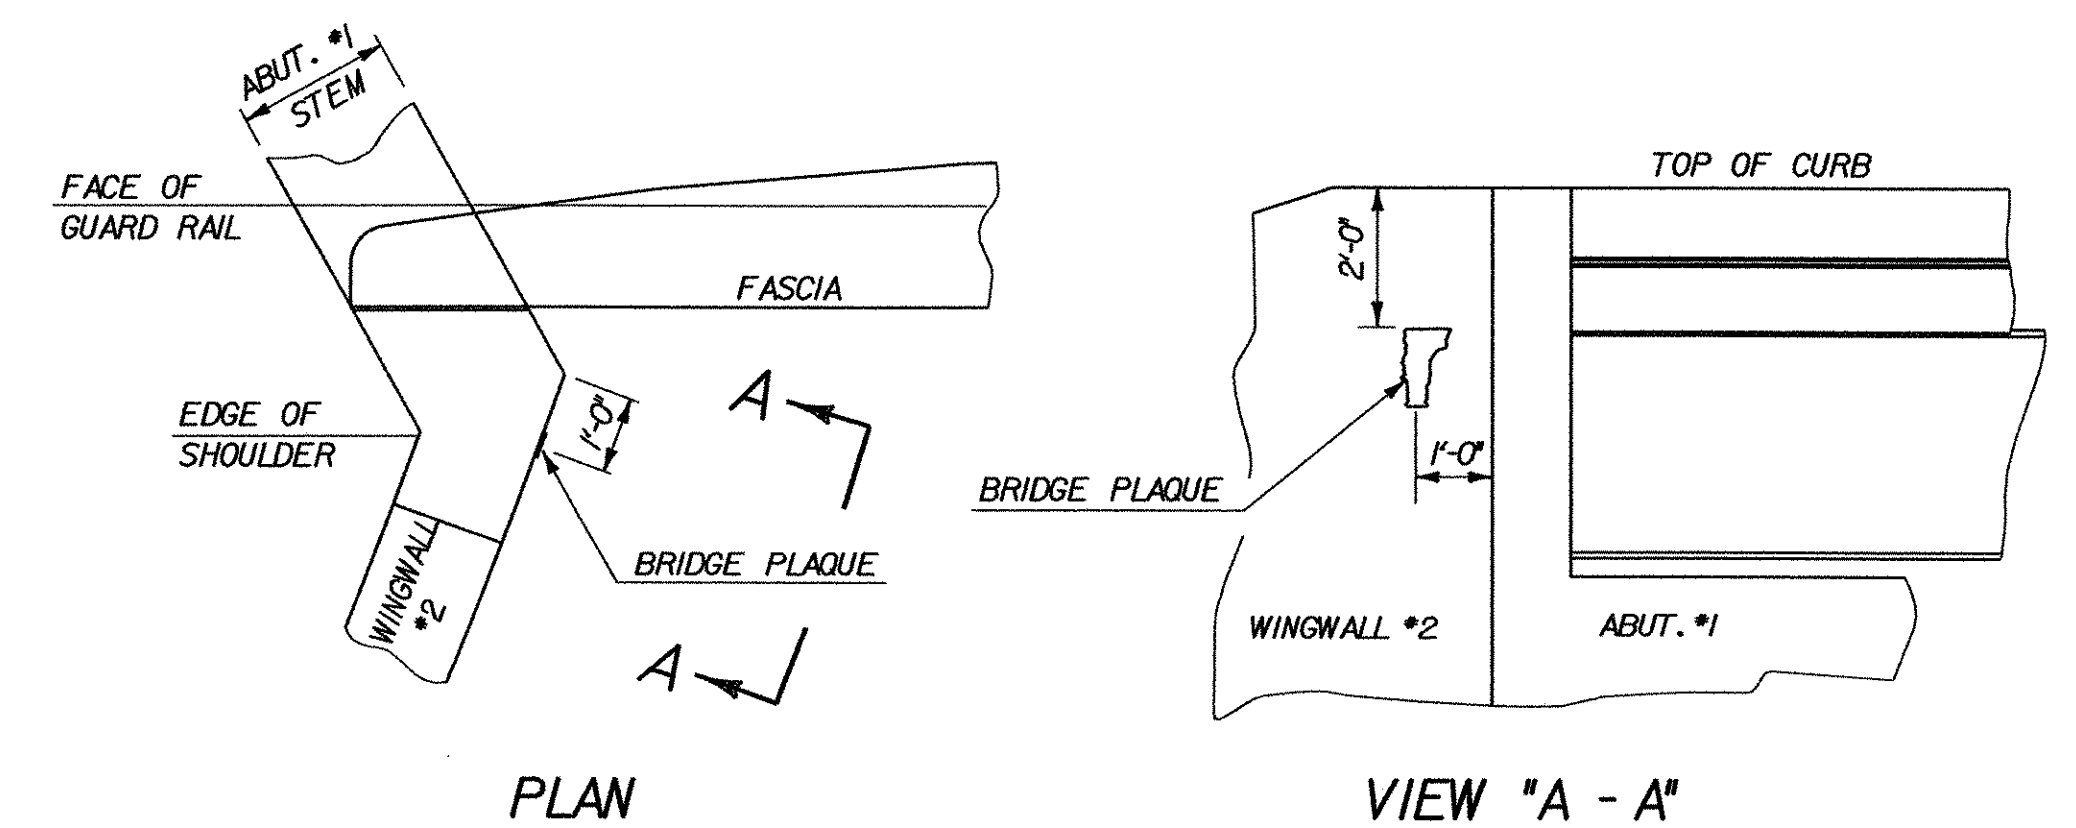


PLAN

VIEW "A - A"

LOCATE BRIDGE PLAQUE

THE BRIDGE PLAQUE WILL BE SUPPLIED BY THE AGENCY OF TRANSPORTATION AND SHALL BE INSTALLED BY THE CONTRACTOR AT ABUTMENT #1 ON THE RIGHT SIDE AS SHOWN OR AS DIRECTED BY THE ENGINEER.

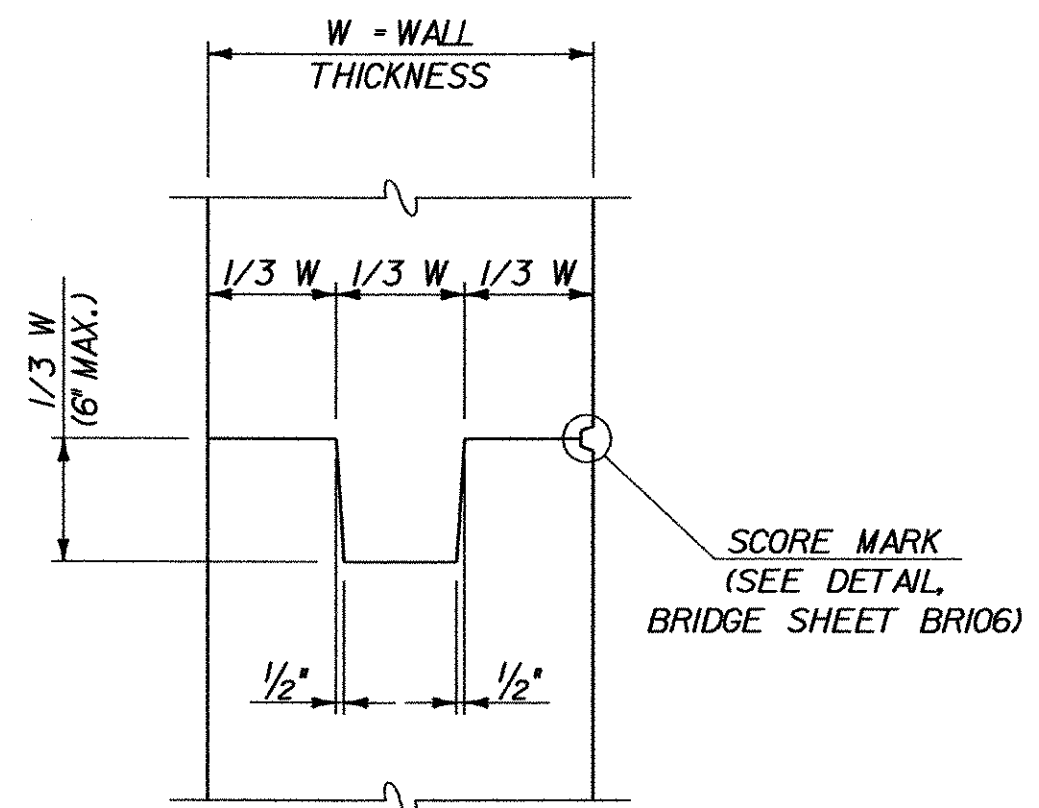

TYPICAL CONCRETE CONSTRUCTION JOINT
SCALE: 1" = 1'-0"

LEGEND

- N.F. = NEAR FACE
- F.F. = FAR FACE
- E.F. = EACH FACE
- ▲ = CUT TO FIT IN FIELD


- ▲ WINGWALL NO. 4 LAYOUT REVISED
- ▲ WINGWALL NO. 1 LAYOUT REVISED

STATE OF VERMONT
AGENCY OF TRANSPORTATION


Town Of	SHELBURNE	Bridge No.	15
Highway No.	TH 3	Log Sta.	
		Surv. Sta.	
BOSTWICK ROAD OVER VERMONT RAILWAY			
ABUTMENT DETAILS (REVISED)			
Designed By	L. WIXSON	Drawn By	S. MERKMAN
Checked By	R. JOY	Bridge Design Supervisor	M. ZYDEL
Date	03/04	Date	03/04
PROJECT	SHELBURNE	PROJECT NO.	BRO 1445(30)
I.G.C. Info. G:\Structures\STR3_Roger Whitcomb\Consultants\McFarland-Johnson\Shelburne			
Bridge Sheet No.	BR116B	Sheet	56B of 73




PLOTTED 24-MAR-2004

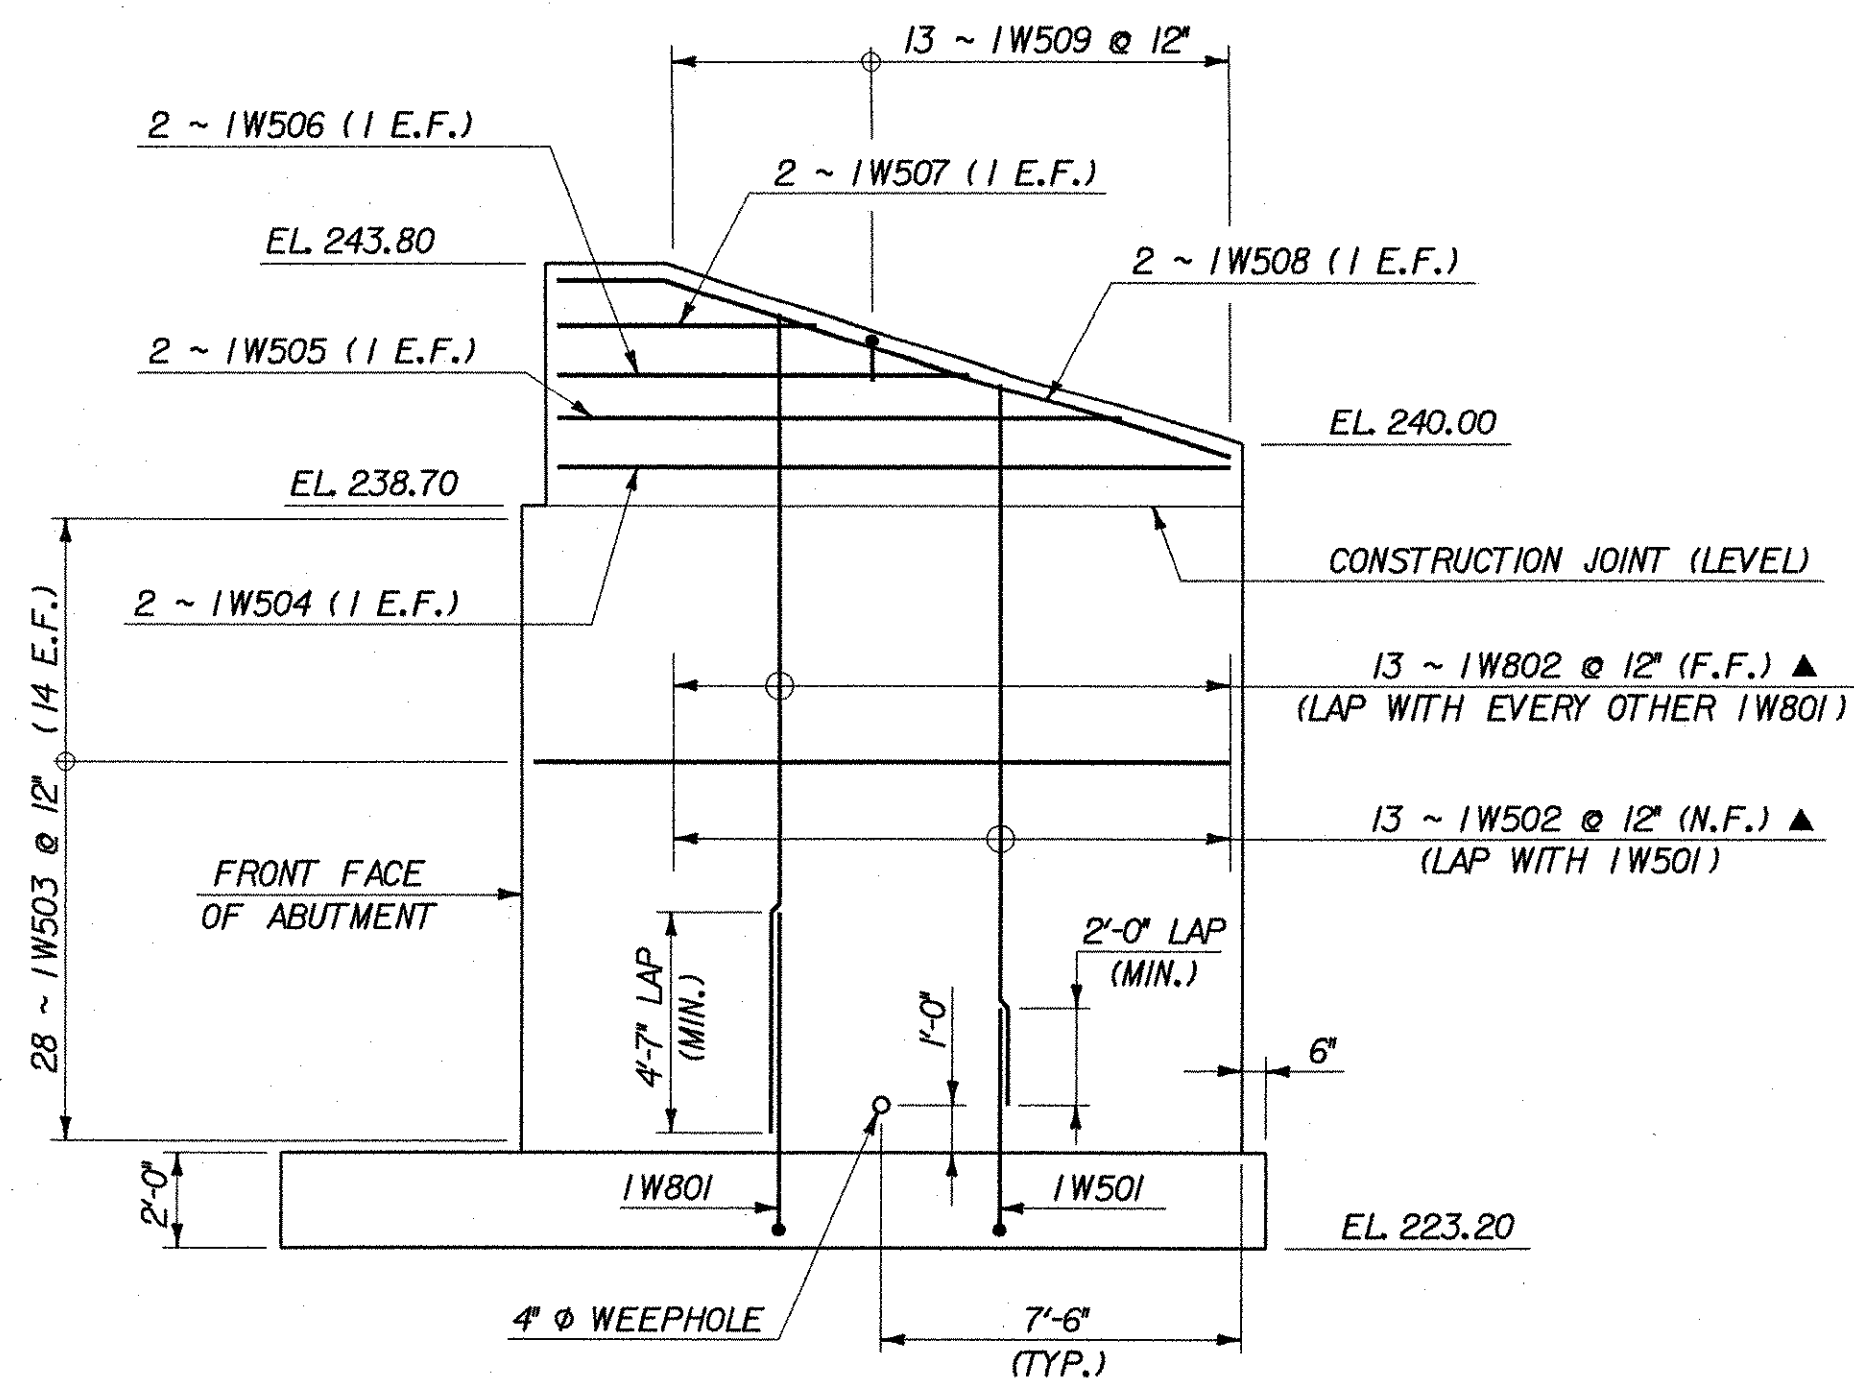


WINGWALL NO. 1 ELEVATION
SCALE: 1/4" = 1'-0"

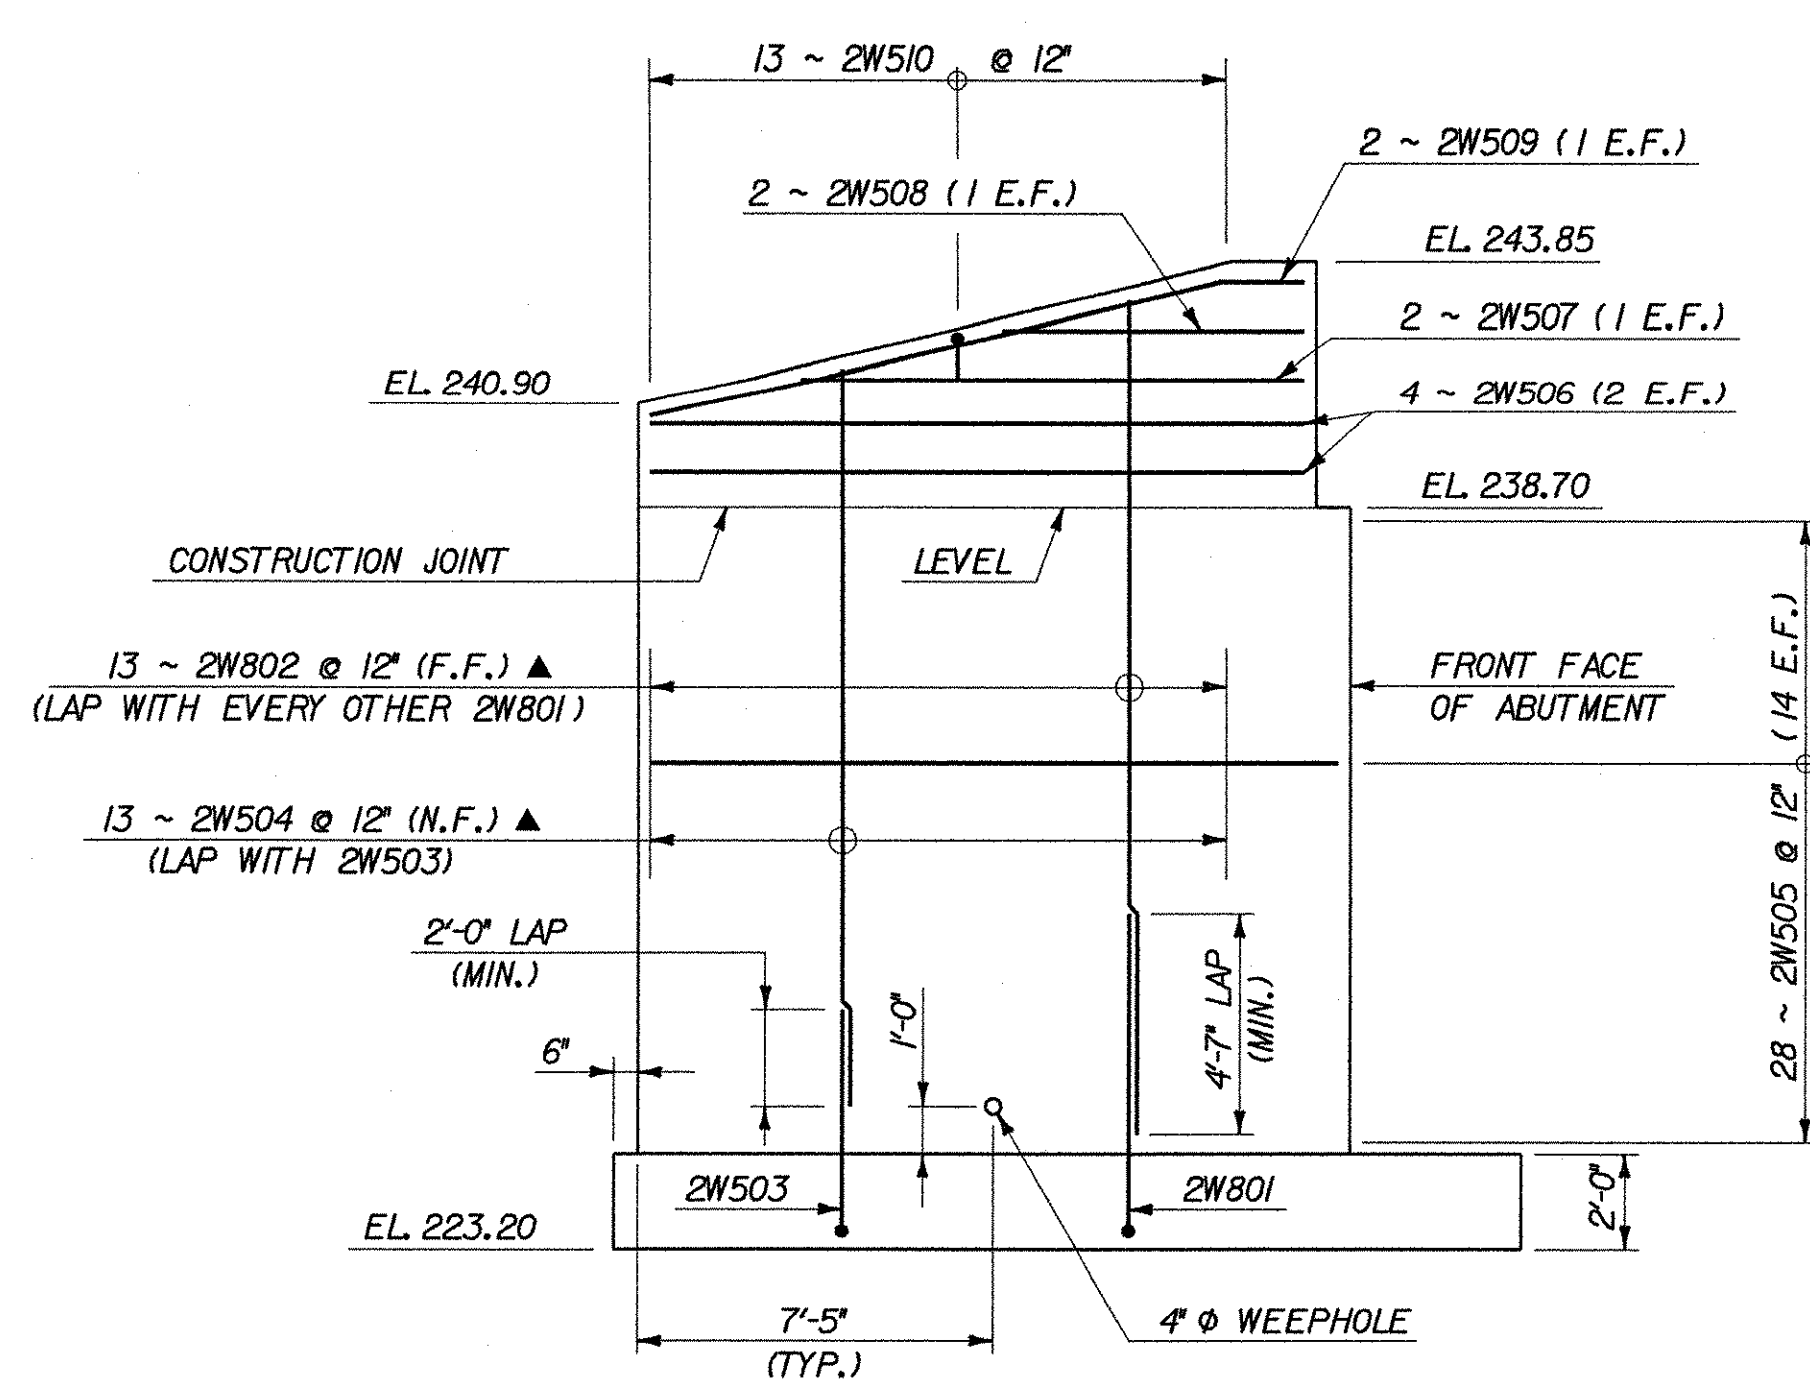


WINGWALL NO. 2 ELEVATION
SCALE: 1/4" = 1'-0"

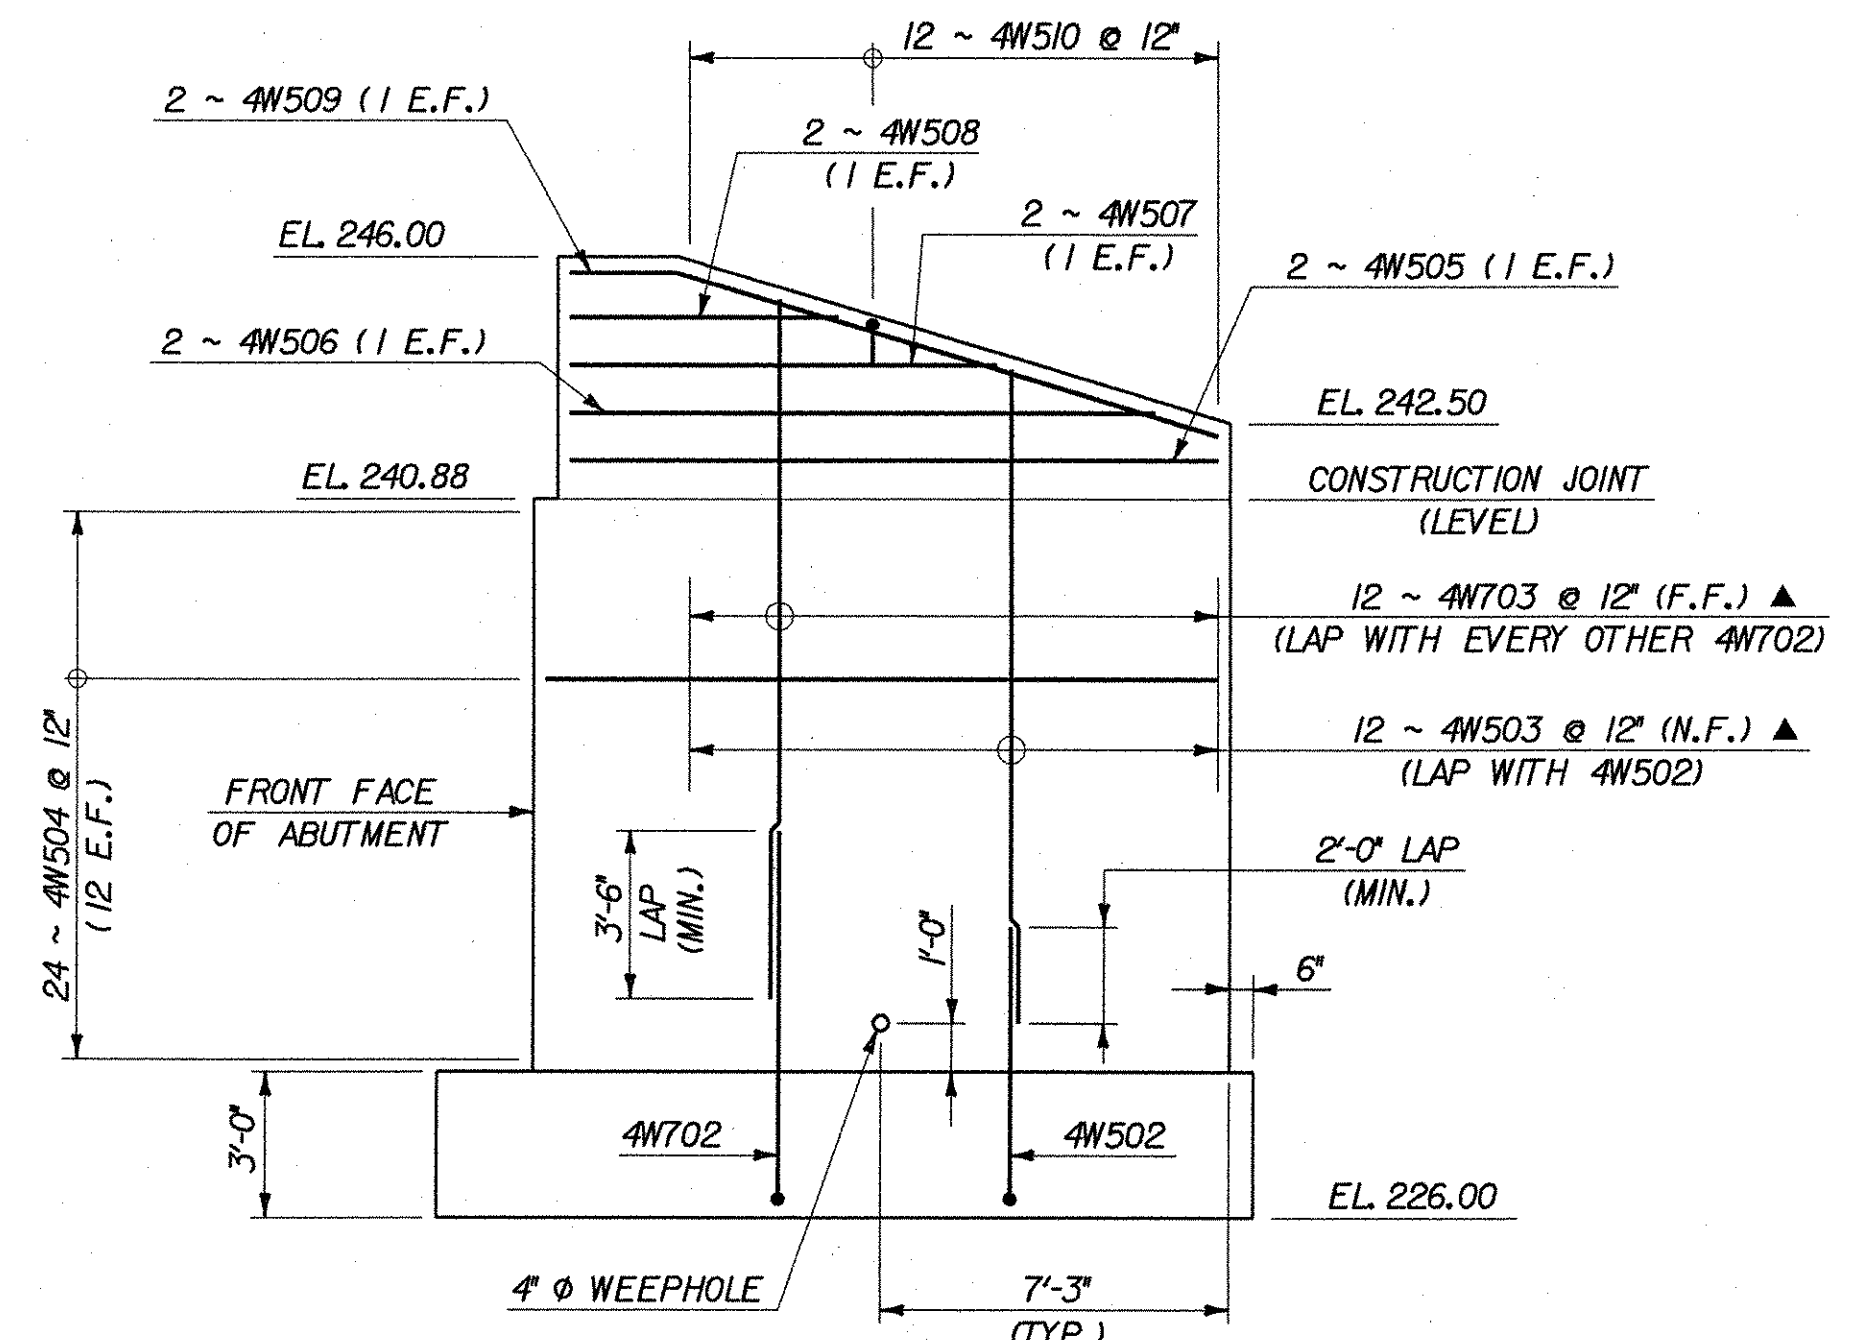


WINGWALL NO. 4 ELEVATION
SCALE: 1/4" = 1'-0"

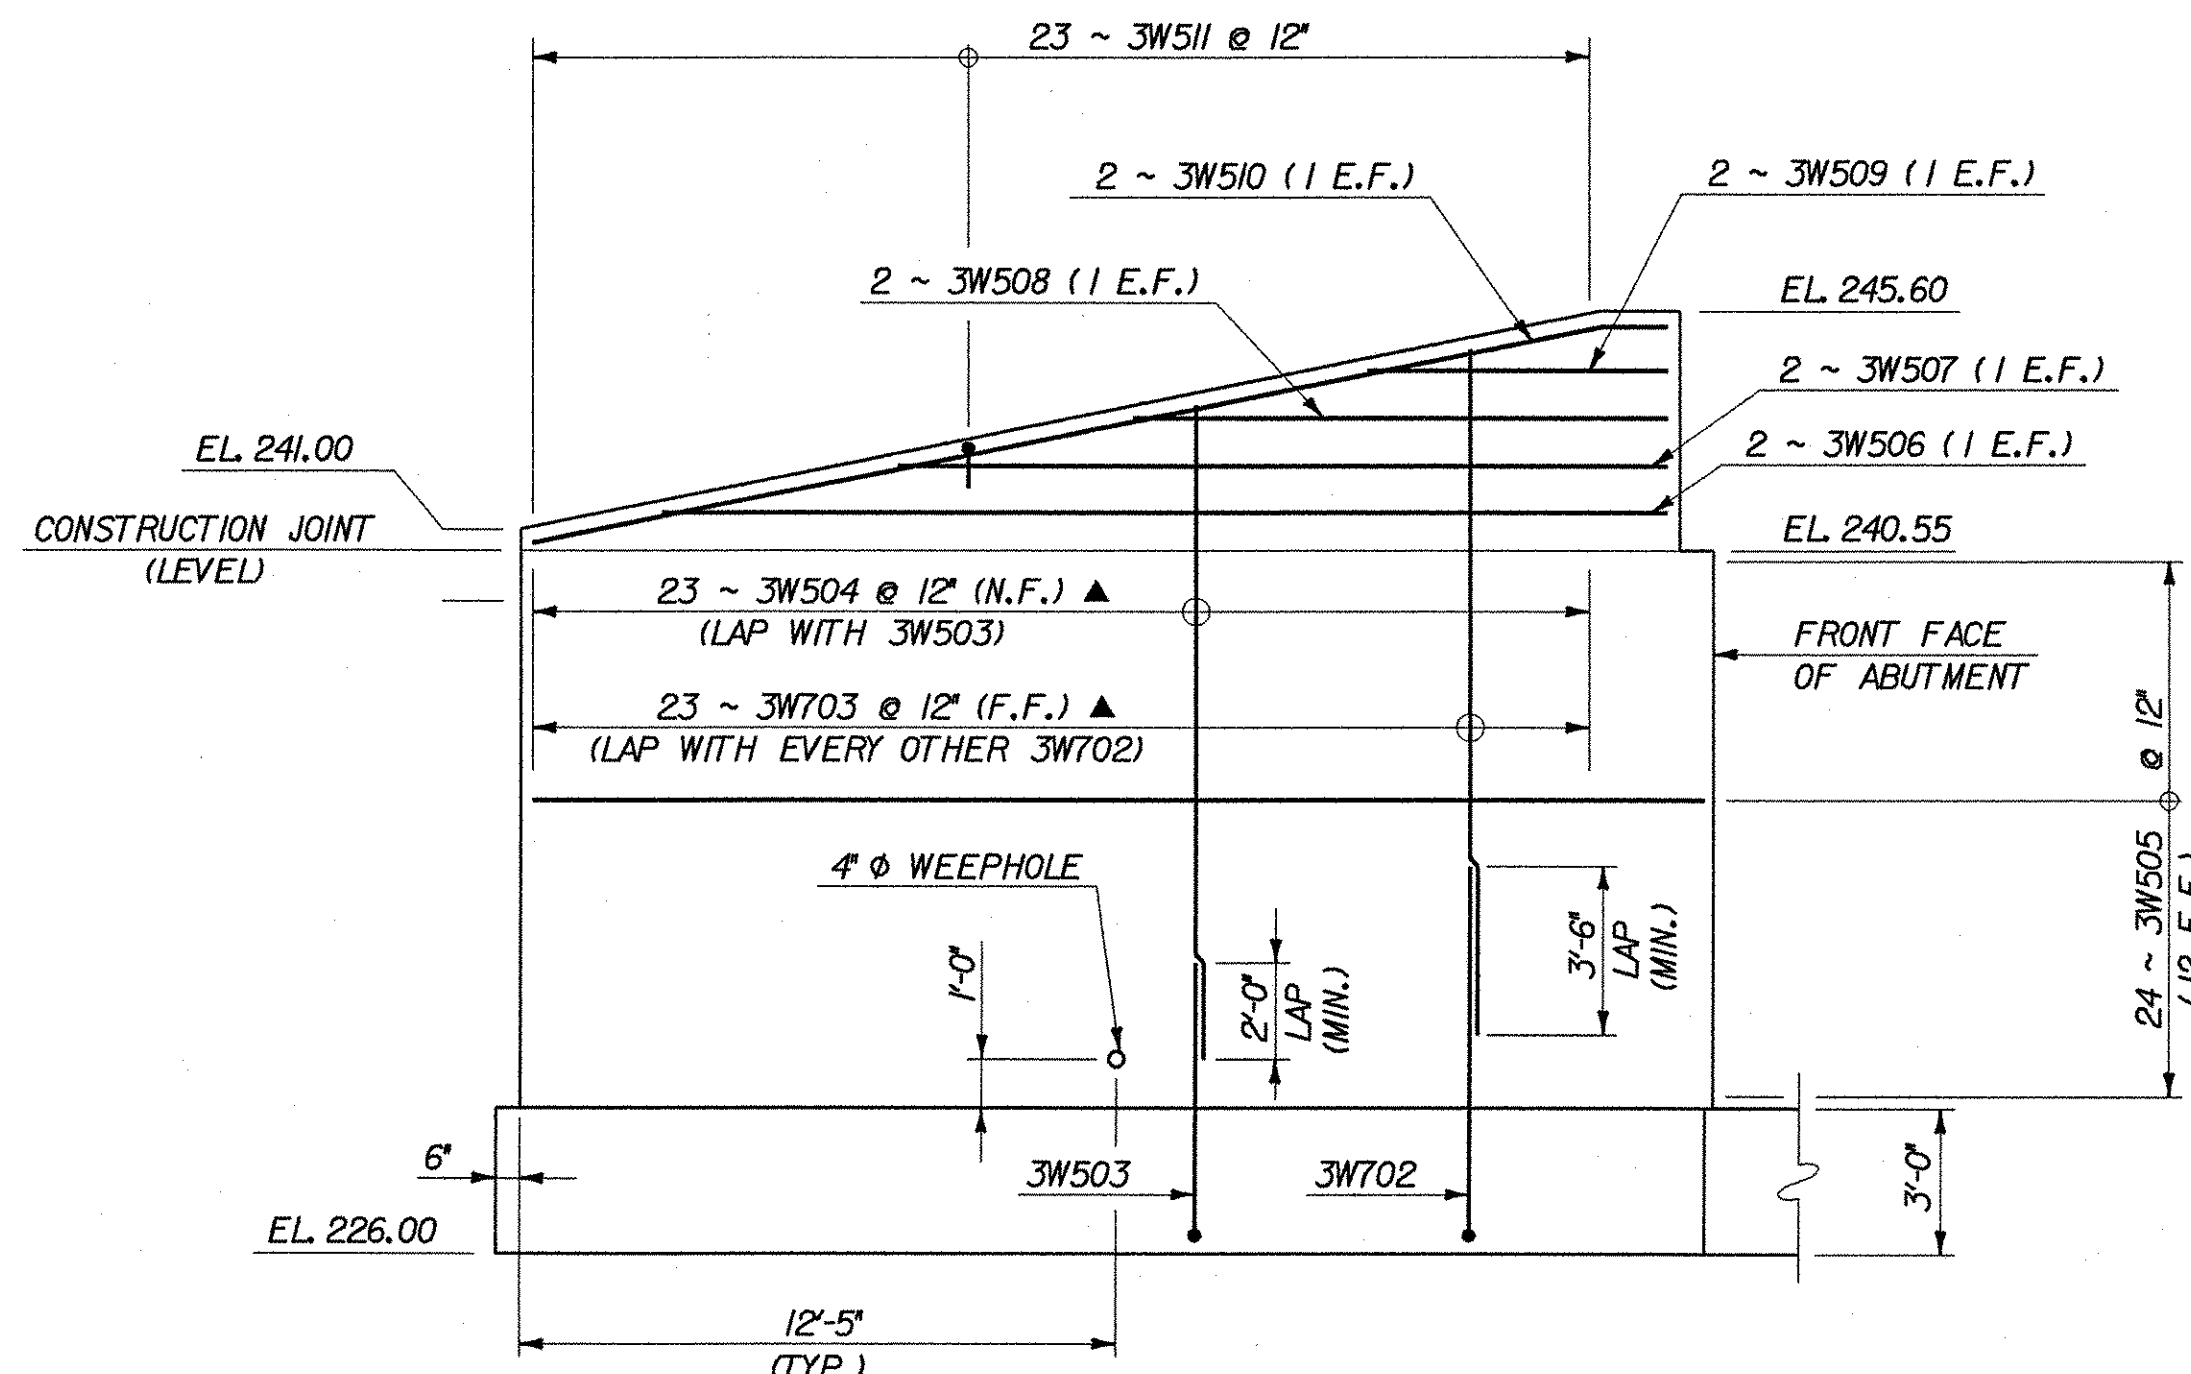

WINGWALL NO. 3 ELEVATION
SCALE: 1/4" = 1'-0"

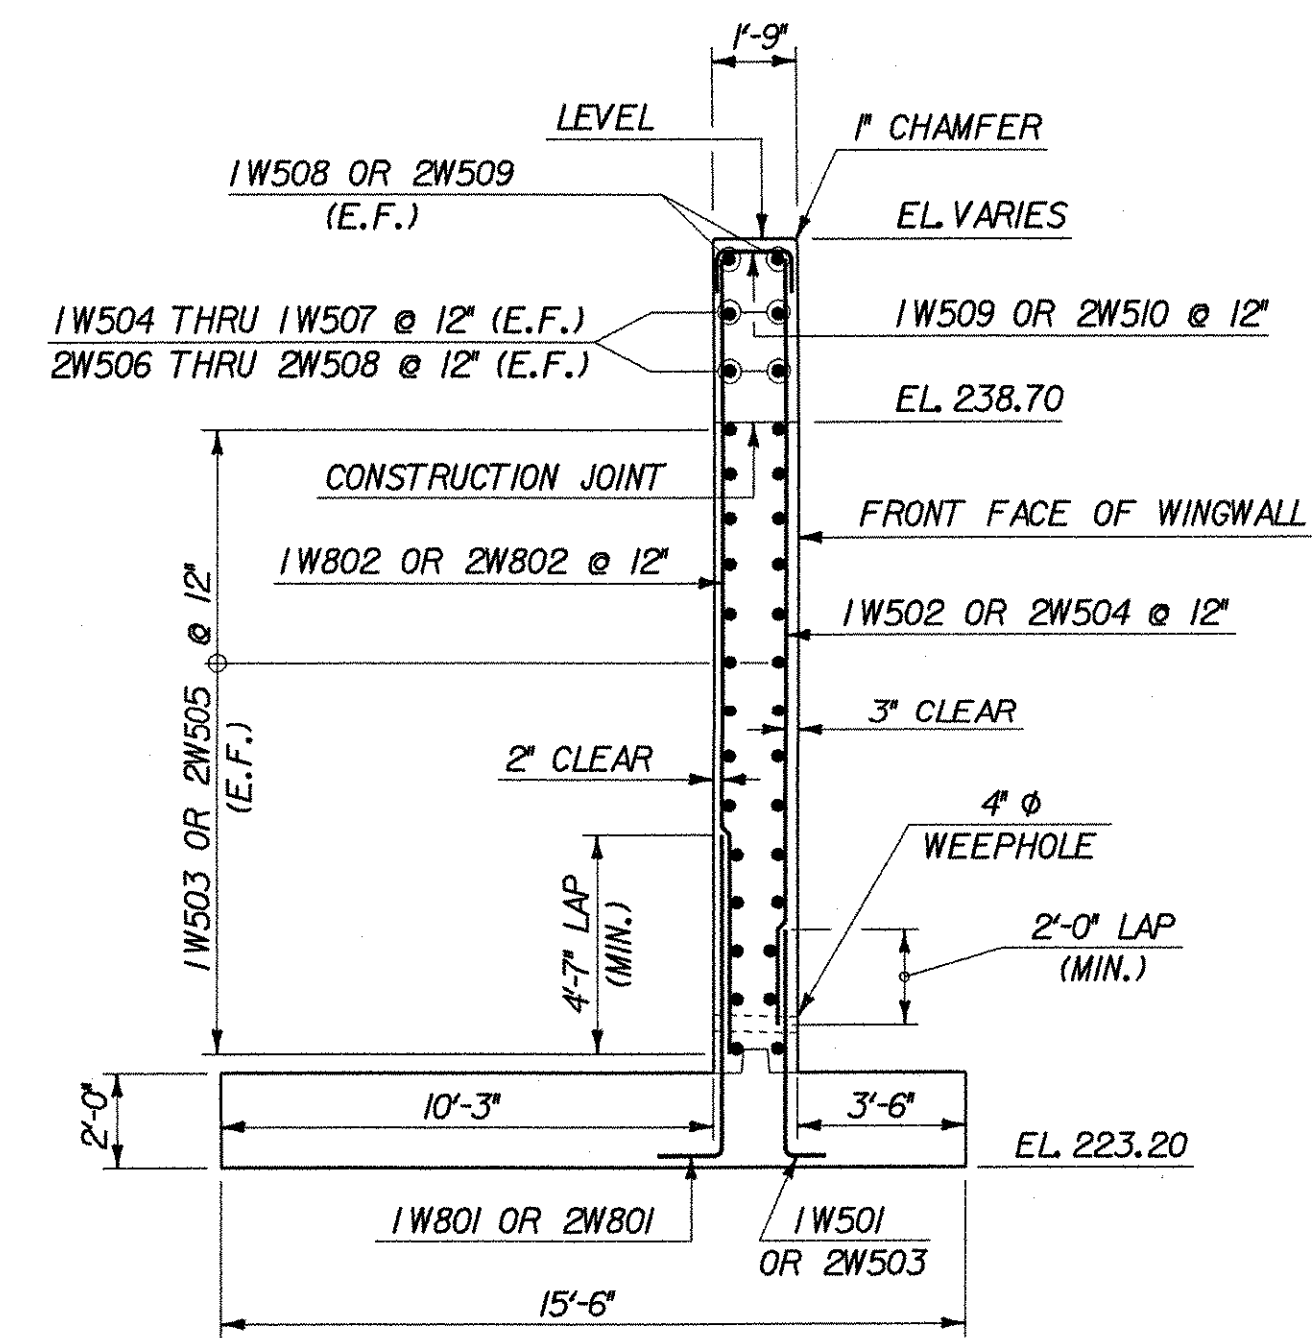

WINGWALL NO. 1 & NO. 2 TYPICAL SECTION
SCALE: 1/4" = 1'-0"

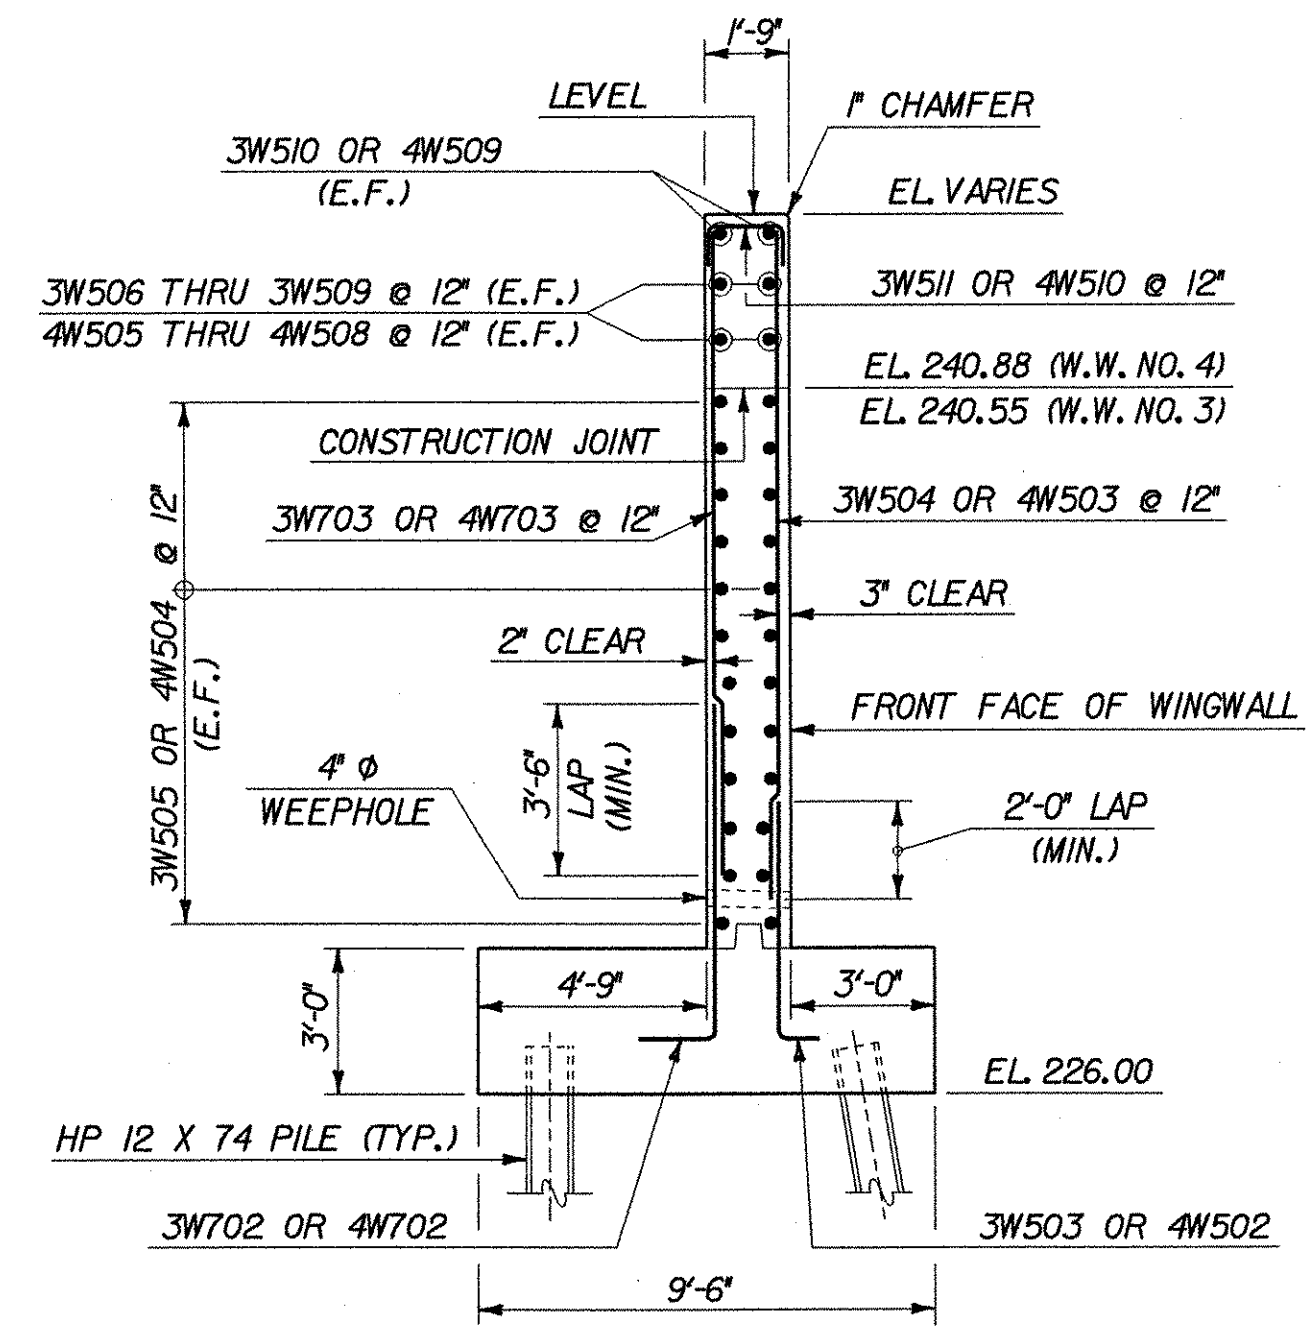

WINGWALL NO. 3 & NO. 4 TYPICAL SECTION
SCALE: 1/4" = 1'-0"


LEGEND

- N.F. = NEAR FACE
- F.F. = FAR FACE
- E.F. = EACH FACE
- ▲ = CUT TO FIT IN FIELD




STATE OF VERMONT AGENCY OF TRANSPORTATION	
Town Of SHELBURNE	Bridge No. 15
Highway No. TH 3	Log Sta. Surv. Sta.
BOSTWICK ROAD OVER VERMONT RAILWAY	
WINGWALL DETAILS	
Designed By L. WIXSON	Drawn By S. MERKMAN
Checked By R. JOY	Date 05/03
Bridge Design Supervisor M. ZYDEL Date 05/03	
PROJECT SHELBURNE	PROJECT NO. BRO 1445(30)
I.G.C. Info. MN595402 BostwickBRIDGE6m/12/196wvd.dgn	
Bridge Sheet No. BRI17	Sheet 57 of 73


PLOTTED 01-AUG-2003

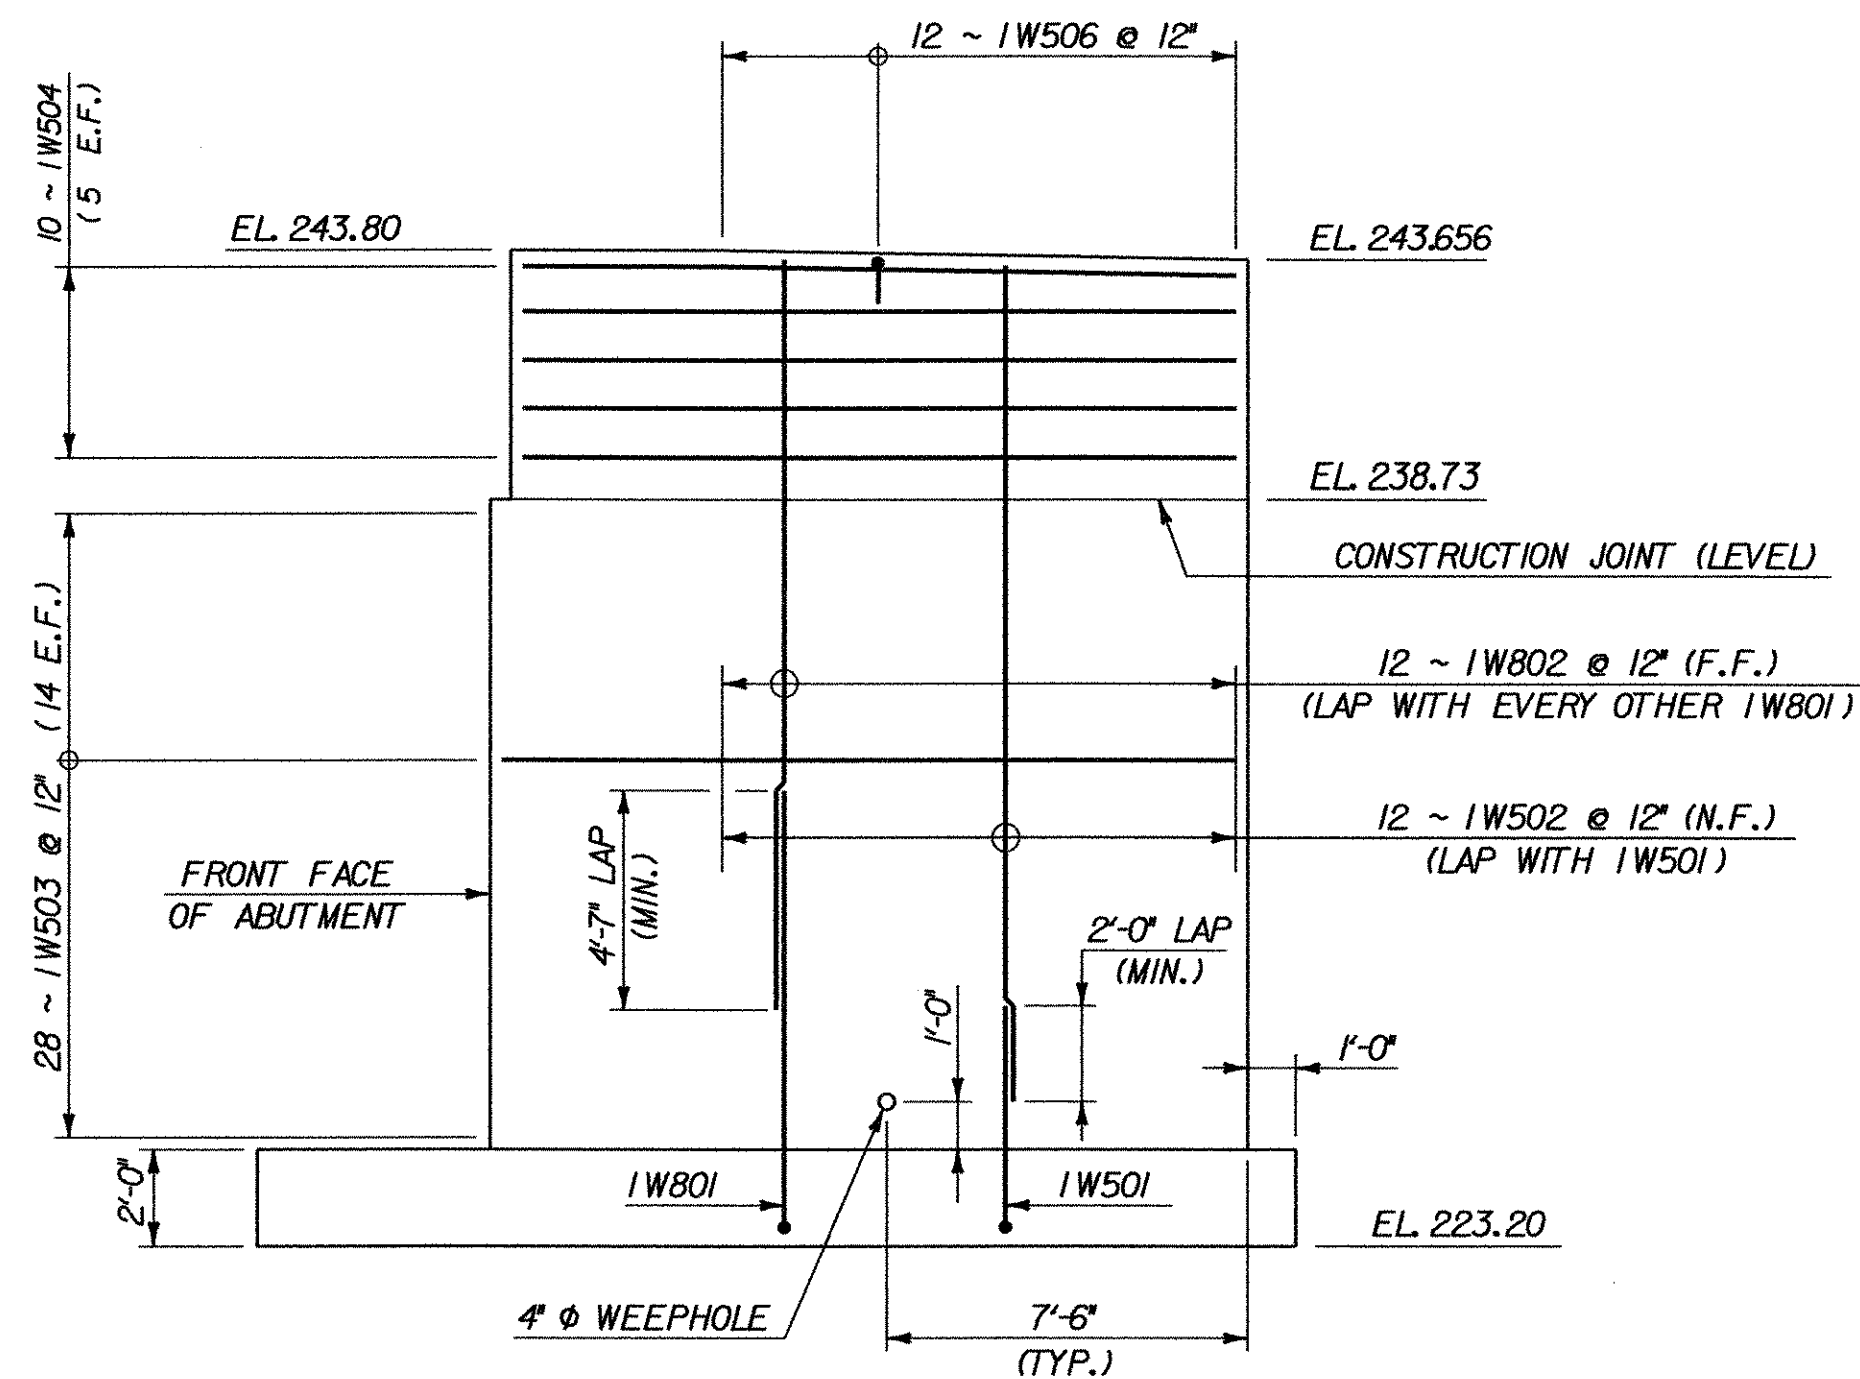


WINGWALL NO. 1 ELEVATION
SCALE: 1/4" = 1'-0"

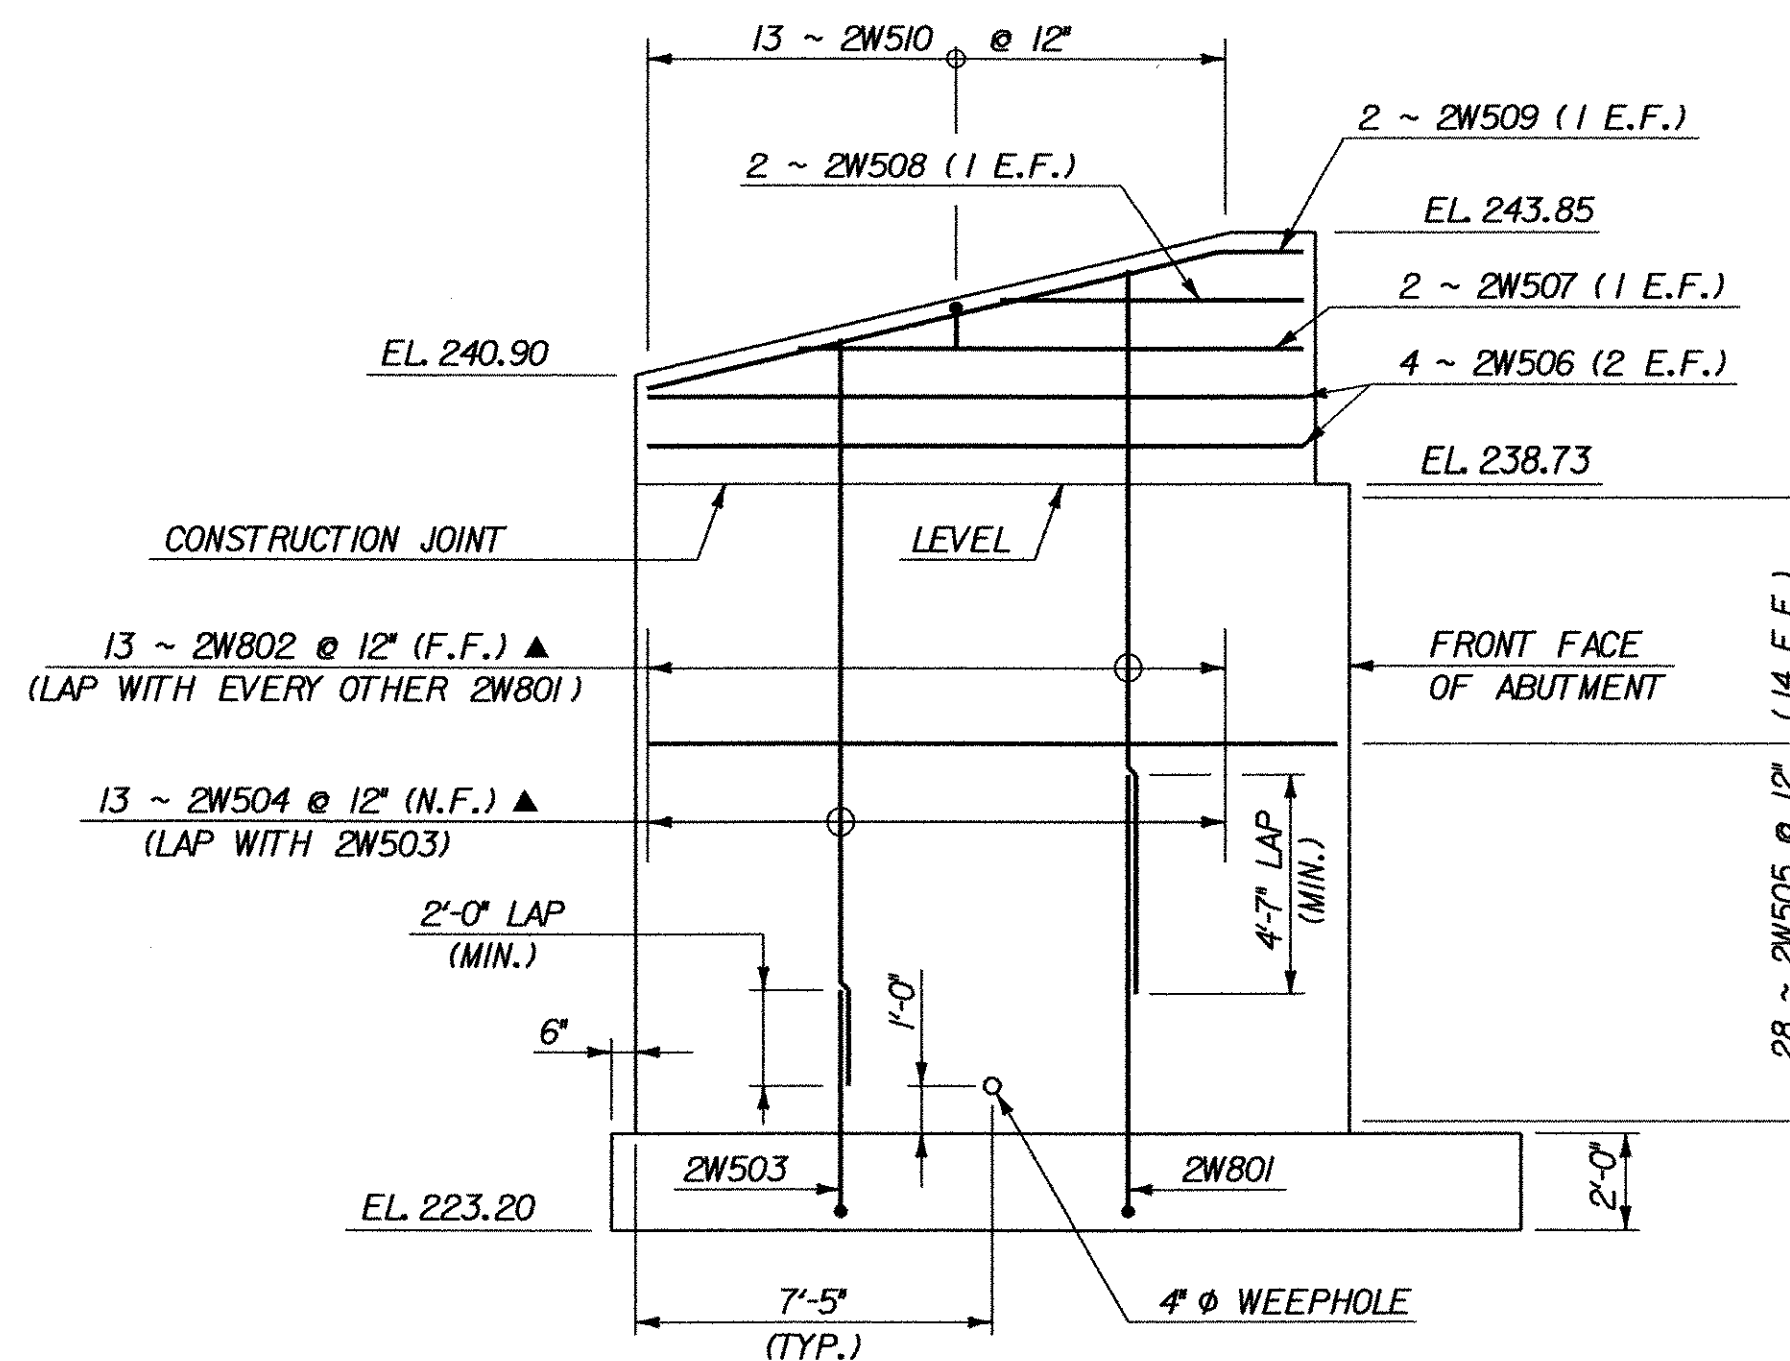


WINGWALL NO. 2 ELEVATION
SCALE: 1/4" = 1'-0"

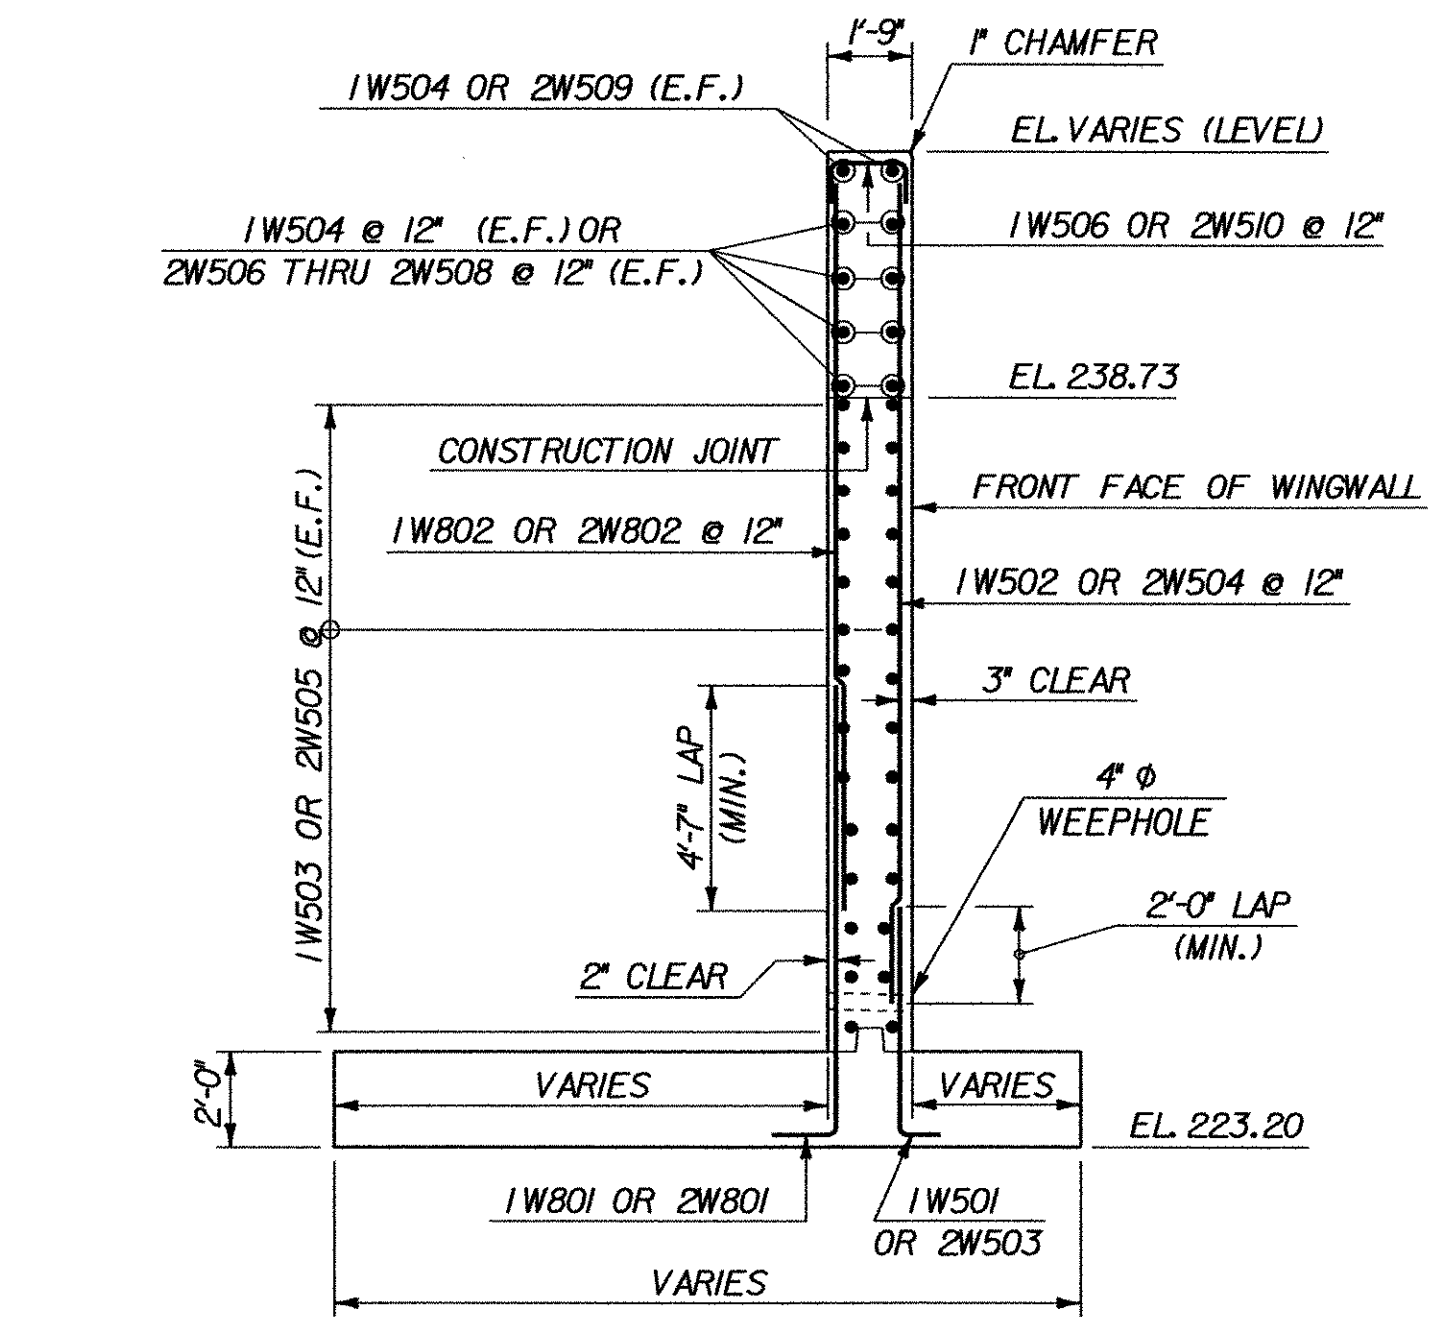


WINGWALL NO. 1 & NO. 2 TYPICAL SECTION
SCALE: 1/4" = 1'-0"

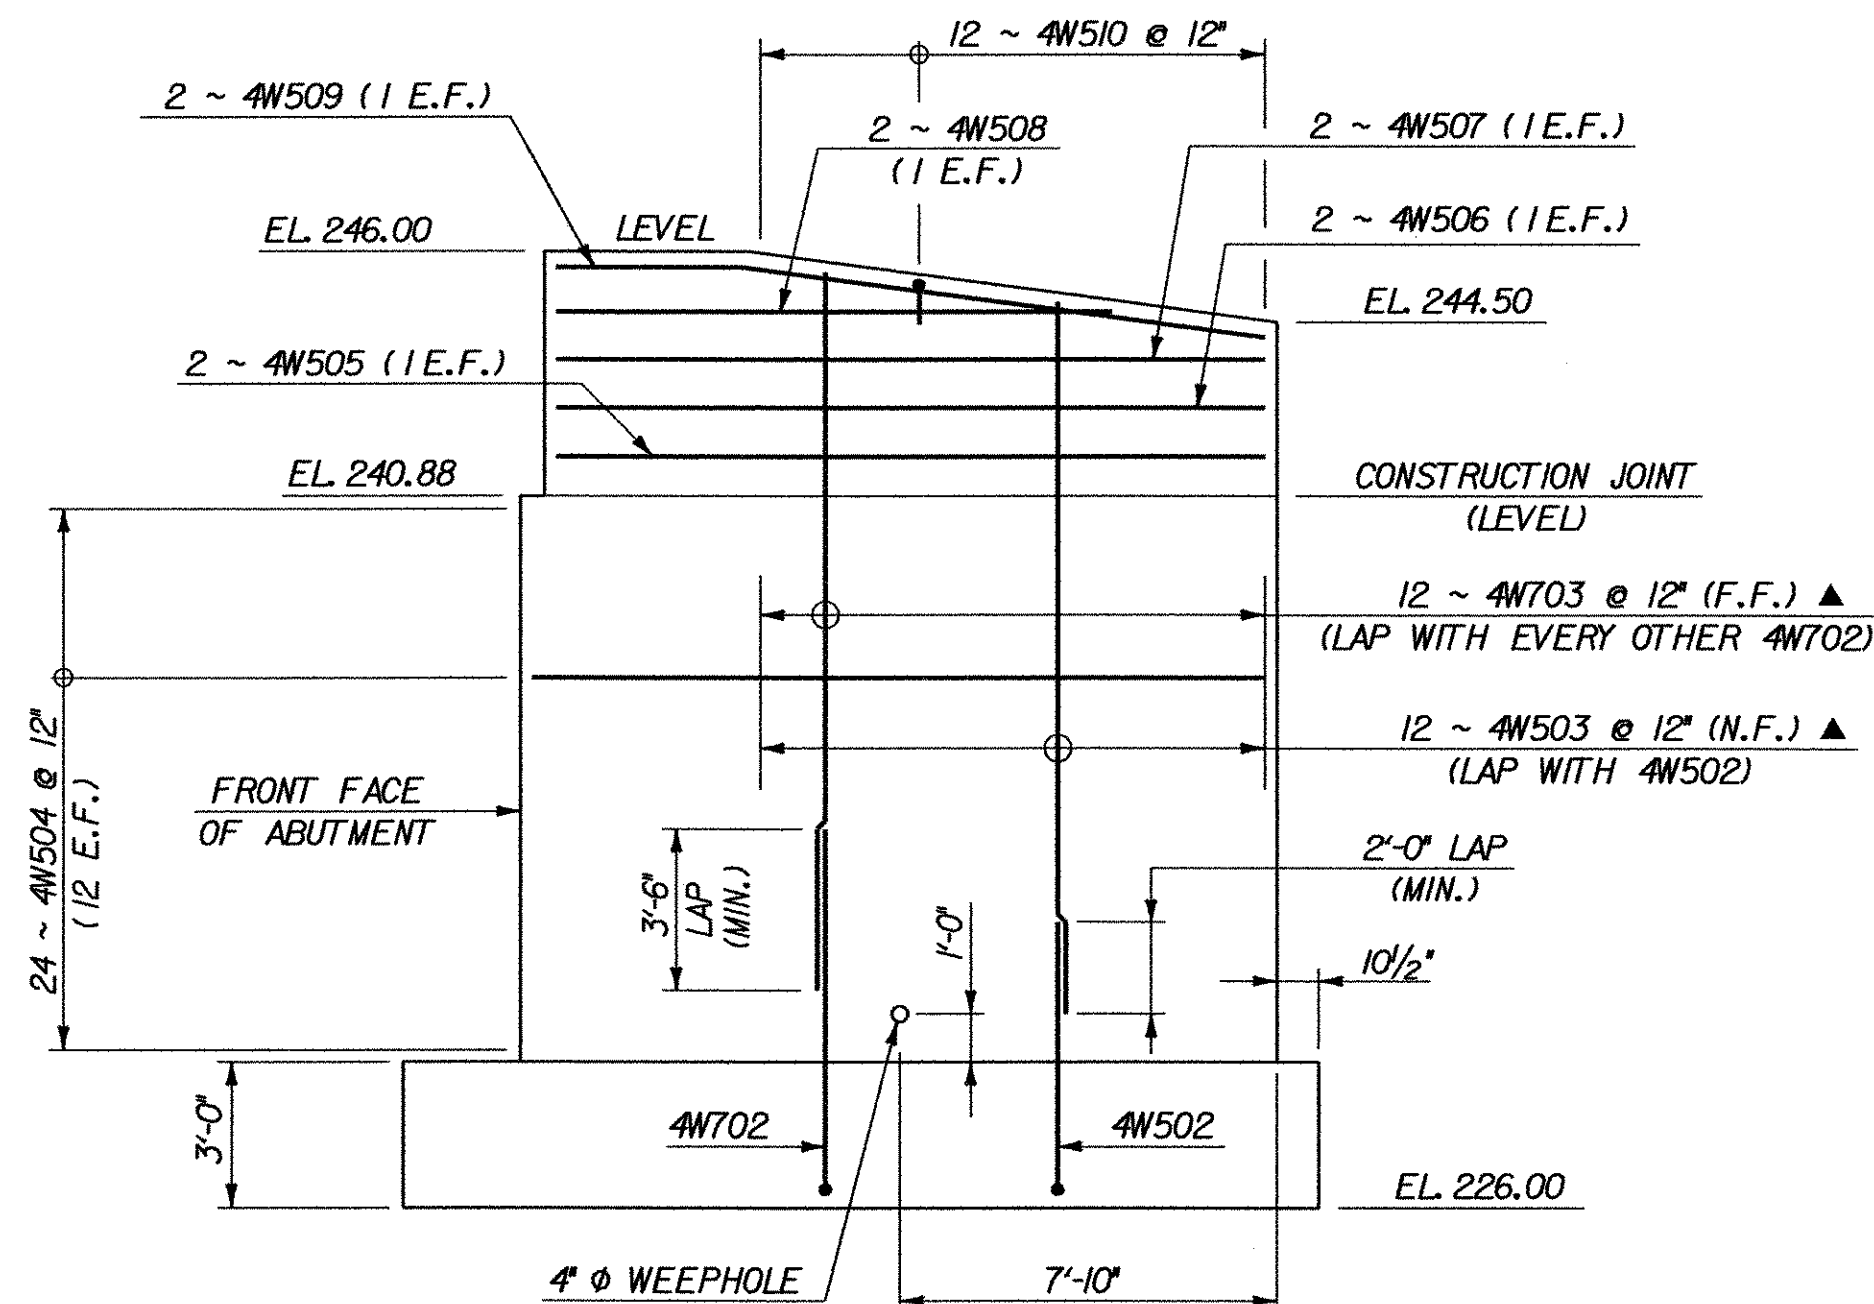

WINGWALL NO. 4 ELEVATION
SCALE: 1/4" = 1'-0"

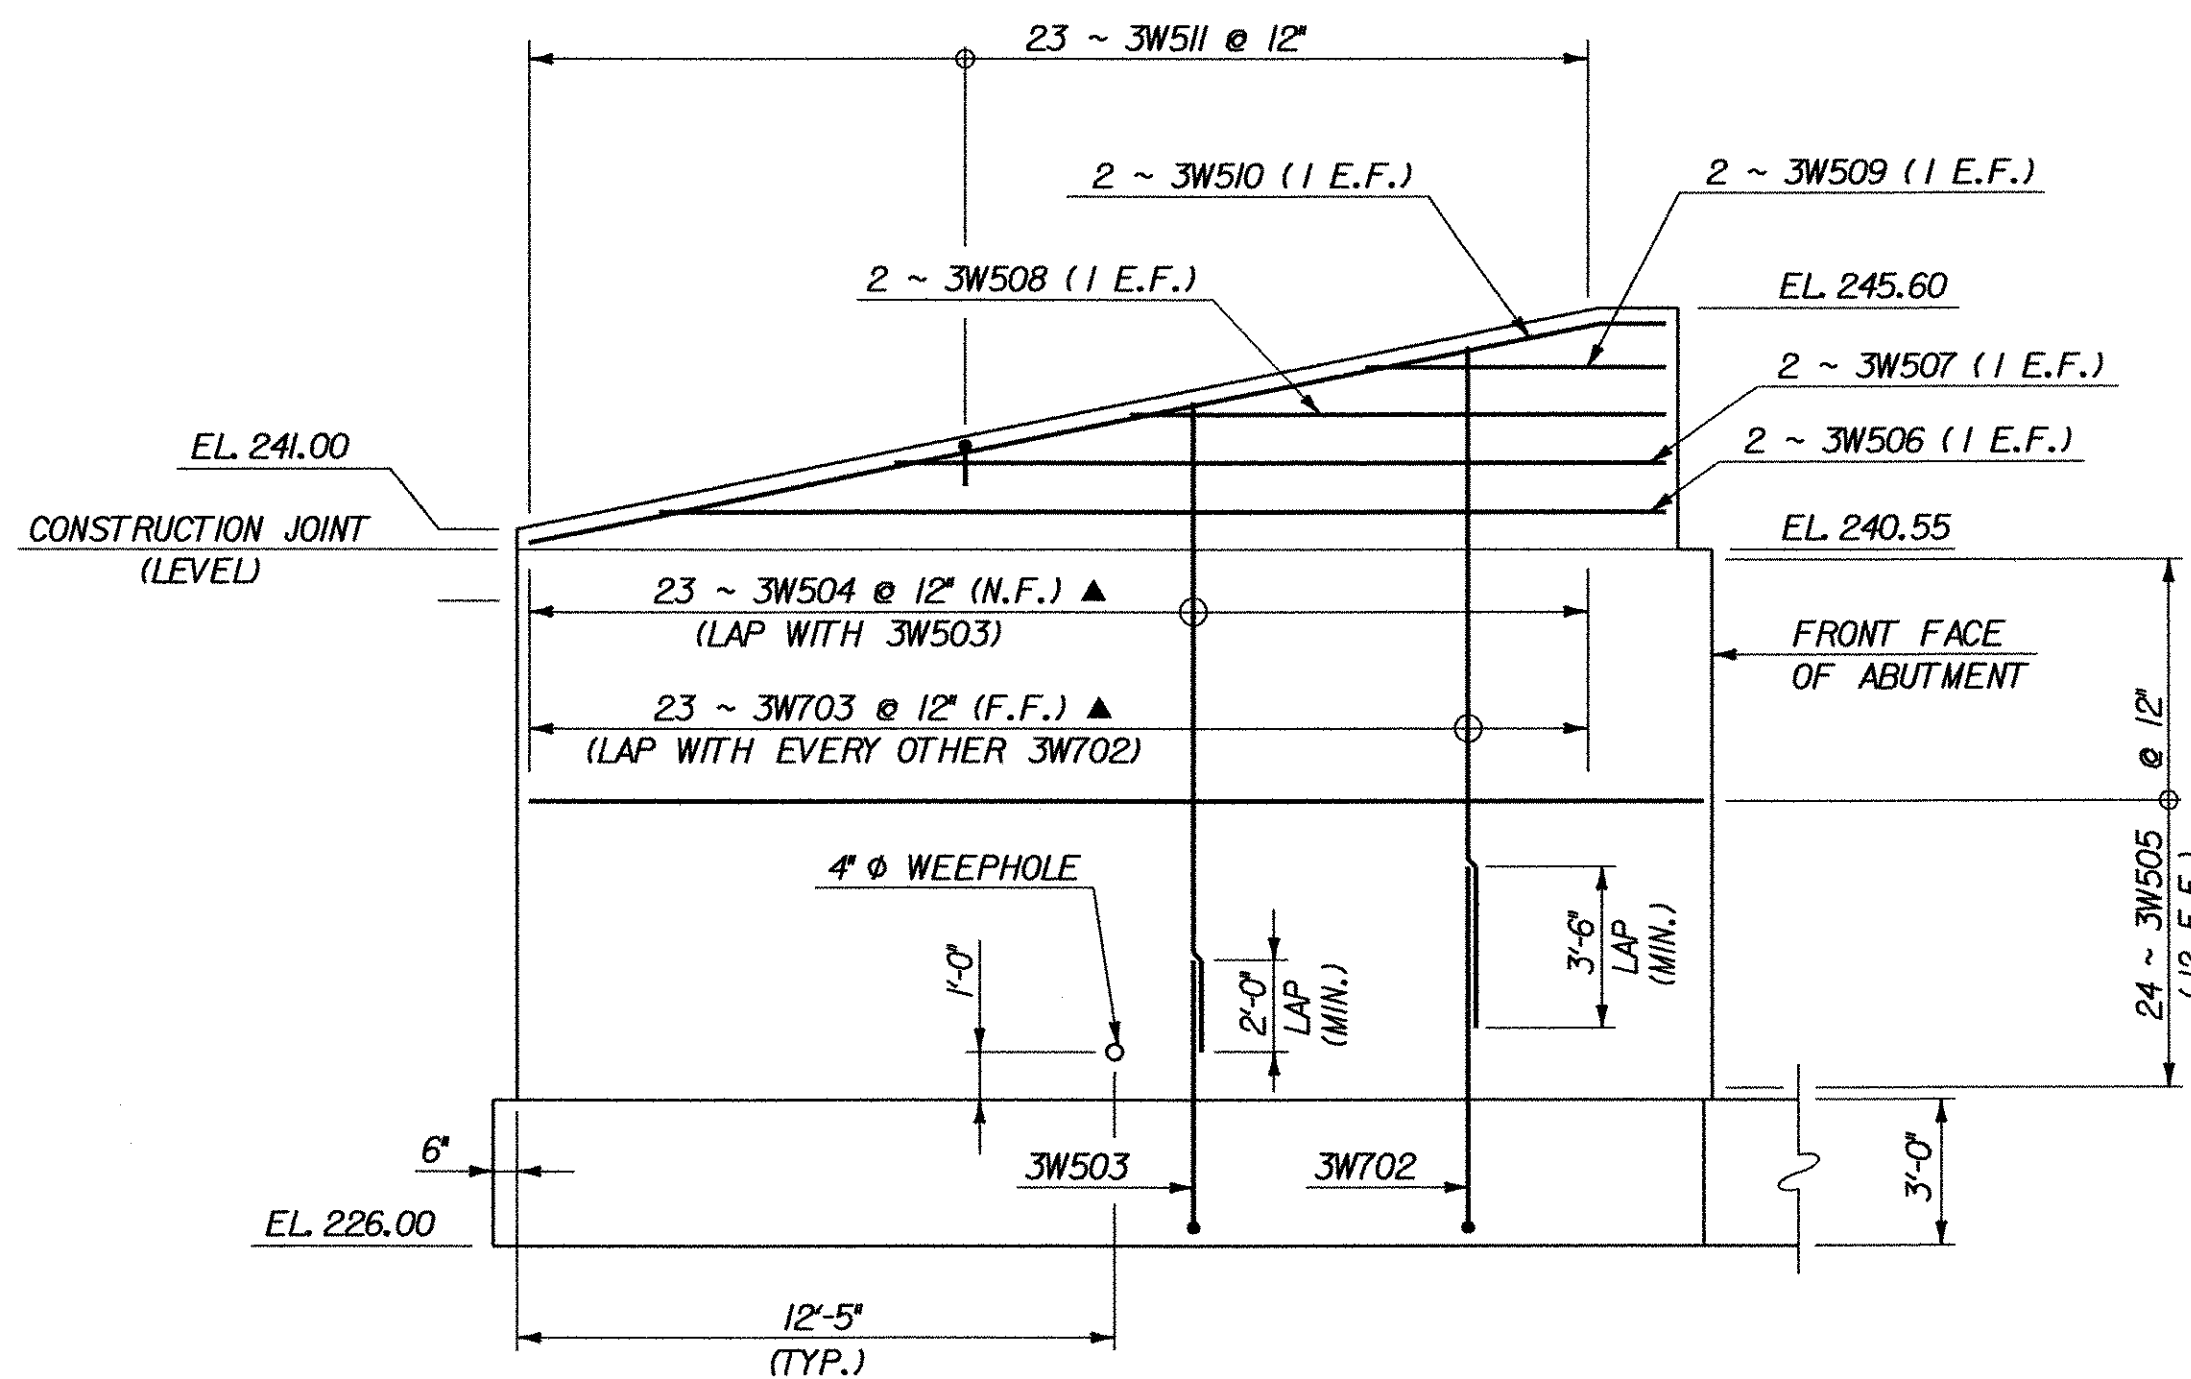

WINGWALL NO. 3 ELEVATION
SCALE: 1/4" = 1'-0"

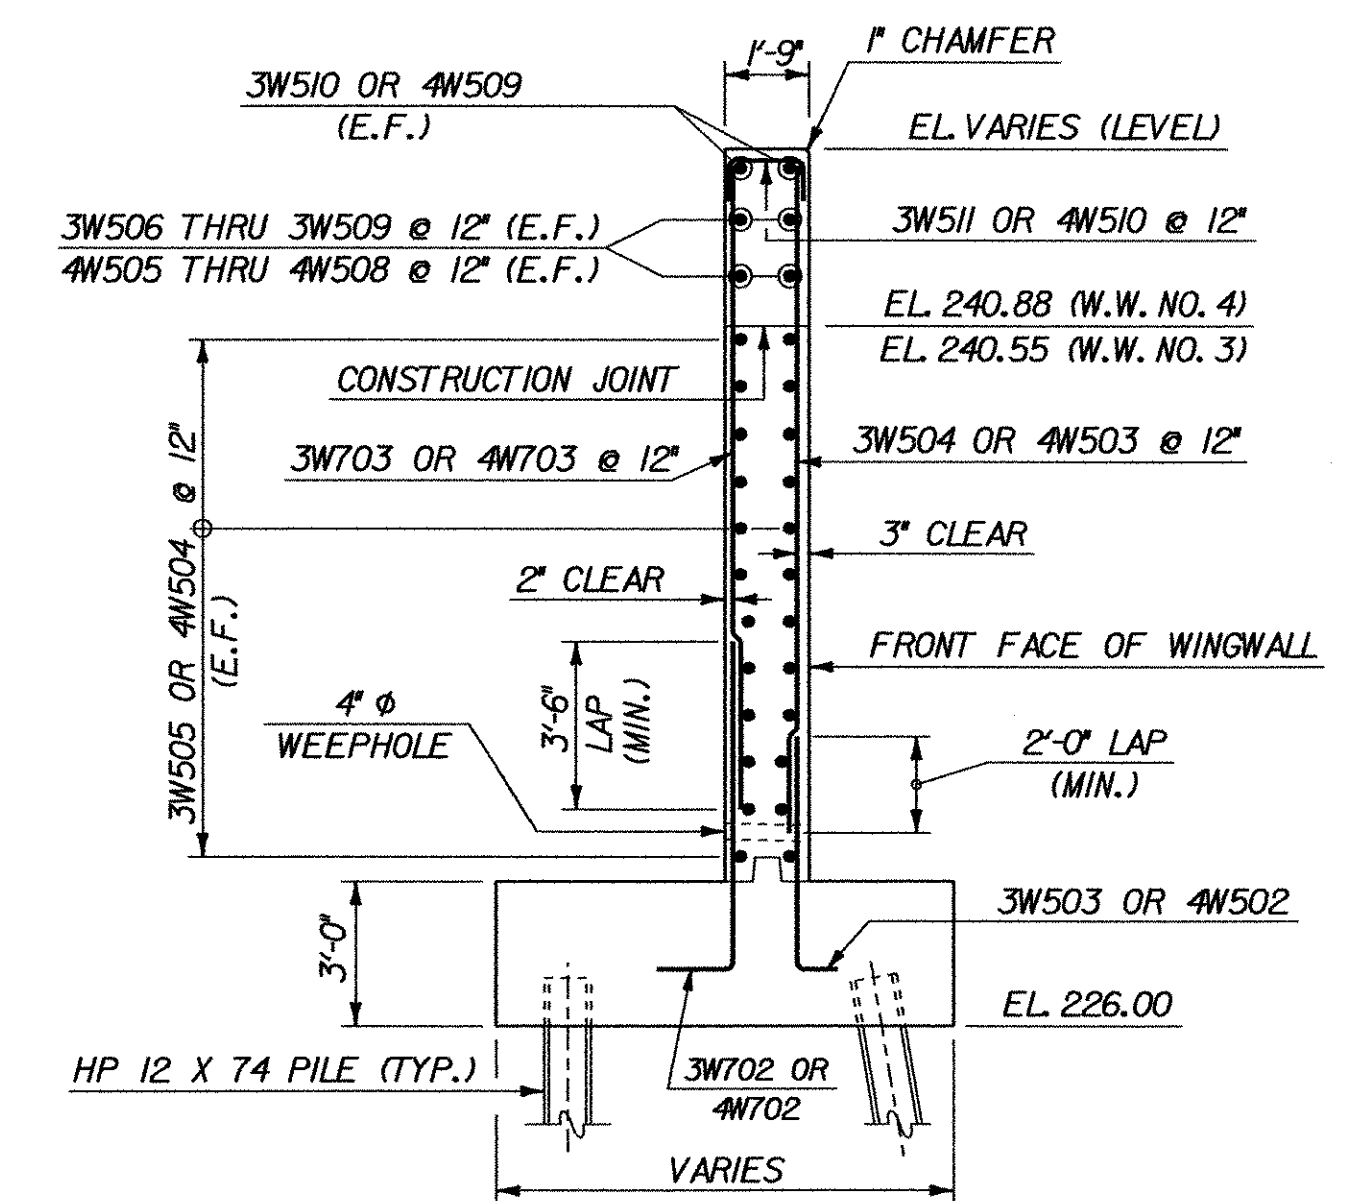

WINGWALL NO. 3 & NO. 4 TYPICAL SECTION
SCALE: 1/4" = 1'-0"

LEGEND

- N.F. = NEAR FACE
- F.F. = FAR FACE
- E.F. = EACH FACE
- ▲ = CUT TO FIT IN FIELD

- ▲ WINGWALL NO. 4 LAYOUT REVISED
- ▲ WINGWALL NO. 1 LAYOUT REVISED

**STATE OF VERMONT
AGENCY OF TRANSPORTATION**

Town Of	SHELBURNE	Bridge No.	15
Highway No.	TH 3	Log Sta.	
		Surv. Sta.	
BOSTWICK ROAD OVER VERMONT RAILWAY			
WINGWALL DETAILS (REVISED)			
Designed By	L. WIXSON / S. DELIA	Drawn By	S. MERKMAN / S. DELIA
Checked By	R. JOY	Date	03/04
		Bridge Design Supervisor	M. ZYDEL
		Date	03/04
PROJECT	SHELBURNE	PROJECT NO.	BRO 1445(30)
I.G.C. Info. @ Structures STR3_Roger Whitcomb/Consultants/McFarland-Johnson/Sherburne			
Bridge Sheet No.	BR117B	Sheet	57B of 73



NO.	PIECES	SIZE	LENGTH	MARK	TYPE	A	B	C	D	E	F	G	H	J	K	R	O	NO.	PIECES	SIZE	LENGTH	MARK	TYPE	A	B	C	D	E	F	G	H	J	K	R	O																																																																																																																																																																																																																																																																																																																																																																																																																																																																																																																																			
DECK																		WINGWALL NO. 2																																																																																																																																																																																																																																																																																																																																																																																																																																																																																																																																																				
380	5	36-1	ES501	STR														32	5	13-0	2W501	STR																																																																																																																																																																																																																																																																																																																																																																																																																																																																																																																																																
234	5	32-4	ES502	STR														8	5	7-10	2W502	STR																																																																																																																																																																																																																																																																																																																																																																																																																																																																																																																																																
175	5	5-1	ES503	S5	0-10	1-4 1/2	0-8	1-4 1/2				0-10						13	5	5-7	2W503	17	0-0	4-9	0-10																																																																																																																																																																																																																																																																																																																																																																																																																																																																																																																																													
4	5	1-6	ES504	STR														13	5	17-5	2W504	STR																																																																																																																																																																																																																																																																																																																																																																																																																																																																																																																																																
9	5	4-3	ES505	STR														28	5	14-4	2W505	STR																																																																																																																																																																																																																																																																																																																																																																																																																																																																																																																																																
4	5	33-8	ES506	STR														4	5	13-7 1/2	2W506	STR																																																																																																																																																																																																																																																																																																																																																																																																																																																																																																																																																
48	5	9-5	ES507	S5	0-11.5	3-5	0-8	3-5				0-11.5						2	5	11-3 1/2	2W507	STR																																																																																																																																																																																																																																																																																																																																																																																																																																																																																																																																																
70	5	4-10	ES508	16	1-0	1-4	0-7	1-11					1-4 1/4		1-4 1/4			3	5	7-1	2W508	STR																																																																																																																																																																																																																																																																																																																																																																																																																																																																																																																																																
36	8	3-0	ES801	16	0-0	0-0	2-0	1-0					0-8 1/2		0-8 1/2			2	5	14-1	2W509	22	1-5 1/2	12-7 1/2	0-0			0-4	0-0	1-5	0-0																																																																																																																																																																																																																																																																																																																																																																																																																																																																																																																																							
APPROACH SLABS																		WINGWALL NO. 3																																																																																																																																																																																																																																																																																																																																																																																																																																																																																																																																																				
21	5	33-7	EAS501	STR														20	5	20-4	3W501	STR																																																																																																																																																																																																																																																																																																																																																																																																																																																																																																																																																
20	5	34-2	EAS502	STR														9	5	6-9	3W502	STR																																																																																																																																																																																																																																																																																																																																																																																																																																																																																																																																																
73	9	20-9	EAS901	I	1-3	19-6						0-0		11 1/4				23	5	5-10	3W503	17	0-0	5-0	0-10																																																																																																																																																																																																																																																																																																																																																																																																																																																																																																																																													
ABUTMENT 1																		WINGWALL NO. 4																																																																																																																																																																																																																																																																																																																																																																																																																																																																																																																																																				
48	5	5-7	IA501	17		0-0	4-9	0-10										10	5	16-6	4W501	STR																																																																																																																																																																																																																																																																																																																																																																																																																																																																																																																																																
48	5	12-6	IA502	STR														12	5	5-10	4W502	17	0-0	5-0	0-10																																																																																																																																																																																																																																																																																																																																																																																																																																																																																																																																													
20	5	6-10	IA503	STR														12	5	15-9	4W503	STR																																																																																																																																																																																																																																																																																																																																																																																																																																																																																																																																																
58	5	22-5	IA504	STR														24	5	14-0	4W504	STR																																																																																																																																																																																																																																																																																																																																																																																																																																																																																																																																																
14	5	9-8	IA505	22		2-0	5-8	2-0				1-5	1-5	1-5	1-5			2	5	13-6	4W505	STR																																																																																																																																																																																																																																																																																																																																																																																																																																																																																																																																																
14	5	4-0	IA506	17			2-0	2-0										2	5	12-9 1/2	4W506	STR																																																																																																																																																																																																																																																																																																																																																																																																																																																																																																																																																
6	5	2-7	IA507	STR														2	5	9-6	4W507	STR																																																																																																																																																																																																																																																																																																																																																																																																																																																																																																																																																
6	5	2-3	IA508	22		0-11	1-4	0-0				0-8	0-0	0-8	0-0			3	5	6-2	4W508	STR																																																																																																																																																																																																																																																																																																																																																																																																																																																																																																																																																
28	5	6-1	IA509	22		2-2	3-11	0-0				1-6	0-0	1-6	0-0			2	5	14-0	4W509	22	2-2 1/2	11-9 1/2	0-0			0-7 1/4	0-0	2-1 1/2	0-0																																																																																																																																																																																																																																																																																																																																																																																																																																																																																																																																							
14	5	4-4	IA510	22		2-2	2-2	0-0				1-6	0-0	1-6	0-0			12	5	3-0	4W510	17	0-10	1-4	0-10																																																																																																																																																																																																																																																																																																																																																																																																																																																																																																																																													
12	5	4-9	IA511	22		1-4	3-5	0-0				0-11 1/2	0-0	0-11 1/2	0-0			10	6	16-6	4W601	STR																																																																																																																																																																																																																																																																																																																																																																																																																																																																																																																																																
44	5	3-3	IA512	17		0-10	1-7	0-10										19	6	9-0	4W602	STR																																																																																																																																																																																																																																																																																																																																																																																																																																																																																																																																																
33	6	34-0	IA601	STR														19	7	9-0	4W701	STR																																																																																																																																																																																																																																																																																																																																																																																																																																																																																																																																																
32	7	14-6	IA701	STR														23	7	10-10	4W702	17	0-0	9-6	1-4																																																																																																																																																																																																																																																																																																																																																																																																																																																																																																																																													
43	7	22-3	IA702	STR														12	7	12-9	4W703	STR																																																																																																																																																																																																																																																																																																																																																																																																																																																																																																																																																
32	10	14-6	IA1001	STR														WINGWALL NO. 1																																																																																																																																																																																																																																																																																																																																																																																																																																																																																																																																																				
44	10	9-7	IA1002	17		0-0	7-9	1-10										ABUTMENT 2																		WINGWALL NO. 2																		39	5	9-6	2A501	STR														13	5	5-7	1W501	17	0-0	4-9	0-10								48	5	6-2	2A502	17		0-0	5-4	0-10										13	5	17-4	1W502	STR											48	5	10-4	2A503	STR														28	5	14-6	1W503	STR											20	5	6-11	2A504	STR														2	5	14-0	1W504	STR										50	5	22-5	2A505	STR														2	5	12-4	1W505	STR									12	5	9-8	2A506	22		2-0	5-8	2-0				1-5	1-5	1-5	1-5			2	5	9-1 1/2	1W506	STR								12	5	4-0	2A507	17			2-0	2-0										3	5	5-11 1/2	1W507	STR								6	5	2-7	2A508	STR														2	5	14-6 1/2	1W508	22	2-2 1/2	12-4 1/4	0-0			0-8	0-0	2-1 1/4	0-0	6	5	2-3	2A509	22		0-11	1-4	0-0				0-8	0-0	0-8	0-0			13	5	3-0	1W509	17	0-10	1-4	0-10							24	5	6-1	2A510	22		2-2	3-11	0-0				1-6	0-0	1-6	0-0			16	7	20-0	1W701	STR									12	5	4-4	2A511	22		2-2	2-2	0-0				1-6	0-0	1-6	0-0			22	7	15-0	1W702	STR								12	5	4-9	2A512	22		1-4	3-5	0-0				0-11 1/2	0-0	0-11 1/2	0-0			24	8	10-7	1W801	17	0-0	9-3	1-4					44	5	3-3	2A513	17		0-10	1-7	0-10										14	8	15-5	1W802	STR							40	6	9-6	2A601	STR														22	9	15-0	1W901	STR						45	7	23-5	2A701	STR														17	10	20-0	1W1001	STR					43	8	8-8	2A801	17		0-0	7-4	1-4										44	8	11-0	2A802	STR													
ABUTMENT 2																		WINGWALL NO. 2																																																																																																																																																																																																																																																																																																																																																																																																																																																																																																																																																				
39	5	9-6	2A501	STR														13	5	5-7	1W501	17	0-0	4-9	0-10																																																																																																																																																																																																																																																																																																																																																																																																																																																																																																																																													
48	5	6-2	2A502	17		0-0	5-4	0-10										13	5	17-4	1W502	STR																																																																																																																																																																																																																																																																																																																																																																																																																																																																																																																																																
48	5	10-4	2A503	STR														28	5	14-6	1W503	STR																																																																																																																																																																																																																																																																																																																																																																																																																																																																																																																																																
20	5	6-11	2A504	STR														2	5	14-0	1W504	STR																																																																																																																																																																																																																																																																																																																																																																																																																																																																																																																																																
50	5	22-5	2A505	STR														2	5	12-4	1W505	STR																																																																																																																																																																																																																																																																																																																																																																																																																																																																																																																																																
12	5	9-8	2A506	22		2-0	5-8	2-0				1-5	1-5	1-5	1-5			2	5	9-1 1/2	1W506	STR																																																																																																																																																																																																																																																																																																																																																																																																																																																																																																																																																
12	5	4-0	2A507	17			2-0	2-0										3	5	5-11 1/2	1W507	STR																																																																																																																																																																																																																																																																																																																																																																																																																																																																																																																																																
6	5	2-7	2A508	STR														2	5	14-6 1/2	1W508	22	2-2 1/2	12-4 1/4	0-0			0-8	0-0	2-1 1/4	0-0																																																																																																																																																																																																																																																																																																																																																																																																																																																																																																																																							
6	5	2-3	2A509	22		0-11	1-4	0-0				0-8	0-0	0-8	0-0			13	5	3-0	1W509	17	0-10	1-4	0-10																																																																																																																																																																																																																																																																																																																																																																																																																																																																																																																																													
24	5	6-1	2A510	22		2-2	3-11	0-0				1-6	0-0	1-6	0-0			16	7	20-0	1W701	STR																																																																																																																																																																																																																																																																																																																																																																																																																																																																																																																																																
12	5	4-4	2A511	22		2-2	2-2	0-0				1-6	0-0	1-6	0-0			22	7	15-0	1W702	STR																																																																																																																																																																																																																																																																																																																																																																																																																																																																																																																																																
12	5	4-9	2A512	22		1-4	3-5	0-0				0-11 1/2	0-0	0-11 1/2	0-0			24	8	10-7	1W801	17	0-0	9-3	1-4																																																																																																																																																																																																																																																																																																																																																																																																																																																																																																																																													
44	5	3-3	2A513	17		0-10	1-7	0-10										14	8	15-5	1W802	STR																																																																																																																																																																																																																																																																																																																																																																																																																																																																																																																																																
40	6	9-6	2A601	STR														22	9	15-0	1W901	STR																																																																																																																																																																																																																																																																																																																																																																																																																																																																																																																																																
45	7	23-5	2A701	STR														17	10	20-0	1W1001	STR																																																																																																																																																																																																																																																																																																																																																																																																																																																																																																																																																
43	8	8-8	2A801	17		0-0	7-4	1-4																																																																																																																																																																																																																																																																																																																																																																																																																																																																																																																																																														
44	8	11-0	2A802	STR																																																																																																																																																																																																																																																																																																																																																																																																																																																																																																																																																																		

~ NOTES ~

- UNLESS OTHERWISE DESIGNATED, ALL BAR REINFORCEMENT FOR CONCRETE IN SIZES UP TO AND INCLUDING NO. 18 SHALL CONFORM TO THE REQUIREMENTS OF THE "SPECIFICATIONS FOR DEFORMED BILLET-STEEL BARS FOR CONCRETE REINFORCEMENT", AASHTO M 31 (ASTM A 615-SI). ALL BARS SHALL BE GRADE 60, UNLESS OTHERWISE DESIGNATED.
- FOR TYPICAL BENDING DETAILS, RECOMMENDED PIN DIAMETER "D" OF BENDS AND HOOKS, AND OTHER STANDARD PRACTICE, SEE CURRENT CONCRETE REINFORCING STEEL INSTITUTE "MANUAL OF STANDARD PRACTICE".
- BARS WHICH REQUIRE MORE ACCURATE BENDING THAN STANDARD PRACTICES SHOULD HAVE LIMITS INDICATED.
- ALL DIMENSIONS ARE OUT TO OUT OF BAR EXCEPT "A" AND "G" ON STANDARD 180 DEGREE AND 135 DEGREE HOOKS.
- "J" DIMENSION ON 180 DEGREE HOOKS TO BE SHOWN ONLY WHERE NECESSARY TO RESTRICT HOOK SIZE, OTHERWISE, STANDARD HOOKS ARE TO BE USED.
- "H" DIMENSION ON STIRRUPS TO BE SHOWN ONLY WHEN NECESSARY TO MAINTAIN CLEARANCES.
- WHERE SLOPE DIFFERS FROM 45 DEGREES, DIMENSIONS "H" AND "K" MUST BE SHOWN.
- ▲ DENOTES BARS TO BE CUT IN FIELD.
- * DENOTES ONE EXTRA BAR ADDED FOR TESTING PURPOSES.
- △ DENOTES TWO EXTRA BARS ADDED FOR TESTING PURPOSES.
- "E" IN PREFIX DENOTES EPOXY COATED REINFORCING STEEL.

ASTM STANDARD REINFORCING BARS				
BAR SIZE DESIGNATION	WEIGHT POUNDS PER FOOT	NOMINAL DIMENSIONS ROUND SECTION		
		DIAMETER INCHES	CROSS SECTIONAL AREA SQ. INCHES	PERIMETER INCHES
#3	.376	.375	.11	1.178
#4	.668	.500	.20	1.571
#5	1.043	.625	.31	1.963
#6	1.502	.750	.44	2.356
#7	2.044	.875	.60	2.749
#8	2.670	1.000	.79	3.142
#9	3.400	1.128	1.00	3.544
#10	4.303	1.270	1.27	3.990
#11	5.313	1.410	1.56	4.430
#14	7.65	1.693	2.25	5.32
#18	13.60	2.257	4.00	7.09

STATE OF VERMONT
AGENCY OF TRANSPORTATION






Town Of **SHELBURNE** Bridge No. **15**
 Highway No. **TH 3** Log Sta. _____
 Surv. Sta. _____

BOSTWICK ROAD OVER VERMONT RAILWAY
REINFORCING STEEL SCHEDULE

Designed By **L. WIXSON** Drawn By **S. MERKMAN**
 Checked By _____ Date _____ Bridge Design Supervisor _____ Date _____


PROJECT **SHELBURNE** PROJECT NO. **BRO 1445(30)**
 I.G.C. Info. **m\595402 Bostwick\BRIDGE\6m\10\2\116rshdgn**
 Bridge Sheet No. **BRI18** Sheet **58** of **73**



ITEM NO.	PIECES	SIZE	LENGTH	MARK	TYPE	A	B	C	D	E	F	G	H	J	K	R	O	ITEM NO.	PIECES	SIZE	LENGTH	MARK	TYPE	A	B	C	D	E	F	G	H	J	K	R	O			
DECK																		WINGWALL NO. 2																				
5	380	5	36-1	ES501	STR													103	32	5	13-0	2W501	STR															
6	234	5	32-4	ES502	STR													104	8	5	7-10	2W502	STR															
7	175	5	5-1	ES503	S5	0-10	1-4 1/2	0-8	1-4 1/2			0-10						105	13	5	5-7	2W503	17	0-0	4-9	0-10												
8	4	5	1-6	ES504	STR													106	13	5	17-5	2W504	STR															
9	9	5	4-3	ES505	STR													107	28	5	14-4	2W505	STR															
10	4	5	33-8	ES506	STR													108	4	5	13-7 1/2	2W506	STR															
11	48	5	9-5	ES507	S5	0-11.5	3-5	0-8	3-5			0-11.5						109	2	5	11-3 1/2	2W507	STR															
12	70	5	4-10	ES508	16	1-0	1-4	0-7	1-11				1-4 1/4		1-4 1/4			110	3	5	7-1	2W508	STR	1-5 1/2	12-7 1/2	0-0			0-4	0-0	1-5	0-0						
13	36	8	3-0	ES801	16	0-0	0-0	2-0	1-0				0-8 1/2		0-8 1/2			111	2	5	14-1	2W509	22	0-10	1-4	0-10												
APPROACH SLABS																		WINGWALL NO. 3																				
20	21	5	33-7	EAS501	STR													117	20	5	20-4	3W501	STR															
21	20	5	34-2	EAS502	STR													118	9	5	6-9	3W502	STR															
22	73	9	20-9	EAS901	I	1-3	19-6					0-0			11 1/4			119	23	5	5-10	3W503	17	0-0	5-0	0-10												
ABUTMENT 1																		WINGWALL NO. 4																				
29	49	5	5-7	IA501	17		0-0	4-9	0-10									120	23	5	15-4	3W504	STR	0-0	5-0	0-10												
30	49	5	12-6	IA502	STR													121	23	5	24-4	3W505	STR															
31	22	5	6-10	IA503	STR													122	2	5	21-11	3W506	STR															
32	58	5	22-9	IA504	STR													123	2	5	17-0	3W507	STR															
33	14	5	8-10	IA505	22		2-2	4-6	2-2				1-10 1/2	1-10 1/2	1-1	1-1		124	2	5	12-1 1/2	3W508	STR															
34	14	5	5-3	IA506	27	0-0	2-7 1/2	2-7	0-0				2-6		1-4			125	2	5	7-3	3W509	STR	1-4	22-9	0-0			0-3 1/4	0-0	1-3 1/4	0-0						
35	6	5	5-3	IA507	27	0-0	2-7 1/2	2-7	0-0				2-6		1-4			126	2	5	24-1	3W510	22	0-10	1-4	0-10												
36	6	5	2-0	IA508	STR													127	23	5	3-0	3W511	17															
37	28	5	6-1	IA509	22		2-2	3-11	0-0				1-6	0-0	1-6	0-0		128	2	5	9-0	3W601	STR															
38	14	5	4-4	IA510	22		2-2	2-2	0-0				1-6	0-0	1-6	0-0		129	2	5	9-0	3W701	STR															
39	12	5	4-9	IA511	22		1-4	3-5	0-0				0-11 1/2	0-0	0-11 1/2	0-0		130	45	7	10-10	3W702	17	0-0	9-6	1-4												
40	44	5	3-3	IA512	17		0-10	1-7	0-10									131	23	7	12-4	3W703	STR															
41	33	6	32-10	IA601	STR													132	10	5	18-4 1/2	4W501	STR	0-0	5-0	0-10												
42	14	6	14-0	IA602	STR													133	12	5	5-10	4W502	17															
43	27	7	14-6	IA701	STR													134	12	5	15-9	4W503	STR															
44	42	7	10-10	IA702	STR													135	24	5	14-8	4W504	STR															
45	9	7	16-9	IA703	STR													136	2	5	14-2	4W505	STR															
46	27	10	14-6	IA1001	STR													137	2	5	14-2	4W506	STR															
47	43	10	9-7	IA1002	17	0-0	7-9	1-10										138	3	5	10-11	4W508	STR															
48	9	10	16-9	IA1003	STR													139	2	5	14-3	4W509	22	3-5	10-10	0-0			0-5 1/2	0-0	3-4 1/2	0-0						
ABUTMENT 2																		WINGWALL NO. 1																				
53	38	5	9-6	2A501	STR													140	12	5	18-4 1/2	4W601	STR	0-0	1-4	0-10												
54	50	5	6-2	2A502	17	0-0	5-4	0-10										141	9	6	9-5	4W602	STR															
55	50	5	10-4	2A503	STR													142	9	7	9-5	4W701	STR															
56	22	5	6-11	2A504	STR													143	23	7	10-10	4W702	17	0-0	9-6	1-4												
57	50	5	22-11	2A505	STR													144	12	7	12-9	4W703	STR															
58	12	5	10-2 3/4	2A506	22		2-2	5-10 1/4	2-2				1-7	1-11	1-5 3/4	0-11 1/2		145	10	6	18-4 1/2	4W601	STR															
59	12	5	5-4	2A507	22		2-8	2-8	0-0				2-6	0-0	0-11	0-0		146	9	6	9-5	4W602	STR															
60	6	5	6-11	2A508	22		3-5 1/2	3-5 1/2	0-0				3-2 3/4	0-0	1-2 1/8	0-0		147	9	7	9-5	4W701	STR															
61	6	5	2-5 1/2	2A509	STR													148	23	7	10-10	4W702	17															
62	24	5	6-1	2A510	22		2-2	3-11	0-0				1-6	0-0	1-6	0-0		149	12	7	12-9	4W703	STR															
63	12	5	4-4	2A511	22		2-2	2-2	0-0				1-6	0-0	1-6	0-0		150	9	6	9-5	4W602	STR															
64	12	5	4-9	2A512	22		1-4	3-5	0-0				0-11 1/2	0-0	0-11 1/2	0-0		151	9	7	9-5	4W701	STR															
65	44	5	3-3	2A513	17		0-10	1-7	0-10									152	23	7	10-10	4W702	17															
66	39	6	9-6	2A601	STR													153	12	7	12-9	4W703	STR															
67	45	7	25-9	2A701	STR																																	

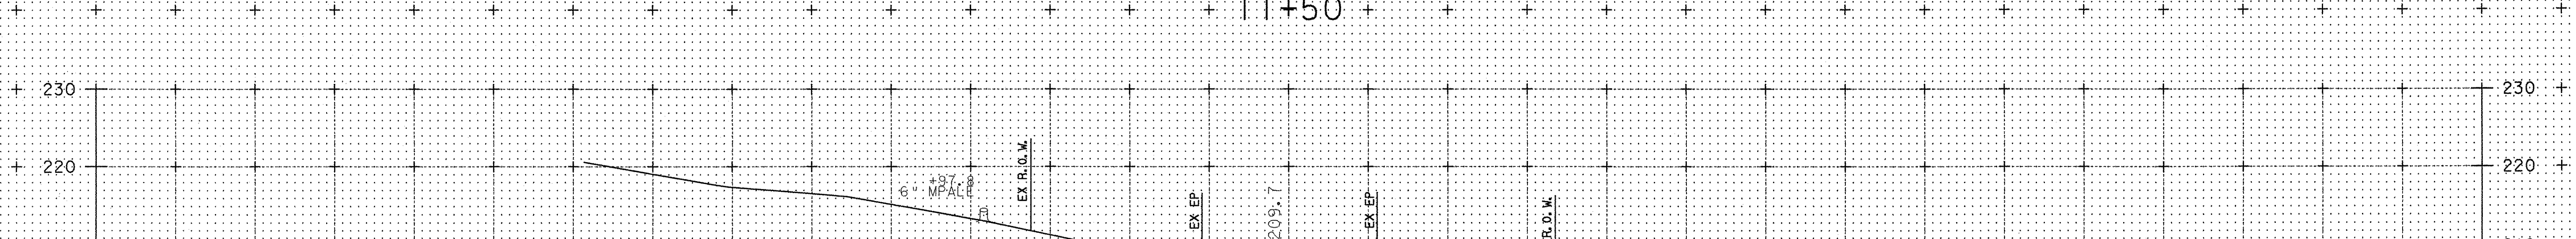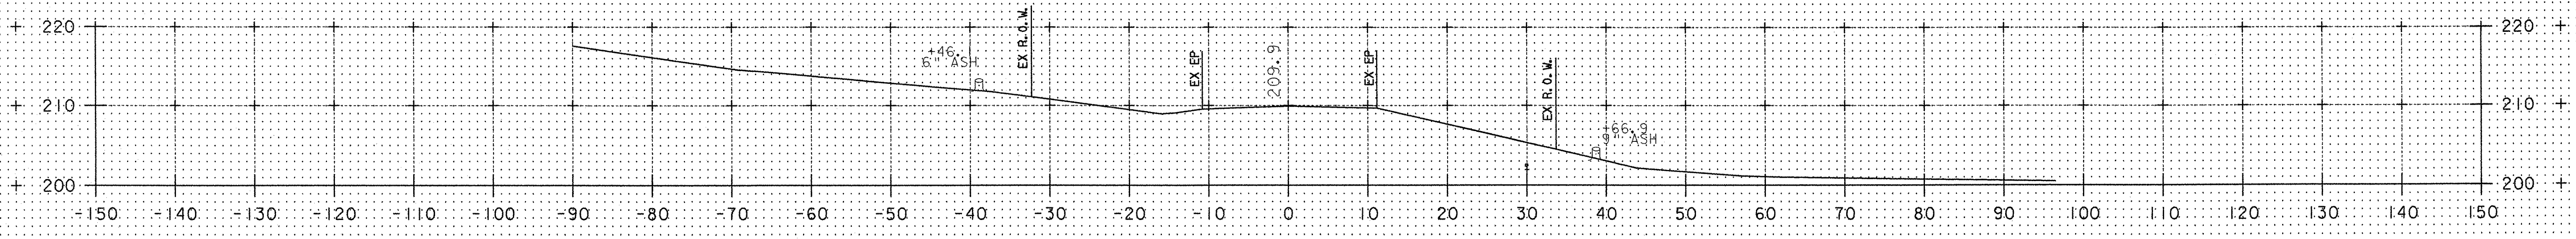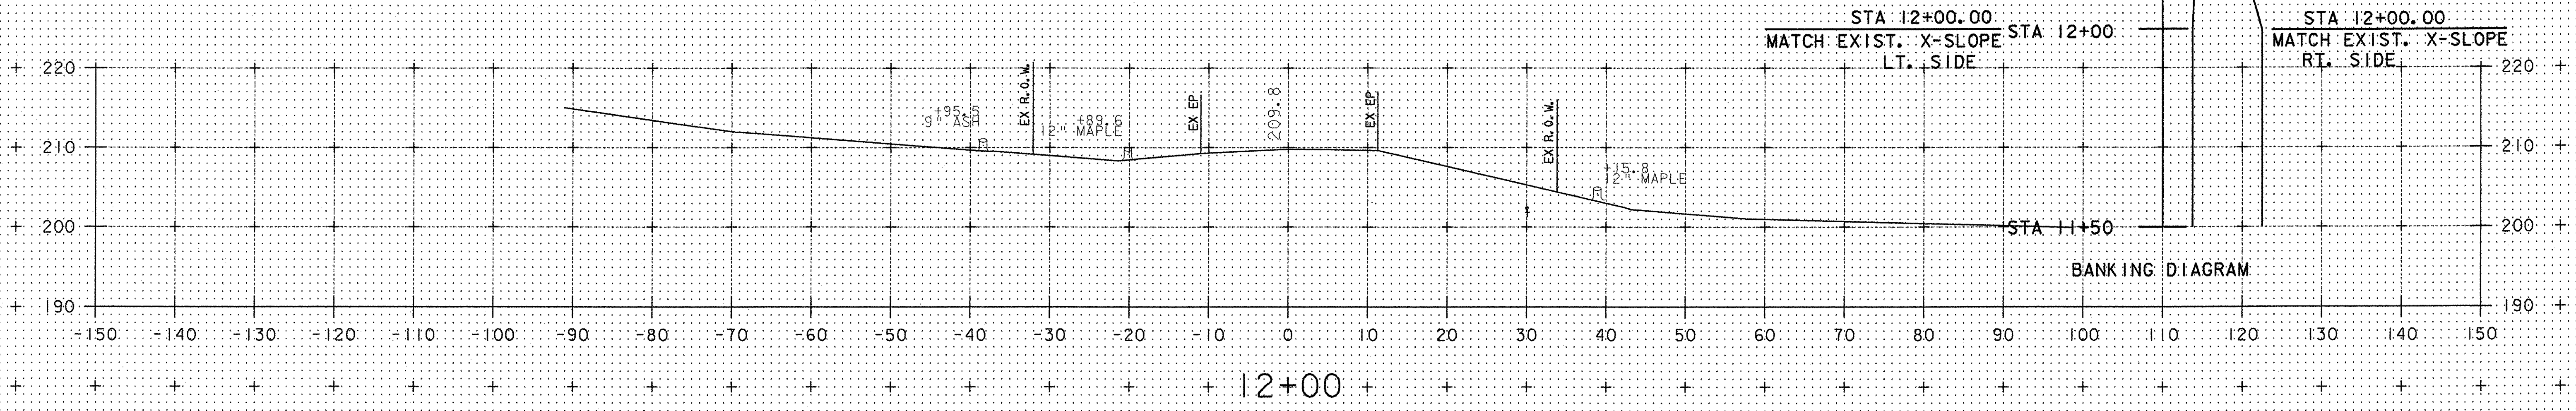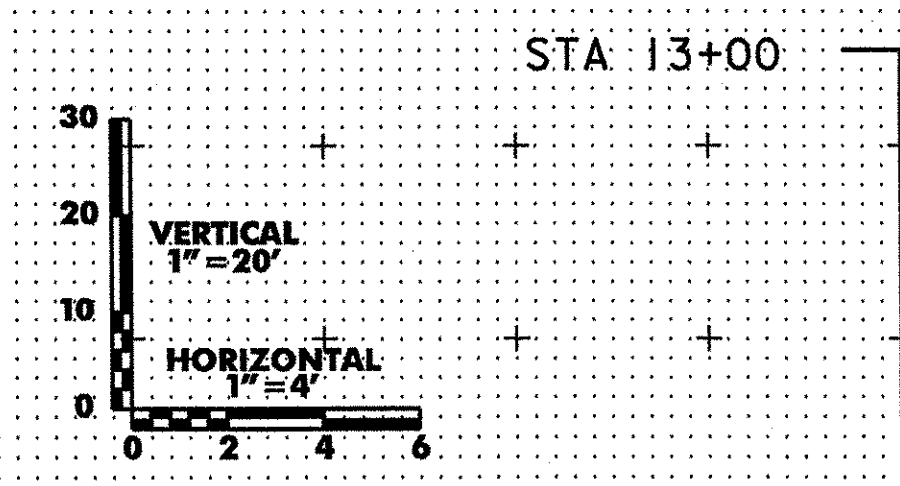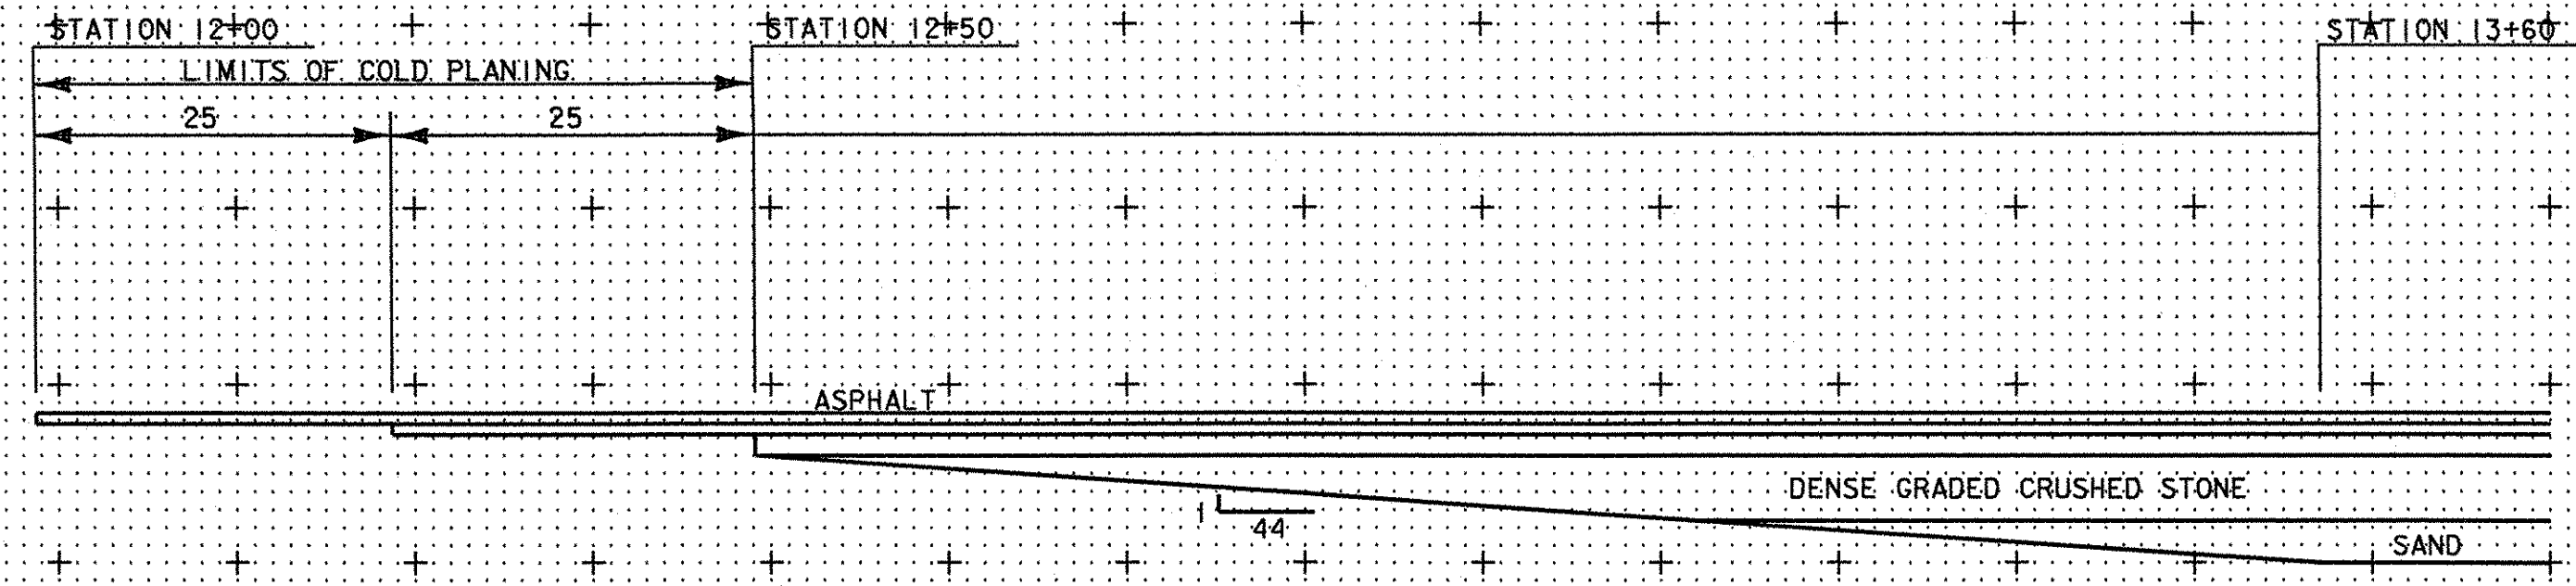


BOSTWICK ROAD

PROJECT NAME:	SHELBURNE
PROJECT NUMBER:	BRO 1445(30)
FILE NAME:	M:\1595402 Bostwick\HWY\DRAW\J196wrk.dgn
PROJECT LEADER:	MBZ
DESIGNED BY:	DMB
CHECKED BY:	MDL
PLOT DATE:	01-AUG-2003
DRAWN BY:	DMB
SHEET	59 OF 73

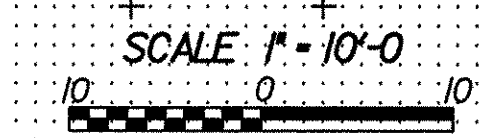


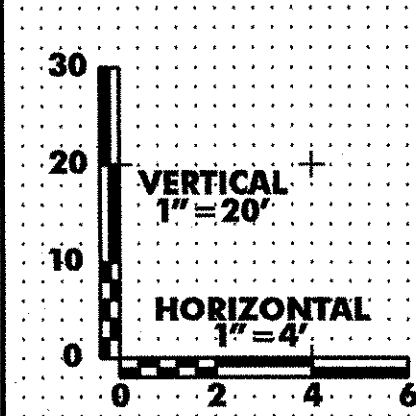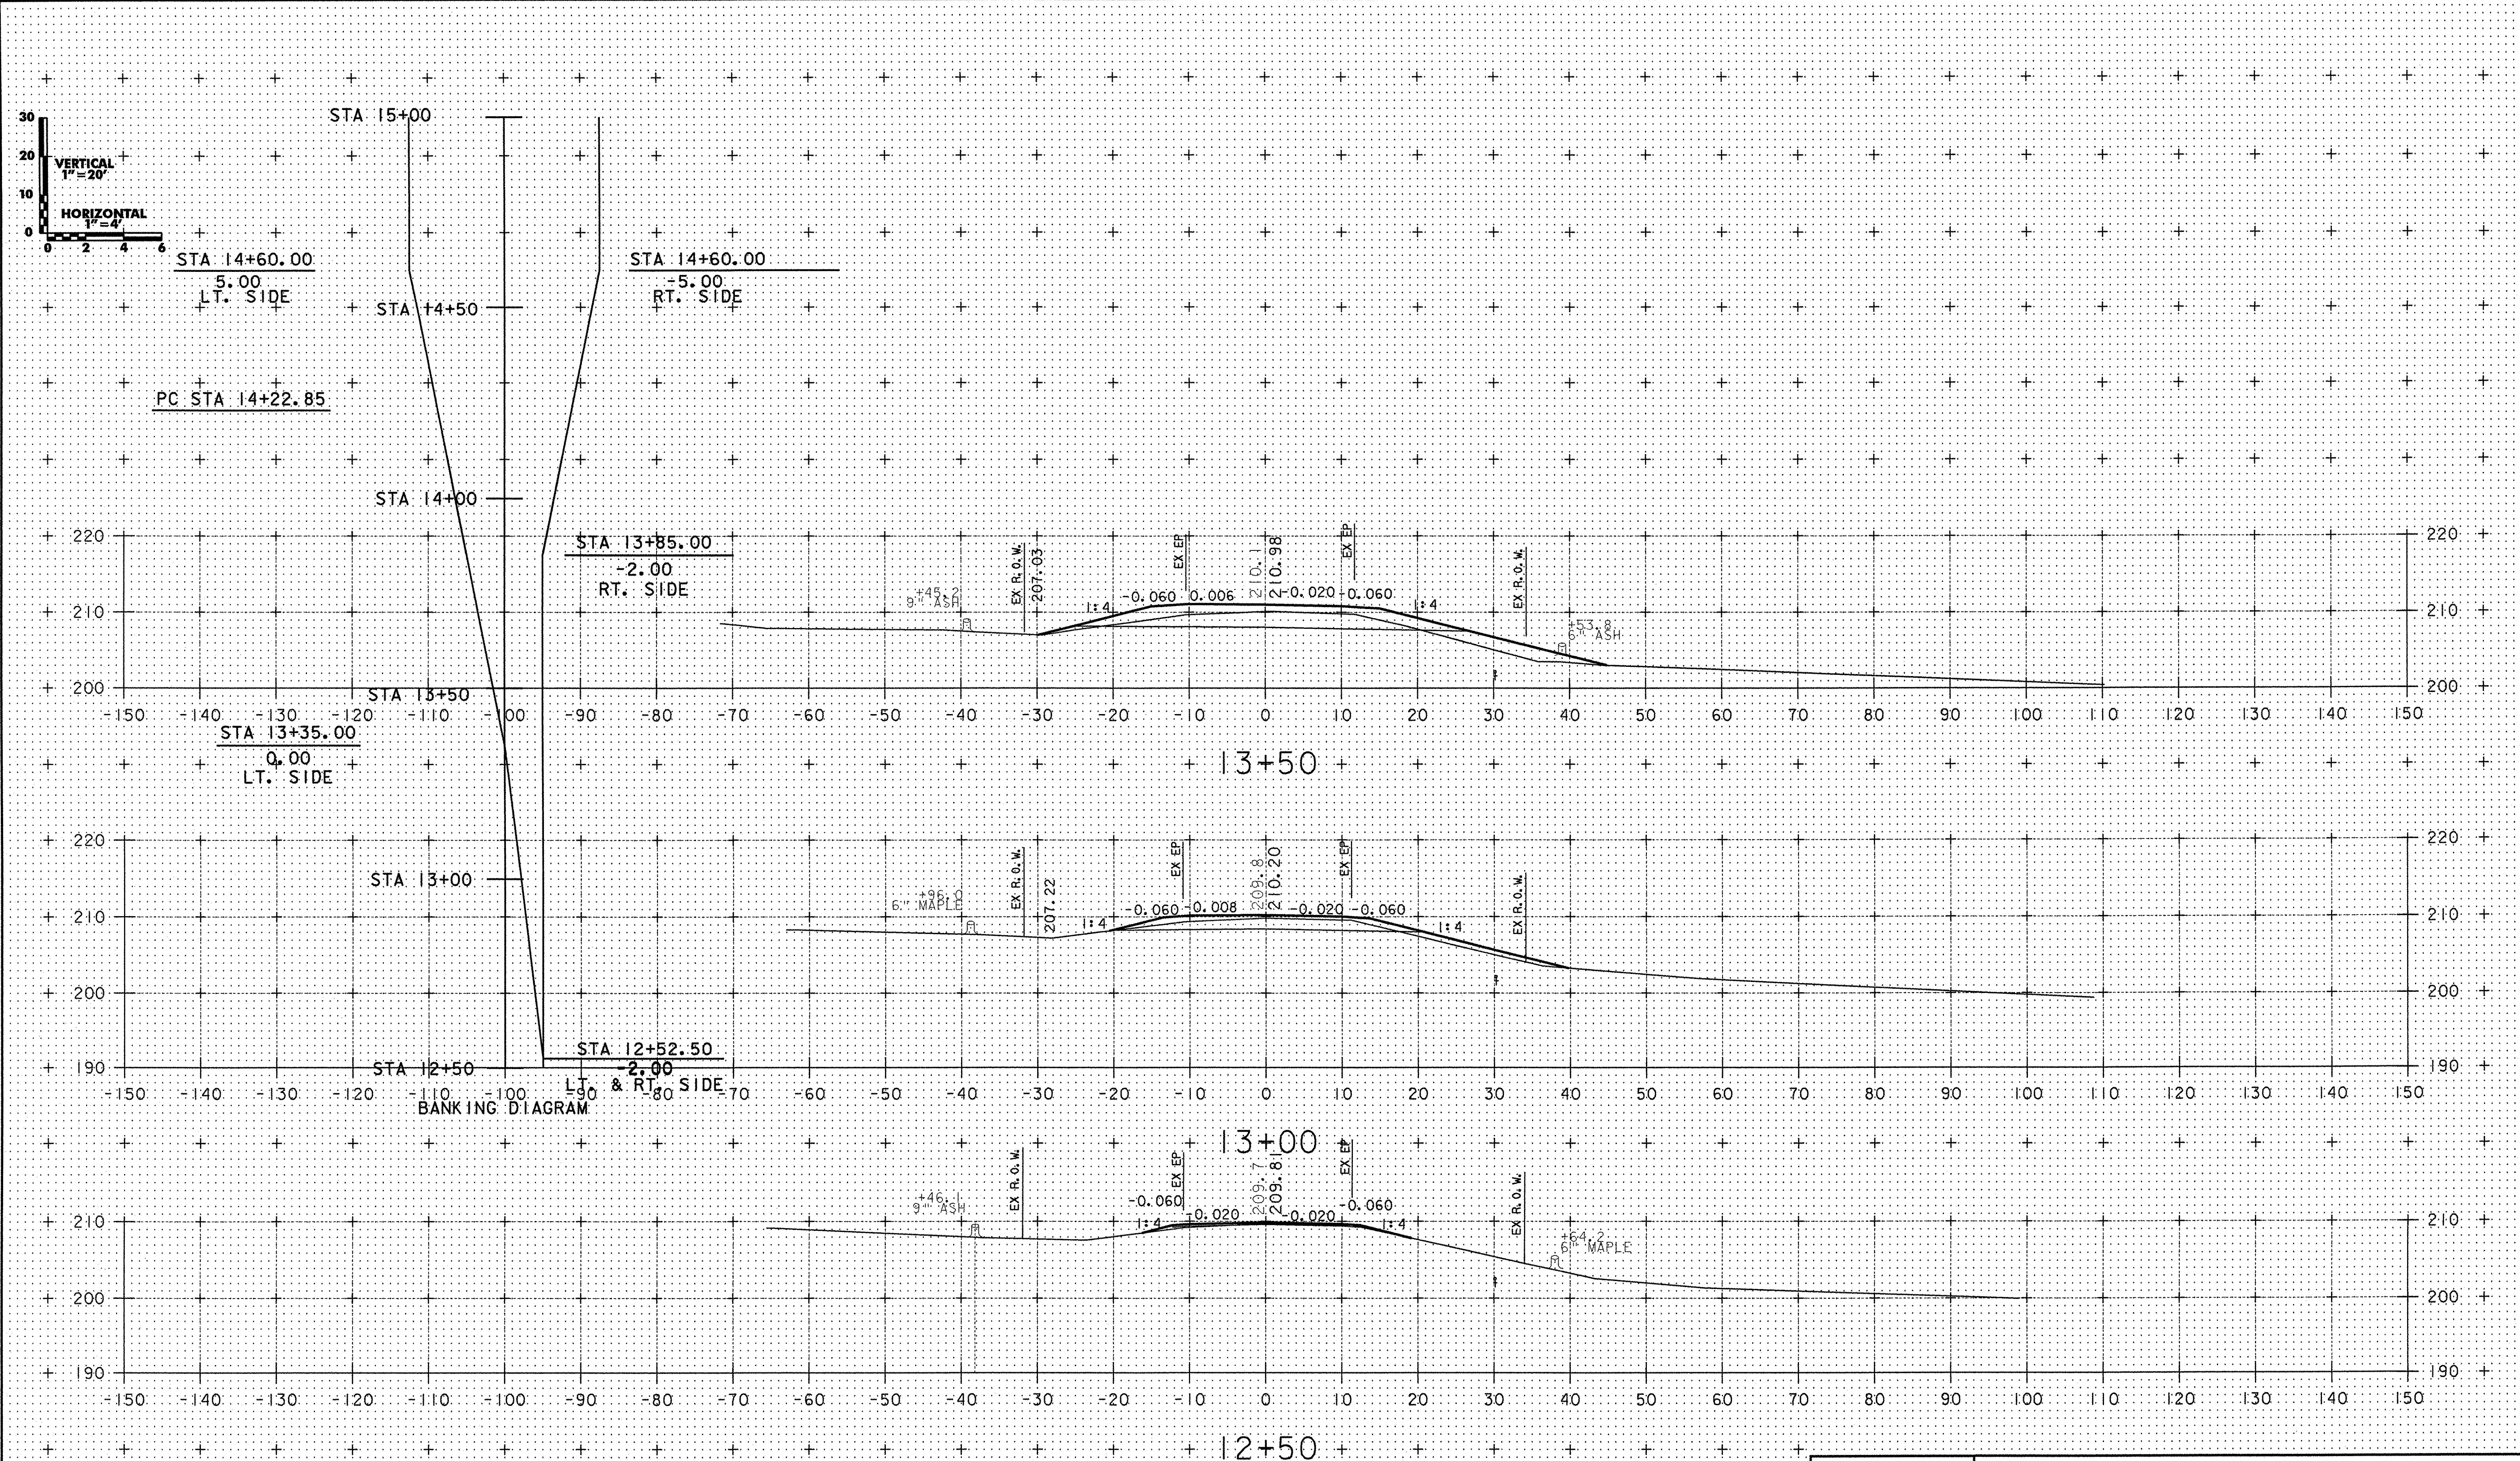


BOSTWICK ROAD

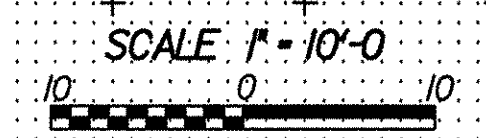


PROJECT NAME:	SHELBURNE
PROJECT NUMBER:	BRO 1445(30)
FILE NAME:	M:\1595402 Bostwick\HWY\DRAW\J196wrk.dgn
PROJECT LEADER:	MBZ
DESIGNED BY:	DMB
CHECKED BY:	MDL
PLOT DATE:	01-AUG-2003
DRAWN BY:	DMB
SHEET	60 OF 73

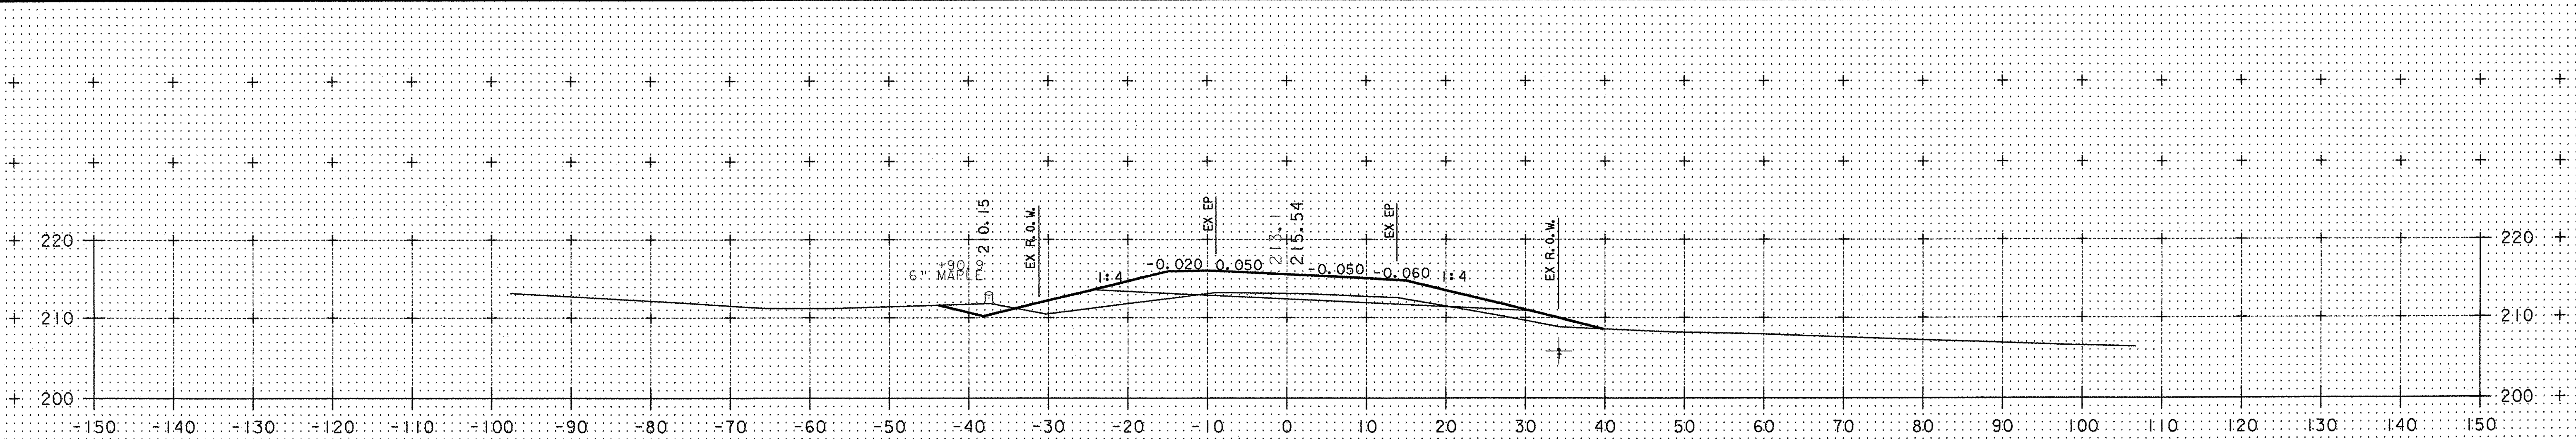


15+00

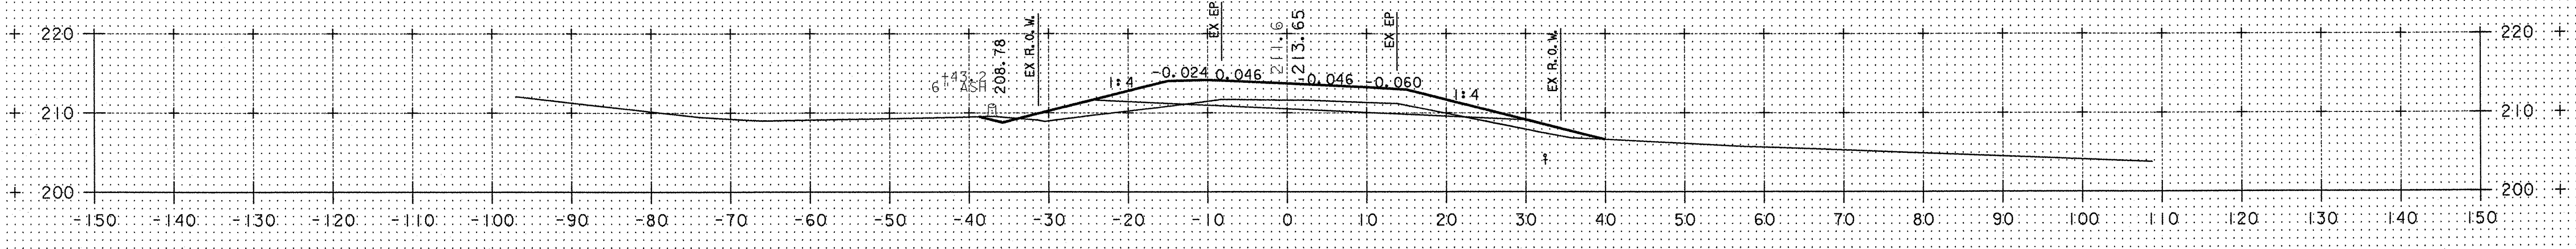


14+50

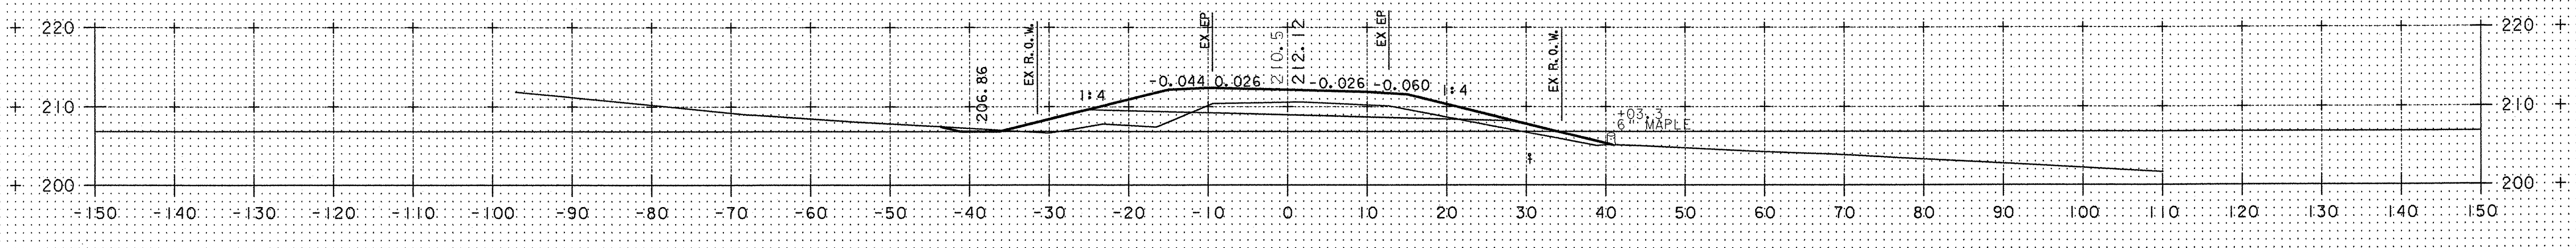

14+00

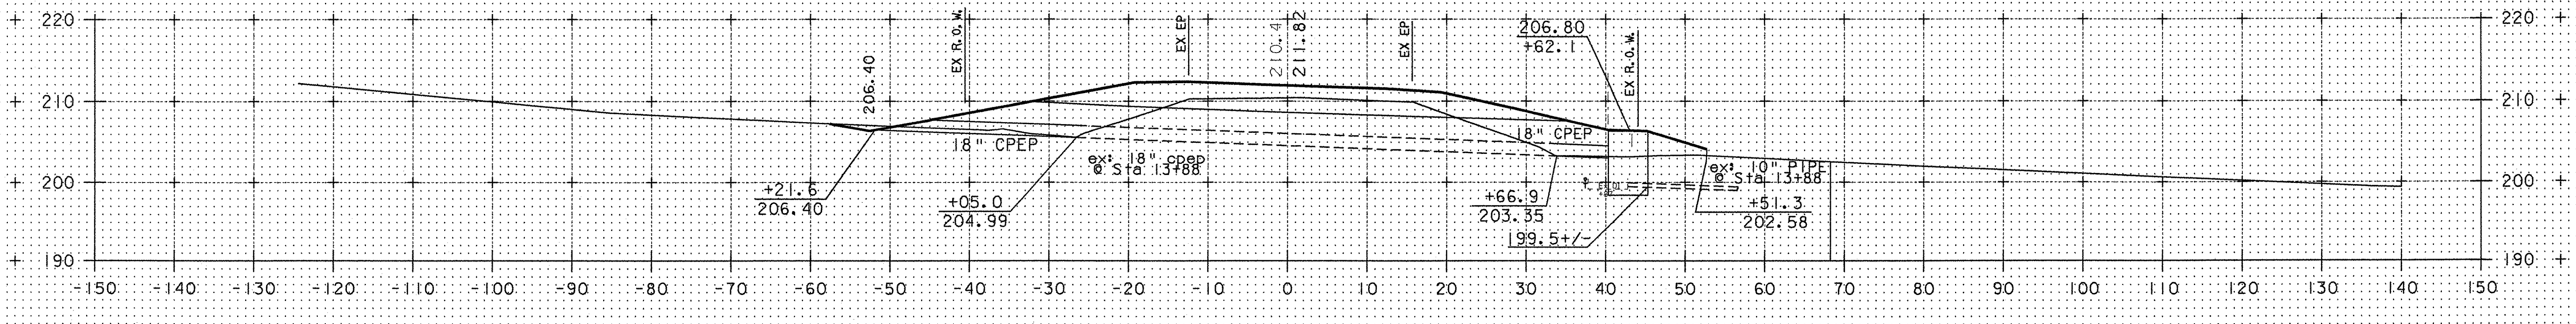


13+88 (skewed)

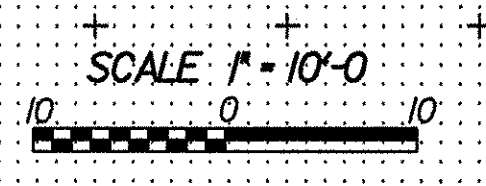


BOSTWICK ROAD


PROJECT NAME:	SHELBURNE		
PROJECT NUMBER:	BRO 1445(30)		
FILE NAME:	M:\1595402 Bostwick\HWY\DRAW\J196wrk.dgn	DESIGNED BY:	DMB
PROJECT LEADER:	MBZ	CHECKED BY:	MDL
		PLOT DATE:	01-AUG-2003
		DRAWN BY:	DMB
		SHEET	61 OF 73

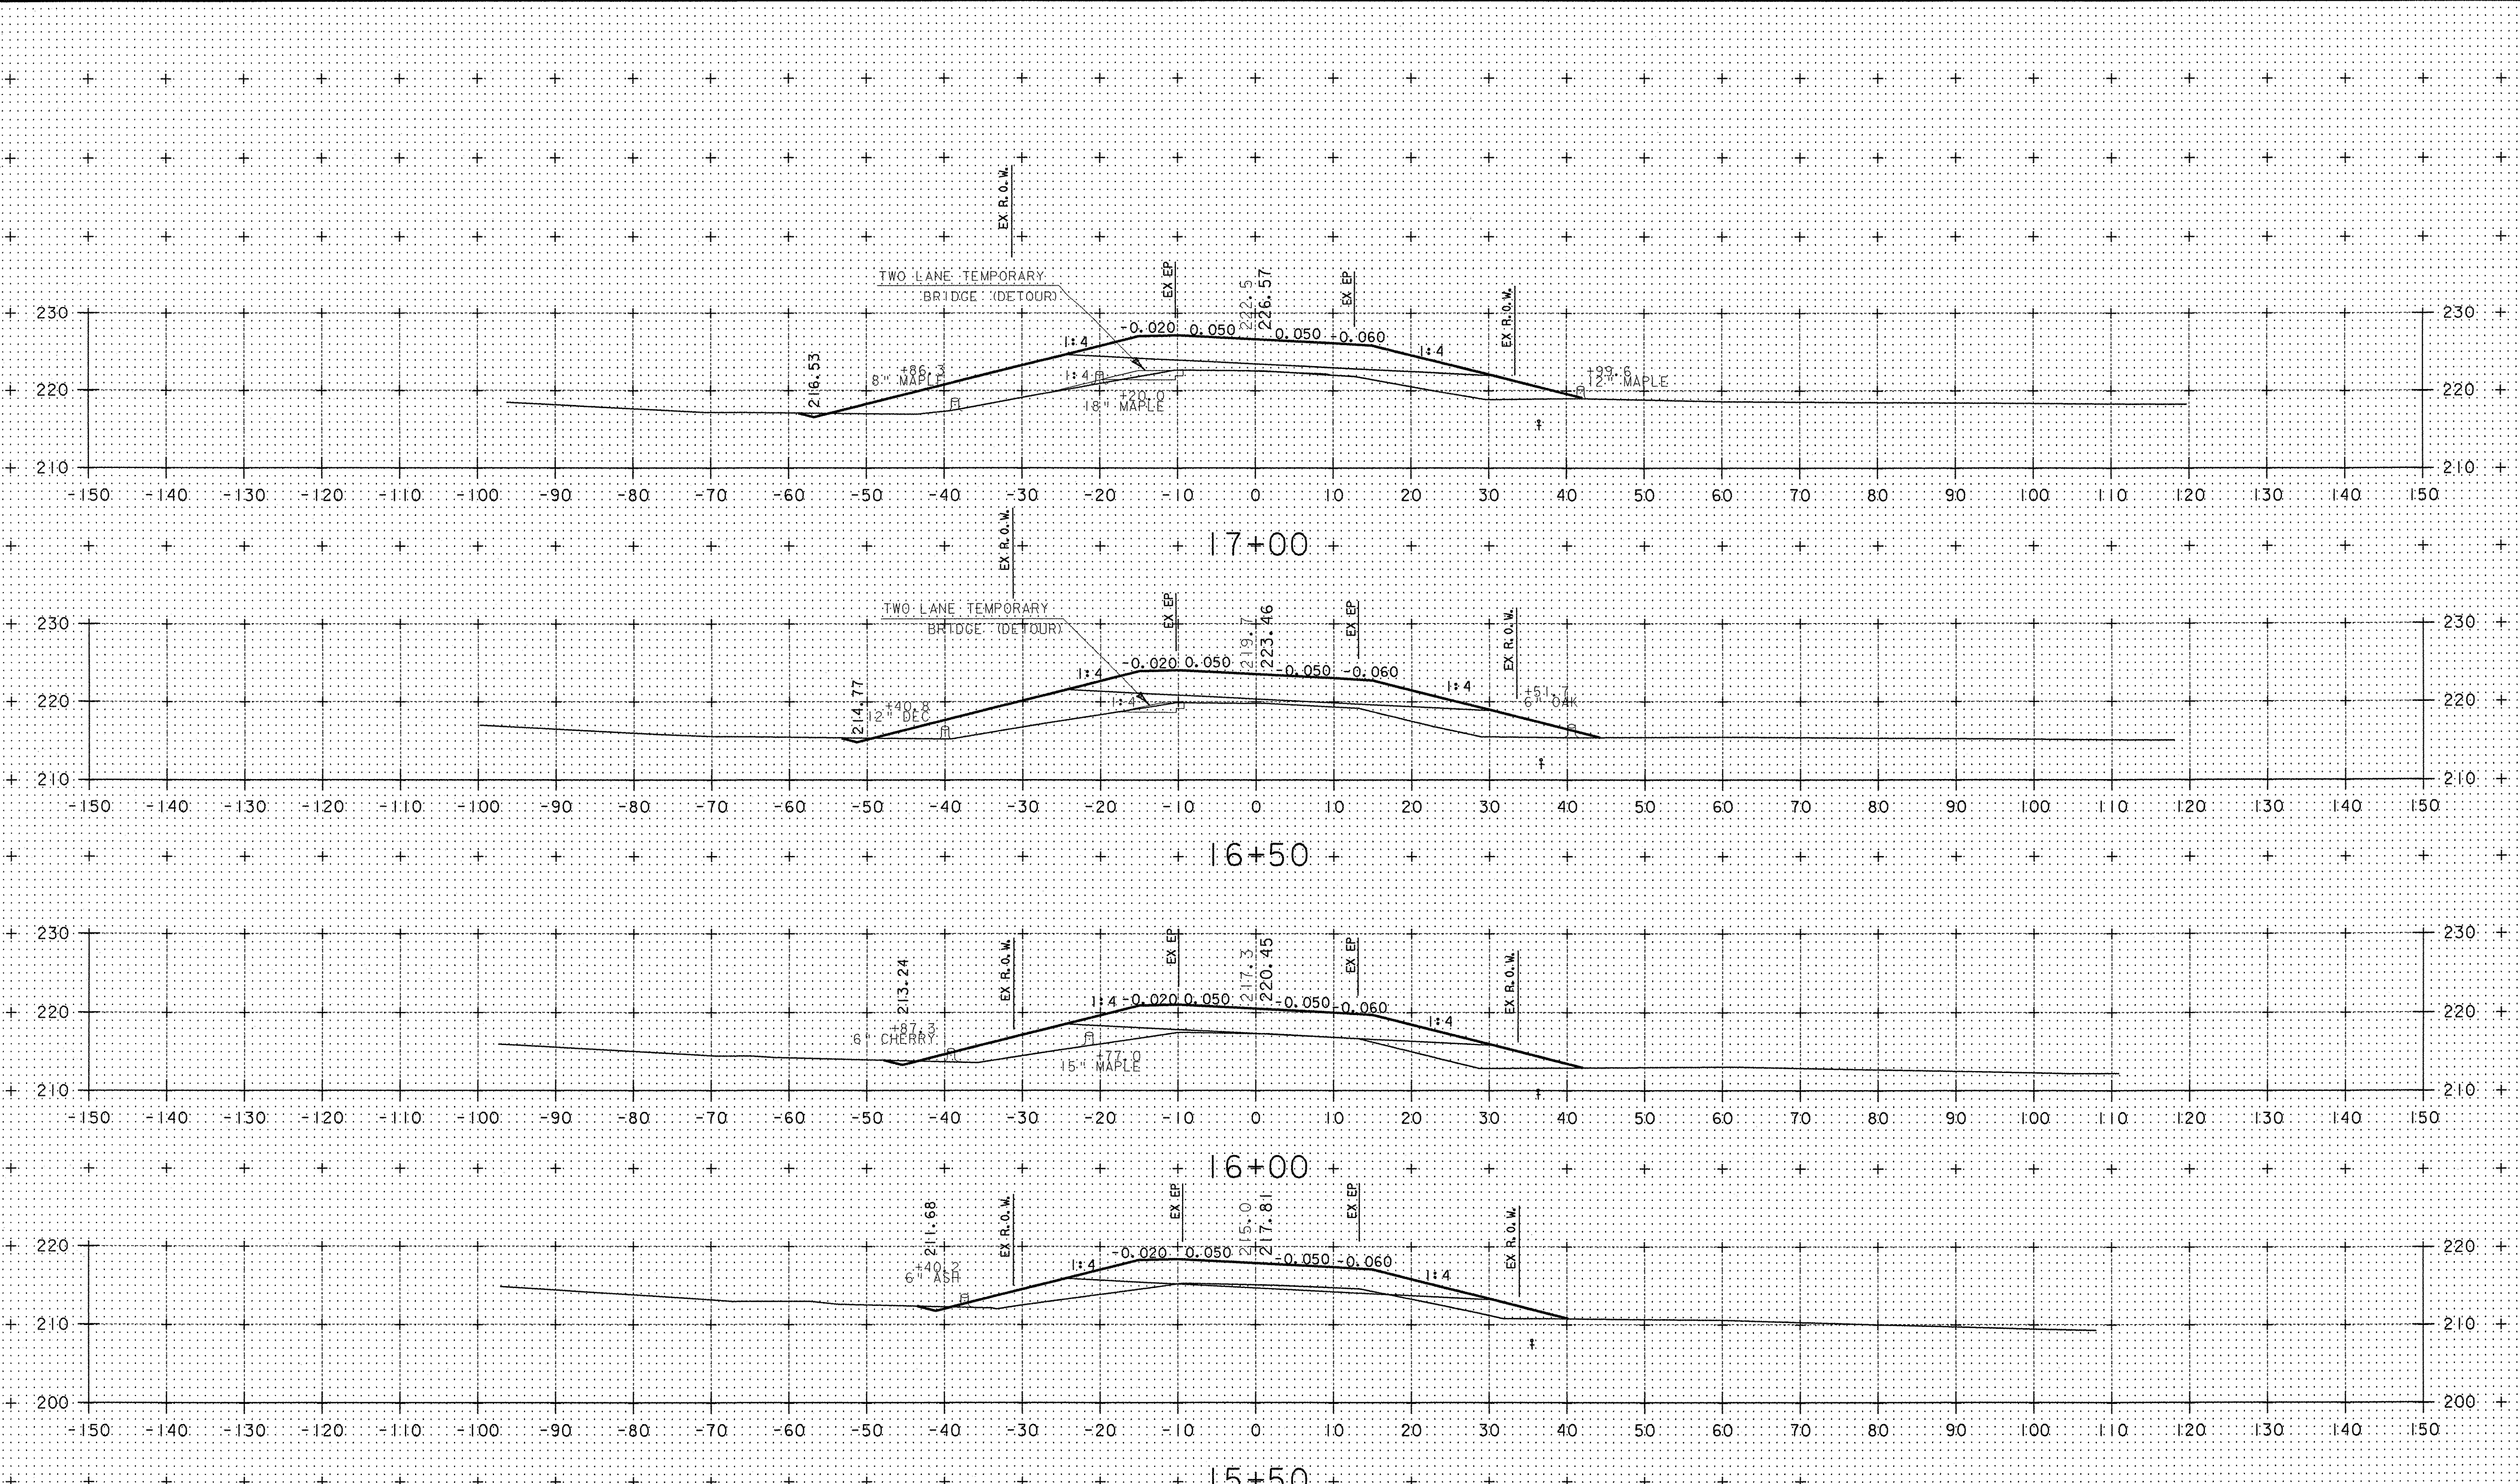

BOSTWICK ROAD

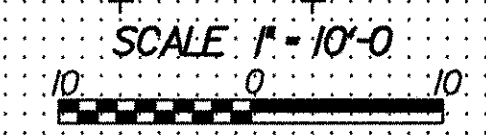


PROJECT NAME:	SHELBURNE
PROJECT NUMBER:	BRO 1445(30)
FILE NAME:	M:\595402 Bostwick\HWY\DRAW\J96wrk.dgn
PROJECT LEADER:	MBZ
DESIGNED BY:	DMB
CHECKED BY:	MDL
PLOT DATE:	01-AUG-2003
DRAWN BY:	DMB
SHEET	62 OF 73

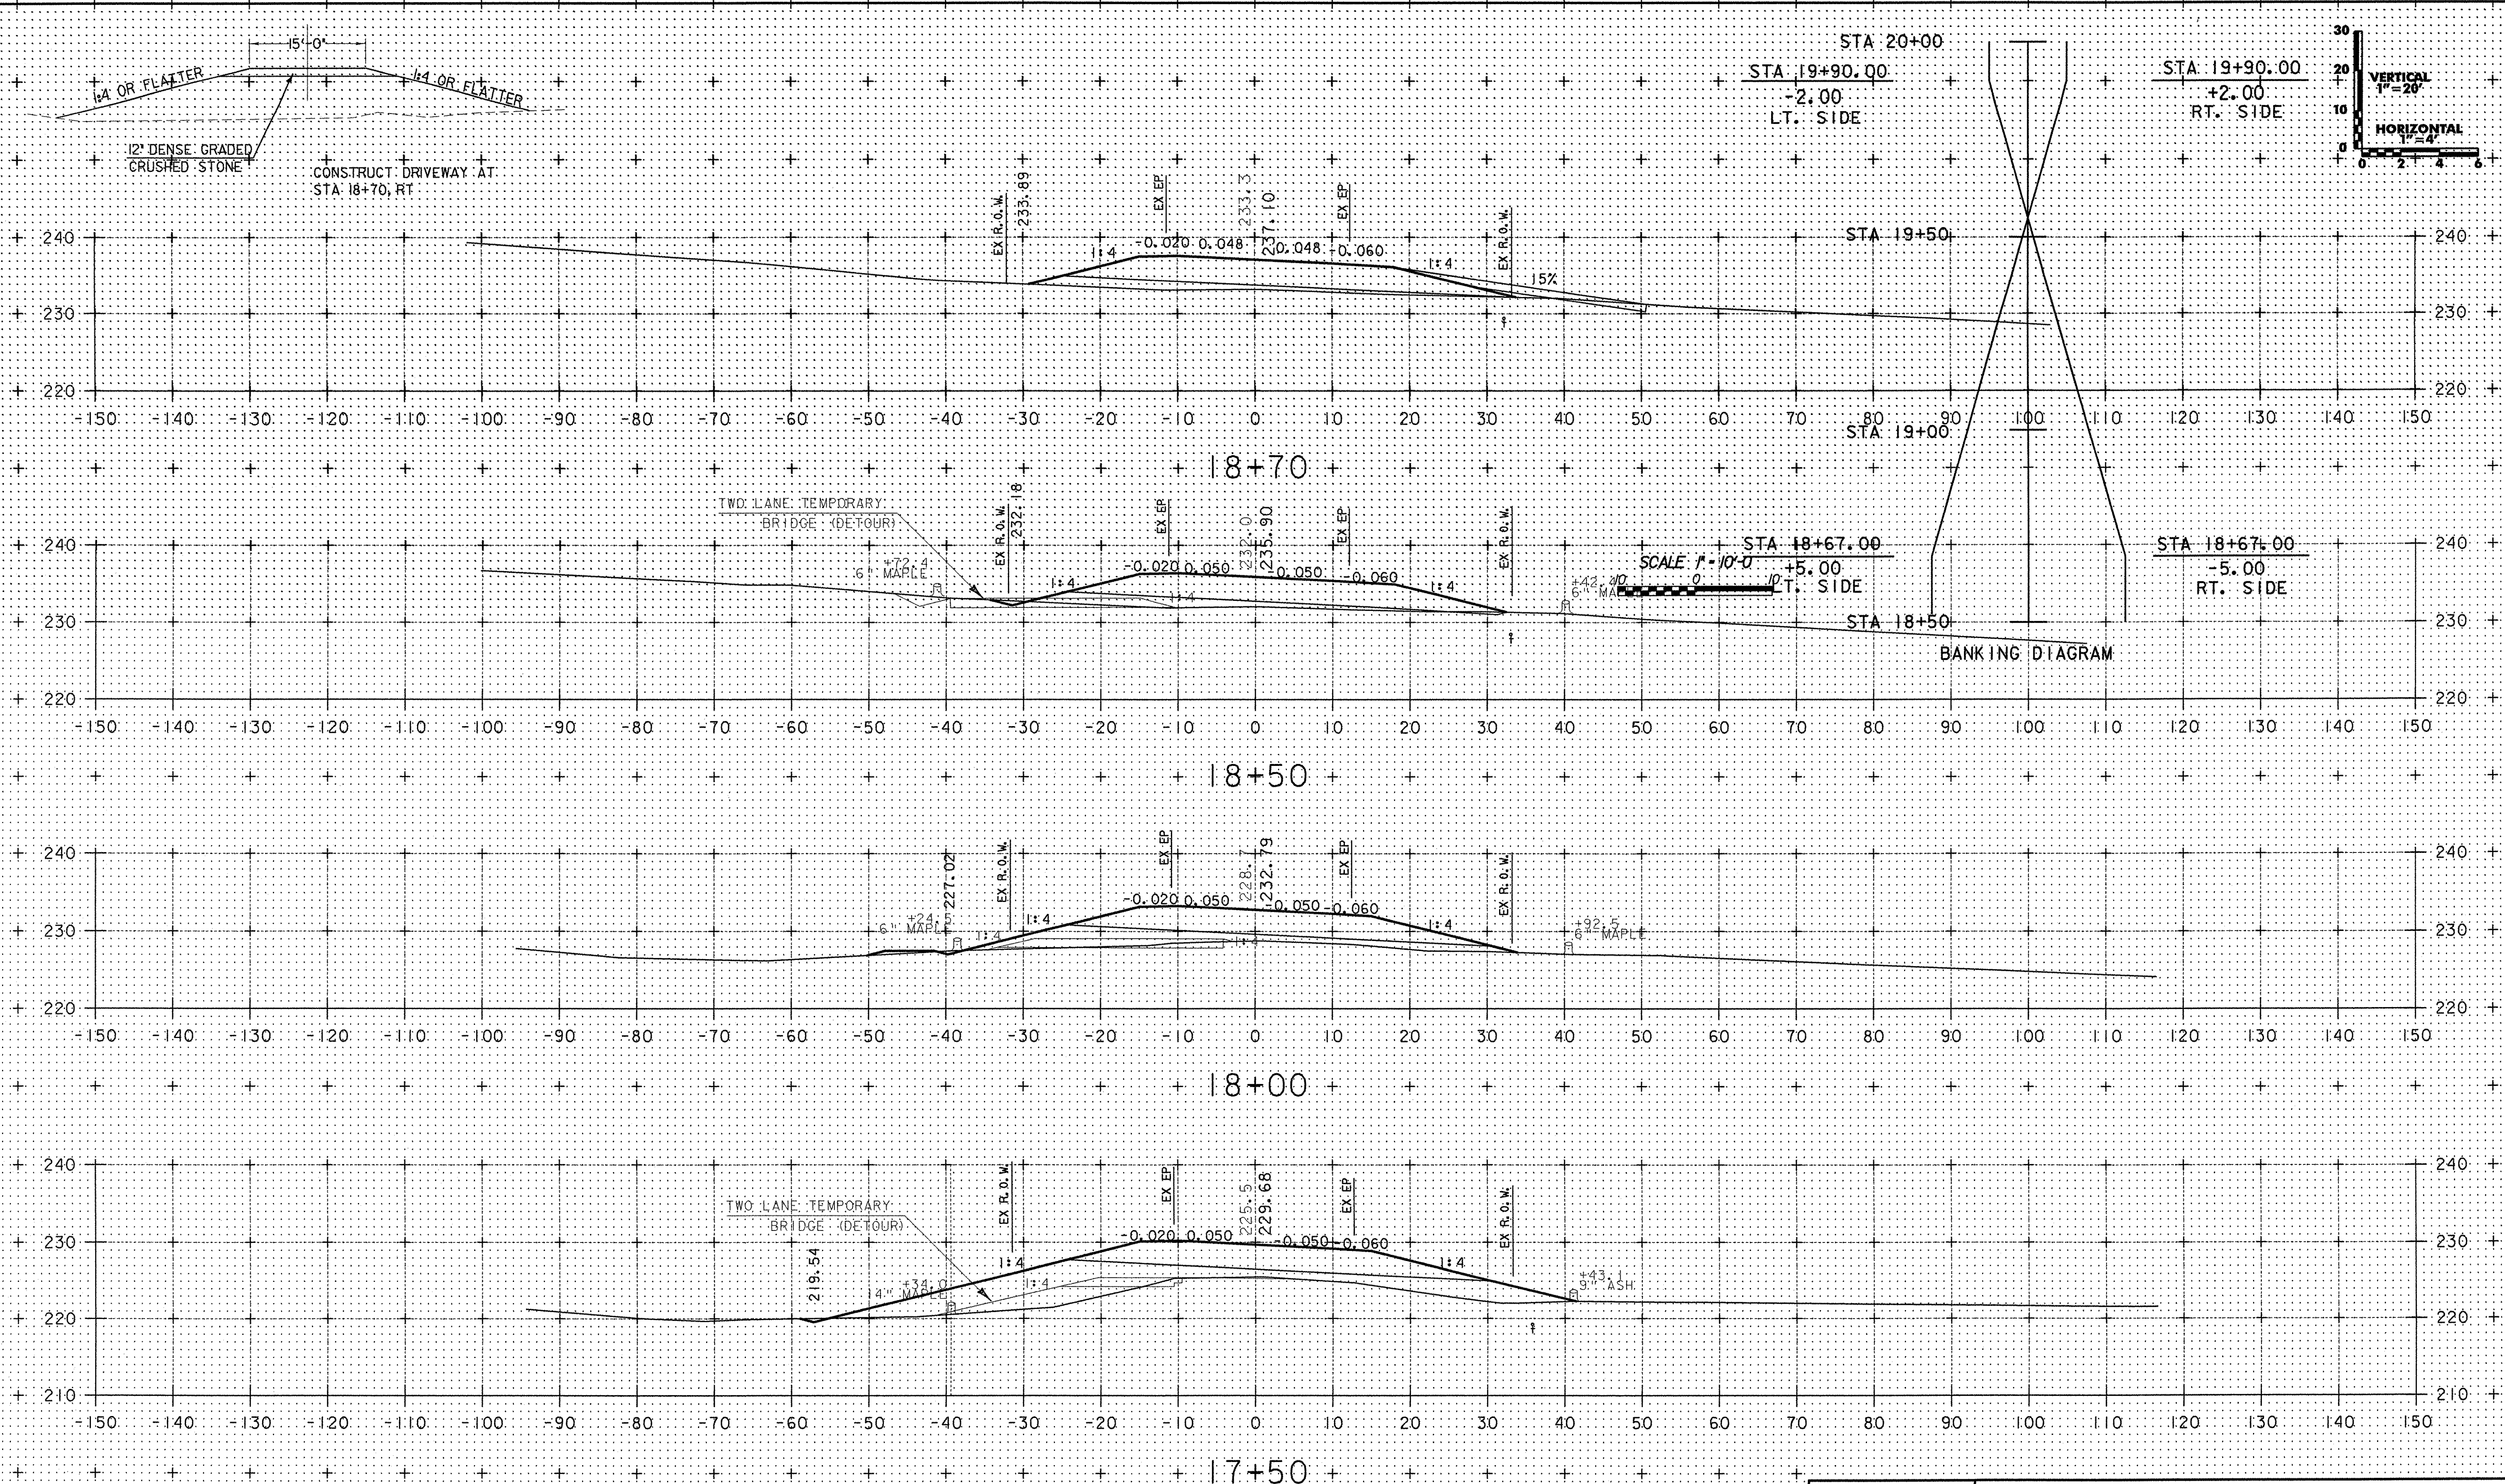


BOSTWICK ROAD


PROJECT NAME:	SHELBURNE
PROJECT NUMBER:	BRO 1445(30)
FILE NAME:	M:\1595402 Bostwick\HWY\DRAW\J196wrk.dgn
PROJECT LEADER:	MBZ
DESIGNED BY:	DMB
CHECKED BY:	MDL
PLOT DATE:	01-AUG-2003
DRAWN BY:	DMB
SHEET	63 OF 73

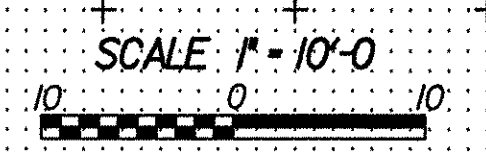

SHOULDER TRANSITION		
STATION	LT	RT
19+00	-0.020	-0.060
19+50	-0.020	-0.016
19+90	-0.020	+0.020



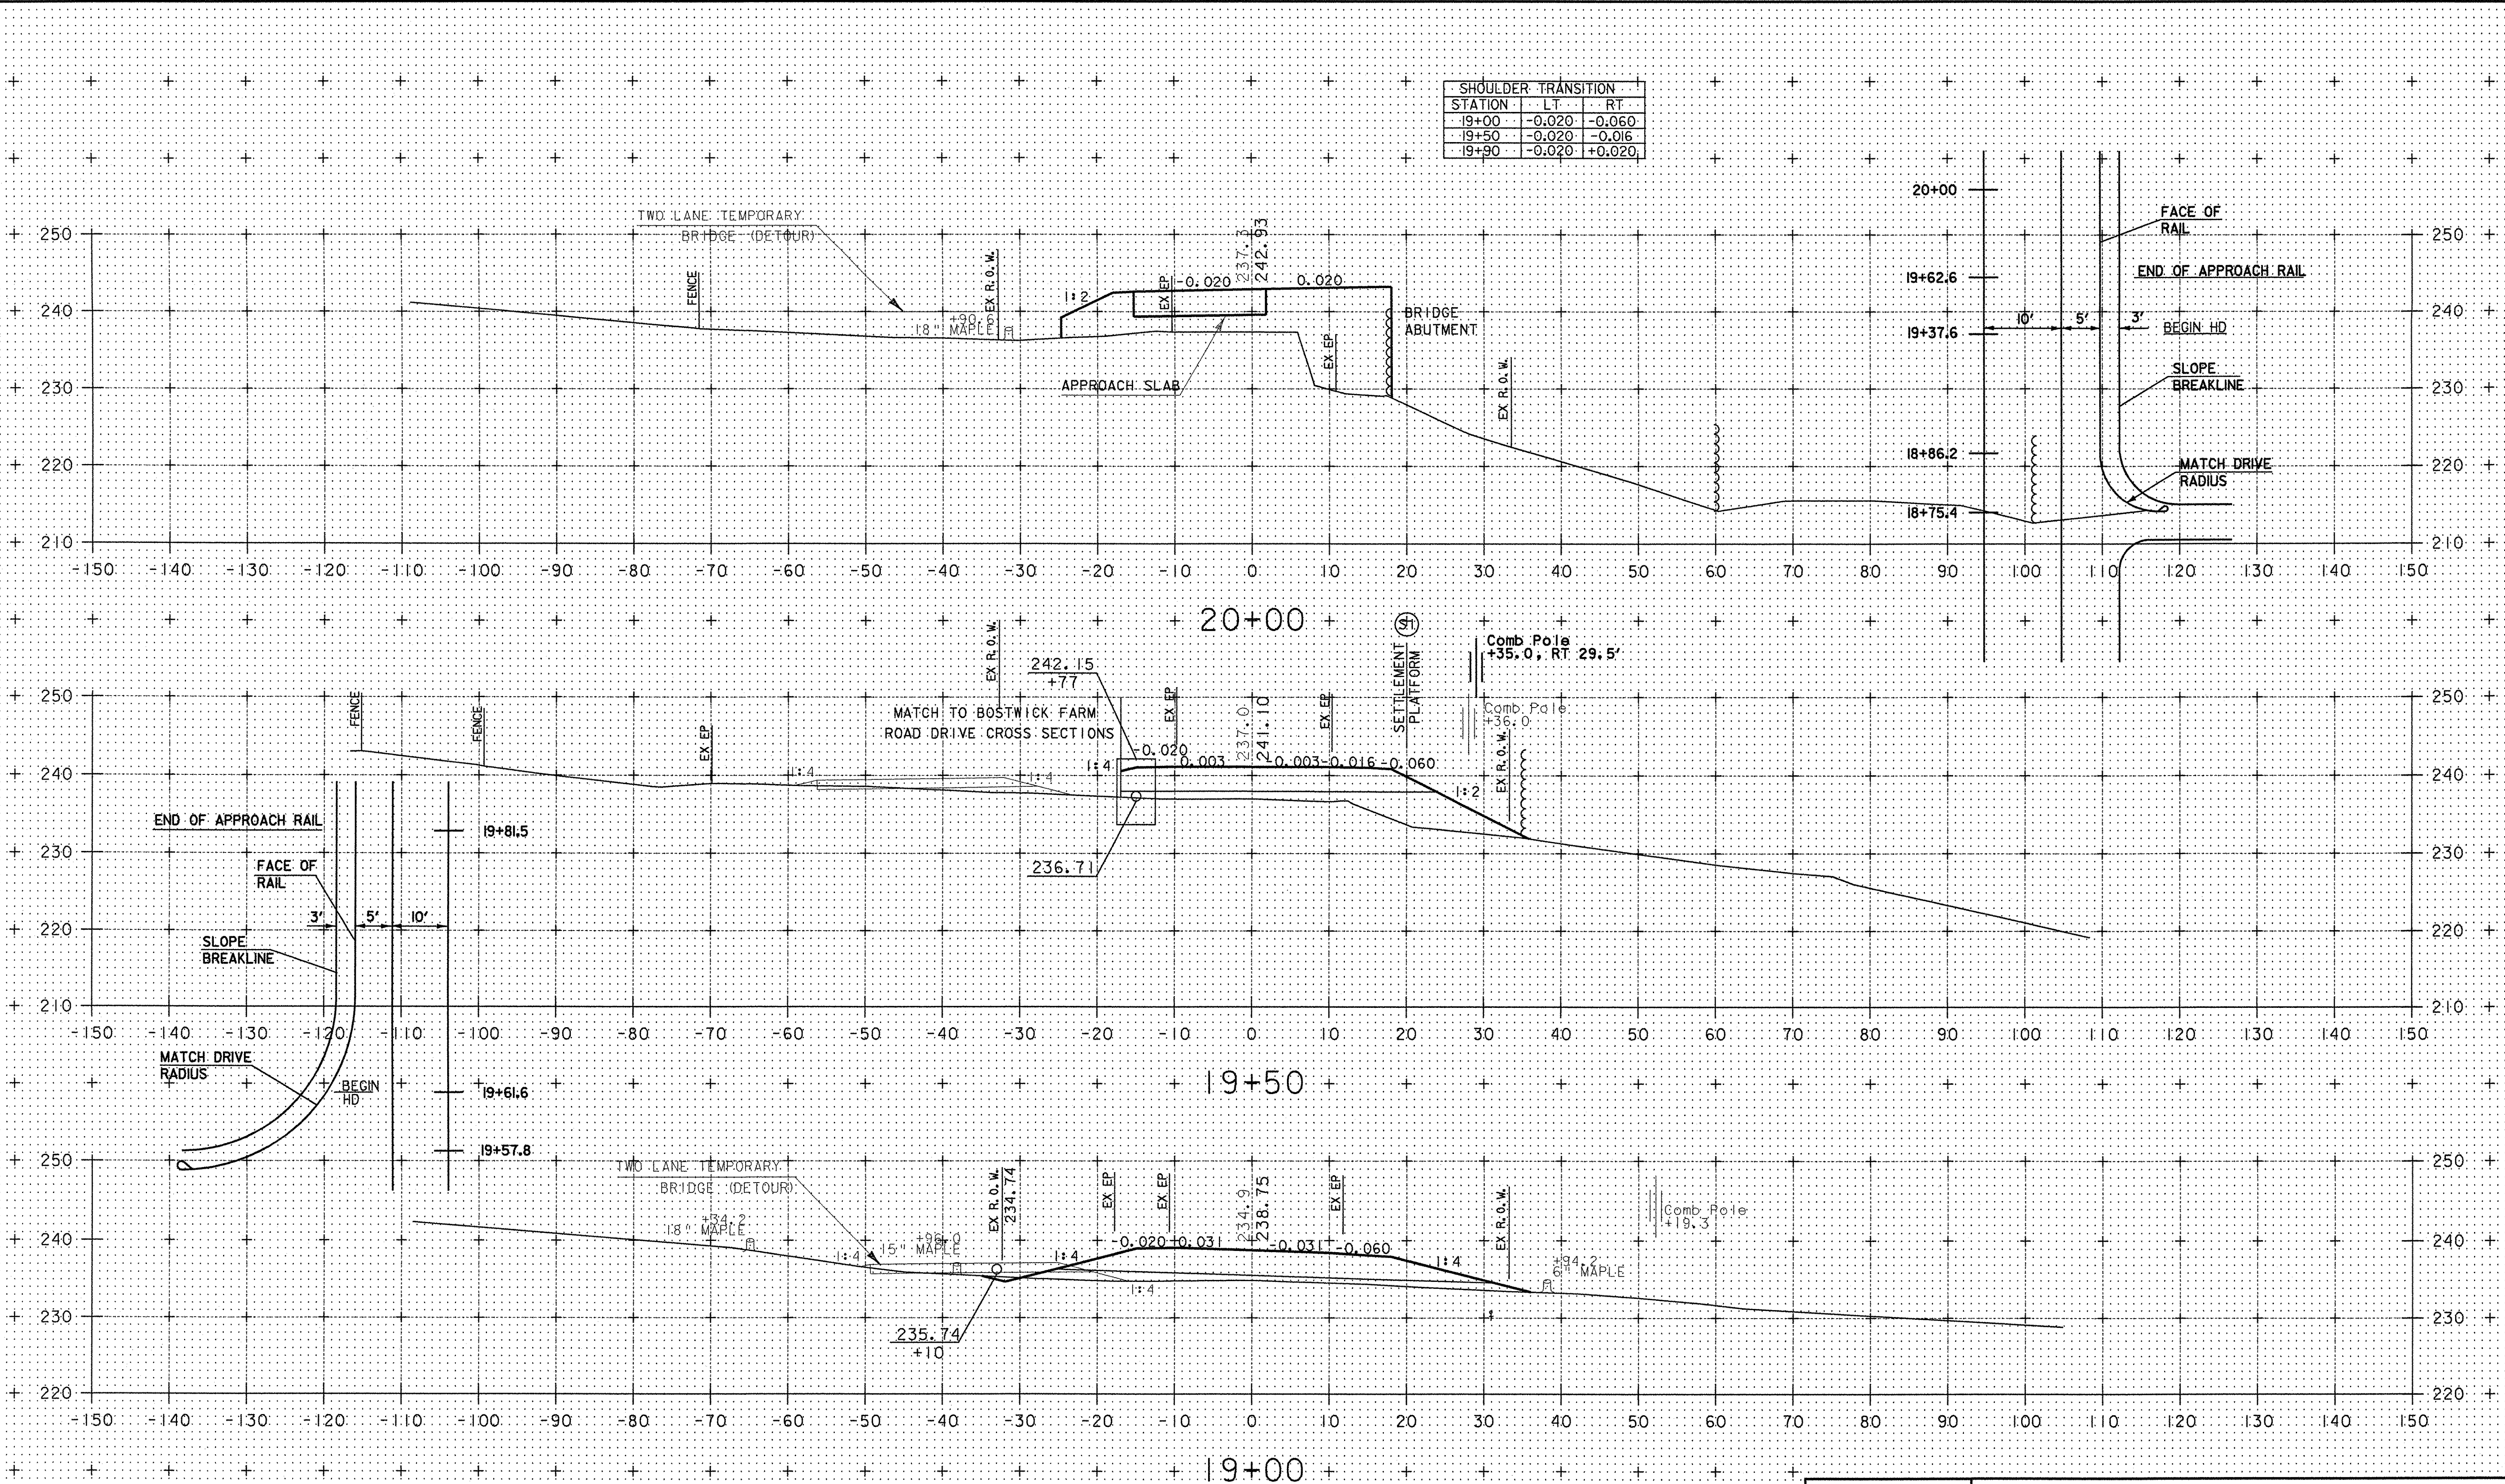


BOSTWICK ROAD

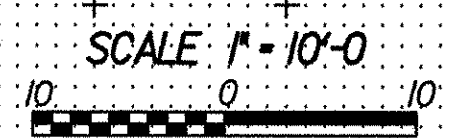


PROJECT NAME:	SHELBURNE
PROJECT NUMBER:	BRO 1445(30)
FILE NAME:	M:\1595402 Bostwick\HWY\DRAW\J196wrk.dgn
PROJECT LEADER:	MBZ
DESIGNED BY:	DMB
CHECKED BY:	MDL
PLOT DATE:	01-AUG-2003
DRAWN BY:	DMB
SHEET	64 OF 73

SHOULDER TRANSITION		
STATION	LT	RT
21+0	-0.020	+0.020
21+50	-0.043	+0.004

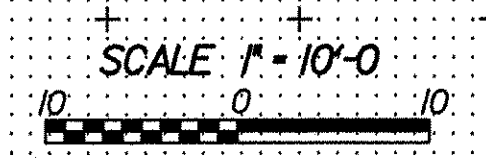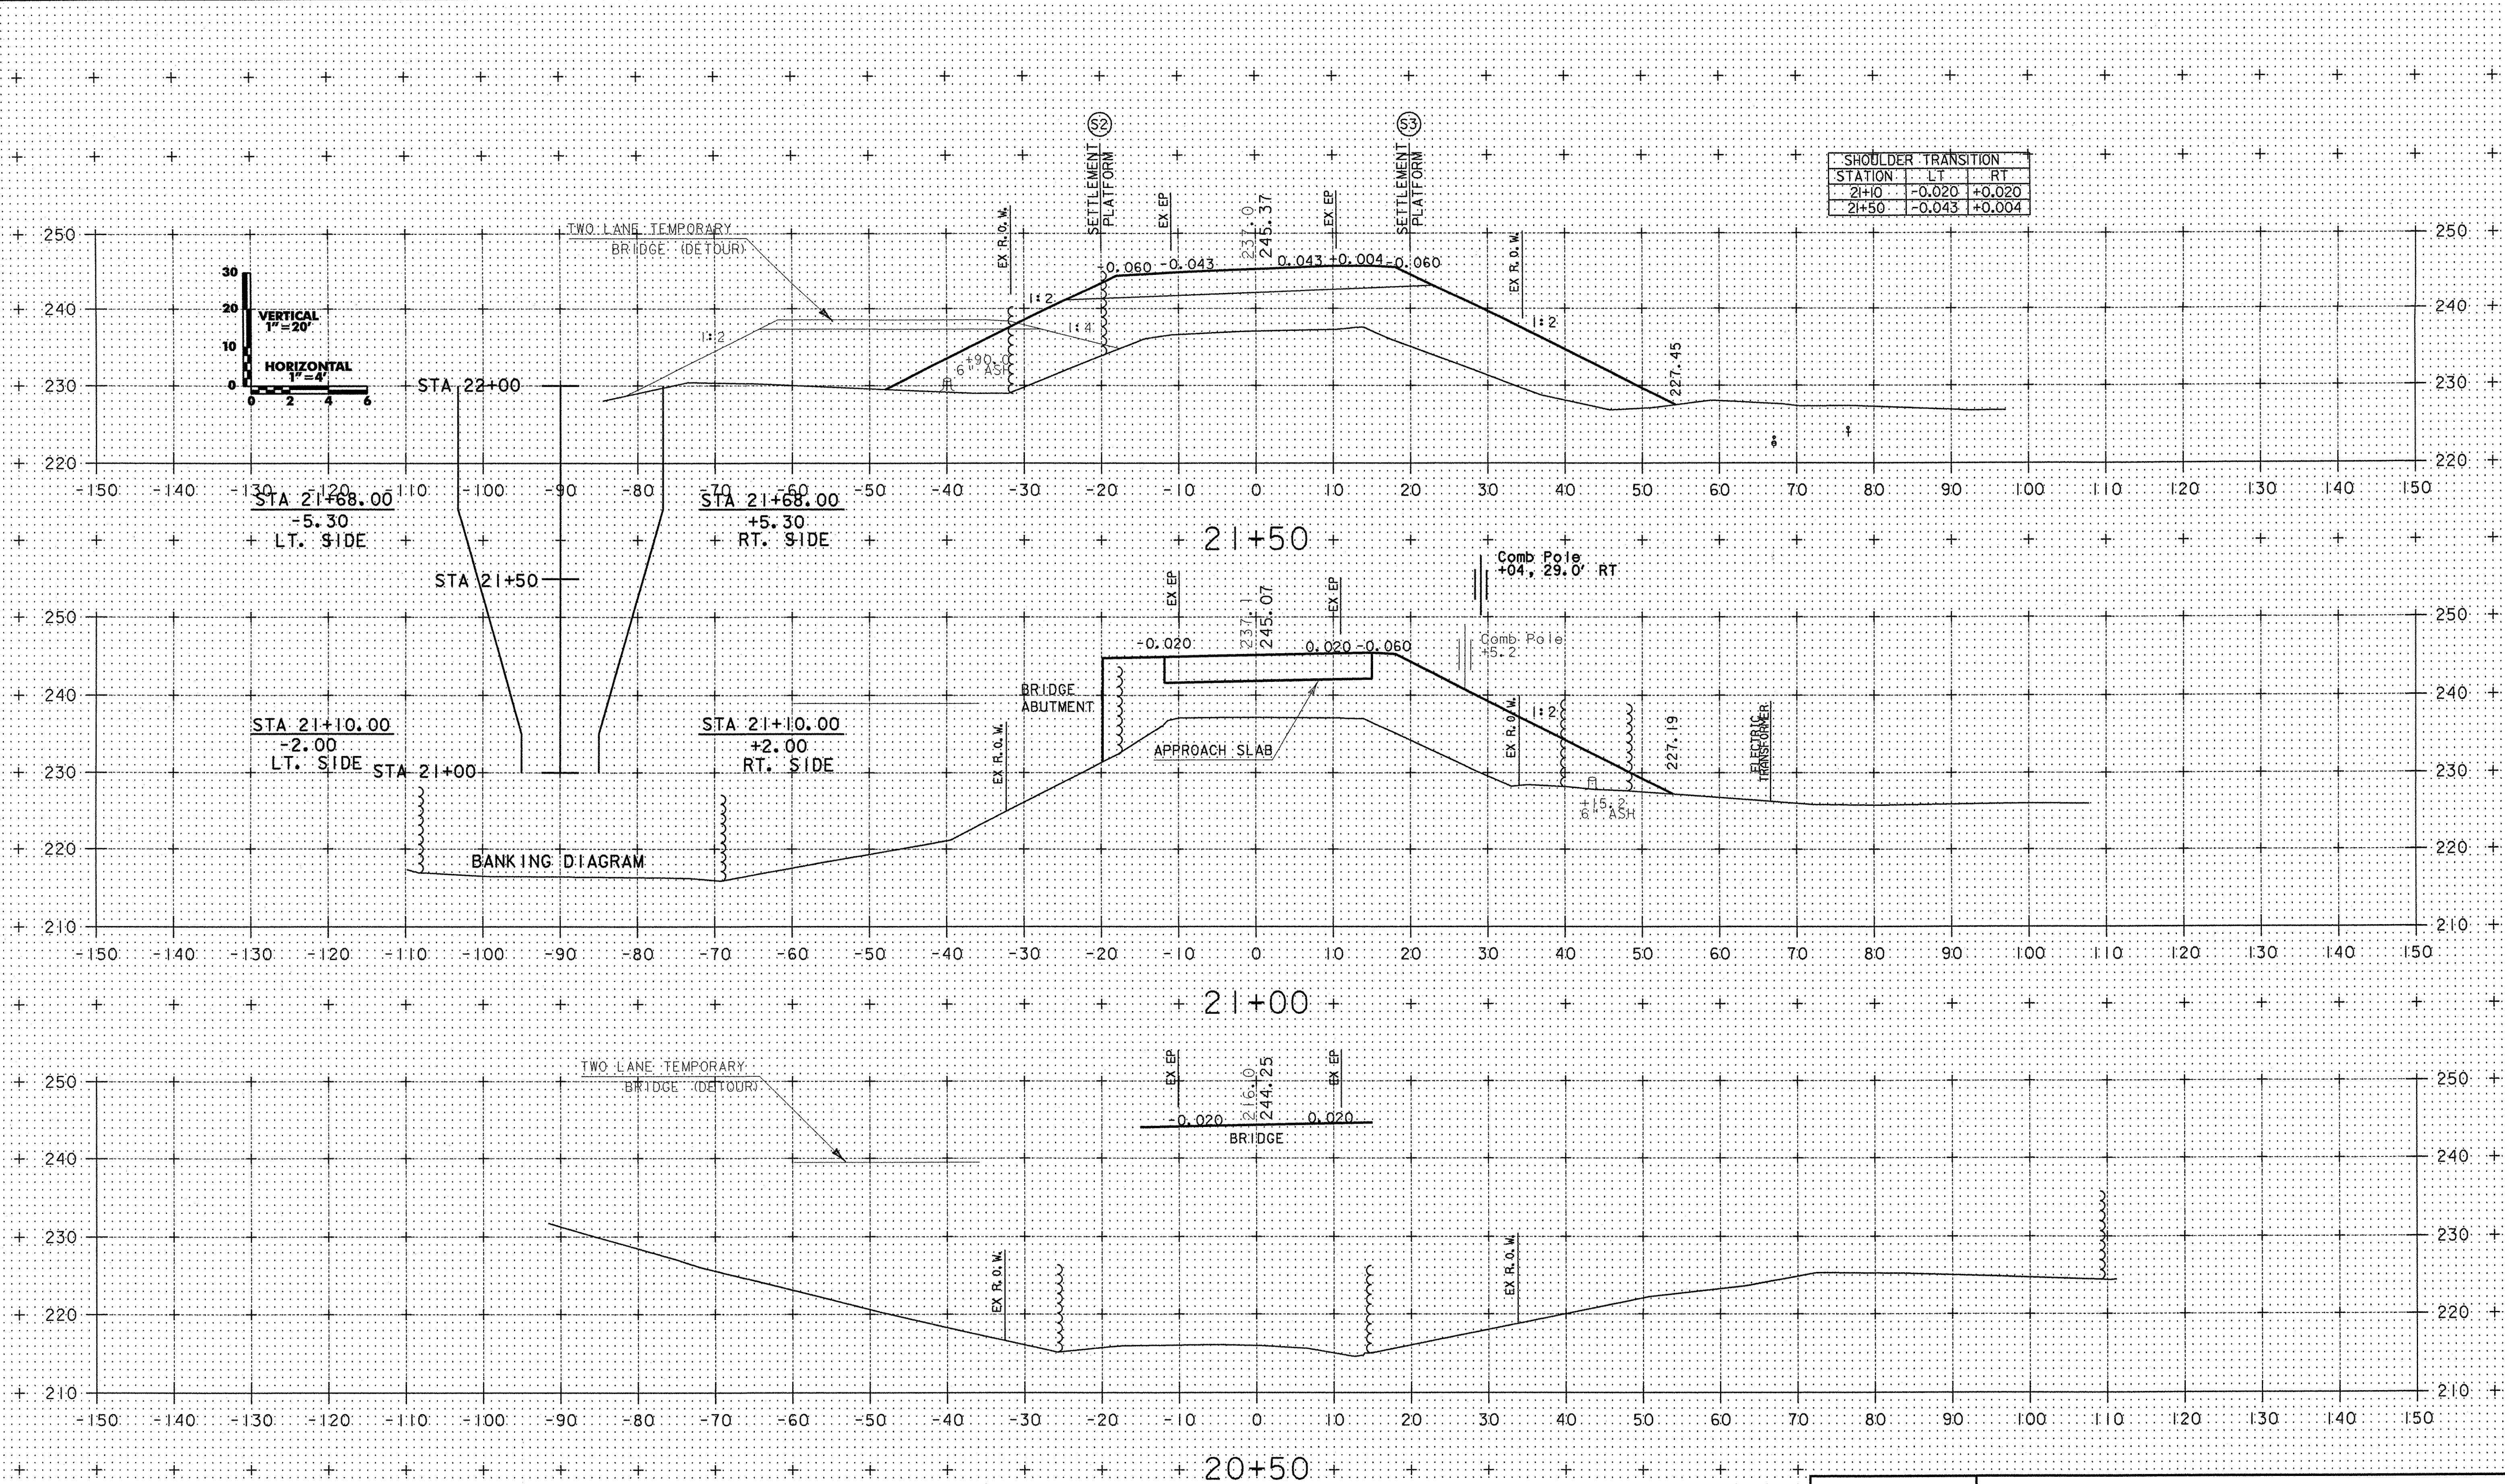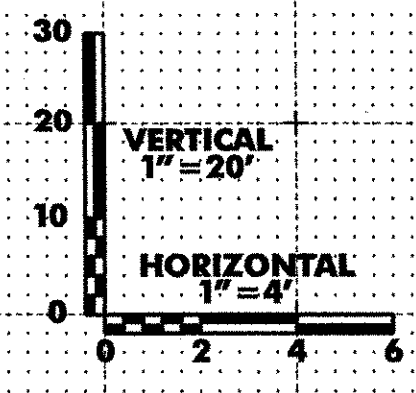


BOSTWICK ROAD

PROJECT NAME:	SHELBURNE		
PROJECT NUMBER:	BRO 1445(30)		
FILE NAME:	M:\1595402 Bostwick\HWY\DRAW\J196wrk.dgn	DESIGNED BY:	DMB
PROJECT LEADER:	MBZ	CHECKED BY:	MDL
PLOT DATE:	01-AUG-2003	DRAWN BY:	DMB
		SHEET	65 OF 73



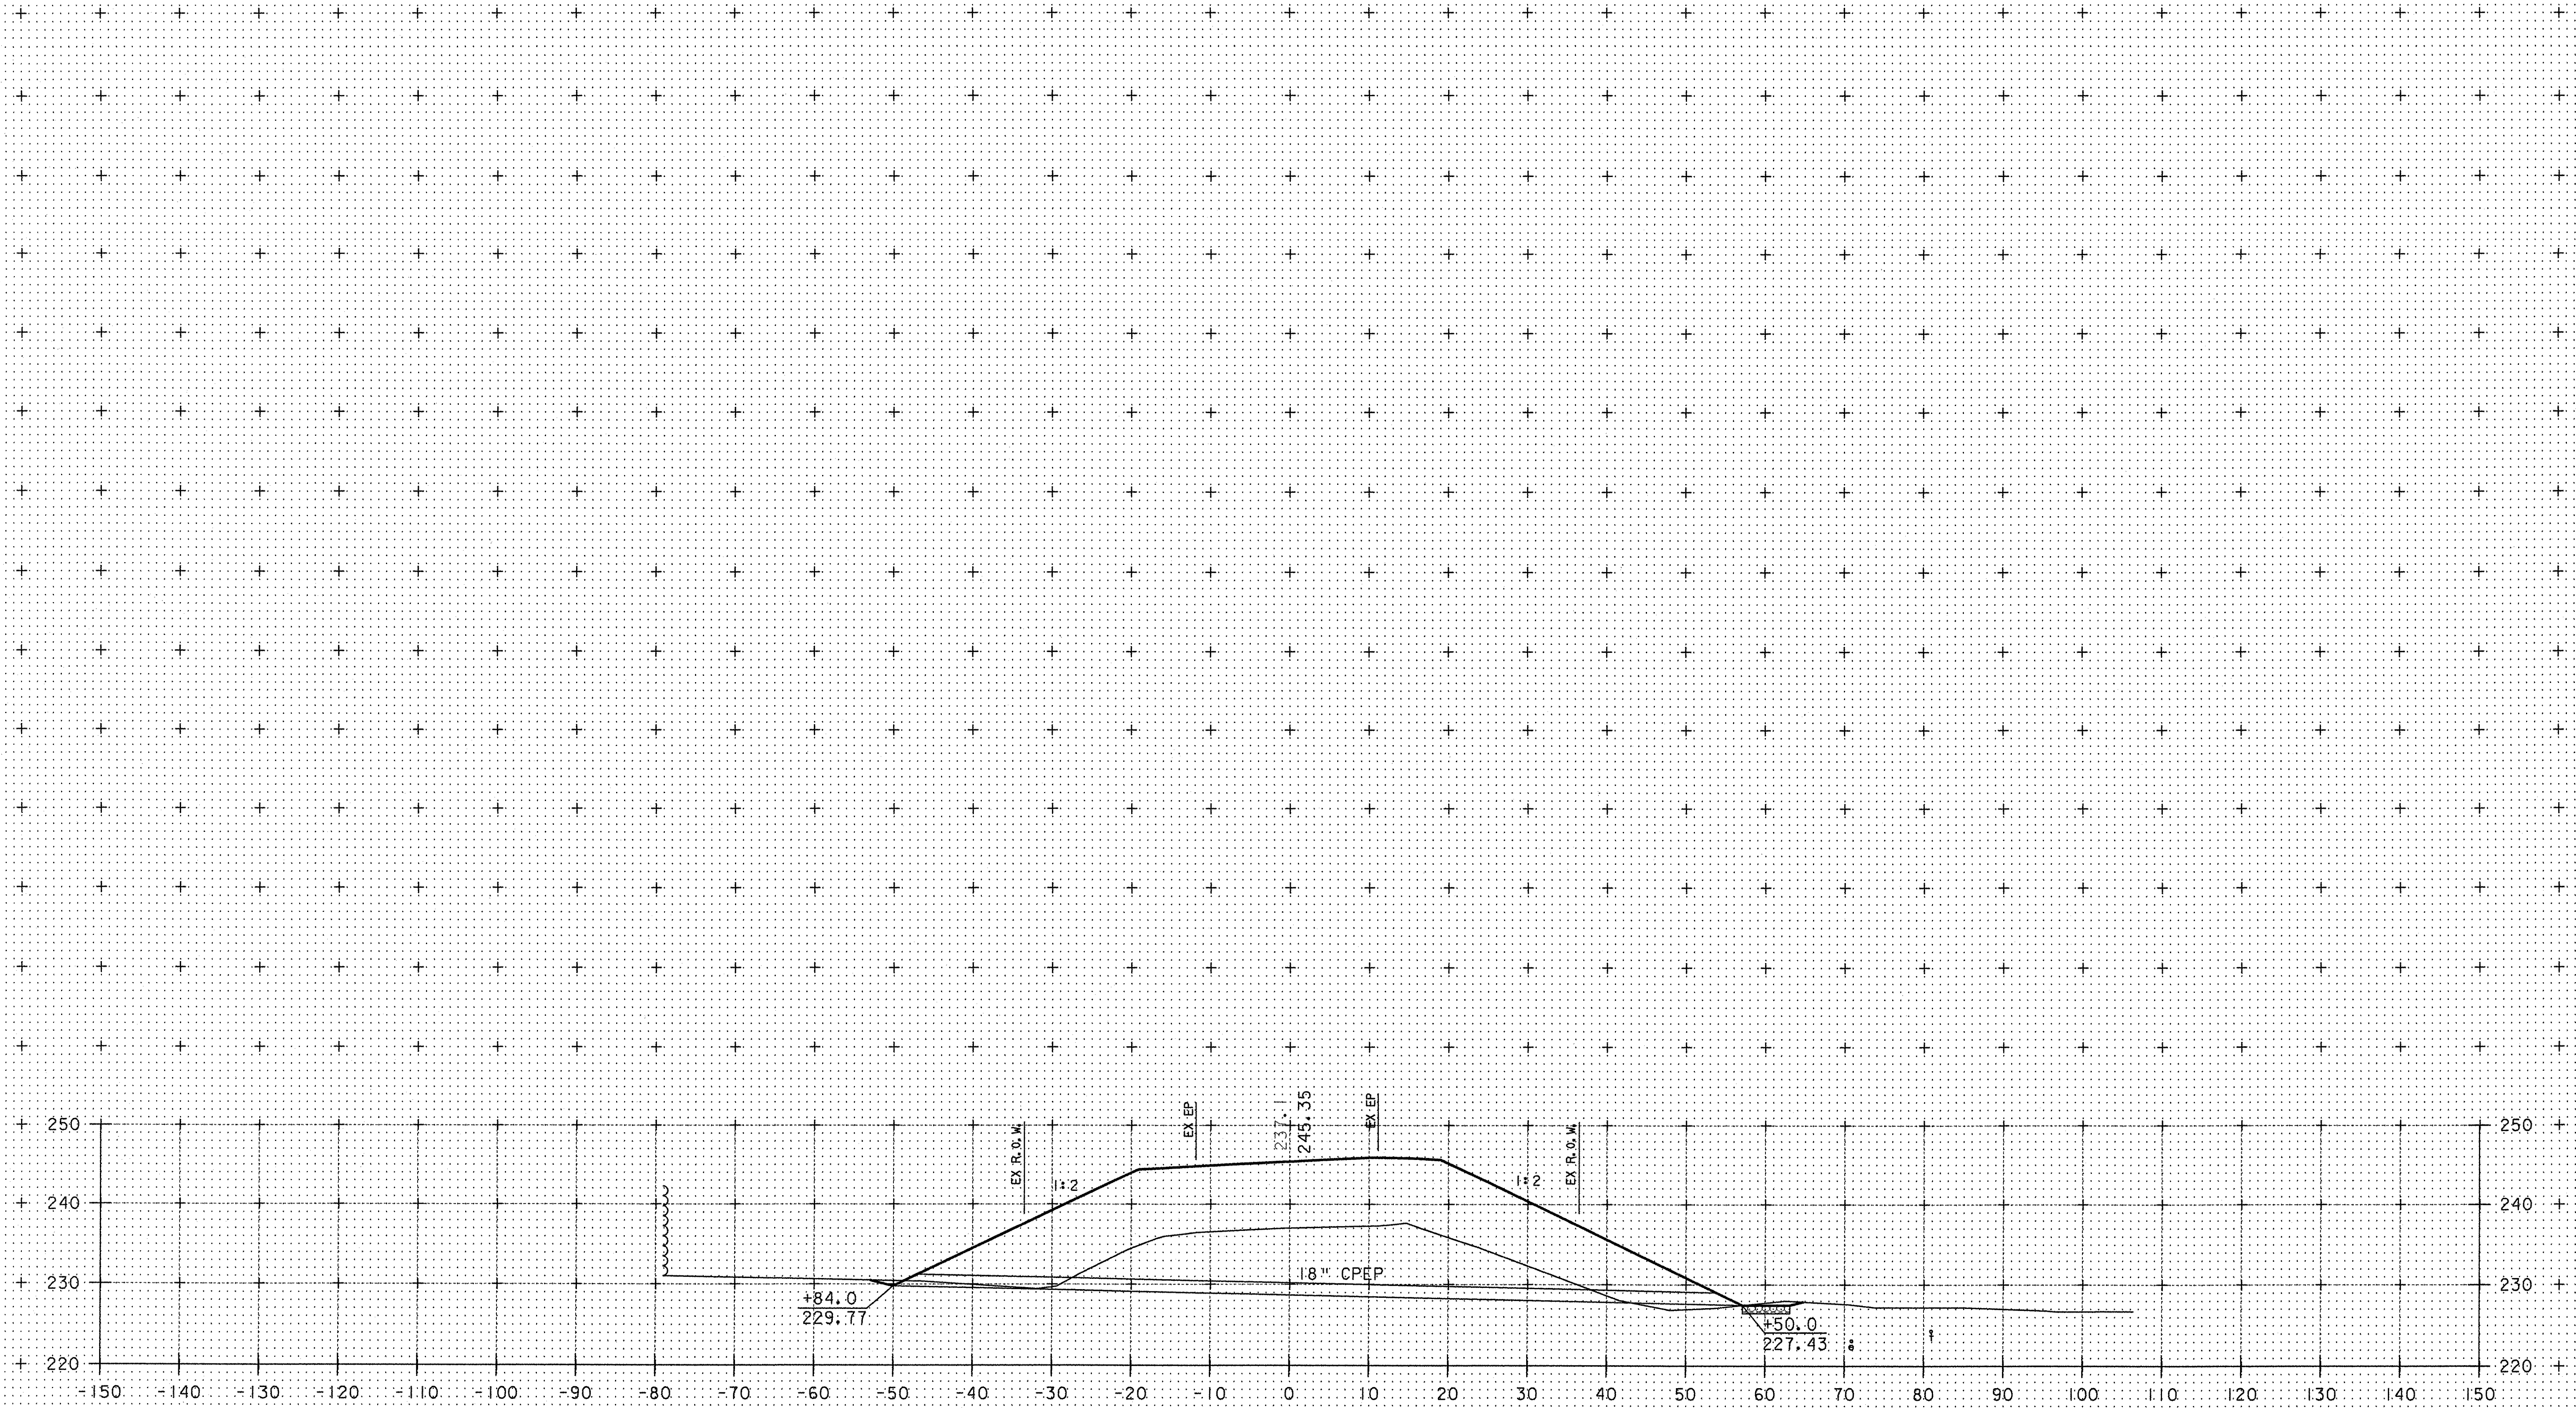


+21+68 (skewed)+

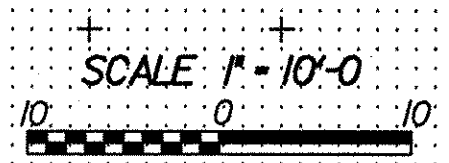


BOSTWICK ROAD	PROJECT NAME: SHELBURNE
	PROJECT NUMBER: BRO 1445(30)
	FILE NAME: M:\1595402 Bostwick\HWY\DRAW\J196wrk.dgn
	PROJECT LEADER: MBZ
DESIGNED BY: DMB	PLOT DATE: 01-AUG-2003
CHECKED BY: MDL	DRAWN BY: DMB
	SHEET 66 OF 73


SHOULDER TRANSITION		
STATION	LT	RT
22+00	-0.060	-0.017

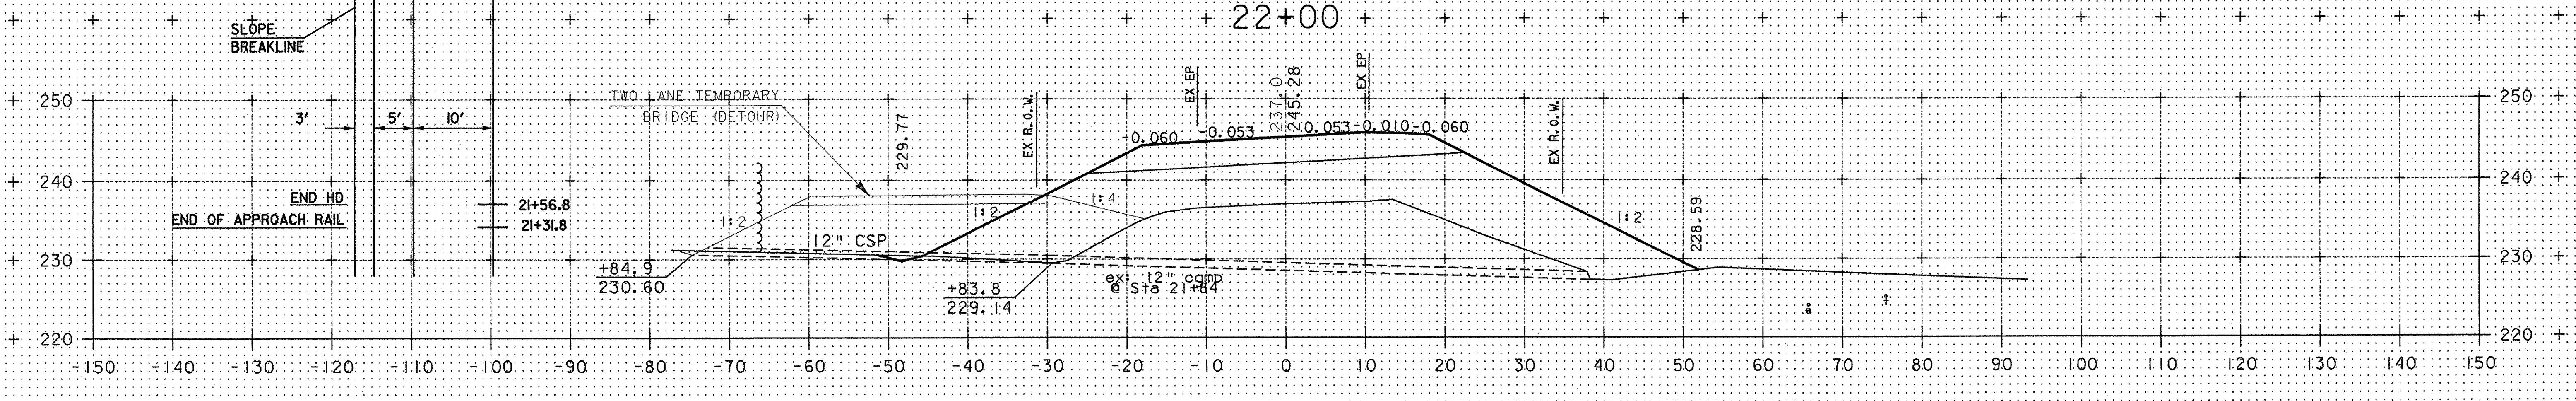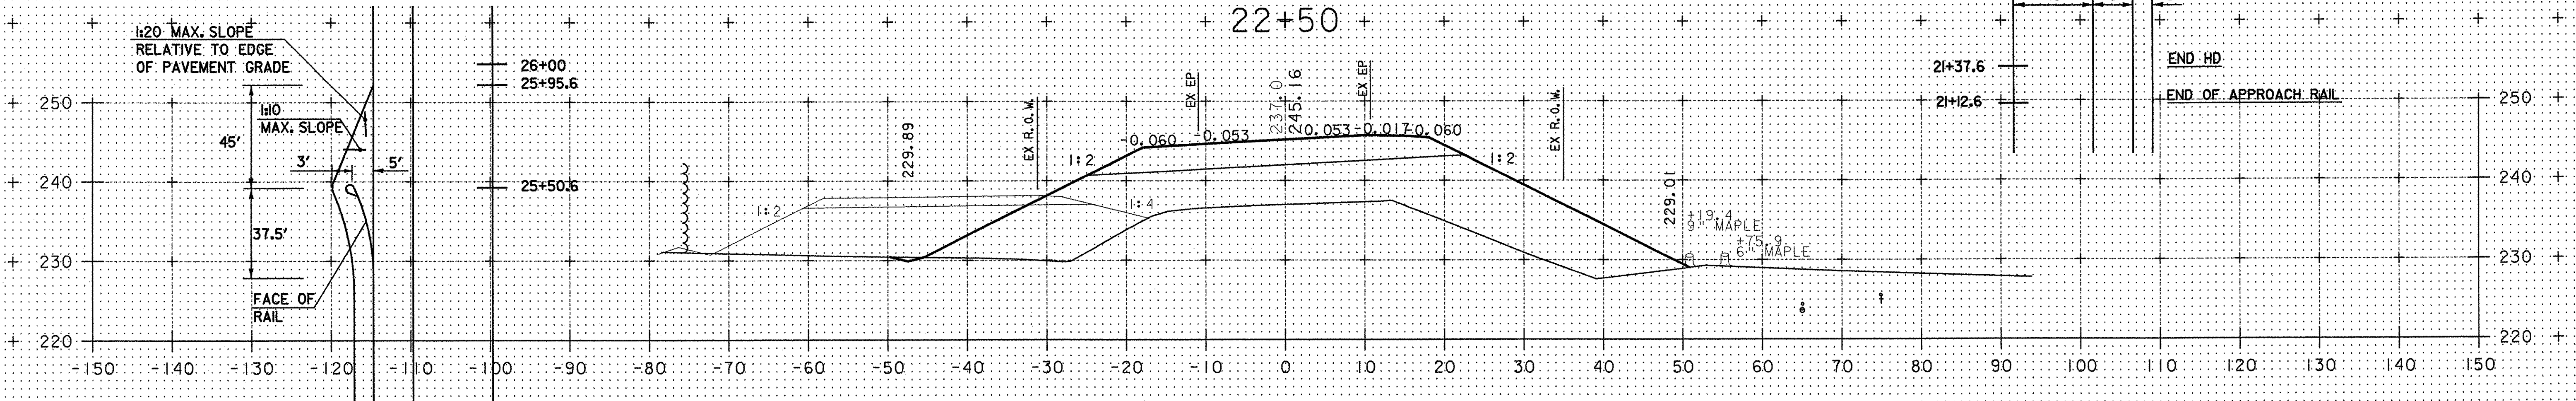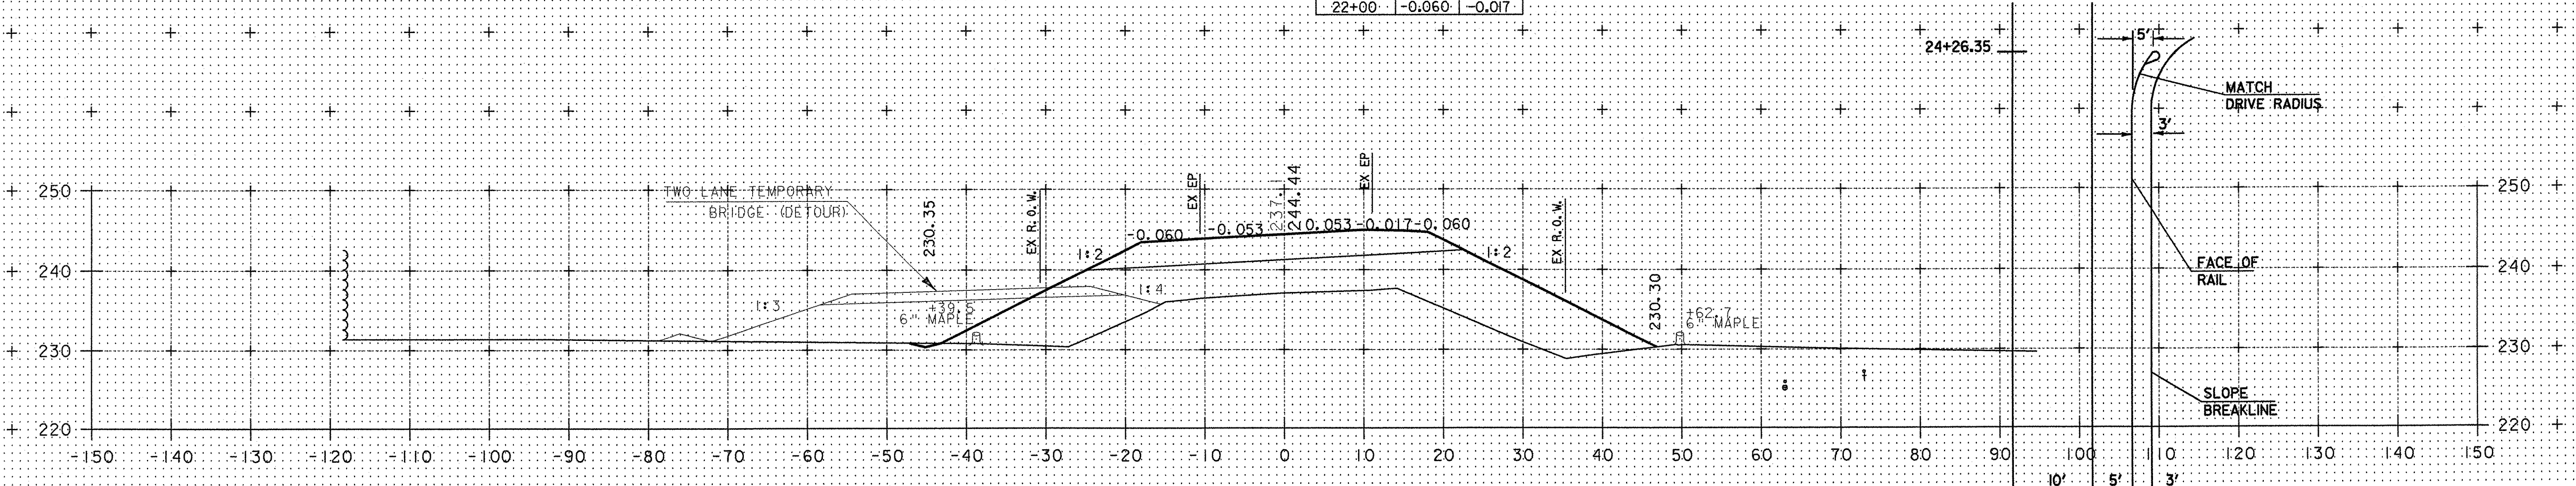


BOSTWICK ROAD

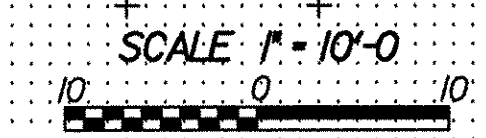


PROJECT NAME:	SHELBURNE
PROJECT NUMBER:	BRO 1445(30)
FILE NAME:	M:\1595402 Bostwick\HWY\DRAW\J196wrk.dgn
PROJECT LEADER:	MBZ
DESIGNED BY:	DMB
CHECKED BY:	MDL
PLOT DATE:	01-AUG-2003
DRAWN BY:	DMB
SHEET	67 OF 73

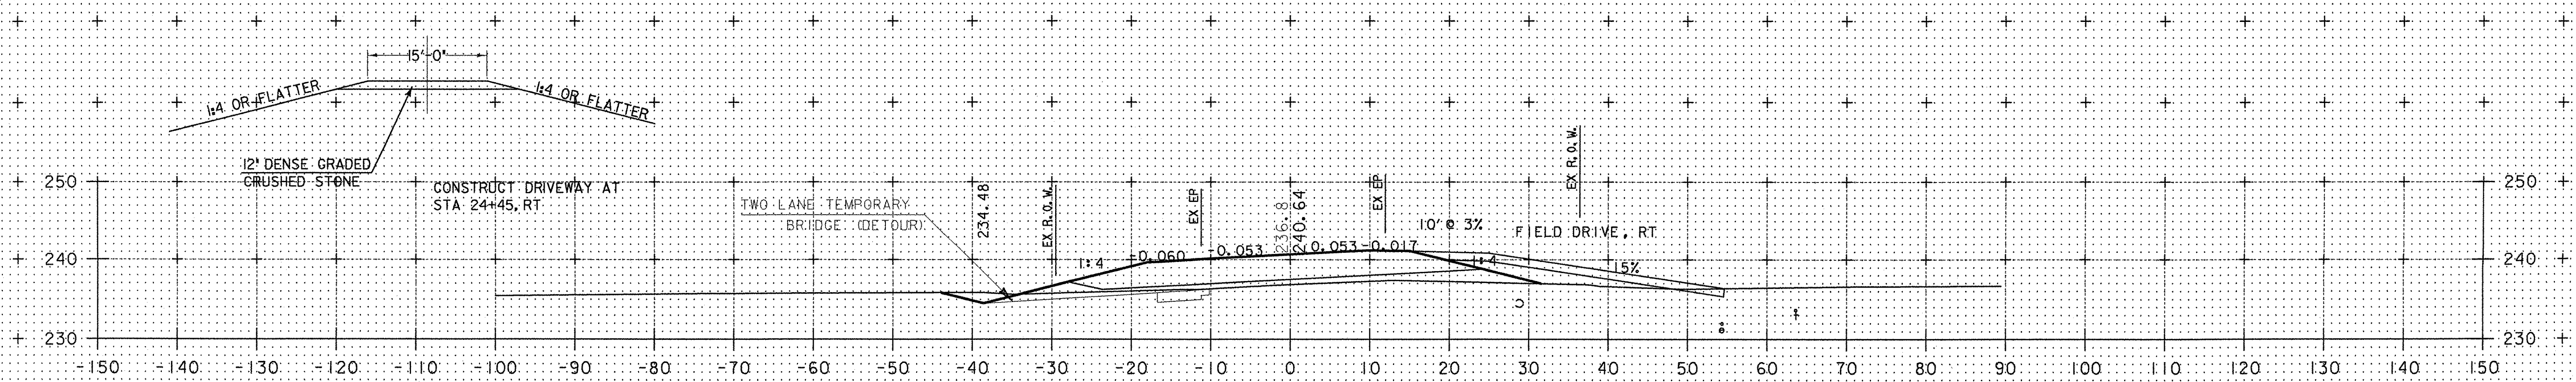


24+45

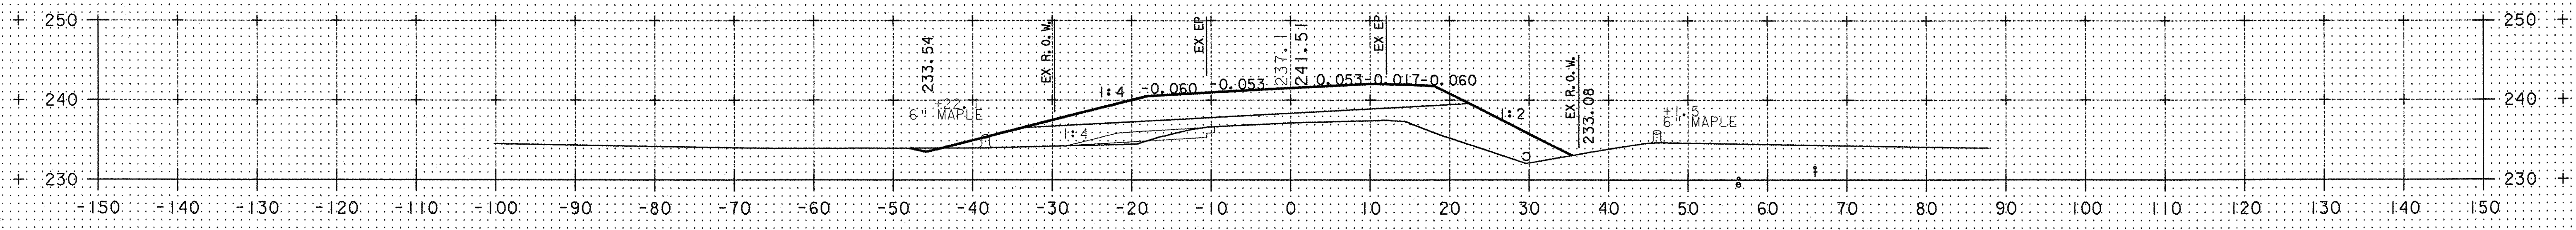


24+00

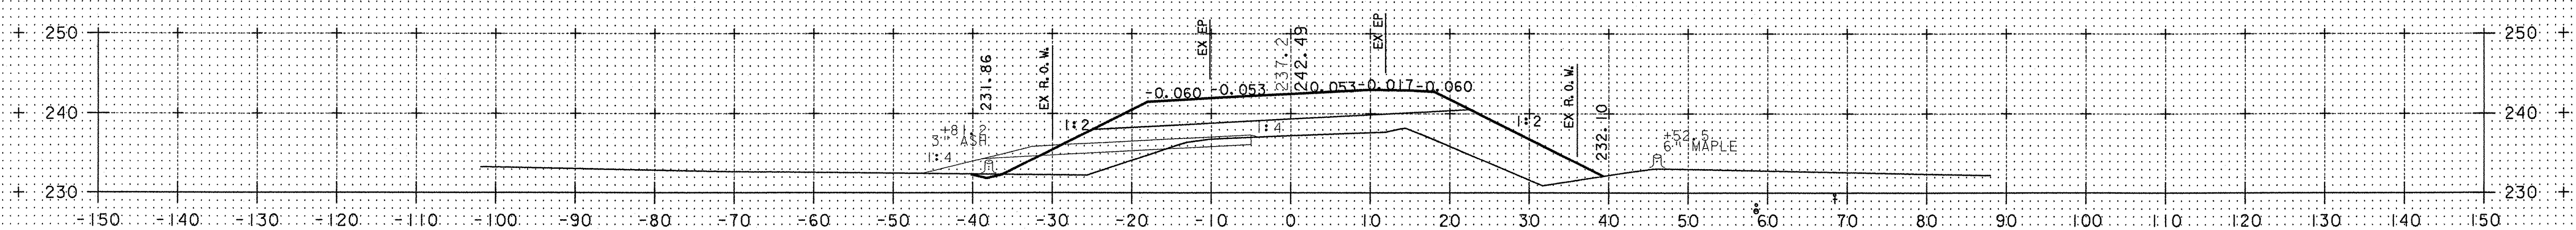

23+50

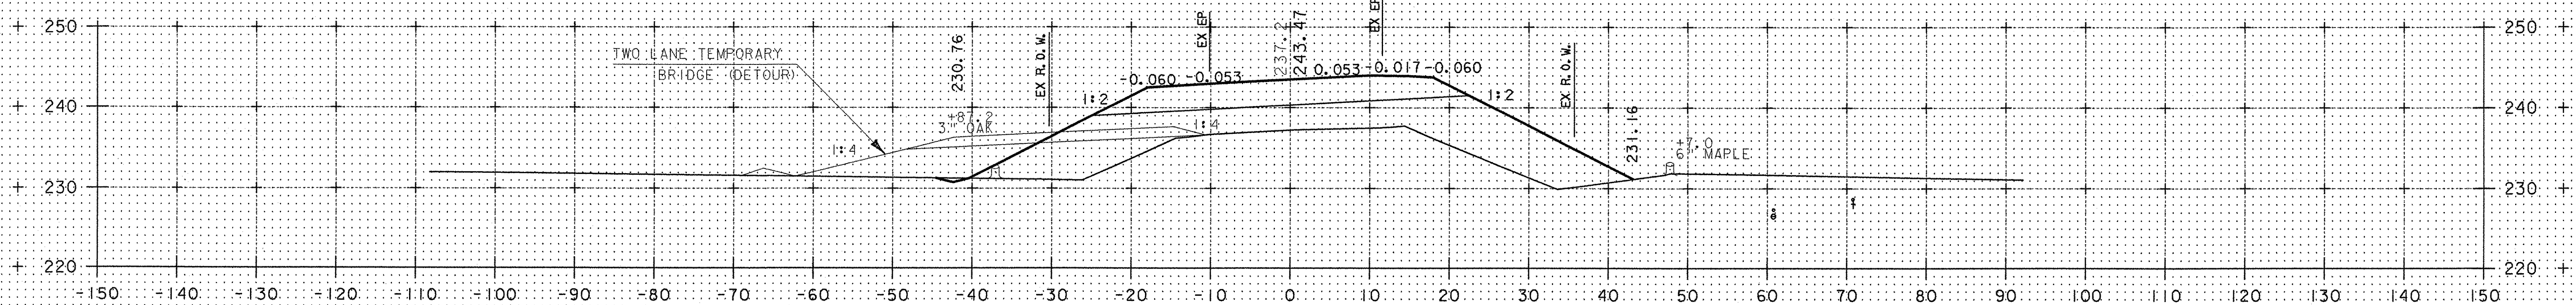


23+00

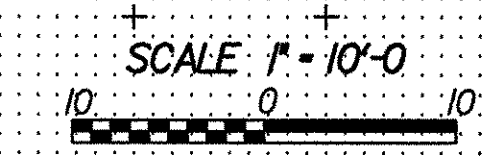


BOSTWICK ROAD


PROJECT NAME:	SHELburnE
PROJECT NUMBER:	BRO 1445(30)
FILE NAME:	M:\595402 Bostwick\HWY\DRAW\J96wrk.dgn
PROJECT LEADER:	MBZ
DESIGNED BY:	DMB
CHECKED BY:	MDL
PLOT DATE:	01-AUG-2003
DRAWN BY:	DMB
SHEET	68 OF 73

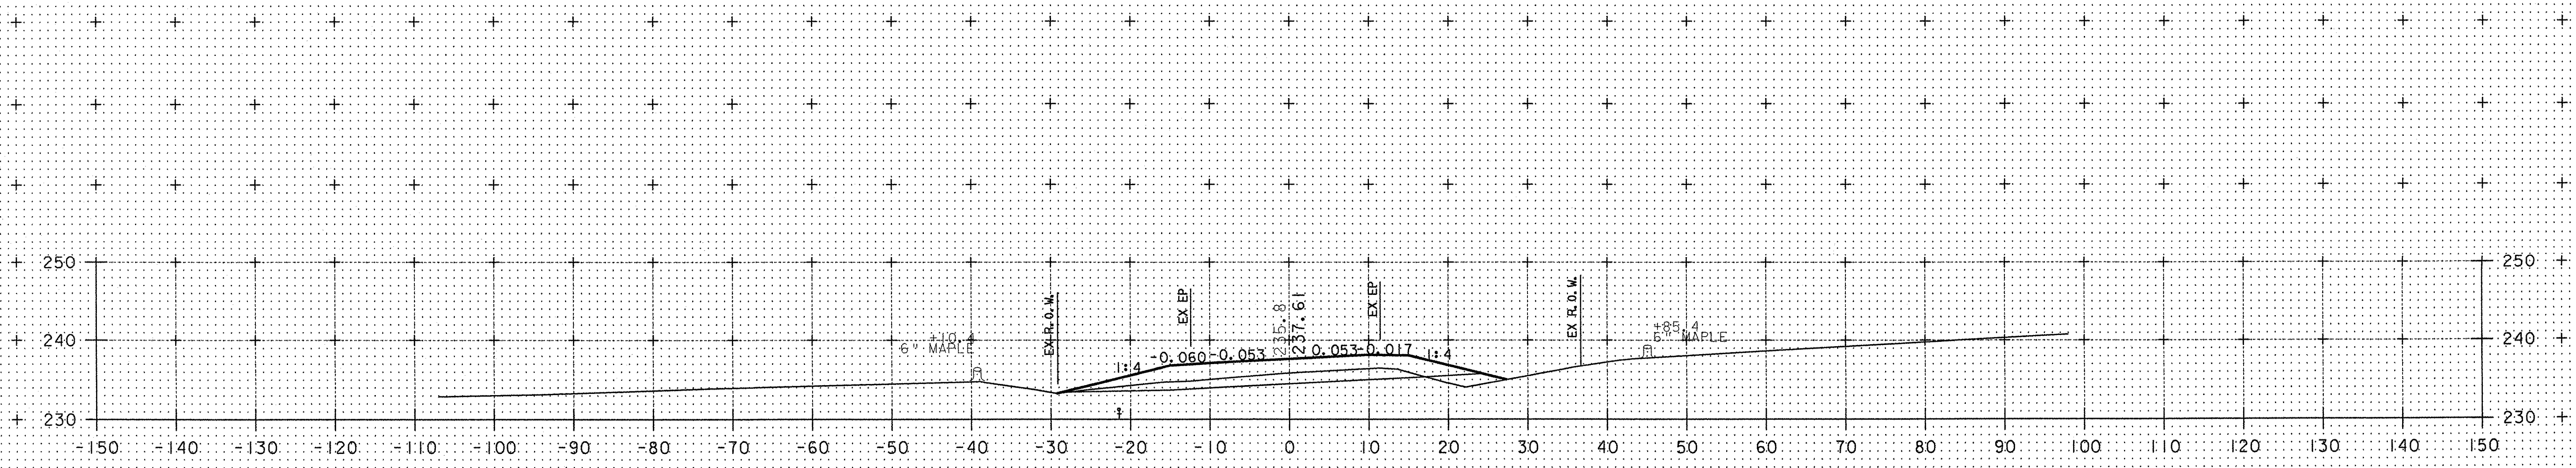


26+00

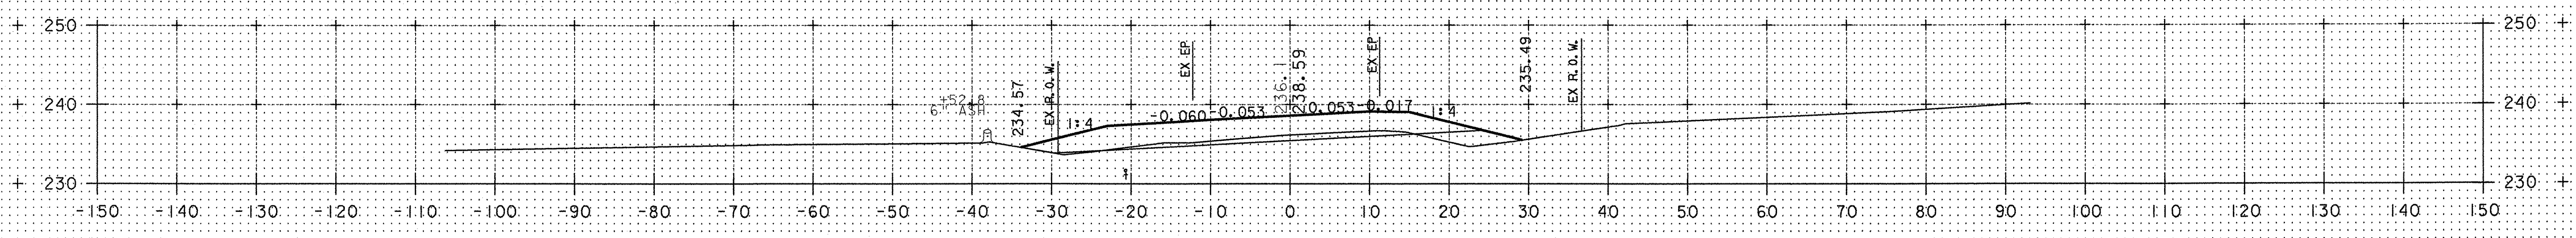


25+50

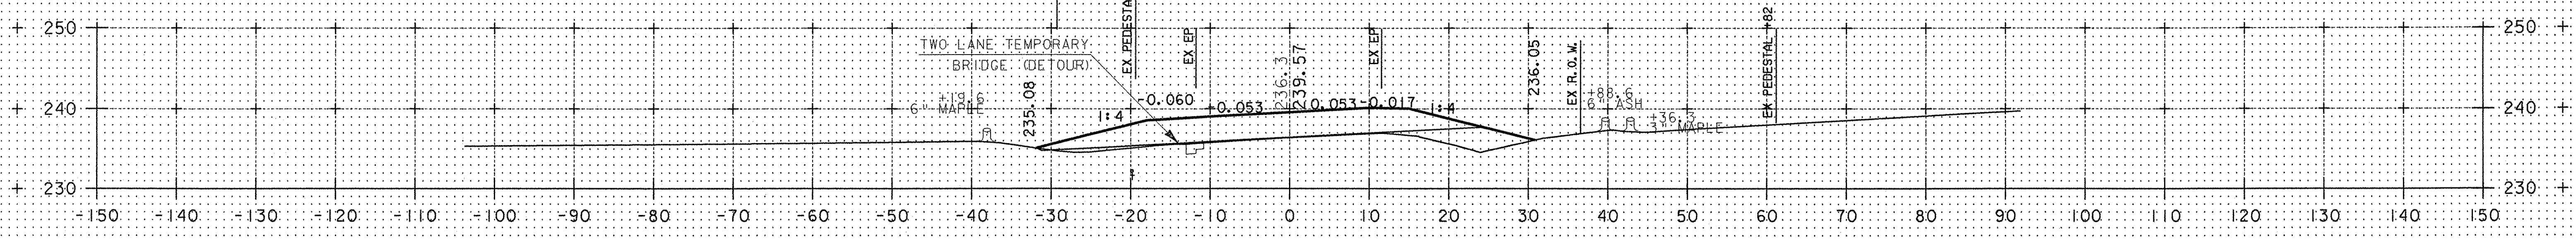

25+00




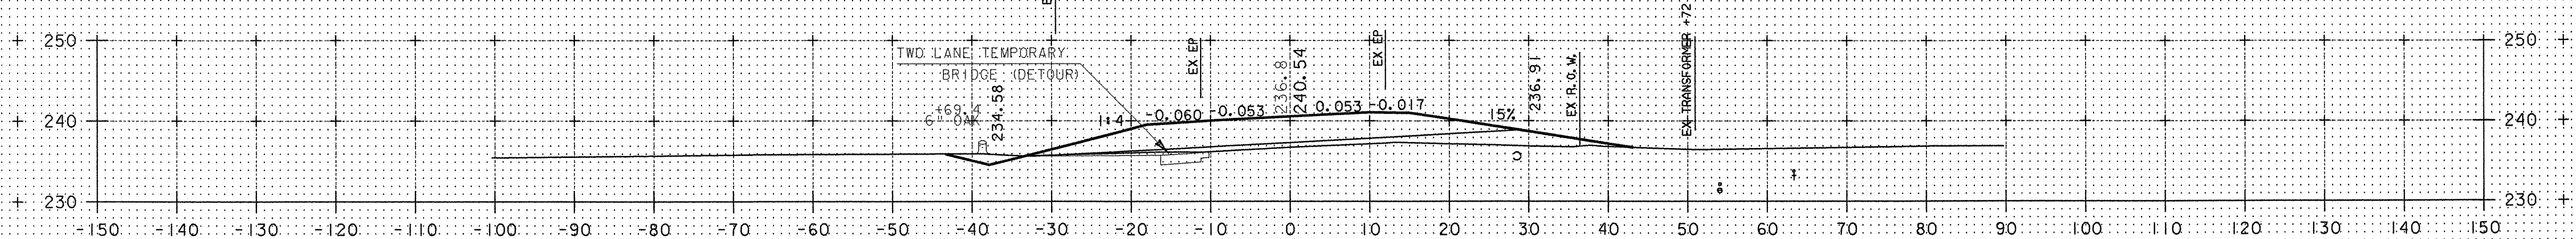


24+50

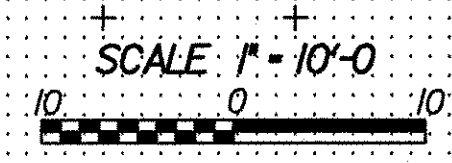

BOSTWICK ROAD

PROJECT NAME:	SHELBURNE
PROJECT NUMBER:	BRO 1445(30)
FILE NAME:	M:\1595402 Bostwick\HWY\DRAW\J196wrk.dgn
PROJECT LEADER:	MBZ
DESIGNED BY:	DMB
CHECKED BY:	MDL
PLOT DATE:	01-AUG-2003
DRAWN BY:	DMB
SHEET	69 OF 73

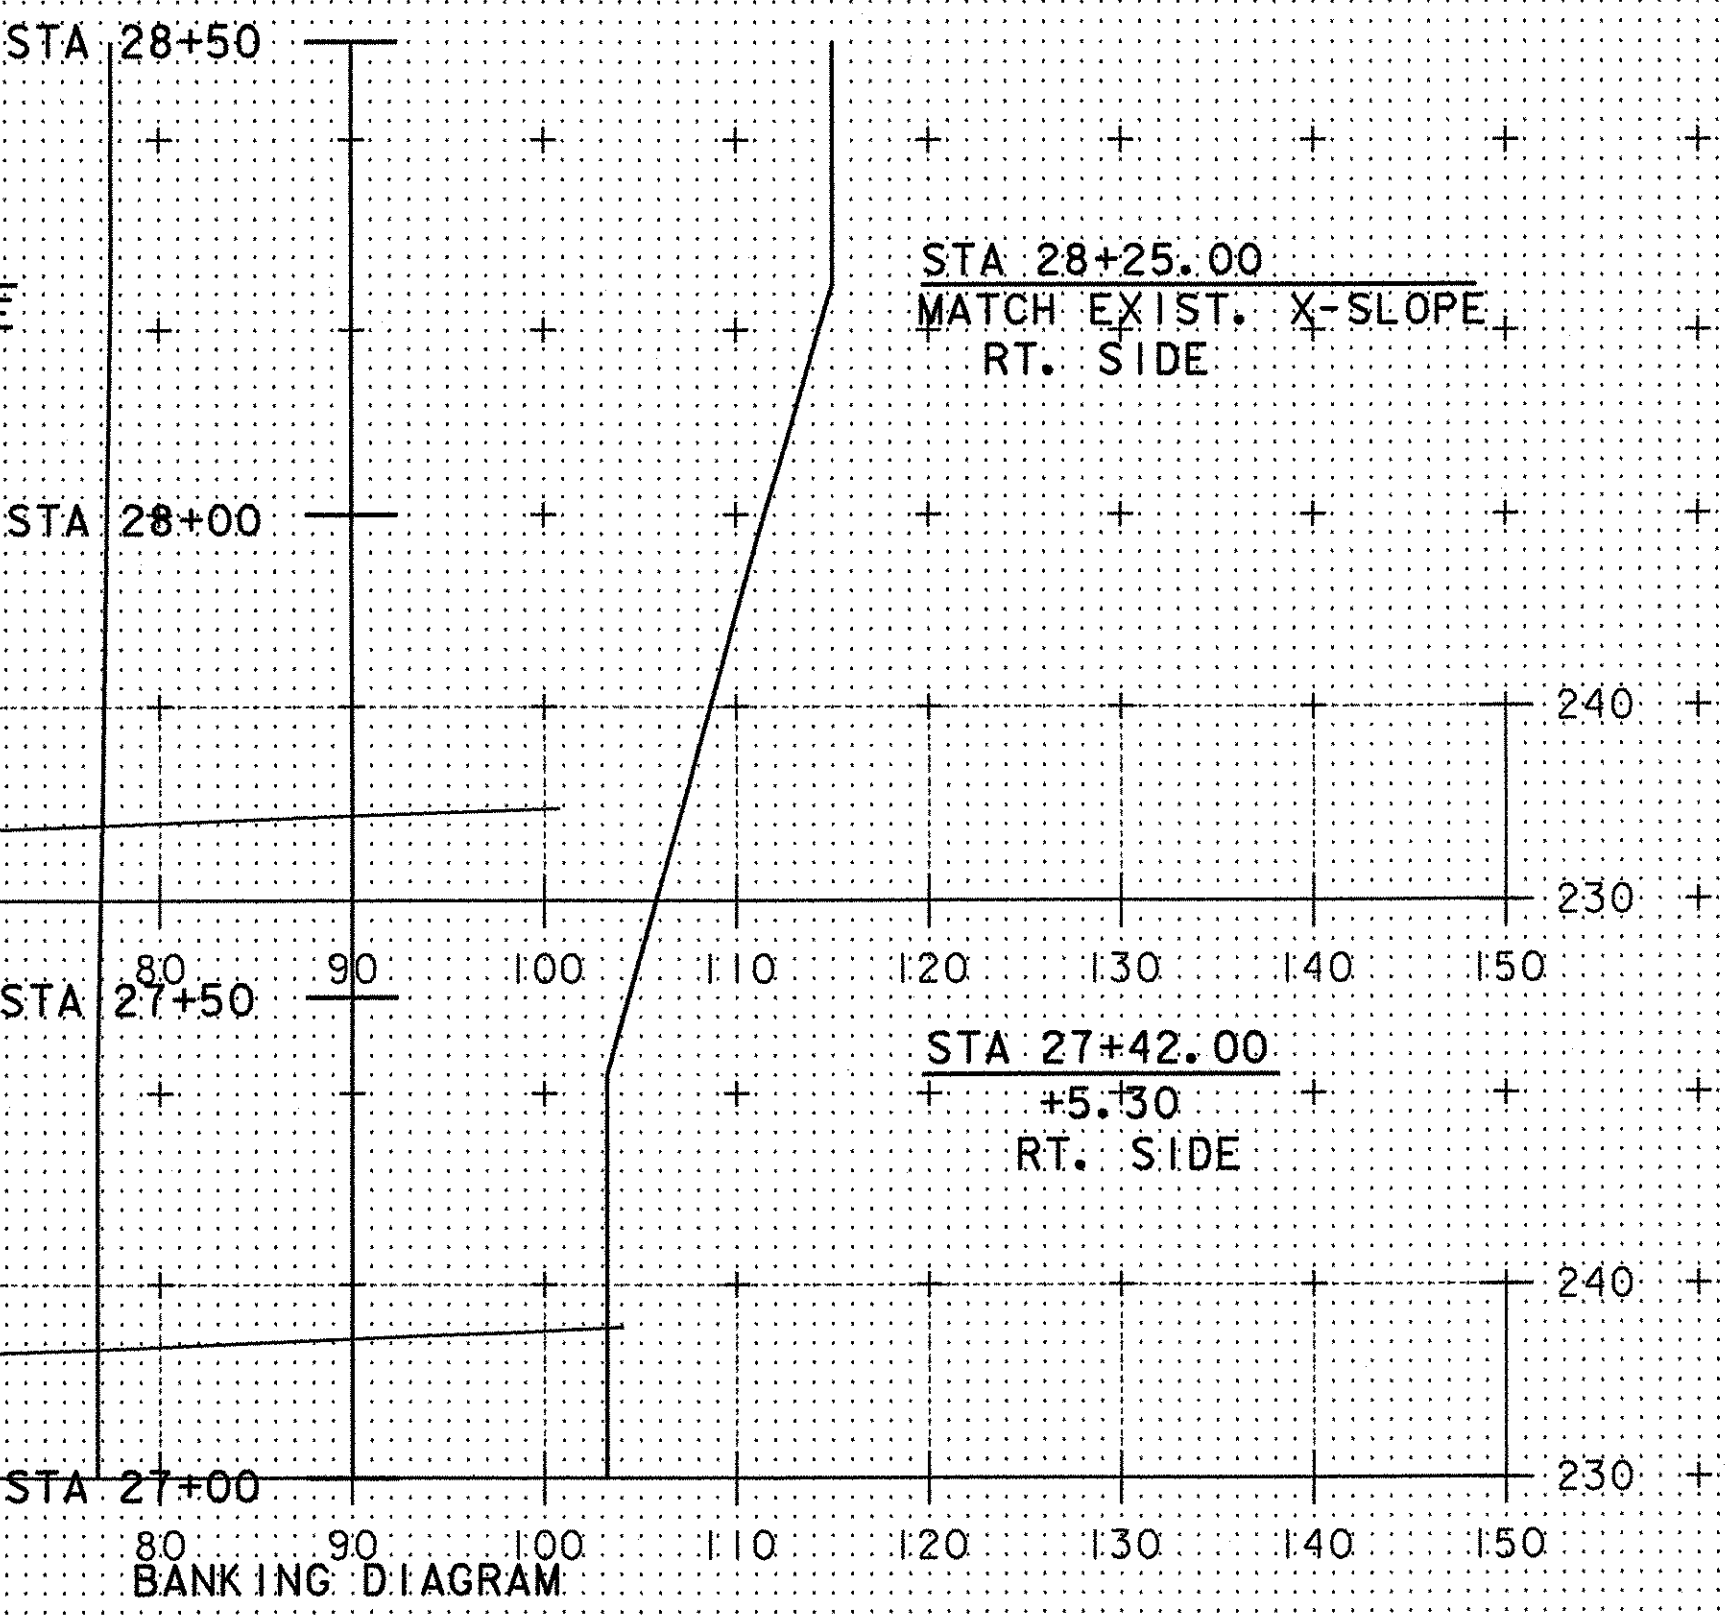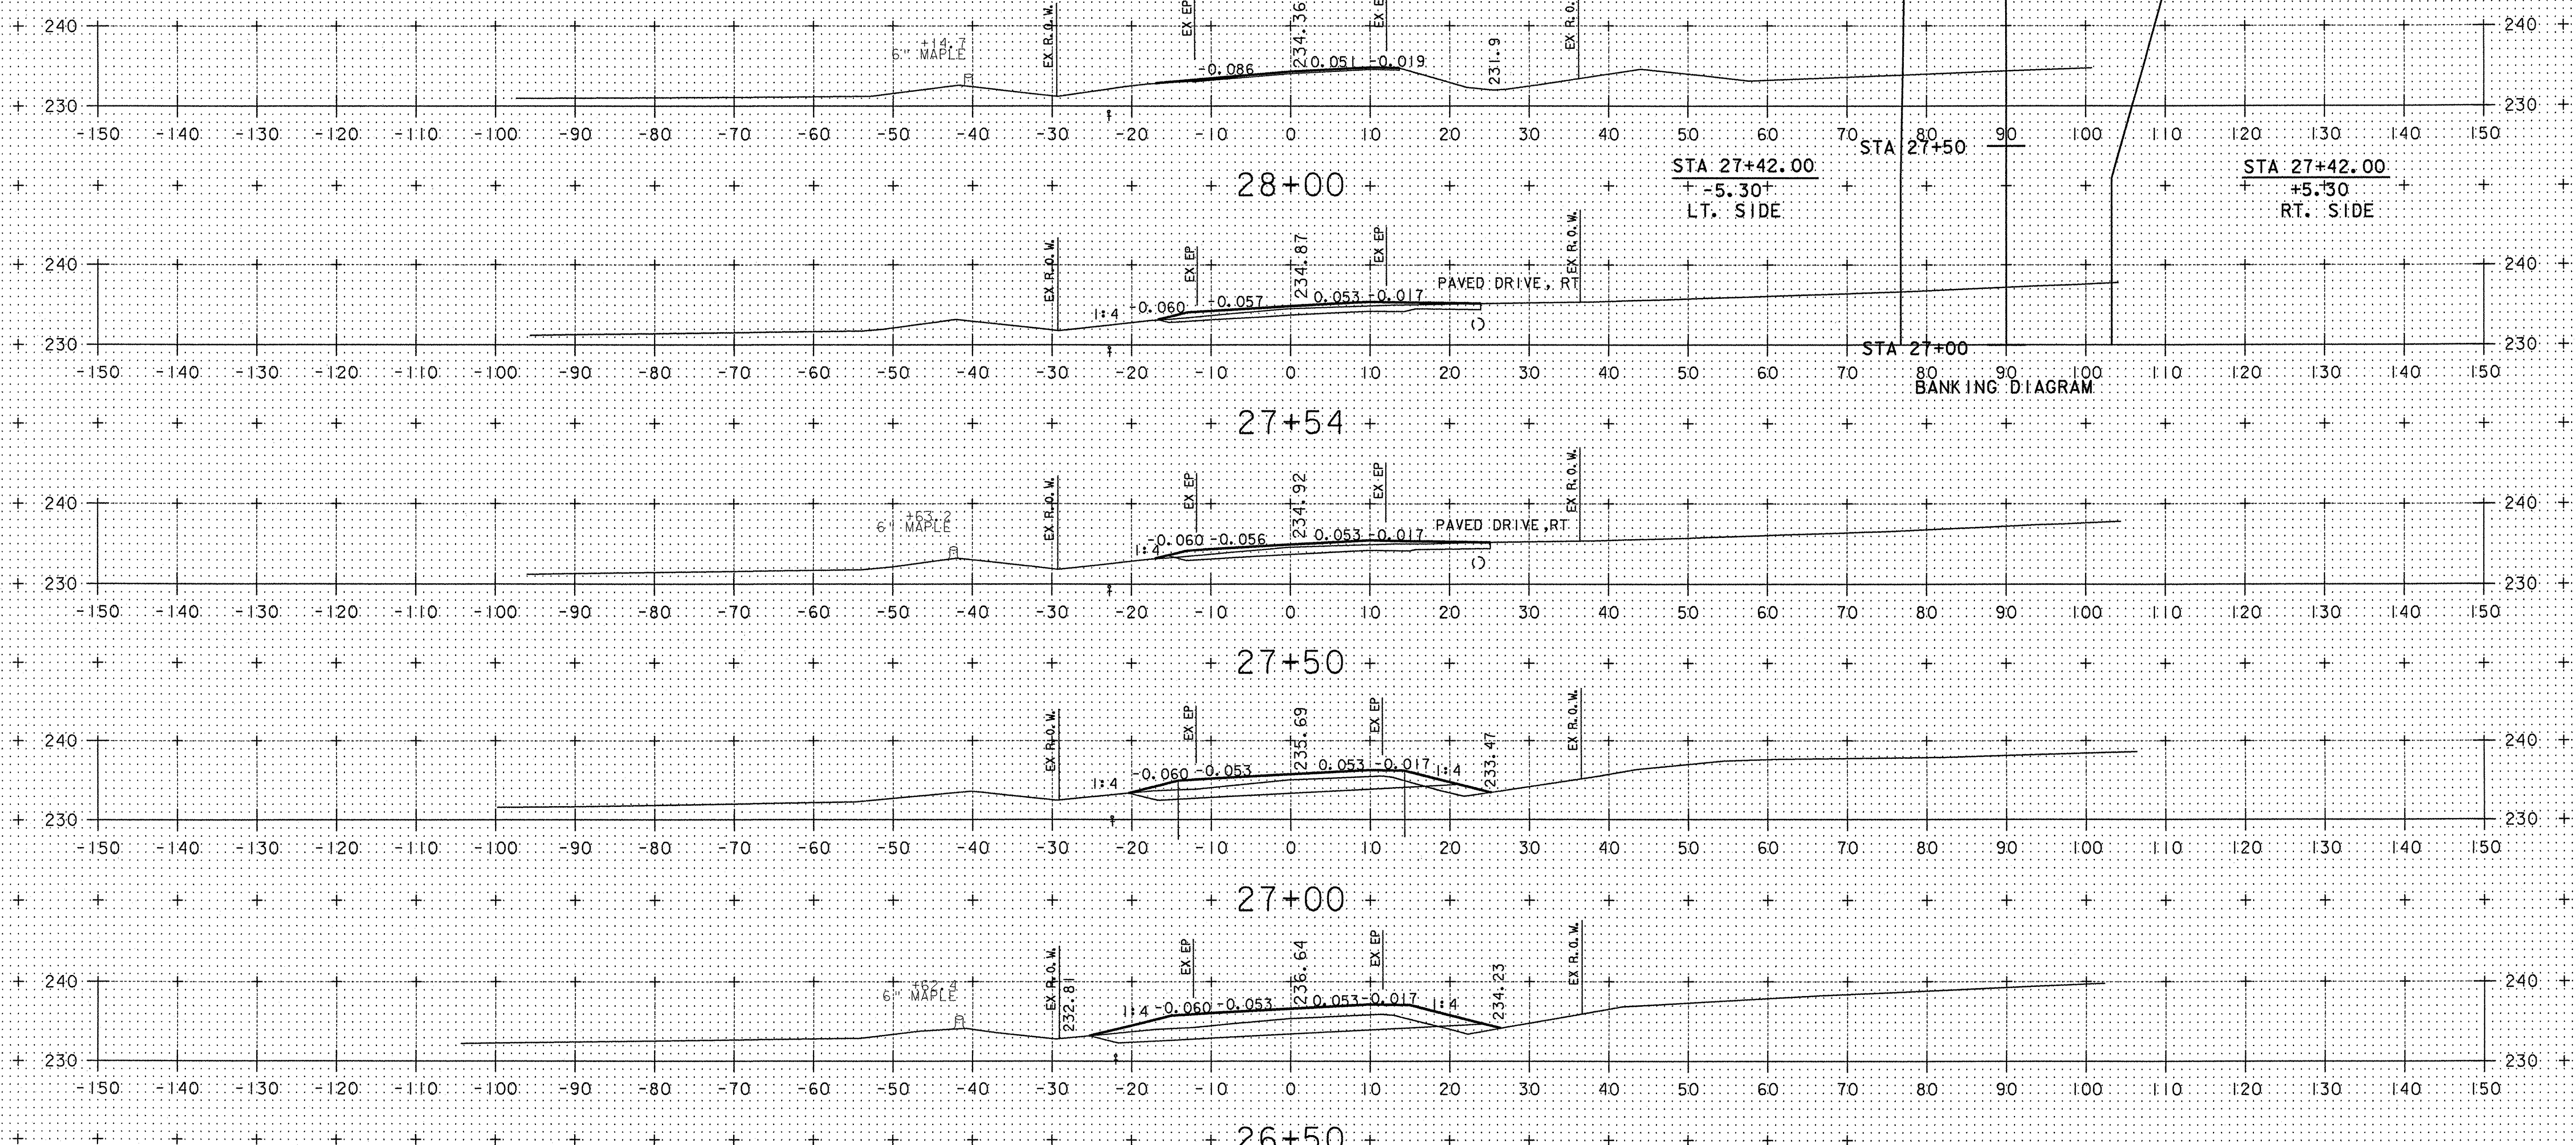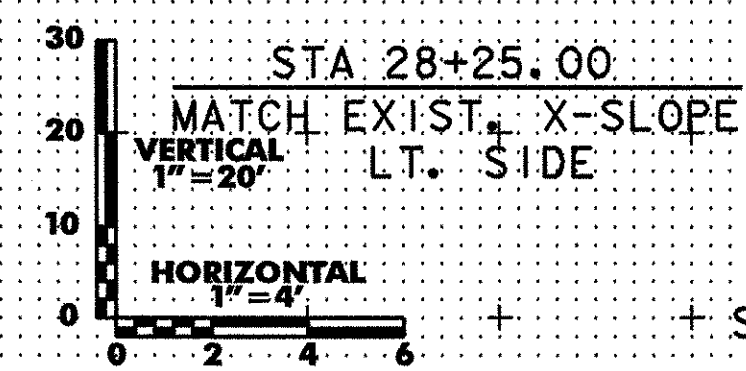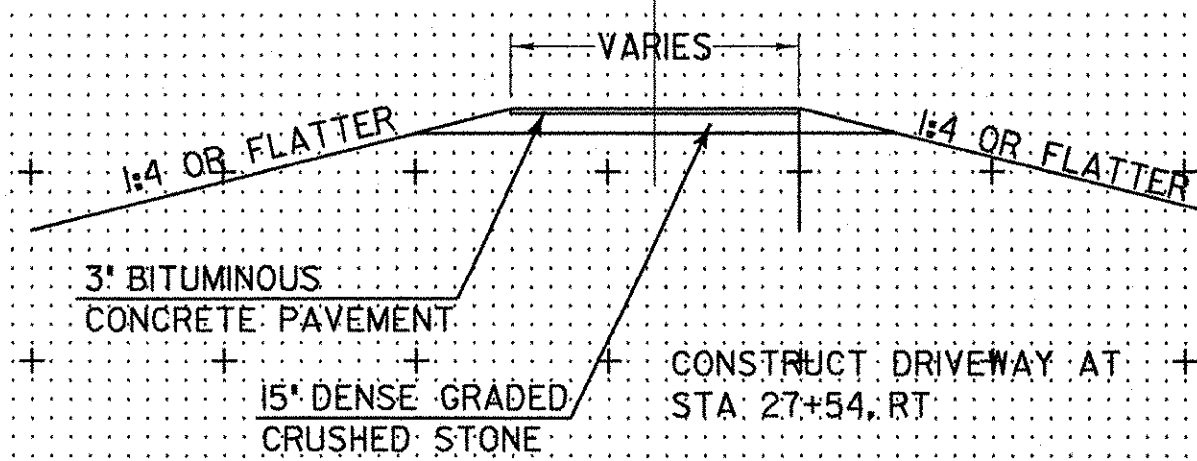

BOSTWICK ROAD	PROJECT NAME: SHELBURNE
	PROJECT NUMBER: BRO 1445(30)
	FILE NAME: M:\1595402 Bostwick\HWY\DRAW\J196wrk.dgn
	PROJECT LEADER: MBZ PLOT DATE: 01-AUG-2003
DESIGNED BY: DMB DRAWN BY: DMB	
CHECKED BY: MDL SHEET 70 OF 73	



STATION 26+75

STATION 27+75

STATION 28+25

LIMITS OF COLD PLANING

25


25

ASPHALT


DENSE GRADED CRUSHED STONE

SAND


40

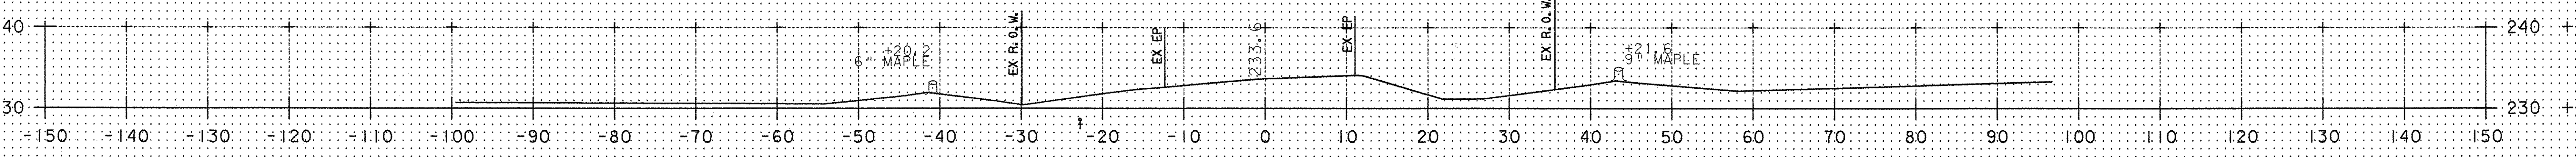


29+00

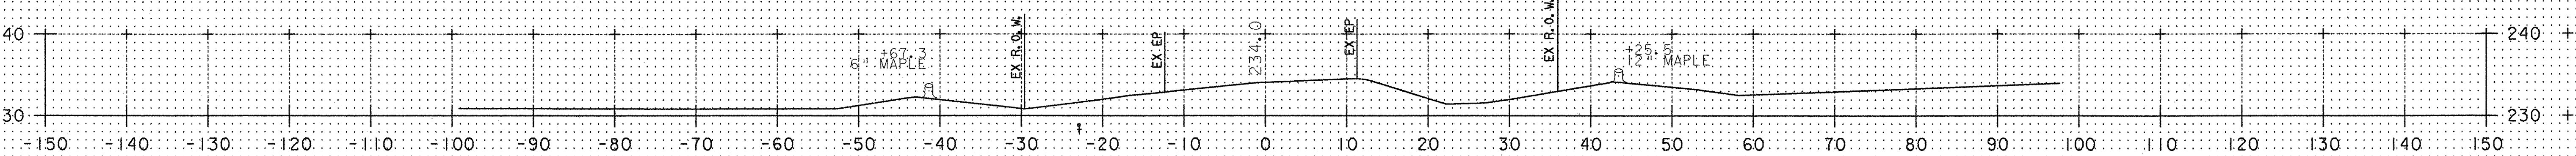

28+50




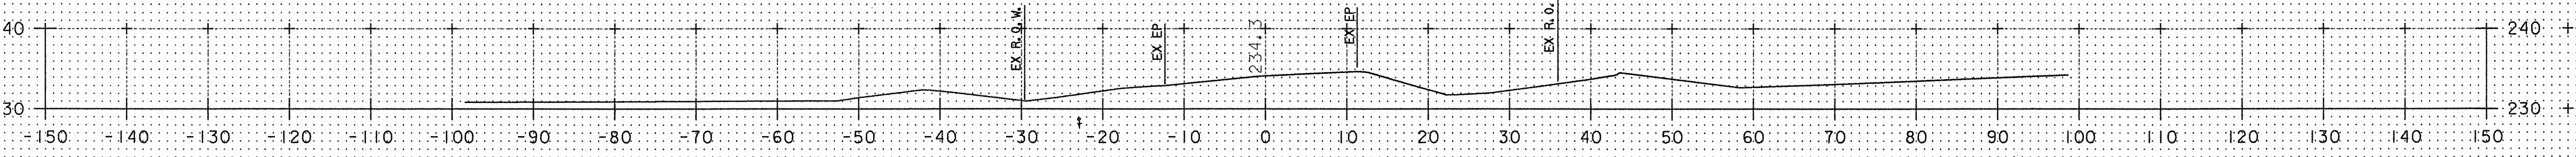


28+25

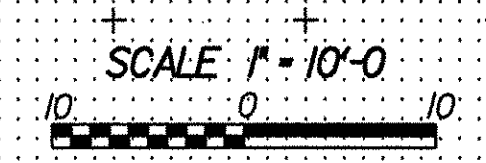



BOSTWICK ROAD

PROJECT NAME:	SHELBURNE
PROJECT NUMBER:	BRO 1445(30)
FILE NAME:	M:\595402 Bostwick\HWY\DRAW\J196wrk.dgn
PROJECT LEADER:	MBZ
DESIGNED BY:	DMB
CHECKED BY:	MDL
PLOT DATE:	01-AUG-2003
DRAWN BY:	DMB
SHEET	71 OF 73

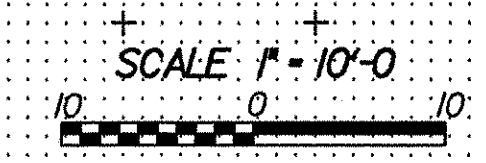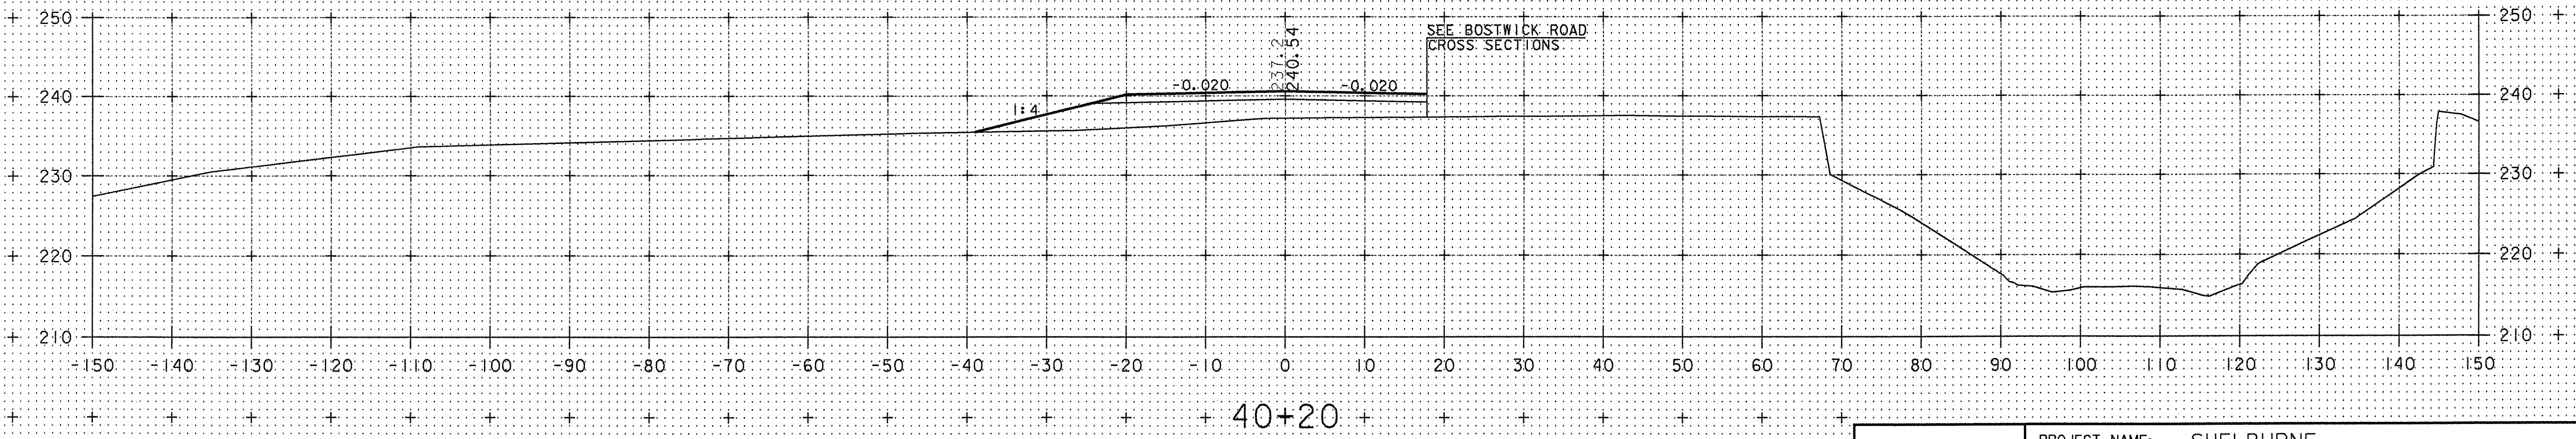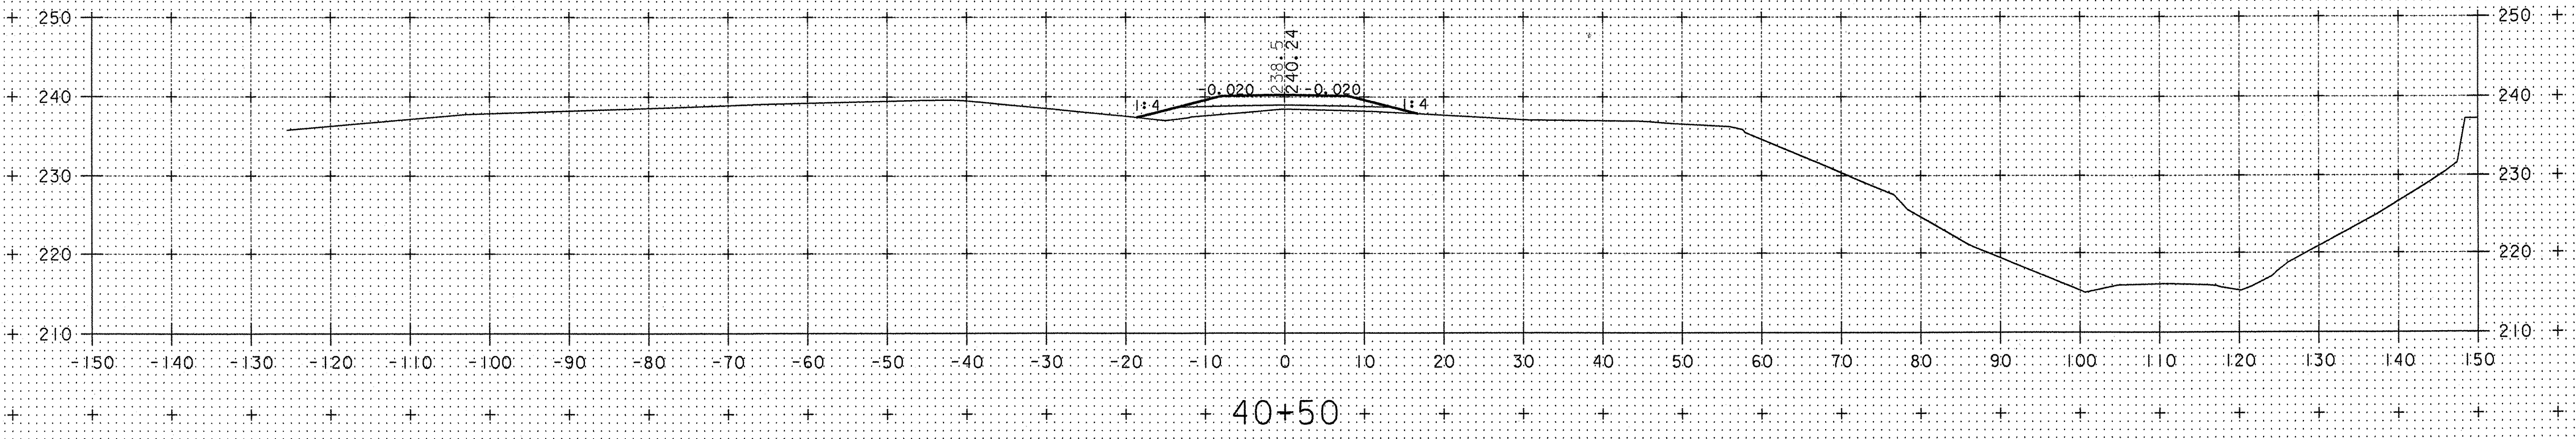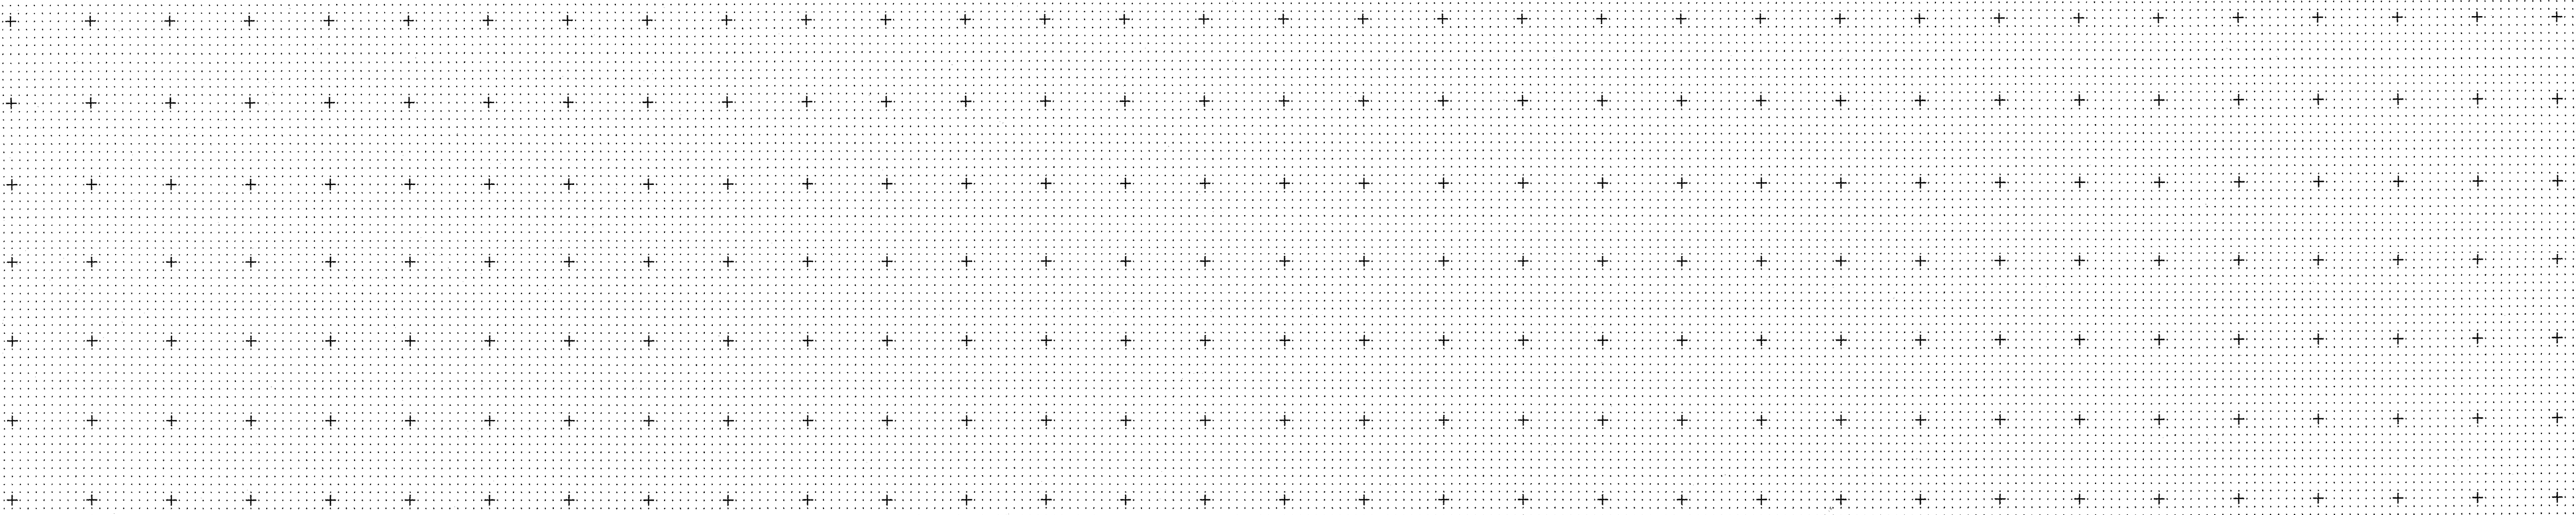


**BOSTWICK
FARM
ROAD
DRIVE**

PROJECT NAME:	SHELBURNE
PROJECT NUMBER:	BRO 1445(30)
FILE NAME:	M:\1595402 Bostwick\HWY\DRAW\J196wrk.dgn
PROJECT LEADER:	MBZ
DESIGNED BY:	DMB
CHECKED BY:	MDL
PLOT DATE:	01-AUG-2003
DRAWN BY:	DMB
SHEET	72 OF 73

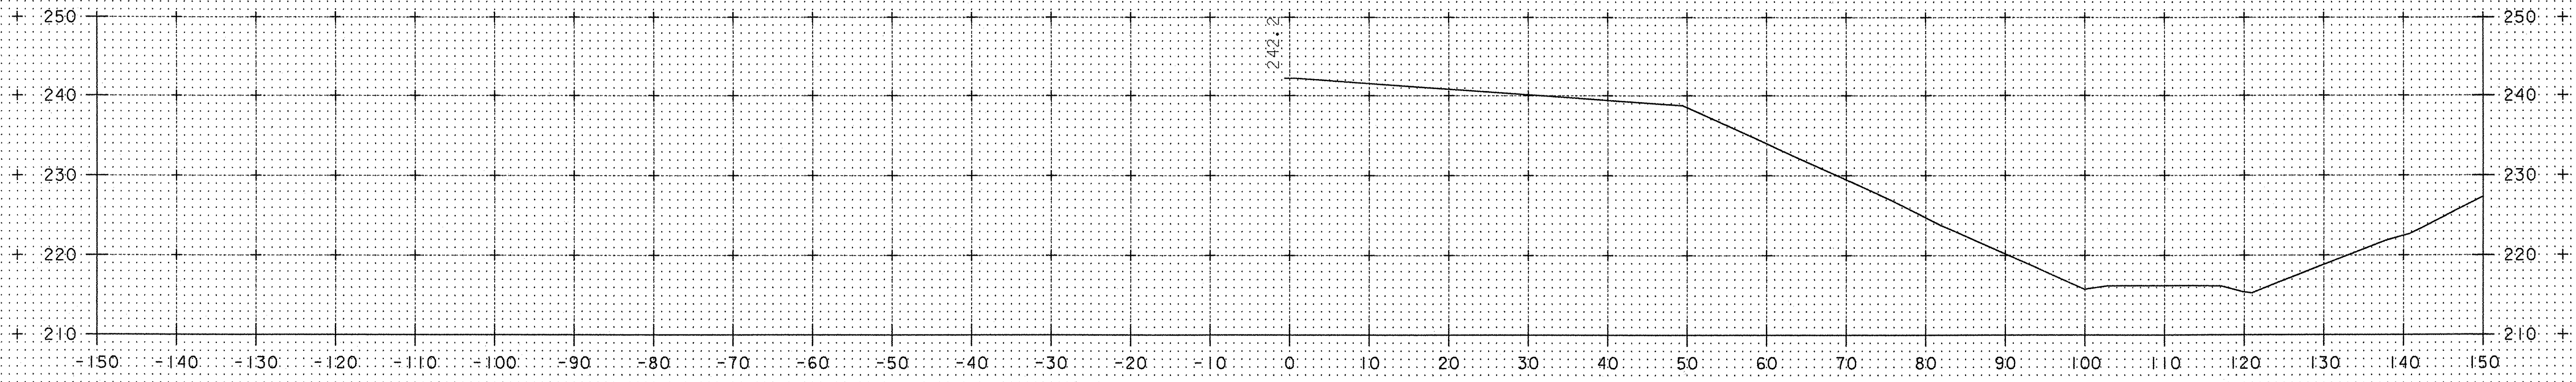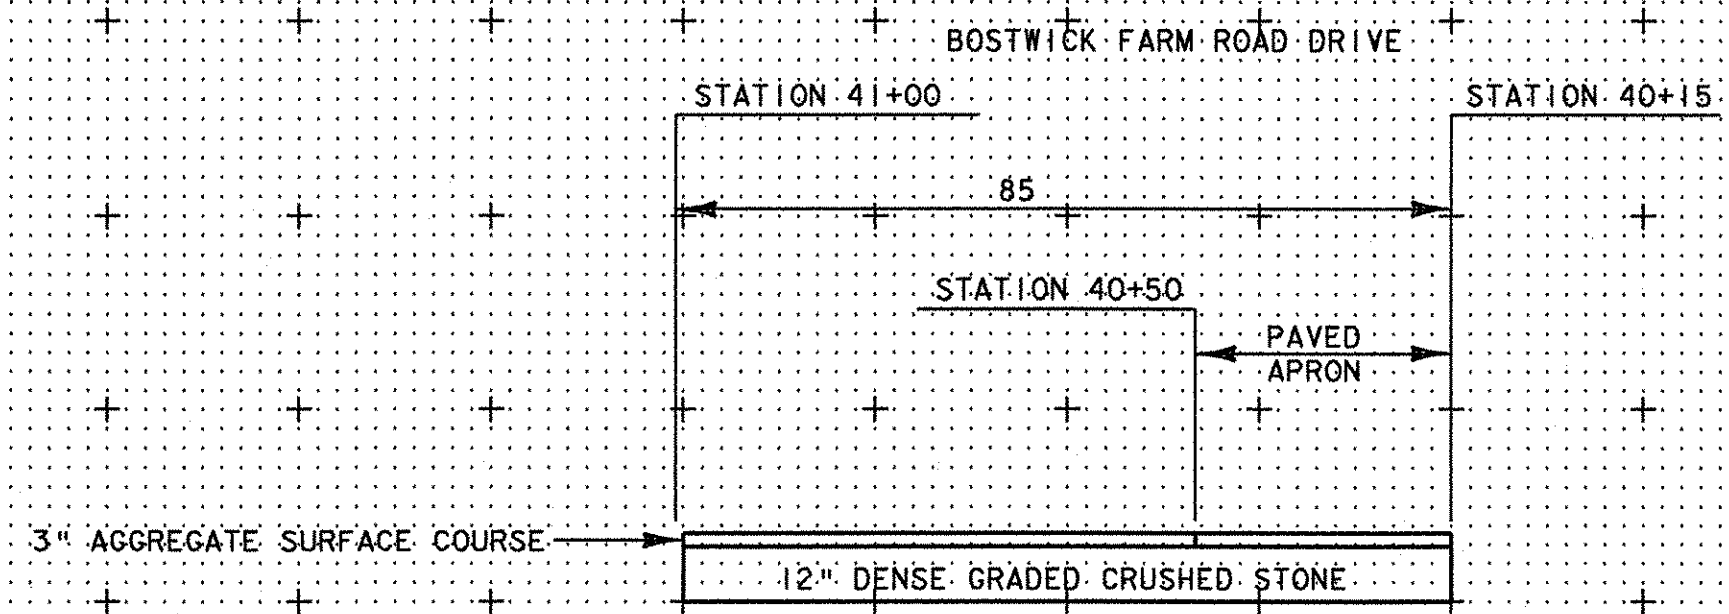


41+32


STATION 41+00 LIMIT OF WORK

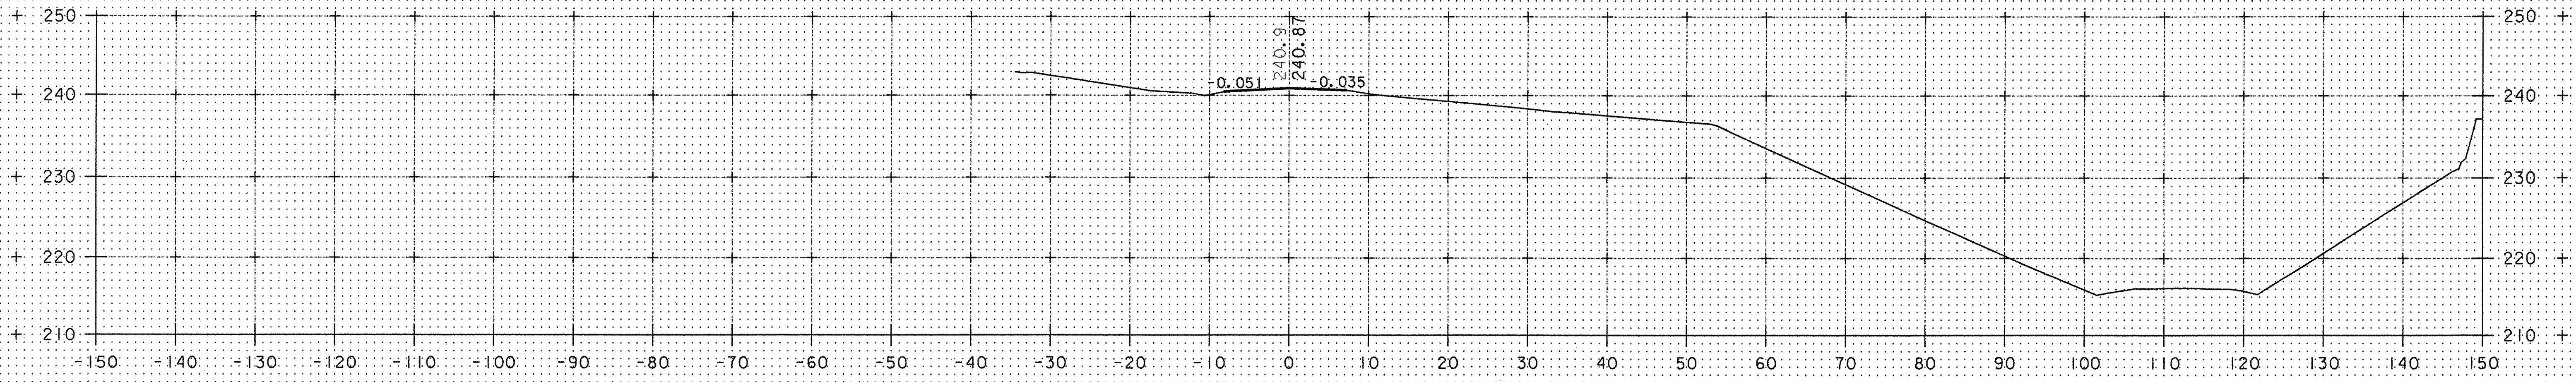

41+00

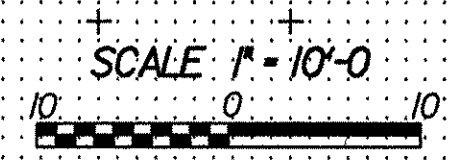

BOSTWICK FARM ROAD DRIVE	PROJECT NAME: SHELBURNE
	PROJECT NUMBER: BRO 1445(30)
	FILE NAME: M:\1595402 Bostwick\HWY\DRAW\J196wrk.dgn
	DESIGNED BY: DMB
DESIGNED BY: DMB	PLOT DATE: 01-AUG-2003
CHECKED BY: MDL	DRAWN BY: DMB
	SHEET 73 OF 73

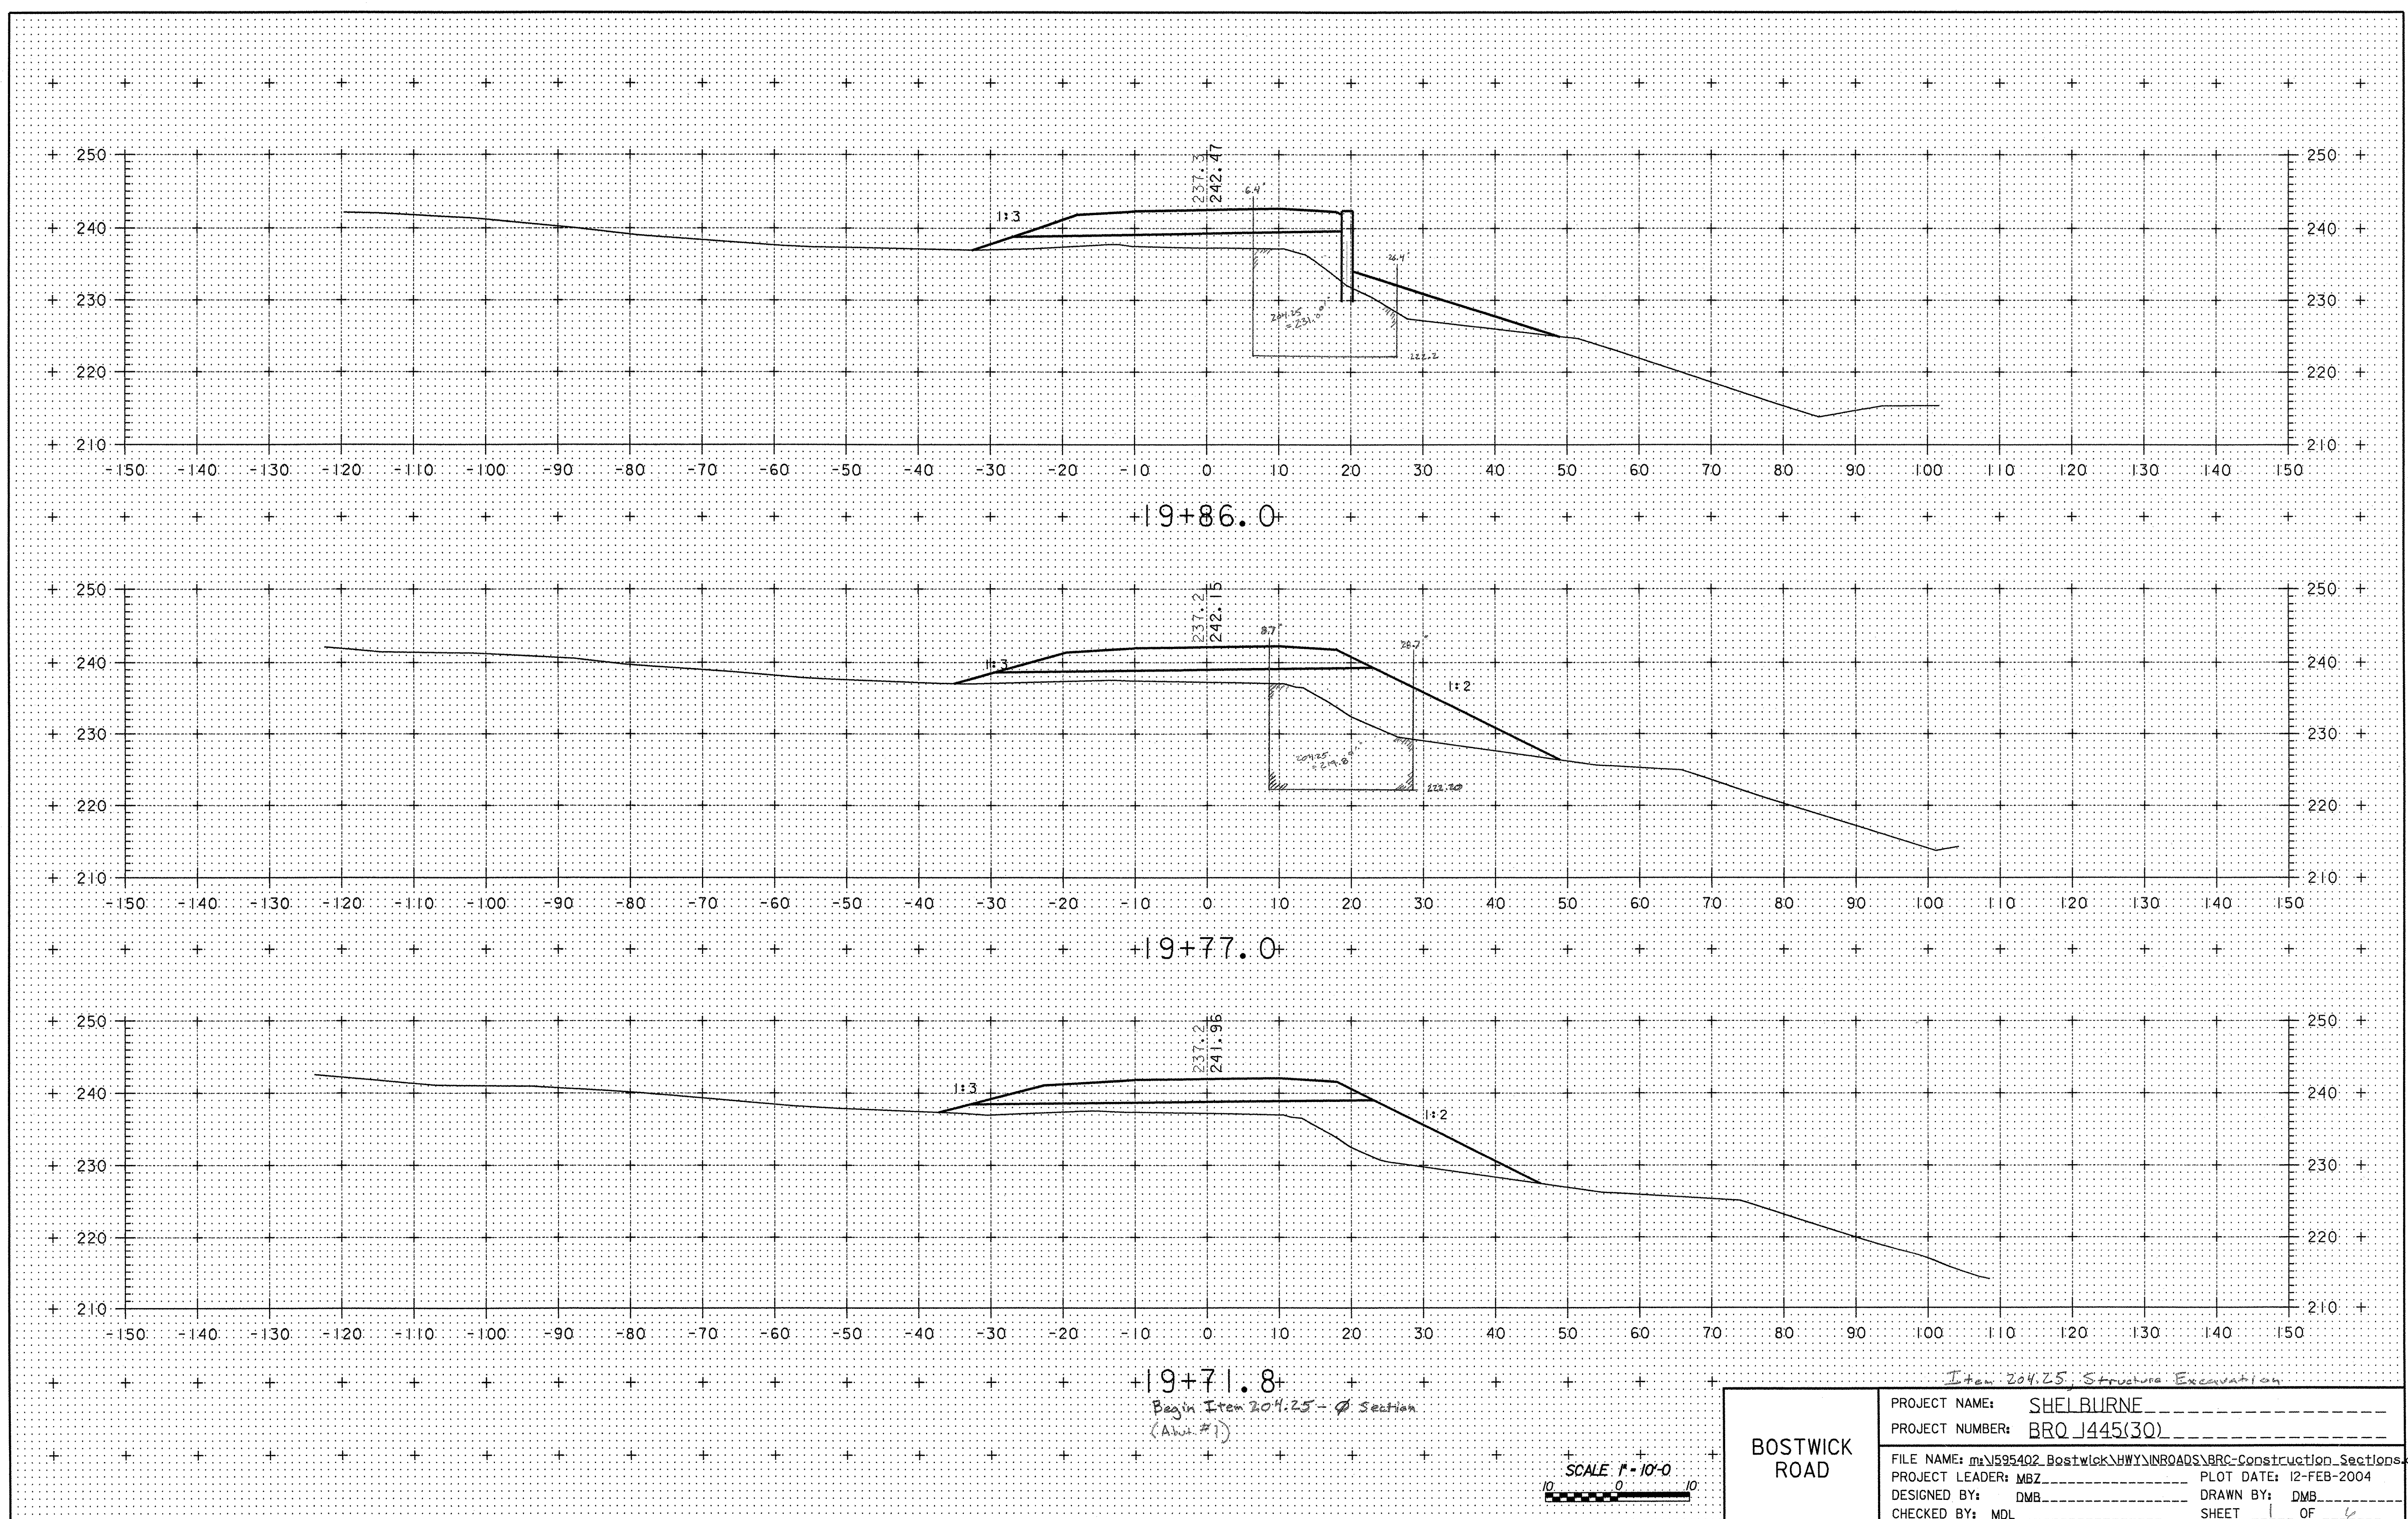


Item 204.25, Structure Excavation

BOSTWICK ROAD

PROJECT NAME:	SHEL BURNE
PROJECT NUMBER:	BRQ J445(30)
FILE NAME:	m:\595402_Bostwick\HWY\INROADS\BRC-Construction_Sections
PROJECT LEADER:	MBZ
DESIGNED BY:	DMB
CHECKED BY:	MDL
PLOT DATE:	12-FEB-2004
DRAWN BY:	DMB
SHEET	1 OF 6

SCALE 1" = 10'-0"


+19+71.8
 Begin Item 204.25 - Section
 (A.W. #1)

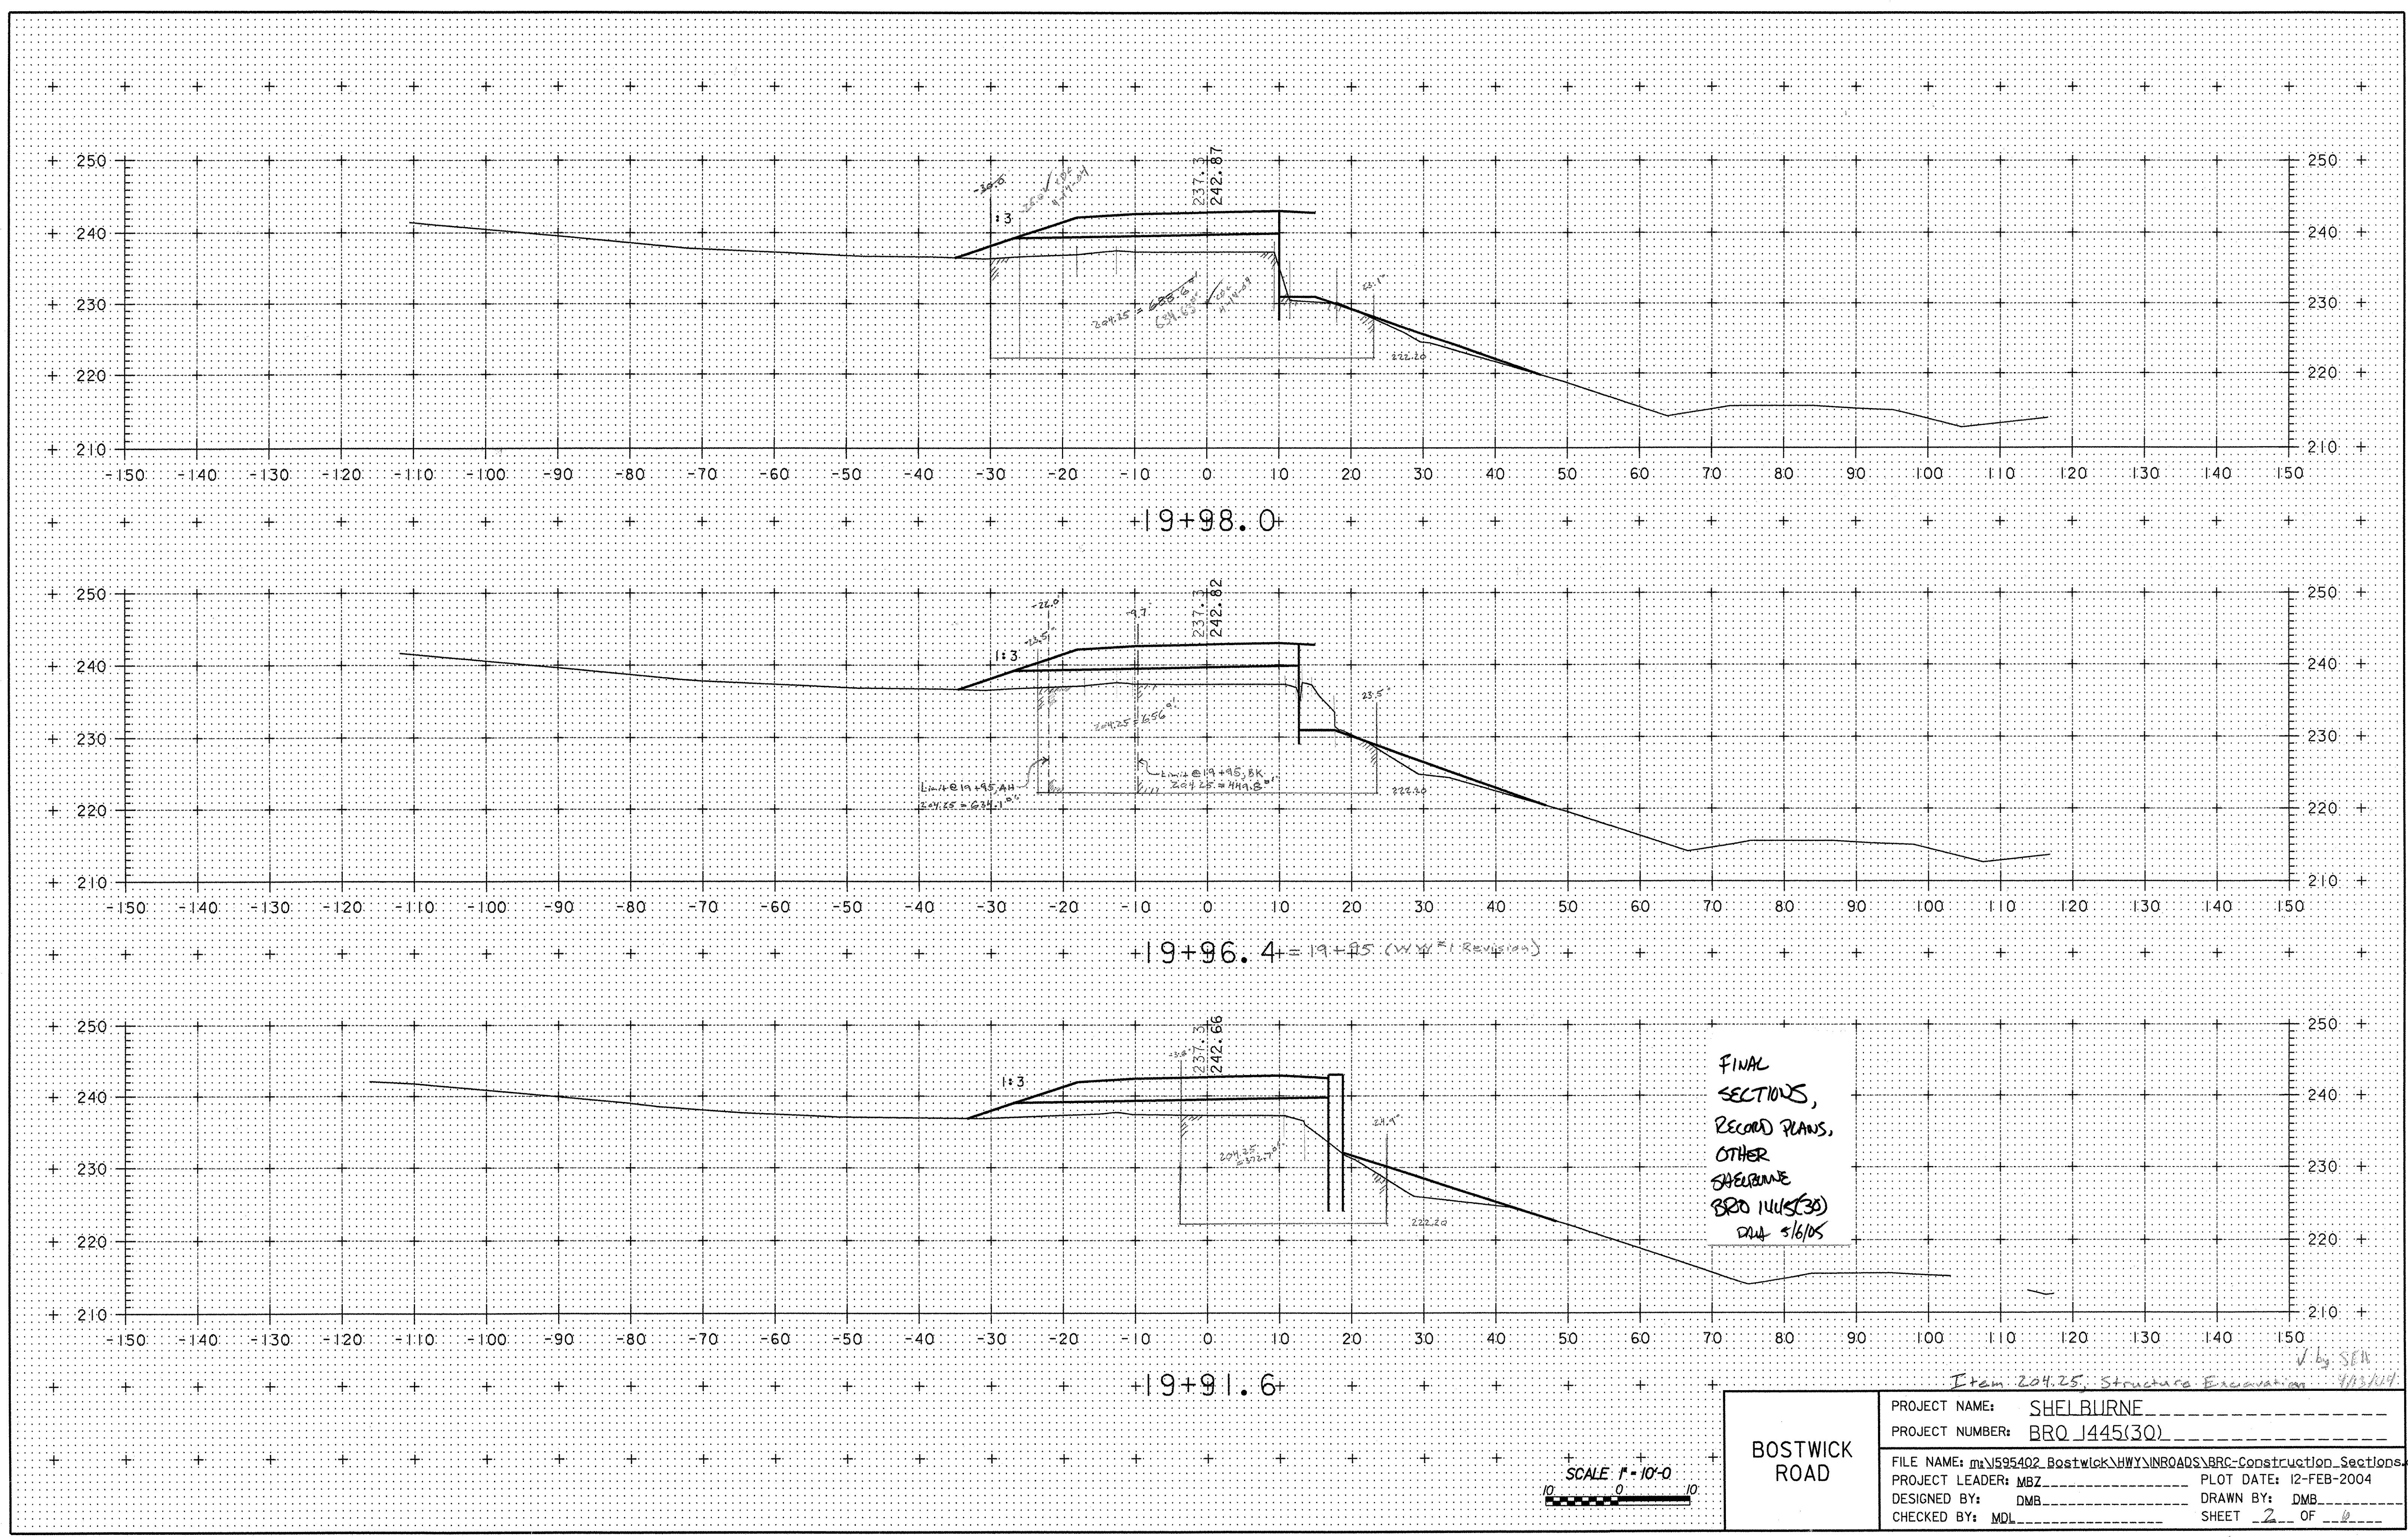


FINAL
SECTIONS,
RECORD PLANS,
OTHER
SHELBURNE
BRQ 1145(30)
DMM 5/6/05

Item 204.25, Structure Excavation 1/23/04

BOSTWICK ROAD	PROJECT NAME: SHELBURNE
	PROJECT NUMBER: BRQ 1145(30)
	FILE NAME: m:\595402_Bostwick\HWY\INROADS\BRC-Construction_Sections
	PROJECT LEADER: MBZ PLOT DATE: 12-FEB-2004
DESIGNED BY: DMB DRAWN BY: DMB	
CHECKED BY: MDL SHEET 2 OF 6	

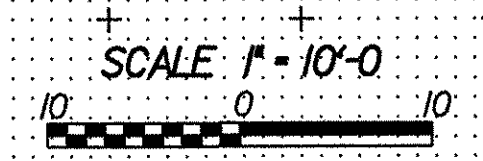

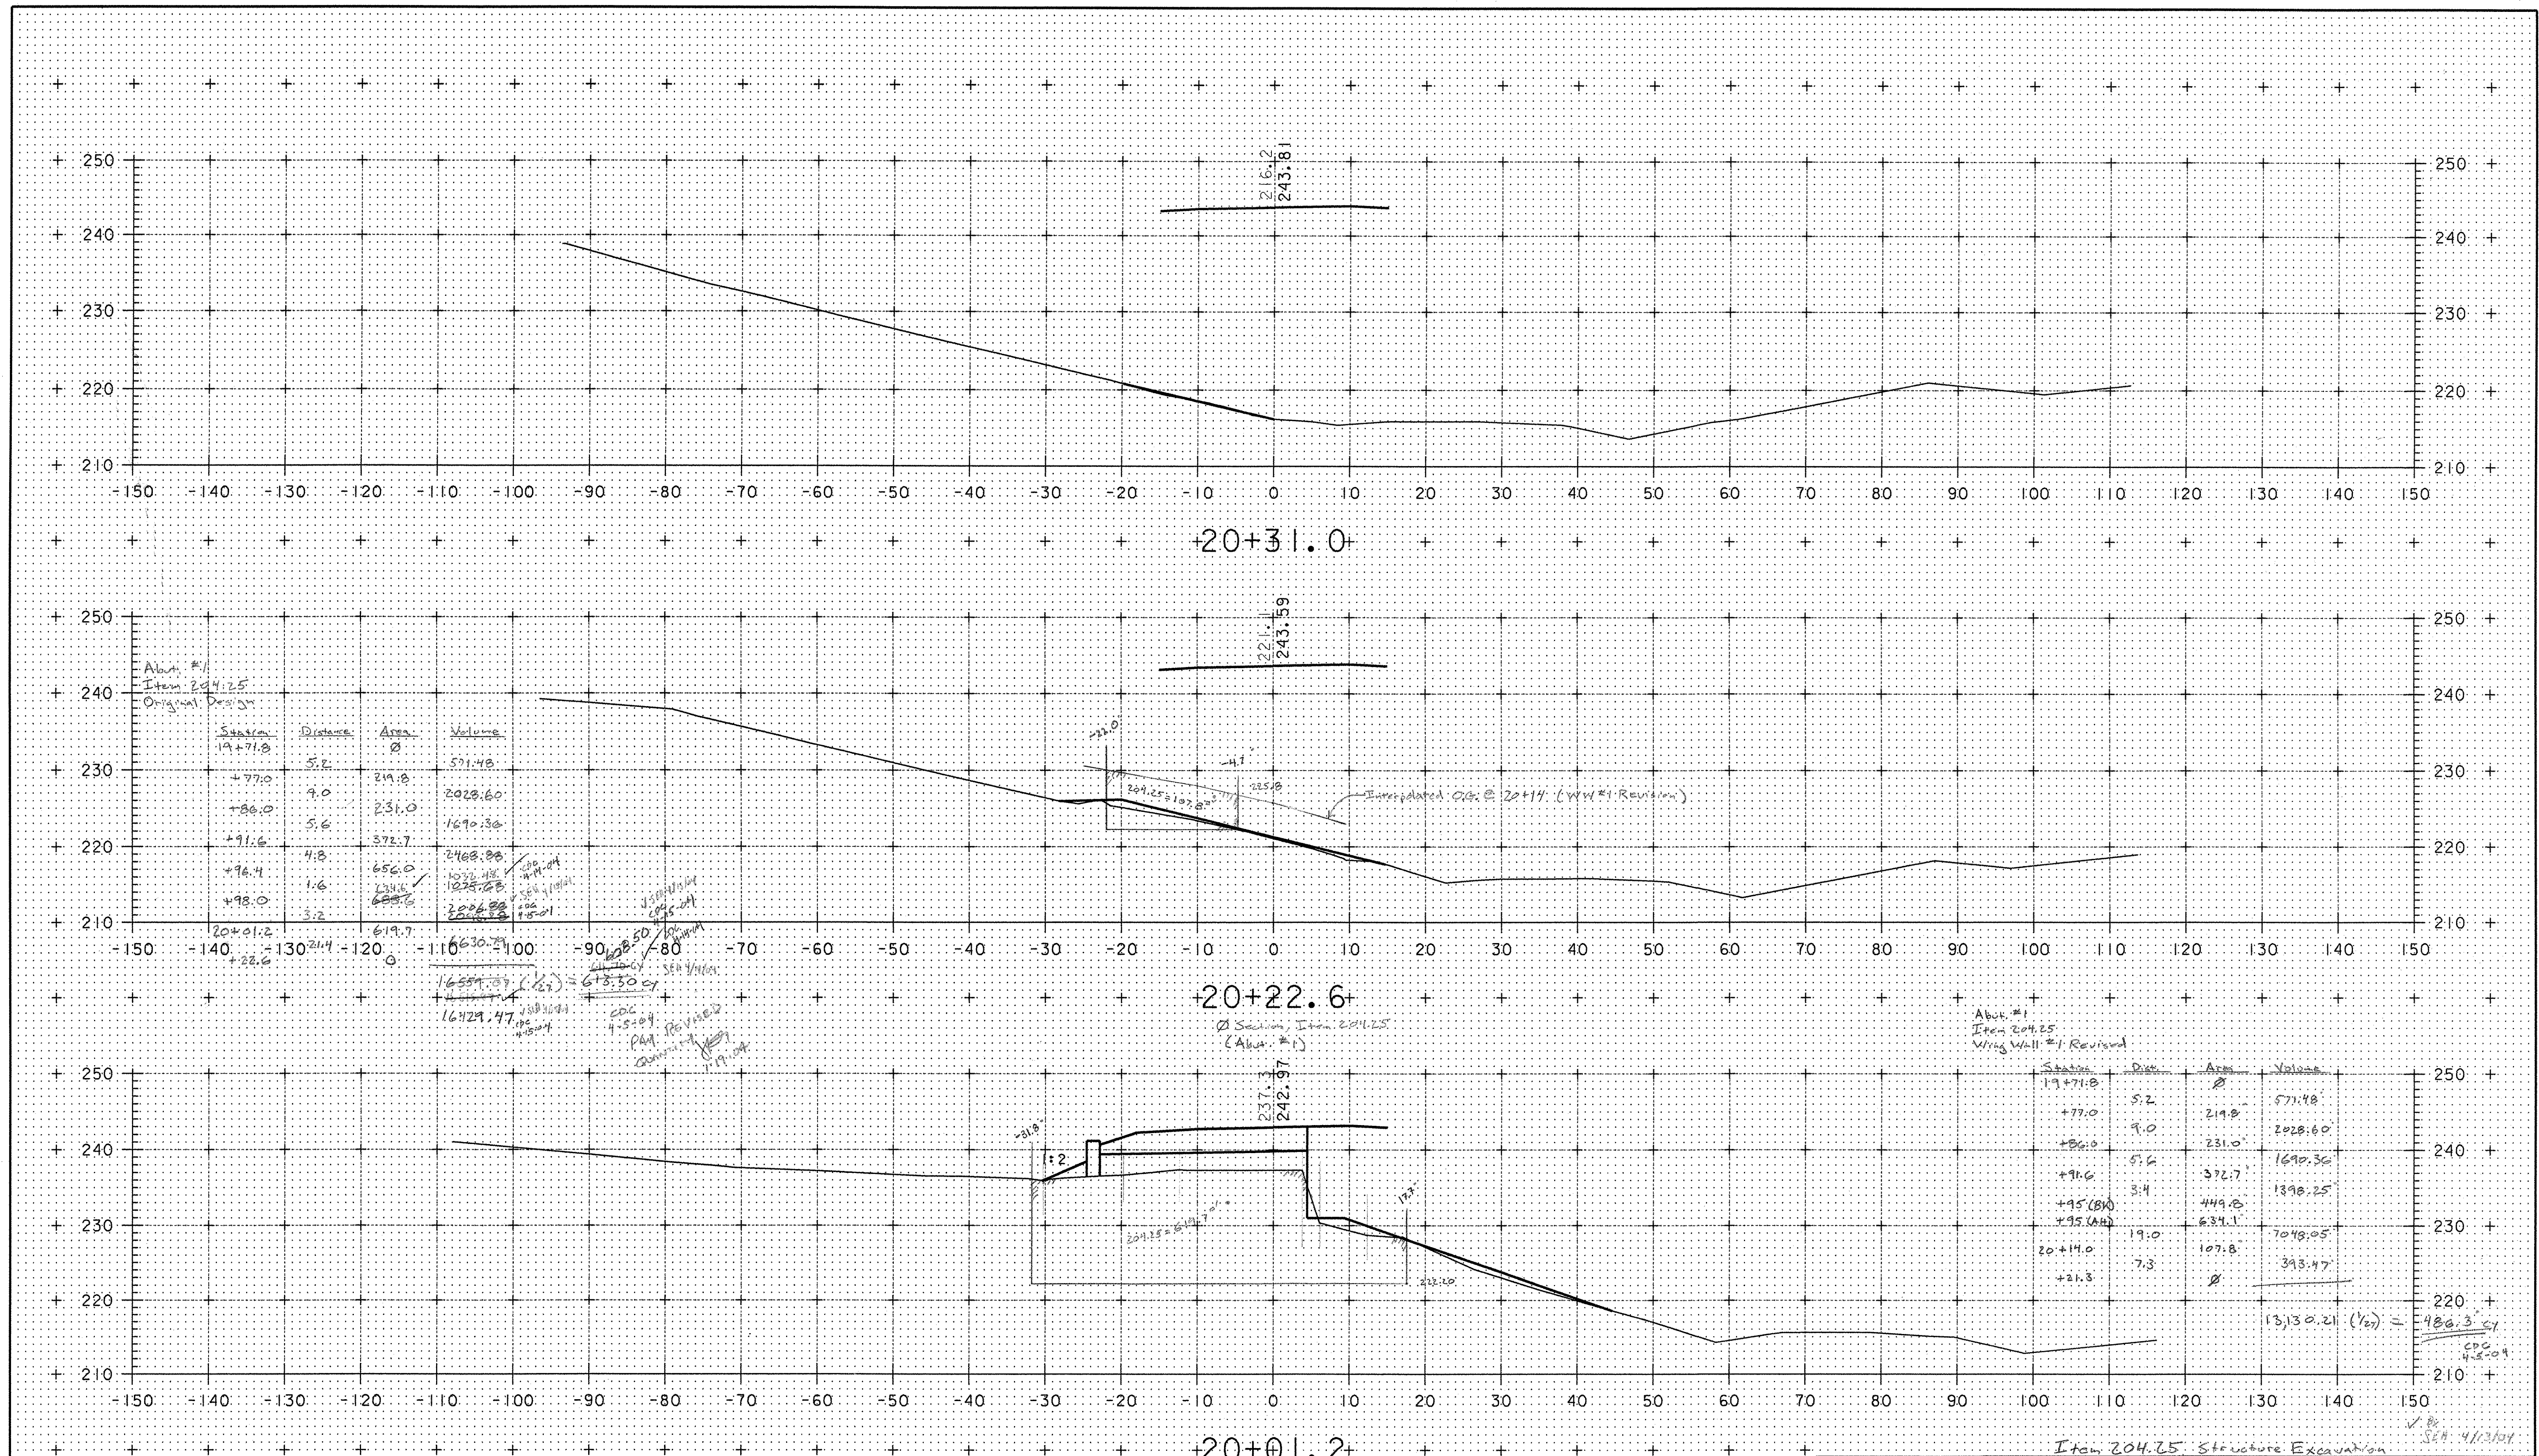


BOSTWICK ROAD

PROJECT NAME: SHELBURNE
 PROJECT NUMBER: BRQ J445(30)


FILE NAME: m:\595402_Bostwick\HWYINROADS\BRC-Construction_Sections
 PROJECT LEADER: MBZ PLOT DATE: 12-FEB-2004
 DESIGNED BY: DMB DRAWN BY: DMB
 CHECKED BY: MDL SHEET 3 OF 6

SCALE 1" = 10'-0"


102 66

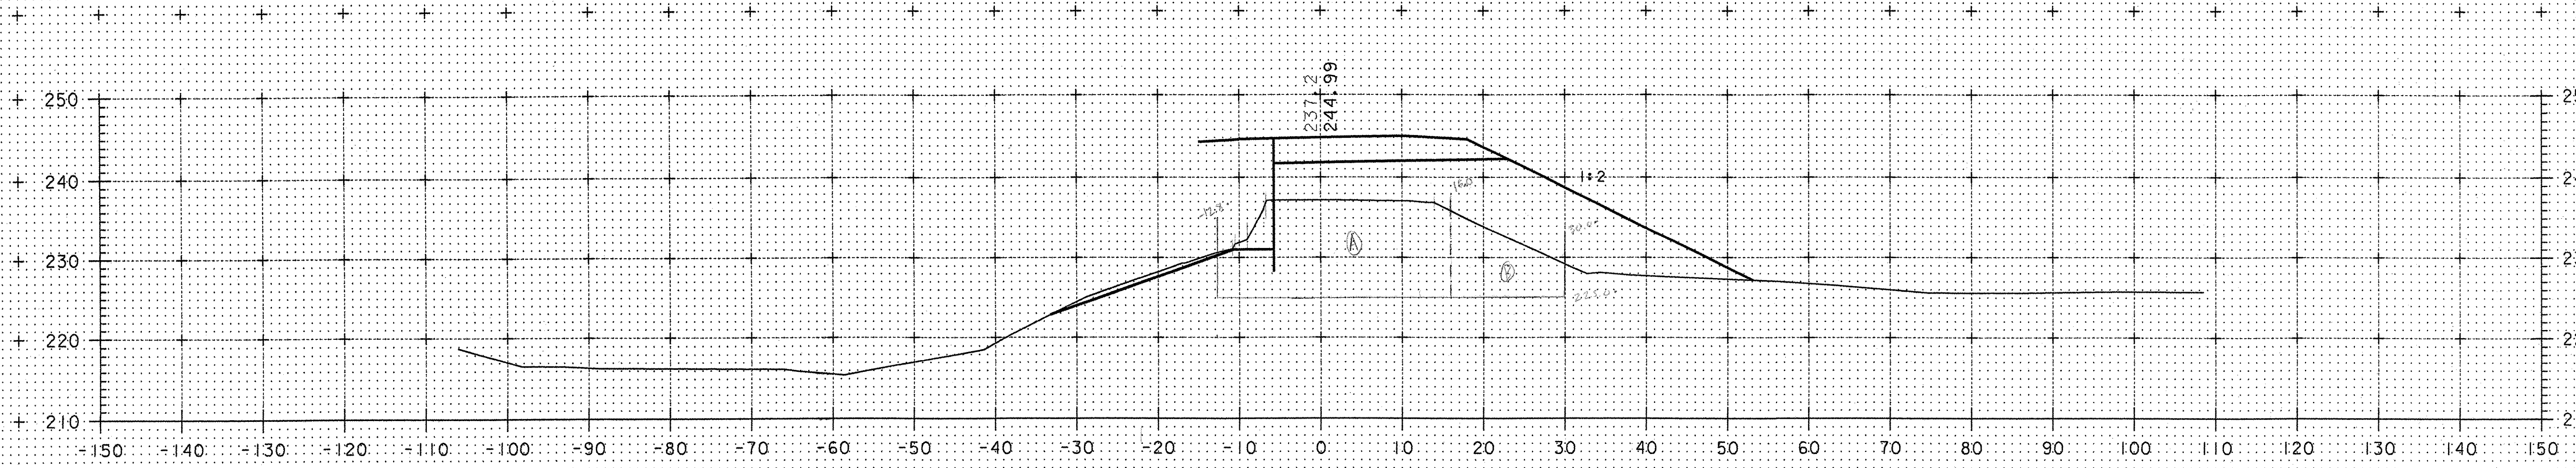

20+93.6

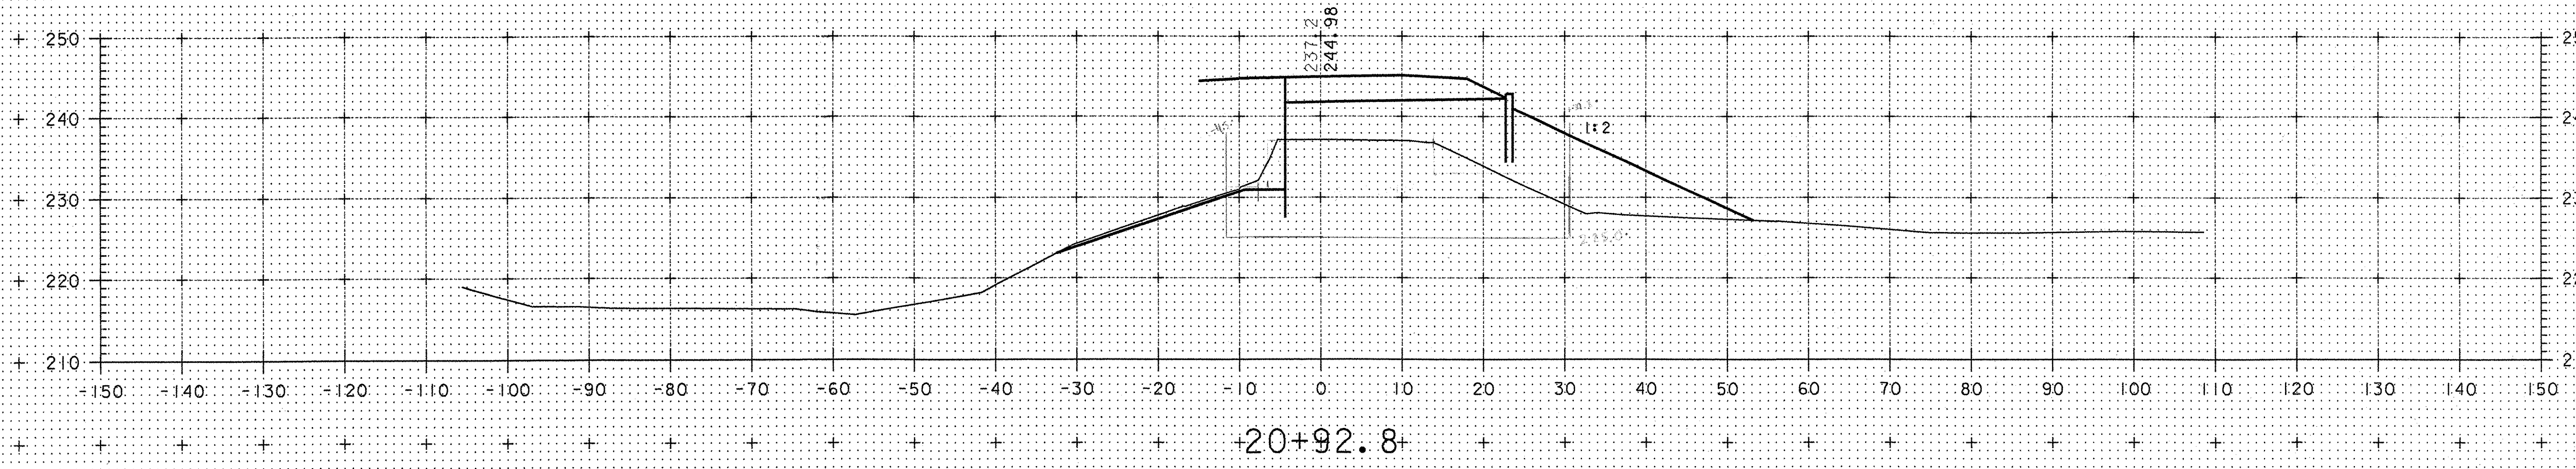


20+92.8

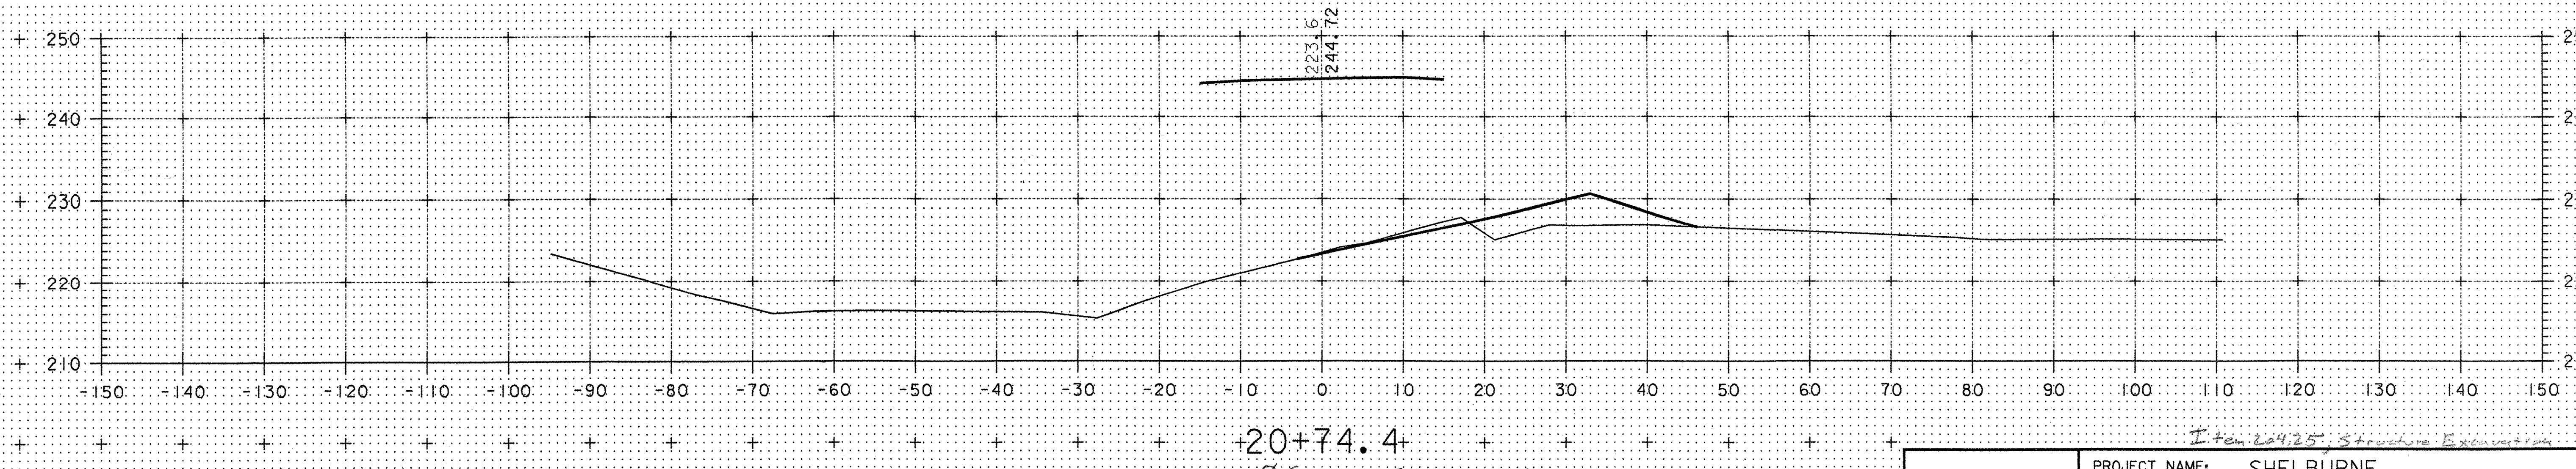

20+74.4


Ø Section - Item 204.25
(Abutment 2)

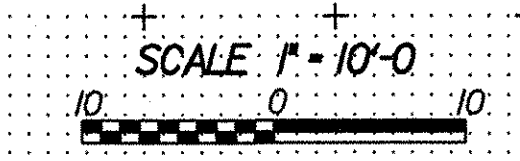


BOSTWICK ROAD

Item 204.25, Structure Excavation


PROJECT NAME:	SHEI BURNE
PROJECT NUMBER:	BRQ J445(30)
FILE NAME:	m:\595402_Bostwick\HWY\INROADS\BRC-Construction_Sections
PROJECT LEADER:	MBZ
DESIGNED BY:	DMB
CHECKED BY:	MDL
PLOT DATE:	12-FEB-2004
DRAWN BY:	DMB
SHEET	4 OF 6

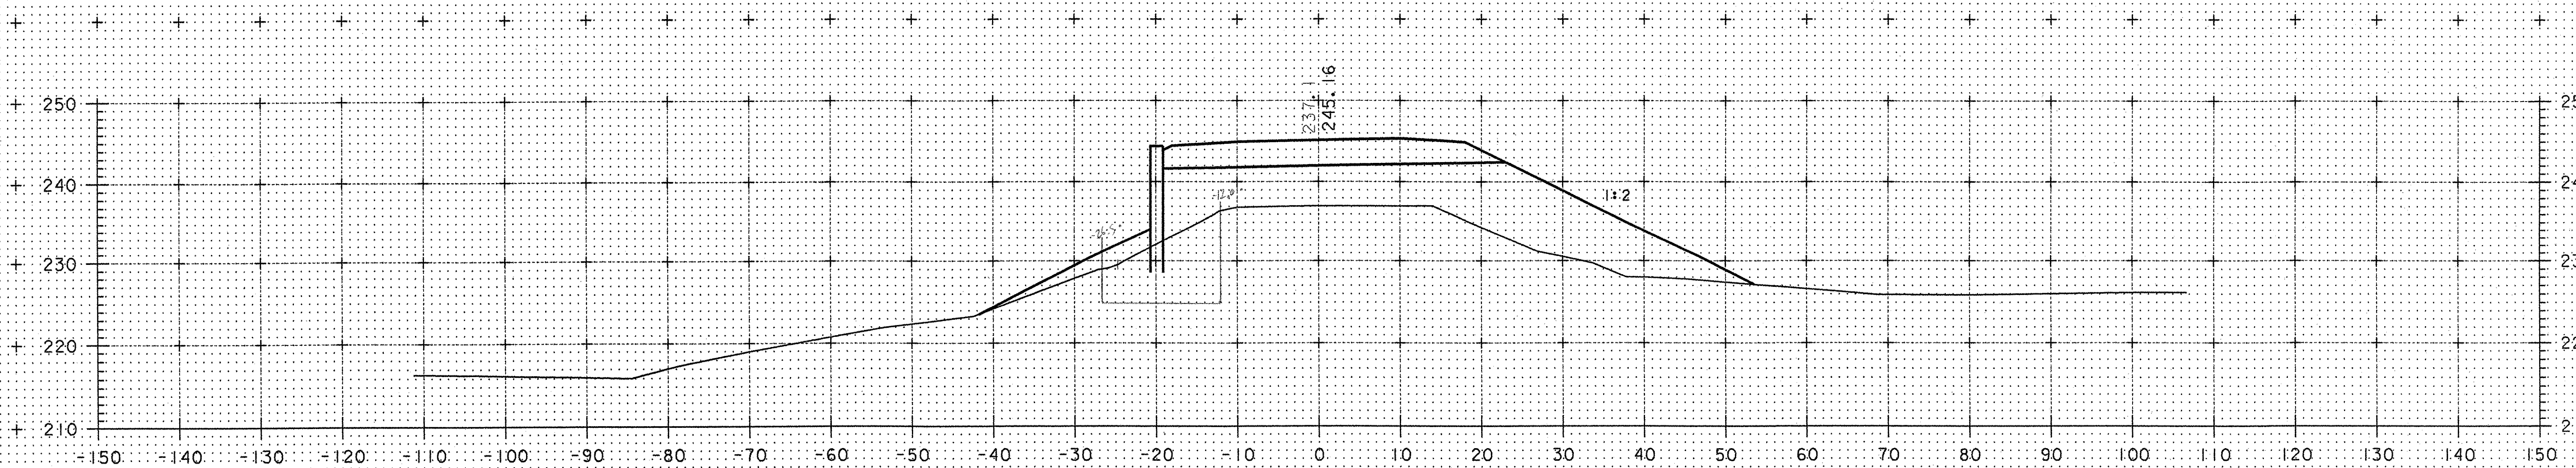


+21+09.4

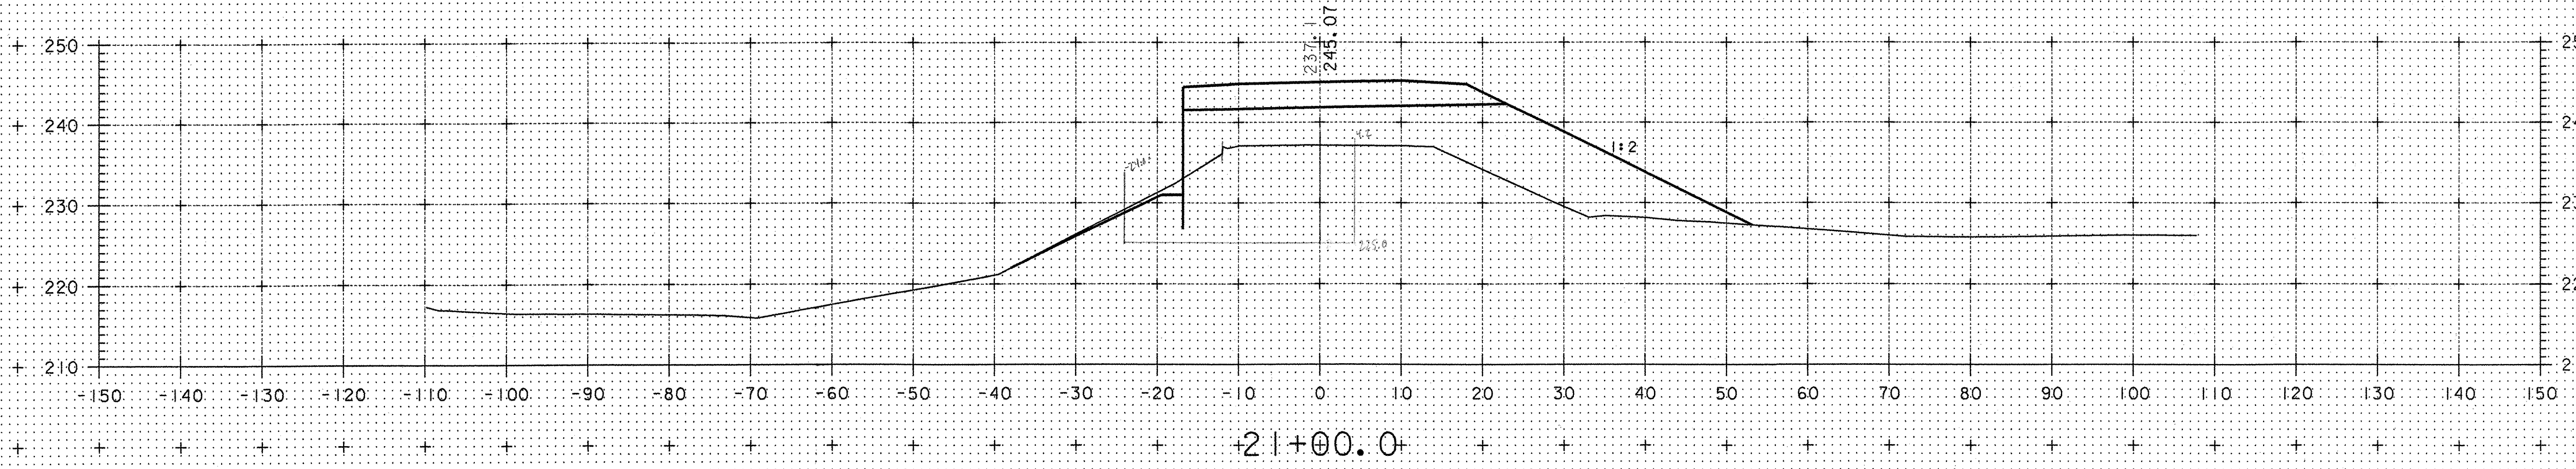

+21+00.0

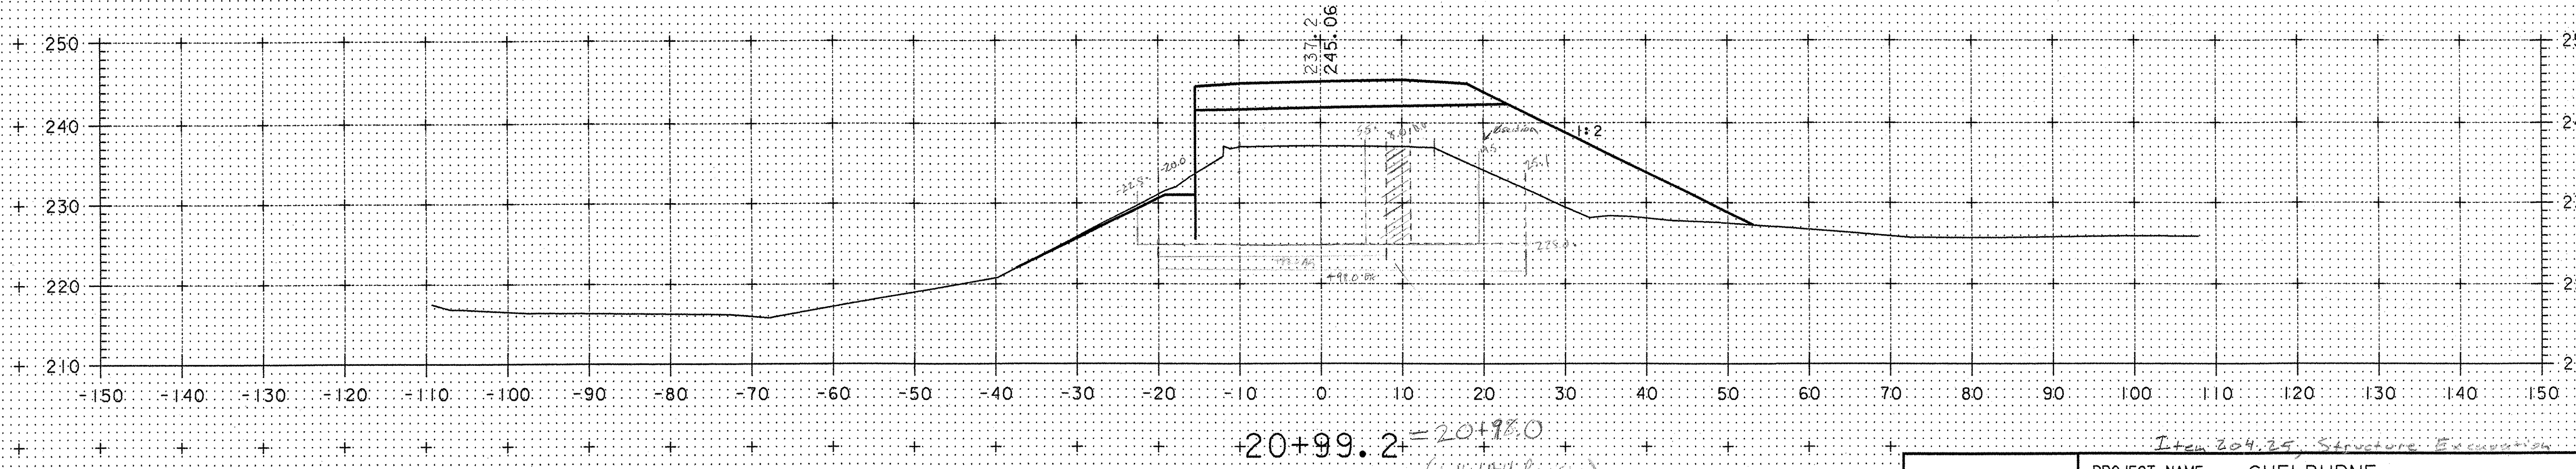


+20+99.2 = 20+98.0
(WWA-4 Revision)

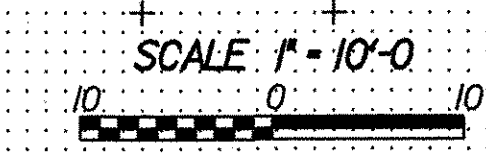


BOSTWICK ROAD

PROJECT NAME:	SHEL BURNE		
PROJECT NUMBER:	BR0 J445(30)		
FILE NAME:	m:\595402_Bostwick\HWY\INROADS\BRC-Construction_Sections		
PROJECT LEADER:	MBZ	PLOT DATE:	12-FEB-2004
DESIGNED BY:	DMB	DRAWN BY:	DMB
CHECKED BY:	MDL	SHEET	5 OF 6


Item 204.24, Structure Excavation

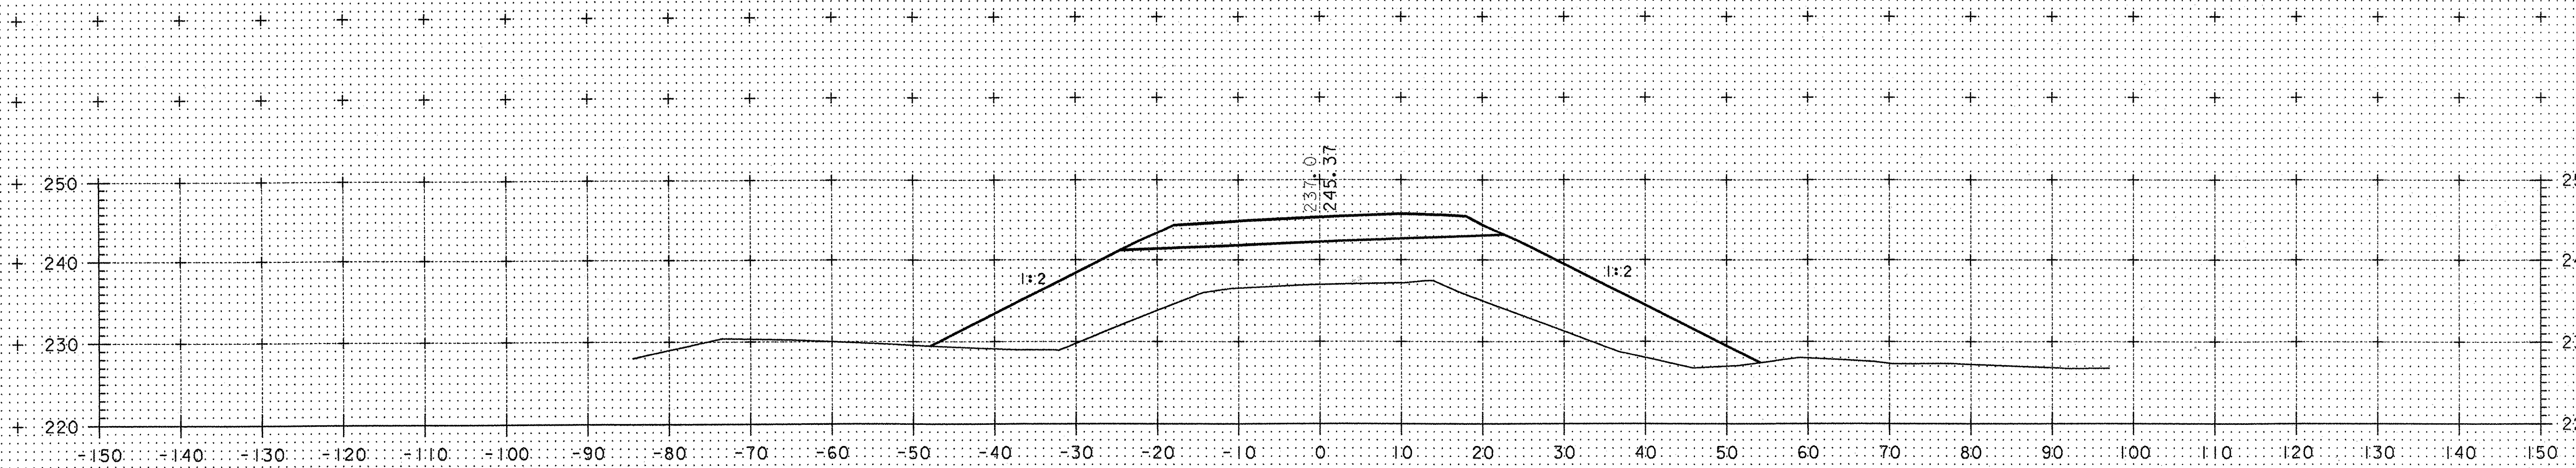

+21+50.0

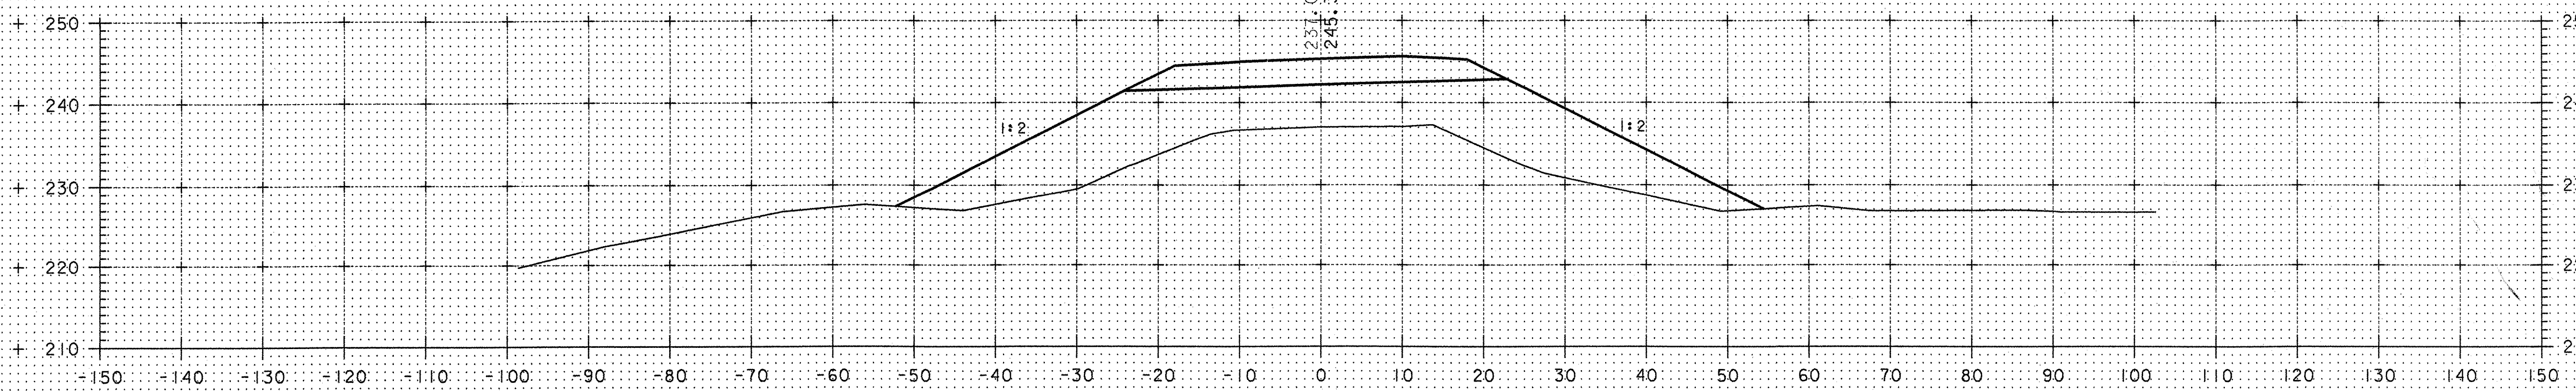


+21+31.0

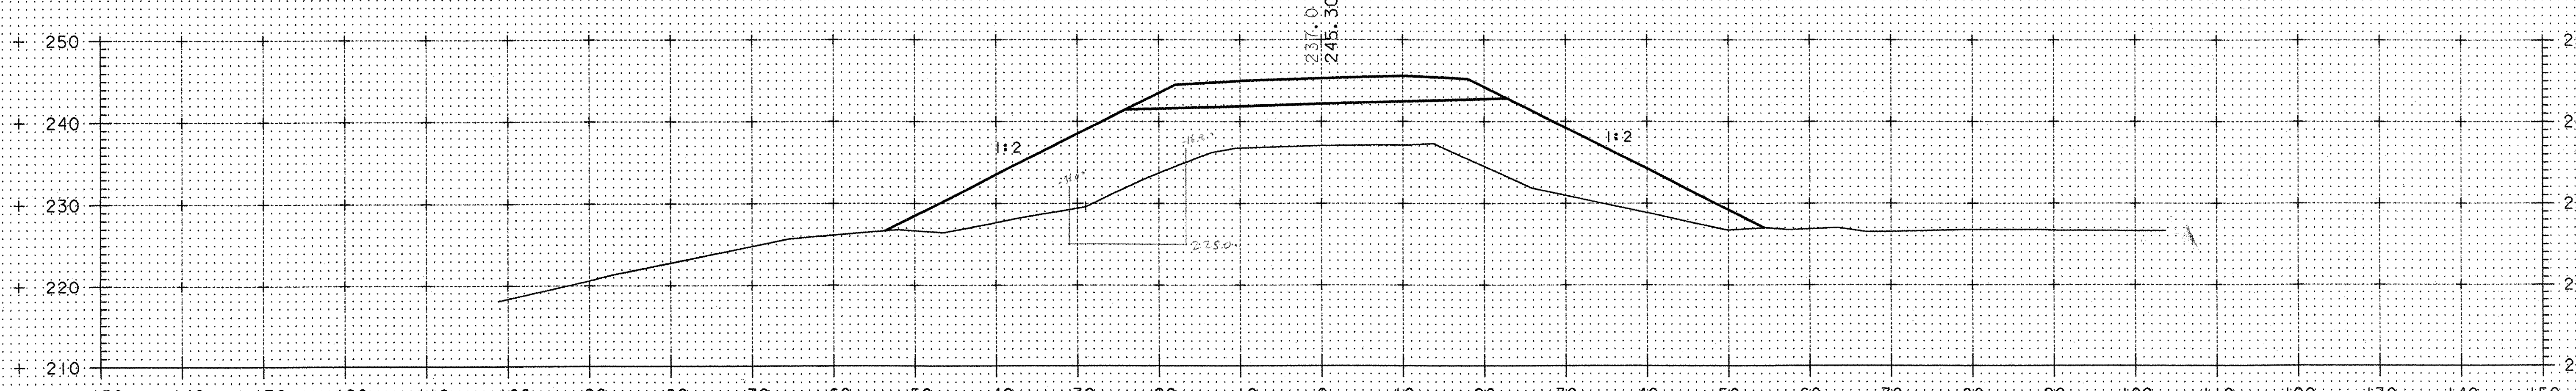


+21+27.4

Iron 204.25, Structure Excavation

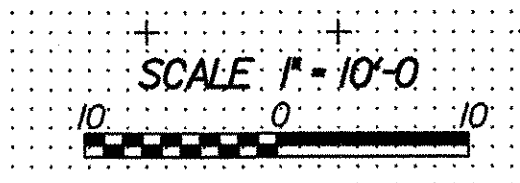


BOSTWICK ROAD	PROJECT NAME: SHELBURNE
	PROJECT NUMBER: BRQ J445(30)
	FILE NAME: m:\595402_Bostwick\HWY\INROADS\BRC-Construction_Sections.k
	PROJECT LEADER: MBZ PLOT DATE: 12-FEB-2004
DESIGNED BY: DMB DRAWN BY: DMB	
CHECKED BY: MDL SHEET 6 OF 6	

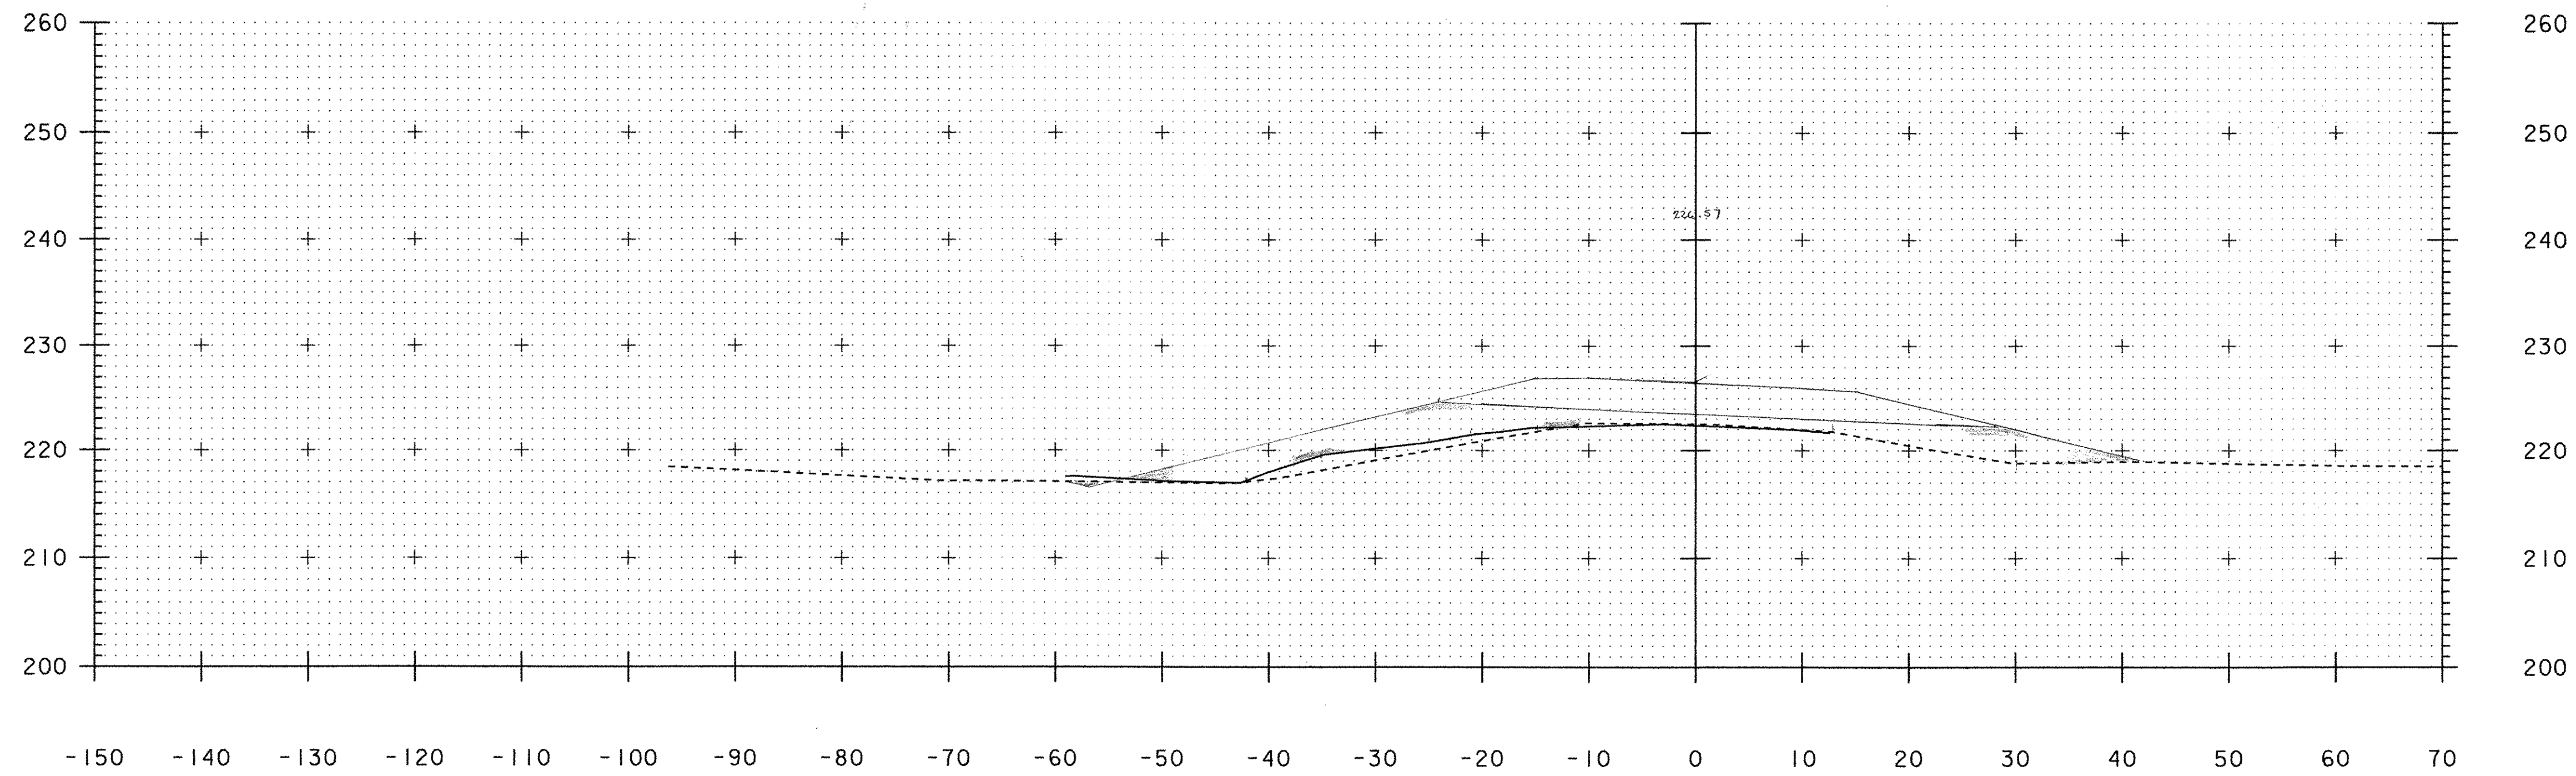

17+00


$F = 123 \times 1.55 = 190.65 \text{ SF}$ $187.8 \text{ or } 190.65 \text{ SF}$ $\text{result deduct} - (43' \times 2/12) = 183.4 \text{ SF}$
 $C = 1 \times 1.55 = 1.6 \text{ SF}$ $2-1.05$ $WB 02/18/05$

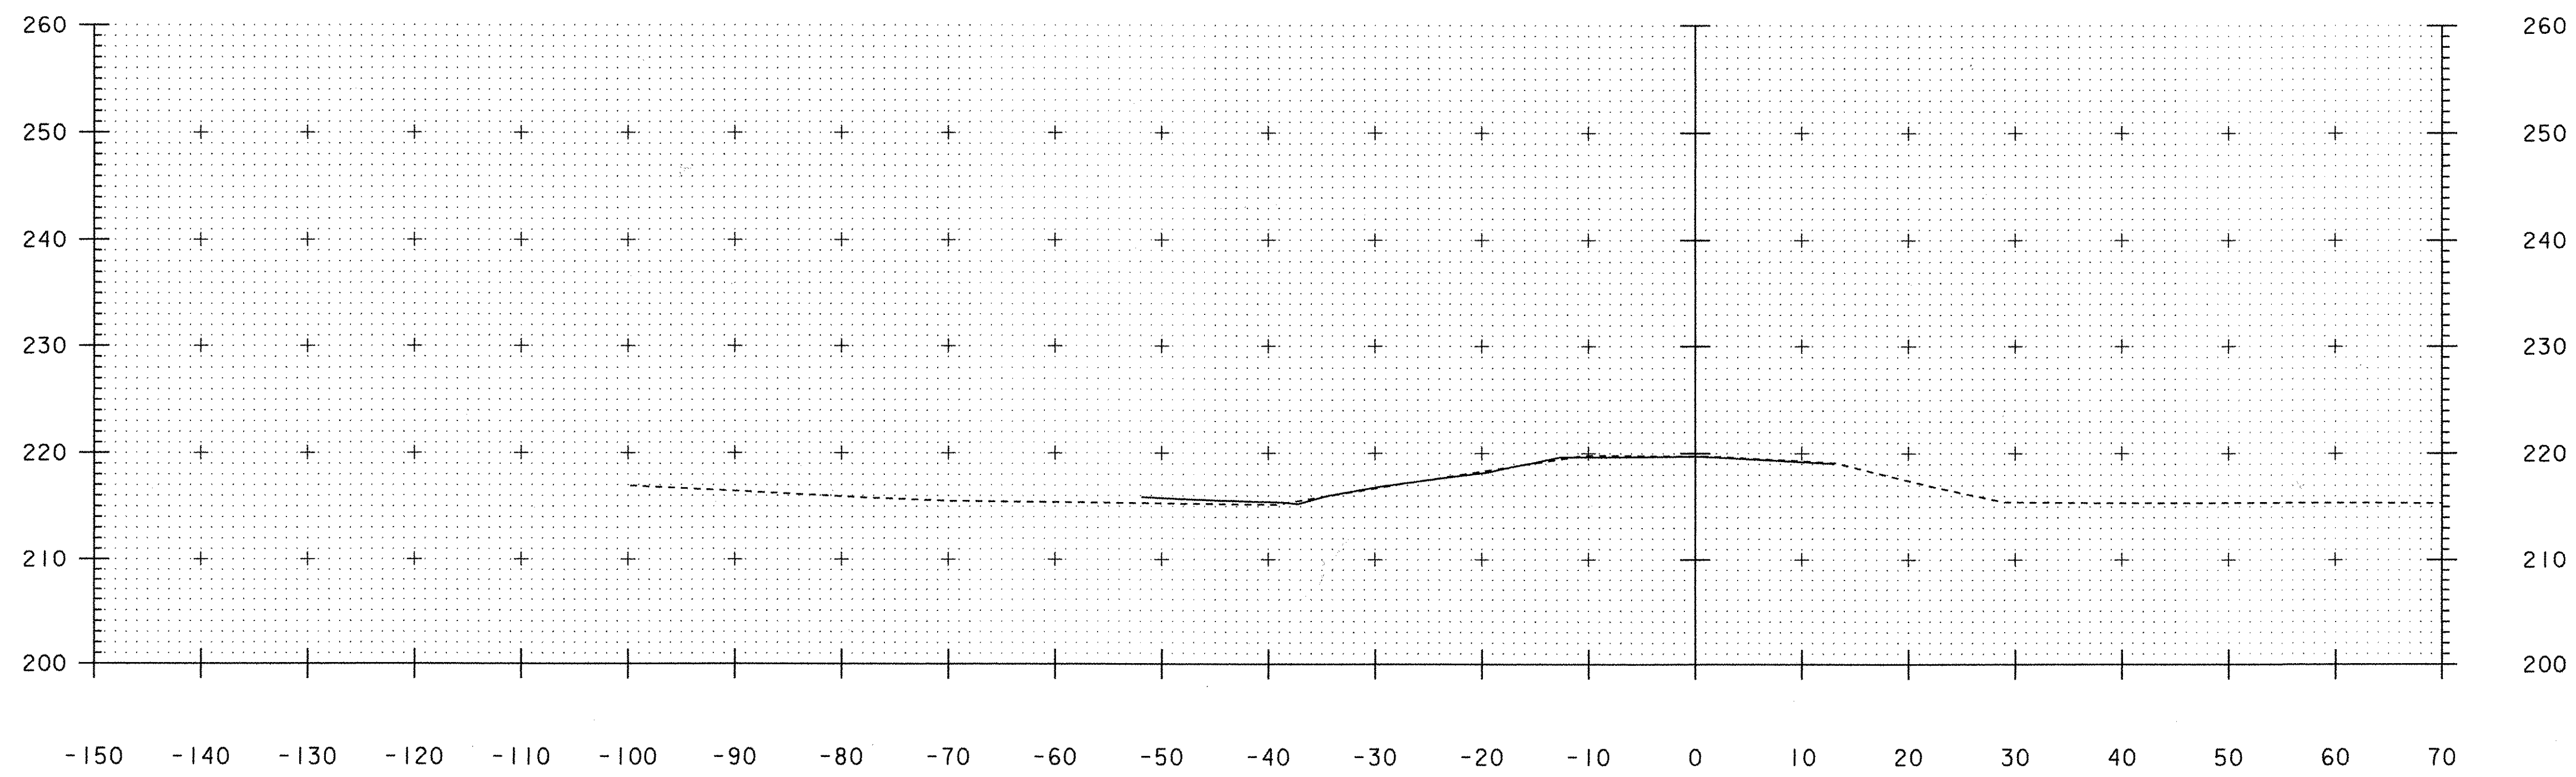


16+50

REVISED ORIGINAL SECTIONS

PROJECT NAME:	SHELBURNE	FILE NAME:	94J196/SURVEY/X94J196DQ	PLOT DATE:	07-JUL-2004
PROJECT NUMBER:	BRO 1445(30)	PROJECT LEADER:		DRAWN BY:	BEYOR
DESIGNED BY:		DESIGNED BY:		CHECKED BY:	
DETOUR SECTIONS -	MAY 28, 2004	DETOUR SECTIONS -	MAY 28, 2004	SHEET	1 OF 9

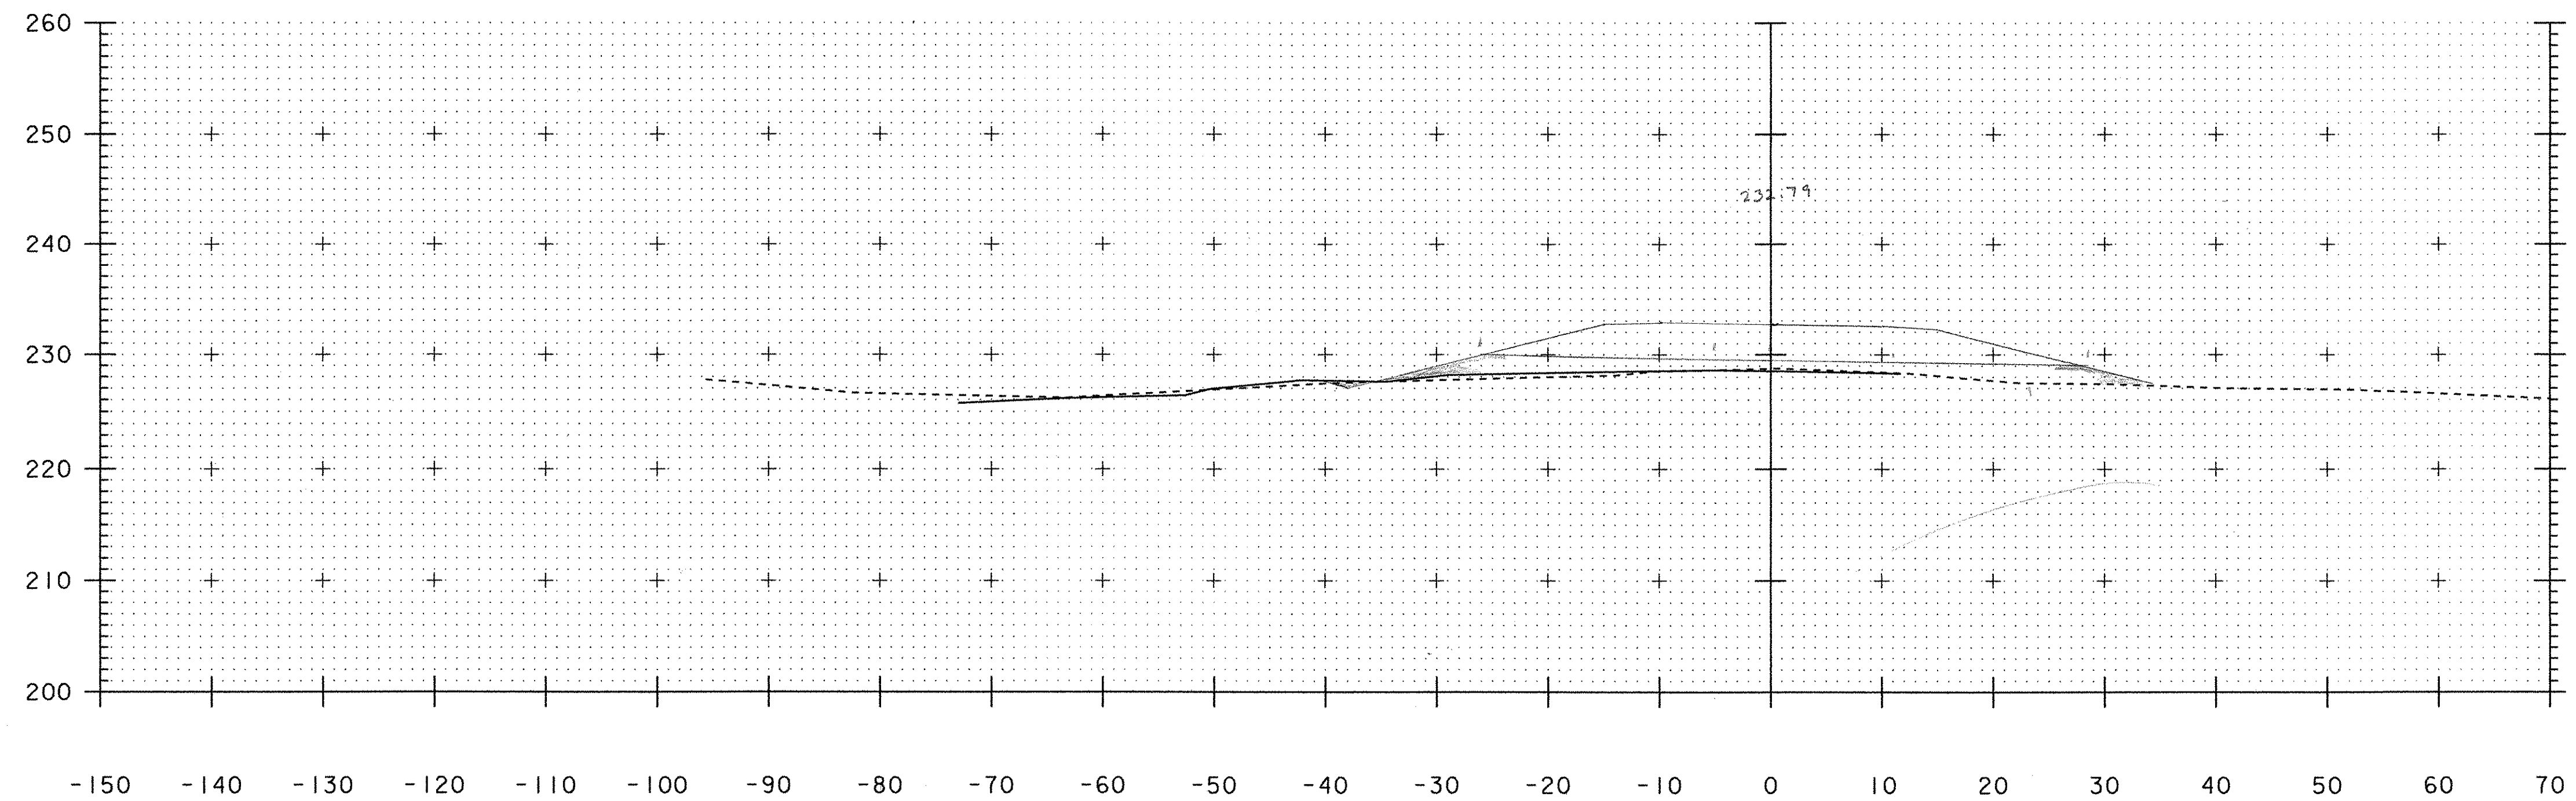

18+00

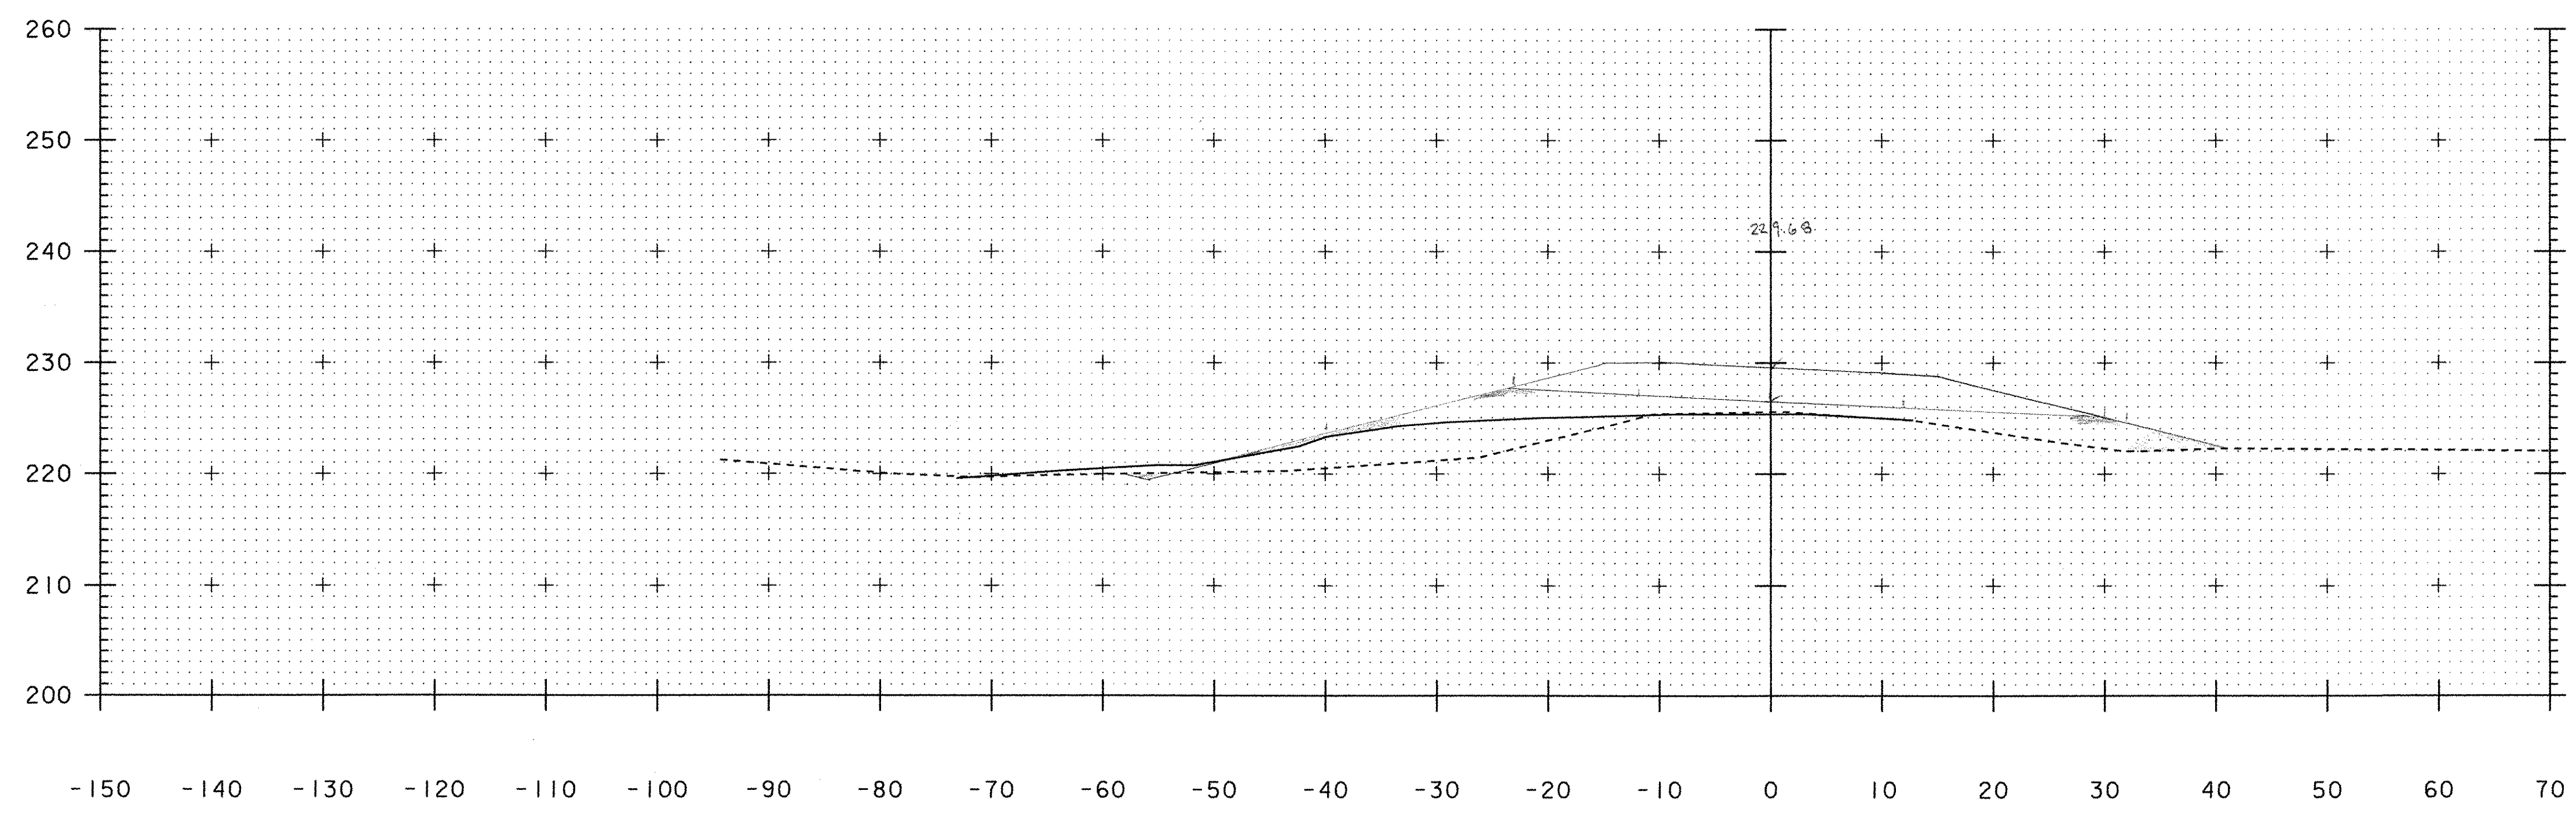


17+50


REVISED ORIGINAL SECTIONS

PROJECT NAME: SHELBURNE	PLOT DATE: 07-JUL-2004
PROJECT NUMBER: BRO 1445(30)	DRAWN BY: BEYOR
FILE NAME: 94J196/SURVEY/X94J196DQ	CHECKED BY:
PROJECT LEADER:	SHEET 2 OF 9
DESIGNED BY:	
DETOUR SECTIONS - MAY 28, 2004	

107 8/5

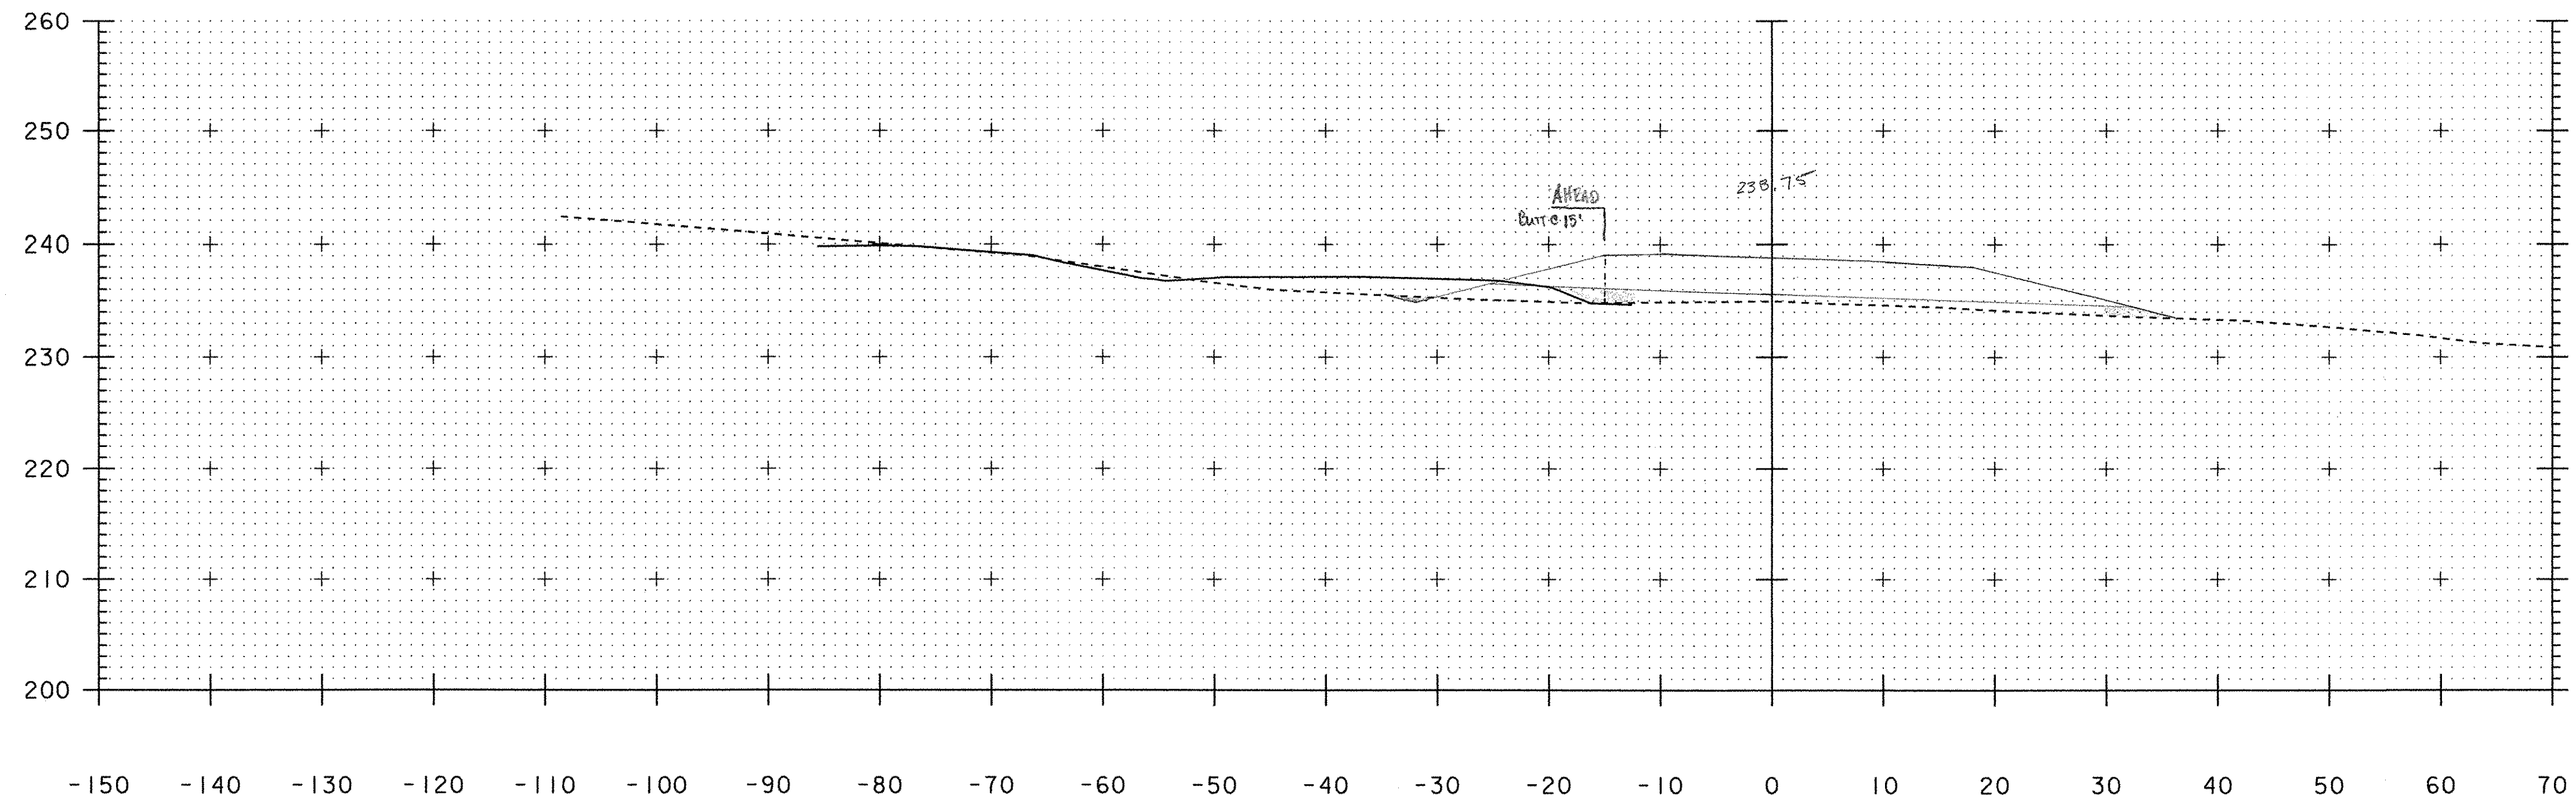

19+00

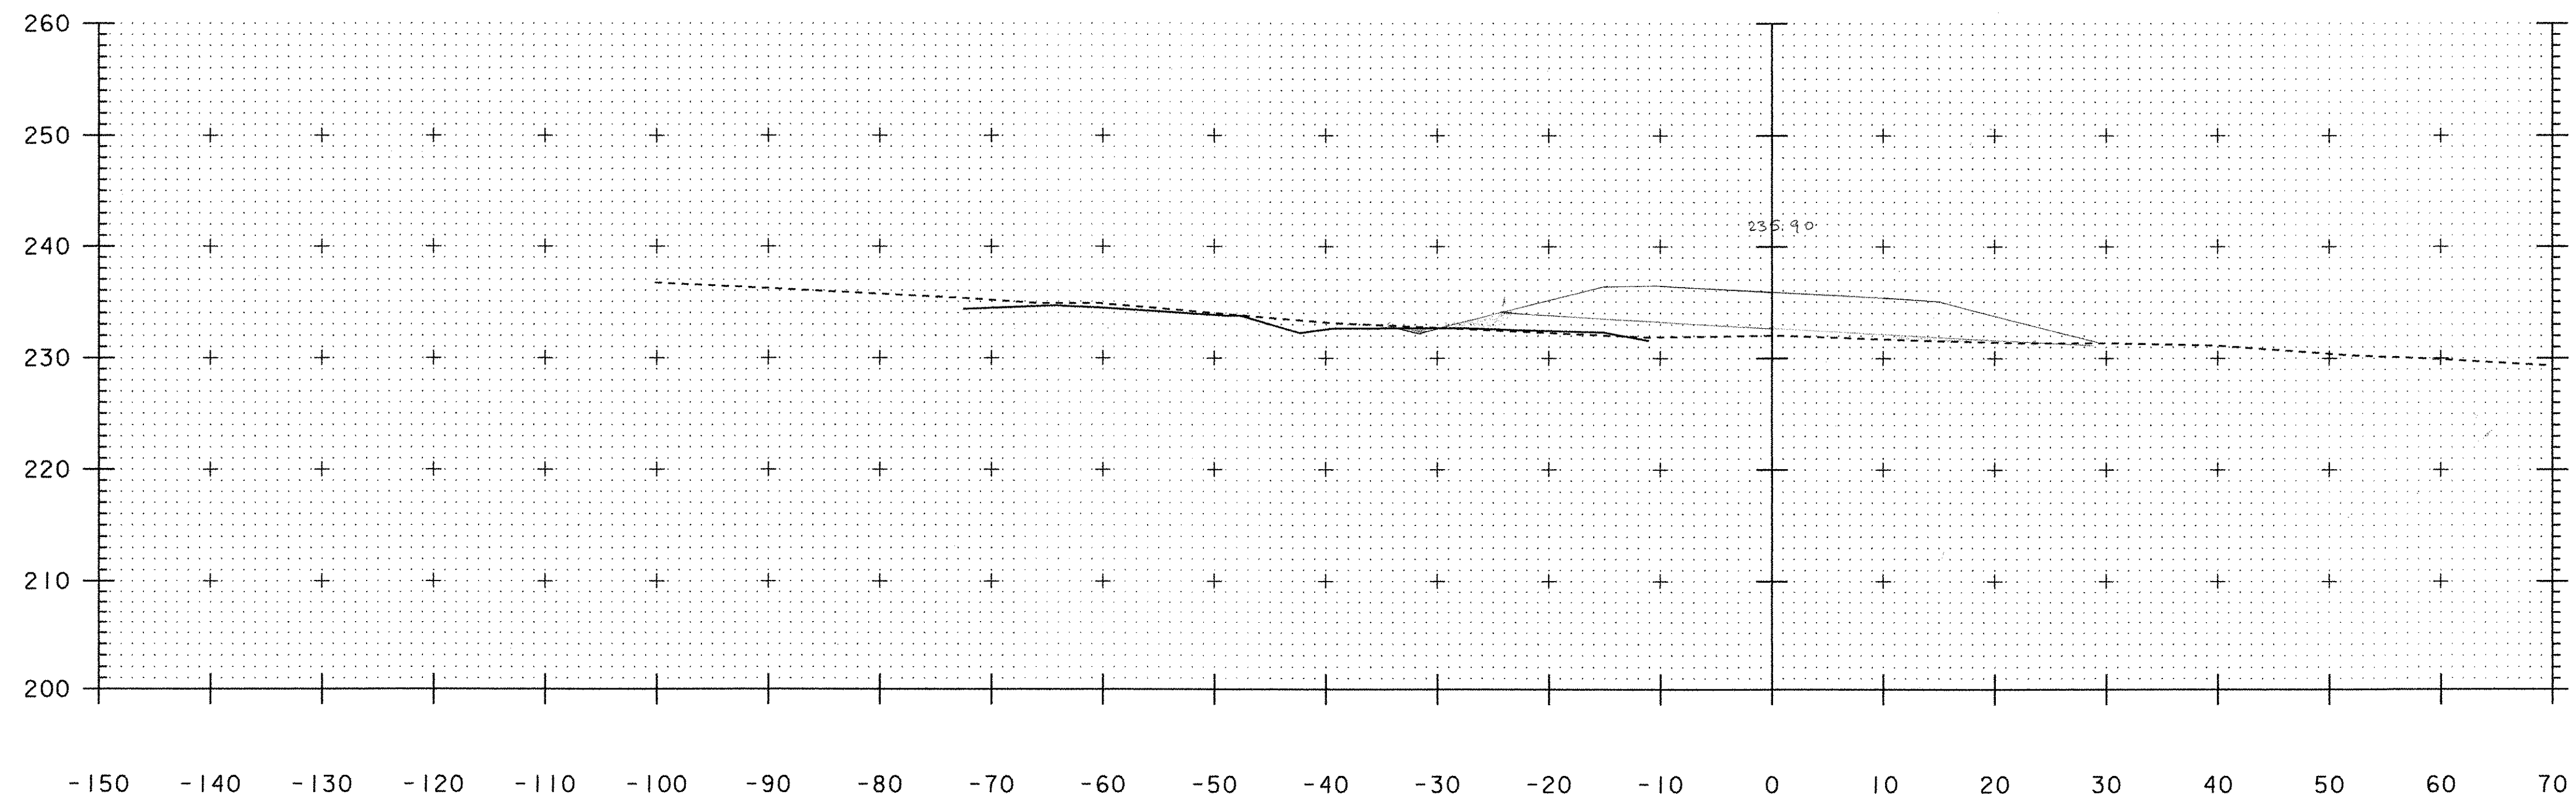

18+50

28
Back 56.7
F - 28 x 1.55 = 43.4 SF
- (4 x 2/12) = 42.7 SF
C - 1 x 1.55 = 1.6 VSF

24
AHEAD 58.7
F - 24 x 1.55 = 37.2 SF - (4 x 2/12) = 36.5 SF
C - 0 V

OK
3.15.05
OK
3.50
2-11-05


26 x 1.55 40.3
40.5 OK
F - 24 x 1.55 = 37.2 SF - (6 x 2/12) = 36.2 SF
C - 1 x 1.55 = 1.6 VSF

POOL DECKER 39.5
OK
3.11.05
2-1-05

REVISED ORIGINAL SECTIONS

PROJECT NAME:	SHELBURNE
PROJECT NUMBER:	BRO 1445(30)
FILE NAME:	94JI96/SURVEY/X94JI96DQ
PROJECT LEADER:	DESIGNED BY:
DESIGNED BY:	DETOUR SECTIONS - MAY 28, 2004
PLOT DATE:	07-JUL-2004
DRAWN BY:	BEYOR
CHECKED BY:	
SHEET	3 OF 9


108

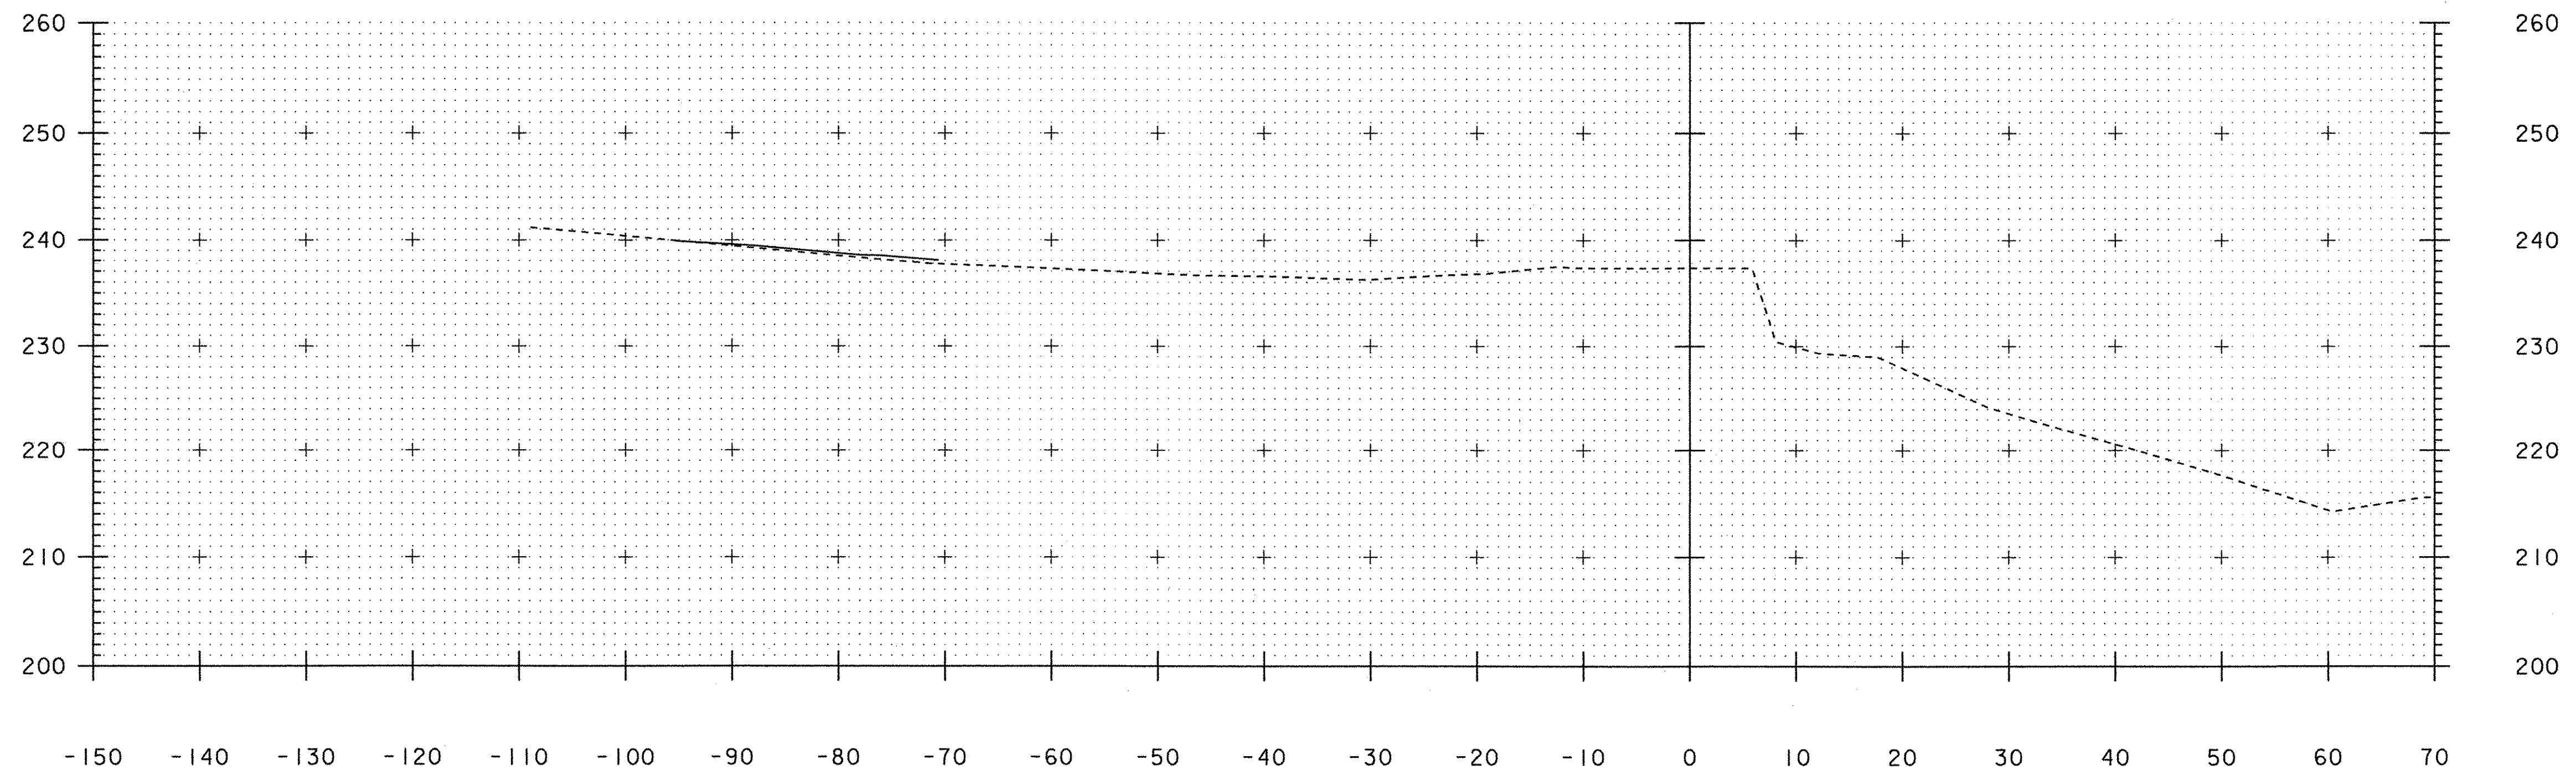

2102
G.P.S.
19 + 91.5
G.P.S.

211.1317
SLAB
19 + 20.6
SLAB

20+00




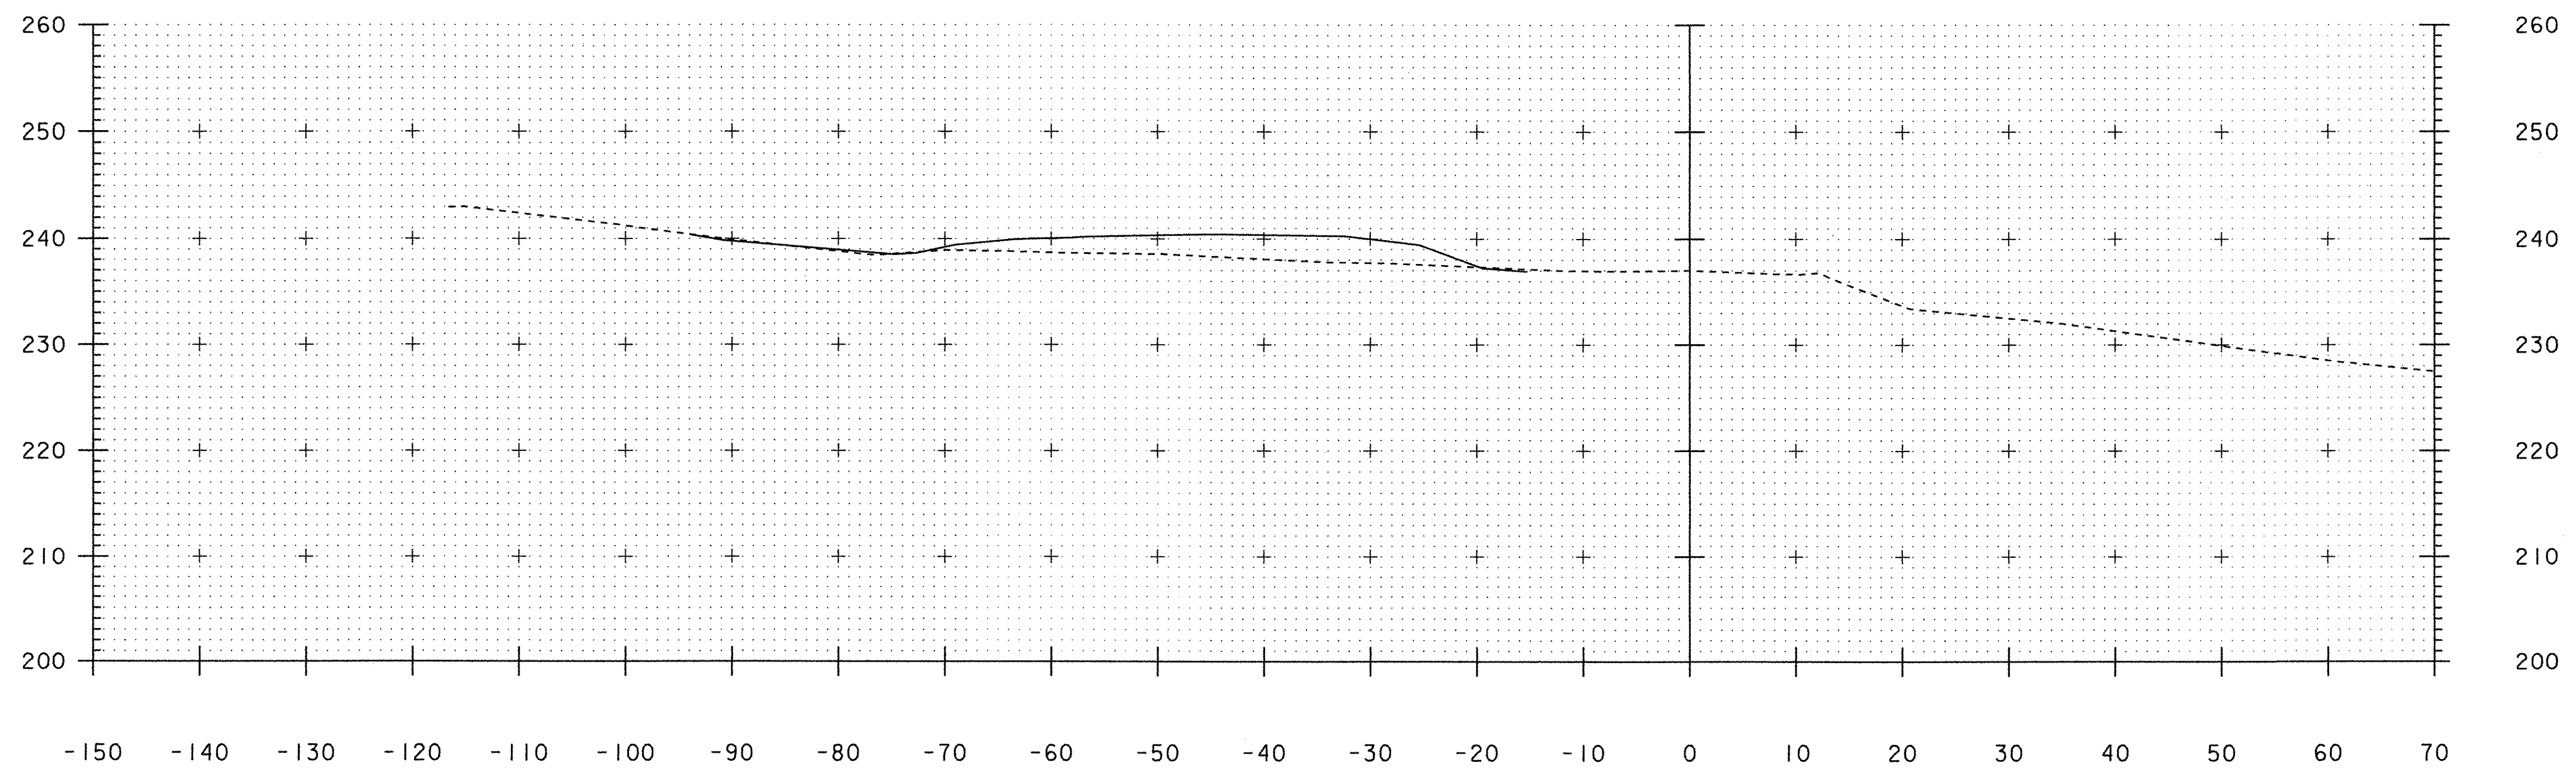


Revised Original Sections


PROJECT NAME: SHELBURNE	PLOT DATE: 07-JUL-2004
PROJECT NUMBER: BRO 1445(30)	DRAWN BY: BEYOR
FILE NAME: 94J196/SURVEY/X94J196DQ	CHECKED BY:
DESIGNED BY:	SHEET 4 OF 9
DETOUR SECTIONS - MAY 28, 2004	

19+50


109 1/2

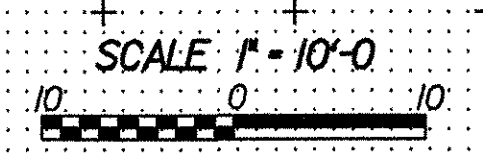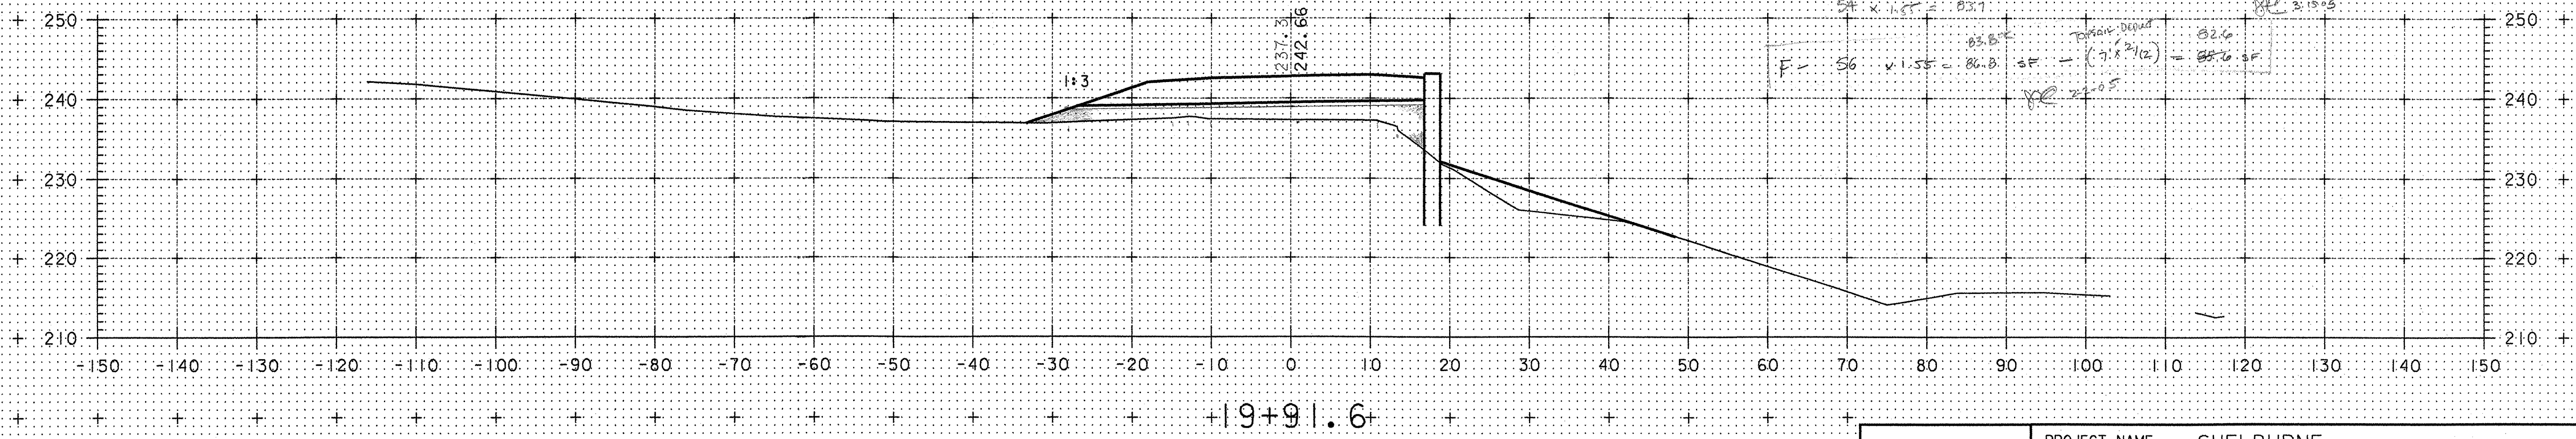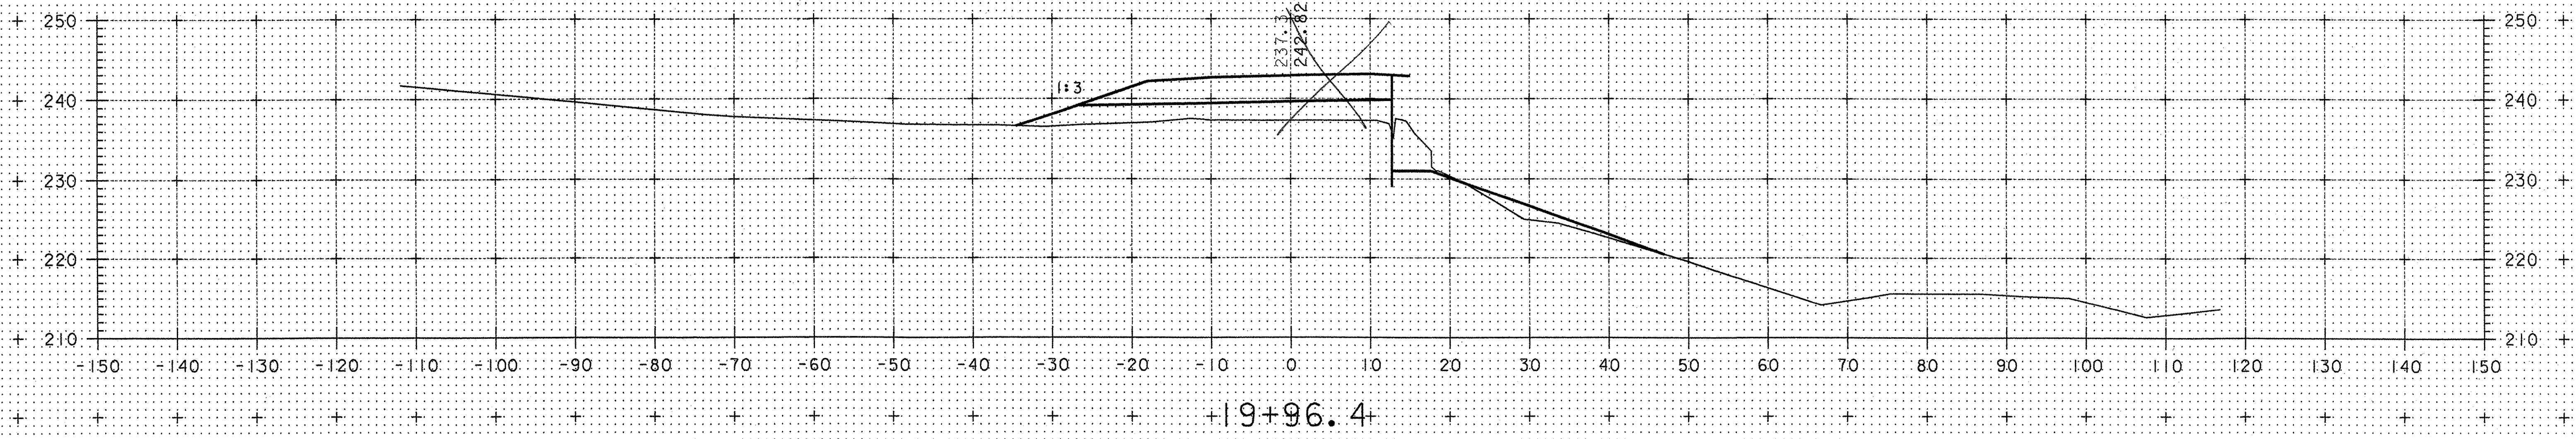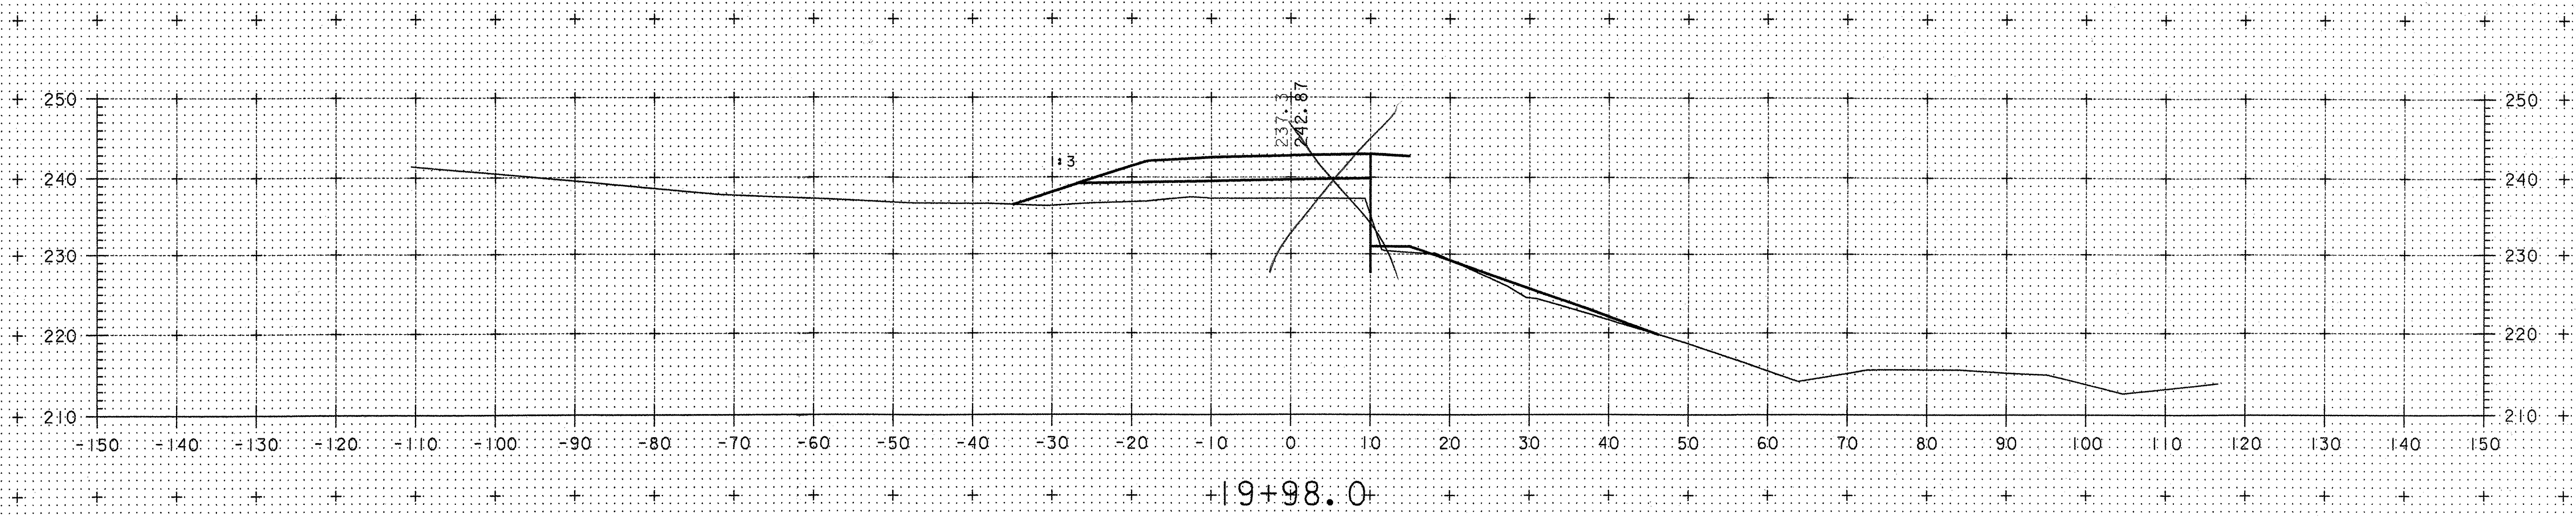


BOSTWICK ROAD	PROJECT NAME: SHELBURNE
	PROJECT NUMBER: BRO J445(30)
	FILE NAME: m:\595402_Bostwick\HWY\INROADS\BRC-Construction_Sections
	PROJECT LEADER: MBZ
DESIGNED BY: DMB	PLOT DATE: 12-FEB-2004
CHECKED BY: MDL	DRAWN BY: DMB
	SHEET 5 OF 9

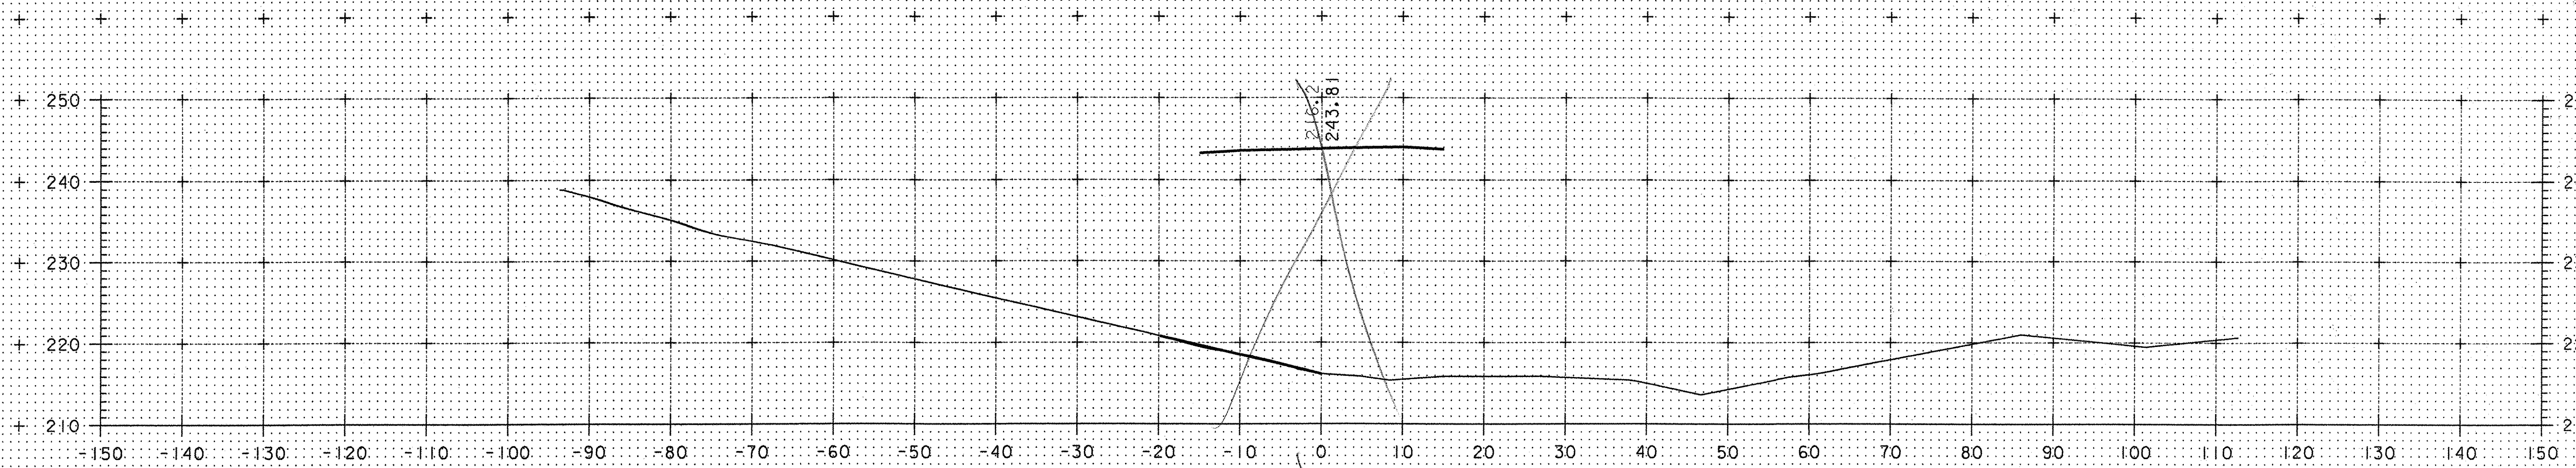


+20+31.0

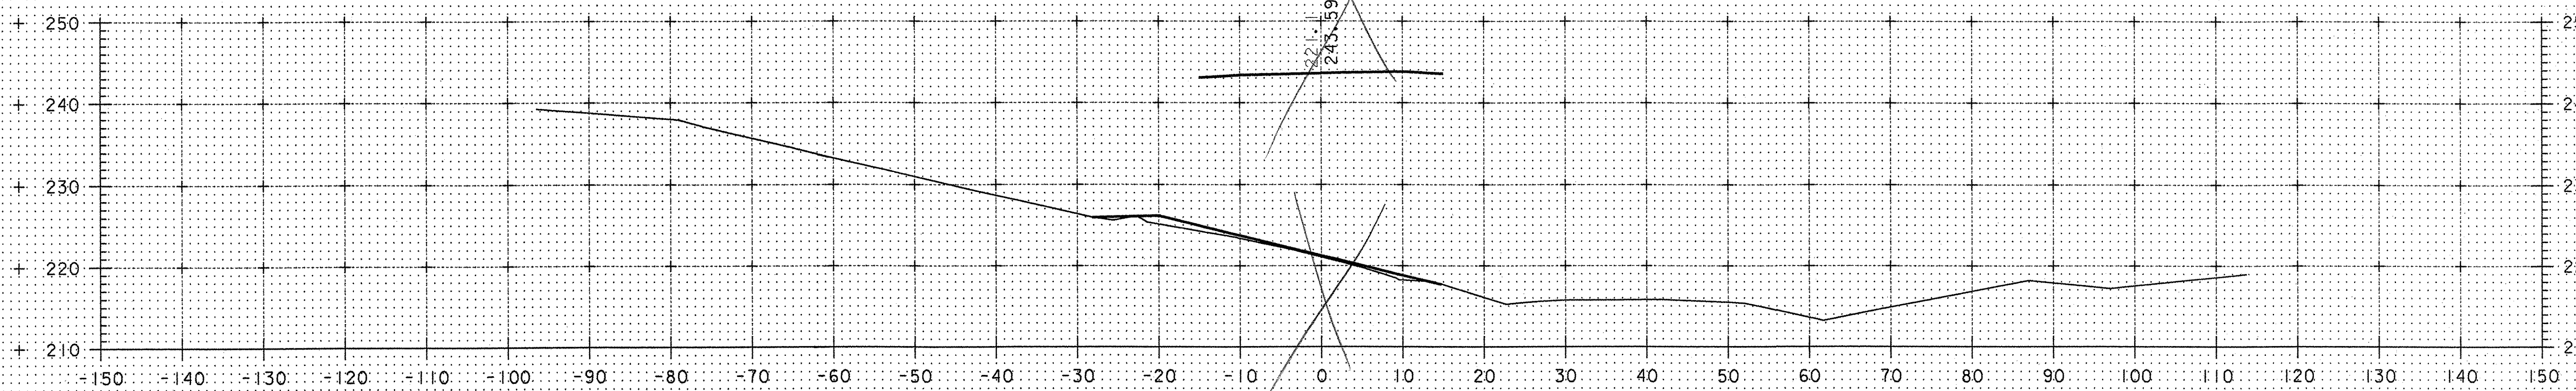


+20+22.6

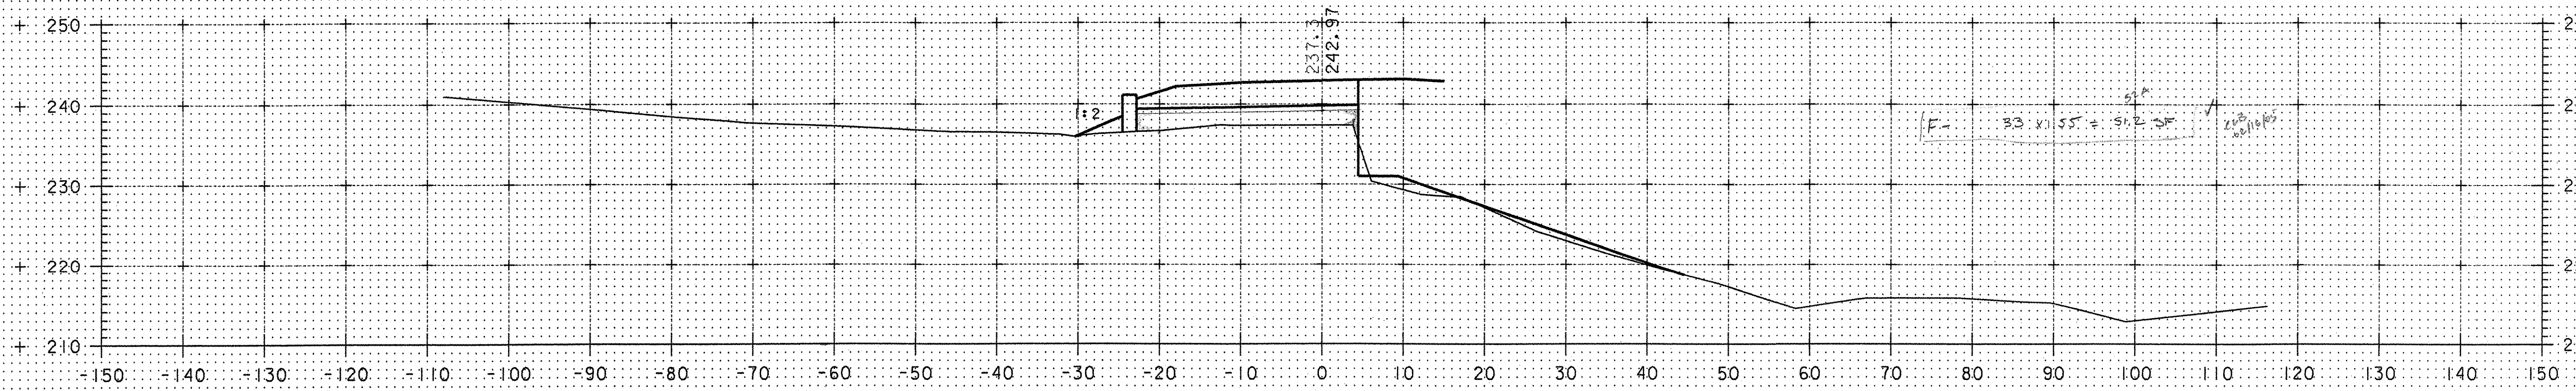


+20+01.2

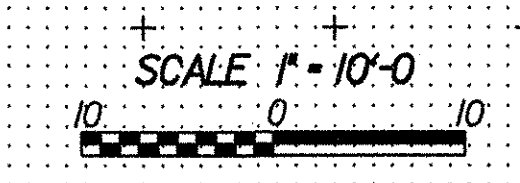

BOSTWICK ROAD	PROJECT NAME: SHEL BURNE
	PROJECT NUMBER: BRO J445(30)
	FILE NAME: m:\595402_Bostwick\HWY\INROADS\BRC-Construction_Sections
	PROJECT LEADER: MBZ PLOT DATE: 12-FEB-2004
DESIGNED BY: DMB DRAWN BY: DMB	
CHECKED BY: MDL SHEET 6 OF 9	

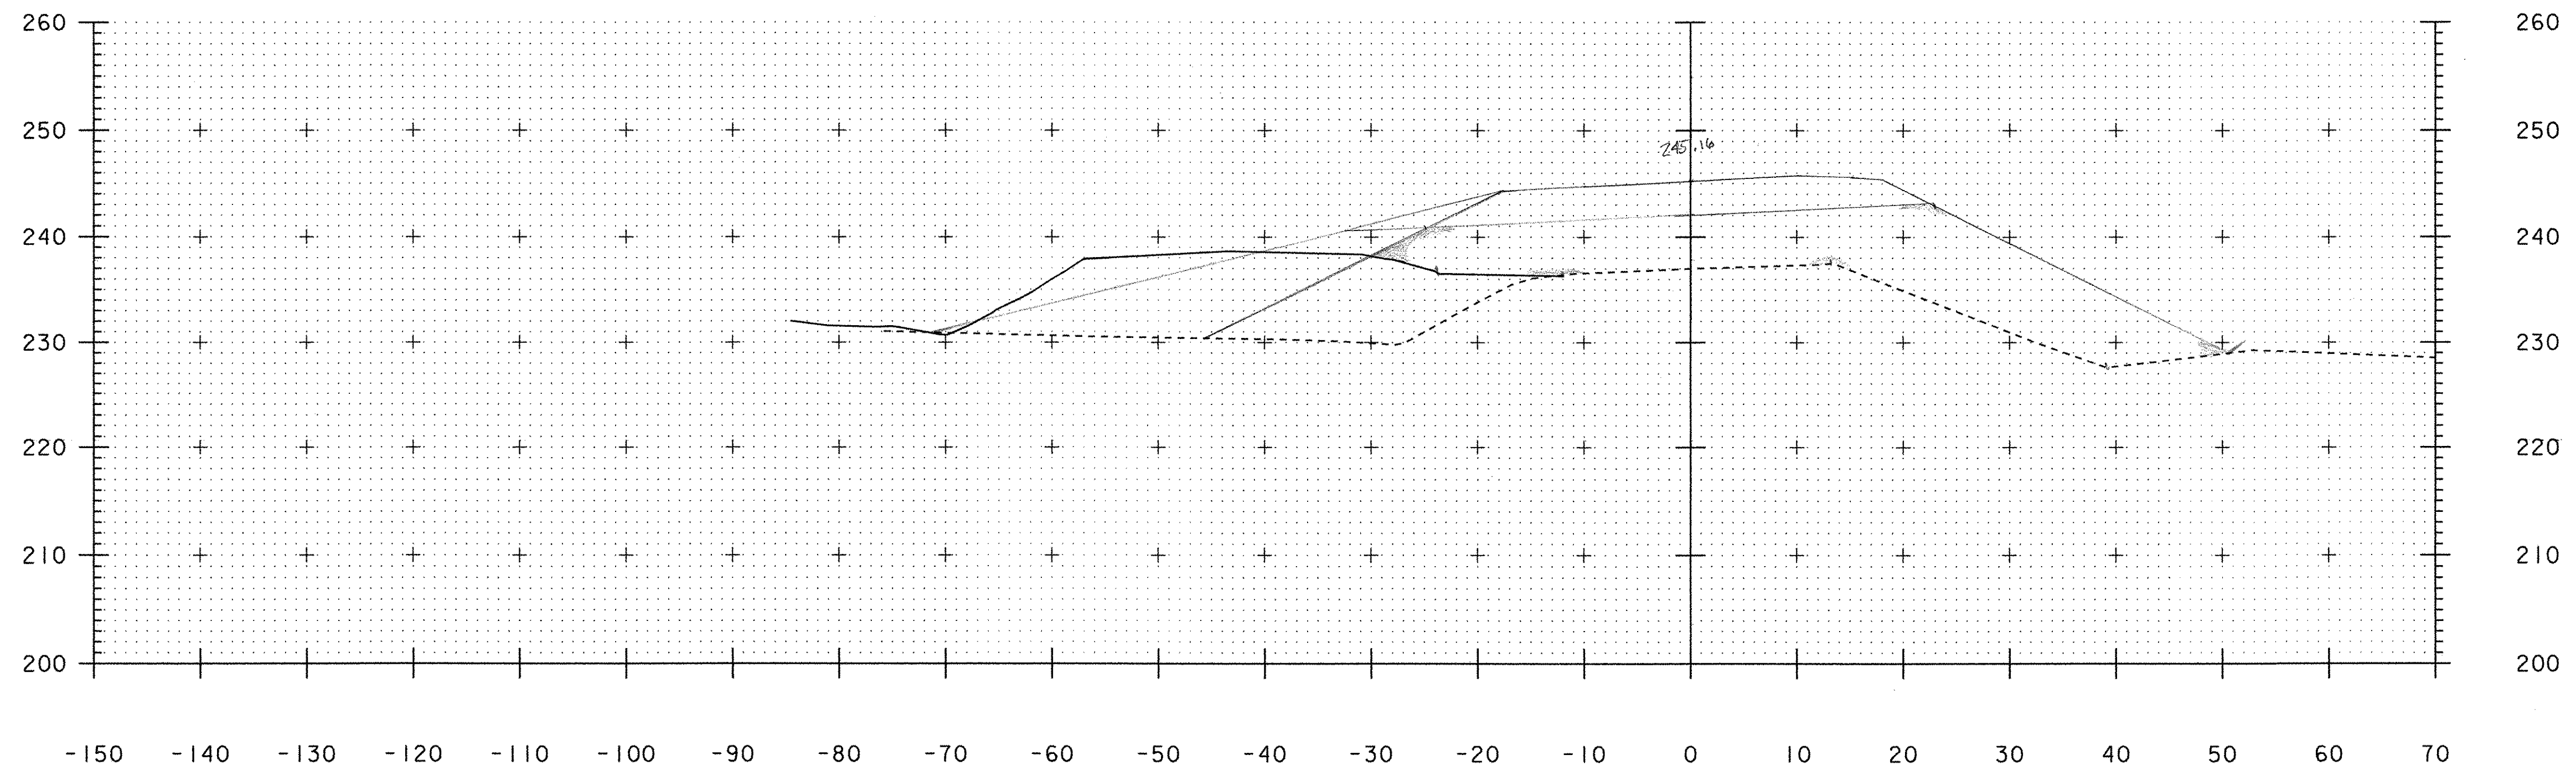

22+00

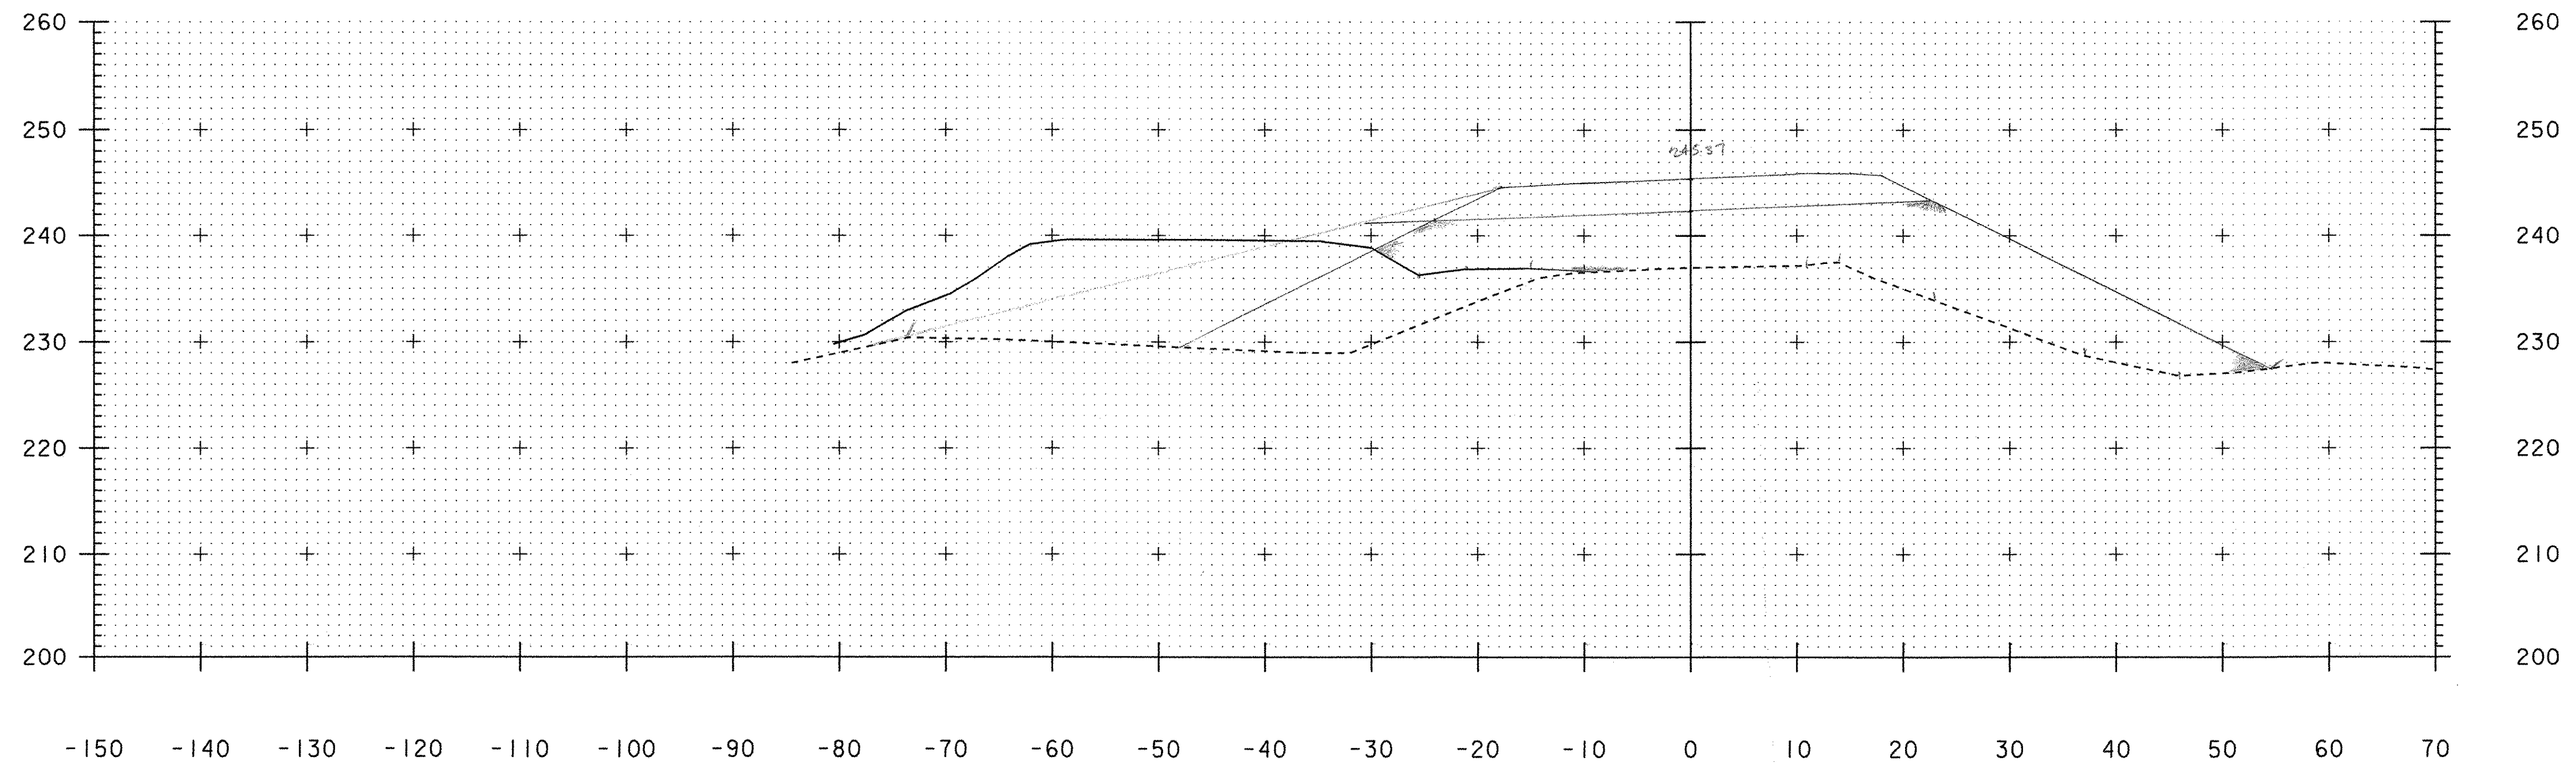


21+50

$F = 230 \times 1.35 = 436.7$
 $- (37' \times 2/12) = 427.8 \text{ SF}$
 063 02/16/05


TO PAUL DEWICK
 $F = 309 \times 1.35 = 417.225$
 $- (40' \times 2/12) = 412.3 \text{ SF}$
 063 02/16/05

REVISED ORIGINAL SECTIONS

PROJECT NAME:	SHELBURNE
PROJECT NUMBER:	BRO 1445(30)
FILE NAME:	94J196/SURVEY/X94J196DQ
PROJECT LEADER:	PLOT DATE: 07-JUL-2004
DESIGNED BY:	DRAWN BY: BEYOR
DETOUR SECTIONS - MAY 28, 2004	CHECKED BY:
	SHEET 7 OF 9

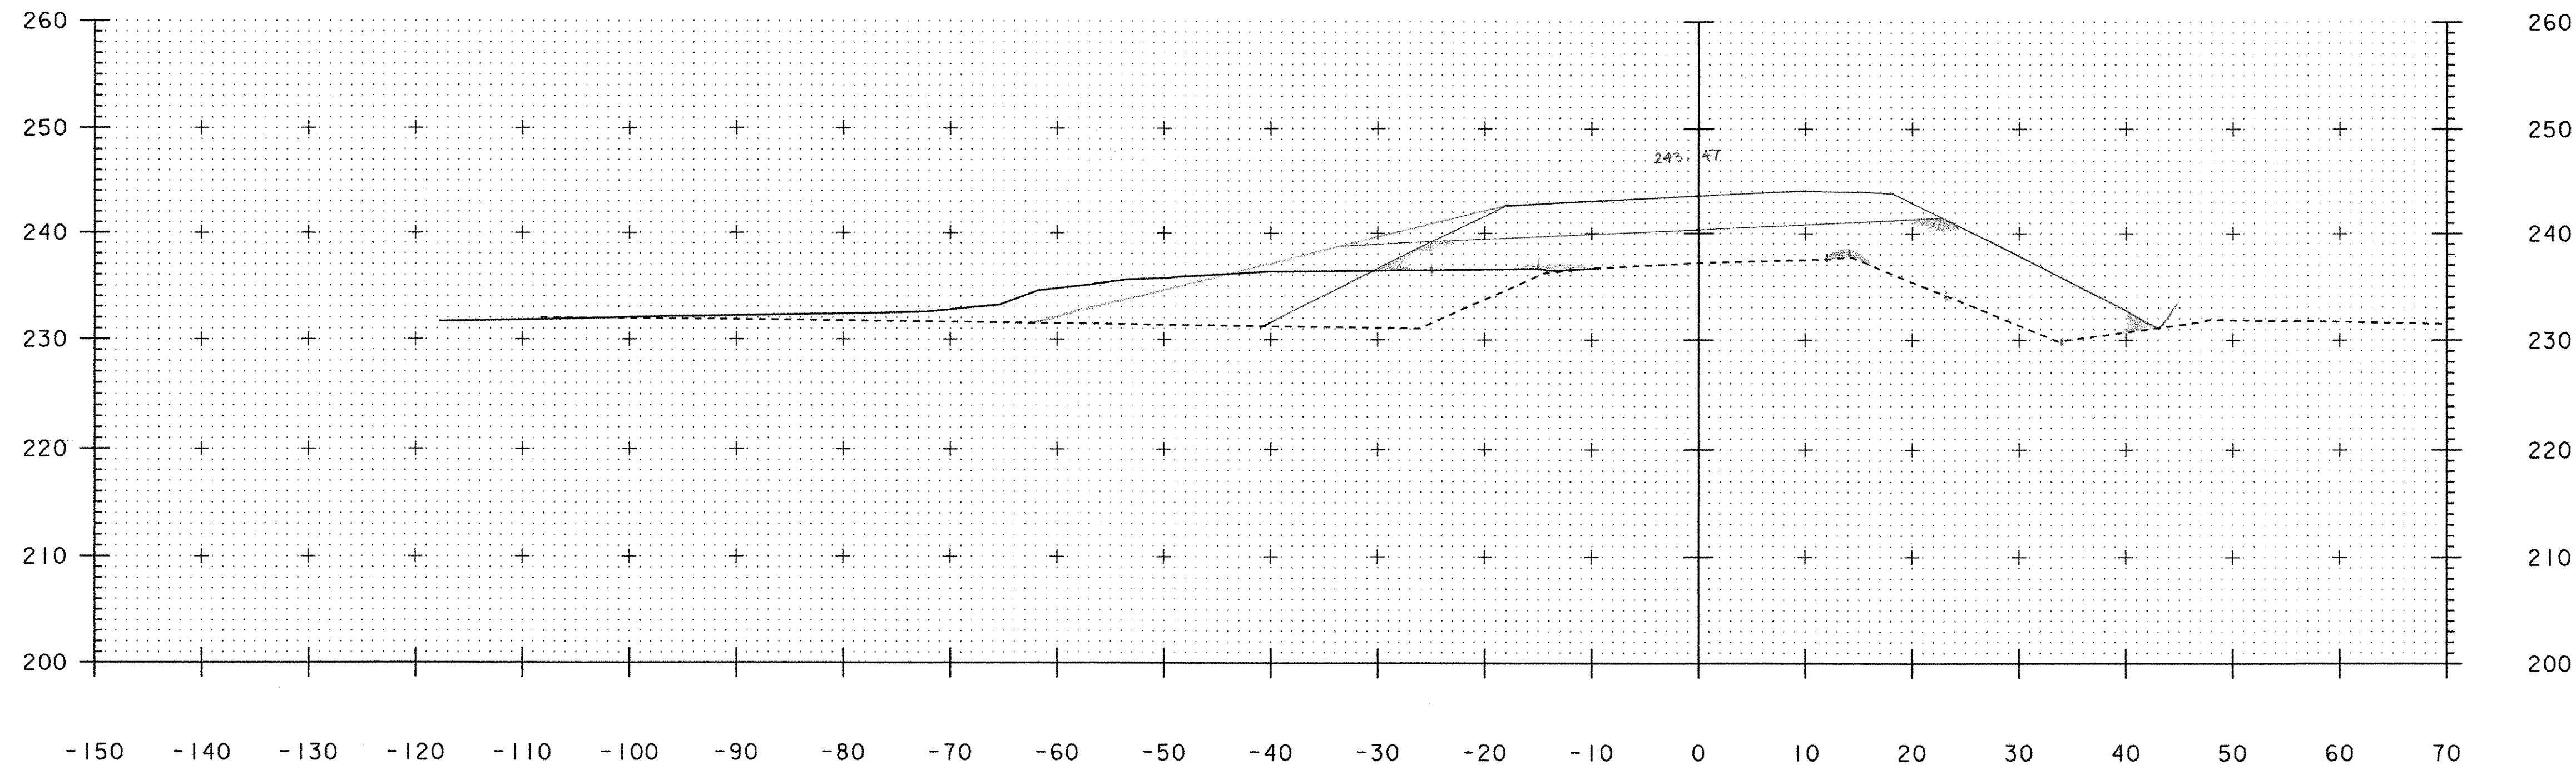


23+00

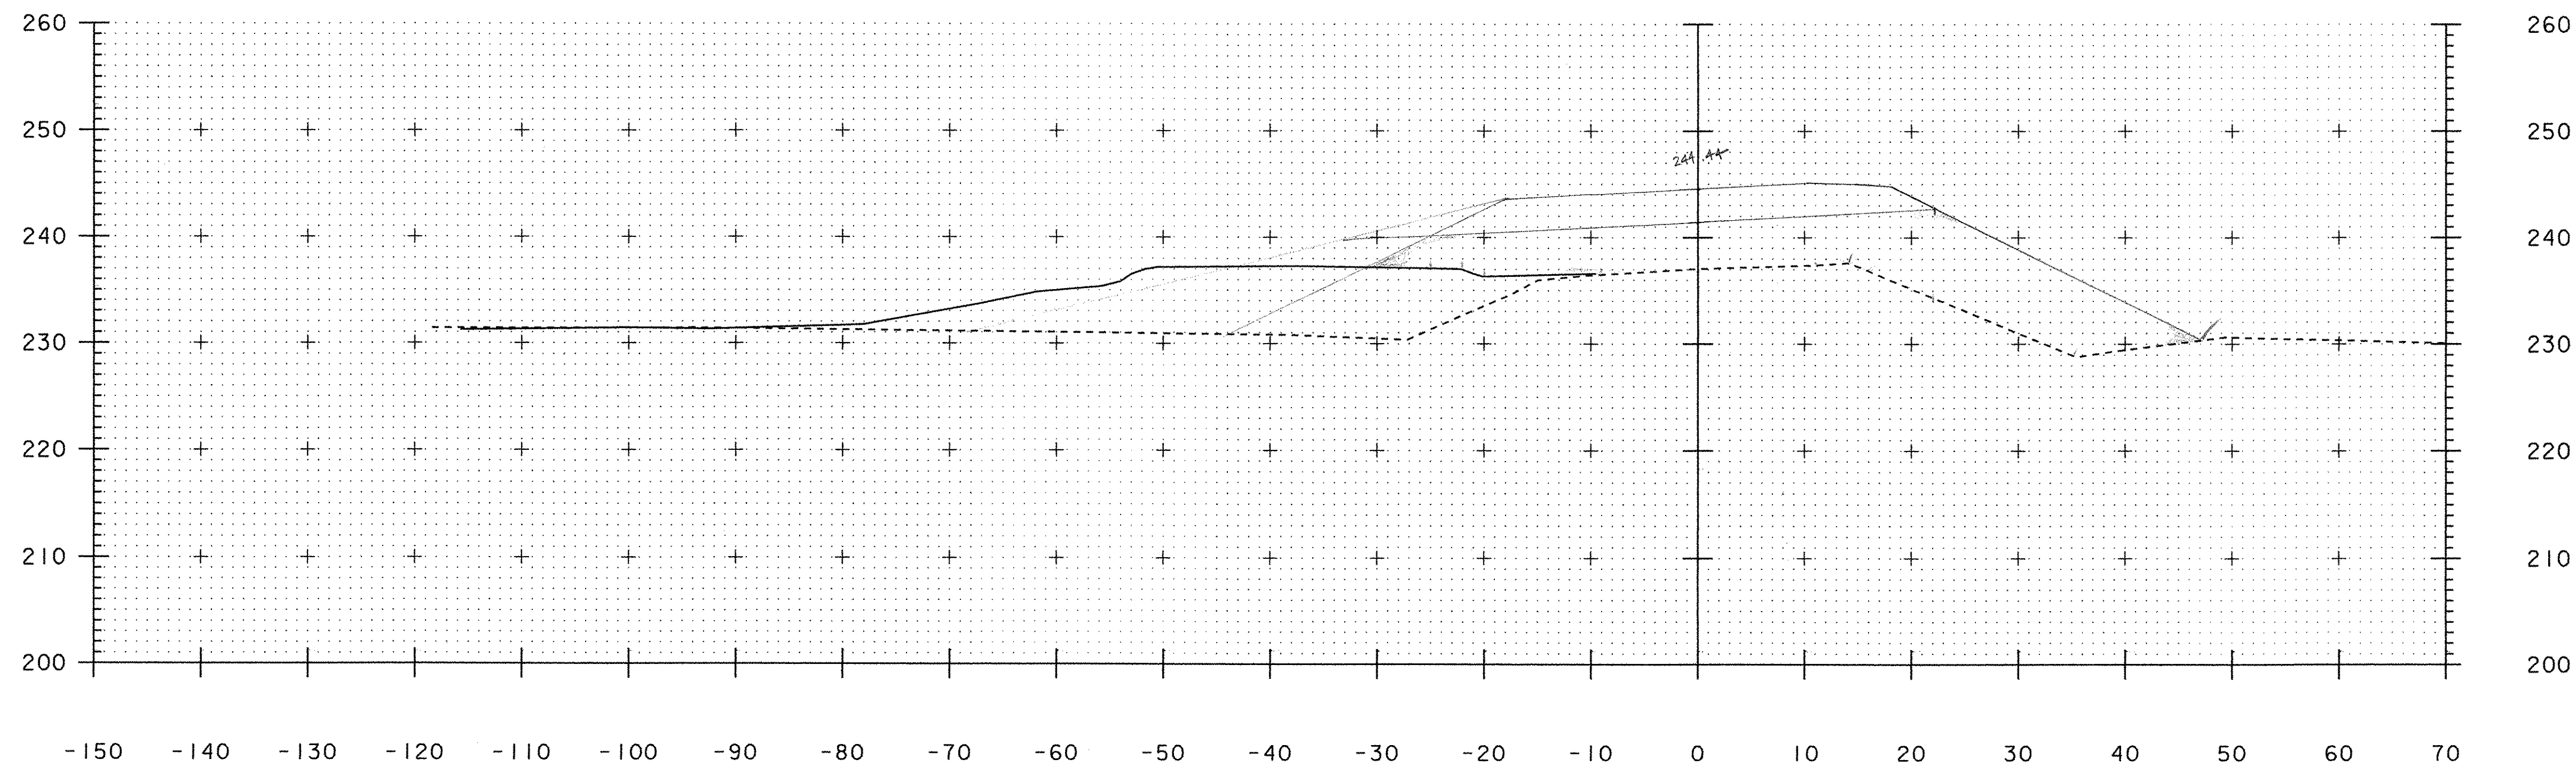


22+50

REVISED ORIGINAL SECTION 45

PROJECT NAME:	SHELBURNE		
PROJECT NUMBER:	BRO 1445(30)		
FILE NAME:	94J196/SURVEY/X94J196DQ	PROJECT LEADER:	BEYOR
DESIGNED BY:		CHECKED BY:	
DETOUR SECTIONS -	MAY 28, 2004	PLOT DATE:	07-JUL-2004
		DRAWN BY:	BEYOR
		CHECKED BY:	
		SHEET	B OF 3

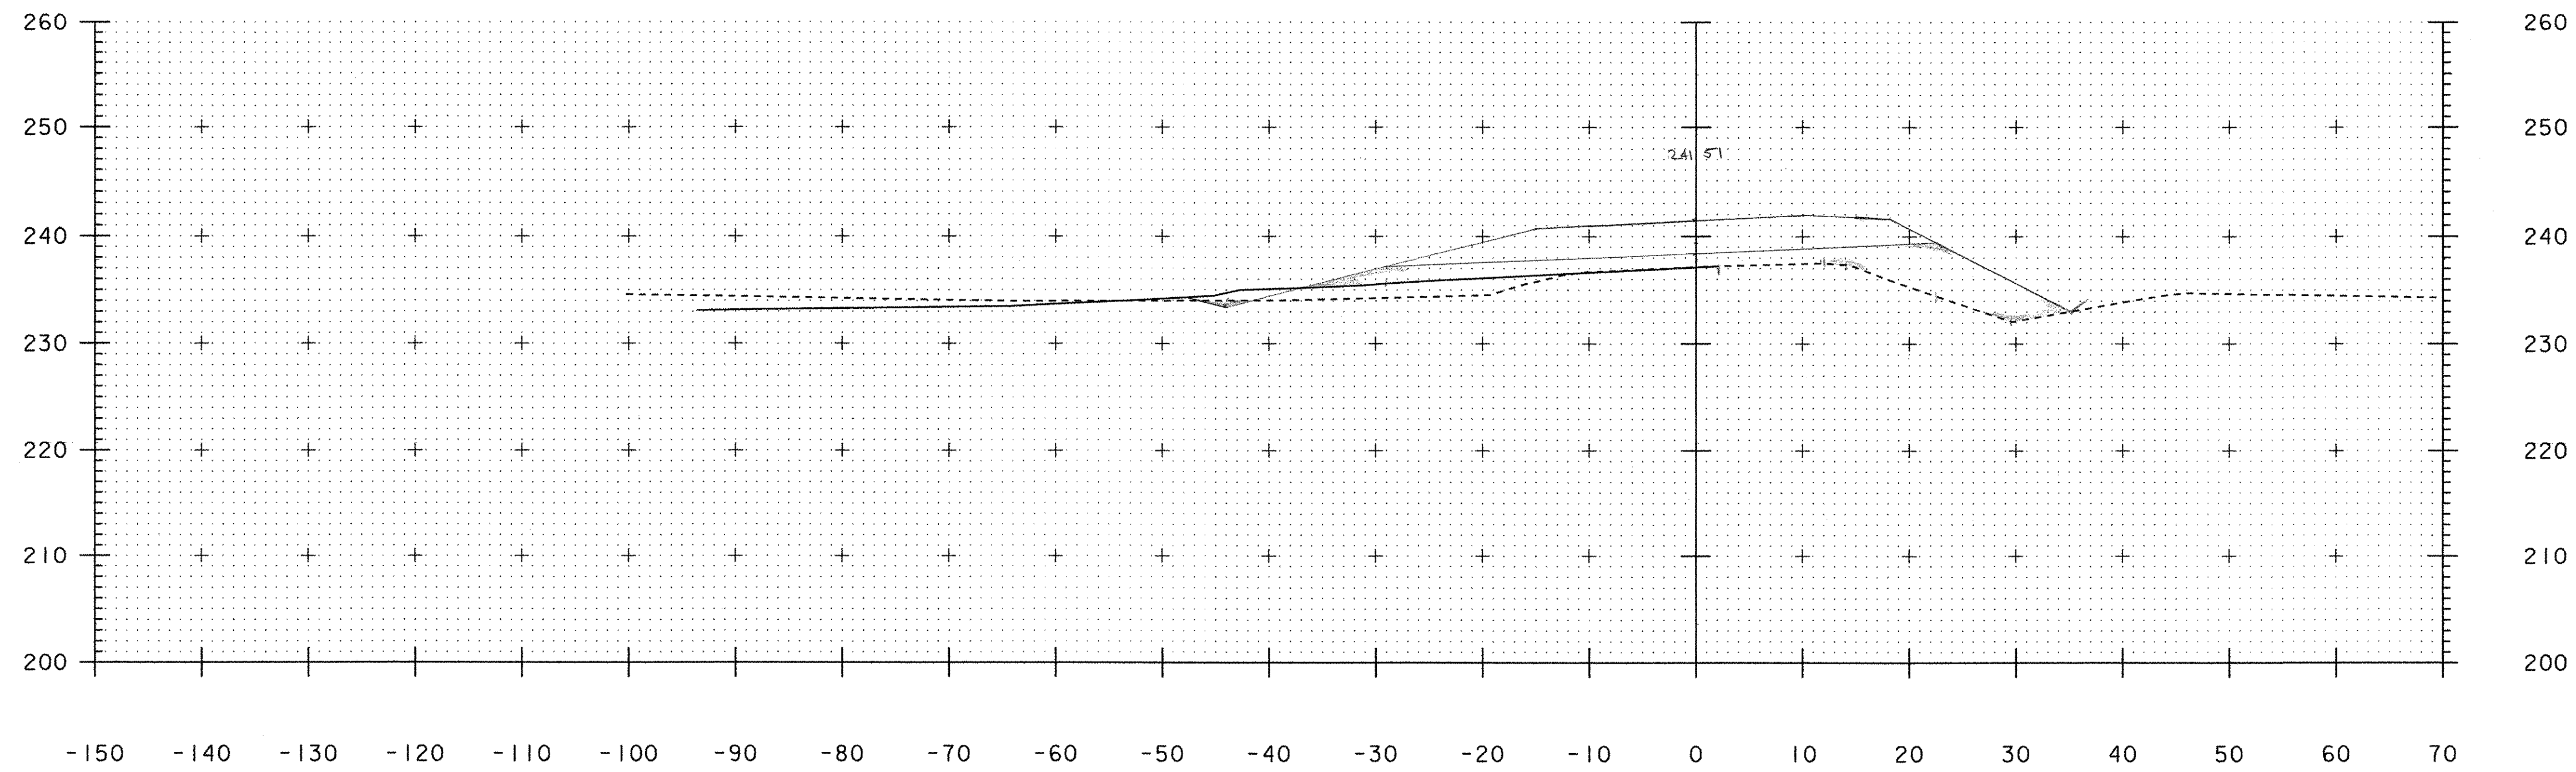

24+00

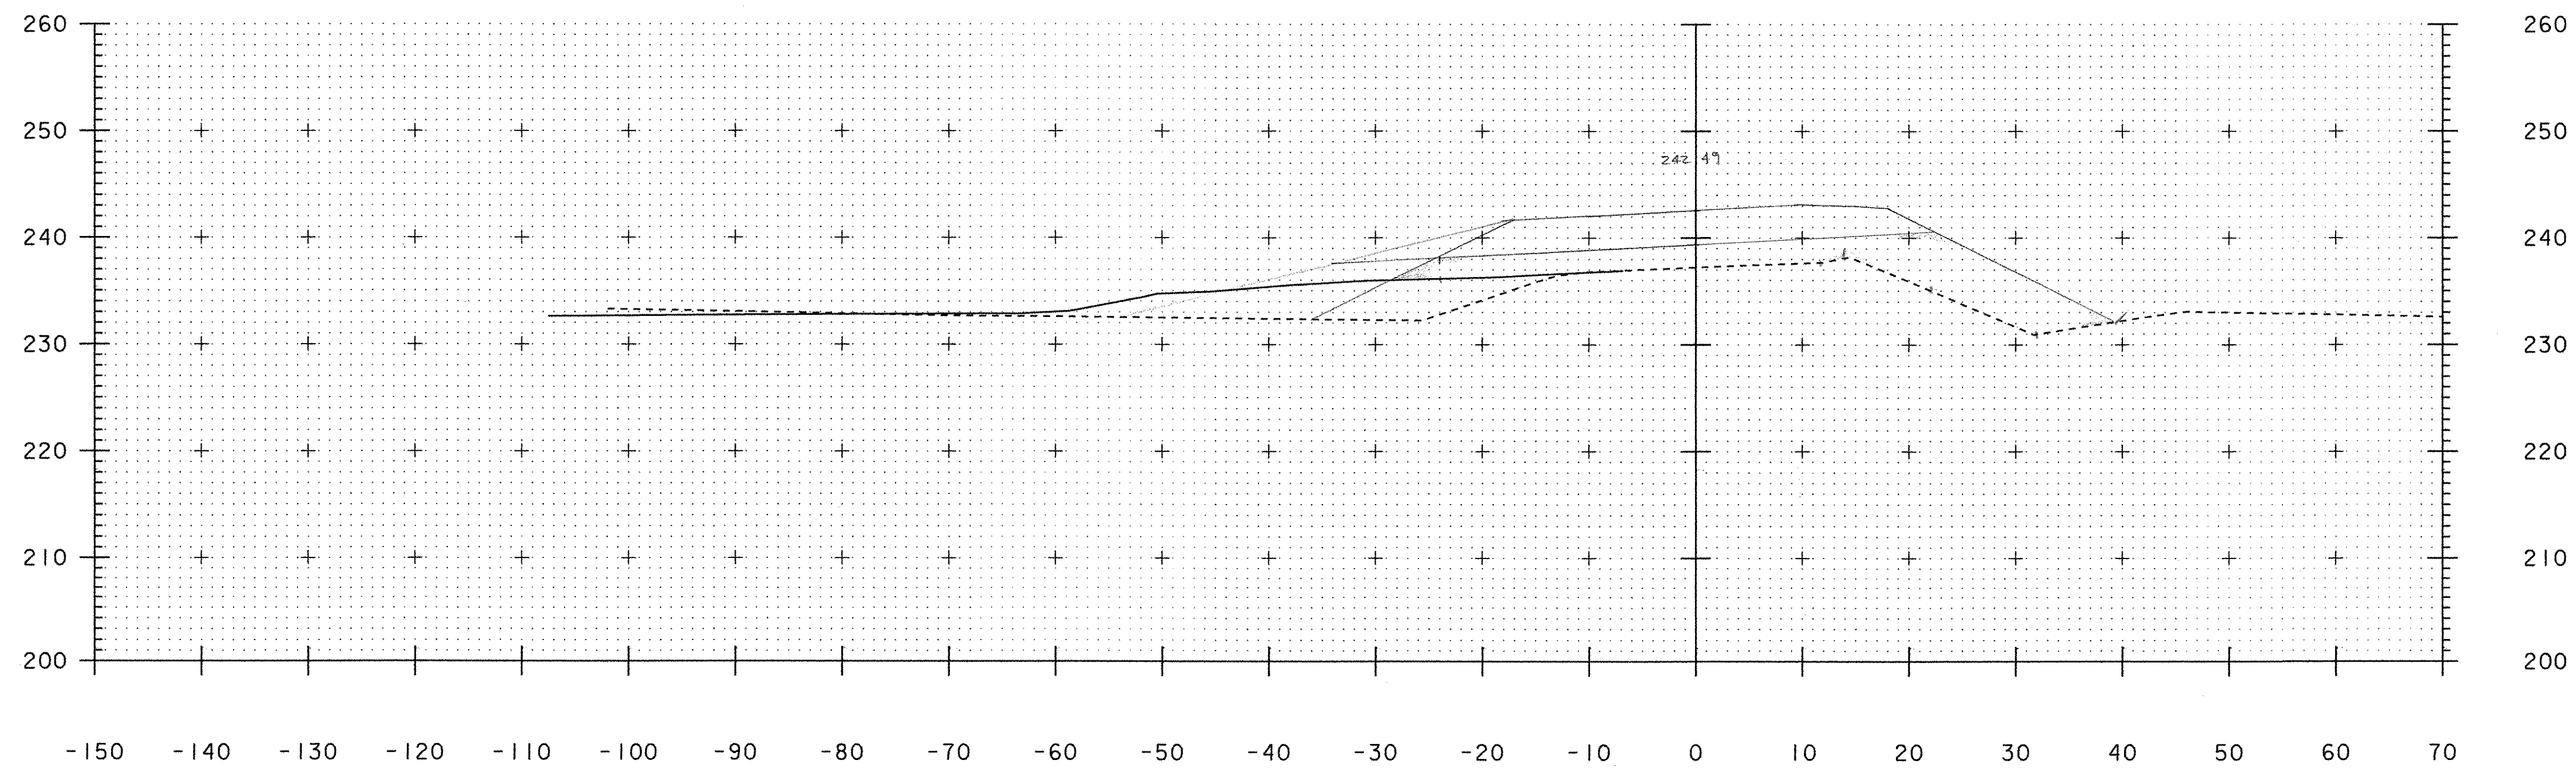

23+50

$86 \times 1.55 = 133.3 \text{ SF}$
 133.0 SF
 $F = 83 \times 1.55 = 127.6 \text{ SF} - (20' \times 2 \frac{1}{2}) = 124.9$
 $C = 1 \text{ SF}$
 JE 3.15.05
 JE 2.2.05


$C = 0 \text{ SF}$
 190
 $F = 127 \times 1.55 = 196.85 \text{ SF} - (24' \times 2 \frac{1}{2}) = 183.6 \text{ SF}$
 JE 2.2.05
 6/5 06/10/05

REVISED ORIGINAL SECTIONS


PROJECT NAME:	SHELBURNE
PROJECT NUMBER:	BRO 1445(30)
FILE NAME:	94J196/SURVEY/X94J196DQ
PROJECT LEADER:	PLOT DATE: 07-JUL-2004
DESIGNED BY:	DRAWN BY: BEYOR
DETOUR SECTIONS - MAY 28, 2004	CHECKED BY:
	SHEET 9 OF 9

MK	QTY.	DESCRIPTION	MATERIAL	LENGTH	REMARKS	PART NO.
1A	5	PREFORMED FABRIC BEARING				
1a1	5	1.750" X 16.000"	AASHTO 18.4.10.1	9.000"	EPOXY BOND TO SOLE PLATE	
1sp1	5	1.375" X 25.000"	A709 GR 36	13.000"	BEVEL, CLIP CORNER; METALIZE	
1B	10	SWEDGE ROD				
1b1	10	1.500"Ø X 21.000"	A449		4.000" THREADS, 14.000" SWEDGE, A153-HDG	
1C	10	HEAVY HEX NUT				
1c1	10	1.500"Ø	A563-DH/A194-2H		A153-HDG	
1D	10	WASHER PLATE				
1d1	10	0.375" X 3.000"	A36	3.000"	1.875" DIAMETER HOLE @ CENTER OF PLATE; A153-HDG	

NOTE: ALL MATERIAL SPECIFICATION DESCRIPTIONS ARE ASTM, UNLESS OTHERWISE NOTED.

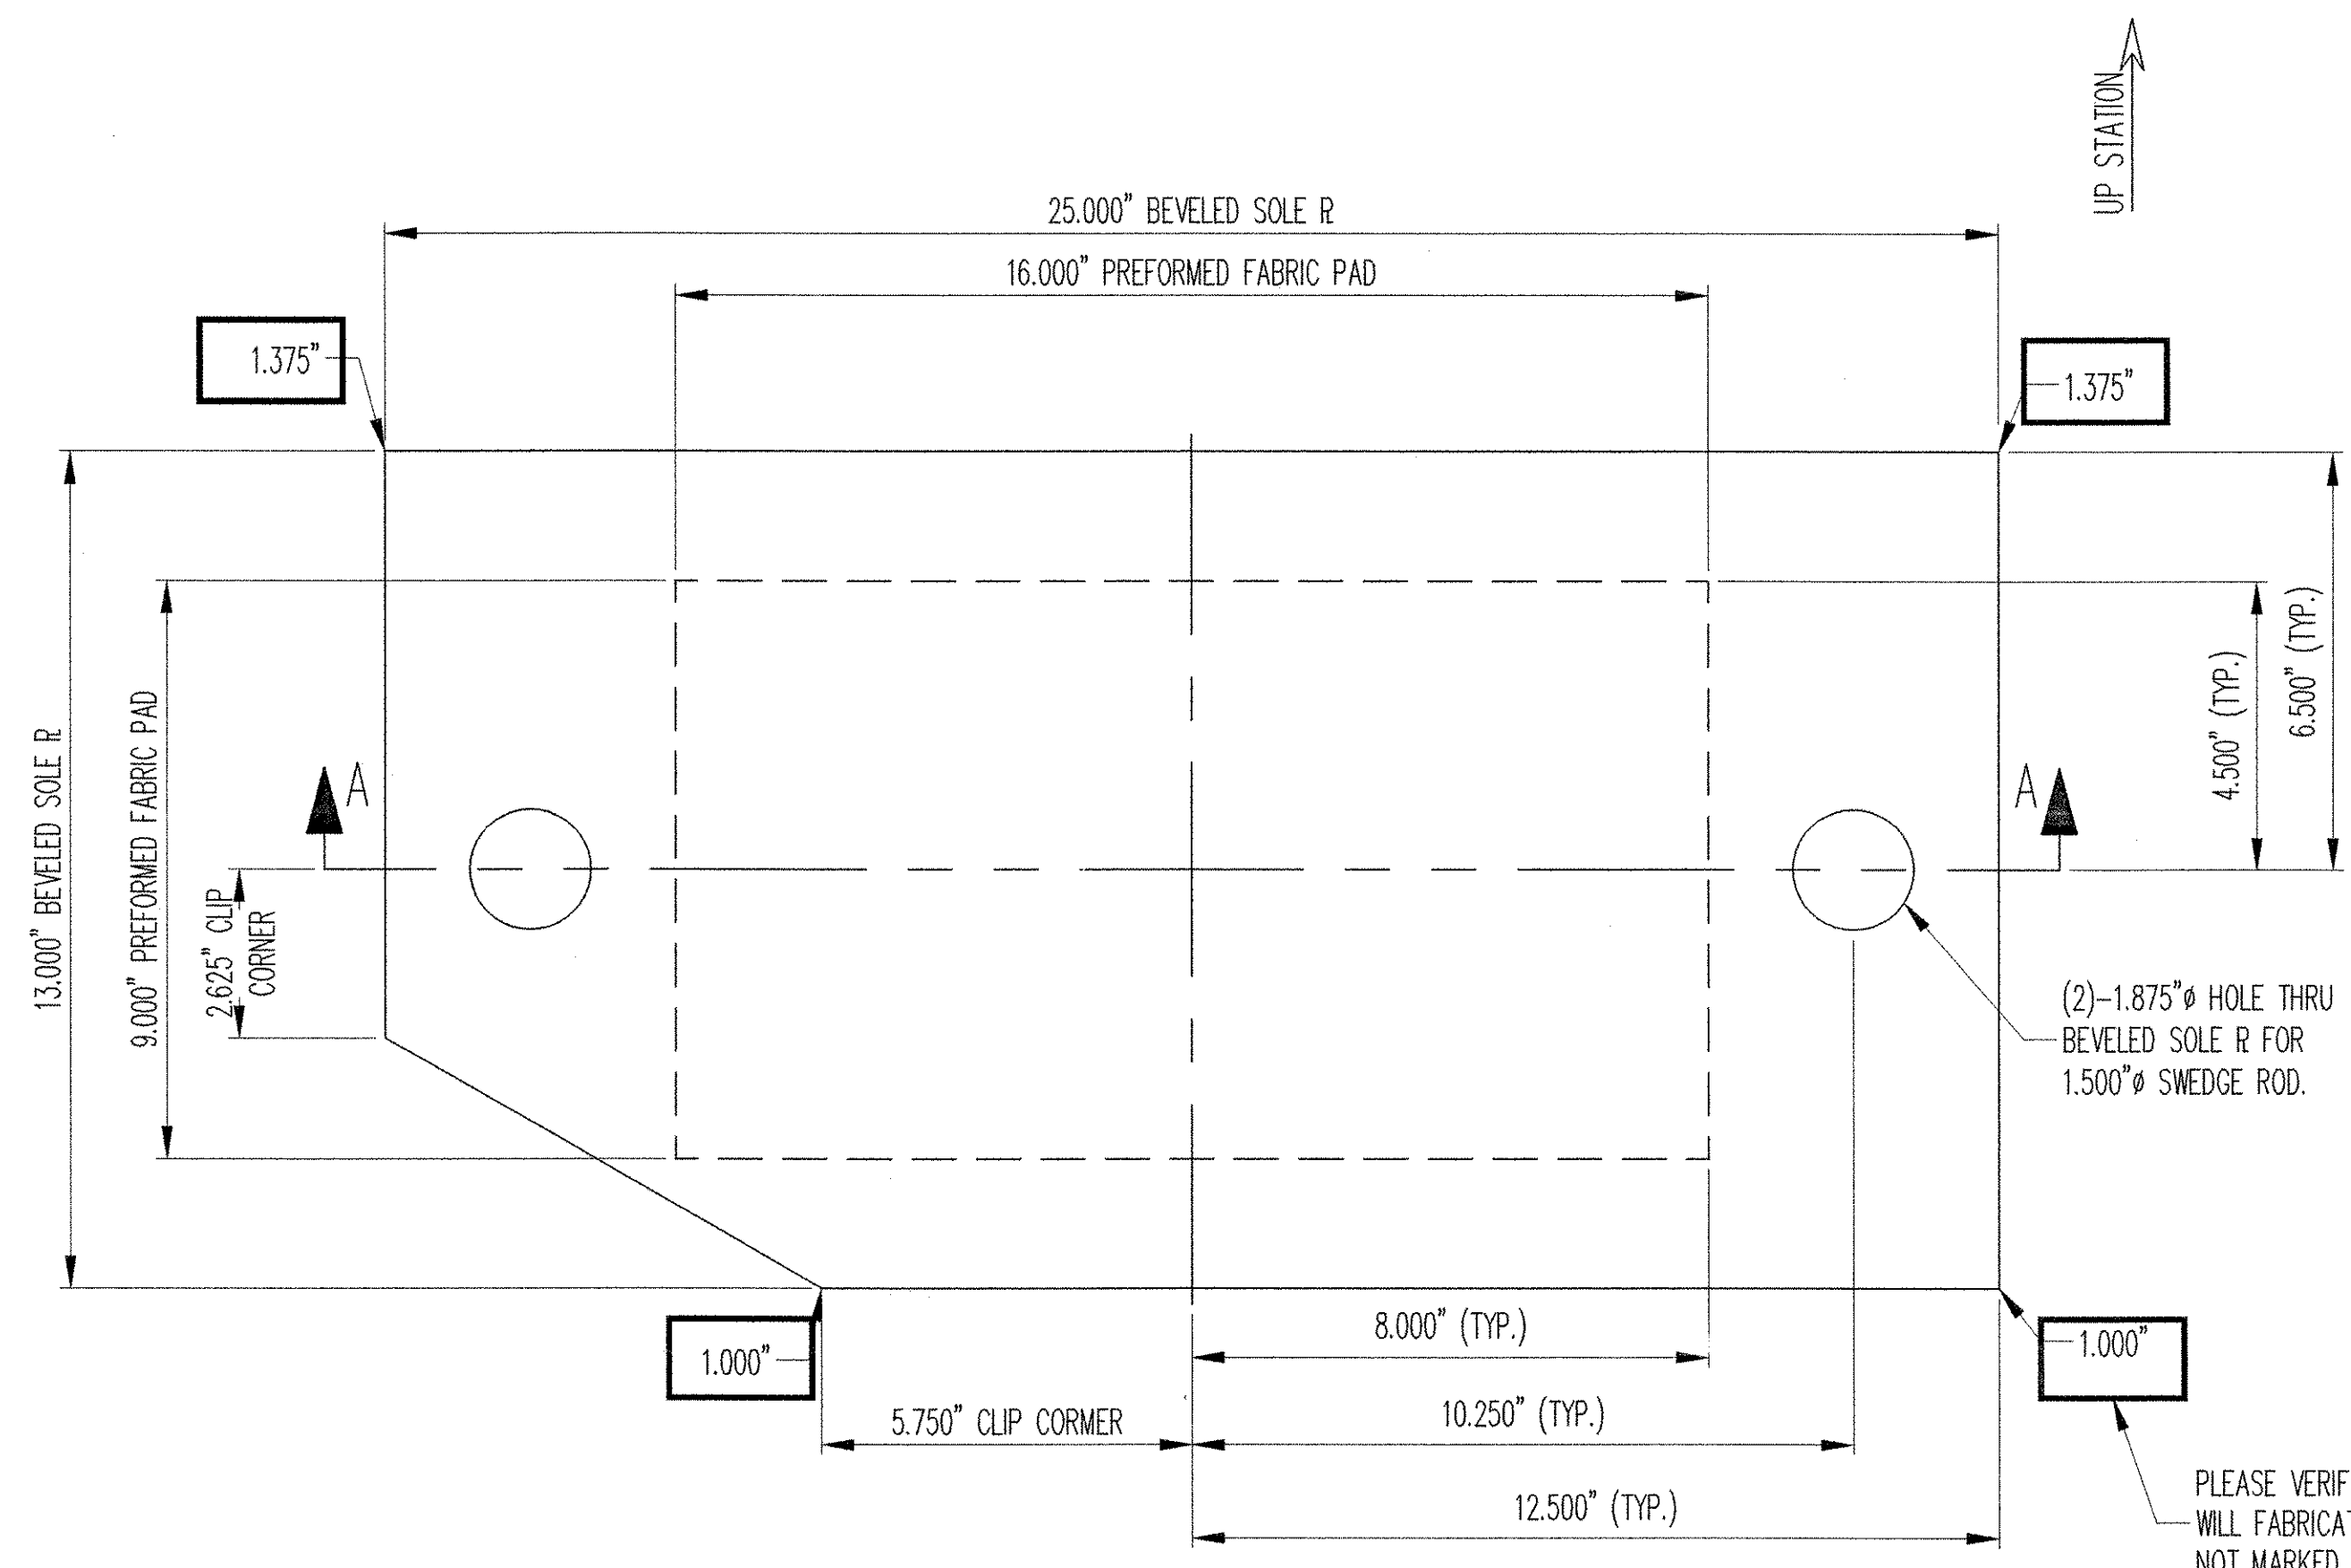


PLAN VIEW
FIXED PREFORMED FABRIC BEARING
(5) REQ'D @ ABUT. 1

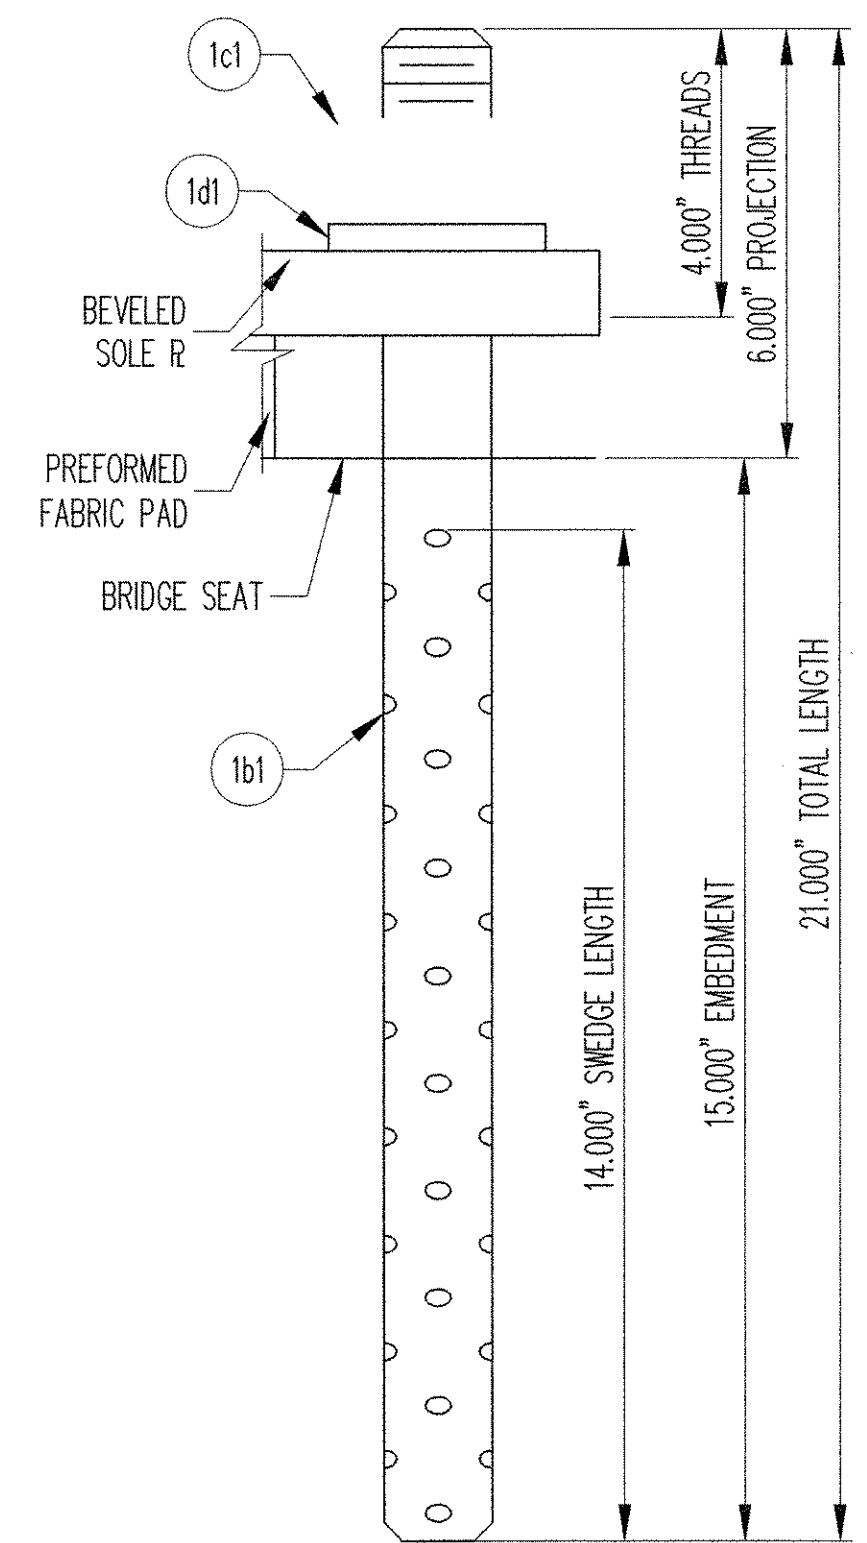


SWEDGE ROD DETAIL

PLEASE VERIFY ALL BEVELS. DSB WILL FABRICATE AS SHOWN IF NOT MARKED.

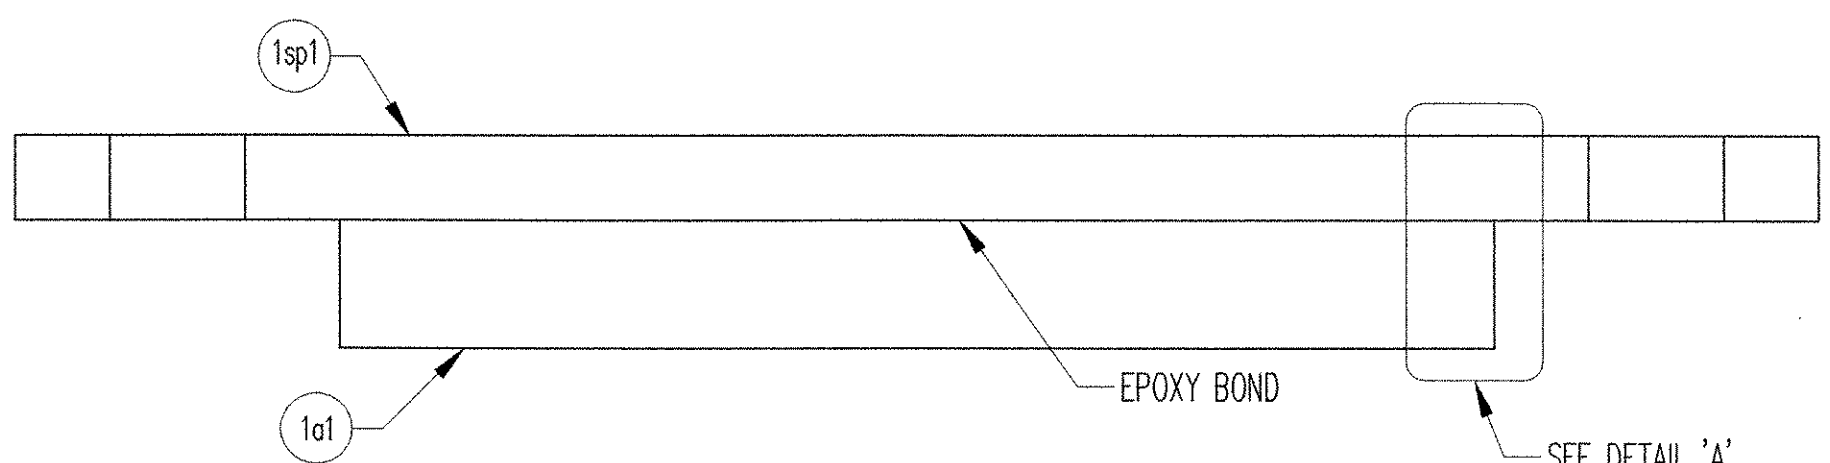

SECTION 'A-A'

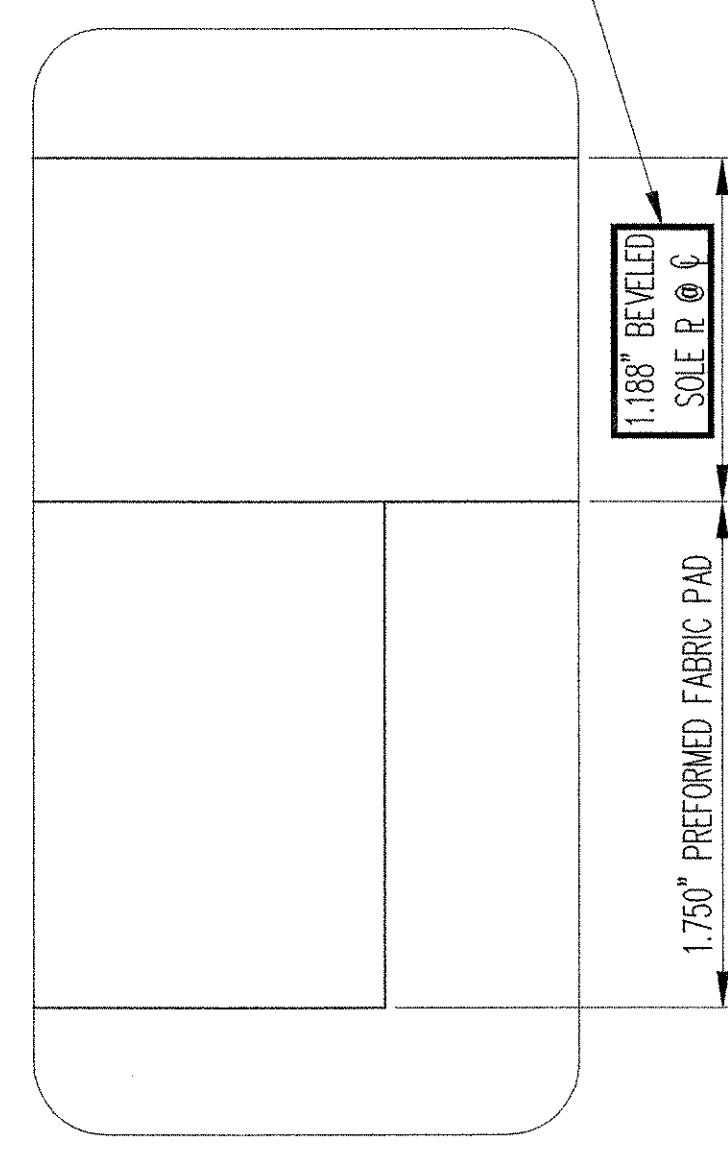

DETAIL 'A'

LOAD TABLE

LOAD DATA	KIPS
DL + SDL	57
LL + I	73
TOTAL	130


RECEIVED
OK'D BY _____ OK'D BY _____
JAN 05 2004
RESUBMIT _____ APPROVED _____
BY *RLW* DATE *1-9-04*

SEE SHT. GN1 FOR GENERAL NOTES & COATING LIMITS.


D.S. BROWN
300 E. CHERRY STREET
NORTH BALTIMORE, OHIO 45872
419.257.3561
FAX: 419.257.0332
4201 NOREX DRIVE
CHASKA, MINNESOTA 55318
952.368.3000
FAX: 952.448.7000
DSBROWN.COM

REV.	DESCRIPTION	DATE	DET.	CKD.
	LOCATION — BOSTWICK ROAD OVER VERMONT RAILWAY		ITEM	QUANTITY
	BRIDGE — 15		10251-1106-1	5 OF 5
	PROJECT — BRO 1445(30)		—	—
	HIGHWAY — TH3		—	—
	P.O. NO. — 7890		—	—
	DESIGNER — McFARLAND-JOHNSON, INC.		—	—
	CUSTOMER — S.D. IRELAND CONSTRUCTION		—	—


DESCRIPTION	SCALE	DRAWN BY	CHECKED BY	DATE
FIXED PREFORMED FABRIC BEARING CHITTENDEN CO., VERMONT	N.T.S.	D.ANDERSON	R. SCHADE	12/23/03
PROJECT NUMBER	PRODUCT CODE	RELEASE	SHEET	
10251	1106	1	01	

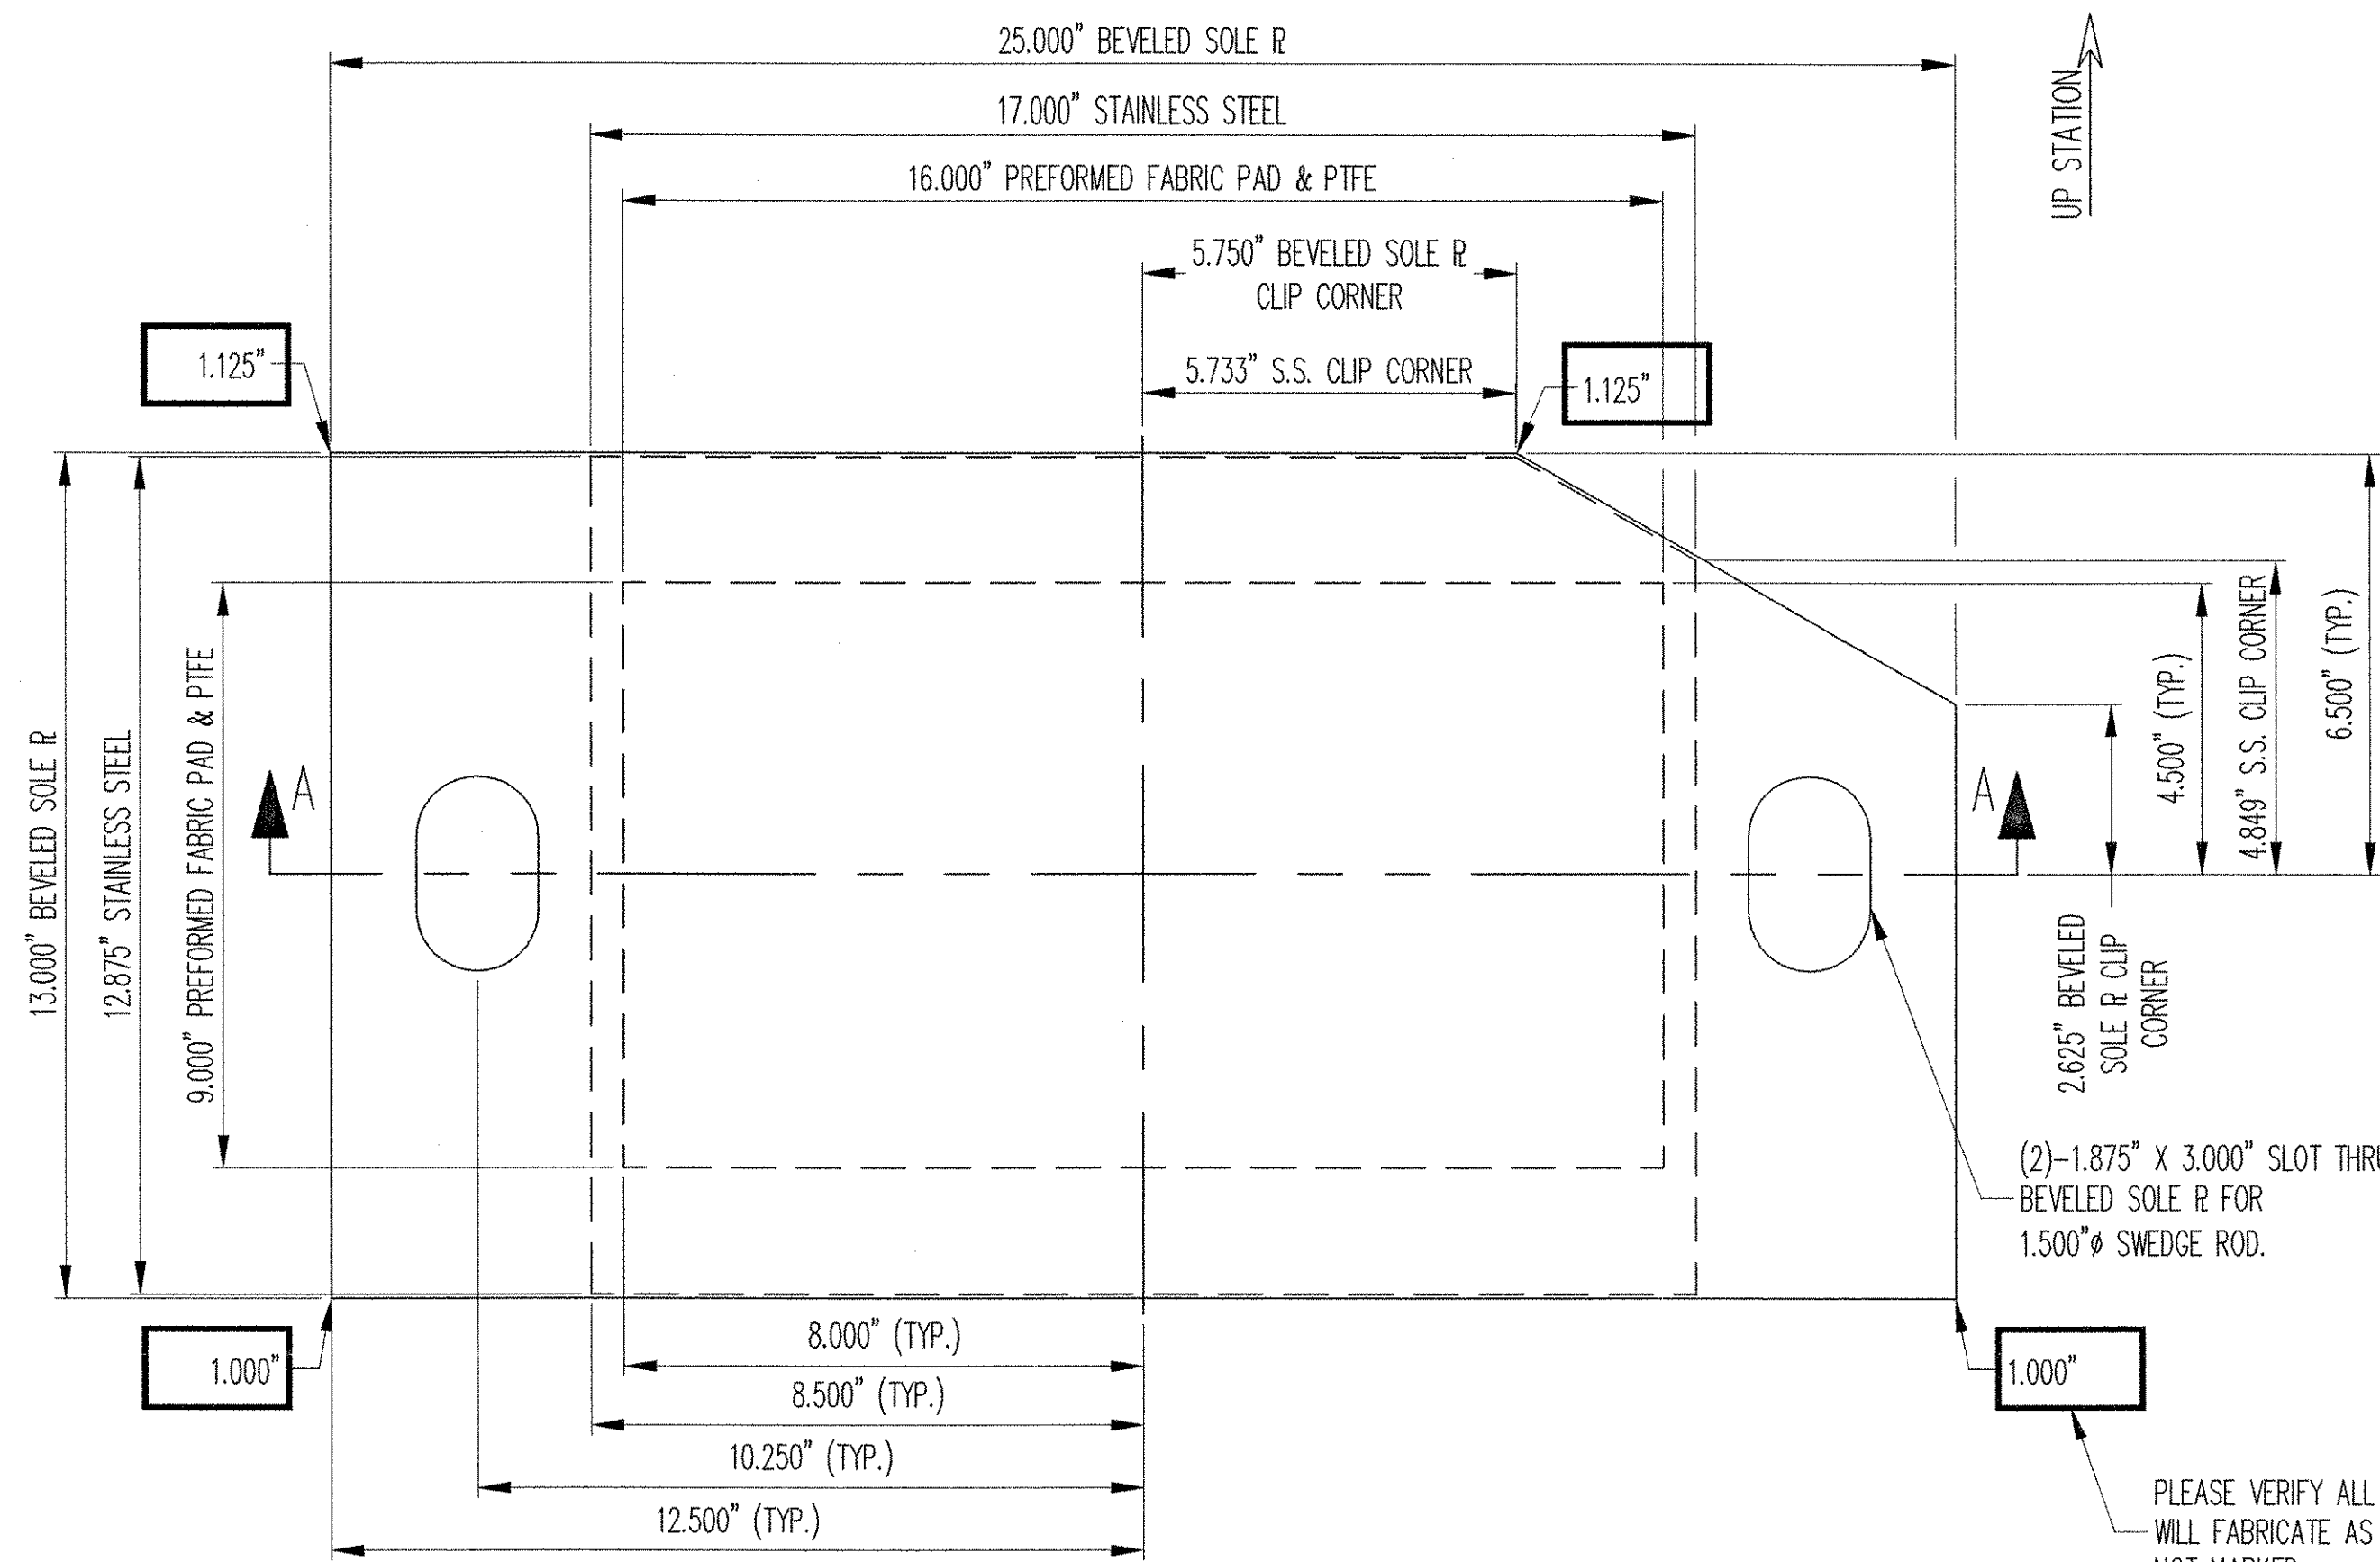


PLAN VIEW
SLIDING PREFORMED FABRIC BEARING
(5) REQ'D @ ABUT. 2

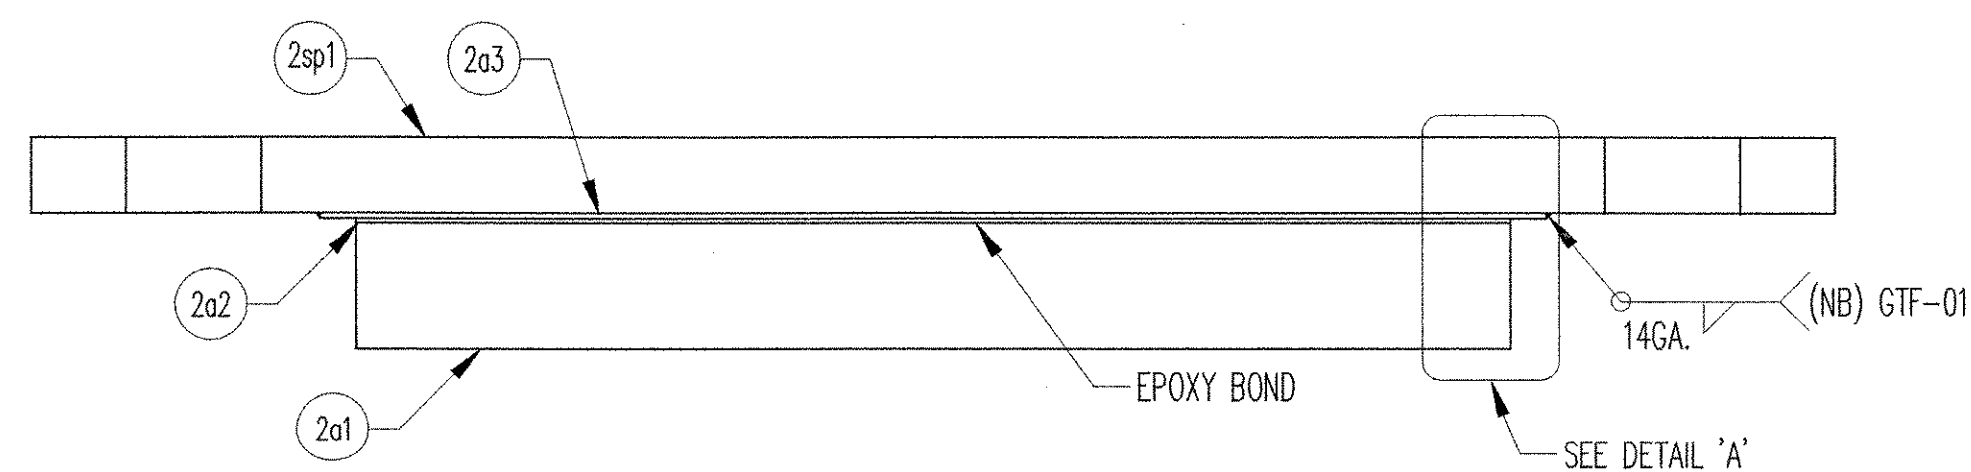

SECTION 'A-A'

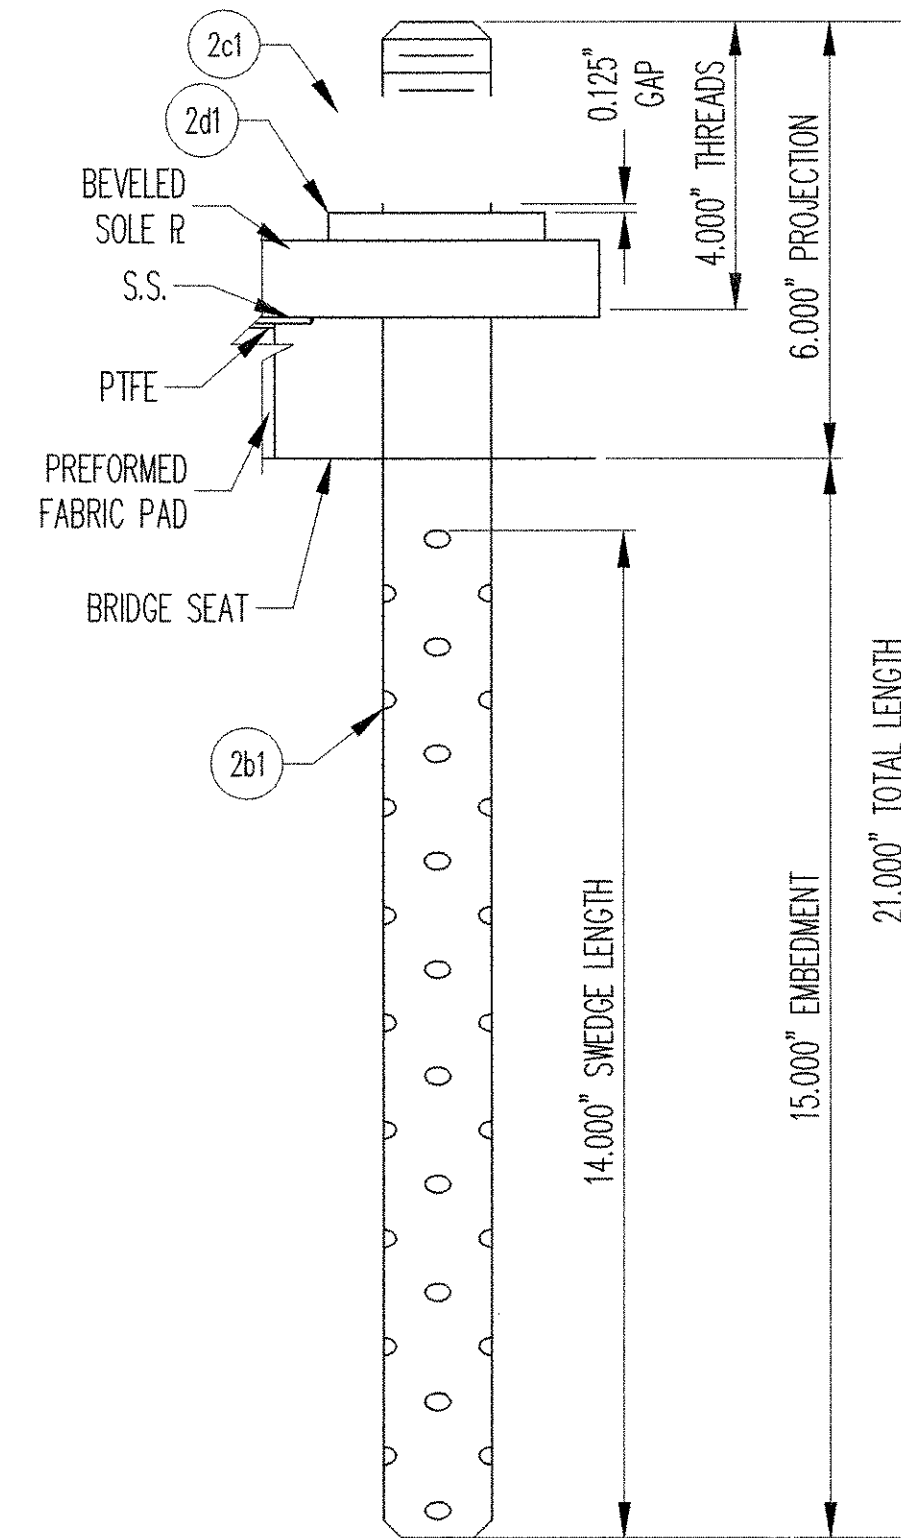

SWEDGE ROD DETAIL

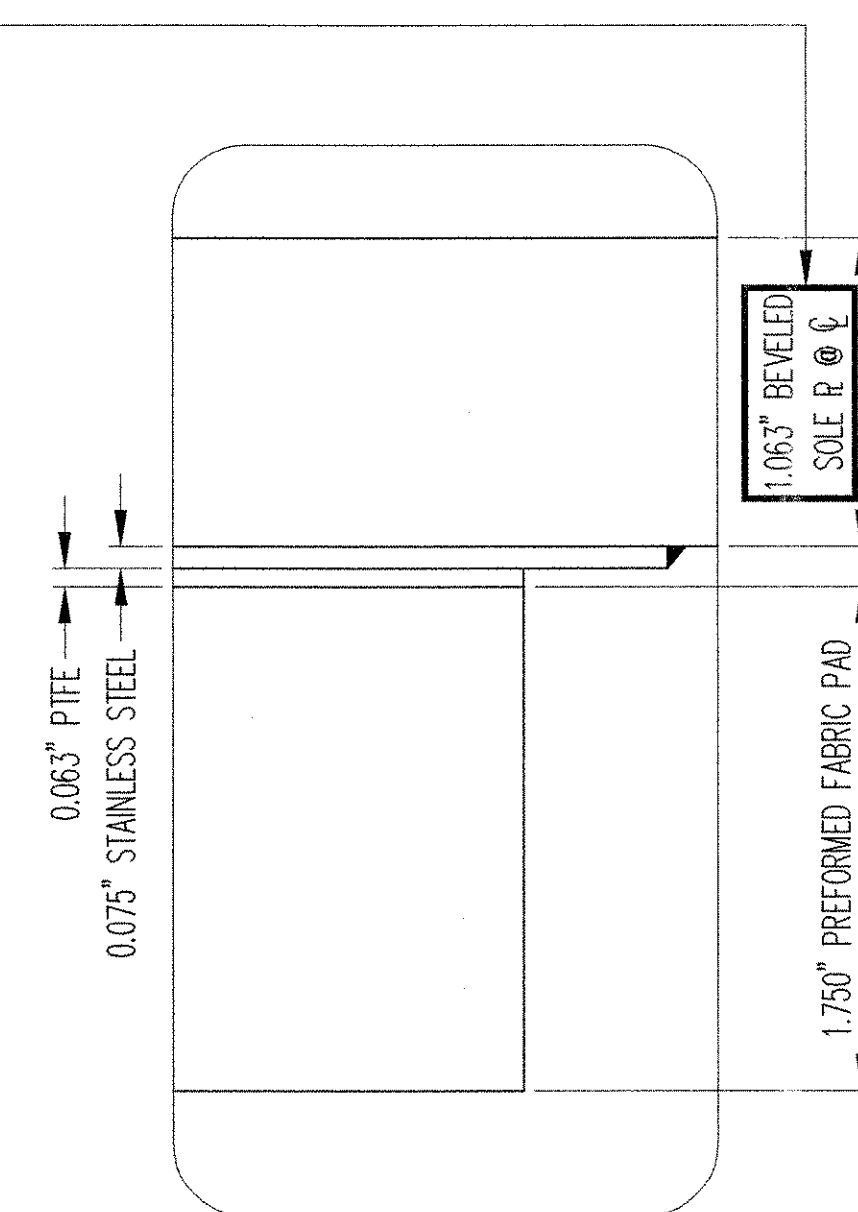

DETAIL 'A'

MK	QTY.	DESCRIPTION	MATERIAL	LENGTH	REMARKS	PART NO.
2A	5	SLIDING PREFORMED FABRIC BEARING				
2a1	5	1.750" X 16.000"	AASHTO 18.4.10.1	9.000"	EPOXY BOND TO SOLE PLATE	
2a2	5	0.063" X 16.000"	PTFE	9.000"	PURE VIRGIN UNFILLED	
2a3	5	14 GA. X 17.000"	A240.304.#8	12.875"	CLIP CORNER; PLAIN	
2sp1	5	1.125" X 25.000"	A709 GR 36	13.000"	BEVEL, CLIP CORNER; METALIZE	
2B	10	SWEDGE ROD				
2b1	10	1.500"Ø X 21.000"	A449		4.000" THREADS, 14.000" SWEDGE; A153-HDG	
2C	10	HEAVY HEX NUT				
2c1	10	1.500"Ø	A563-DH/A194-2H		A153-HDG	
2D	10	WASHER PLATE				
2d1	10	0.375" X 3.000"	A36	6.000"	1.875" DIAMETER HOLE @ CENTER OF PLATE; A153-HDG	

NOTE: ALL MATERIAL SPECIFICATION DESCRIPTIONS ARE ASTM, UNLESS OTHERWISE NOTED.

LOAD TABLE

LOAD DATA	KIPS
DL + SDL	57
LL + I	73
TOTAL	130


RECEIVED
OK'D BY _____ OK'D BY _____
JAN 05 2004
RESUBMIT _____ APPROVED _____
BY *RRW* DATE *1-8-04*

SEE SHT. GN1 FOR GENERAL NOTES & COATING LIMITS.


D.S. BROWN
300 E. CHERRY STREET
NORTH BALTIMORE, OHIO 45872
419.257.3561
FAX: 419.257.0332
4201 NOREX DRIVE
CHASKA, MINNESOTA 55318
952.368.3000
FAX: 952.448.7000
DSBROWN.COM



REV.	DESCRIPTION	DATE	DET.	CKD.	
	LOCATION — BOSTWICK ROAD OVER VERMONT RAILWAY		ITEM	QUANTITY	
	BRIDGE — 15		10251-1106-2	5 OF 5	
	PROJECT — BRO 1445(30)				
	HIGHWAY — TH3				
	P.O. NO. — 7890				
	DESIGNER — McFARLAND-JOHNSON, INC.				
	CUSTOMER — S.D. IRELAND CONSTRUCTION				
DESCRIPTION: SLIDING PREFORMED FABRIC BEARING CHITTENDEN CO., VERMONT		SCALE: N.T.S.	DRAWN BY: D.ANDERSON	CHECKED BY: R. SCHADE	DATE: 12/23/03
		PROJECT NUMBER: 10251	PRODUCT CODE: 1106	RELEASE: 1	SHEET: 02

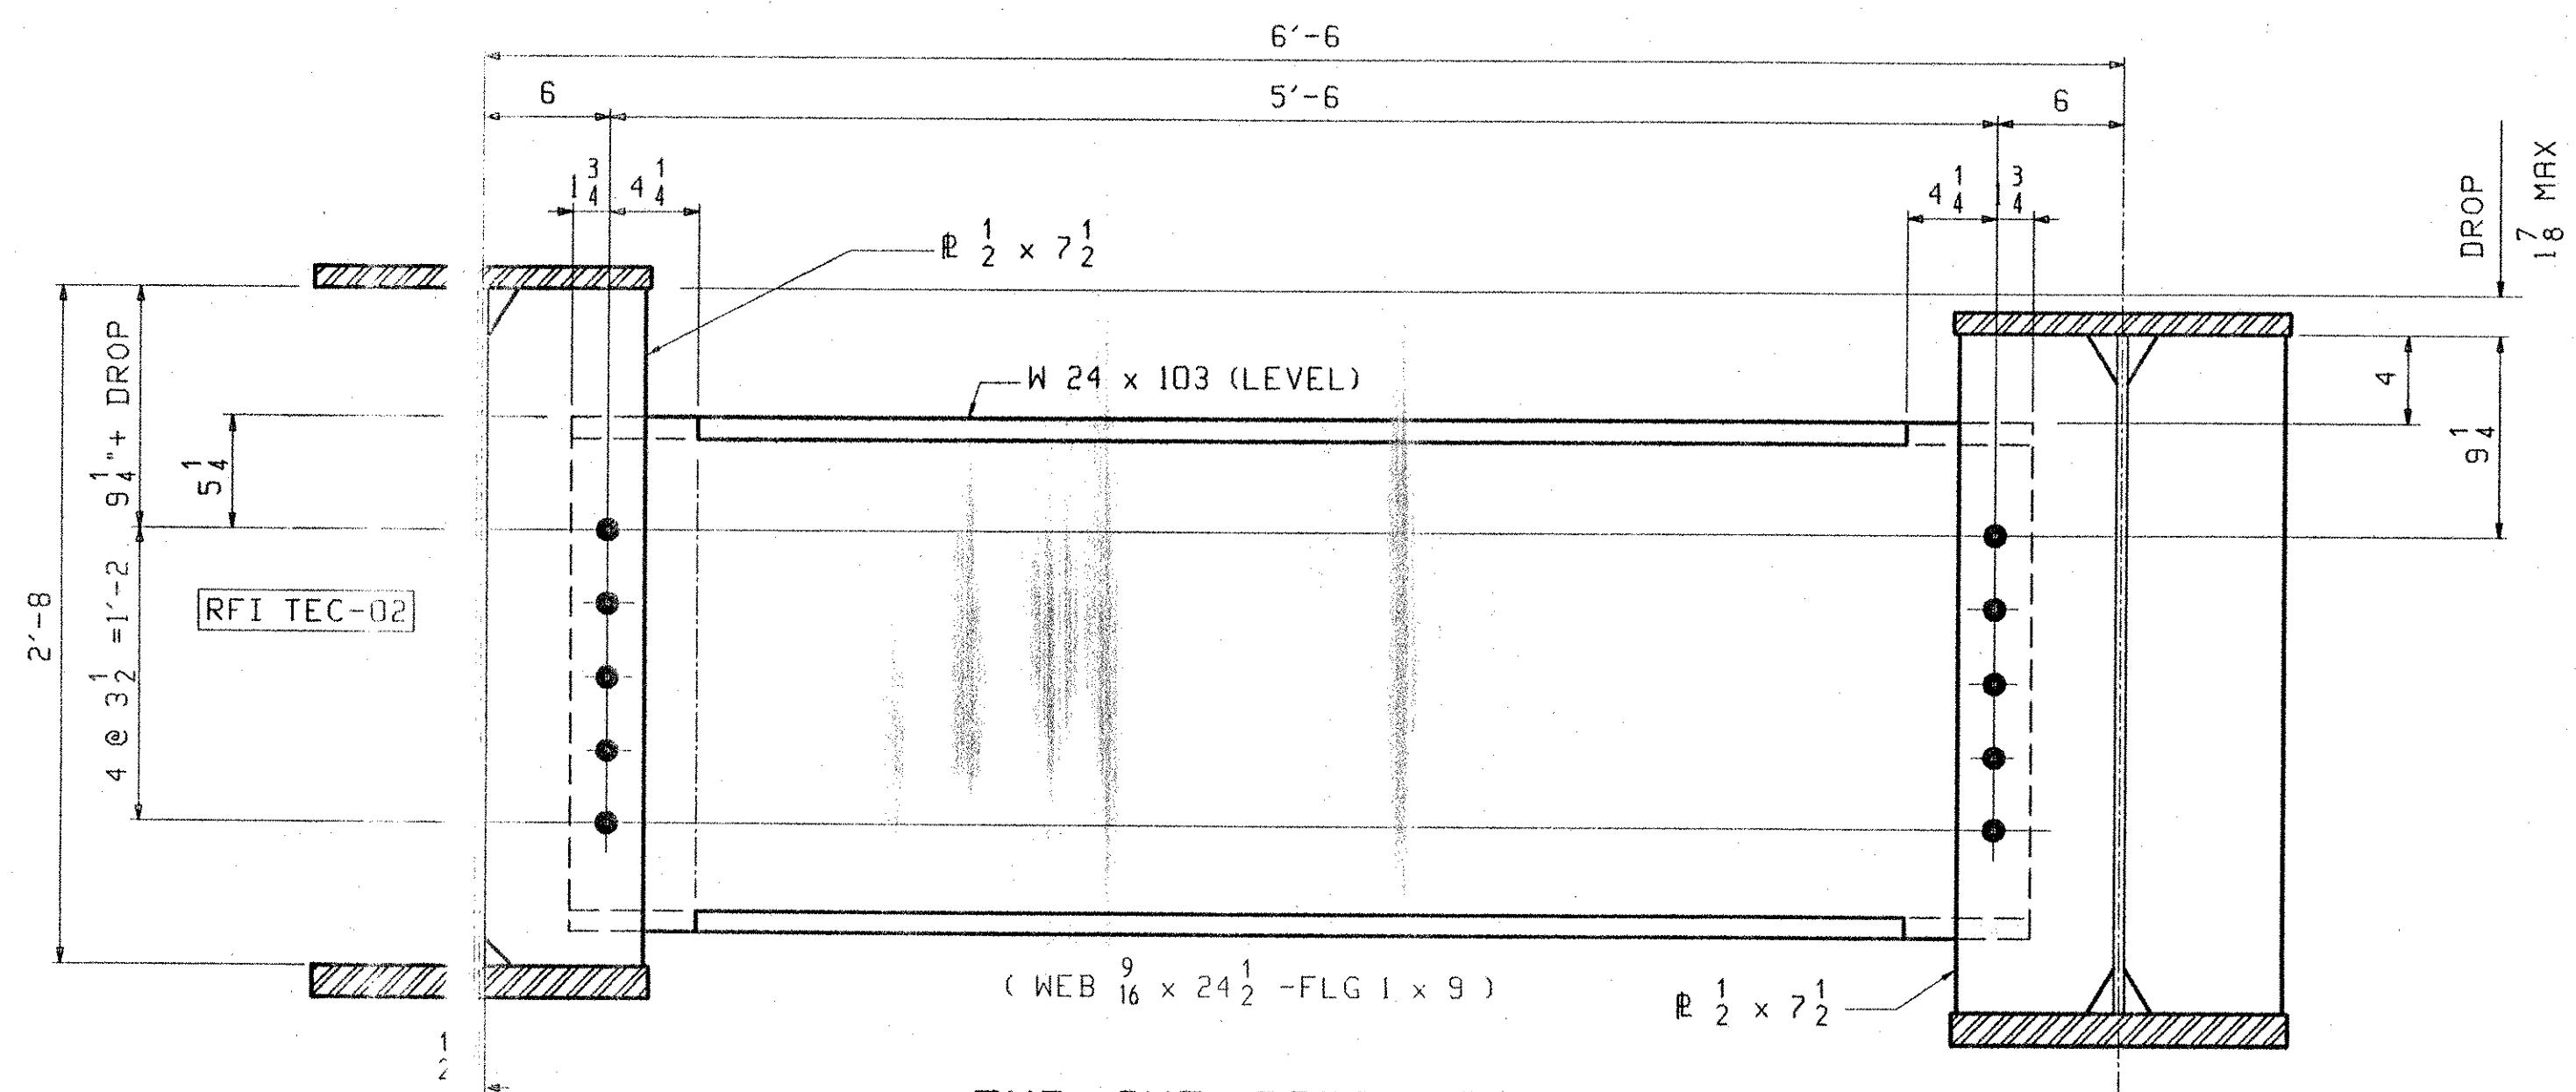

TYP. INT. DIAPHRAGM
LOOKING WEST (BK STATION)

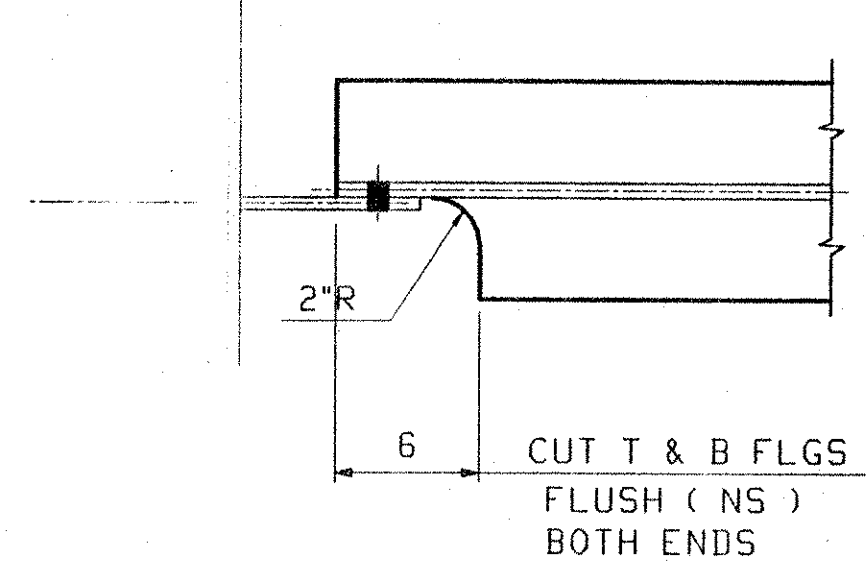


**** NOTE ****
THE PURPOSE OF THIS DRAWING IS TO COORDINATE GEOMETRIC CONTROL INFORMATION AND CONNECTION SPACING. THIS DWG IS SUBMITTED FOR INFORMATION ONLY & IS NOT INTENDED FOR SHOP FABRICATION. DETAIL DWGS WILL SHOW ALL WELDING AND DIMENSIONS REQ'D FOR FABRICATION.

MATL A709-50W
HOLES ... 15
BOLTS.... 7 8 Ø A325-3


RECEIVED
CHK'D BY _____ OK'D BY _____
DEC 03 2003
RESUBMIT _____ APPROVED _____
BY *RKw* DATE *1-8-04*

OUT FOR APPROVAL	12/1/03																				
OUT FOR APPROVAL																					
ISSUED TO SHOP																					
FIELD & OFFICE																					
REV.	REMARKS	DATE	DWN	CHK	APP	Q.A.	NO.	DIA.	LGT	TYPE	WASHER										
MATERIAL:		ELECTRODES:		HOLES:		SHOP BOLTS:															
SURFACE PREP. & PAINT:																					
DESCRIPTION:											LAYOUTS					DRAWN BY	DATE				
JOB: BOSTWICK ROAD OVER VERMONT RAILWAY											HIGHWAY NO. TH 3					WJG	11/03				
BRIDGE NO. 15											TOWN OF SHELBURNE					CHKD BY					
ENGR: McFarland-Johnson, INC.											CONTRACTOR: S.D. IRELAND BROS. CORP.					JTB	11/14				
SUPERVISOR W. J. GATTI																APPROV BY					
PROJ NO. BRO 1445(30)																Q.A.					
CUSTOMER: VERMONT AGENCY OF TRANSPORTATION																					
CASCO BAY STEEL STRUCTURES, INC.																JOB NO.	DRG. NO.				
75 SPRING HILL ROAD											SACO, MAINE 04072					209	T01				
PHONE (207) 282-7360											FAX. (207) 282-1179					REV.	△				

P:\New 2\1024-00 031 0003 -PARTY\2004\2004\T01 - Rev0

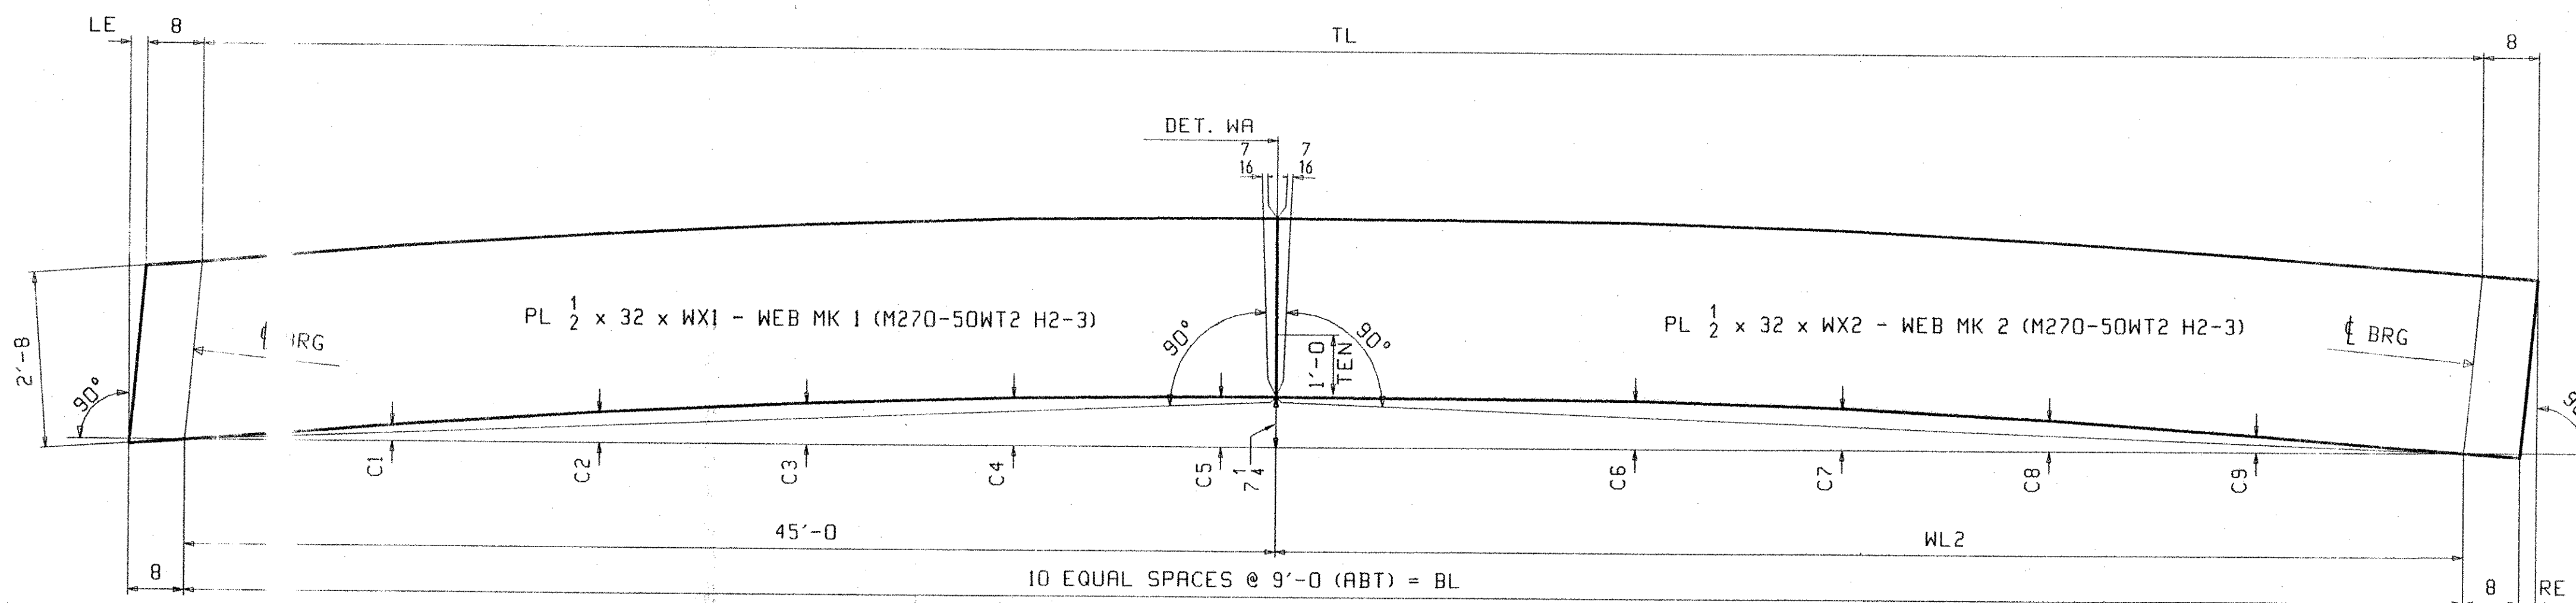

MARK	TL	BL	LE	RE	WL2	WX1	WX2	C1	C2	C3	C4	C5	C6	C7	C8	C9	WEB MK 1	PG/LINE	WEB MK 2	PG/LINE
1G1	90'-0 ¹¹ / ₁₆	89'-11 ³ / ₄	3 ³ / ₁₆	1 ¹ / ₈	44'-11 ³ / ₄	5'-8 ¹ / ₂	45'-8 ¹⁵ / ₁₆	2 ³ / ₈	4 ⁷ / ₁₆	5 ¹⁵ / ₁₆	6 ⁷ / ₈	7 ¹ / ₄	6 ¹⁵ / ₁₆	6	4 ⁷ / ₁₆	2 ³ / ₈	wa	1/J	wb	1/J
2G2	90'-0 ¹¹ / ₁₆	89'-11 ¹³ / ₁₆	1 ¹ / ₄	1 ¹ / ₈	44'-11 ¹³ / ₁₆	5'-8 ¹ / ₂	45'-9	2 ³ / ₈	4 ⁷ / ₁₆	5 ¹⁵ / ₁₆	6 ⁷ / ₈	7 ¹ / ₄	6 ¹⁵ / ₁₆	6	4 ⁷ / ₁₆	2 ³ / ₈	wa	1/J	wb	1/J
3G3	90'-0 ³ / ₄	89'-11 ¹³ / ₁₆	1 ¹ / ₄	1 ³ / ₁₆	44'-11 ¹³ / ₁₆	5'-8 ¹ / ₂	45'-9 ¹ / ₁₆	2 ⁷ / ₁₆	4 ⁷ / ₁₆	5 ¹⁵ / ₁₆	6 ¹⁵ / ₁₆	7 ¹ / ₄	6 ¹⁵ / ₁₆	5 ¹⁵ / ₁₆	4 ⁷ / ₁₆	2 ³ / ₈	wa	1/J	wb	1/J
4G4	90'-0 ³ / ₄	89'-11 ⁷ / ₈	5 ⁵ / ₁₆	1 ³ / ₁₆	44'-11 ⁷ / ₈	5'-8 ¹ / ₂	45'-9 ¹ / ₈	2 ⁷ / ₁₆	4 ⁷ / ₁₆	6	6 ¹⁵ / ₁₆	7 ¹ / ₄	6 ⁷ / ₈	5 ¹⁵ / ₁₆	4 ³ / ₈	2 ³ / ₈	wa	1/J	wb	1/J
5G5	90'-0 ³ / ₄	89'-11 ⁷ / ₈	5 ⁵ / ₁₆	1 ³ / ₁₆	44'-11 ⁷ / ₈	45'-8 ¹ / ₂	45'-9 ¹ / ₈	2 ³ / ₈	4 ¹ / ₂	6	6 ¹⁵ / ₁₆	7 ¹ / ₄	6 ⁷ / ₈	5 ¹⁵ / ₁₆	4 ³ / ₈	2 ³ / ₈	wa	1/J	wb	1/J

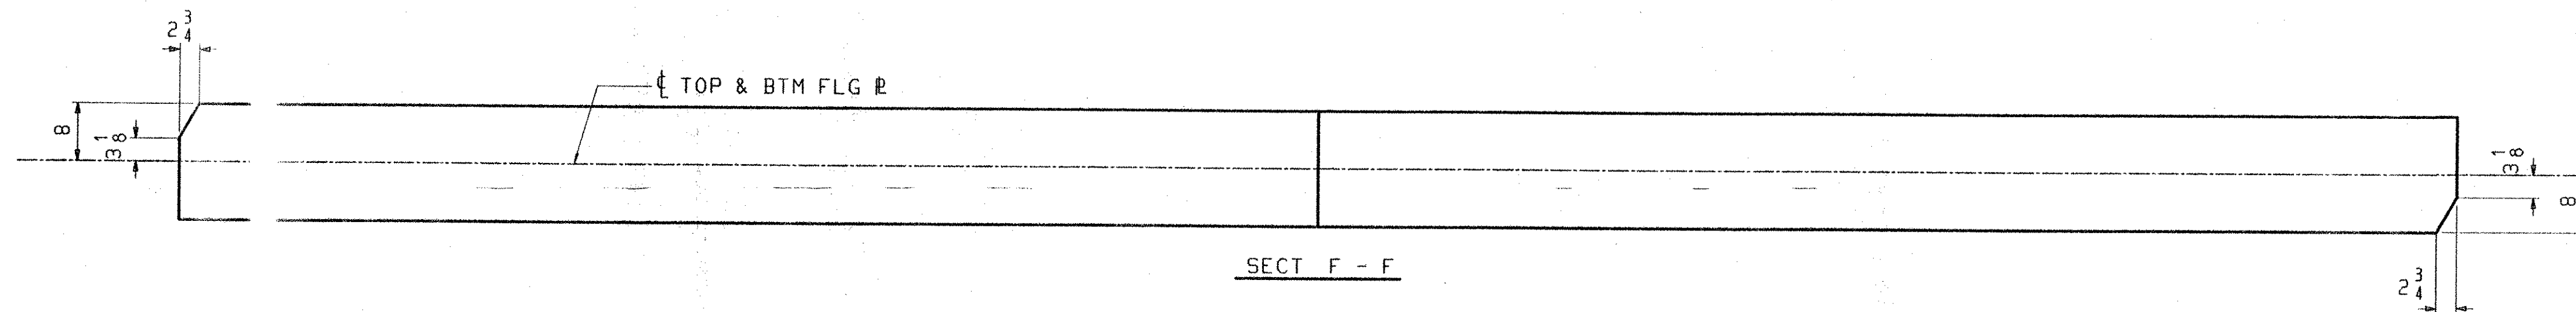

MARK	PL	SIZE	DESCRIPTION	PL	SIZE	DESCRIPTION
1G1	PL 7/8	x 16 x 41'-4 ¹¹ / ₁₆	- ta (A709-50W) 1/E	PL 7/8	x 16 x 50'-0	- tb (A709-50W) 1/E
2G2	PL 7/8	x 16 x 50'-0	- ta (A709-50W) 1/E	PL 7/8	x 16 x 41'-4 ¹¹ / ₁₆	- tb (A709-50W) 1/G
3G3	PL 7/8	x 16 x 50'-0	- ta (A709-50W) 1/E	PL 7/8	x 16 x 41'-4 ³ / ₄	- tb (A709-50W) 1/G
4G4	PL 7/8	x 16 x 50'-0	- ta (A709-50W) 1/E	PL 7/8	x 16 x 41'-4 ³ / ₄	- tb (A709-50W) 1/G
5G5	PL 7/8	x 16 x 50'-0	- ta (A709-50W) 1/E	PL 7/8	x 16 x 41'-4 ³ / ₄	- tb (A709-50W) 1/G


MARK	PL	SIZE	DESCRIPTION	PL	SIZE	DESCRIPTION
1G1	PL 7/8	x 16 x 41'-3 ³ / ₄	- ba (A709-50WT2 H2-3) 1/C	PL 7/8	x 16 x 50'-0	- bb (A709-50WT2 H2-3) 1/A
2G2	PL 7/8	x 16 x 41'-3 ¹³ / ₁₆	- ba (A709-50WT2 H2-3) 1/C	PL 7/8	x 16 x 50'-0	- bb (A709-50WT2 H2-3) 1/A
3G3	PL 7/8	x 16 x 41'-3 ¹³ / ₁₆	- ba (A709-50WT2 H2-3) 1/C	PL 7/8	x 16 x 50'-0	- bb (A709-50WT2 H2-3) 1/A
4G4	PL 7/8	x 16 x 41'-3 ⁷ / ₈	- ba (A709-50WT2 H2-3) 1/C	PL 7/8	x 16 x 50'-0	- bb (A709-50WT2 H2-3) 1/A
5G5	PL 7/8	x 16 x 50'-0	- ba (A709-50WT2 H2-3) 1/A	PL 7/8	x 16 x 41'-3 ⁷ / ₈	- bb (A709-50WT2 H2-3) 1/C

FLANGE DIAGRAM FOR 1G1 THRU 5G5




RECEIVED
 OK'D BY _____ OK'D BY _____
 DEC 09 2003
 RESUBMIT APPROVED
 BY RRe DATE 1-8-04

NOTES:
 1. FOR GENERAL NOTES AND WELD DETAILS SEE SHT. GNI.
 2. H2-3 DENOTES MATERIAL SUBJECT TO CHARPY V-NOTCH TEST AT H FREQ. FOR ZONE 2

OUT FOR APPROVAL	12-1-03																				
OUT FOR APPROVAL																					
ISSUED TO SHOP																					
FIELD & OFFICE																					
REV.	REMARKS	DATE	DWN	CHK	APP	Q.A.	NO.	DIA.	LGT	TYPE	WASHER										
MATERIAL:	ELECTRODES:	HOLES:									SHOP BOLTS:										
SURFACE PREP. & PAINT:																					
DESCRIPTION: CAMBER DIAGRAM																		DRAWN BY		DATE	
JOB: BOSTWICK ROAD OVER VERMONT RAILWAY																		WJG		11/03	
BRIDGE NO. 15 HIGHWAY NO. TH 3																		CHKD BY			
TOWN OF SHELBURNE																		JTB		11/14	
ENGR: McFarland-Johnson, INC.																		APPROV BY			
CONTRACTOR: S.D. IRELAND BROS. CORP.																		SUPERVISOR		M. J. GATTI	
PROJ NO. BRO 1445(3D)																		Q.A.			
CUSTOMER: VERMONT AGENCY OF TRANSPORTATION																					
CASCO BAY STEEL STRUCTURES, INC.																		JOB NO.		DRG. NO.	
75 SPRING HILL ROAD																		209		C1	
PHONE (207) 282-7360																		FAX. (207) 282-1179		REV. Δ	

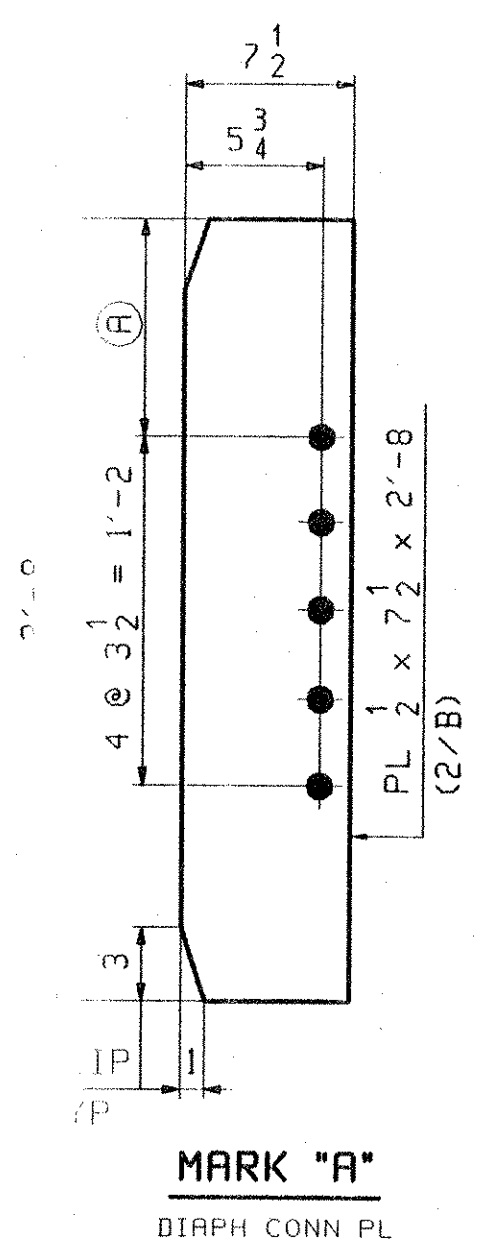

MARK	"A"	QTY	(A)
1a		18	9 1/4
1b		9	10 5/8
1c		9	11

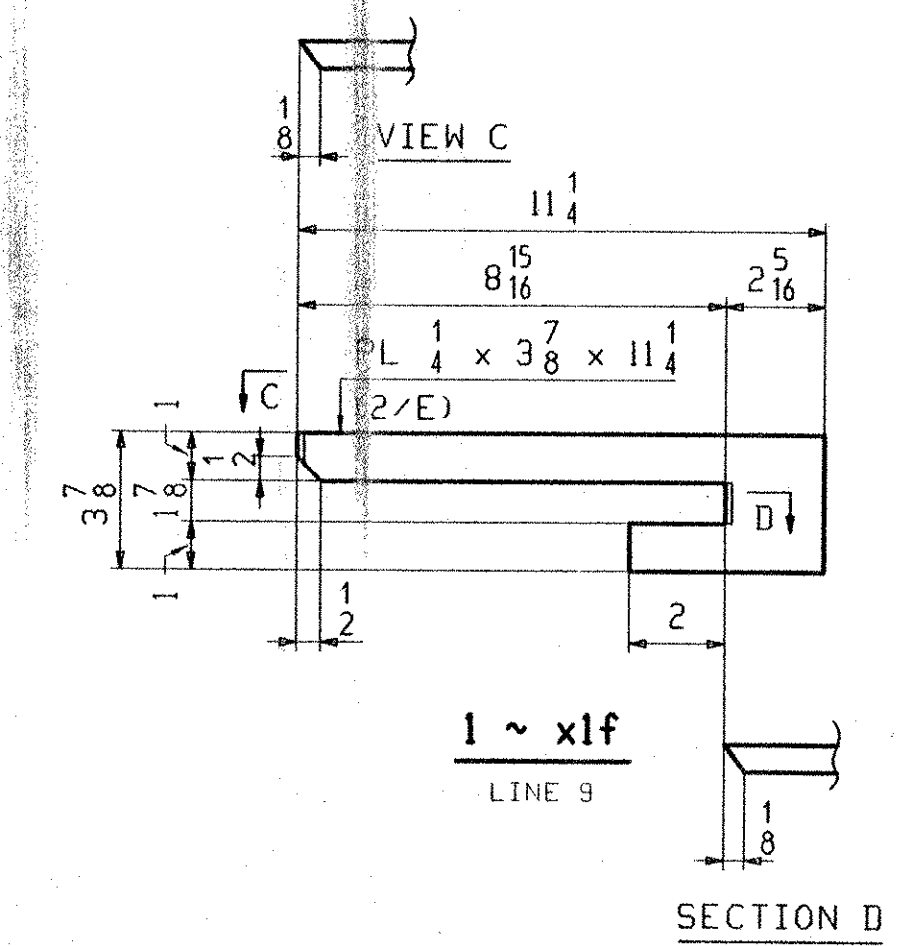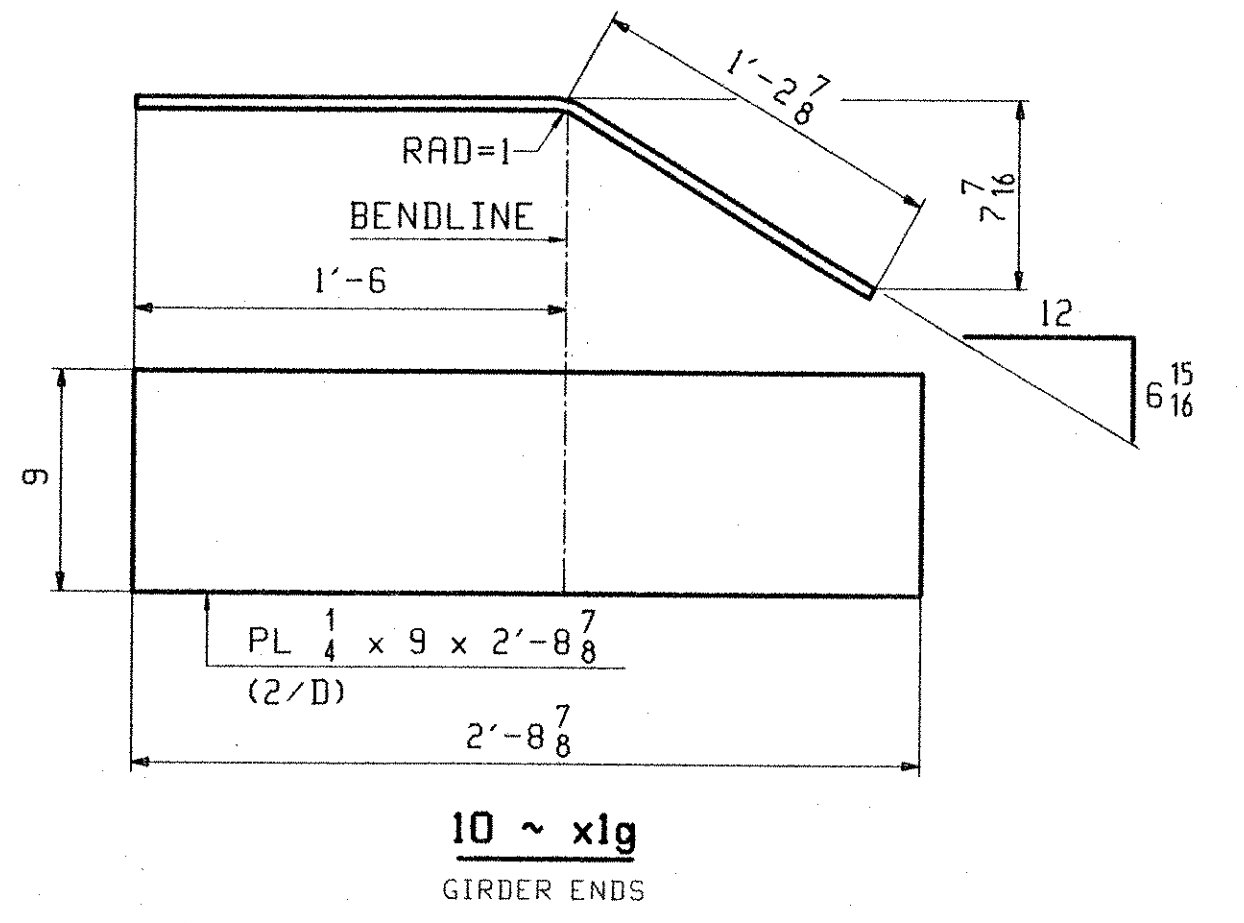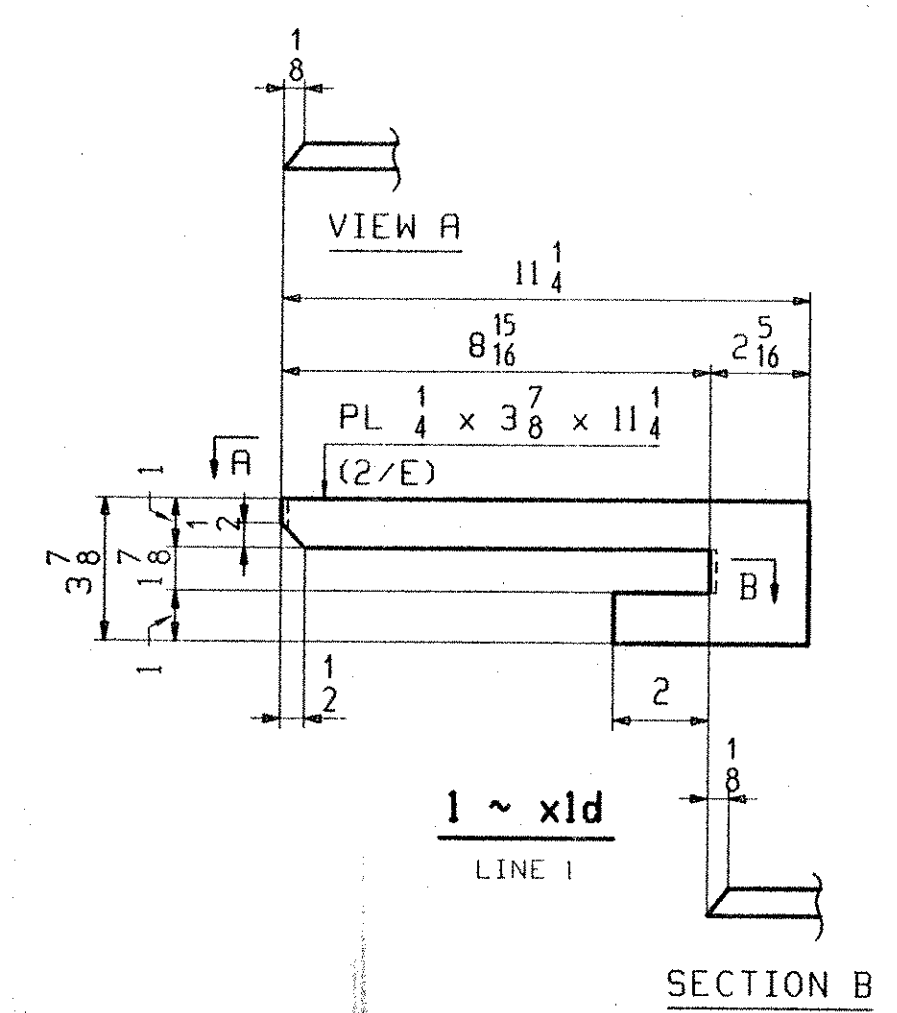

RECEIVED
 OK'D BY _____ OK'D BY _____
 DEC 09 2003
 RESUBMIT APPROVED
 BY RRW DATE 1-8-04

- NOTES:
 1. ALL MATERIAL TO BE A709-50W.
 2. FOR GENERAL NOTES SEE DRAWING GNI.
 3. ALL BOLT HOLES SHALL BE 15/16" Ø FOR 7/8" HSB.

OUT FOR APPROVAL	12-1-03									
ISSUED TO SHOP										
FIELD & OFFICE										


REV.	REMARKS	DATE	DWN	CHK	APP	Q.A.	NO.	DIA.	LGT	TYPE	WASHER
MATERIAL:	A709-50W										
ELECTRODES:											
HOLES:	15/16" Ø										
SHOP BOLTS:	NONE										

SURFACE PREP. & PAINT:
 NONE

DESCRIPTION:	GIRDER STANDARDS	DRAWN BY	JTB	DATE	11/14
JOB:	BOSTWICK ROAD OVER VERMONT RAILWAY BRIDGE NO. 15 HIGHWAY NO. TH 3	CHKD BY	FTM		
	TOWN OF SHELburne	APPROV BY			11/21/03
	ENGR: McFarland-Johnson, INC.	SUPERVISOR	W. J. GATTI		
	CONTRACTOR: S.D. IRELAND BROS. CORP.				




PROJ NO.	BRO 1445(30)	Q.A.	
CUSTOMER:	VERMONT AGENCY OF TRANSPORTATION		
CASCO BAY STEEL STRUCTURES, INC.	JOB NO.	DRG. NO.	
75 SPRING HILL ROAD	209	X1	
SACO, MAINE 04072			
PHONE (207) 282-7360	FAX (207) 282-1179	REV.	△

SEE CAMBER DIAGRAM

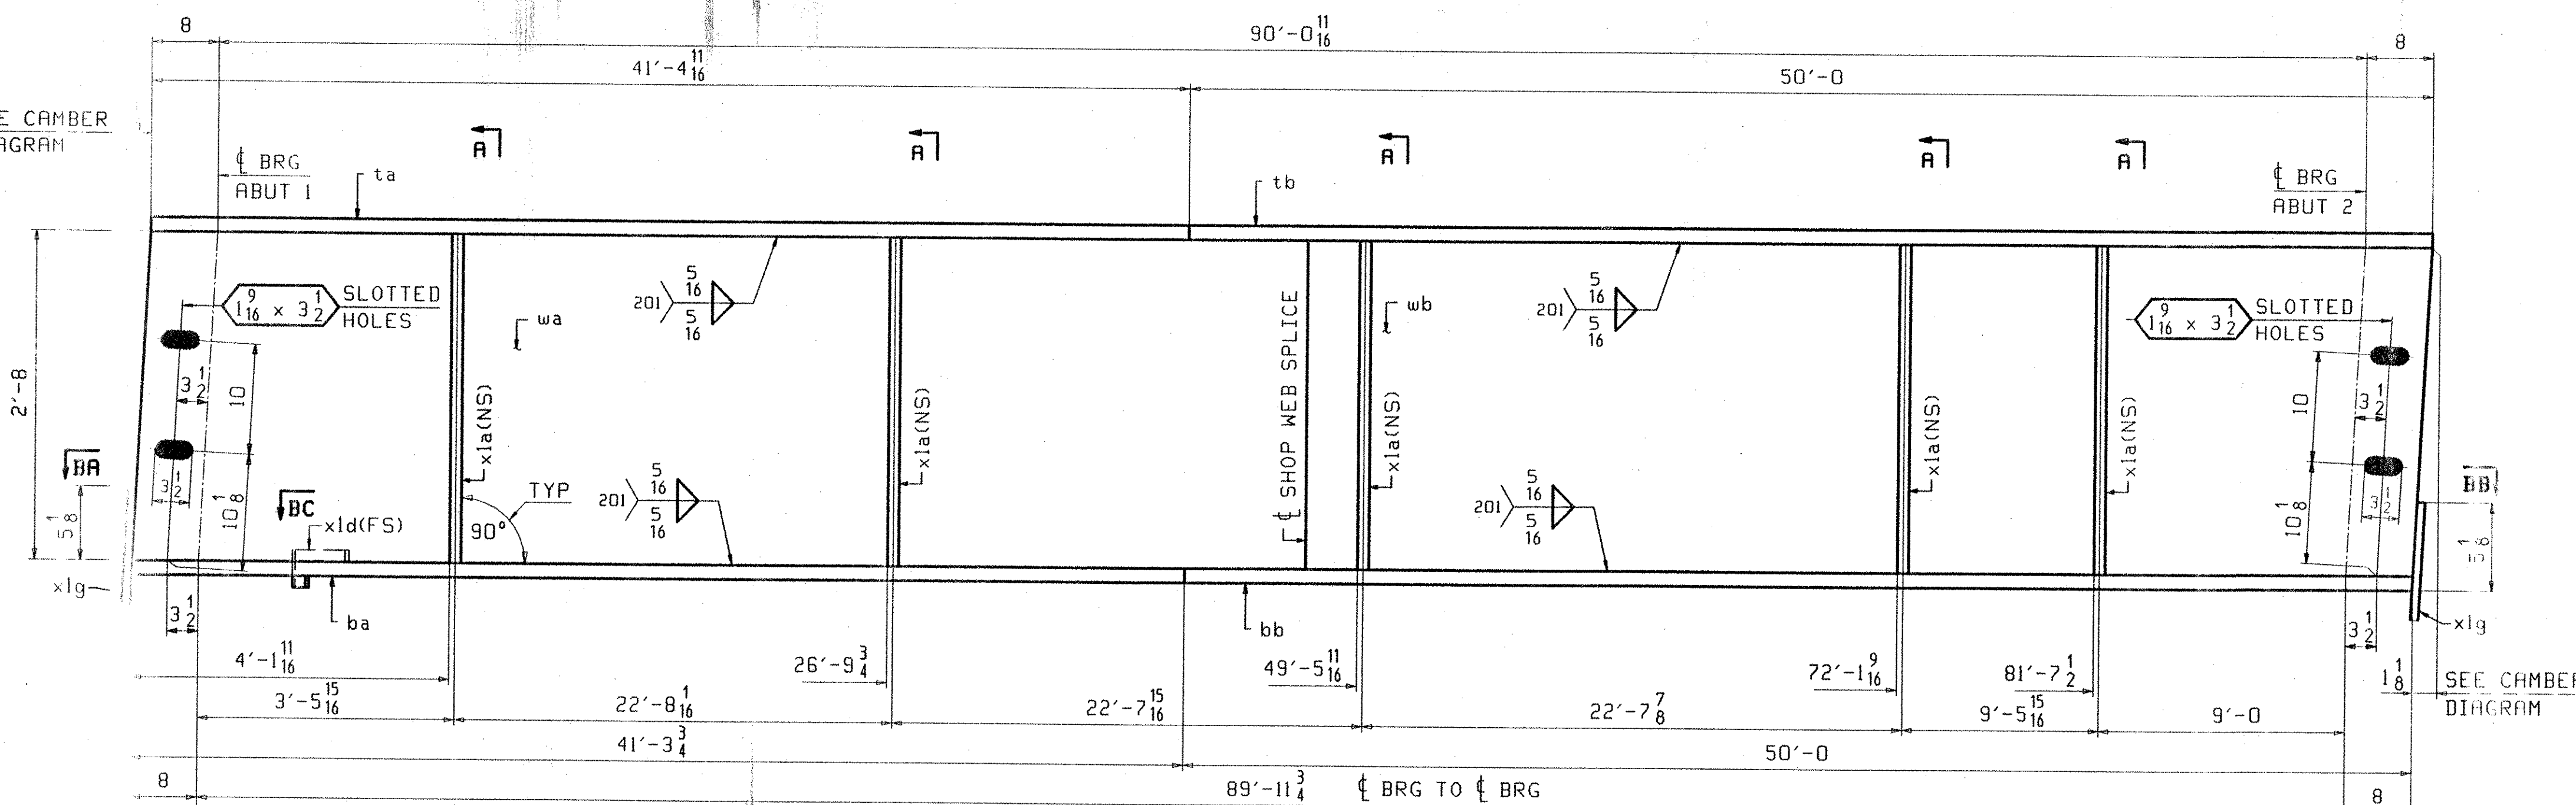

ONE - GIRDER - 1G1

FOR GIRDER STANDARD DETAILS SEE DRAWING X1.
 FOR CAMBER DIAGRAM SEE DRAWING C1.
 FOR GENERAL NOTES SEE DRAWING GNI.
 H2-3 DENOTES MATERIAL SUBJECT TO CHARPY V-NOTCH TESTING.

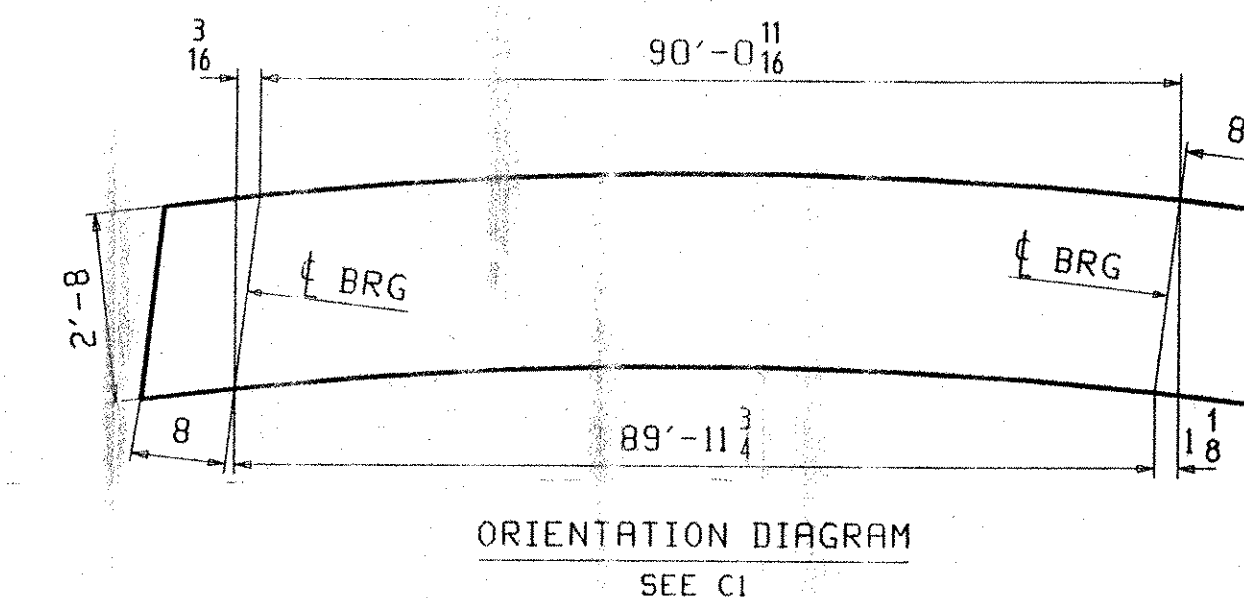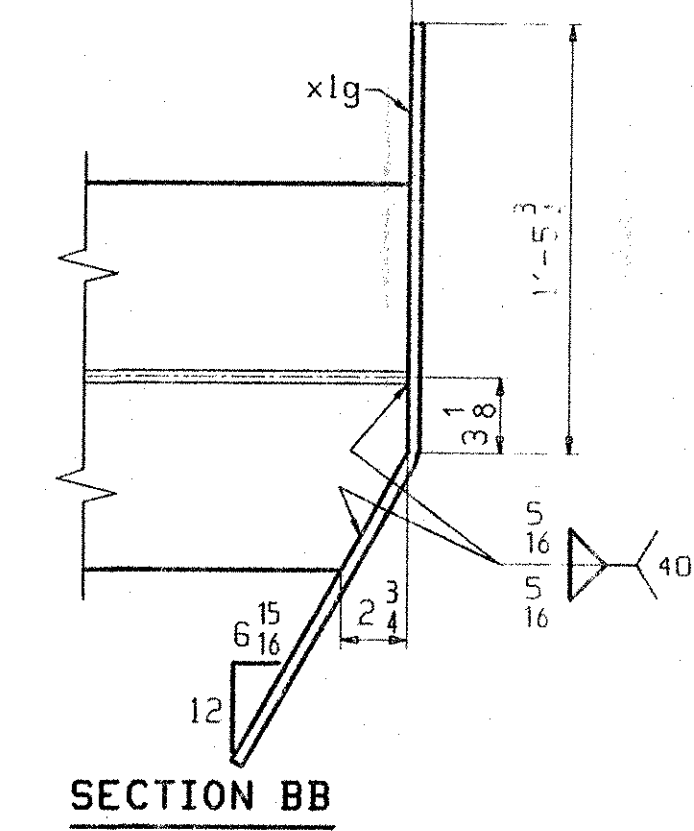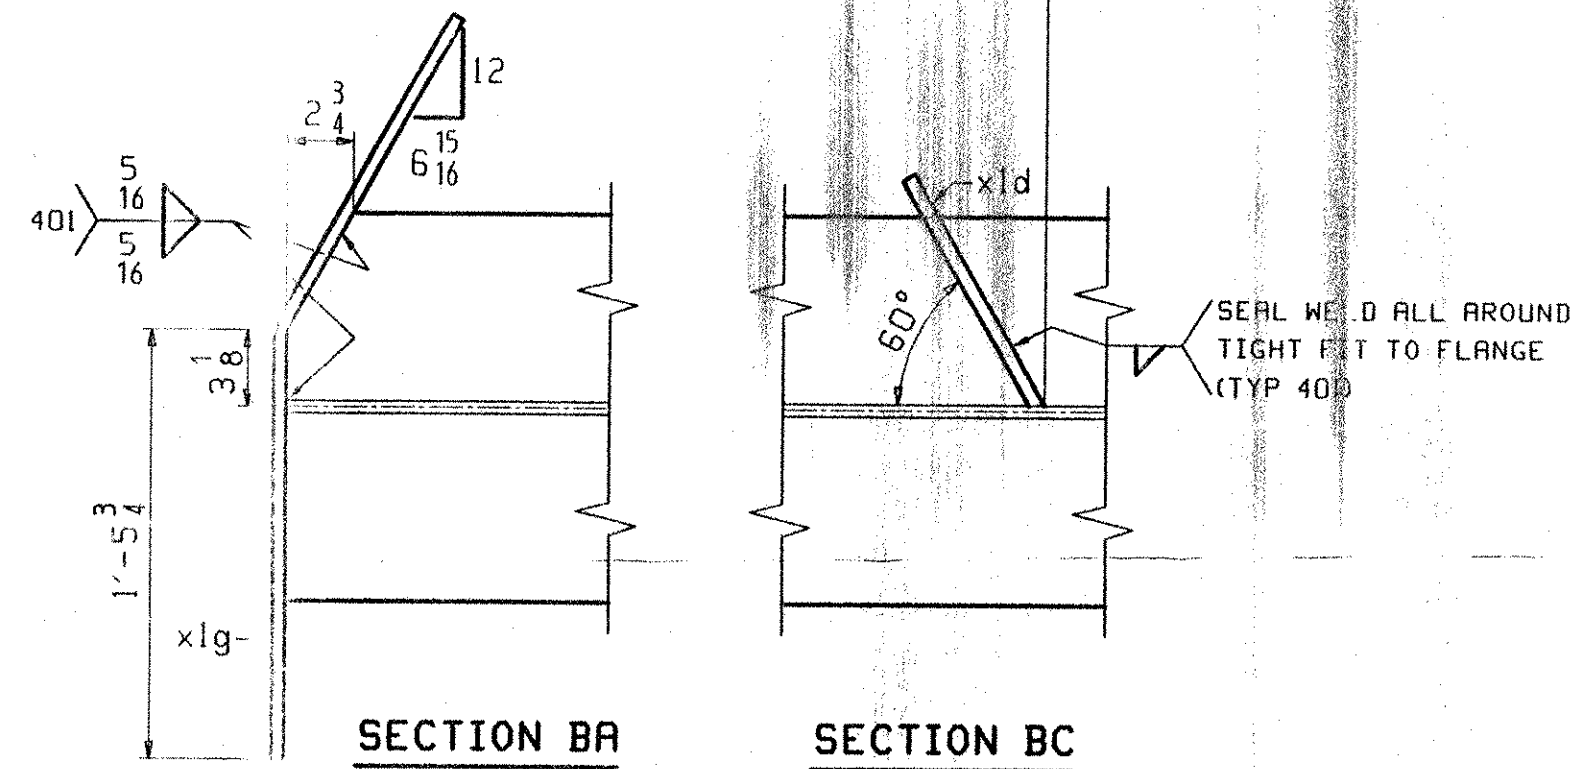


ABM INFO		SHIP	BILL OF MATERIAL				JOB NO.	DRAWING NO.	REV.
PAGE	LINE	MARK	QTY	MARK	MATERIAL	LENGTH FT INCHES	REMARKS	WT	PROCUREMENT NOTES
		IG1	1		GIRDER			19122	
1	J		1	wb	PL 1/2 x 33 5/8	4' 8 1/2	(M220-50WT2) (H2-3)		
1	J		1	wb	PL 2 x 33 5/8	4' 8 1/2	(M220-50WT2) (H2-3)		
1	G		1	td	PL 7/8 x 16	4' 4 1/8			
1	E		1	td	PL 5/8 x 16	5' 0			
1	C		1	td	PL 7/8 x 16	4' 3 3/4	(A209-50WT2) (H2-3)		
1	A		1	td	PL 1 1/2 x 16	5' 0	(A209-50WT2) (H2-3)		
2	B		5	x1a	PL 1/2 x 7 1/2	2' 8			
2	E		1	x1a	PL 1/2 x 3 7/8	0' 11 1/4			
2	D		2	x1g	PL 1/4 x 9	2' 8 3/4	BENT		

OUT FOR APPROVAL	<i>K/ds</i>								
OUT FOR APPROVAL									
ISSUED TO SHOP									
FIELD & OFFICE									


REV.	REMARKS	DATE	DWN	CHK	APP	O.A.	NO.	DIA.	LGT	TYPE	WASHER
	MATERIAL:										
	A209-50W (UN)							1 5/16"		(UN)	NONE

SURFACE PREP. & PAINT:		NONE	
DESCRIPTION:	GIRDER - 1G1	DRAWN BY	DATE
JOB:	BOSTWICK ROAD OVER VERMONT RAILWAY BRIDGE NO. 15 HIGHWAY NO. TH 3	JTB	11/14
	TOWN OF SHELburnE	CHKD BY	
	ENGR: McFarland-Johnson, INC.	FTM	11/21/03
	CONTRACTOR: S.D. IRELAND BROS. CORP.	APPROV BY	
		SUPERVISOR	H. J. GATTI
PROJ NO.	BRO 1445(3D)	O.A.	
CUSTOMER:	VERMONT AGENCY OF TRANSPORTATION		
CASCO BAY STEEL STRUCTURES, INC.		JOB NO.	DRG. NO.
75 SPRING HILL ROAD		209	1
PHONE (207) 282-7360		FAX (207) 282-1179	REV. Δ

RECEIVED
 OK'D BY _____ OK'D BY _____
 DEC 03 2003
 RESUBMIT APPROVED *As Noted*
 by *RAW* DATE *1-8-04*

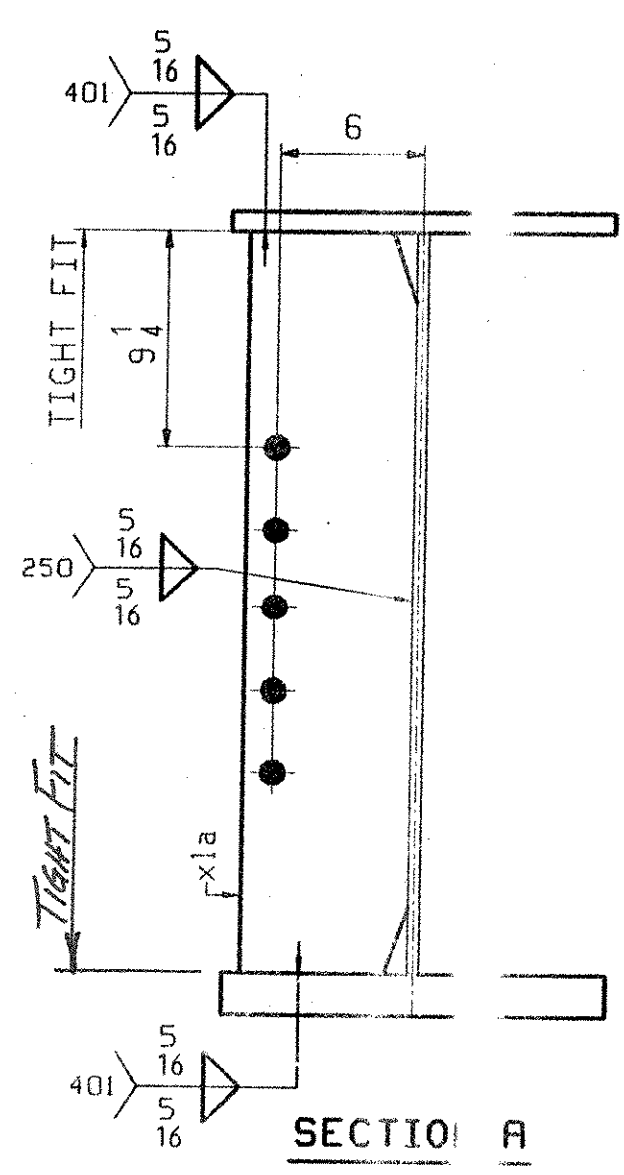


SEE CAMBER DIAGRAM

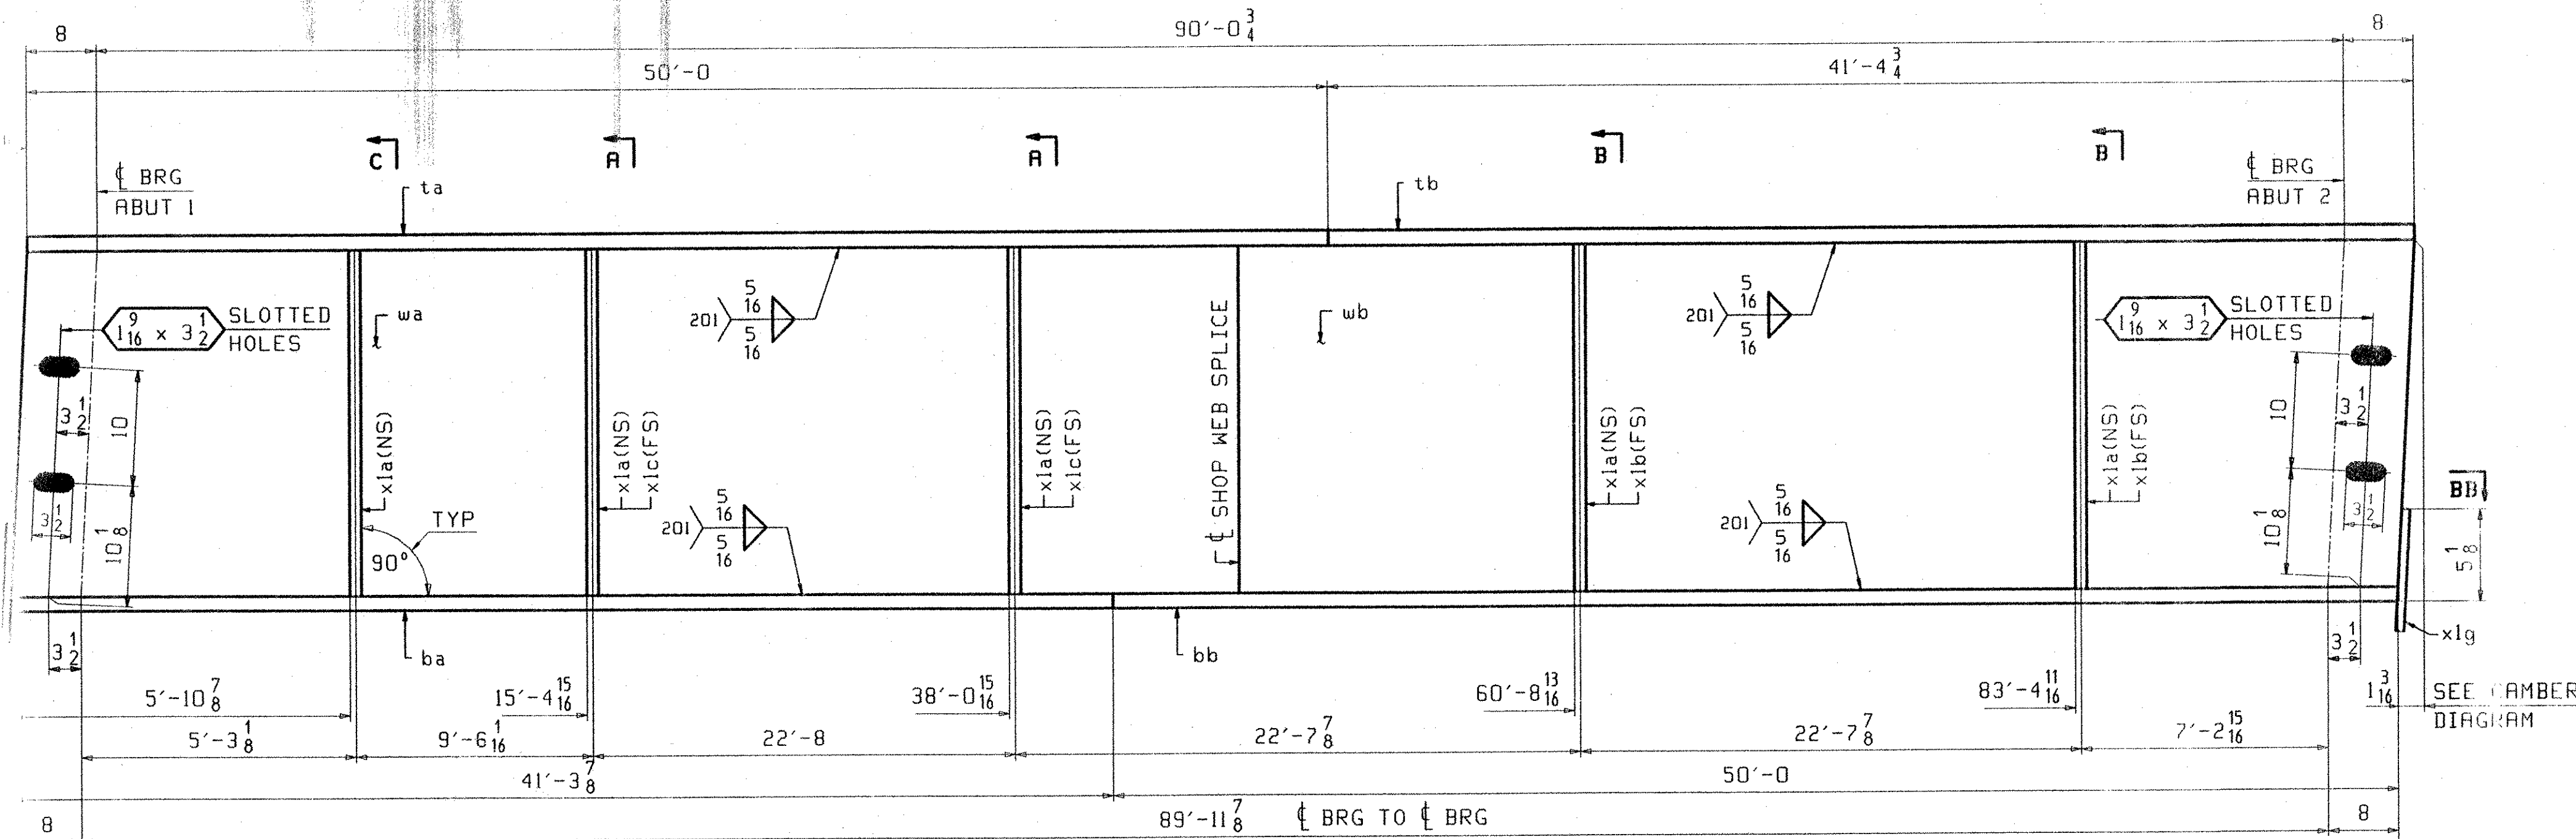


ONE - GIRDER - 4G4


FOR GIRDER STANDARD DETAILS SEE DRAWING XI.
 FOR CAMBER DIAGRAM SEE DRAWING CI.
 FOR GENERAL NOTES SEE DRAWING GNI.
 H2-3 DENOTES MATERIAL SUBJECT TO CHARPY V-NOTCH TESTING.

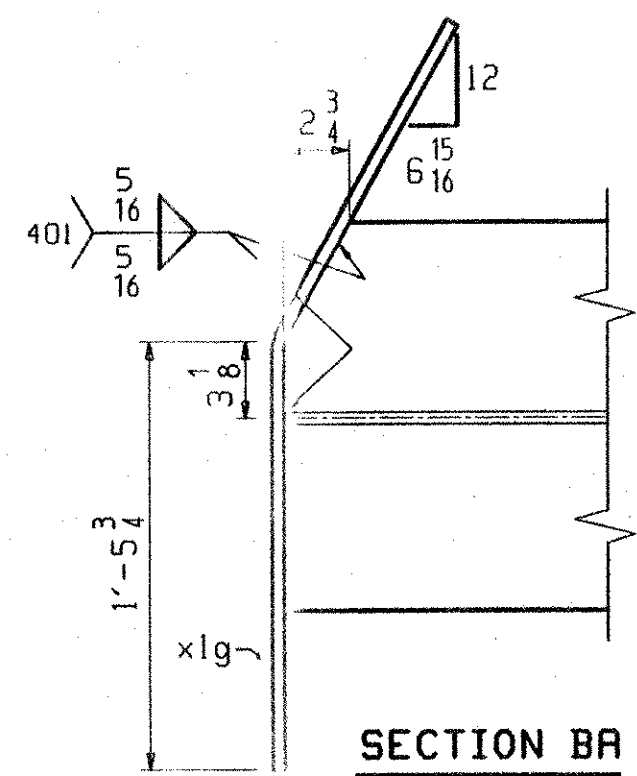


SECTION BA

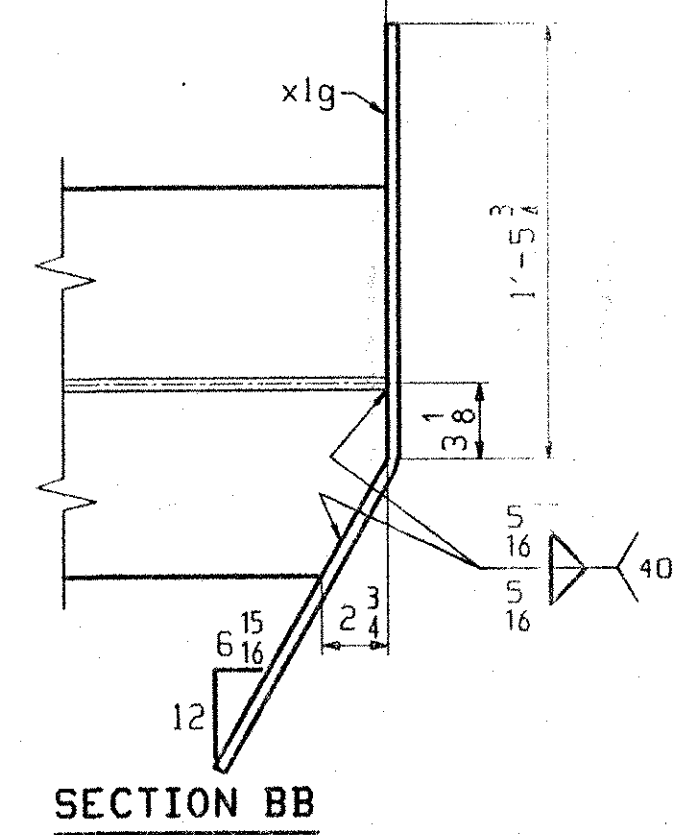

SECTION BB

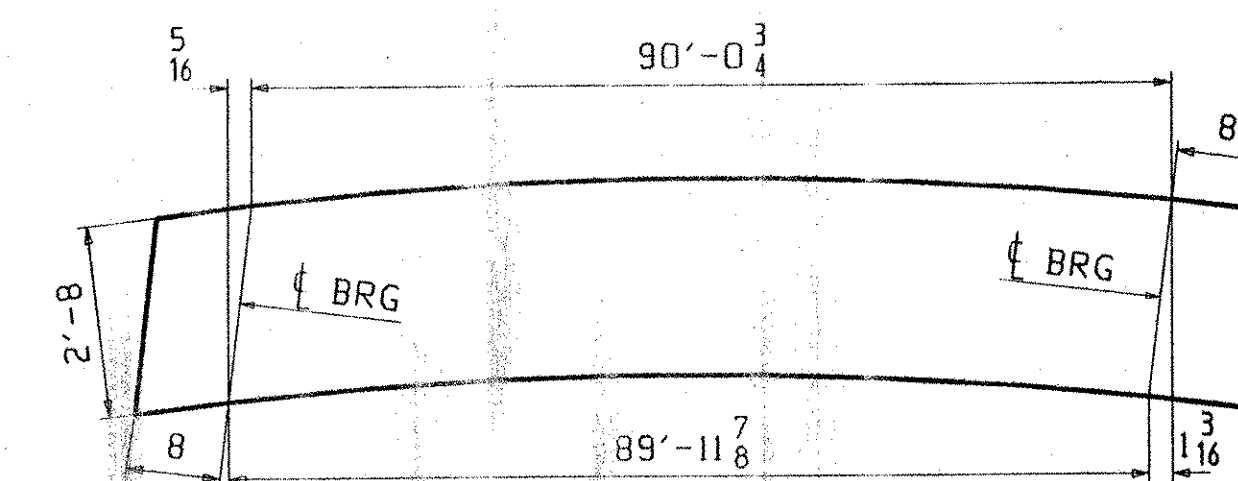

ORIENTATION DIAGRAM
SEE CI

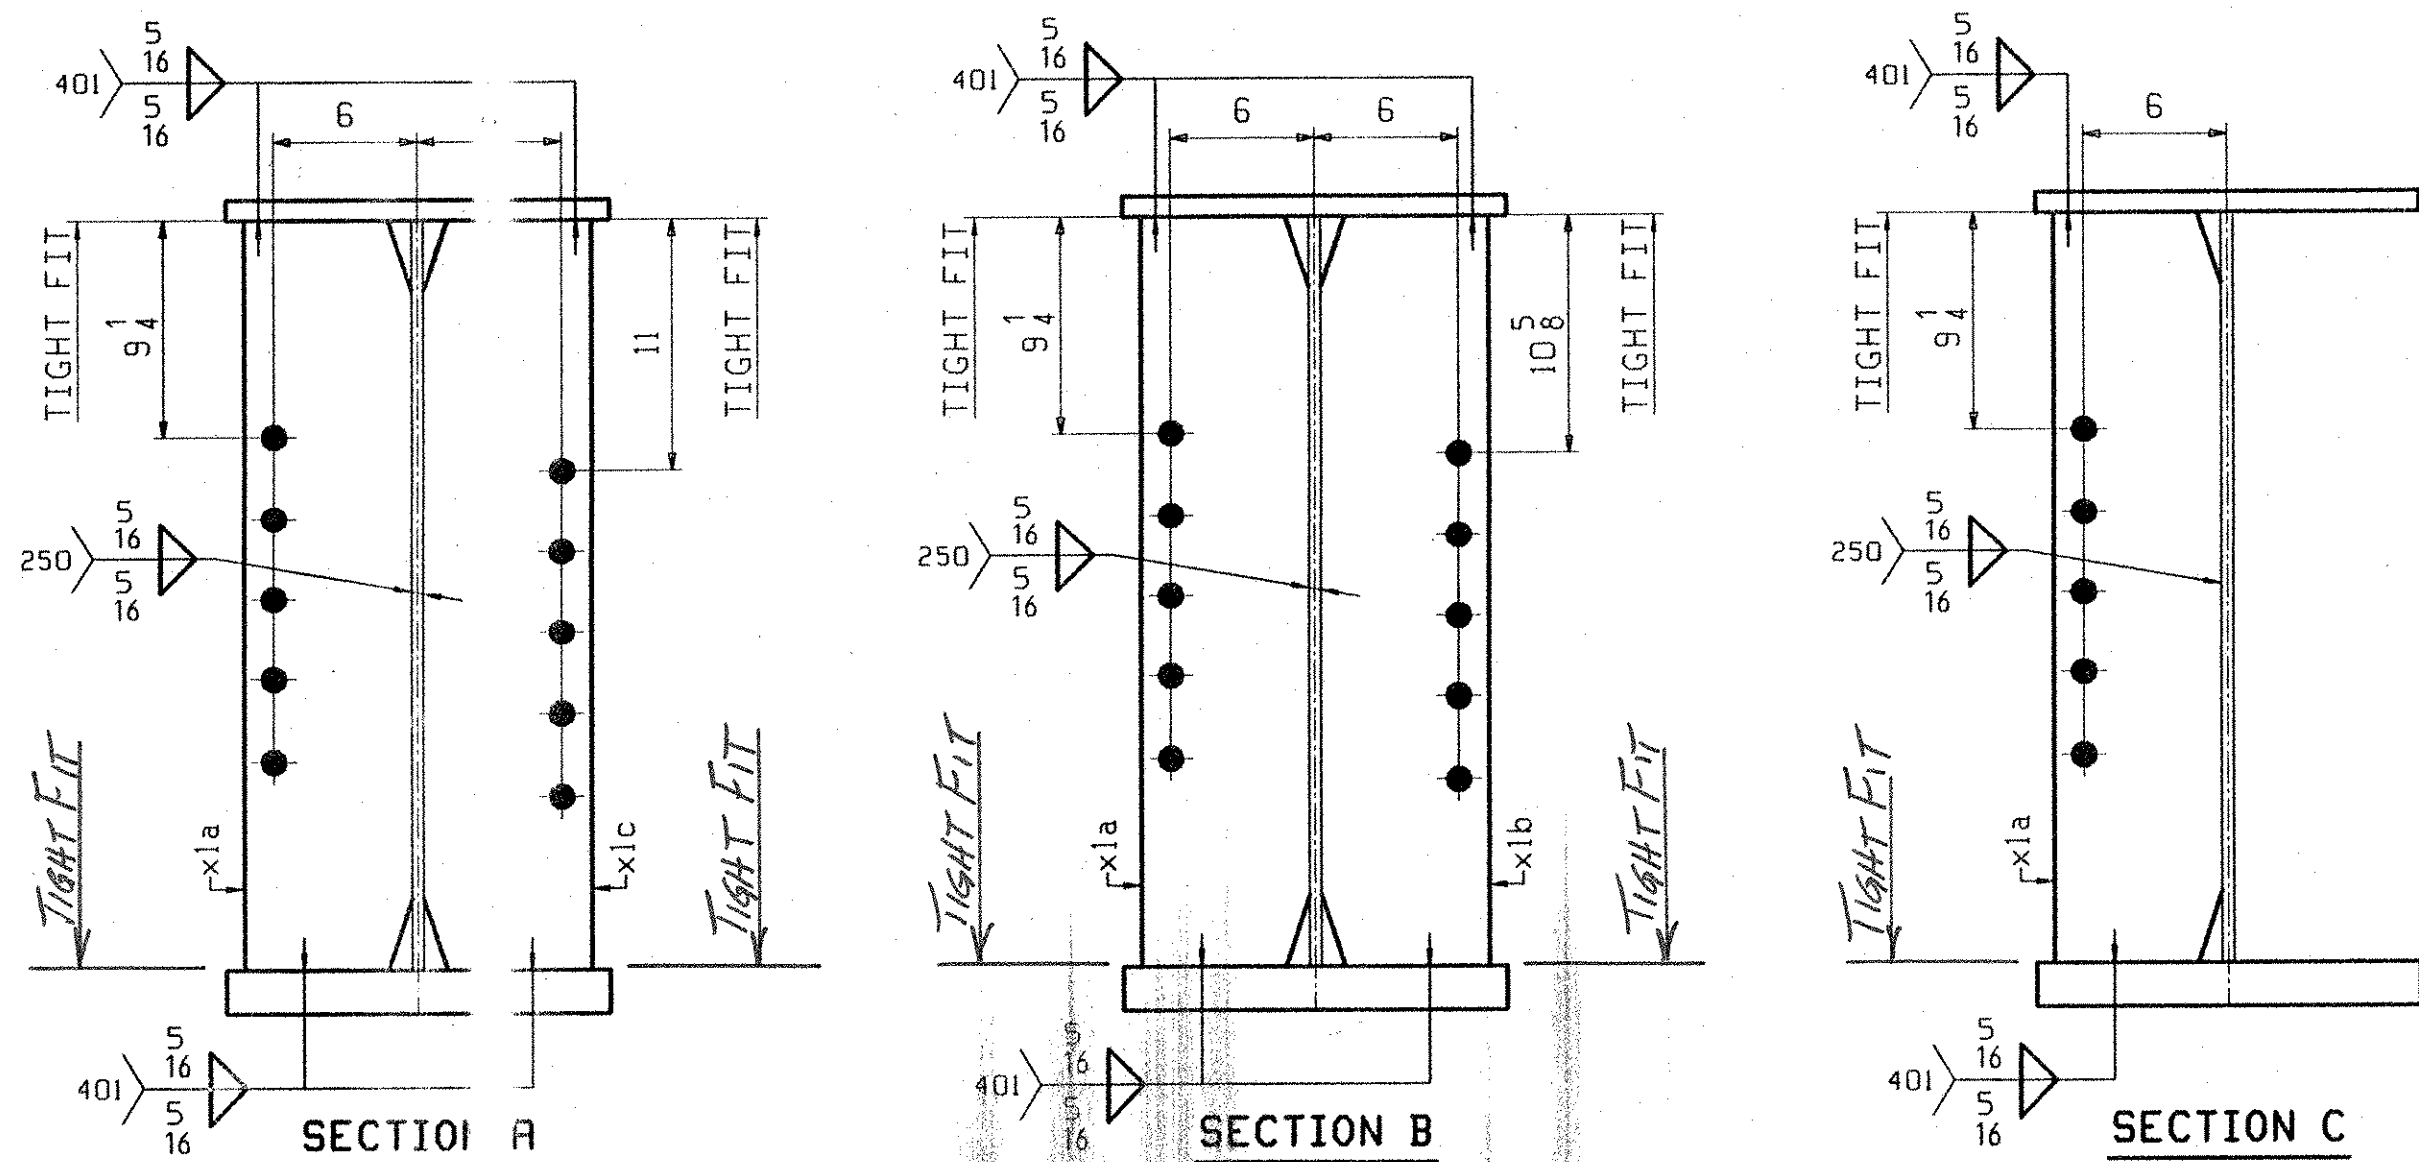

SECTION A

SECTION B

SECTION C


ABM INFO		SHP		BILL OF MATERIAL				JOB NO.		DRAWING NO.		REV.
PRG	LINE	MARK	QTY	UNIT	MATERIAL	LENGTH		REMARKS	WT	PROCURE	EN	
						FT	INCHES					
					GIRDER							4
		4G4	1						19248			
1	J		1	wa	PL 1/2 x 33 1/2	45	8 1/2	(M220-SOHT2) (H2-3)				
1	J		1	wb	PL 1/2 x 33 1/2	45	9 1/8	(M220-SOHT2) (H2-3)				
1	E		1	ta	PL 7/8 x 16	50	0					
1	G		1	tb	PL 7/8 x 16	41	4 1/2					
1	C		1	ba	PL 1 1/8 x 16	41	3 1/8	(A709-SOHT2) (H2-3)				
1	A		1	bb	PL 1 1/8 x 16	50	0	(A709-SOHT2) (H2-3)				
			5	xla	PL 1 1/2 x 7 1/2	2	8					
			2	xlc	PL 1 1/2 x 7 1/2	2	8					
			2	xlb	PL 1 1/2 x 7 1/2	2	8					
			2	xli	PL 1 1/2 x 9	2	8 7/8	BENT				

OUT FOR APPROVAL	12-1-03											
ISSUED TO SHOP												
FIELD & OFFICE												
REV.	REMARKS	DATE	DWN	CHK	APP	Q.A.	NO.	DIA.	LGT	TYPE	WASHER	
	MATERIAL: A709-50W (UN)										SHOP BOLTS: NONE	
	ELECTRODES:											
	HOLES: 15.16 Ø (UN)											
	SURFACE PREP. & PAINT: NONE											
DESCRIPTION: GIRDER - 4G4		DRAWN BY		DATE								
JOB: BOSTWICK ROAD OVER VERMONT RAILWAY		JT B		11/14								
BRIDGE NO. 15 HIGHWAY NO. TH 3		CHKD BY		FT M		11/21/03						
TOWN OF SHELBURNE		APPROV BY		W. J. GATTI								
ENGR: McFarland-Johnson, INC.		SUPERVISOR										
CONTRACTOR: S.D. IRELAND BROS. CORP.		Q.A.										
PROJ NO. BR 1445(30)												
CUSTOMER: VERMONT AGENCY OF TRANSPORTATION												
CASCO BAY STEEL STRUCTURES, INC.		JOB NO.		DRG. NO.								
75 SPRING HILL ROAD		209		4								
PHONE (207) 282-7360		SACO, MAINE 04072		REV.								
		FAX. (207) 282-1179										

RECEIVED





DEC 05 2003

APPROVED: *As Noted*
 BY: *RW* DATE: *1-8-04*

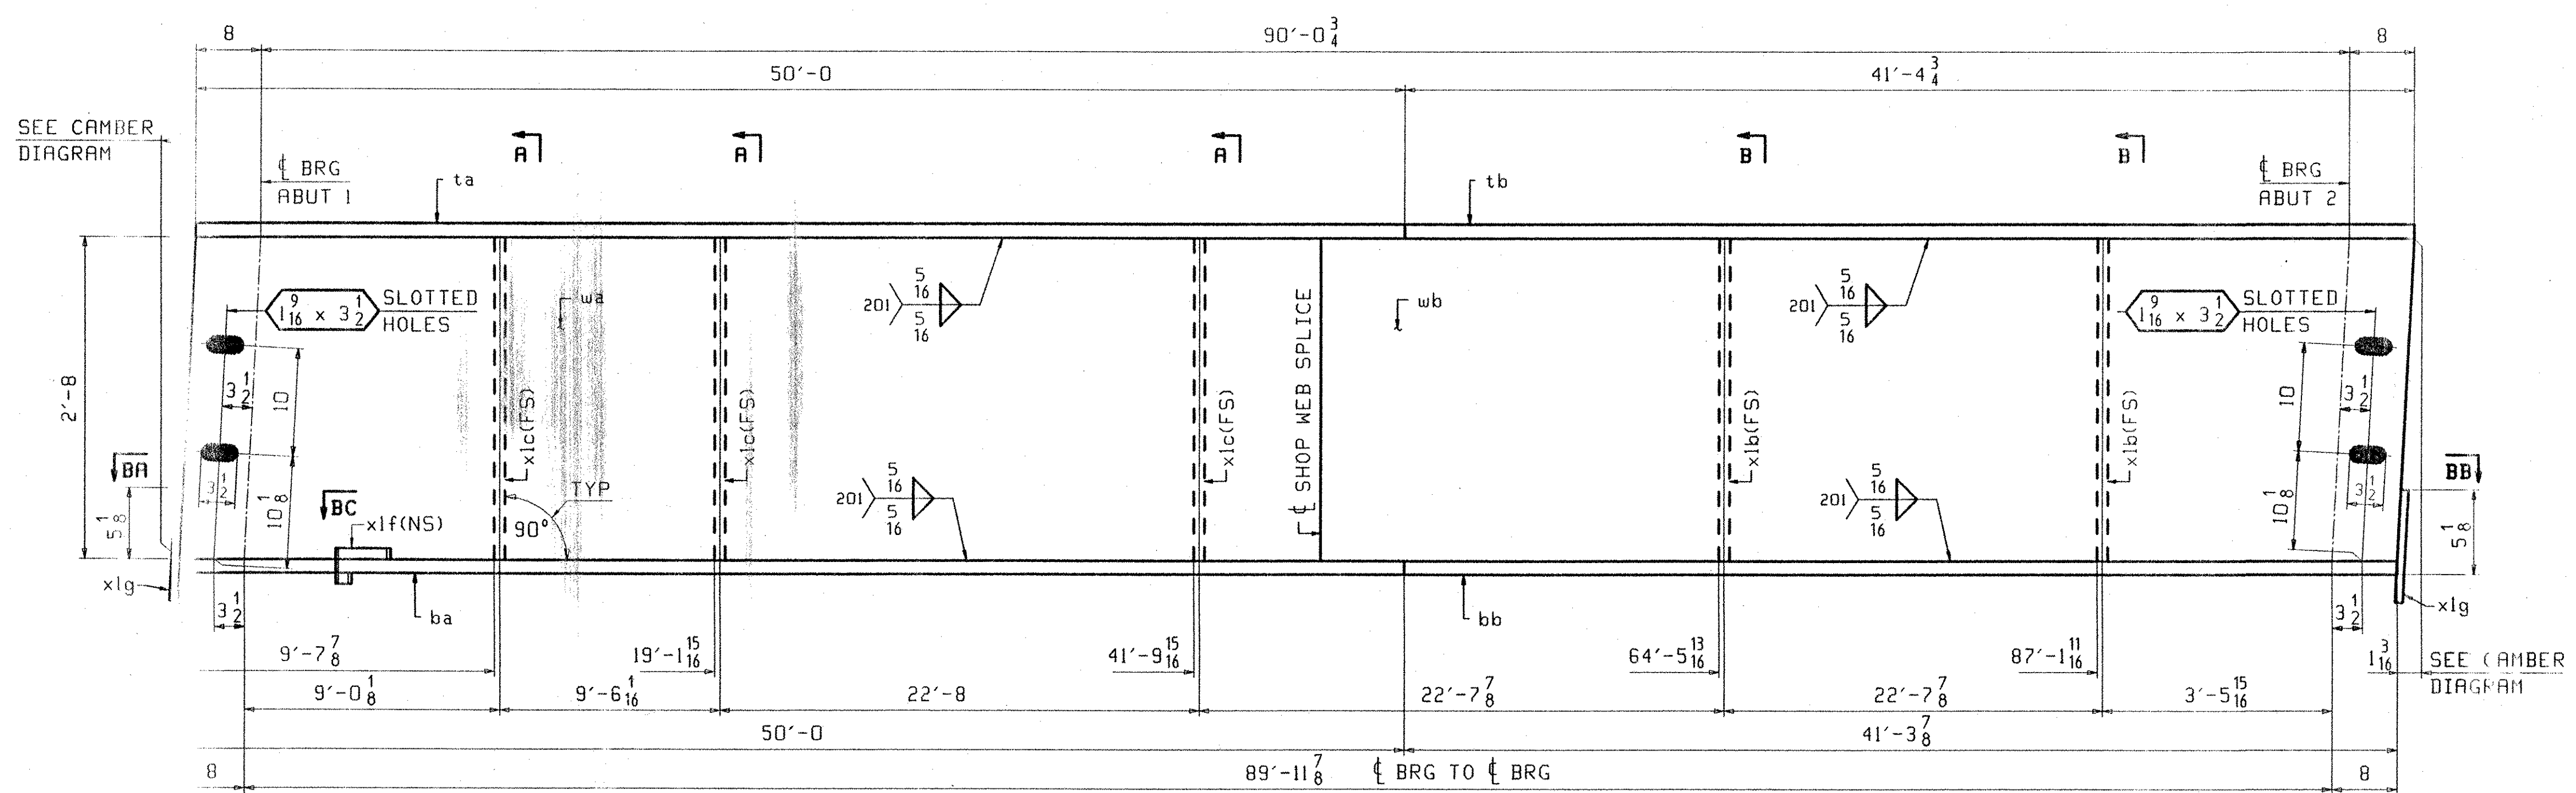


ABM INFO		SHIP	BILL OF MATERIAL				JOB NO.	DRAWING NO.	REV.
PAGE	LINE	MARK	QTY	MARK	MATERIAL	LENGTH FT INCHES	REMARKS	WT	PROCUREMENT NOTE
					GIRDER			19115	
1	J	1	wa		PL 1/2 x 33 5/8	45 8 1/2	(M270-50HT2) (H2-3)		
1	J	1	wb		PL 1/2 x 33 5/8	45 8 1/2	(M270-50HT2) (H2-3)		
1	E	1	ta		PL 7/8 x 16	50 0			
1	G	1	tb		PL 7/8 x 16	41 4 3/4			
1	A	1	ba		PL 1 1/8 x 16	50 0	(A709-50HT2) (H2-3)		
1	C	1	bb		PL 1 1/8 x 16	41 3 3/8	(A709-50HT2) (H2-3)		
2	B	3	x1c		PL 1/2 x 2 1/2	2 8			
2	B	2	x1d		PL 1/2 x 2 1/2	2 8			
2	E	1	x1e		PL 1/2 x 3 1/2	0 11 1/4			
2	D	2	x1g		PL 1/2 x 9	2 8 7/8	RENT		

ONE - GIRDER - 5G5
 FOR GIRDER STANDARD DETAILS SEE DRAWING XI.
 FOR CAMBER DIAGRAM SEE DRAWING CI.
 FOR GENERAL NOTES SEE DRAWING GNI.
 H2-3 DENOTES MATERIAL SUBJECT TO CHARPY V-NOTCH TESTING.

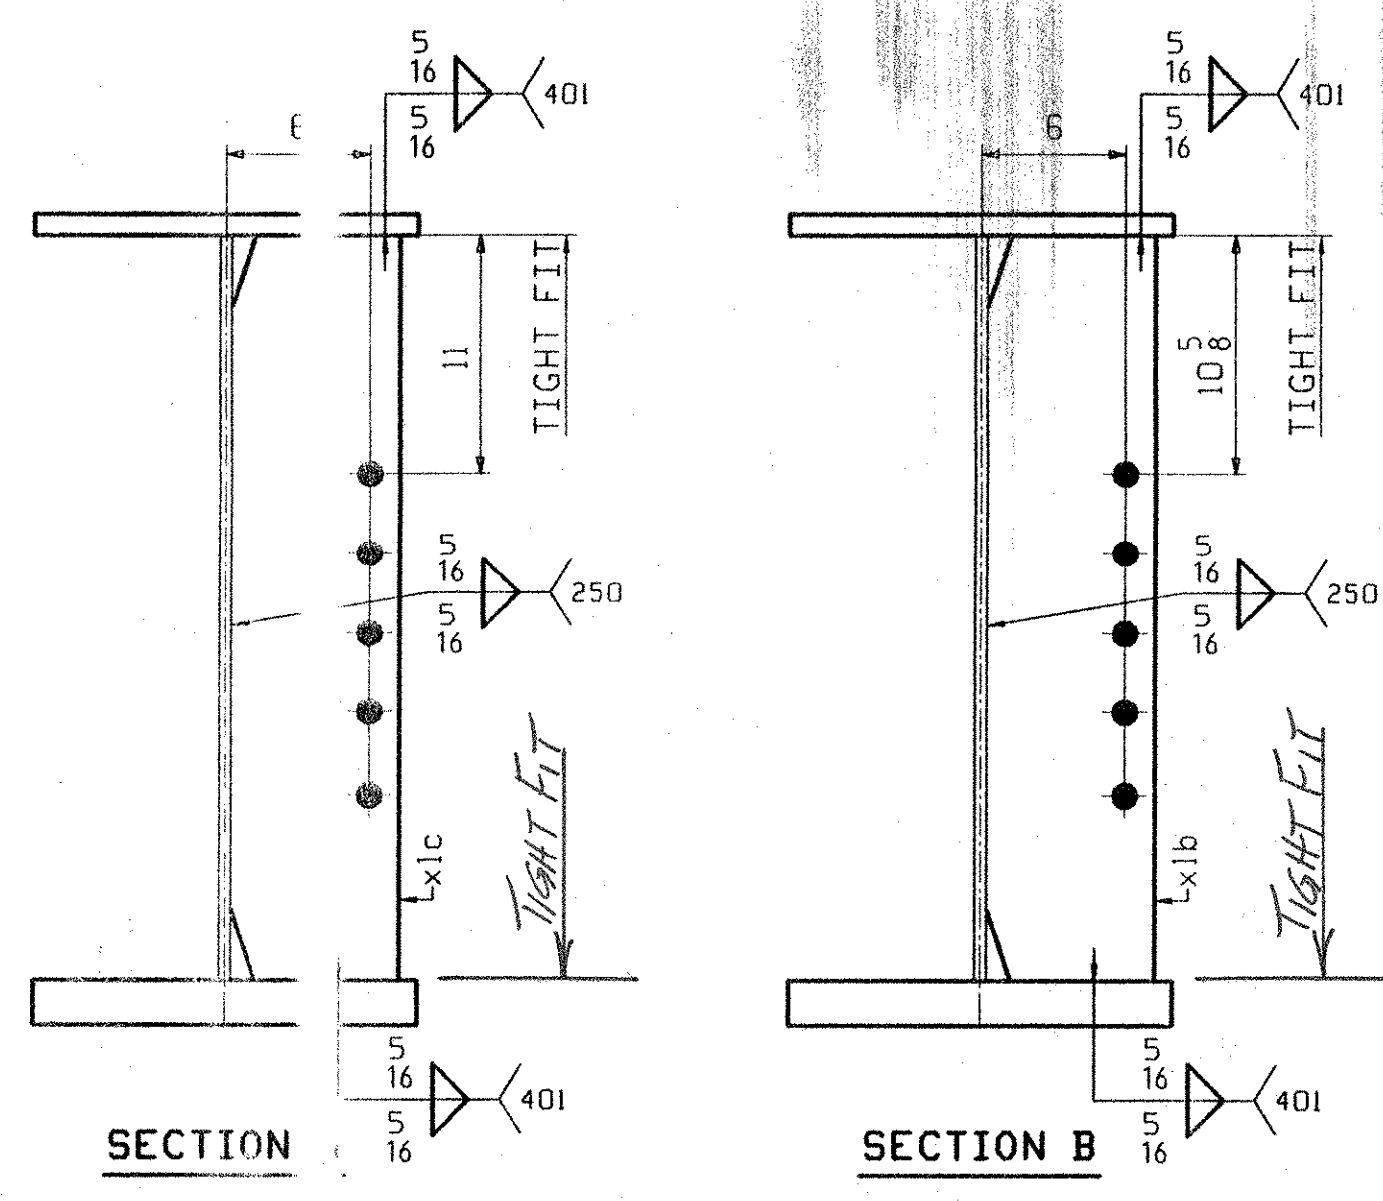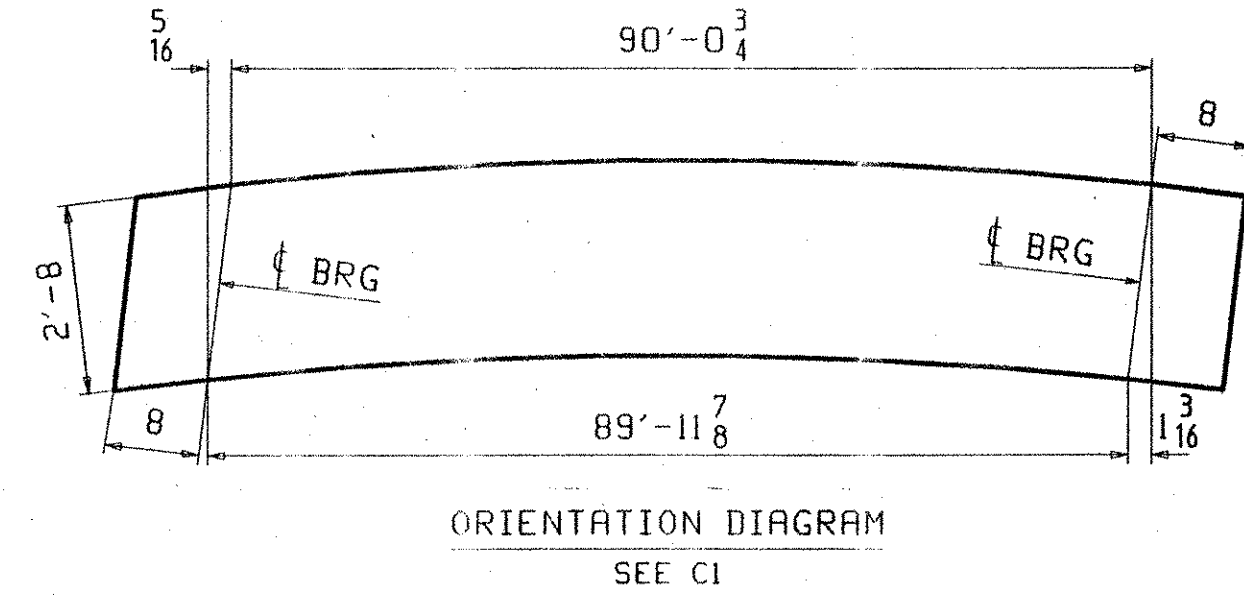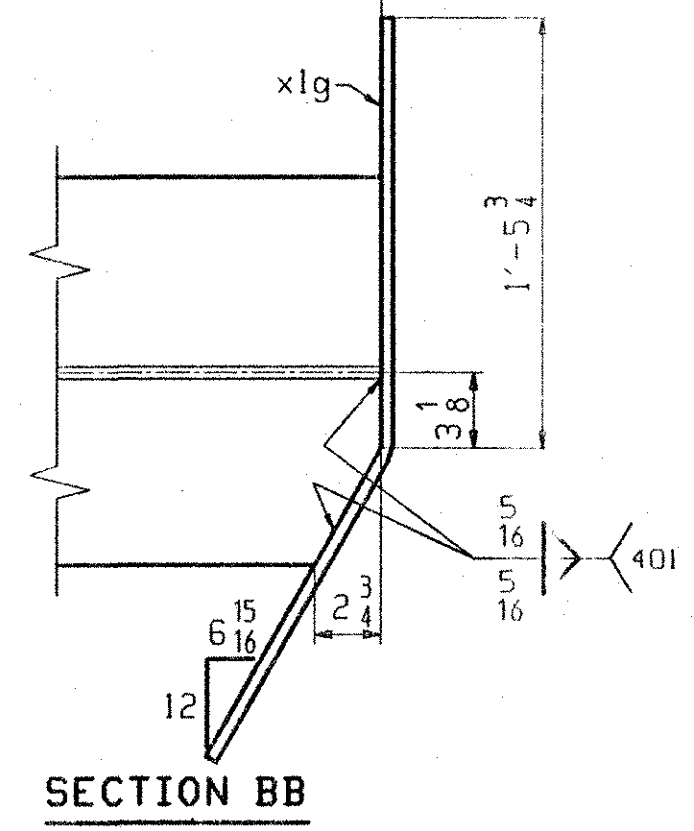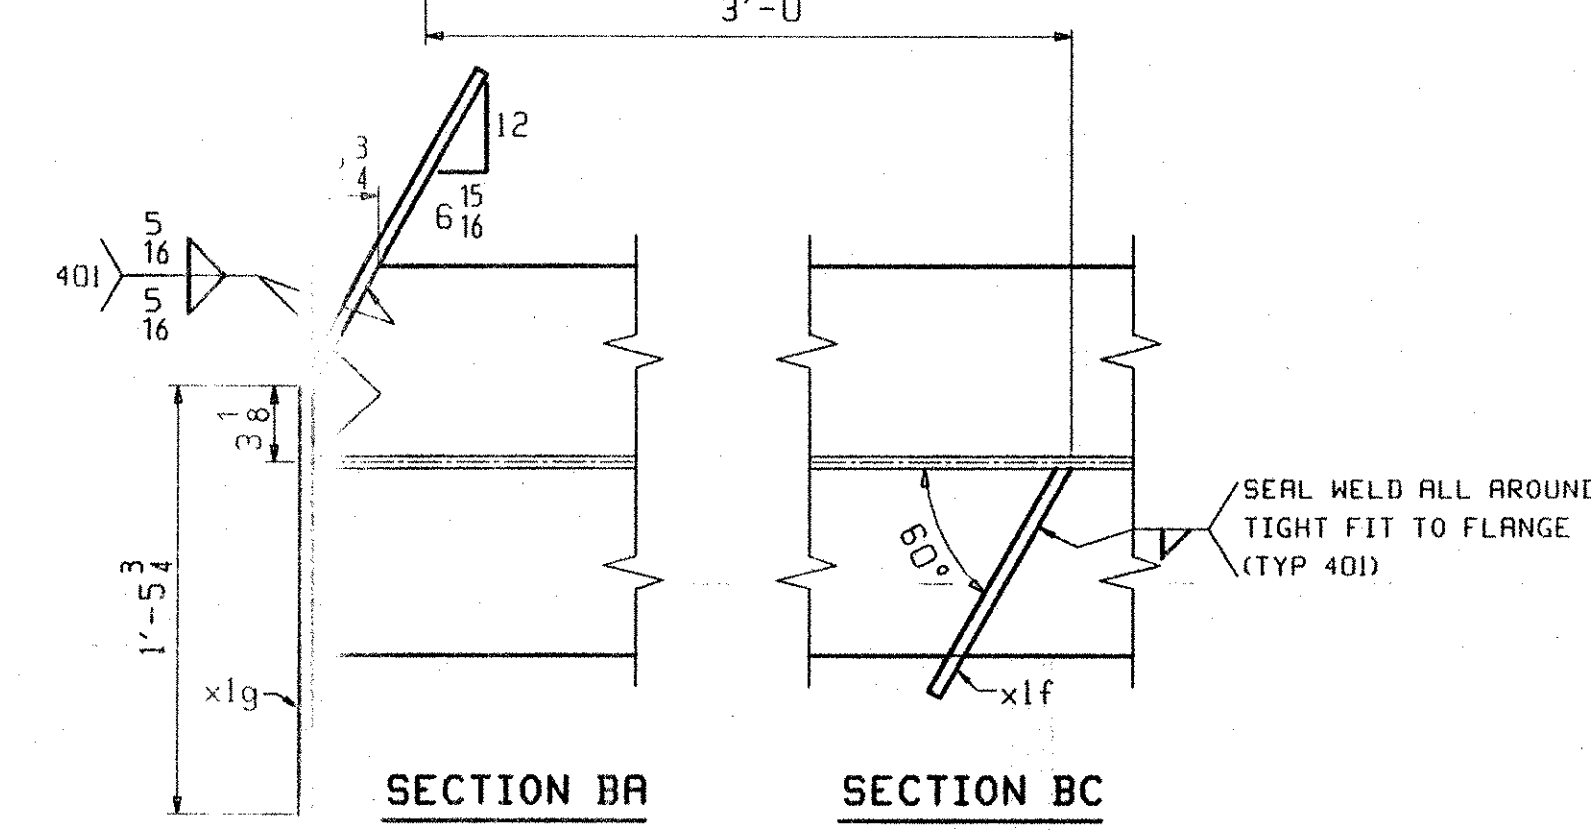

RECEIVED
 DEC 09 2003
 APPROVED *As Noted*
 BY *RRW* DATE *1-8-04*

OUT FOR APPROVAL	12-1-03											
OUT FOR APPROVAL												
ISSUED TO SHOP												
FIELD & OFFICE												
REV.	REMARKS	DATE	DWN	CHK	APP	Q.A.	NO.	DIA.	LGT	TYPE	WASHER	
	MATERIAL:	ELECTRODES:		HOLES:		SHOP BOLTS:						
	A709-50W (UN)			15/16 Ø (UN)		NONE						
SURFACE PREP. & PAINT:												
NONE												
DESCRIPTION: GIRDER - 5G5										DRAWN BY	DATE	
JOB: BOSTWICK ROAD OVER VERMONT RAILWAY										JTB	11/14	
BRIDGE NO. 15 HIGHWAY NO. TH 3										CHKD BY		
TOWN OF SHELBURNE										FTM	11/21/03	
ENGR: McFarland-Johnson, INC.										APPROV BY		
CONTRACTOR: S.D. IRELAND BROS. CORP.										SUPERVISOR	H. J. GATTI	
PROJ NO.	BRO 1445(30)										Q.A.	
CUSTOMER: VERMONT AGENCY OF TRANSPORTATION												
CASCO BAY STEEL STRUCTURES, INC.										JOB NO.	DRG. NO.	
75 SPRING HILL ROAD SACO, MAINE 04072										209	5	
PHONE (207) 282-7360 FAX. (207) 282-1179										REV.	△	

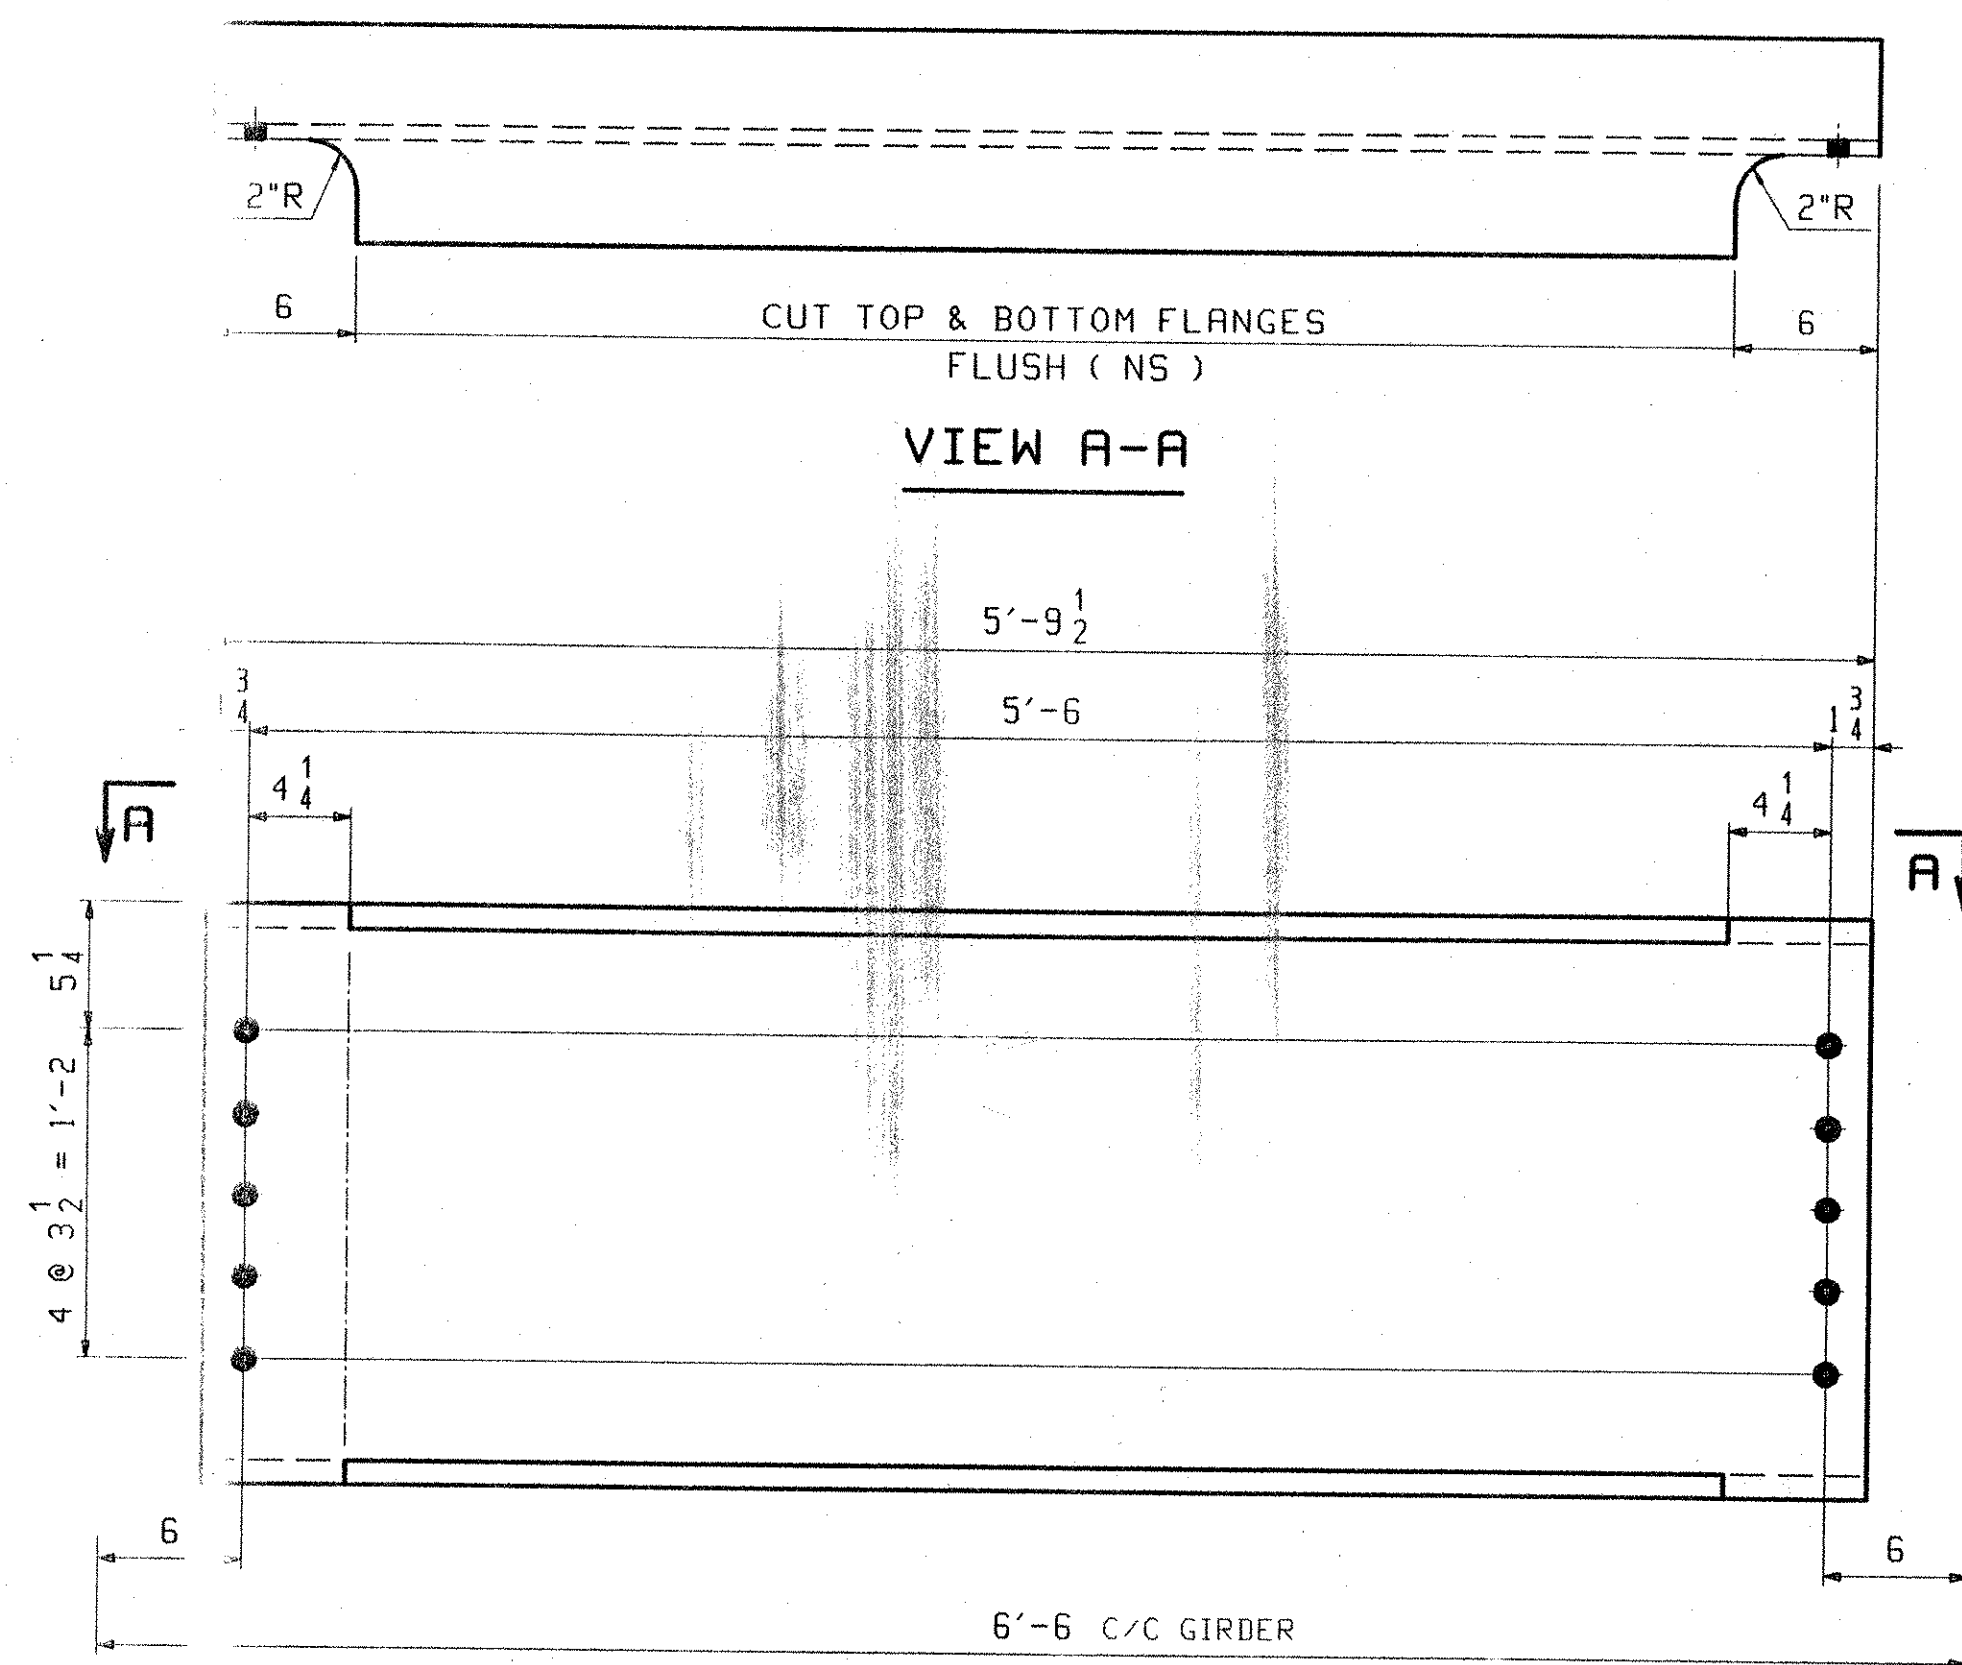

18 ~ DIAPHRAGM - 6D1
LOOKING WEST (BK STATION)

ABM INFO		SHIP	BILL OF MATERIAL				JOB NO.	DRAWING NO.	REV.
LINE	MARK	QTY	MARK	MATERIAL	LENGTH		REMARKS	WT	PROCUREMENT NOTIS
					FT	INCHES			
2	H		18 6D1	W 24x103	5	9 1/2	(A209-50W)		


RECEIVED
 OK'D BY _____ OK'D BY _____
 DEC 09 2003
 RESUBMIT _____ APPROVED _____
 BY *RLW* DATE *12-04*

OUT FOR APPROVAL	12-1-03								
OUT FOR APPROVAL									
ISSUED TO SHOP									
FIELD & OFFICE									

REV.	REMARKS	DATE	DWN	CHK	APP	Q.A.	NO.	DIA.	LGT	TYPE	WASHER	
MATERIAL:		ELECTRODES:		HOLES:		SHOP BOLTS:						
A709-50W				15/16		NONE						
SURFACE PREP. & PAINT:												
NONE												
DESCRIPTION: INTERMEDIATE DIAPHRAGM										DRAWN BY		DATE
JOB: BOSTWICK ROAD OVER VERMONT RAILWAY										JTB		11/14
BRIDGE NO. 15 HIGHWAY NO. TH 3										CHKD BY		
TOWN OF SHELBURNE										FTM		11/21/03
ENGR: McFarland-Johnson, INC.										APPROV BY		
CONTRACTOR: S.D. IRELAND BROS. CORP.										SUPERVISOR		W. J. GATTI
PROJ NO. BRO 1445(30)										Q.A.		
CUSTOMER: VERMONT AGENCY OF TRANSPORTATION												
CASCO BAY STEEL STRUCTURES, INC.										JOB NO.		DRG. NO.
75 SPRING HILL ROAD										209		6
PHONE (207) 282-7360										FAX. (207) 282-1179		REV. Δ

BILL OF MATERIAL				
Qty.	Description	Size/Shape	Length	Material
30	FASCIA MID. POST	W8 x 24	4'-1"	A572 GR 50
6	DRIVEN POST	W8 x 24	6'-0"	A572 GR 50
2	DRIVEN POST	W8 x 24	6'-4"	A572 GR 50
16	HDSB RAIL 12'-6" / 6'-3"	W-BEAM	12'-6"	AASHTO M180 B2
2	HAND RAIL TUBE	TS 6 x 3 x 1/4"	24'-11"	A500 GR B
6	HAND RAIL TUBE	TS 6 x 3 x 1/4"	18'-8"	A500 GR B
2	HAND RAIL DROP END	TS 6 x 3 x 1/4"	12'-6.250"	A500 GR B
2	HAND RAIL DROP END	TS 6 x 3 x 1/4"	4'-11.250"	A500 GR B
2	BRIDGE TUBING	TS 8 x 4 x 3/16"	24'-11"	A500 GR B
6	BRIDGE TUBING	TS 8 x 4 x 3/16"	18'-8"	A500 GR B
2	BRIDGE TUBING	TS 8 x 4 x 3/16"	14'-5.250"	A500 GR B
2	BRIDGE TUBING	TS 8 x 4 x 3/16"	5'-1.250"	A500 GR B
20	SPUCE PLATE	.750" x 5"	2'-7"	A572 GR 50
30	SHELF BRACKET	LS 3 1/2 x 3/8"	6.500"	A36
72	TUBE BLOCK TS 8x4x3/16x6" LG.	TS 8 x 4 x 3/16"	6"	A500 GR B
40	SPECIAL PLATE WASHER	.250" x 1.750"	3"	A572 GR 50
10	SPUCE CHANNEL	C7 x 12.25	2'-7"	A572 GR 50
40	HEX BOLT W/HEAVY HEX NUT & FLAT WASHER	3/4"	4"	A307
40	HEX BOLT W/NUT & STD. WASHER	5/8"	10"	A325
30	HEX BOLT W/NUT & (2) STD. WASHERS	5/8"	4.500"	A307
72	HEX BOLT W/NUT & STD. WASHER	5/8"	2"	A325
60	HEX BOLT W/NUT & STD. WASHER	5/8"	2"	A307
40	HEX BOLT W/STD. WASHER	5/8"	2"	A325
128	RD HEAD SPUCE BOLT W/NUT	5/8"	1.250"	A307
34	HEX BOLT W/NUT & (2) STD. WASHERS	5/8"	13"	A325
*60	U-BOLT ANCH. W/(4)NUTS&(2)STD. WASHERS	1"	- - -	A449
*120	PLATE WASHER	.250" x 2"	5"	A36

* - PROVIDED BY OTHERS - NOT SUPPLIED BY HIGHWAY SAFETY CORP.

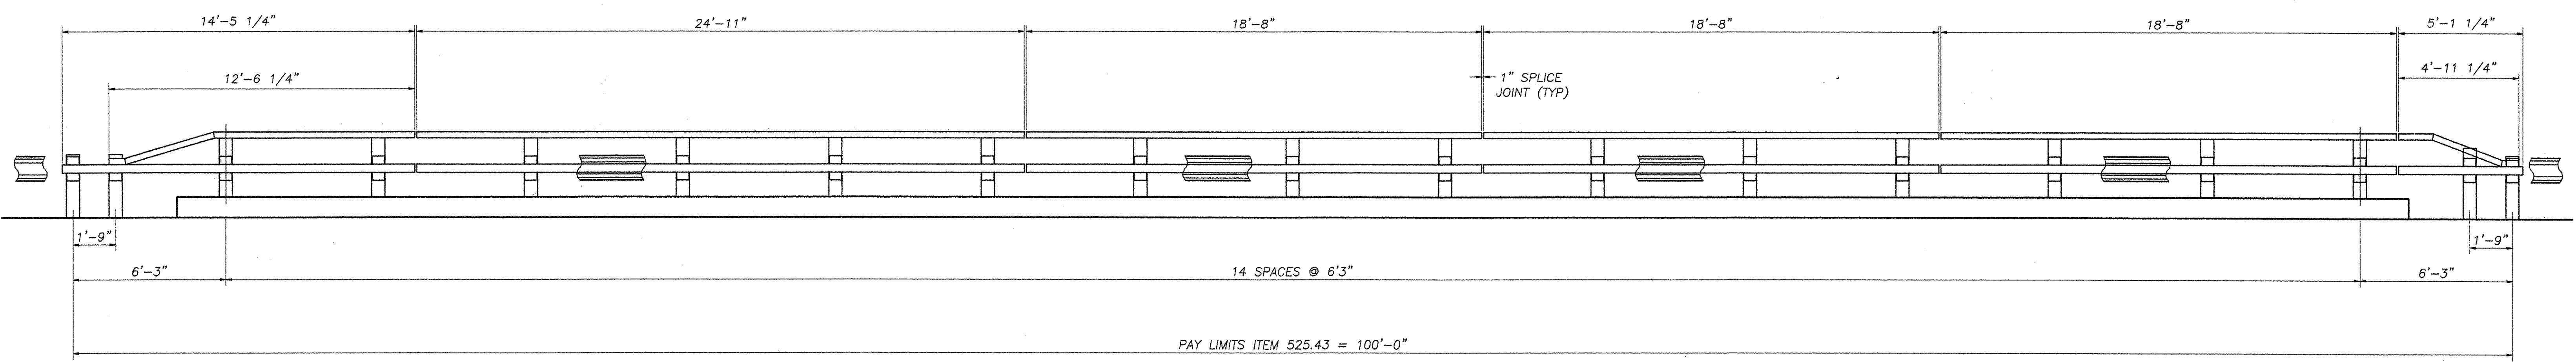

ELEVATION - NORTH BRIDGE RAIL
 FACING NORTH FROM Φ OF ROADWAY
 SOUTH BRIDGE RAILING SIMILAR

TOTAL PAY LIMITS FOR ITEM 525.43 (STEEL BRIDGE RAILING HDSB WITH HANDRAIL) = 200 LF

















REVISIONS		
No.	Remarks	Date
0	Initial submittal	1/20/04
2 ND	SUBMITTAL	2/11/04

RECEIVED
 OK'D BY G. ROY OK'D BY _____
 2-17-04
 FEB 11 2004
 RESUBMIT _____ APPROVED AS NOTED
 BY RRW DATE 2-17-04

QUALITY ASSURANCE
AISC
 CERTIFICATION

HIGHWAY SAFETY CORP.
 GLASTONBURY, CT

ITEM 525.43 STEEL BRIDGE RAIL - HDSB W/HANDRAIL	DRAWN J. Ruiz
TOWN OF SHELburnE, CHITTENDEN COUNTY	CHECKED <u>[Signature]</u>
BOSTWICK ROAD OVER VERMONT ROAD	DATE 1/19/04
BRIDGE No. 15	SCALE NONE
BHO 1445 (30)	HSC REFERENCE NO. 1412
GENERAL CONTRACTOR	SIZE D REVISION 0
SUB CONTRACTOR F.R. LAFAYETTE, INC.	SHEET NO. 1 of 2

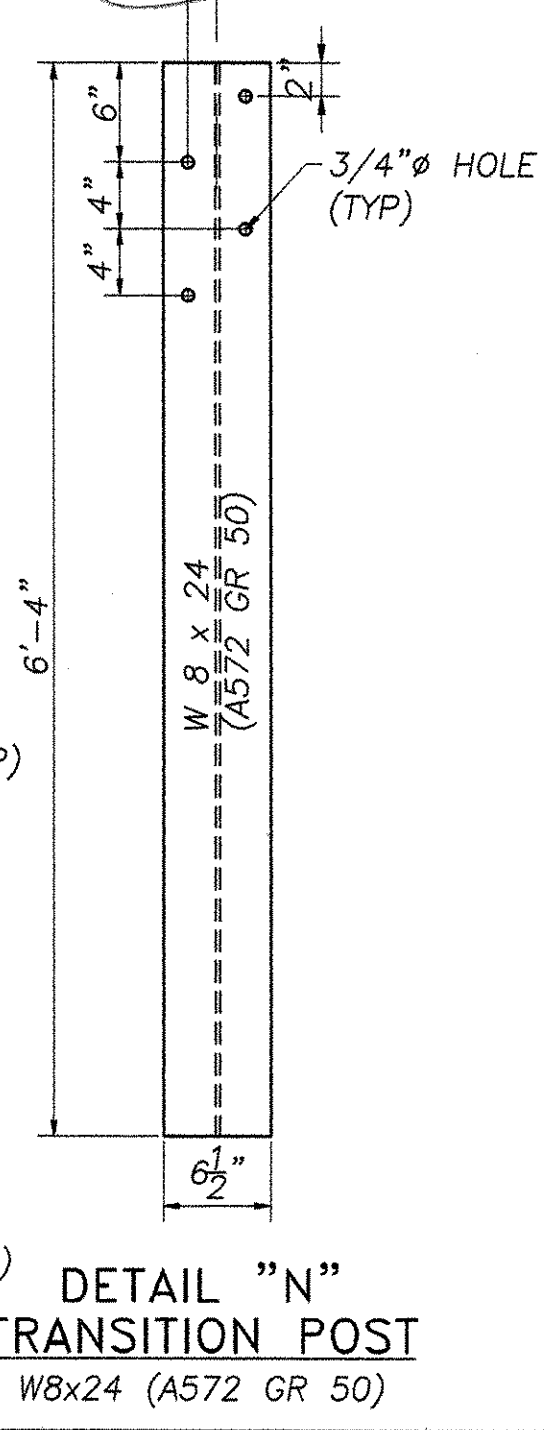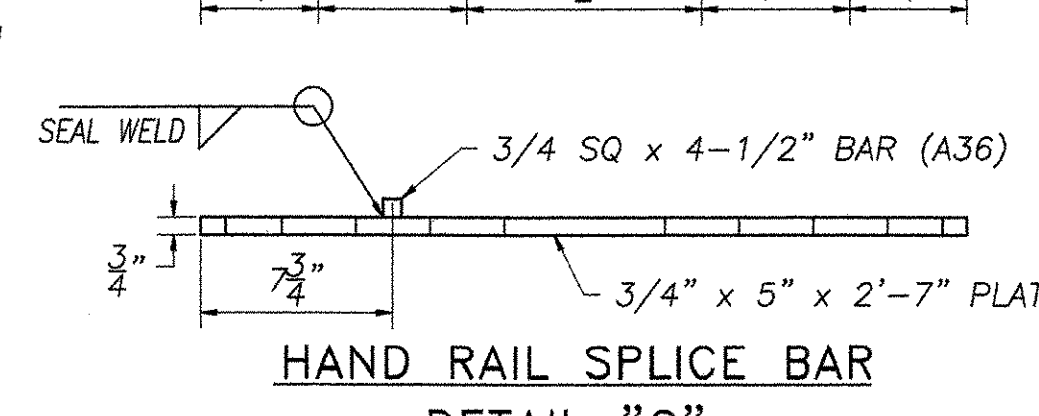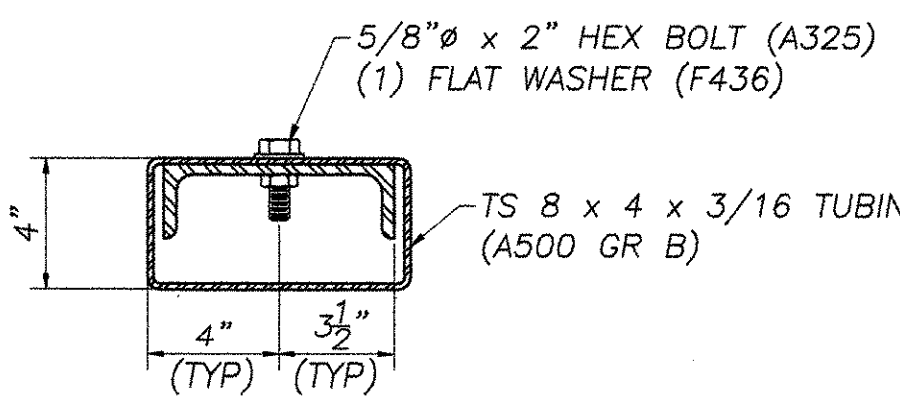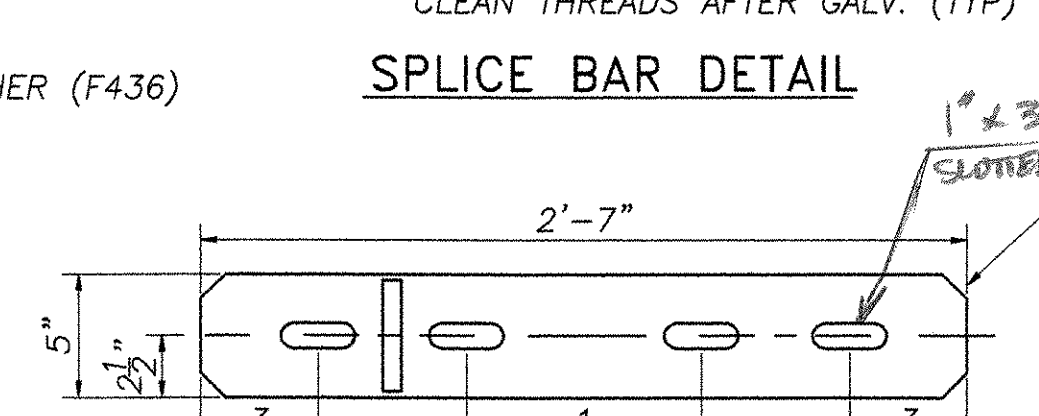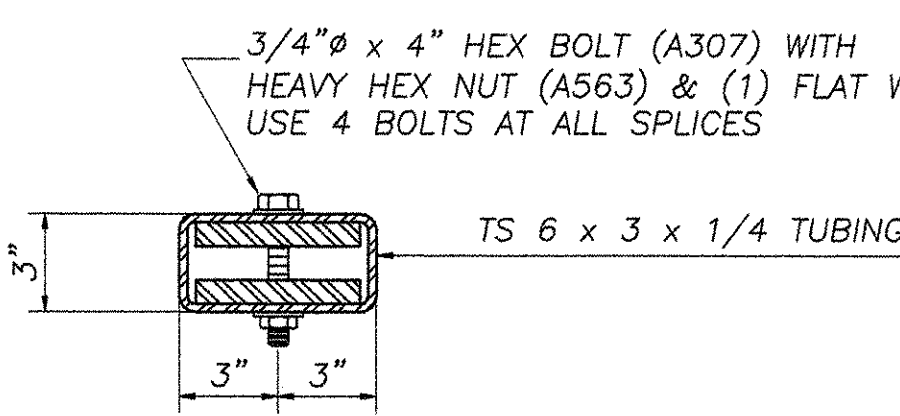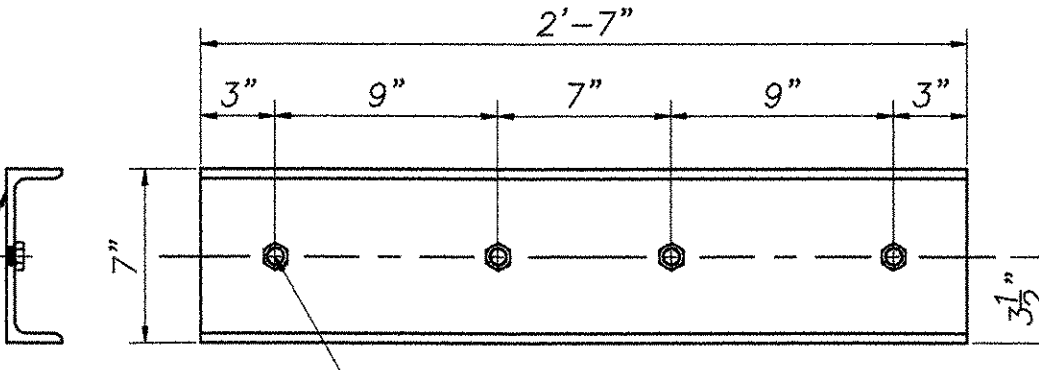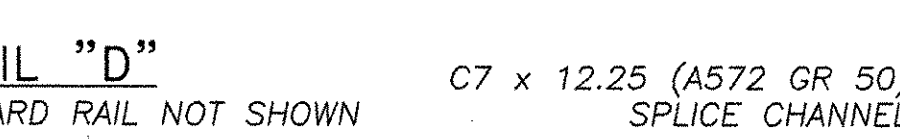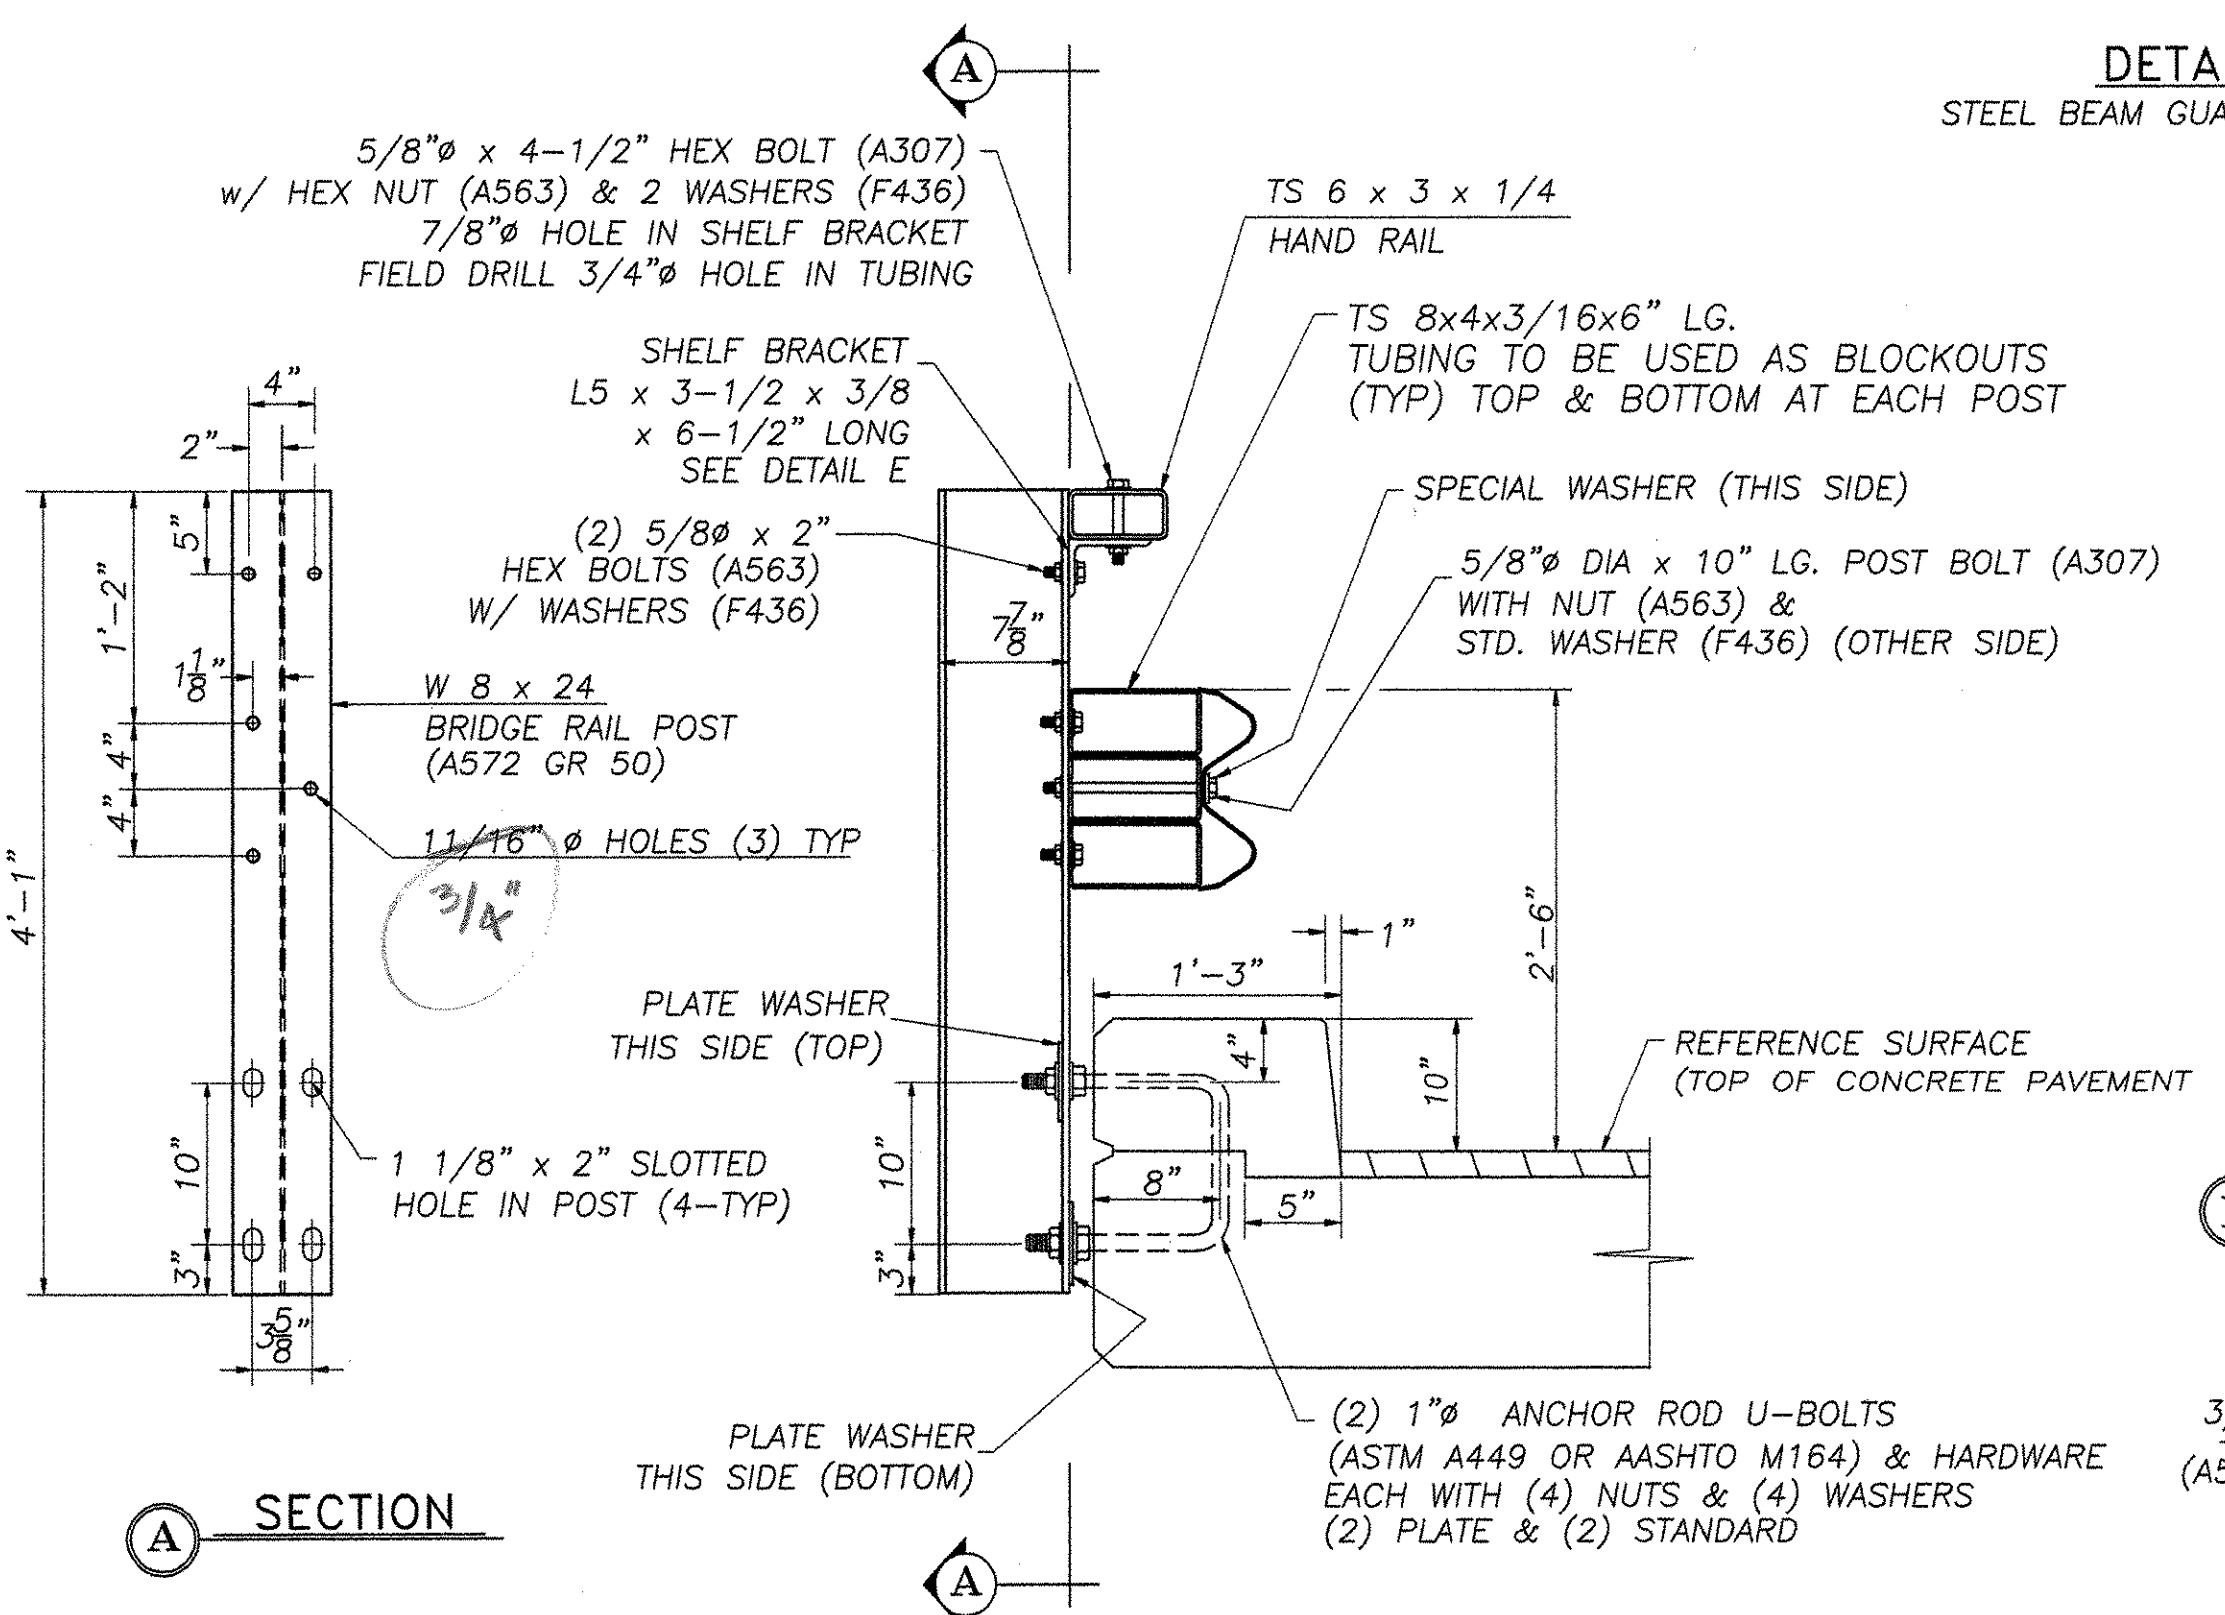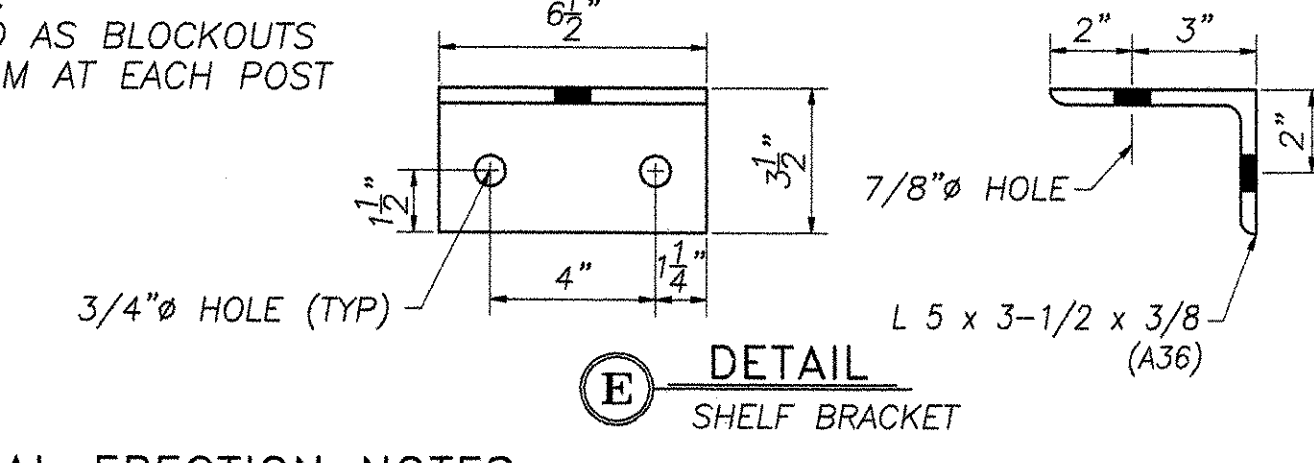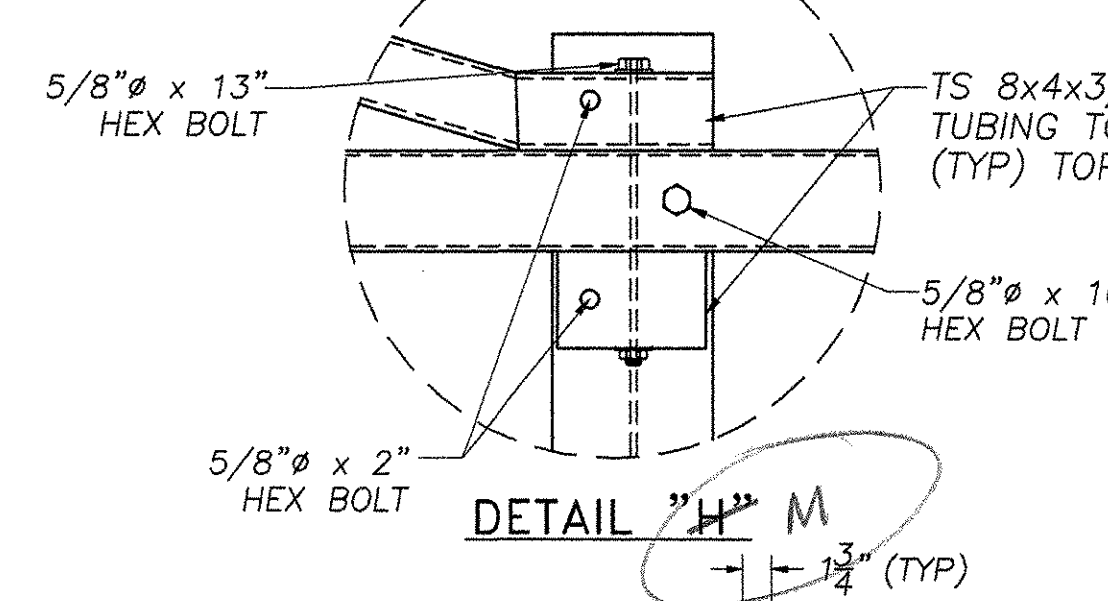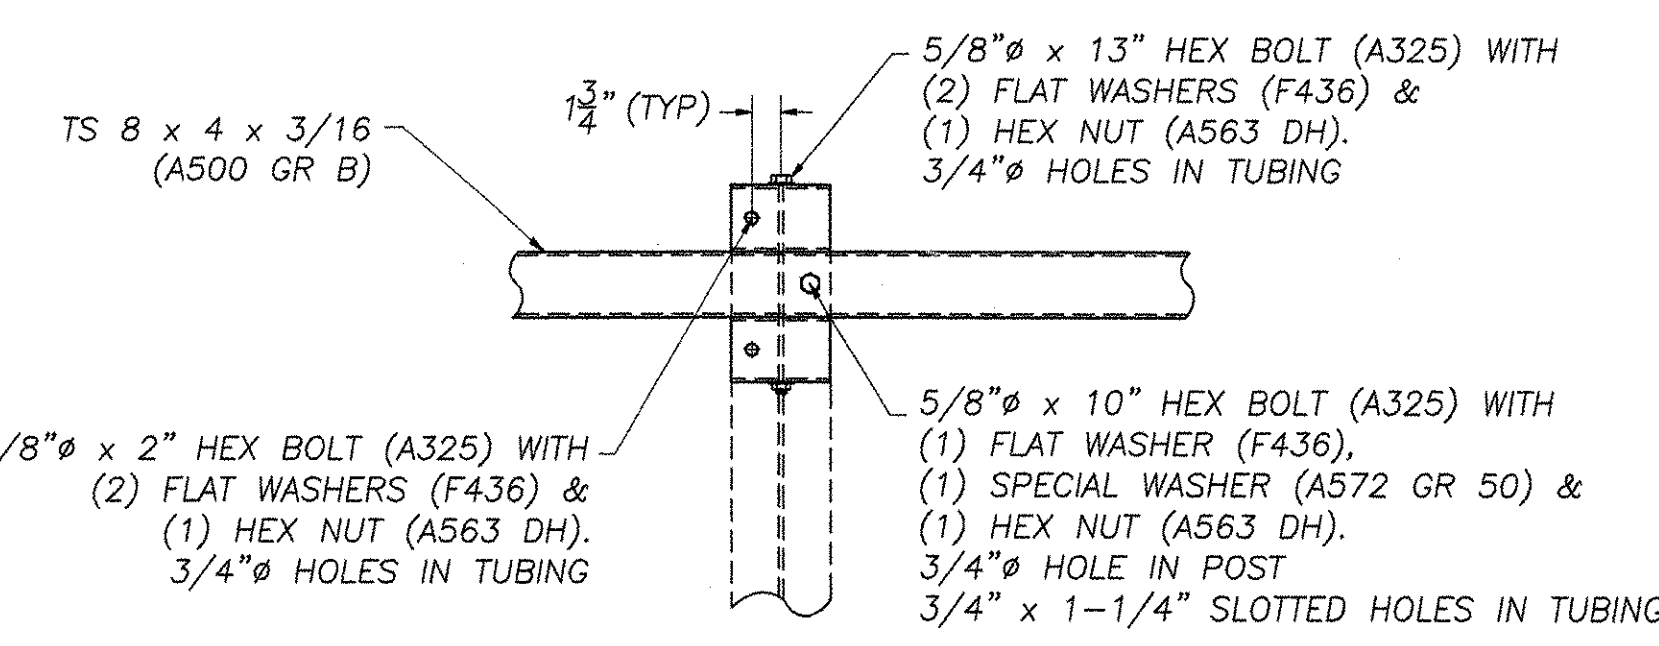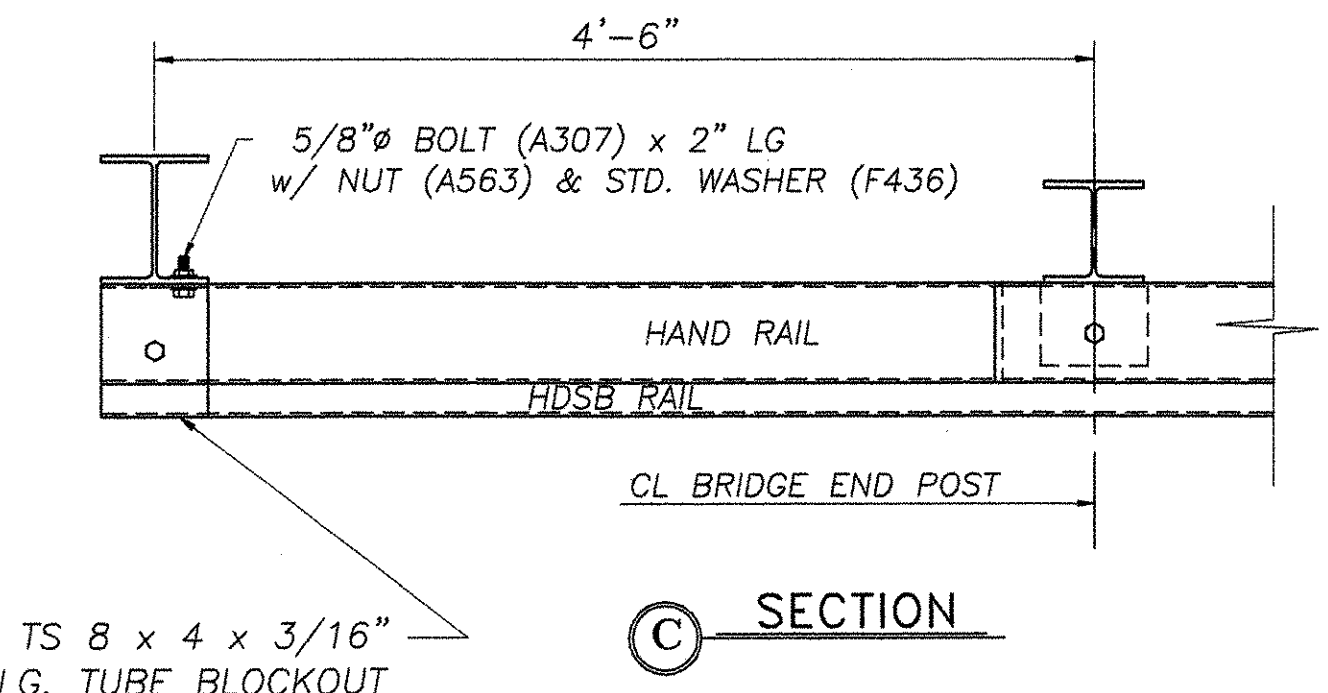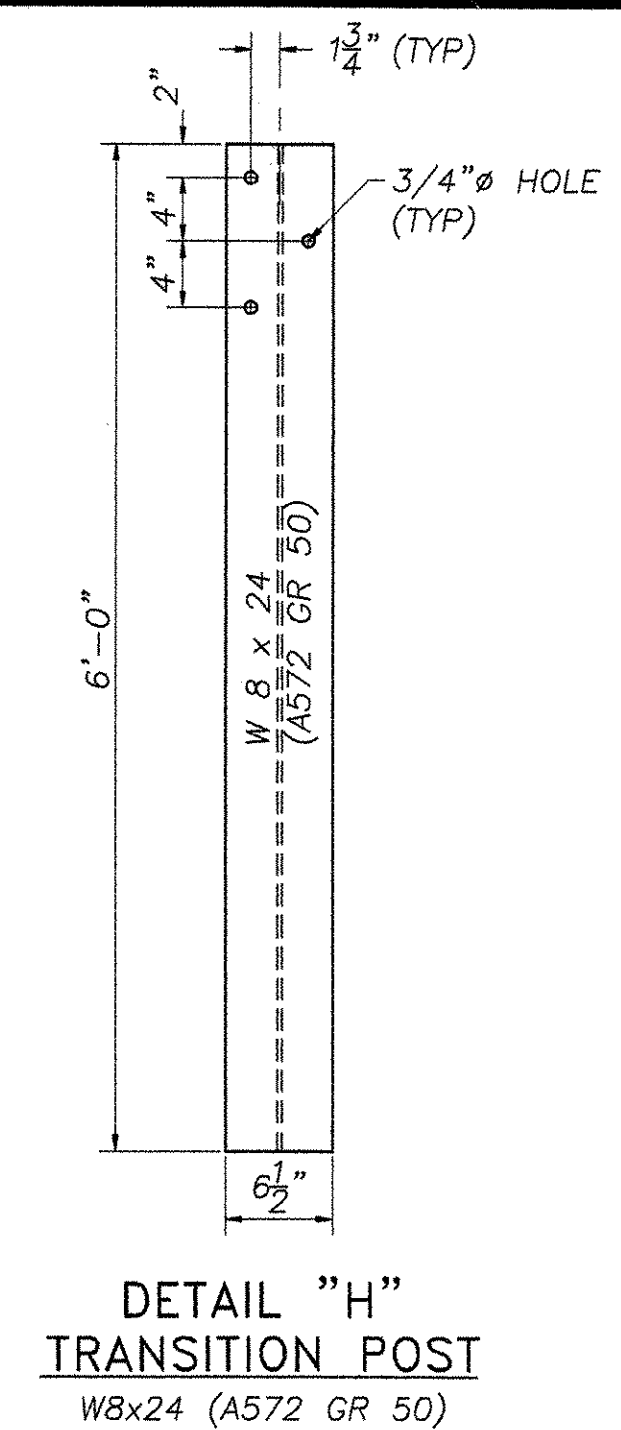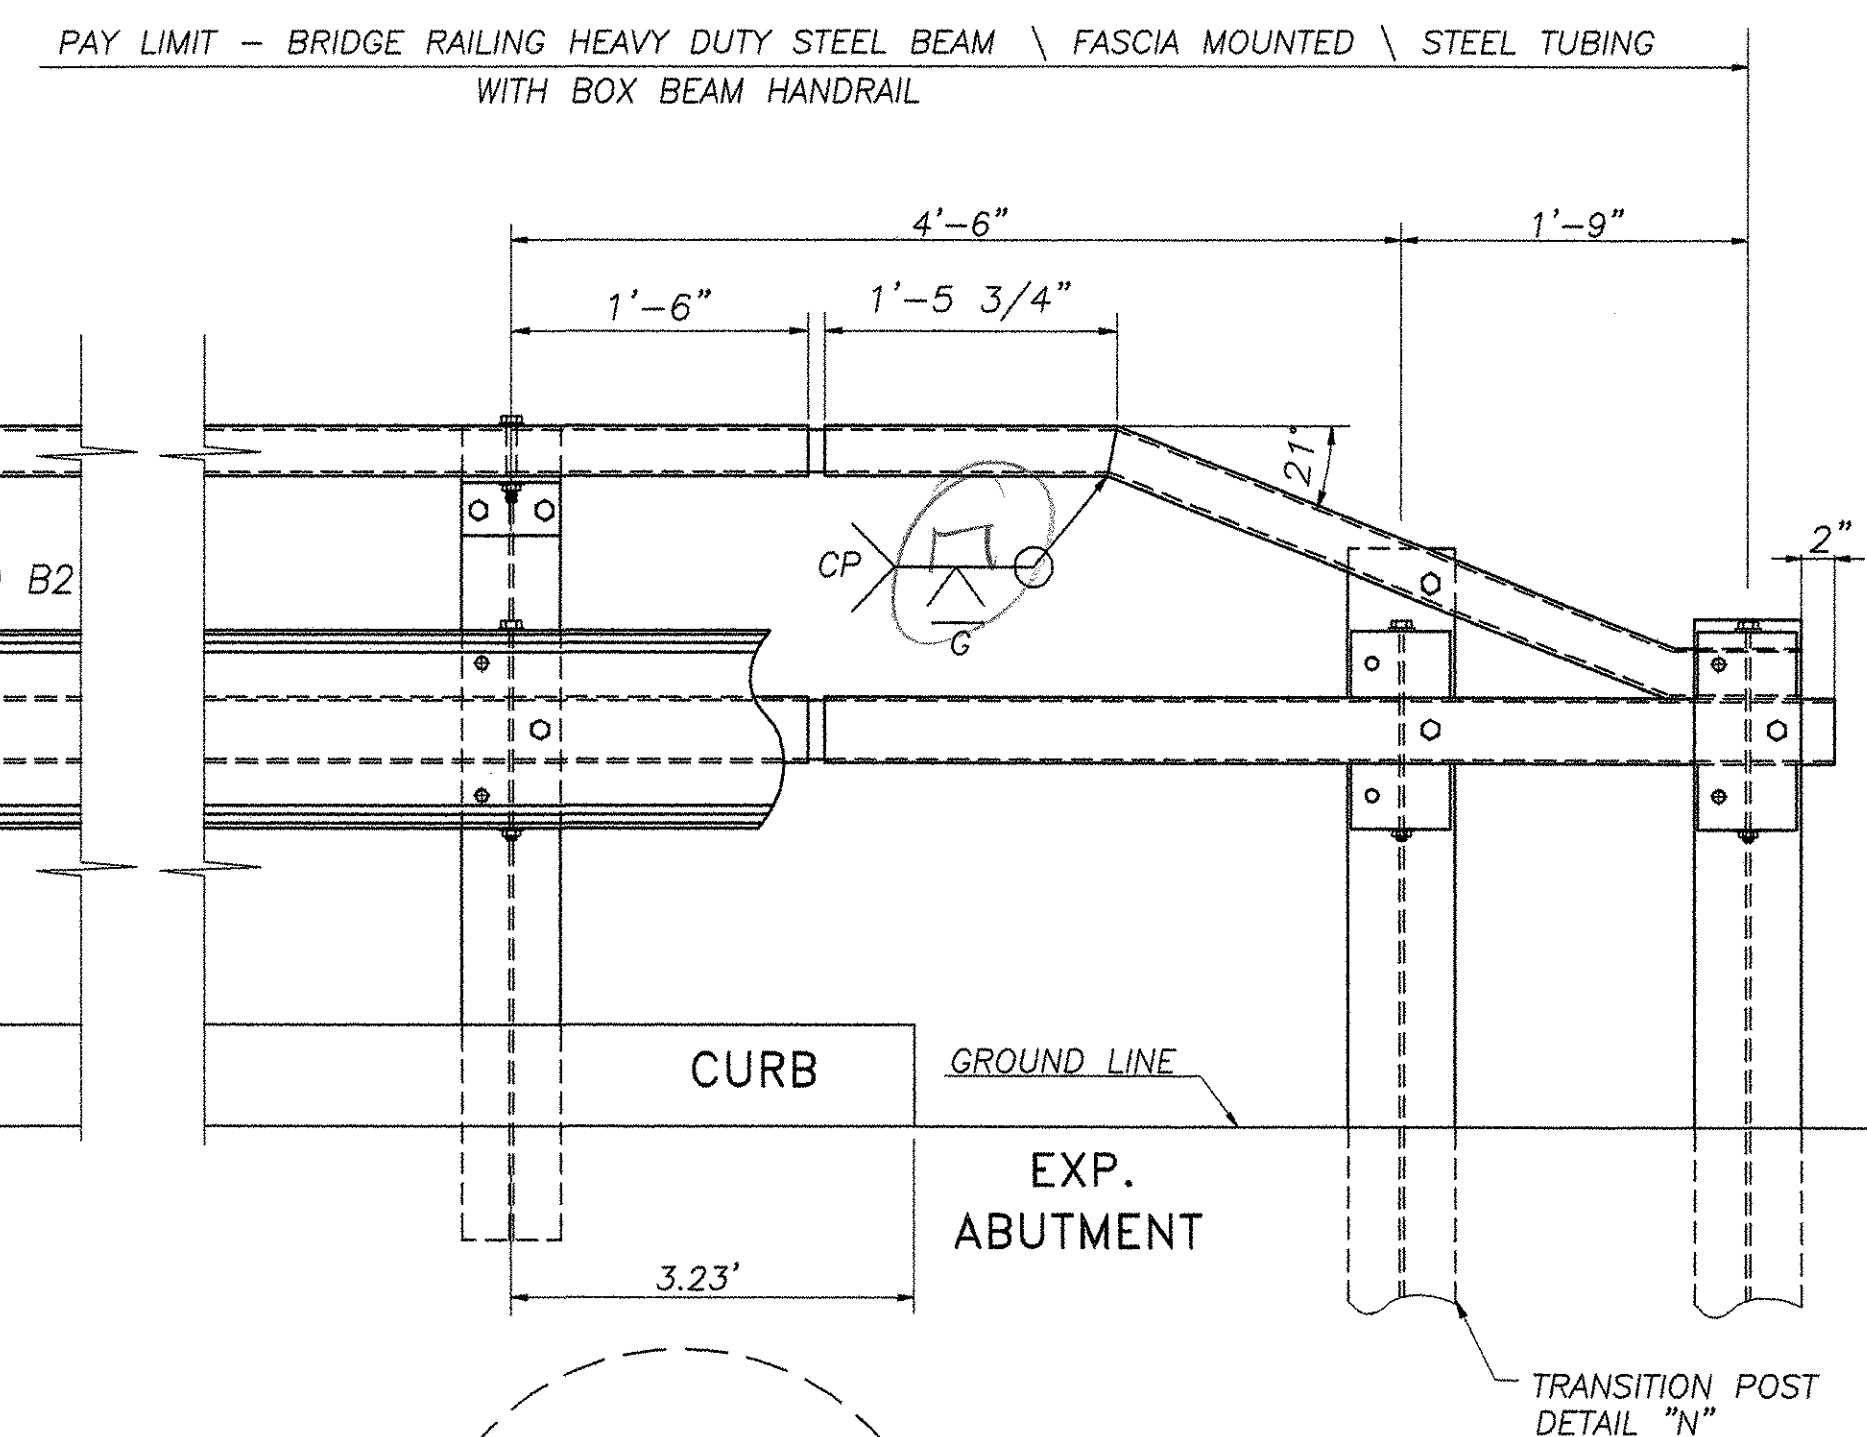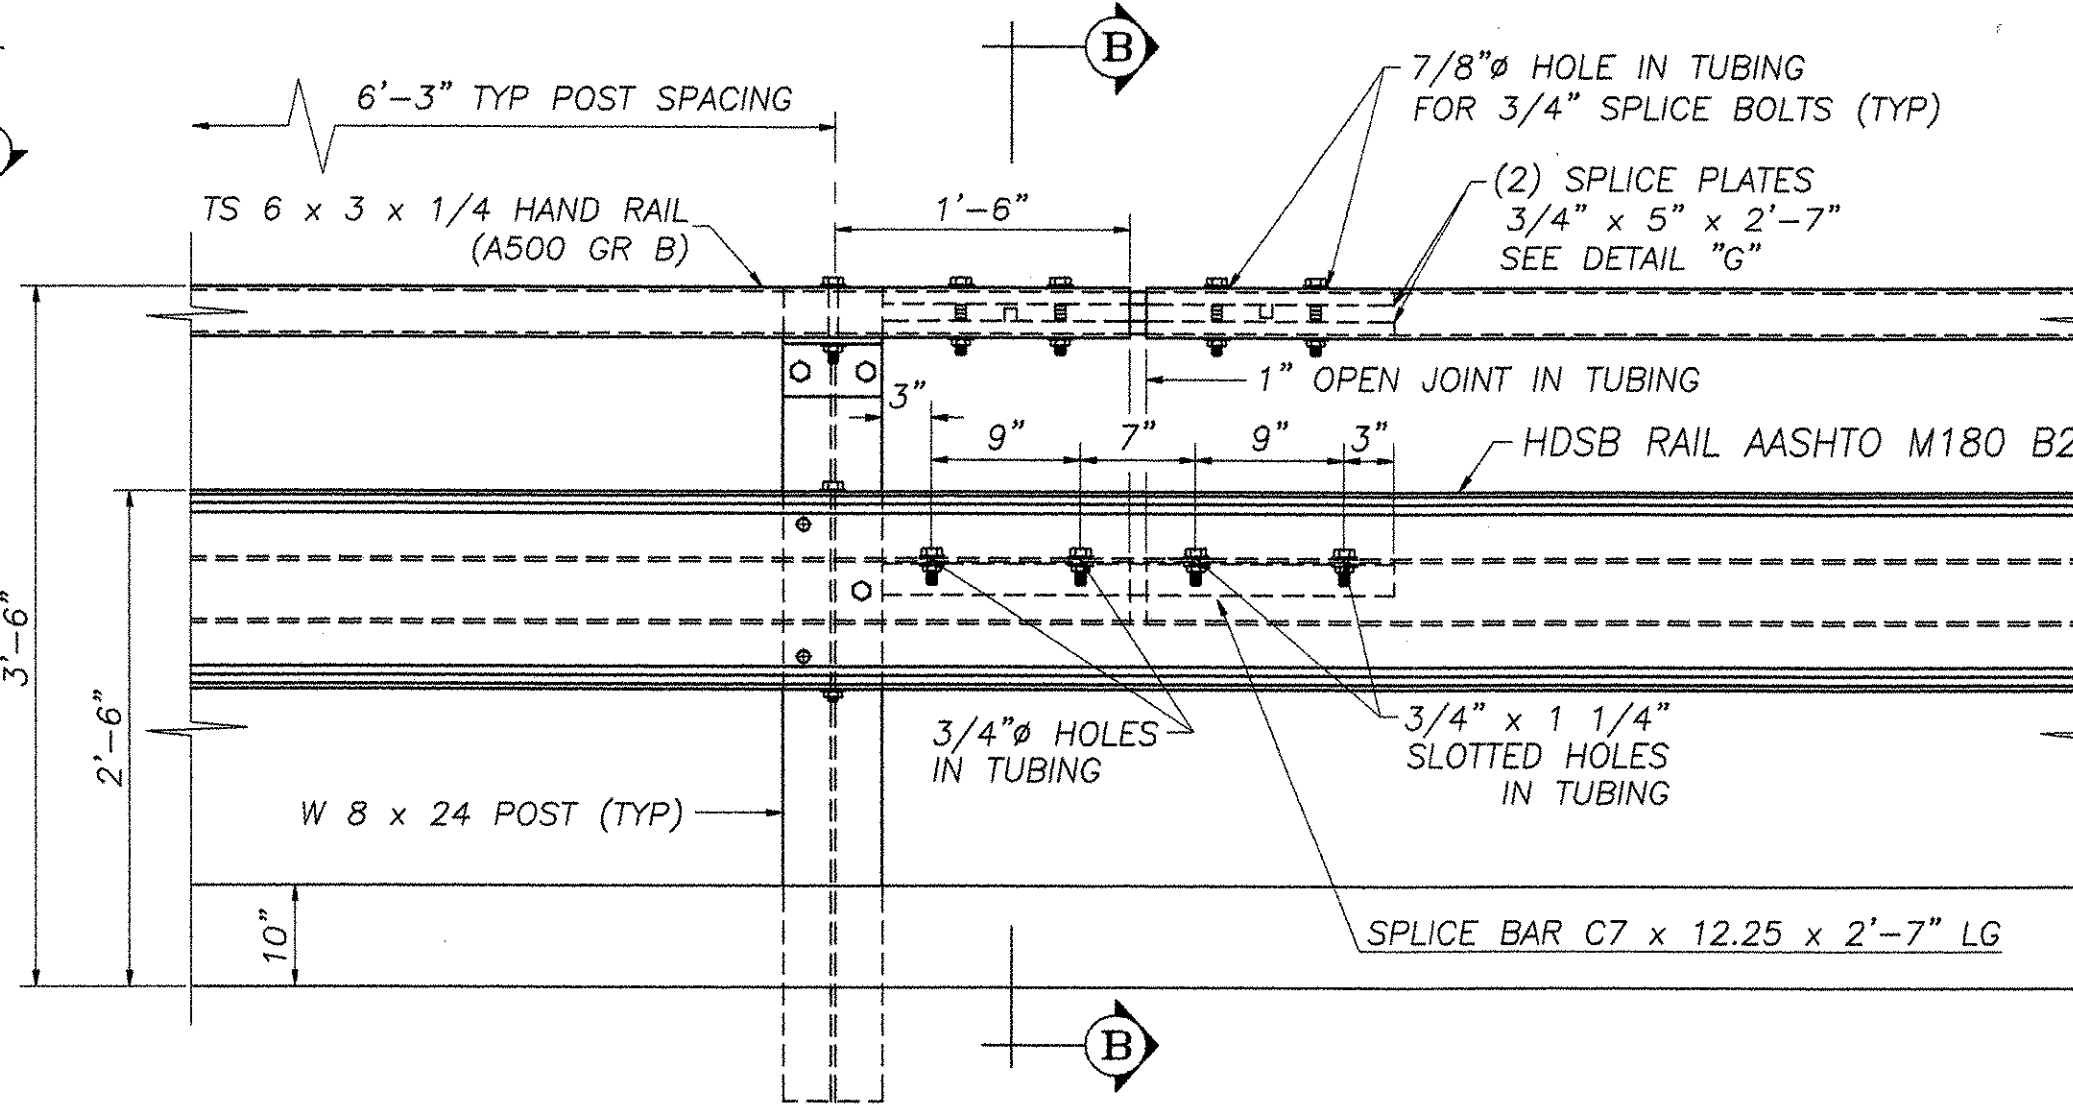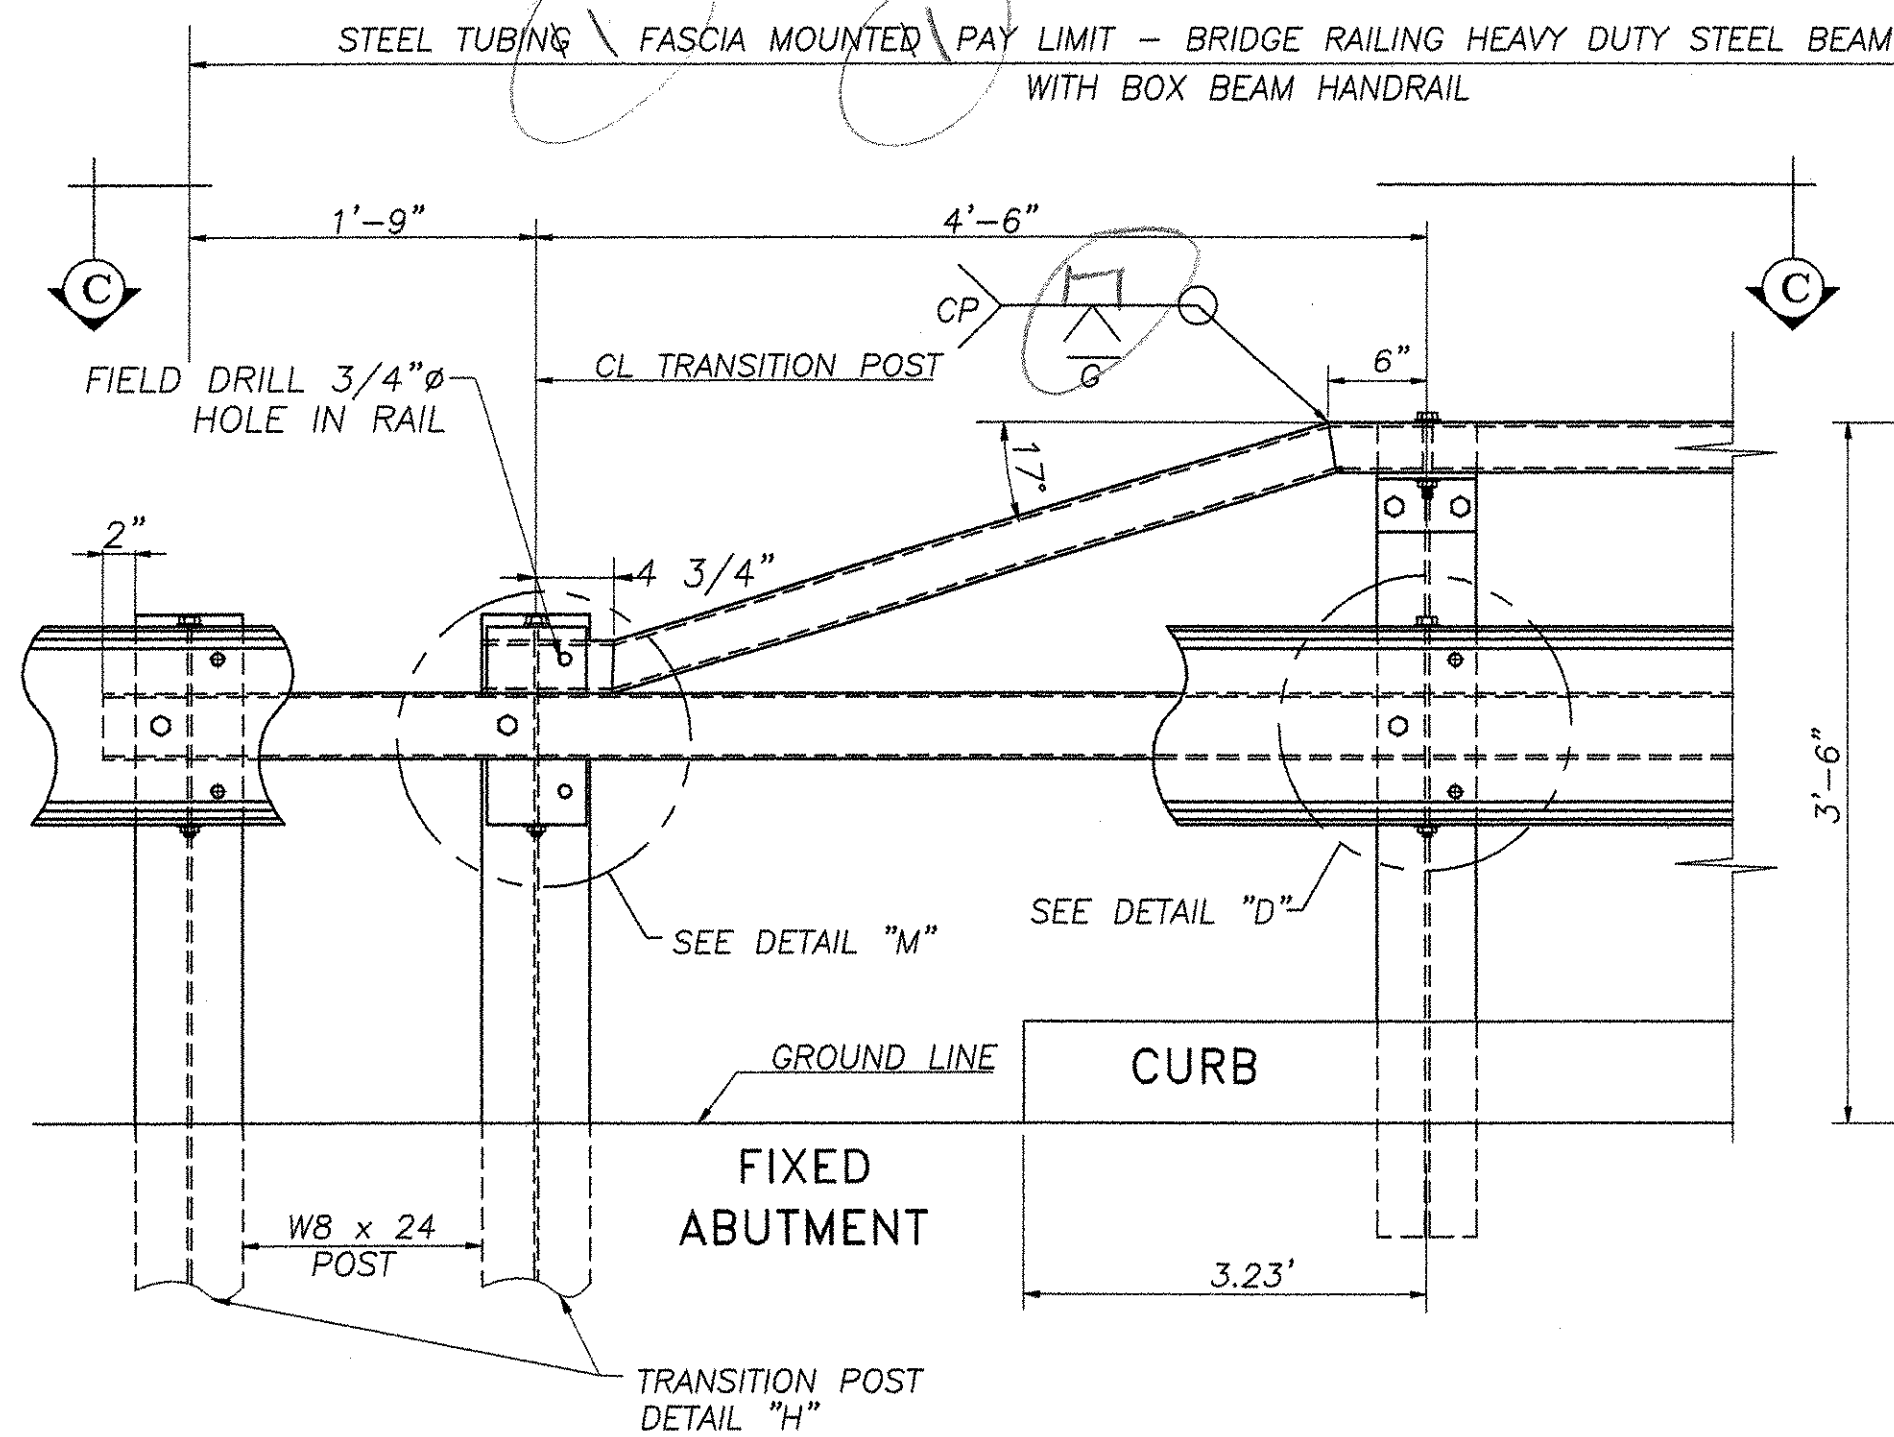

- GENERAL ERECTION NOTES**
- Heavy duty steel beam guard rail shall conform to VT. specification 732. AASHTO M180 B2
 - Structural steel tubing shall conform to VT. specification 732. ASTM A500 gr B
 - Anchor bolts, nuts and washers shall be galvanized in accordance with AASHTO M 232 and shall conform to VT. specification 714 unless otherwise noted.
 - Bridge rail posts, special washers, splice bars and plate washers shall conform to AASHTO M 223 / M 223M and shall be galvanized after fabrication in accordance with AASHTO M 111. Prior to galvanizing all corners and edges of steel plates, shapes, etc., shall be ground to a 1/16" radius.
 - See standard drawing G-1 and G-1d for additional details concerning guard rail.
 - See standard drawing SB-R6-82 for approach rail details and for information relative to schedule I and schedule II. All approach rail shall be heavy duty steel beam guard rail. Also see Std. Dwg. SB-R6-82 for handrail details (except end details) if hand rail is required.
 - All posts shall be set normal to grade.
 - Splices for the steel beam guard rail shall lap in the direction of traffic.
 - See Standard drawing G-1 for details of delineators. A delineator shall be located at every fifth post. Payment shall be subsidiary to other items.
 - A railing joint splice shall be provided at each superstructure expansion joint.
 - All field cut or drilled areas shall be coated with zinc rich paint.
 - For radii less than 950 feet, the steel tubing shall be shop bent to fit the applicable curve.
 - The drop-weight tear test in section 732 shall not apply to the structural tubing on this standard.
 - All bolts and related hardware shall conform to AASHTO M164 type 1 bolts, hot dipped or mechanically galvanized per specification.

RECEIVED
 OK'D BY: *[Signature]*
 FEB 11 2004
 RESUBMIT APPROVED: *[Signature]*
 BY: *[Signature]* DATE: 2-17-04

HIGHWAY SAFETY CORP.
 GLASTONBURY, CT

ITEM 525.43 STEEL BRIDGE RAIL - HDSB W/HANDRAIL
 TOWN OF SHELBURNE, CHETTENDEN COUNTY
 BOSTWICK ROAD OVER VERMONT ROAD
 BRIDGE No. 15
 BHO 1445 (30)

GENERAL CONTRACTOR: *[Blank]*
 SUB CONTRACTOR: F.R. LAFAYETTE, INC.

DRAWN: J. Ruiz
 CHECKED: *[Signature]*
 DATE: 1/19/04
 SCALE: NONE
 HSC REFERENCE NO.: 1412
 SIZE: D REVISION: 0
 SHEET NO.: 2 of 2

REVISIONS		
No.	Remarks	Date
0	Initial submittal	1/20/04
1	2 nd submittal	2/11/04