


3+040
READSBORO
 DI LOCATIONS

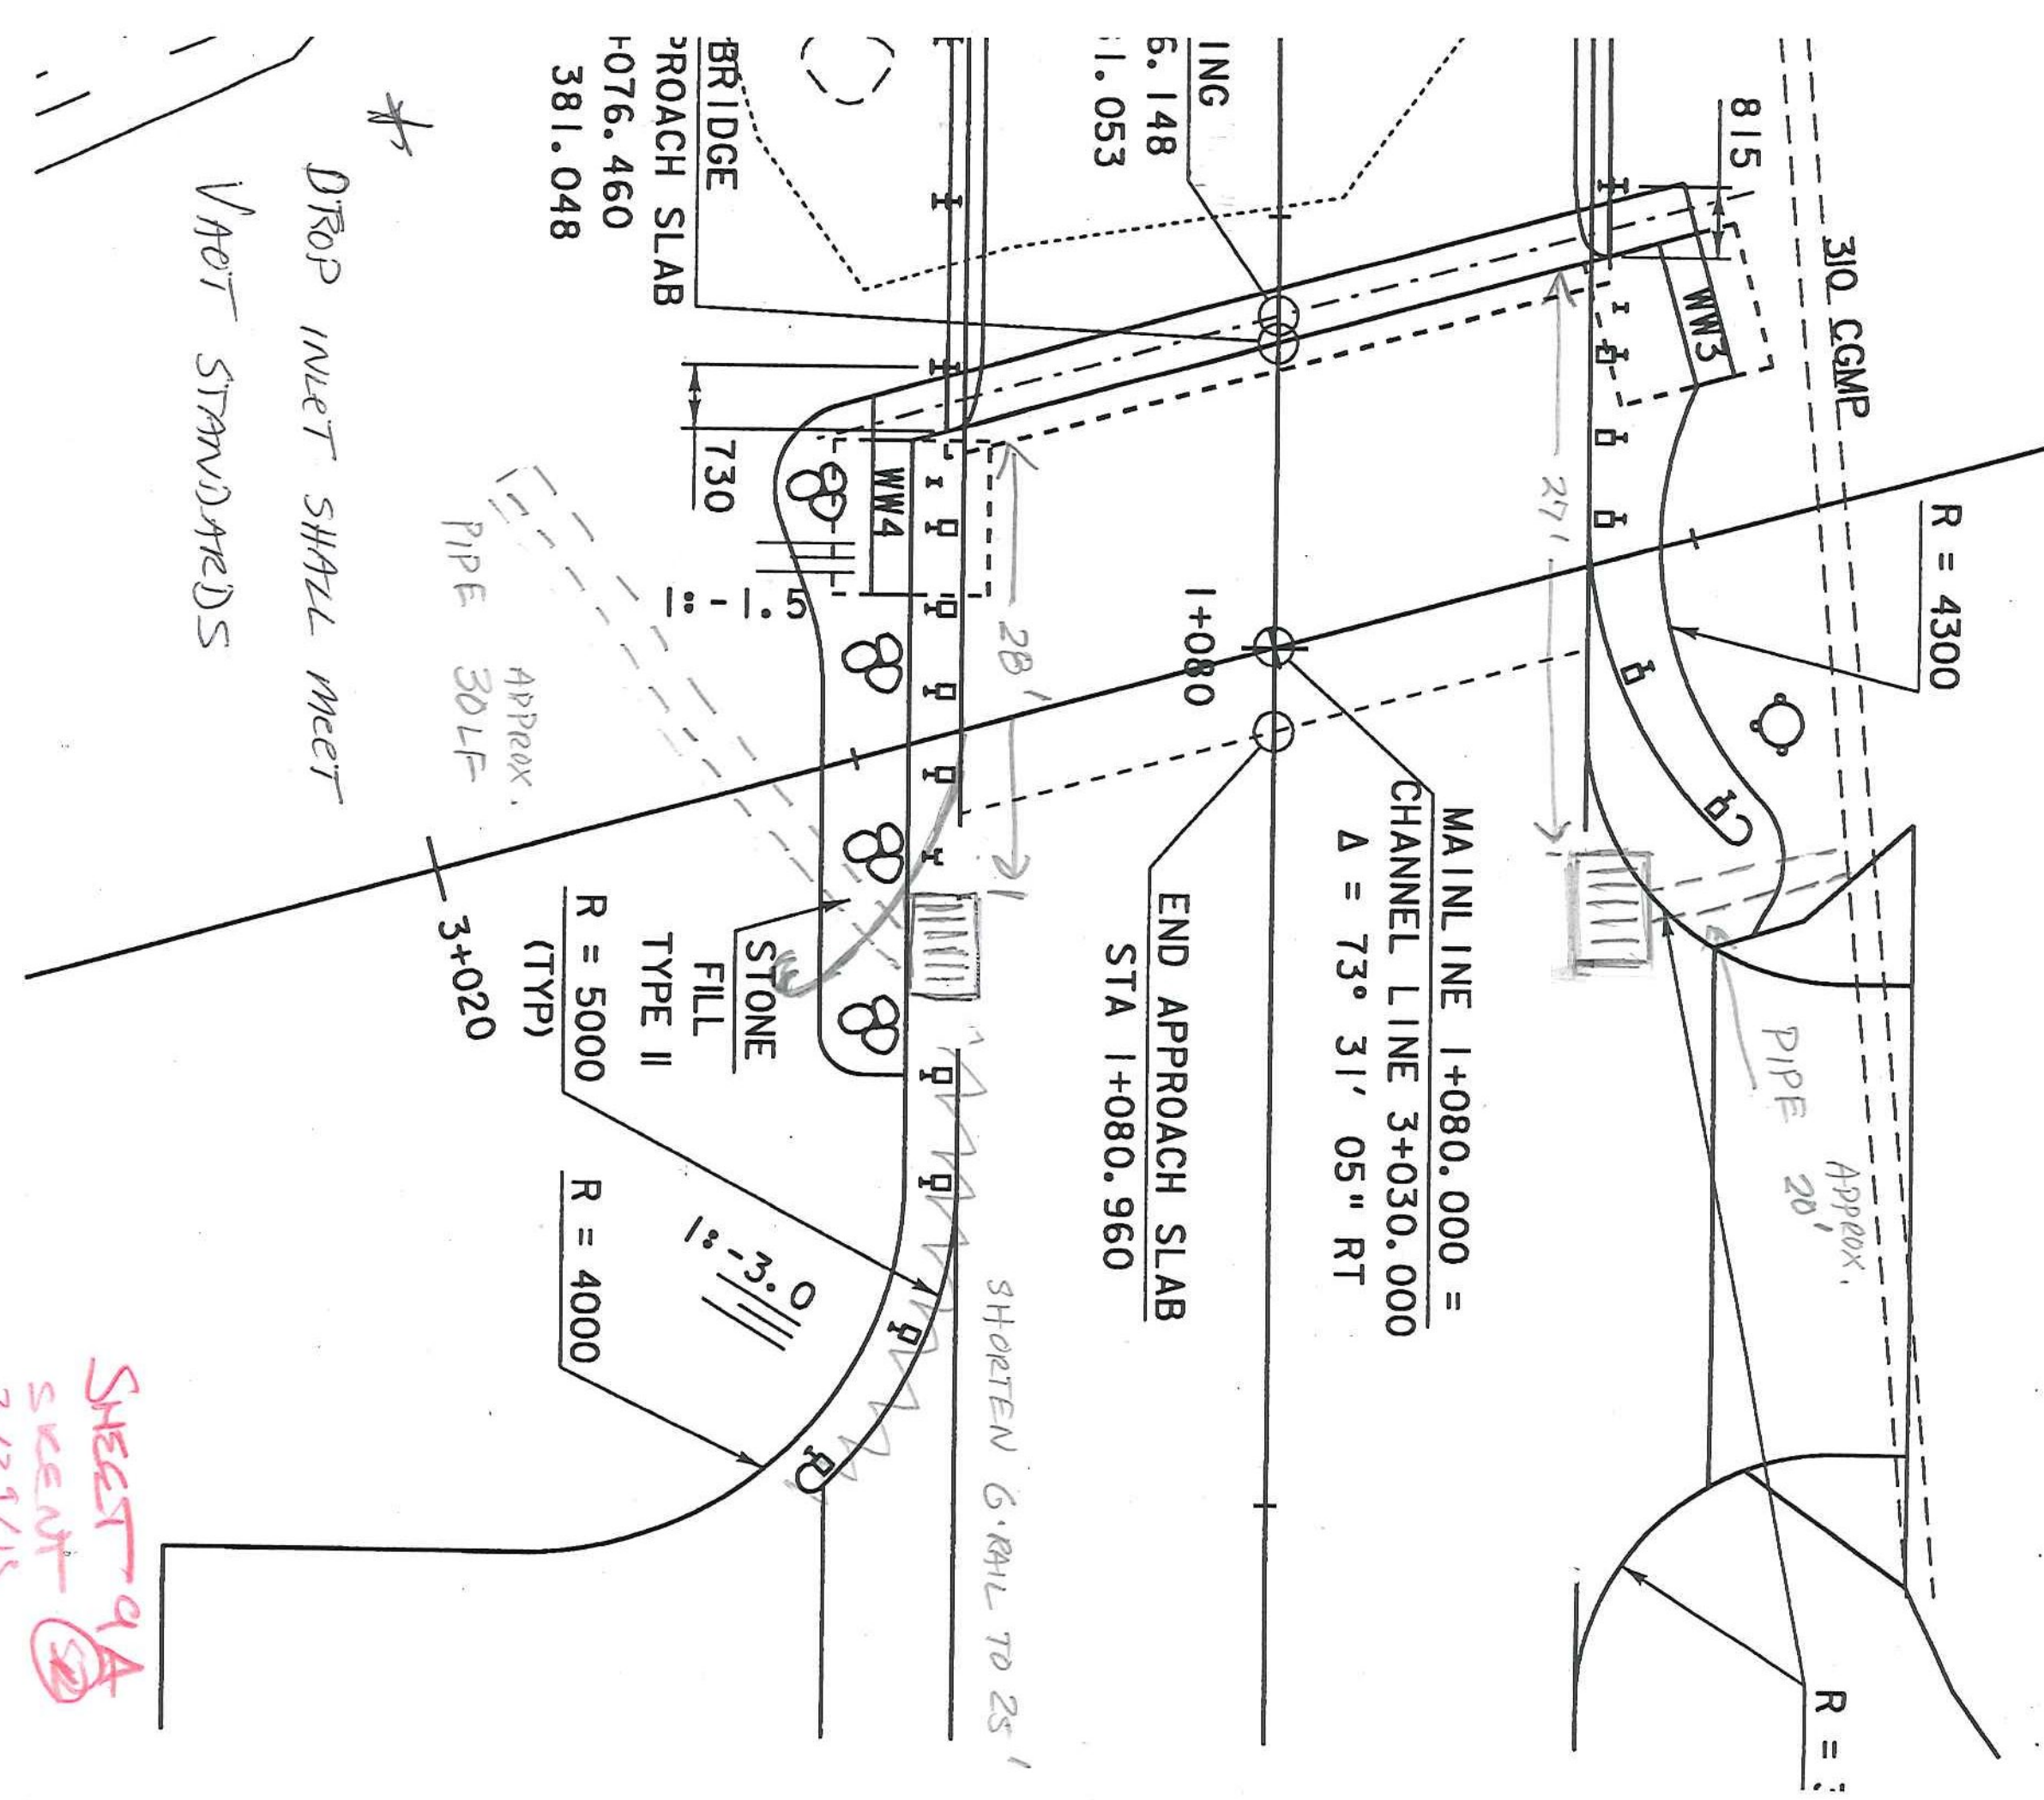

MAINLINE 1+080.000 =
 CHANNEL LINE 3+030.000
 $\Delta = 73^\circ 31' 05''$ RT

ING
 5.148
 1.053

BRIDGE
 APPROACH SLAB
 4076.460
 381.048

END APPROACH SLAB
 STA 1+080.960

STONE
 FILL
 TYPE II
 R = 5000
 (TYP)

STONE
 FILL
 TYPE II
 R = 4000
 (TYP)

* DROP INLET SHALL MEET
 VERT STANDARDS

SHEET 9A
 SHEET
 3/21/15