


BRIDGE APPROACH RAILING AT WINGWALLS 2 AND 3


POST #	SPACING	PAYMENT FACTOR
1	952.5	1.4X1905
2	952.5	
3	1905	1.0
4	(TYP)	(TYP)

PLAN
SCALE 1:100

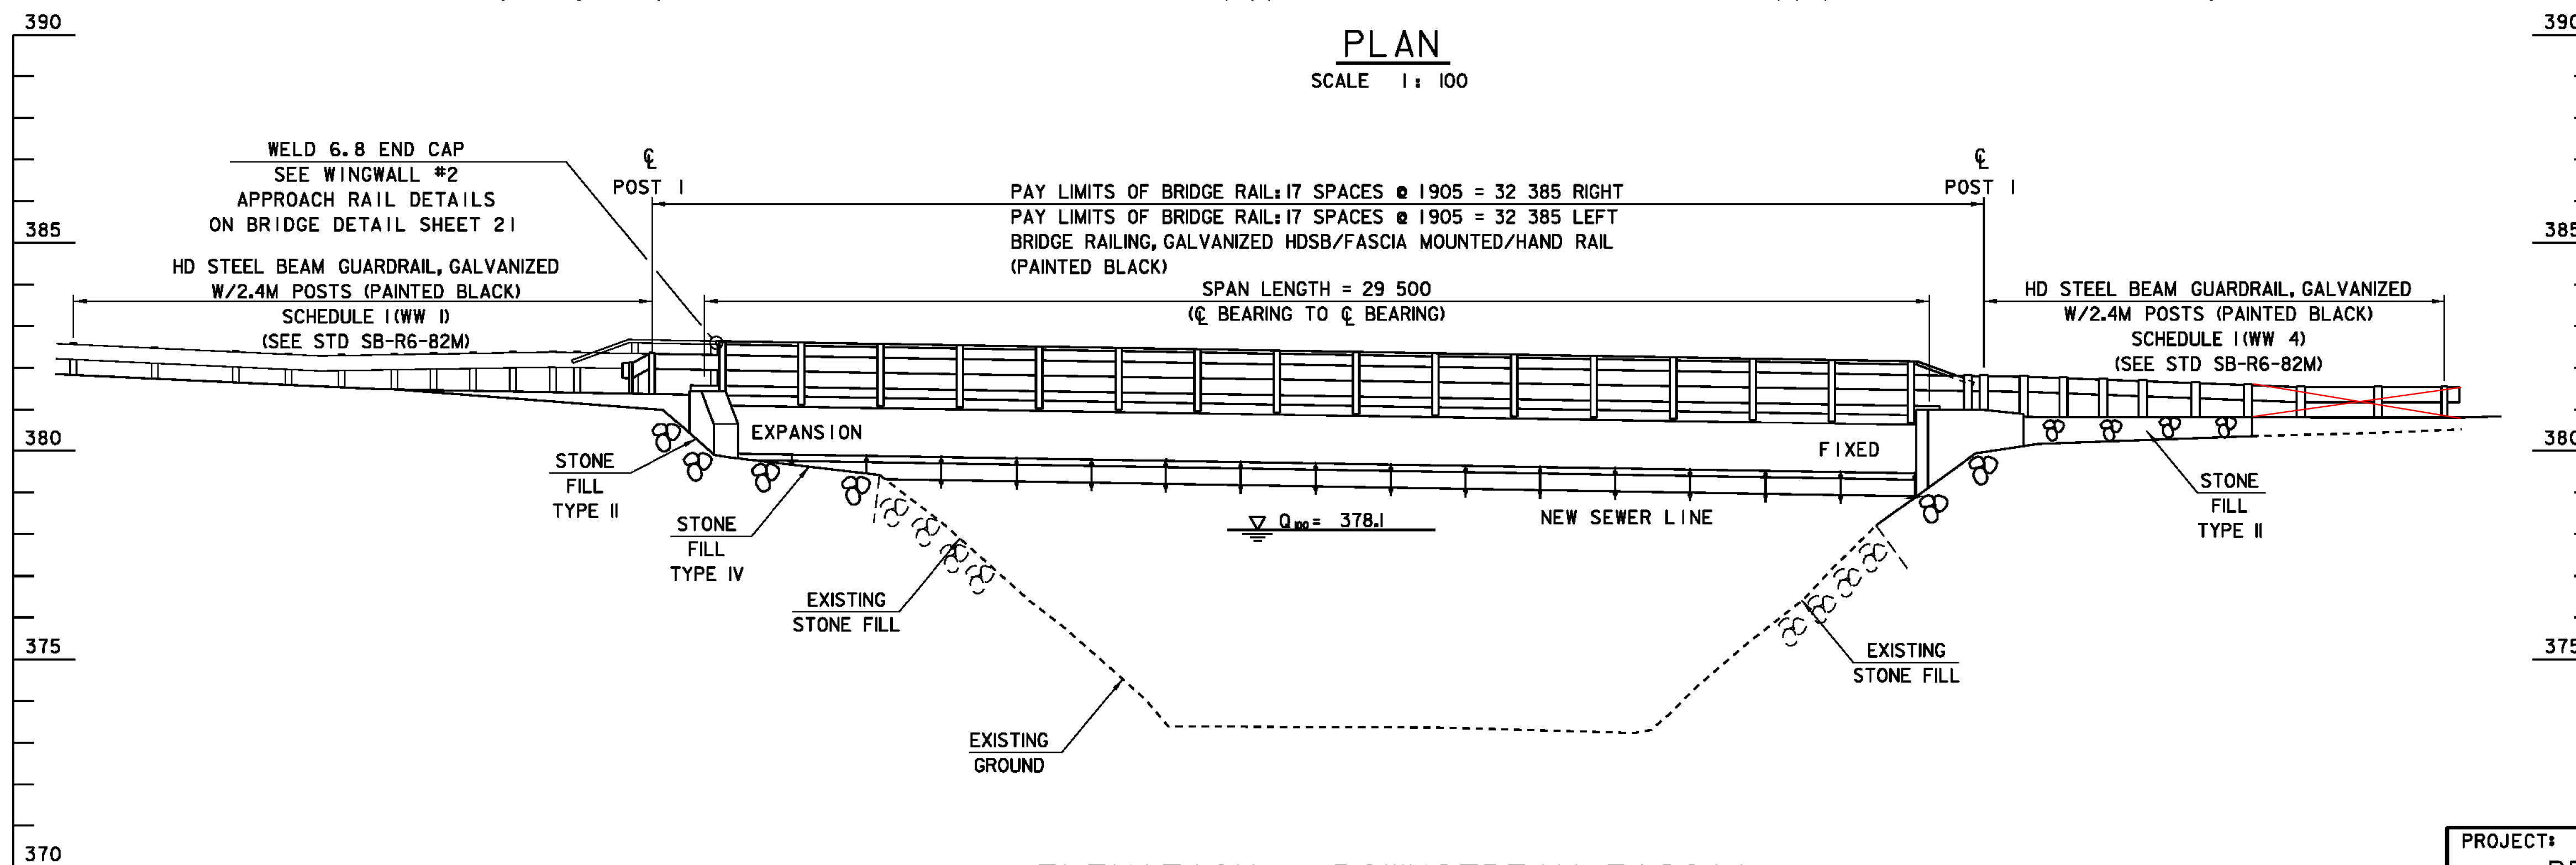

ELEVATION @ DOWNSTREAM FASCIA

SCALE 1:100

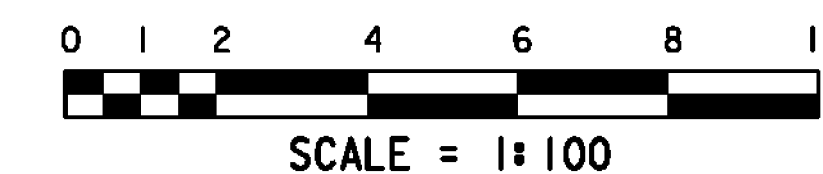

PROJECT: READSBORO	PROJECT NO. # BRO 1441 (25)
DESIGN FILE NAME: 94\070\structures\sj070pe.dgn	PLOT DATE: 05-JAN-2010
IPARM FILE NAME: sj070pe.i	DRAWN BY: H. I. SALLS
DESIGNED BY: H. I. SALLS	CHECKED BY: R. S. YOUNG
SQUAD LEADER: C. P. WILLIAMS	PLAN AND ELEVATION
	SHEET: 17 OF 60