
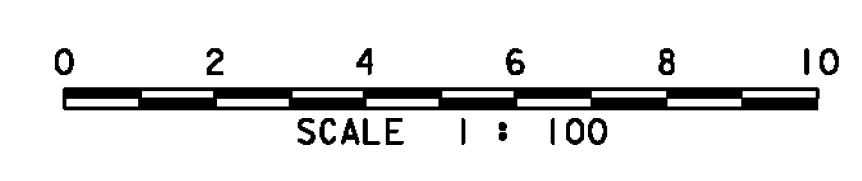
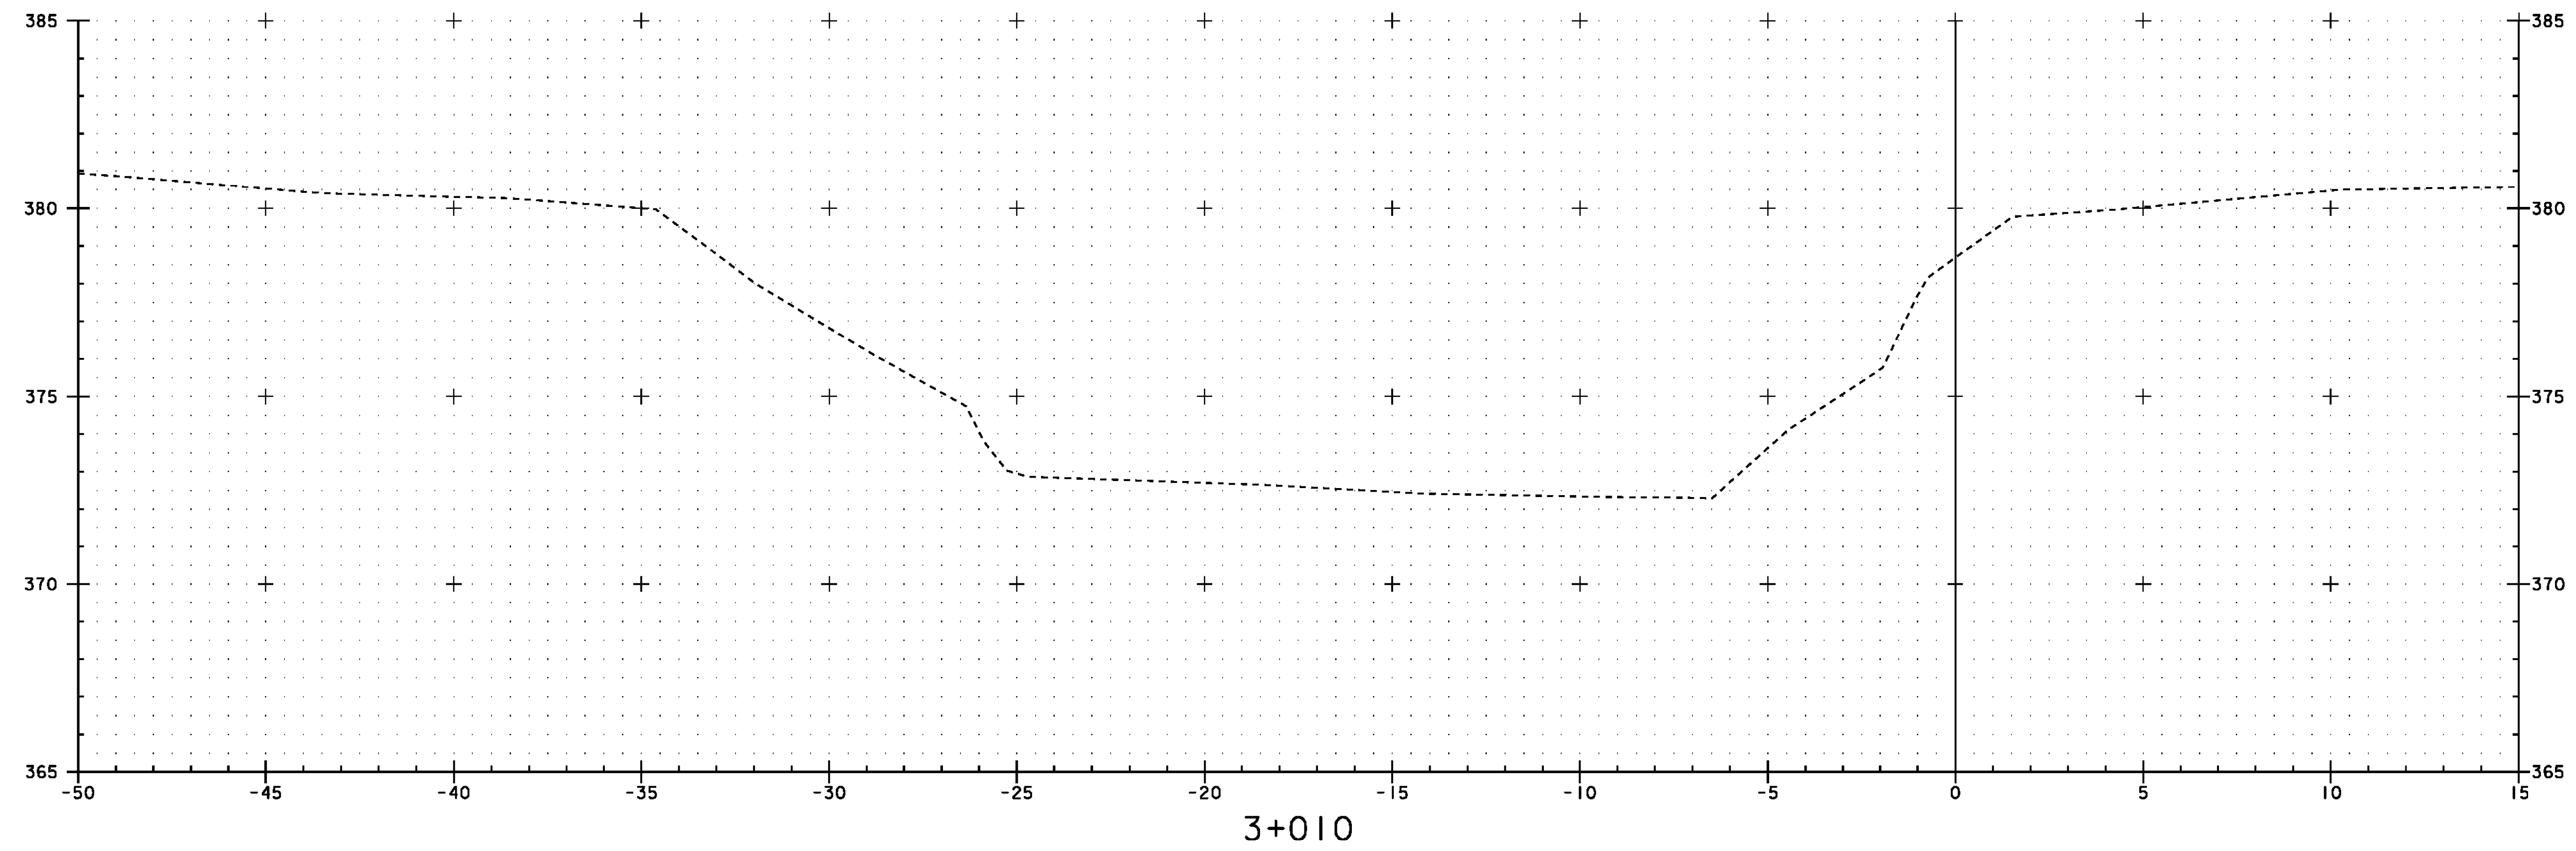


CHANNEL SECTIONS ARE NOW DIFFERENT, CHANNEL WAS MODIFIED BY A FEMA PROJECT
 WINTER OF 2011 AFTER T.S.I. WASHED STONE FILL FROM AROUND THE ABUTMENTS
 (TYP ALL CHANNEL SECTIONS).

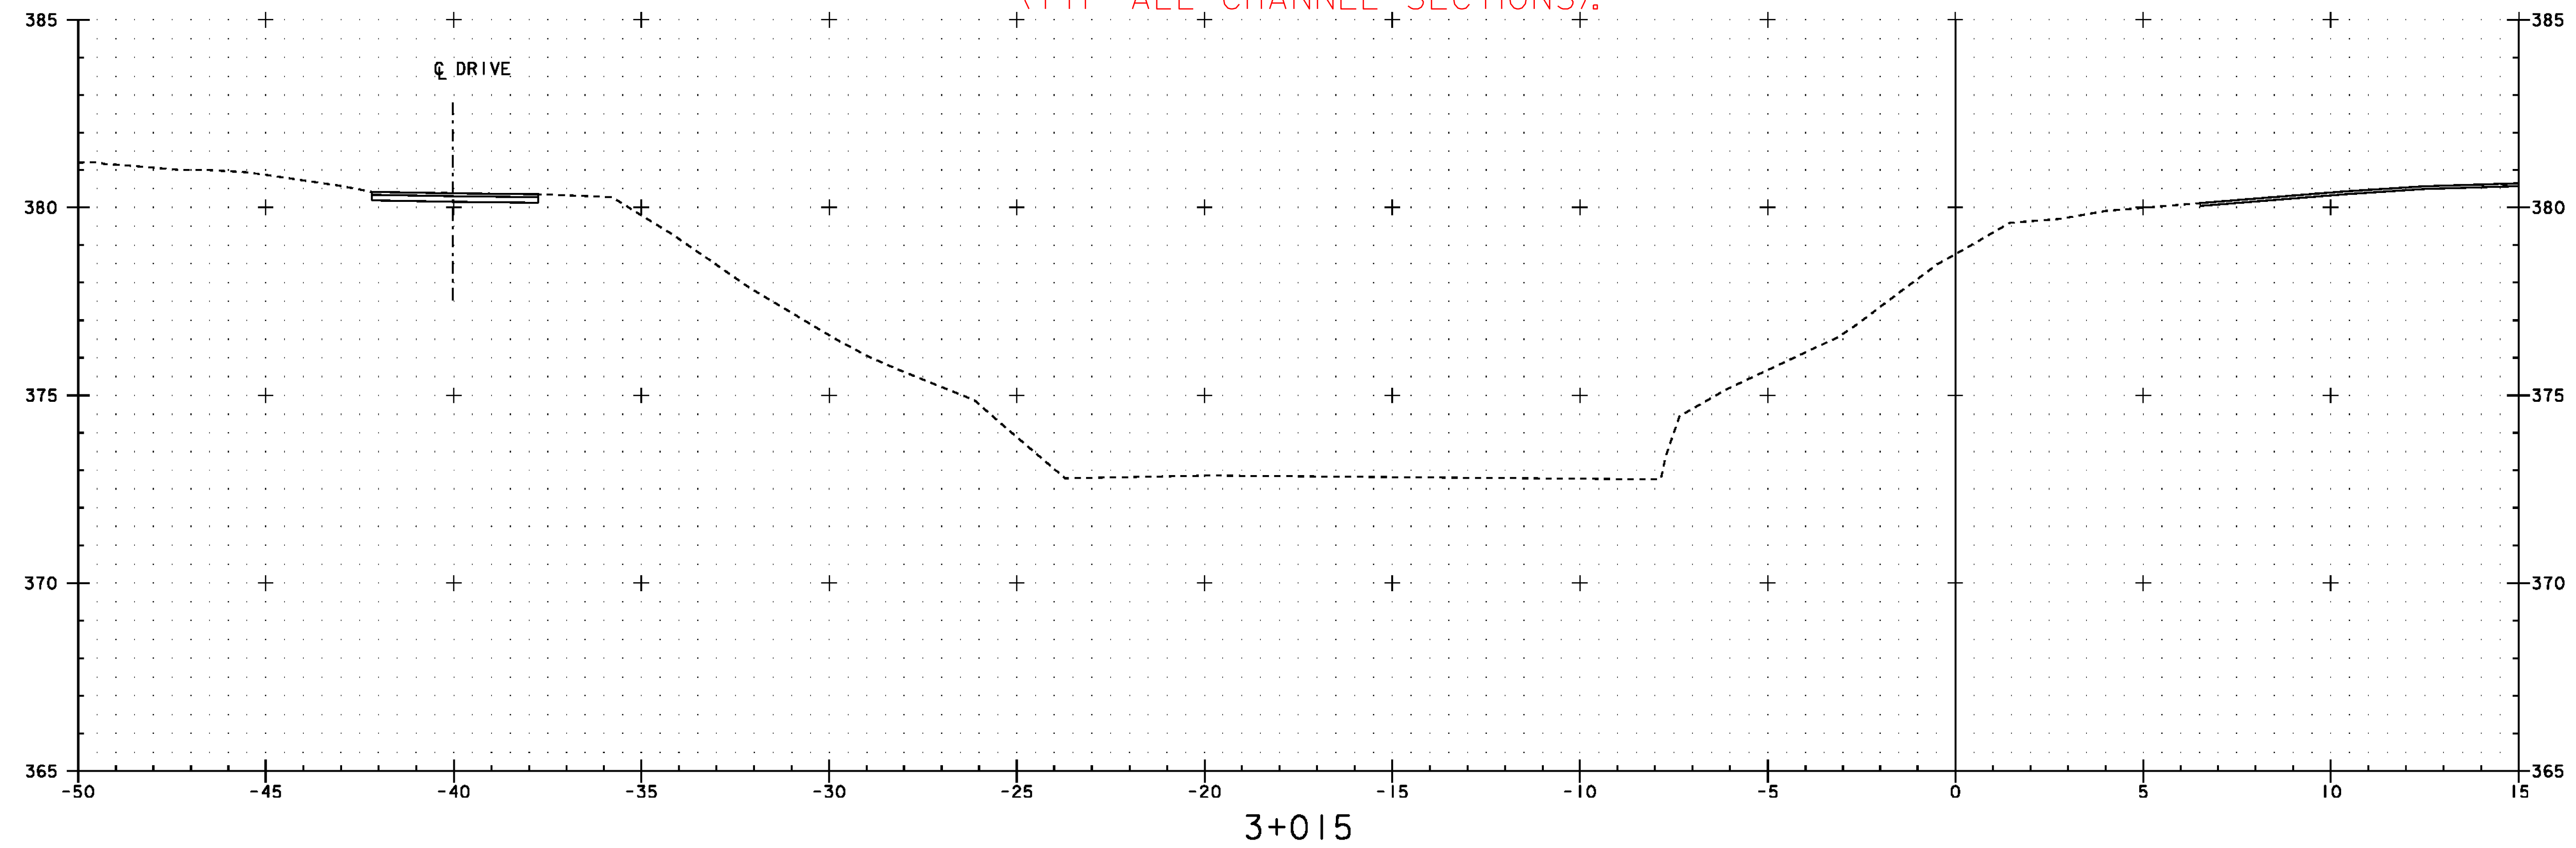

STA 3+010 TO STA 3+015

PROJECT: READSBORO	PROJECT NO. : BRO 1441 (25)
DESIGN FILE NAME: 94\070\Structures\sj070xs.dgn	PLOT DATE: 05-JAN-2010
IPARM FILE NAME: sj070cx2.i	DRAWN BY: H. I. SALLS
DESIGNED BY: H. I. SALLS	CHECKED BY: E. L. RUSTAY
SQUAD LEADER: C. P. WILLIAMS	SHEET: 53 OF 60
CHANNEL CROSS SECTIONS I	