


# STATE OF VERMONT AGENCY OF TRANSPORTATION

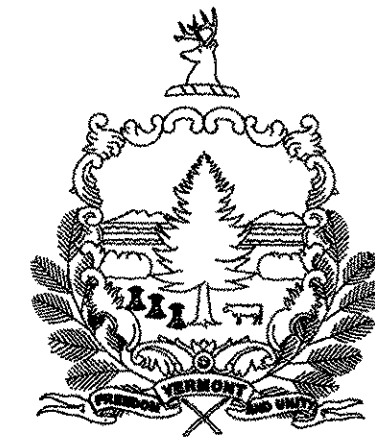

## PROPOSED IMPROVEMENT BRIDGE PROJECT



TOWN OF STAMFORD  
COUNTY OF BENNINGTON

ROUTE NO : T.H. 12, (LOCAL ROAD, CLASS III) - BRIDGE NO. 14


PROJECT LOCATION : BEGINNING AT A POINT ON TH 12 APPROXIMATELY 1.3 KM NORTH- WESTERLY OF THE INTERSECTION OF TH 12 AND VT ROUTE 100 OVER LESURE BROOK.

PROJECT DESCRIPTION : THE PROJECT SHALL CONSIST OF THE REPLACEMENT OF THE EXISTING STRUCTURE WITH RELATED ROADWAY APPROACH AND CHANNEL WORK.

LENGTH OF STRUCTURE = 8.000 METERS  
LENGTH OF ROADWAY = 22.000 METERS  
LENGTH OF PROJECT = 30.000 METERS

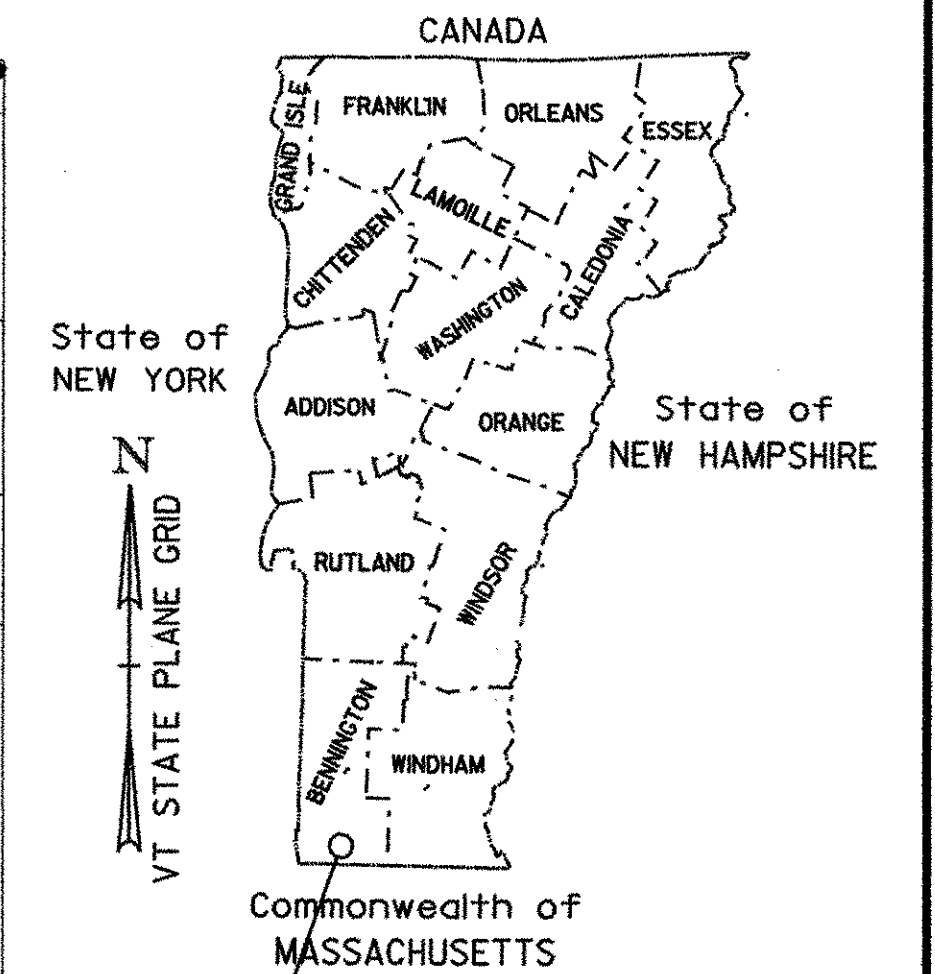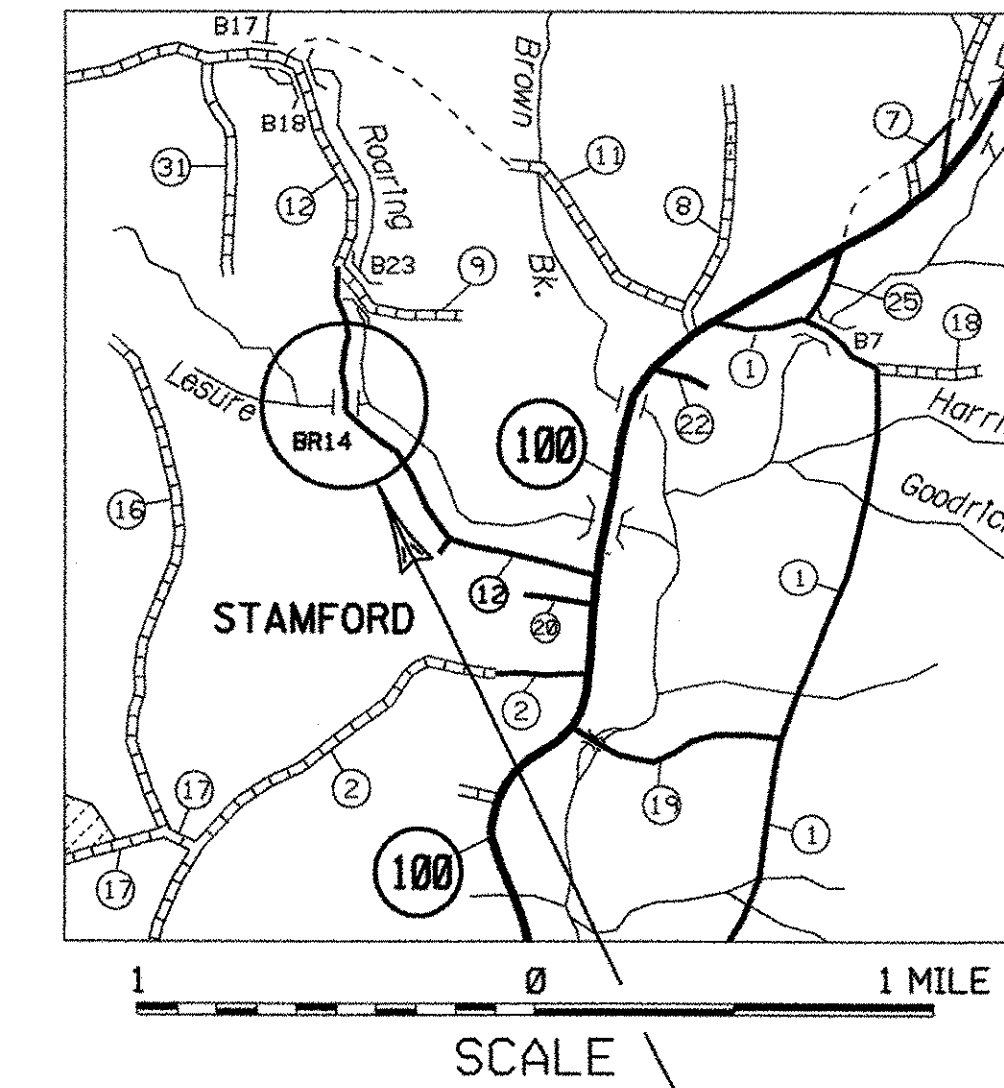


RECORD PLANS	
CONTRACTOR:	KUBRICKY CONSTRUCTION CORP. - GLENS FALLS, NY
RESIDENT ENGINEER:	TIM POCKETTE
CONSTRUCTION BEGAN:	May 6, 2004
CONSTRUCTION COMPLETE:	NOVEMBER 4, 2005
RECORD PLANS BY:	T. POCKETTE & NICK GARBACK
I HEREBY CERTIFY THAT ALL THE CONSTRUCTION REQUIRED BY THIS SET OF DRAWINGS HAS BEEN ACCOMPLISHED AS INDICATED HEREIN.	
BY:	<i>Tim Pockette</i> RESIDENT ENGINEER
DATE:	03-22-2006
NOTE: Any further information concerning final quantities, amounts or other details relative to this project may be found at Central Files in the electronic archives.	

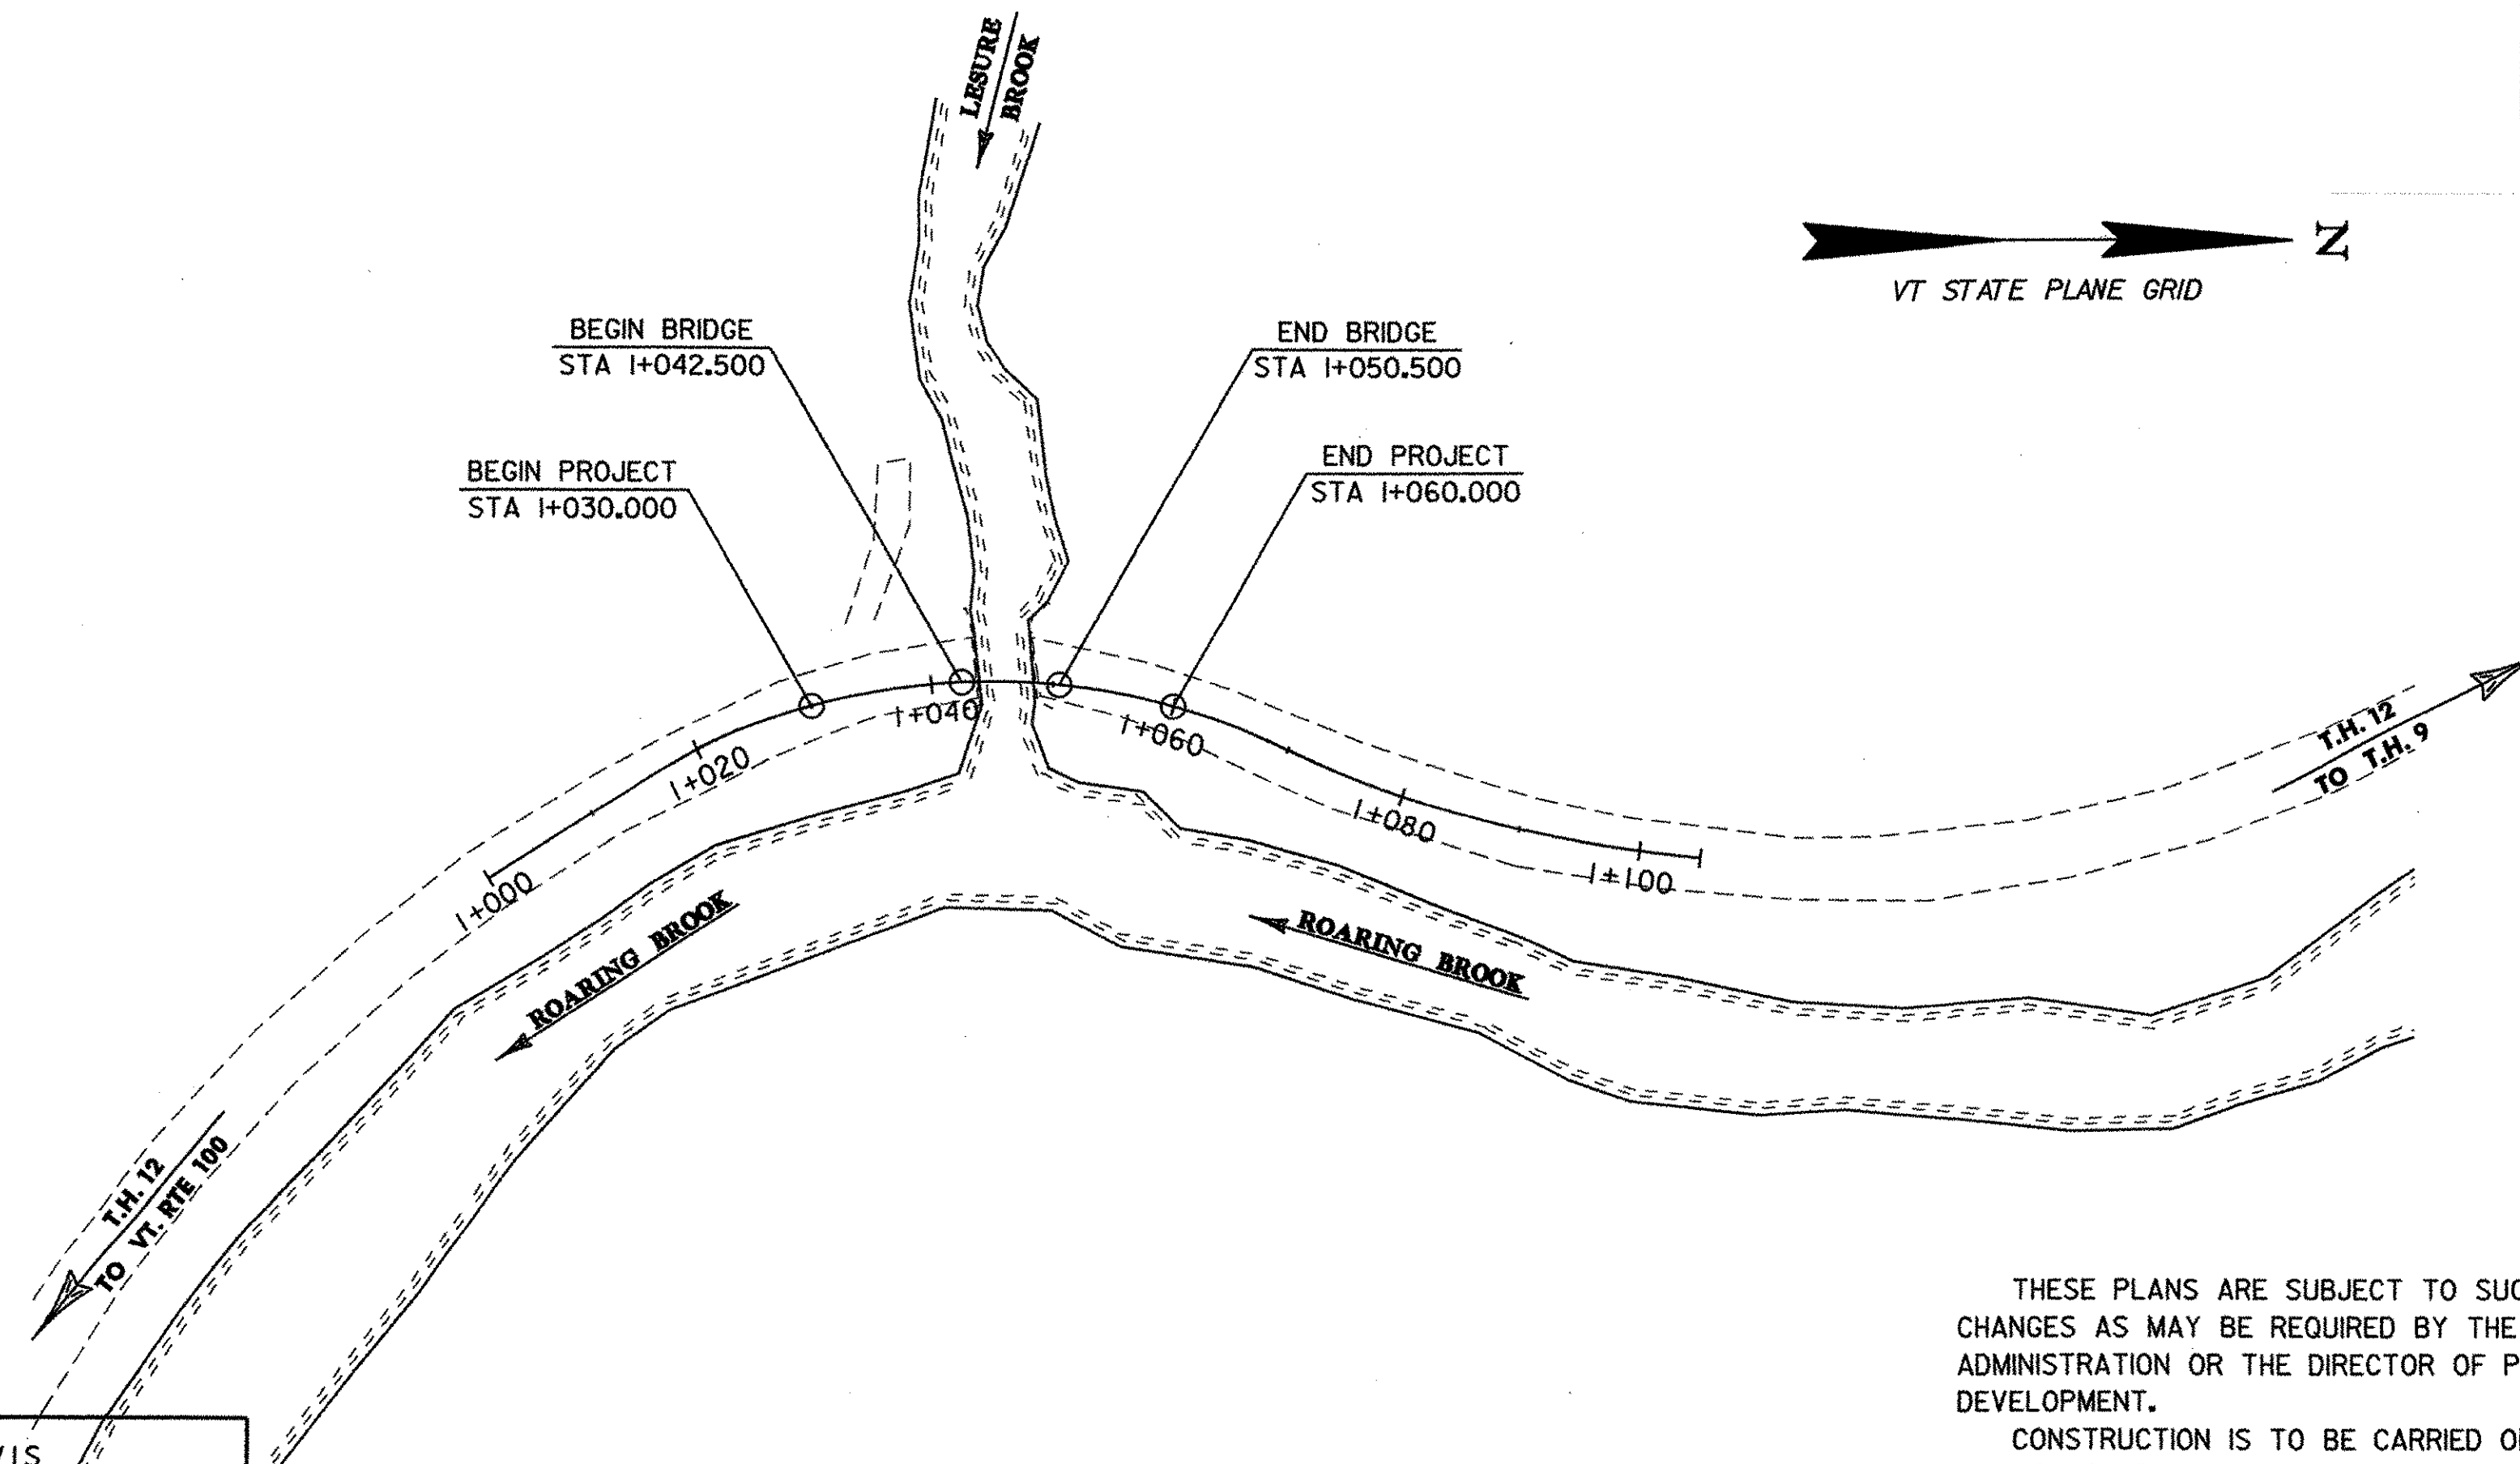

CONVENTIONAL SYMBOLS	
COUNTY LINE	
TOWN LINE	
LIMITS OF ACCESS	
POINT OF ACCESS	
FENCE LINE	
STONE WALL	
TRAVELED WAY	
GUARD RAIL	
RAILROAD	
SURVEY LINE	
CULVERT	
POWER POLE	
TELEPHONE POLE	
TREES	
CONTROL OF ACCESS	
PROPERTY LINE	
R.O.W. TAKING LINE	
SLOPE RIGHTS	
TOP OF CUT	
TOE OF SLOPE	

SURVEYED BY : L. ORVIS  
SURVEYED DATE : FEBRUARY 1995

DATUM  
VERTICAL NAVD 88  
HORIZONTAL NAD 83/92

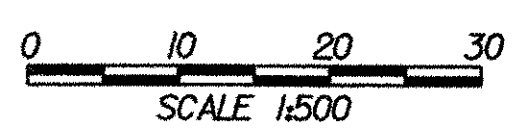

THESE PLANS ARE SUBJECT TO SUCH ENGINEERING CHANGES AS MAY BE REQUIRED BY THE FEDERAL HIGHWAY ADMINISTRATION OR THE DIRECTOR OF PROGRAM DEVELOPMENT.

CONSTRUCTION IS TO BE CARRIED ON IN ACCORDANCE WITH THESE PLANS AND THE STANDARD SPECIFICATIONS FOR CONSTRUCTION DATED 2001, AS APPROVED BY THE FEDERAL HIGHWAY ADMINISTRATION ON JANUARY 4, 2001 FOR USE ON THIS PROJECT, INCLUDING ALL SUBSEQUENT REVISIONS AND SUCH REVISED SPECIFICATIONS AND SPECIAL PROVISIONS AS ARE INCORPORATED IN THESE PLANS.

/str/94j072/sj072bdr.dgn sj072h.l 18-SEP-2003

UNLESS NOTED OTHERWISE  
STATIONS ARE IN KILOMETERS  
ELEVATIONS ARE IN METERS  
DIMENSIONS ARE IN MILLIMETERS

DIRECTOR OF PROGRAM DEVELOPMENT	
APPROVED <i>Gary S. Rogers</i>	DATE 9/19/03
PROJECT MANAGER : <b>GARY S. ROGERS</b>	
PROJECT NAME : <b>STAMFORD</b>	
PROJECT NUMBER : <b>TH3-9411</b>	
SHEET 1 OF 38 SHEETS	