


MAINLINE PROFILE

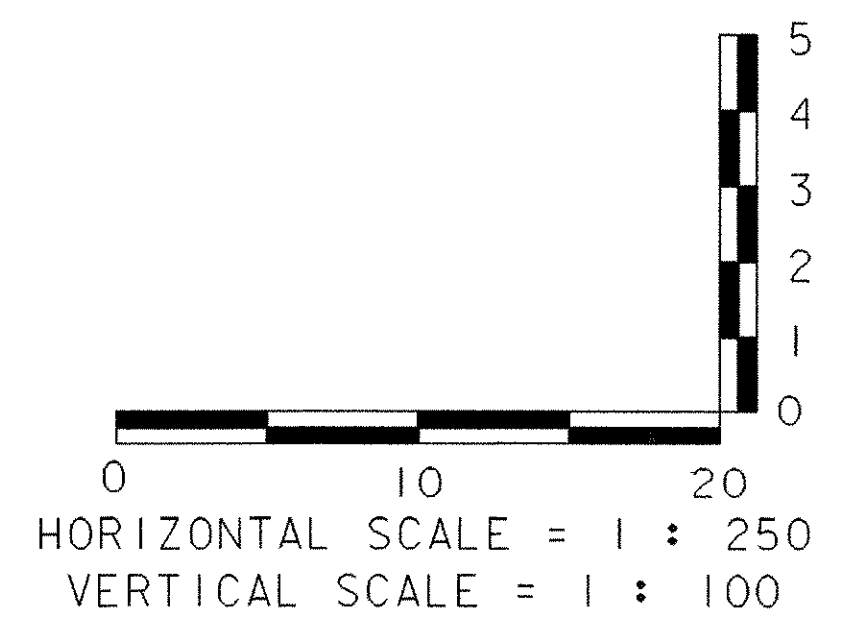

SHEET NAME: MAINLINE PROFILE	
PROJECT NAME: STAMFORD	HIGHWAY NO.: TH 12
PROJECT NUMBER: TH3 94II	BRIDGE NO.: 14
	OVER: LESURE BROOK
FILE NAME: /str1/94j072/sj072xs.dgn	PLOT DATE: 16-OCT-2003
PROJECT MANAGER: G.S. ROGERS	DRAWN BY: K.JPMAL
DESIGNED BY: K. UPMAL	IPARM NAME: sj072mpr.i
BRIDGE SHEET NUMBER:	SHEET 9 OF 38

THE GRADES SHOWN TO THE NEAREST HUNDREDTH ARE THE OLD GROUND ALONG THE CENTERLINE. THE GRADES SHOWN TO THE NEAREST THOUSANDTH ARE THE PROPOSED FINISHED GRADE ALONG THE CENTERLINE.