


NOTES:


SEE SLAB DETAIL SHEET 22 FOR ADDITIONAL INFORMATION REGARDING THE LOCATION OF BRIDGE RAILING ANCHORS ON THE SLAB BRIDGE.

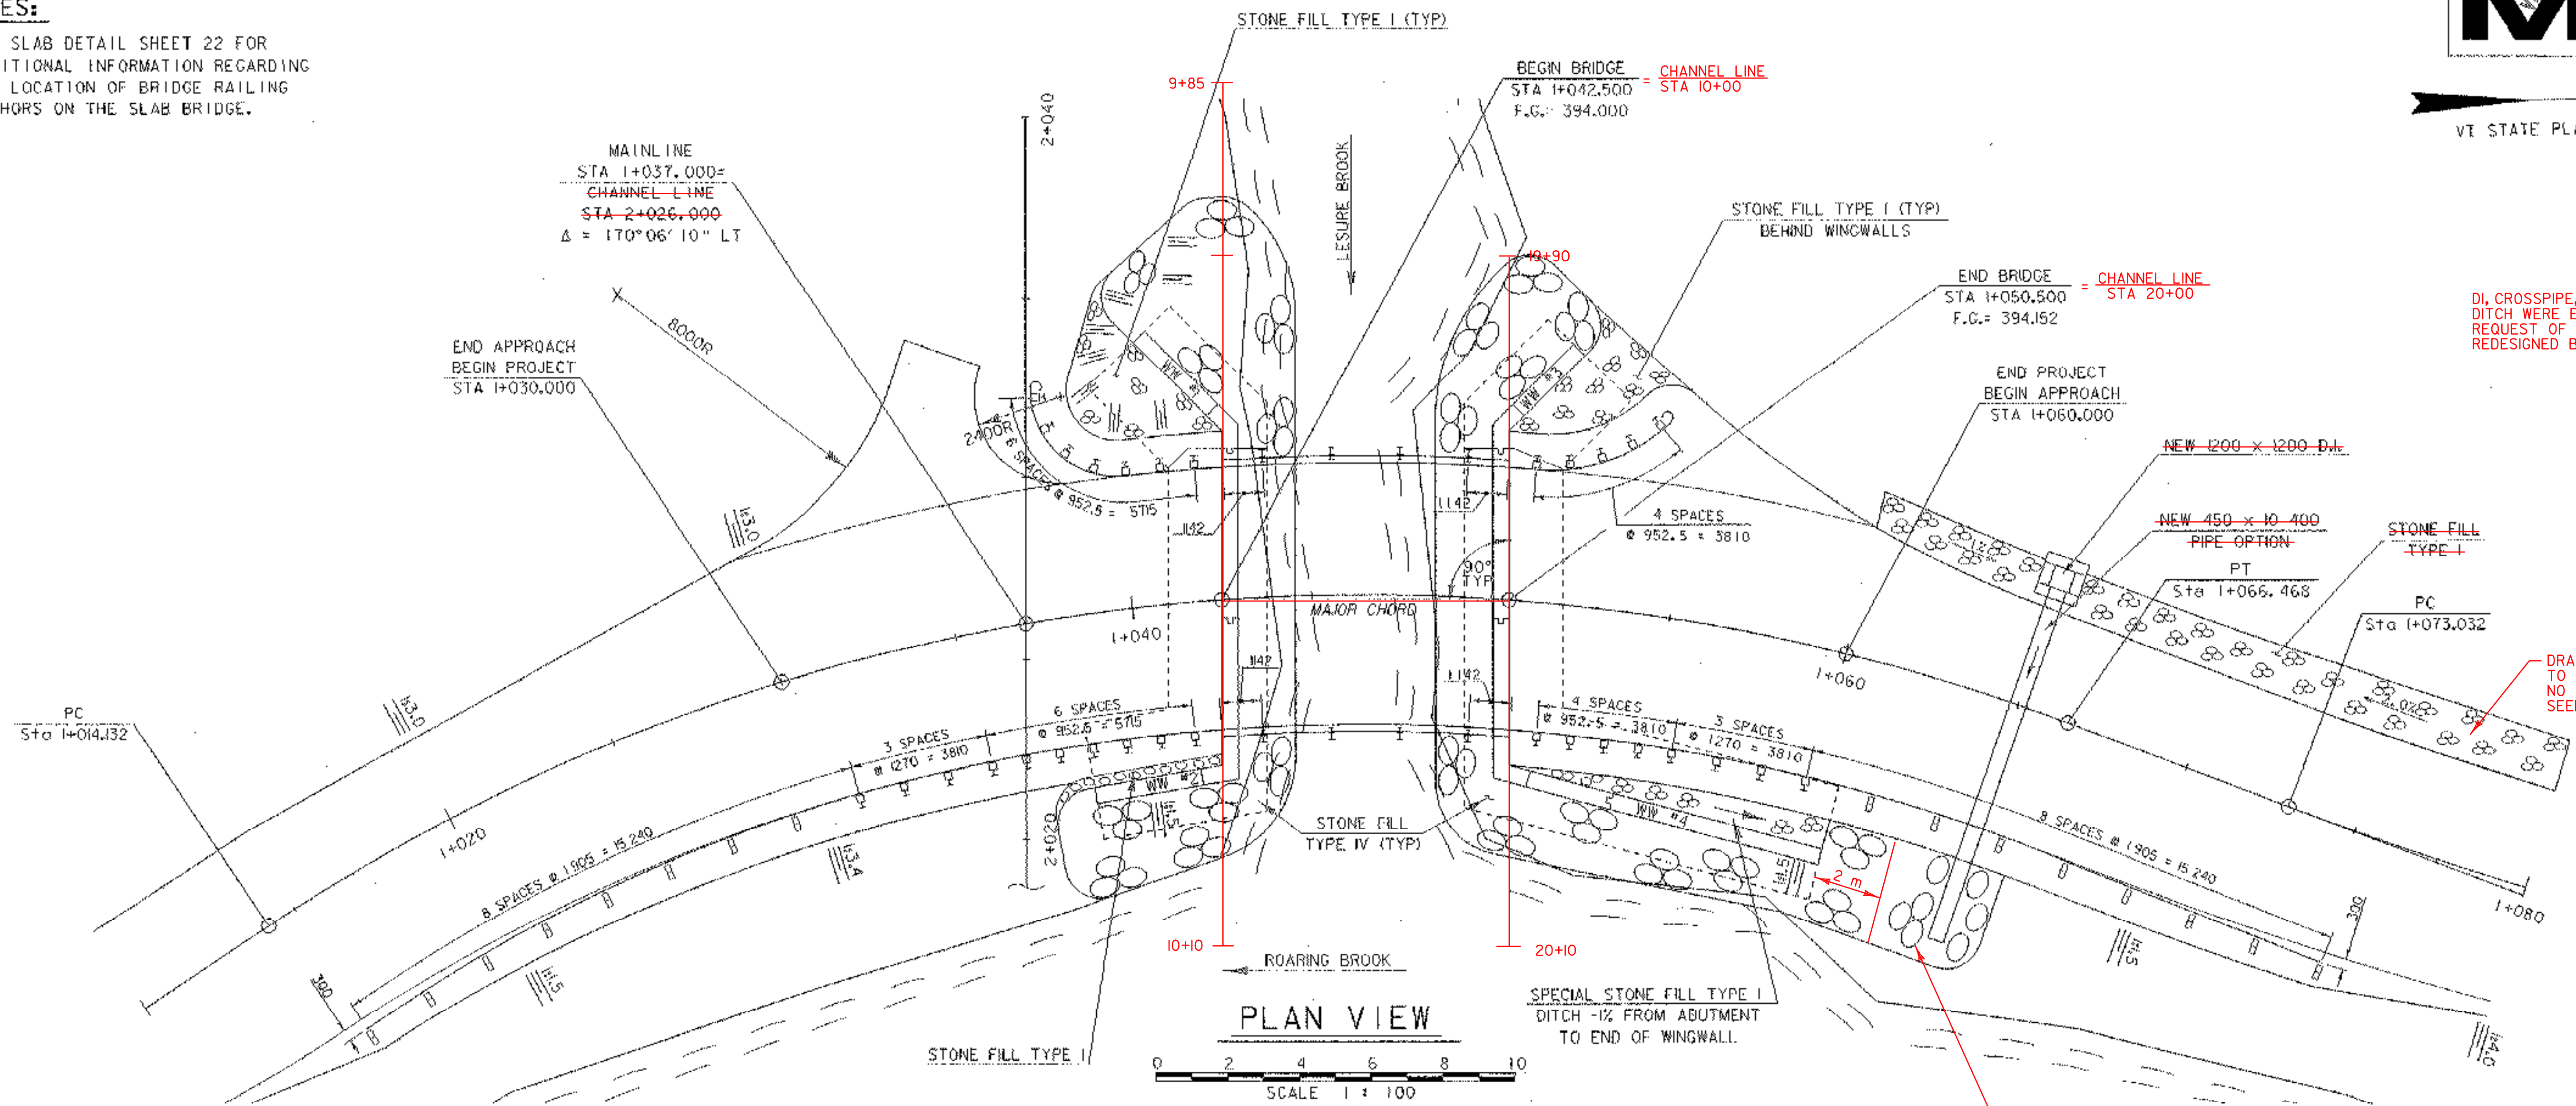

DI, CROSSPIPE, AND STONE LINE DITCH WERE ELIMINATED AT THE REQUEST OF THE TOWN. DITCH REDESIGNED BY ROGER WHITCOMB

DRAINAGE DITCH TO WW#3 NO STONE, JUST TOPSOIL SEED AND MULCH

ORIGINAL GROUND NOT TOUCHED

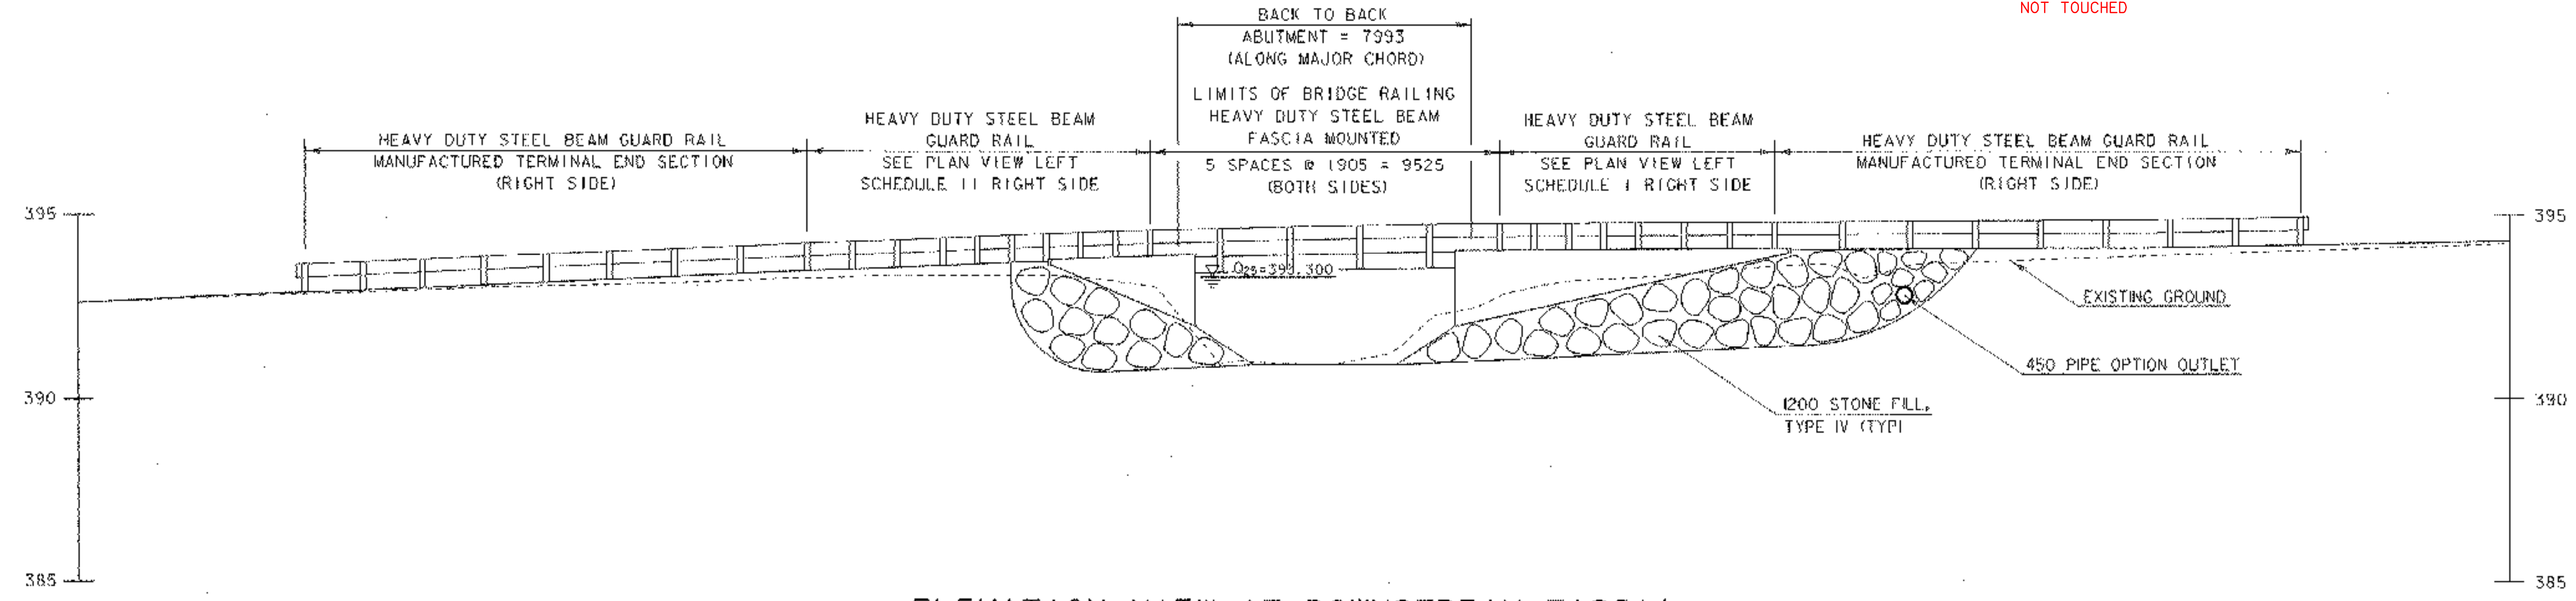

ELEVATION VIEW AT DOWNSTREAM FASCIA

SHEET NAME: PLAN AND ELEVATION		
PROJECT NAME: STAMFORD	HIGHWAY NO.: TH 12	
PROJECT NUMBER: TH3 9411	BRIDGE NO.: 14	OVER: LESURE BROOK
FILE NAME: /s1/94/072/s/072pe.dgn	PLT DATE: 16-OCT-2003	
PROJECT MANAGER: C.S. ROGERS	DRAWN BY: K.UPMAL	
DESIGNED BY: K. UPMAL	IPARM NAME: s/072pe.l	
BRIDGE SHEET NUMBER:	SHEET 13 OF 38	