


DRAINAGE KEYNOTES		
KEYNOTE	LOCATION	DESCRIPTION
①	STATION I+060.000 - I+064.065 LEFT	CONSTRUCT STONE LINED DITCH (STONE FILL, TYPE I)
②	STATION I+064.000 LEFT - I+062.000 RIGHT	REMOVE EXISTING 310 CGMP
③	STATION I+065.000 LEFT	NEW CAST IN PLACE 1200 x 1200 D.I. WITH GRATE TYPE E
④	STATION I+065.000 LEFT - I+065.000 RIGHT	NEW 450 x 10 400 PIPE OPTION
⑤	STATION I+066.200 - I+080 LEFT	CONSTRUCT STONE LINED DITCH (STONE FILL, TYPE I)
⑥	STATION I+050.500 - I+060.755 RIGHT	CONSTRUCT -1/2 DITCH FROM ABUTMENT TO END OF WINGWALL #4

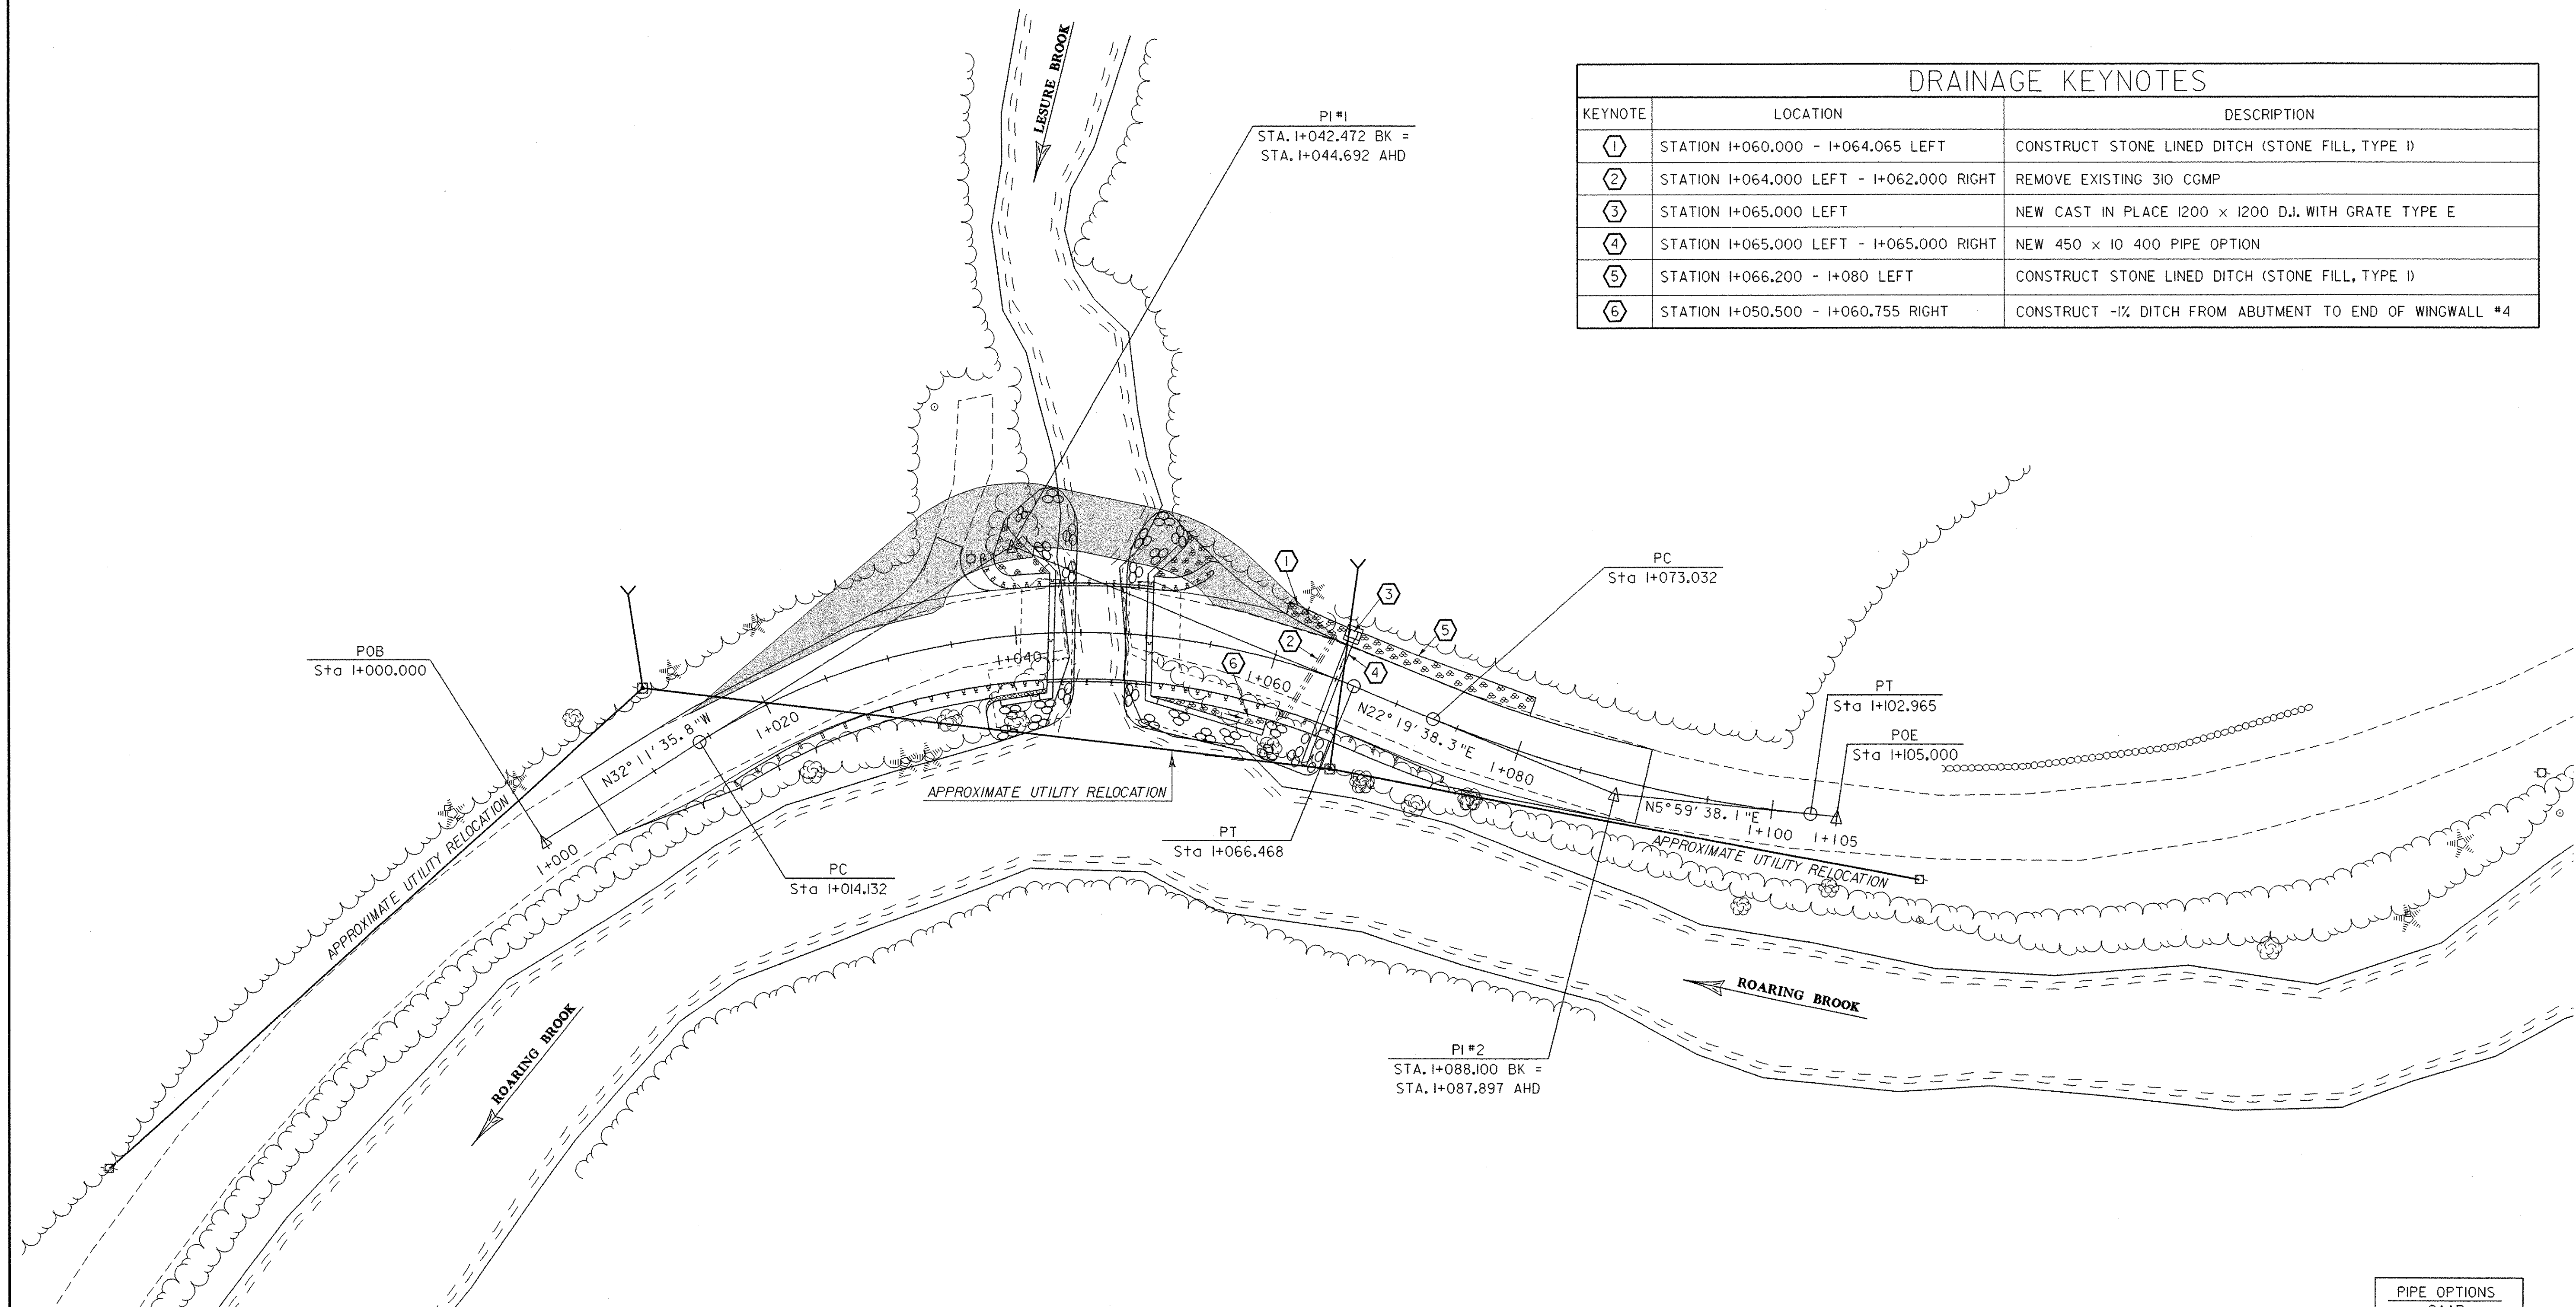

PIPE OPTIONS
CAAP
CPEP
CSP



SHEET NAME: DRAINAGE AND UTILITIES		
PROJECT NAME: STAMFORD	HIGHWAY NO.: TH 12	
PROJECT NUMBER: TH3 9411	BRIDGE NO.: 14	
	OVER: LESURE BROOK	
FILE NAME: /str/194j072/sj072du.dgn	PLOT DATE: 16-OCT-2003	
PROJECT MANAGER: G.S. ROGERS	DRAWN BY: J. GILMORE	
DESIGNED BY: K. UPMAL	IPARM NAME: sj072du.i	
BRIDGE SHEET NUMBER:	SHEET 18 OF 38	