


GRANULE BACKFILL FOR STRUCTURES

$$4.3m \times \left(\frac{3.1 + 2.8}{2} \right) = 13.12 \text{ SM} \checkmark$$

03+2.8
2/25/05

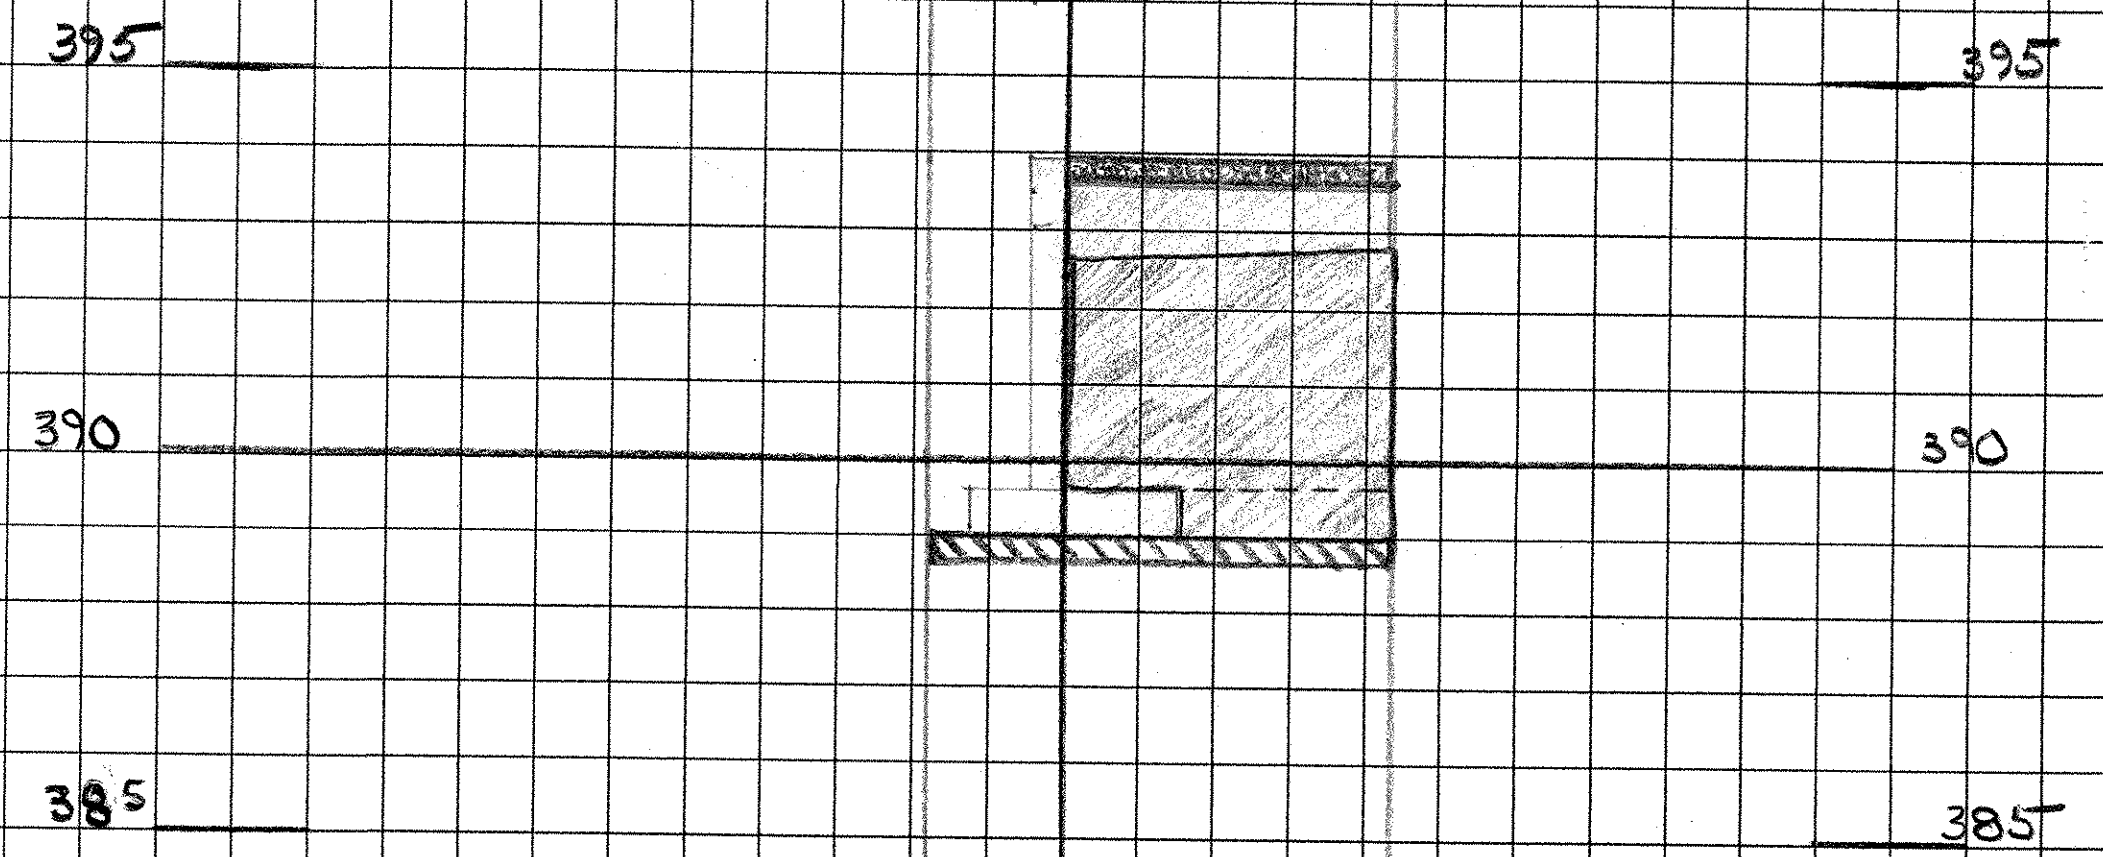

10 + 004.6