


BEGIN VT 30 APPROACH  
 STA 311+010  
 MATCH EXISTING

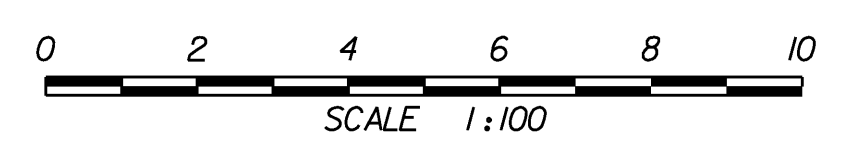

VT 30

ROADWAY CROSS SECTION FROM STA 311+010	TO STA 311+040
PROJECT NAME	DUMMERSTON
PROJECT NO.	BHO 1442 (28)
SURVEYED BY	VAOT 8/98
SHEET	36 OF 49

VANASSE HANGEN BRUSTLIN, INC.