


VT 30 MATERIAL TRANSITION DETAIL
NOT TO SCALE

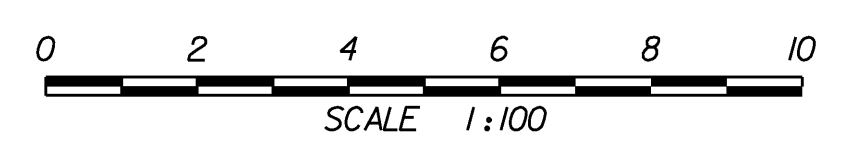

VT 30

ROADWAY CROSS SECTION FROM STA 311+060 TO STA 311+080
PROJECT NAME DUMMERSTON
PROJECT NO. BHO 1442 (28)
SURVEYED BY VAOT 8/98
SHEET 37 OF 49

VANASSE HANGEN BRUSTLIN, INC.