



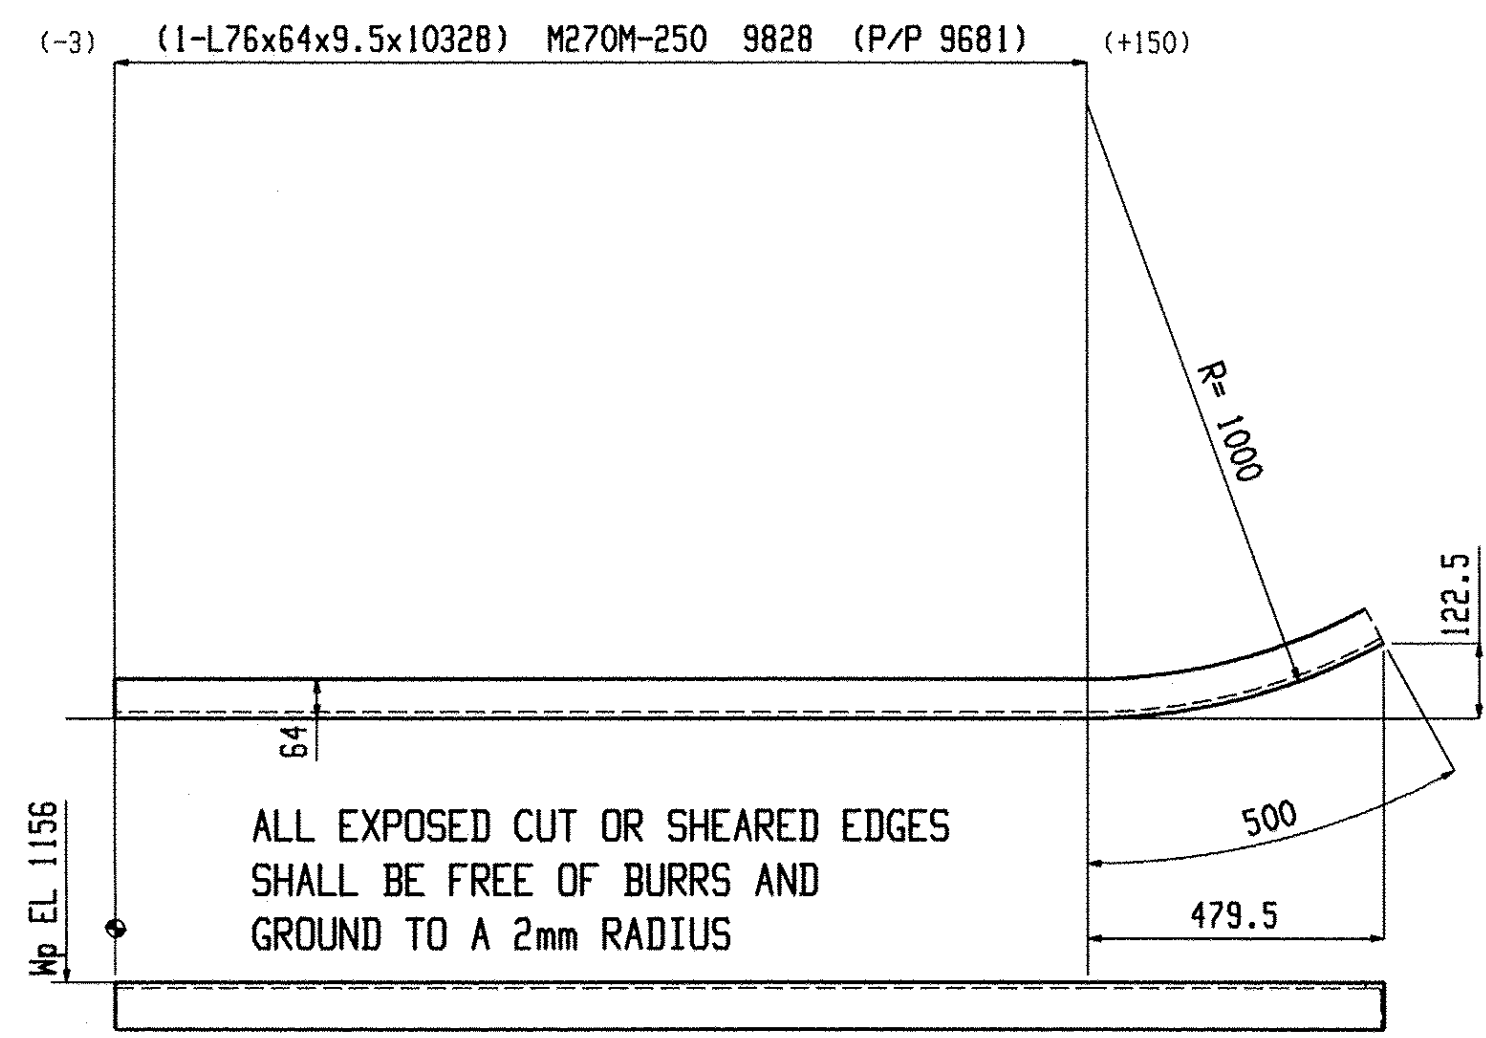


ONE BEAM R32

SHOP NOTE:
TOE DIRECTION FAR SIDE

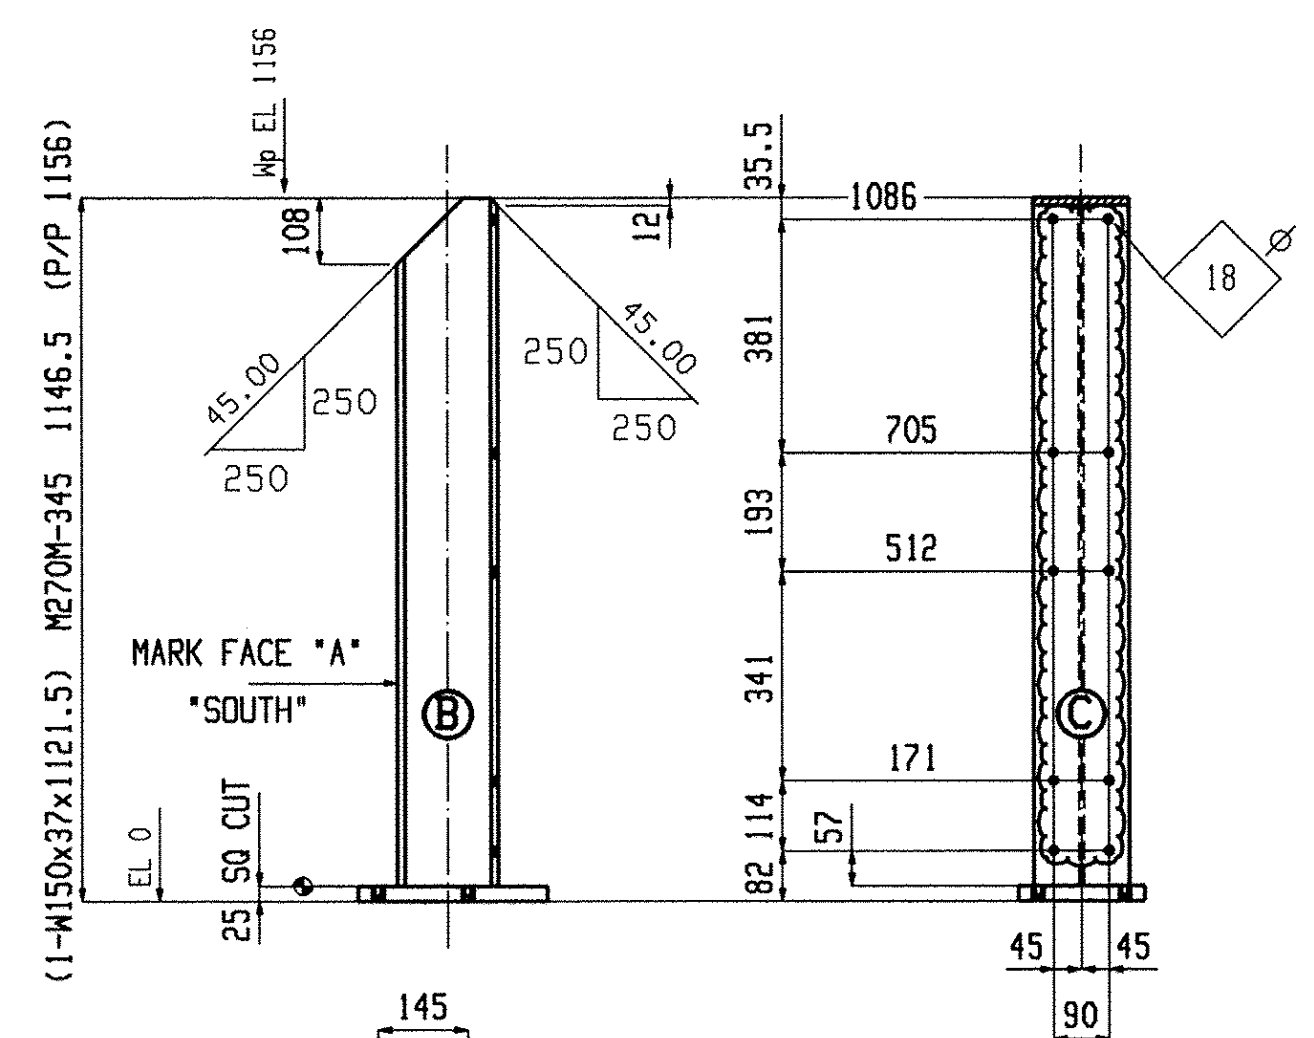


24 COLUMNS C1

W 162x8
F 154.5x11.5
K 20.5x13

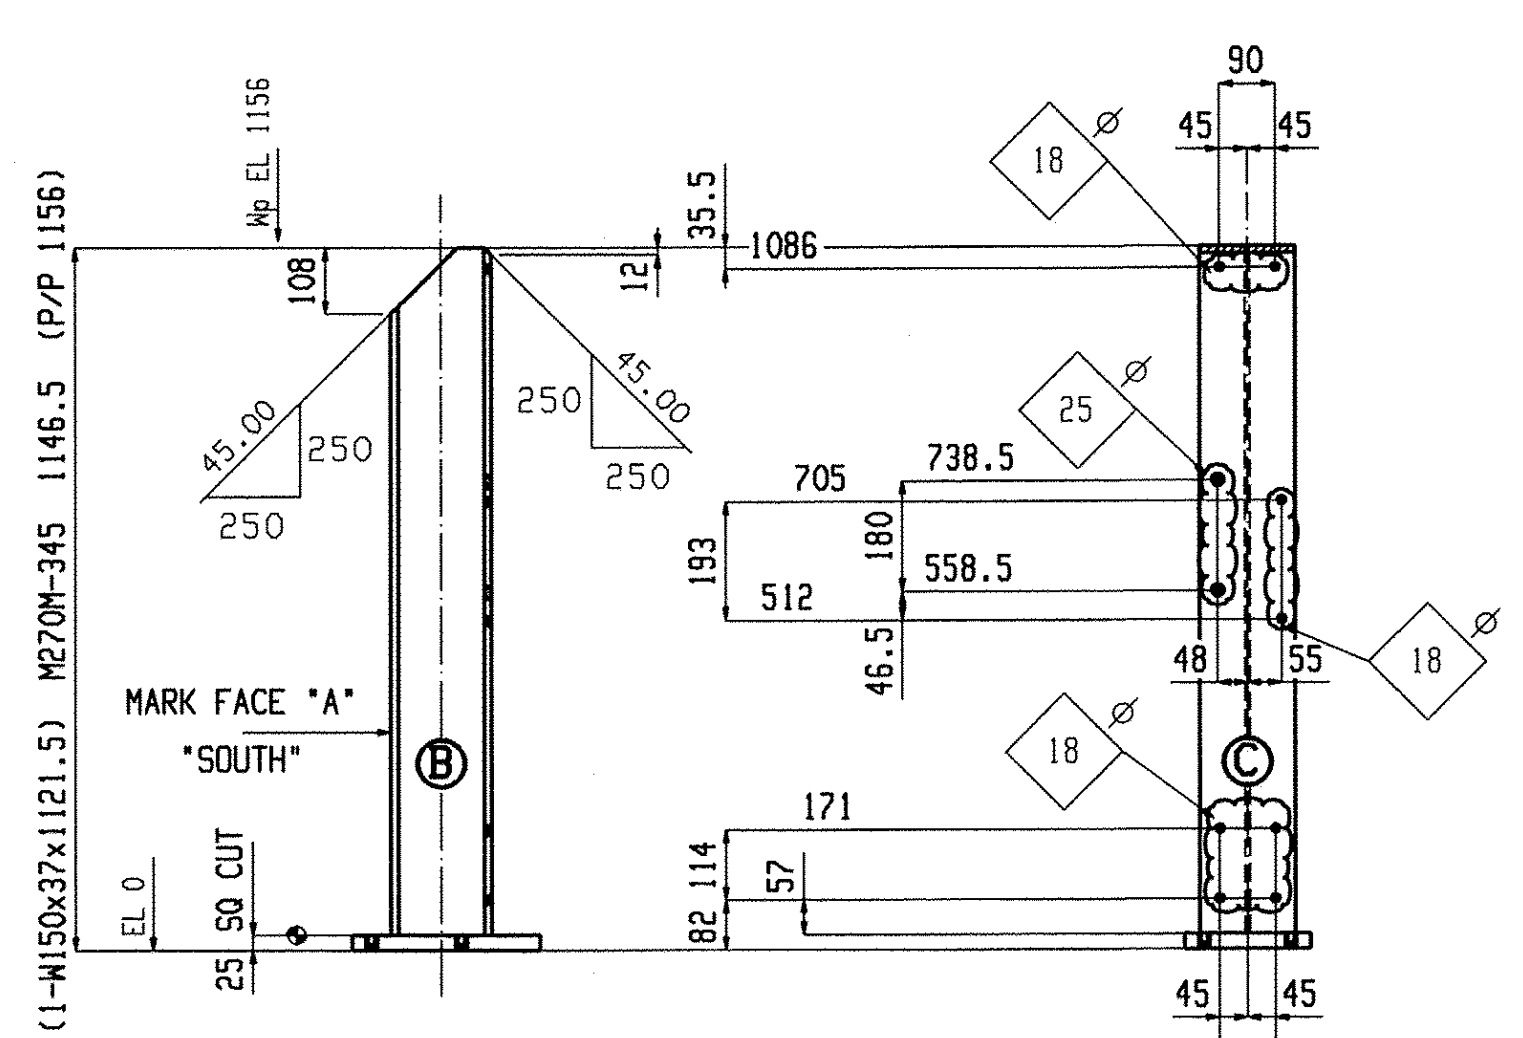


ONE COLUMN C2

W 162x8
F 154.5x11.5
K 20.5x13

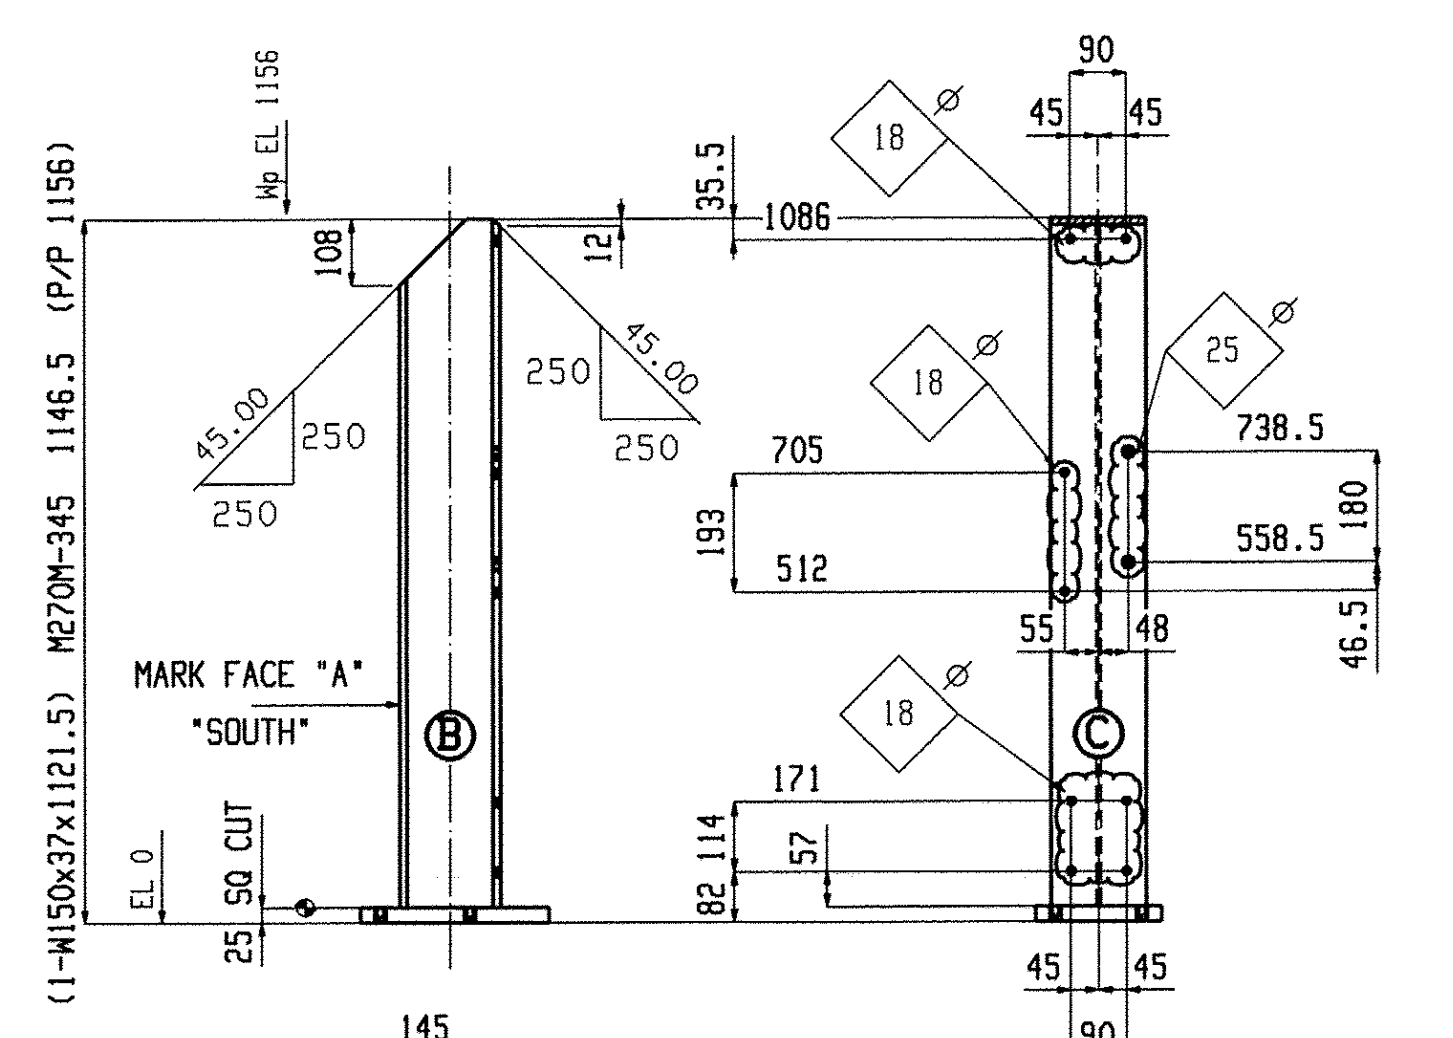


ONE COLUMN C3

W 162x8
F 154.5x11.5
K 20.5x13

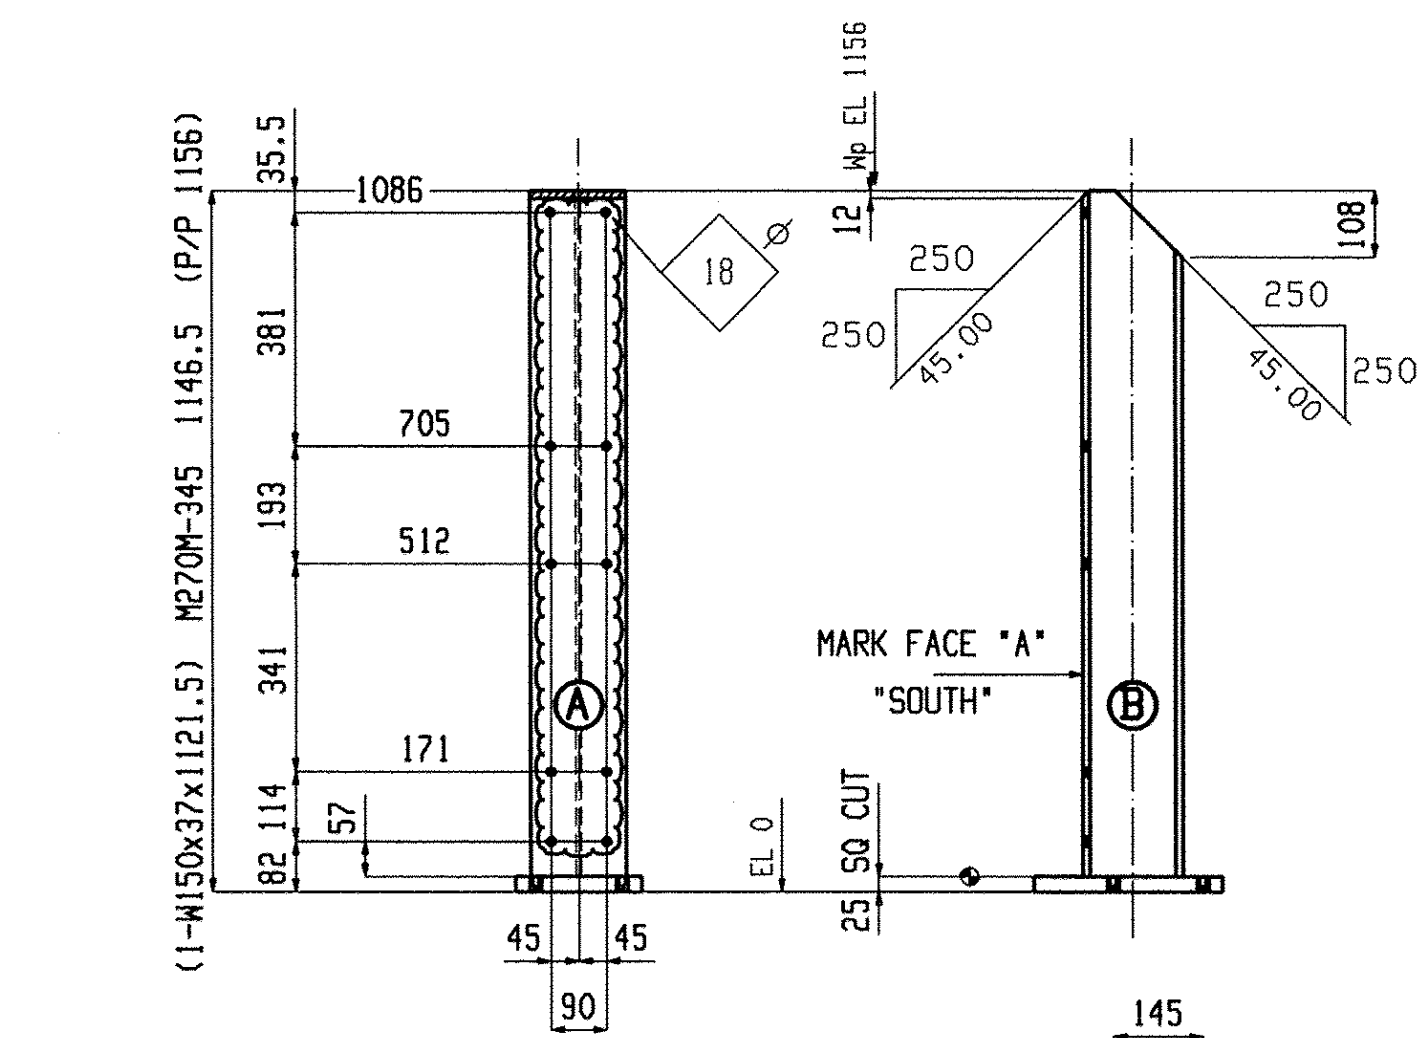


24 COLUMNS C4

W 162x8
F 154.5x11.5
K 20.5x13

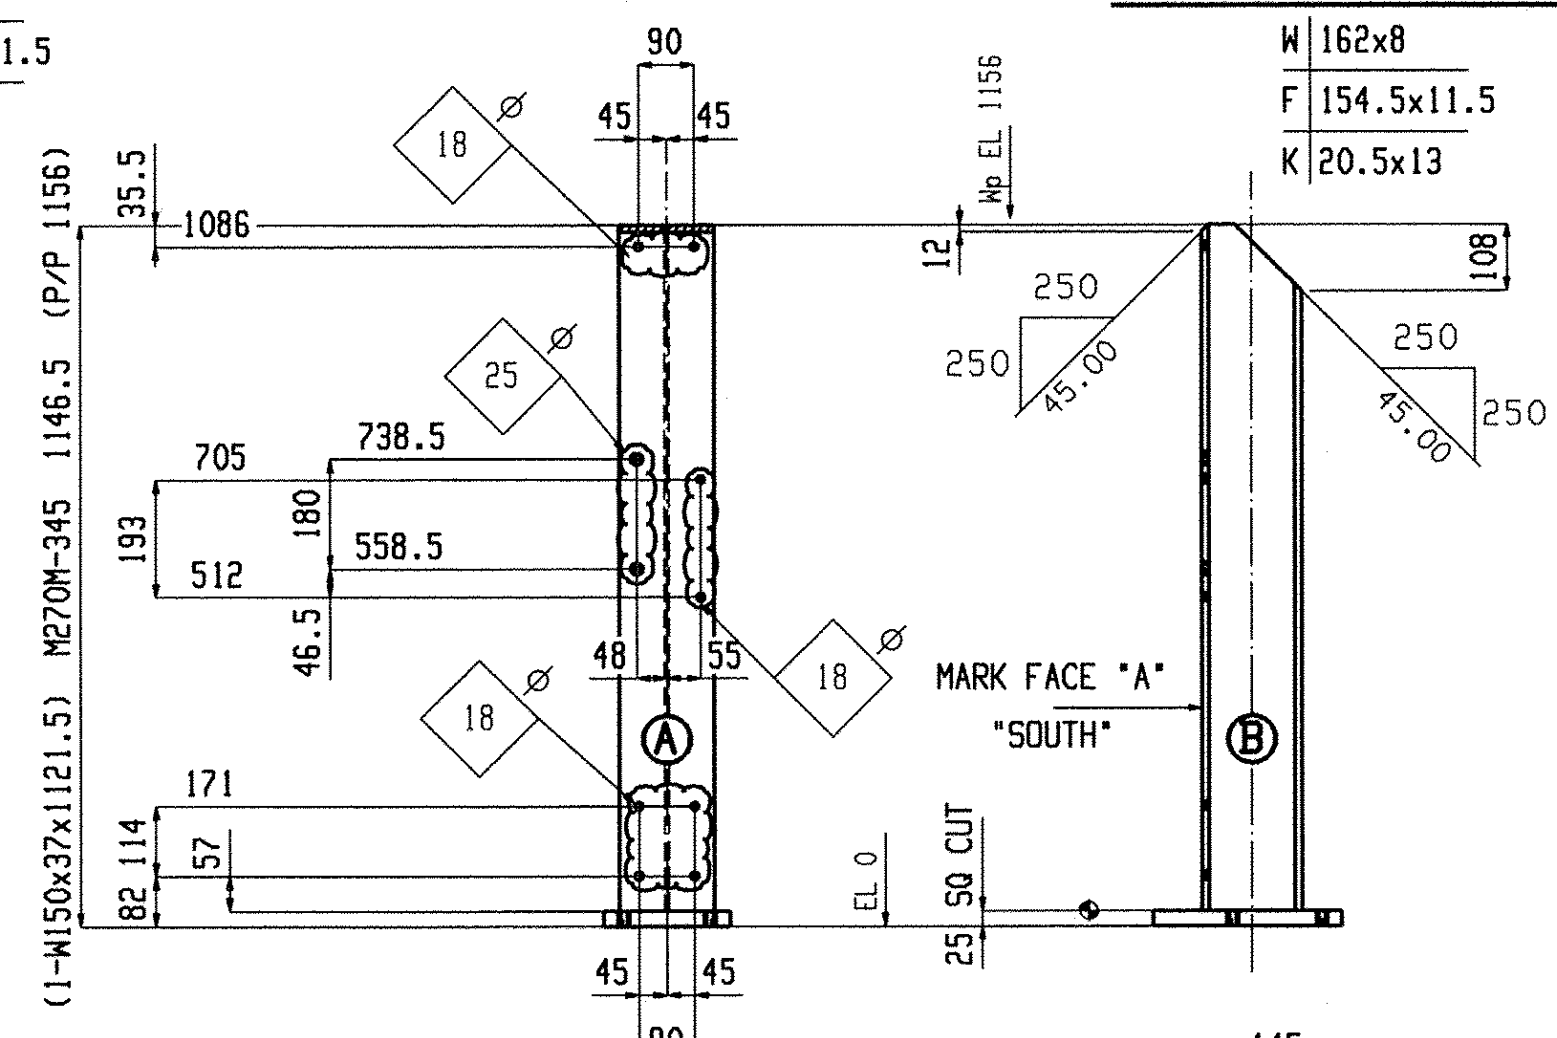

ONE COLUMN C5

W 162x8
F 154.5x11.5
K 20.5x13

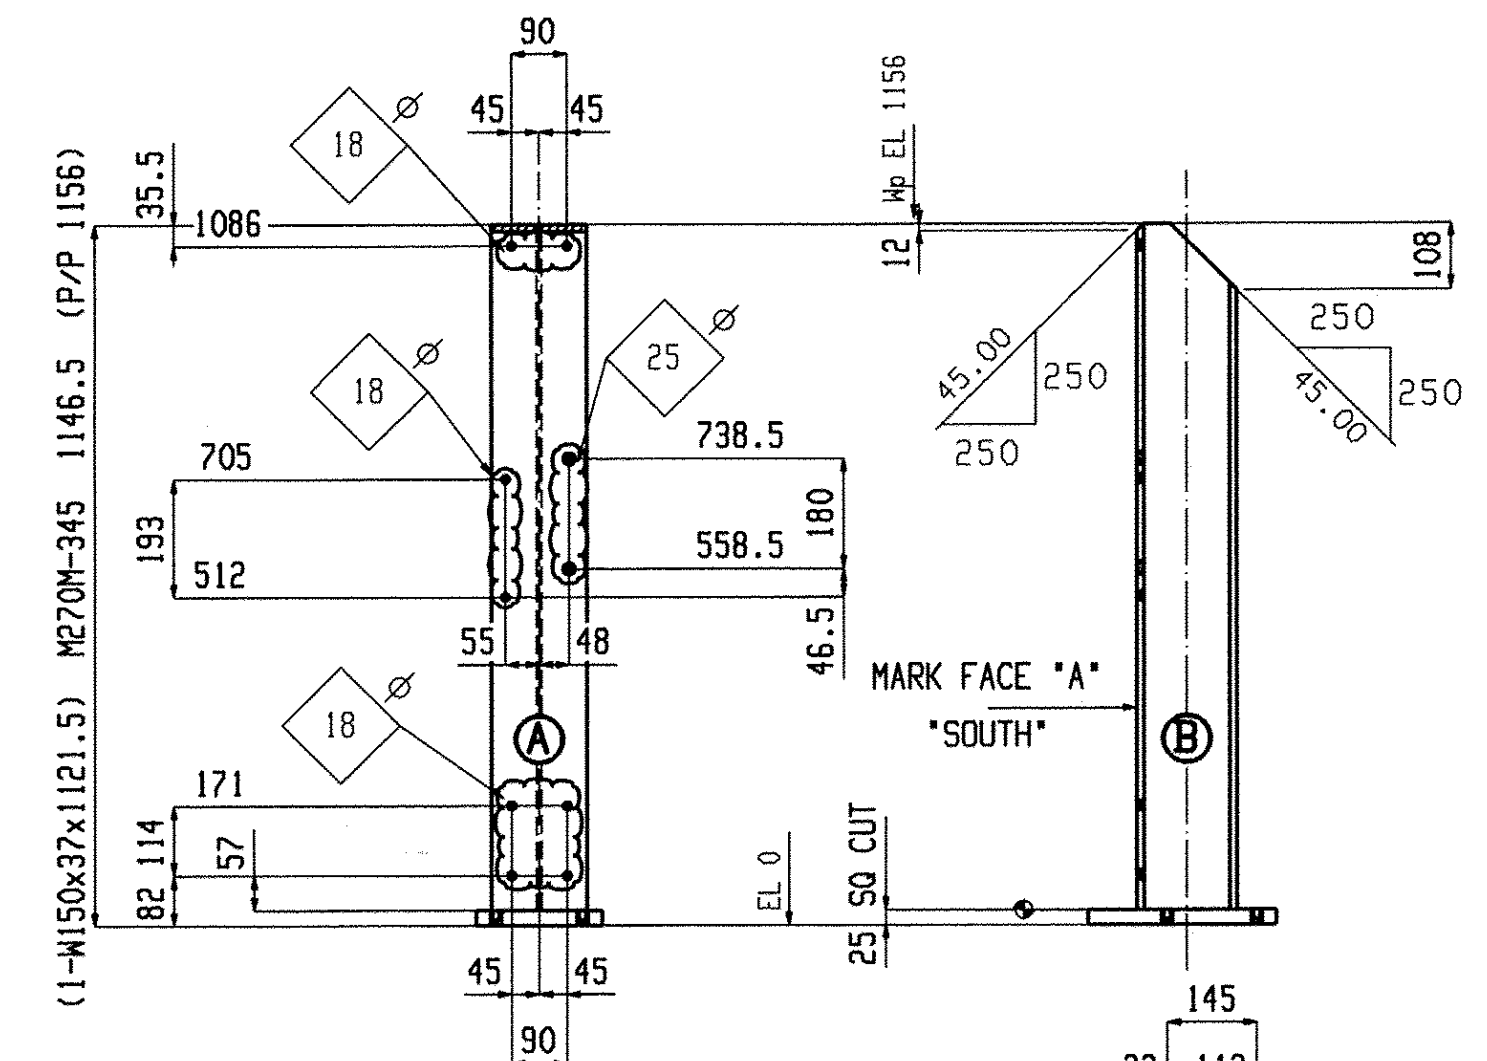

ONE COLUMN C6

W 162x8
F 154.5x11.5
K 20.5x13

Rev 18 2010 03-15-24 PM

Mar. 18 2010 03:42:24 PM

BILL OF MATERIAL									BILL OF MATERIAL									BILL OF MATERIAL								
Qty	Piece			Seq	Seq	Adv	Steel		Qty	Piece			Seq	Seq	Adv	Steel		Qty	Piece			Seq	Seq	Adv	Steel	
Tot.	Mark	Description	Length	NO.	Qty	ABM #	Grade	Remarks	Tot.	Mark	Description	Length	NO.	Qty	ABM #	Grade	Remarks	Tot.	Mark	Description	Length	NO.	Qty	ABM #	Grade	Remarks
ONE	R32	BEAM		2	1				1	p33	PL25x204	305				M270M-345		ONE	C5	COLUMN		2	1			
1	R32	L76x64x9.5	10328				M270M-250											1	C5	W150x37	1121				M270M-345	S1E
24	C1	COLUMN		2	24				ONE	C3	COLUMN		2	1				1	C5	W150x37	1121				M270M-345	S1E
24	C1	W150x37	1121				M270M-345	S1E	1	C3	W150x37	1121				M270M-345	S1E	1	p33	PL25x204	305				M270M-345	
24	p33	PL25x204	305				M270M-345											ONE	C6	COLUMN		2	1			
24	p33	PL25x204	305				M270M-345											1	C6	W150x37	1121				M270M-345	S1E
ONE	C2	COLUMN		2	1				24	C4	COLUMN		2	24				1	p33	PL25x204	305				M270M-345	
1	C2	W150x37	1121				M270M-345	S1E	24	C4	W150x37	1121				M270M-345	S1E	1	p33	PL25x204	305				M270M-345	
									24	p33	PL25x204	305				M270M-345										

RECEIVED
OCT. BY: [Signature]
APR 01 2010
RESUBMIT: [Signature]
BY: [Signature] DATE: 4/28/10

ITEMS ON THIS SHEET ARE PAY ITEM: 900.640 (UN)

Casco Bay Steel Structures 75 Spring Hill Rd Saco, ME, 04072 207-282-7360		Holes: 21mm UNO BOLTS: 19mm DIA. M164M-I GALV UNO Steel GR: M270M-GR345 UNO	
		Paint: PER SPECS (GREEN) UNO Surface Prep: PER SPECS	
Project: DUMMERSTON RAILS DUMMERSTON, VT		Date: 9-9-09 DWN. BY: EG	Job No. Checked: MRS Sheet No. 25