



TOP VIEW

SCALE: 3/16"=1'-0"

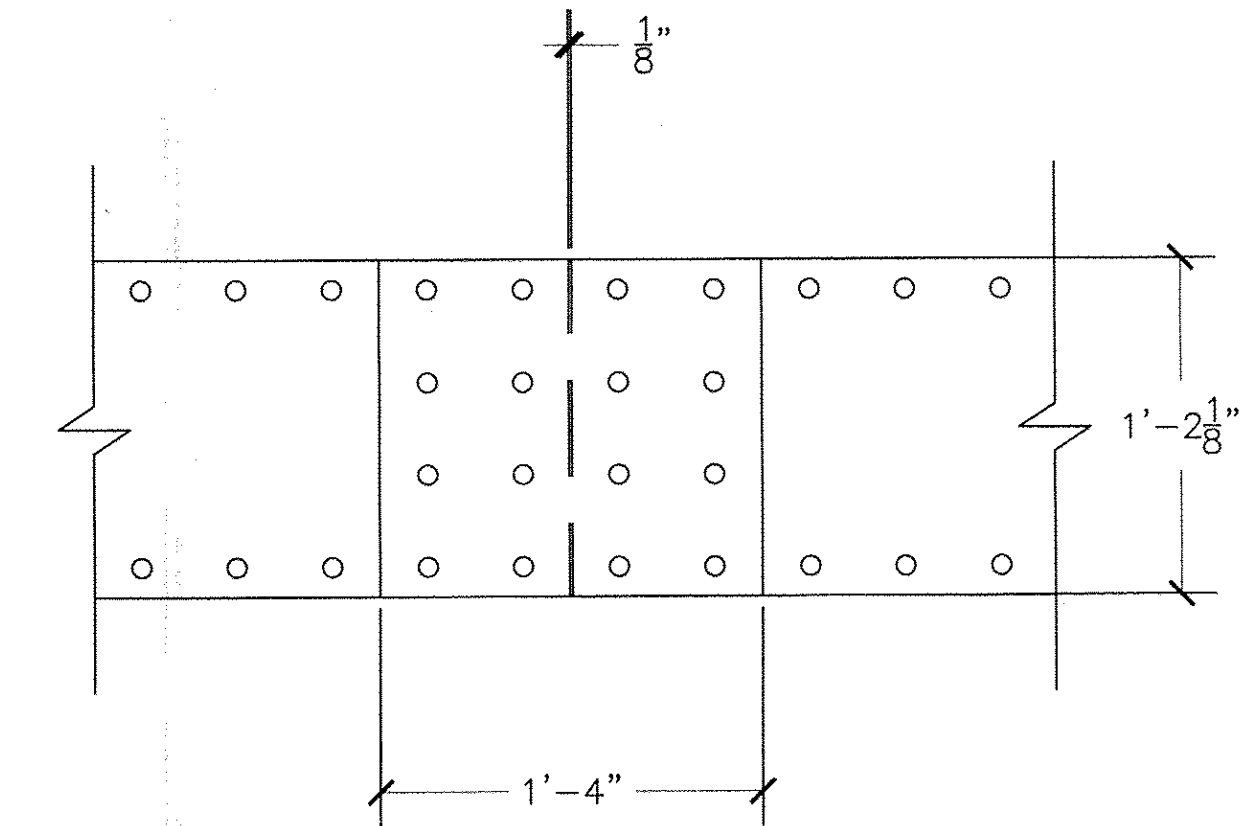


SPLICE DETAIL

SCALE: 1 1/2"=1'-0"

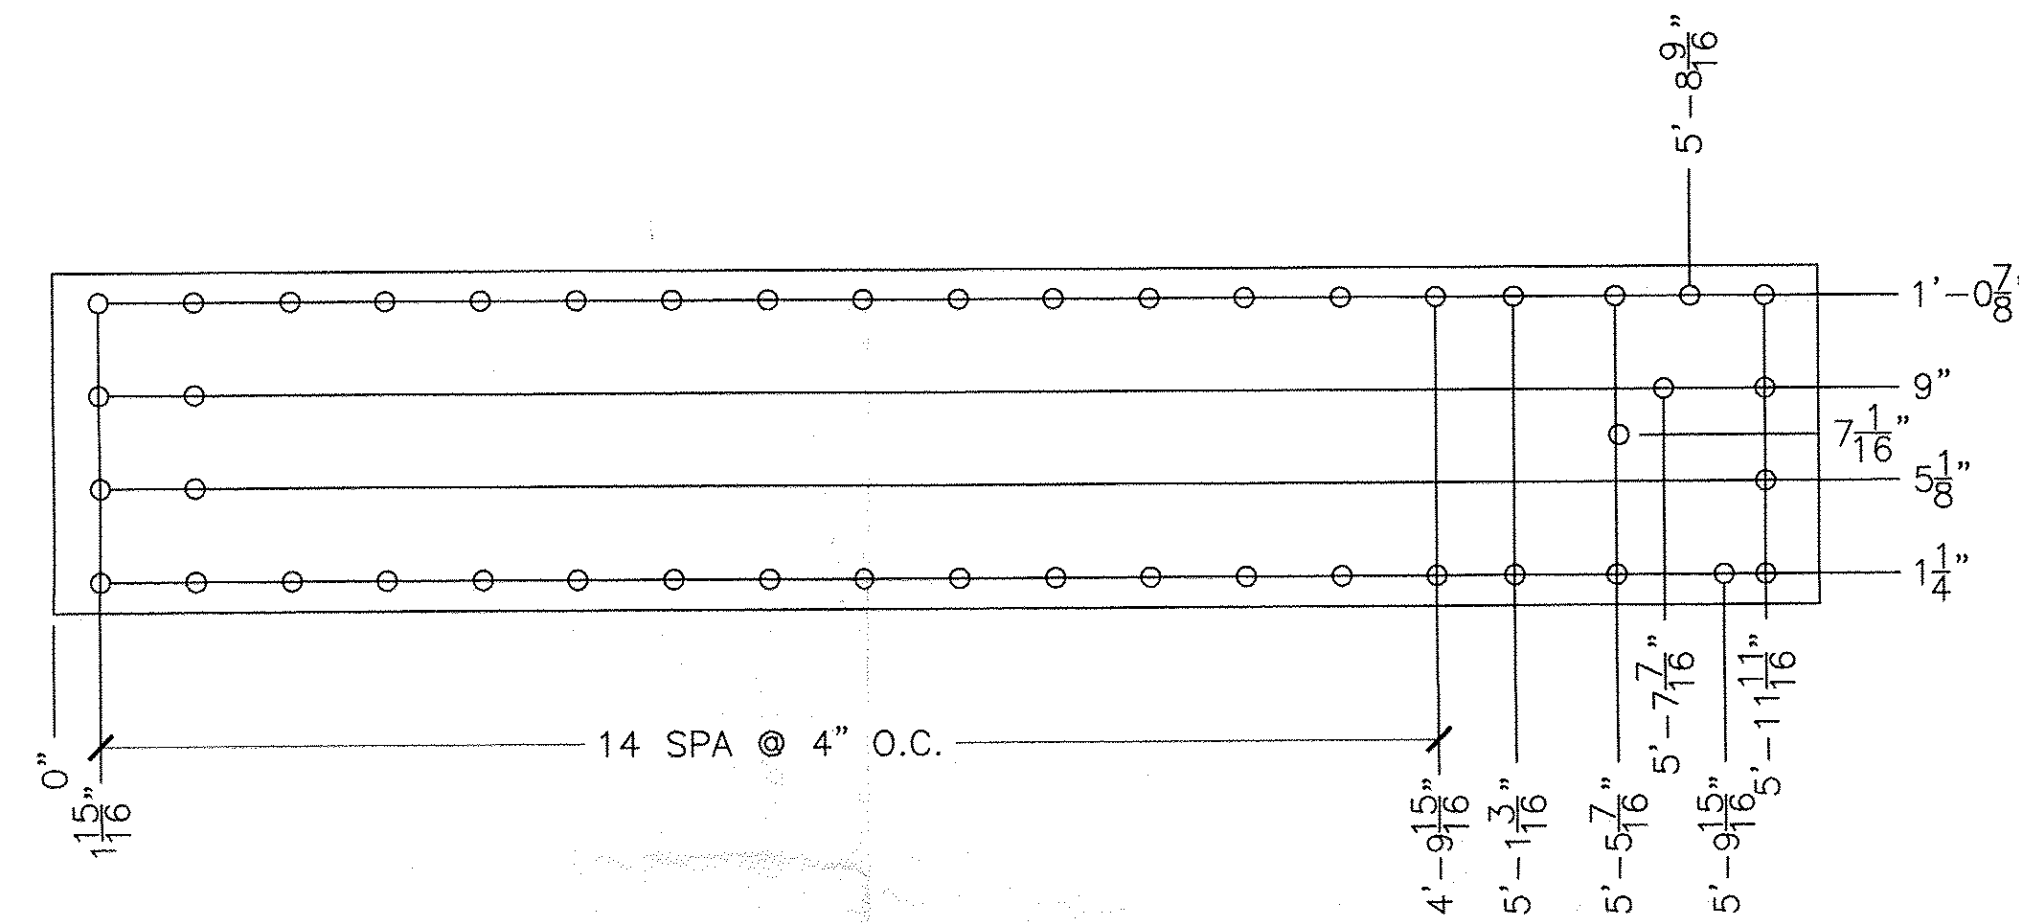

END COVER PLATE

SCALE: 1 1/2"=1'-0" QTY. 4
MAT'L A572-50 PL. HOLES 13/16 Ø TYP.

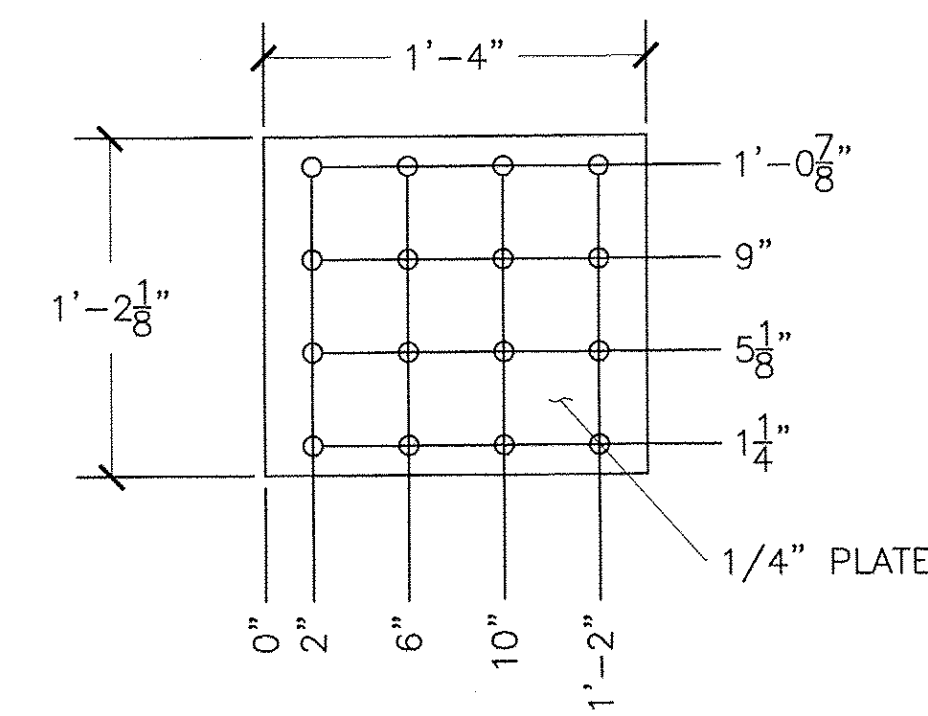


SPLICE PLATE

SCALE: 1 1/2"=1'-0" QTY. 28
MAT'L A572-50 PL. HOLES 13/16 Ø TYP.

NOTES:

- *ALL MATERIAL TO BE A572-50 DOMESTIC
- *BACKING AND SPLICE PLATES TO BE 1/4" THCK.
- *ONLY ONE SECTION SHALL BE COMPLETED AT A TIME
- *PLATE TO BE GALVANIZED, THEN FINISHED OUT WITH MID AND FINISH COAT OF PAINT.
- *ALL EXISTING HOLES TO BE REAMED TO 3/8"
- *ALL 5/8" Ø RIVETS SHALL BE REPLACED WITH 3/4" Ø T.C. BOLTS GR. A325 M.G.
- *ALL MEASUREMENTS TO BE FIELD VERIFIED
- *ALL CUT EDGES SHALL BE GROUND TO A 1/16" RADIUS

RECEIVED
MCM
OCT 27 2010
RESUBMIT APPROVED BY DATE 10/22/10

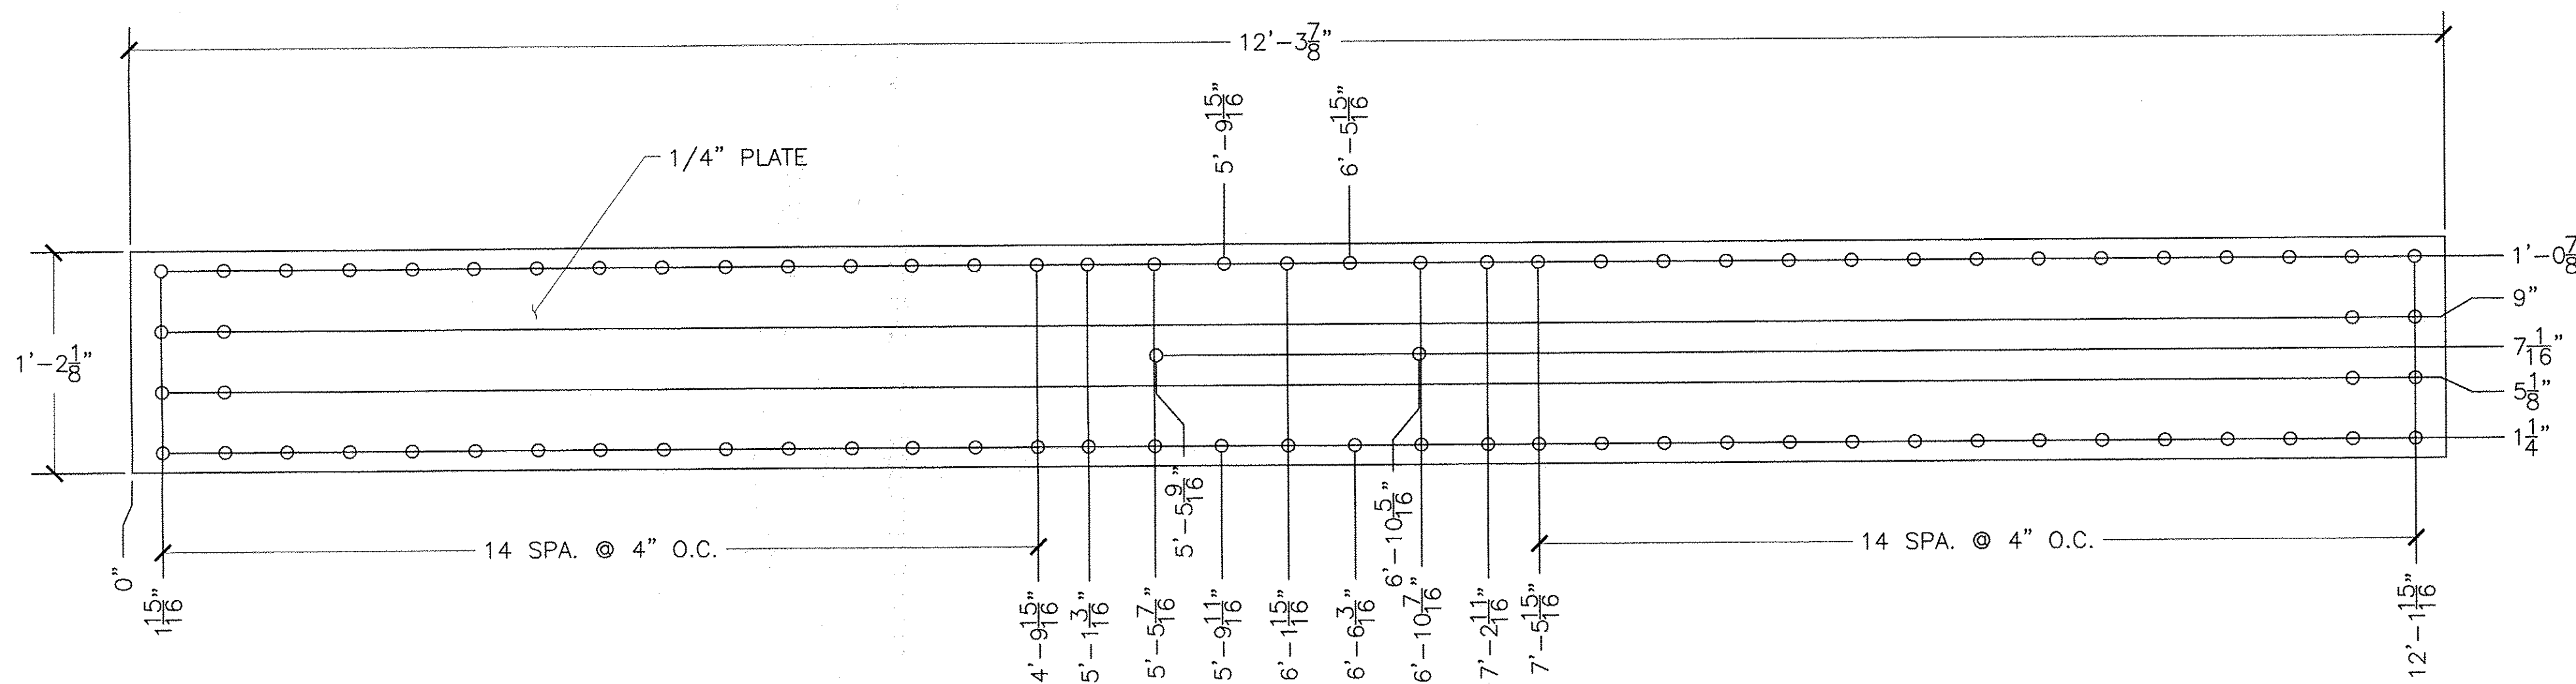

TOP COVER PLATE

SCALE: 1 1/2"=1'-0" QTY. 26
MAT'L A572-50 PL. HOLES 13/16 Ø TYP.

BILL OF MATERIALS

QTY.	DESCRIPTION	THICKNESS	SIZE
26	TOP REPL. PL.	0'-0 1/4"	1'-2 1/8" X 12'-3 7/8"
4	END REPL. PLATE	0'-0 1/4"	1'-2 1/8" X 6'-1 15/16"
26	SPLICE PLATE	0'-0 1/4"	1'-2 1/8" X 1'-4"
2024	A325 T.C. BOLT M.G.	3/4" DIA.	2"
344	A325 T.C. BOLT M.G.	3/4" DIA.	2 1/4"

SHEET NAME: TOP CHORD PLATES

REV. NO.	DATE:
1	10/19/2010

Renaud Bros. Inc.

283 FT BRIDGMAN RD.
VERNON VT. 05354
PH. 802-257-7383 FAX 802-257-7308

PROJECT NAME:	DUMMERSTON	SHEET NO.
PROJECT NO:	BHO 1442(28)	
DRAWN BY:	CHK'D BY:	DATE:
A.D.	M.R.	10/12/10

1 OF 2