
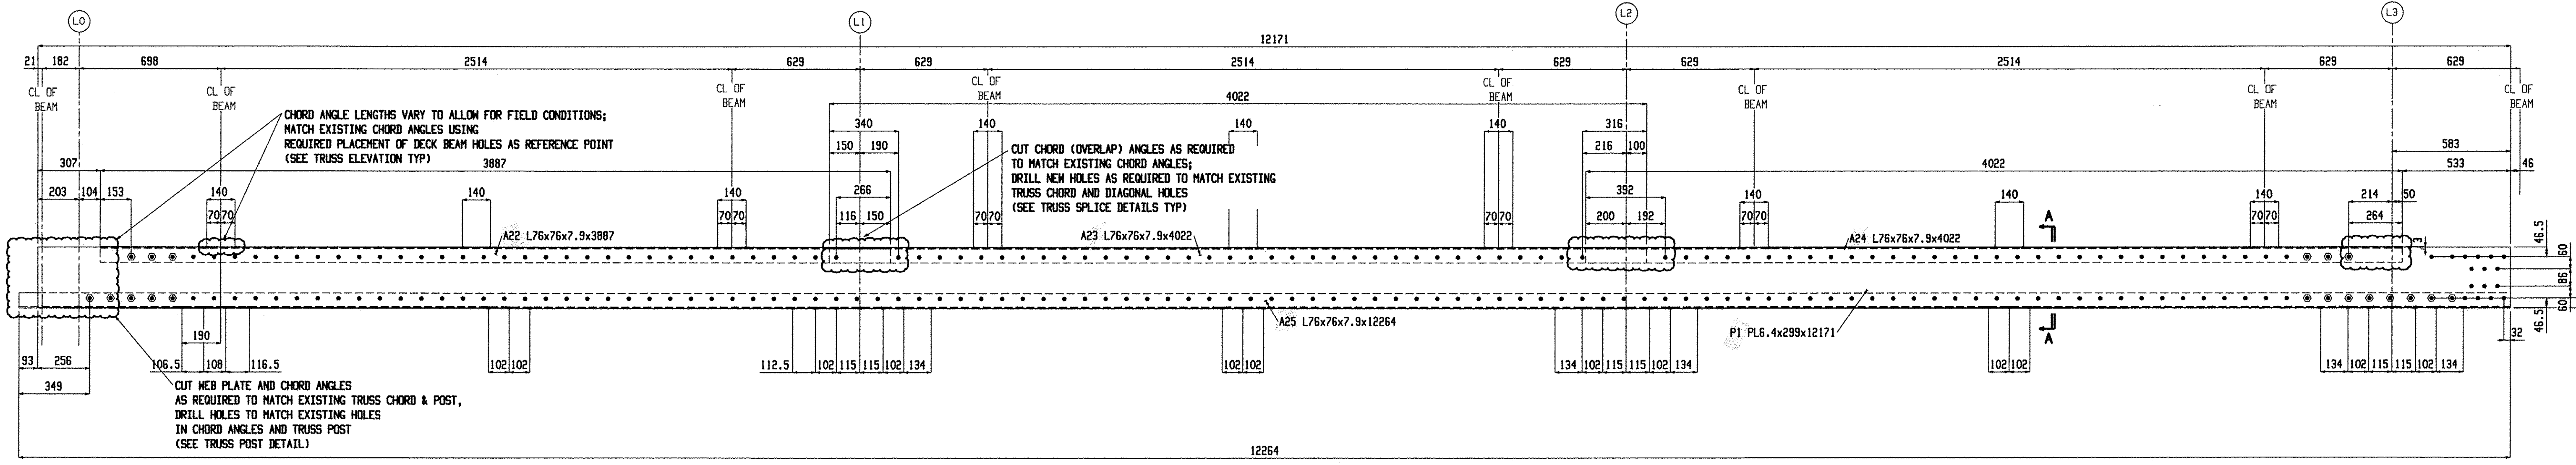


2 GROUP MEMBERS G5

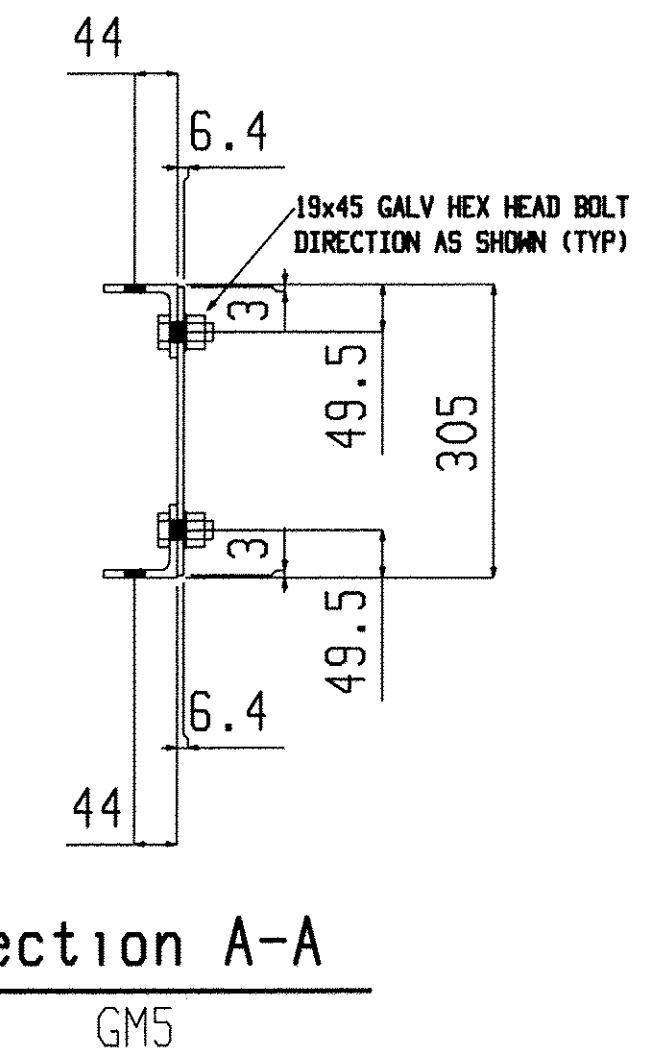

2 GROUP MEMBERS GM6

BILL OF MATERIAL										BILL OF MATERIAL										BILL OF MATERIAL									
Qty	Piece									Qty	Piece									Qty	Piece								
Tot.	Mark	Description	Length	Seq NO.	Seq Qty	Adv ABM #	Steel Grade	Remarks		Tot.	Mark	Description	Length	Seq NO.	Seq Qty	Adv ABM #	Steel Grade	Remarks		Tot.	Mark	Description	Length	Seq NO.	Seq Qty	Adv ABM #	Steel Grade	Remarks	
2	G5	GROUP MEMBER					M270M-345			2	G6	GROUP MEMBER					M270M-345												
2	P1	PL6.4x299	12171				M270M-345			2	P1	PL6.4x299	12171				M270M-345												
2	A21	L76x76x7.9	12264				M270M-345			2	A25	L76x76x7.9	12264				M270M-345												
2	A18	L76x76x7.9	4022				M270M-345			2	A24	L76x76x7.9	4022				M270M-345												
2	A19	L76x76x7.9	4022				M270M-345			2	A23	L76x76x7.9	4022				M270M-345												
2	A20	L76x76x7.9	3887				M270M-345			2	A22	L76x76x7.9	3887				M270M-345												

Total weight: 1602

RECEIVED  
 NOV 17 2009  
 APPROVED BY: [Signature]  
 DATE: [Blank]

**Renaud Bros. Inc.**  
 283 Fort Bridgeman Rd. #2  
 Vernon, VT. 05354  
 Phone 1-802 257-7383

Holes: 21mm UNO  
 BOLTS: 19mm DIA. M164M-I GALV UNO  
 Steel GR: M270M-GR345 UNO  
 Paint: PER SPECS (GREEN) UNO  
 Surface Prep: PER SPECS

Project: DUMMERSTON BRIDGE  
 DUMMERSTON, VT

Date: 9-9-09  
 Job No. Bto 1442 (28)  
 Sheet No. GM5, GM6

Nov 06 2009 10:54:02 AM