


4 GROUP MEMBERS GM15

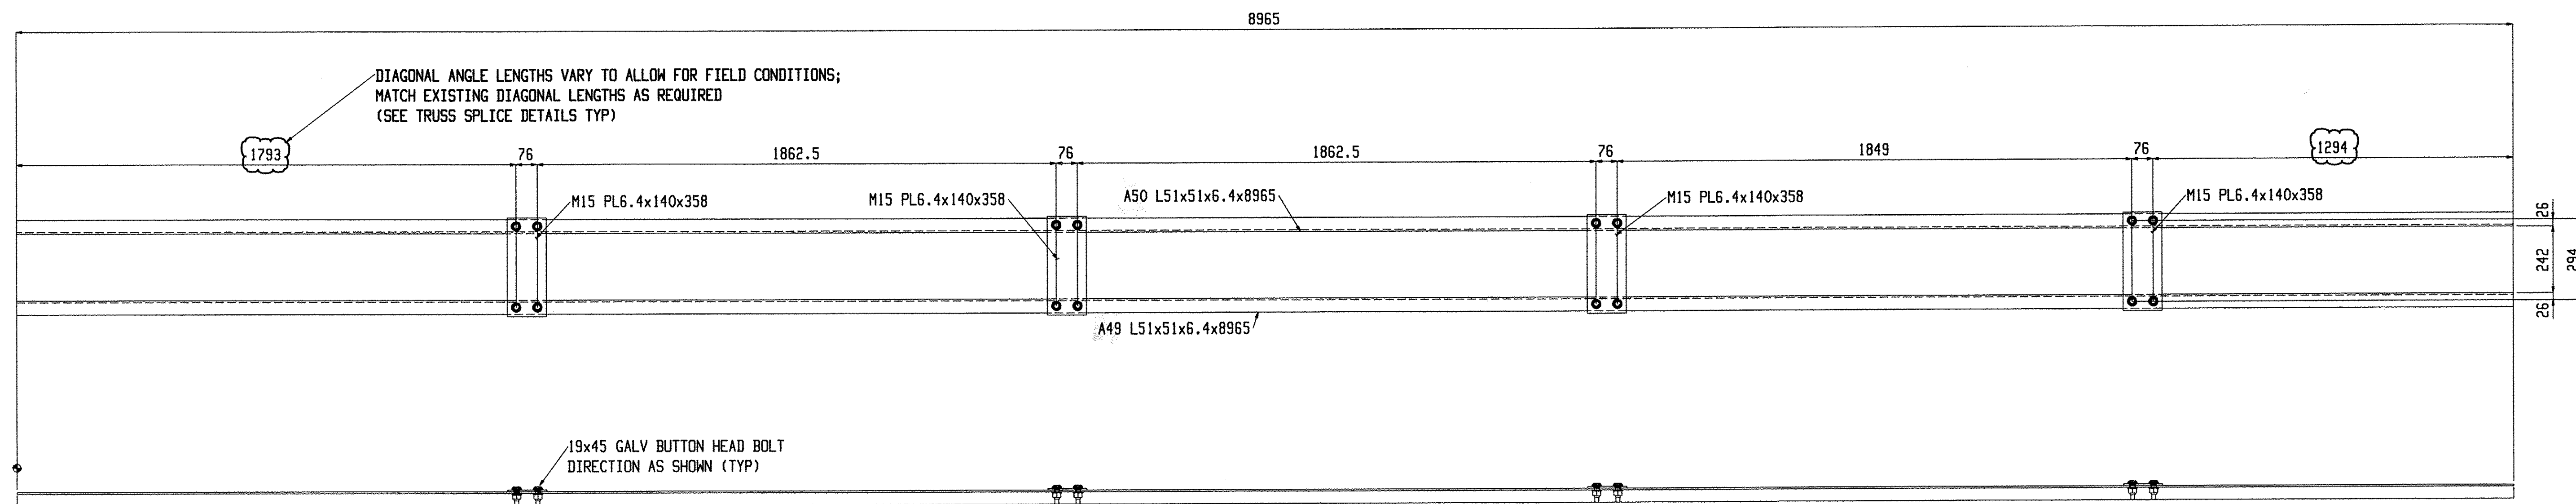

4 GROUP MEMBERS GM16

BILL OF MATERIAL										BILL OF MATERIAL										BILL OF MATERIAL										
Qty	Piece			Seq	Seq	Adv	Steel		Remarks	Qty	Piece			Seq	Seq	Adv	Steel		Remarks	Qty	Piece			Seq	Seq	Adv	Steel		Remarks	
Tot.	Mark	Description	Length	NO.	Qty	ABM #	Grade			Tot.	Mark	Description	Length	NO.	Qty	ABM #	Grade			Tot.	Mark	Description	Length	NO.	Qty	ABM #	Grade			
4	GM15	GROUP MEMBER								4	GM16	GROUP MEMBER																		
16	M15	PL6.4x140	358				M270M-345			16	M15	PL6.4x140	358				M270M-345													
4	A51	L51x51x6.4	11272				M270M-345			4	A49	L51x51x6.4	8965				M270M-345													
4	A52	L51x51x6.4	11272				M270M-345			4	A50	L51x51x6.4	8965				M270M-345													

Total weight : 848

RECEIVED
 NOV 17 2009
 REQUEST APPROVED BY DATE

Renaud Bros. Inc. 283 Fort Bridgeman Rd. #2 Vernon, VT. 05354 Phone 1-802 257-7383	Holes: 21mm UNF Bolts: 19mm DIA. M164M-I GALV UNF Steel GR: M270M-GR345 UNF Paint: PER SPECS (GREEN) UNF Surface Prep: PER SPECS
	Rev.No: _____ Date: 9-9-09 Project: DUMMERSTON BRIDGE DUMMERSTON, VT Job No. BHO 1442(28) Sheet No. GM15, GM16

Nov 06 2009 10:54:26 AM