



Nov 06 2009 10:54:53 AM

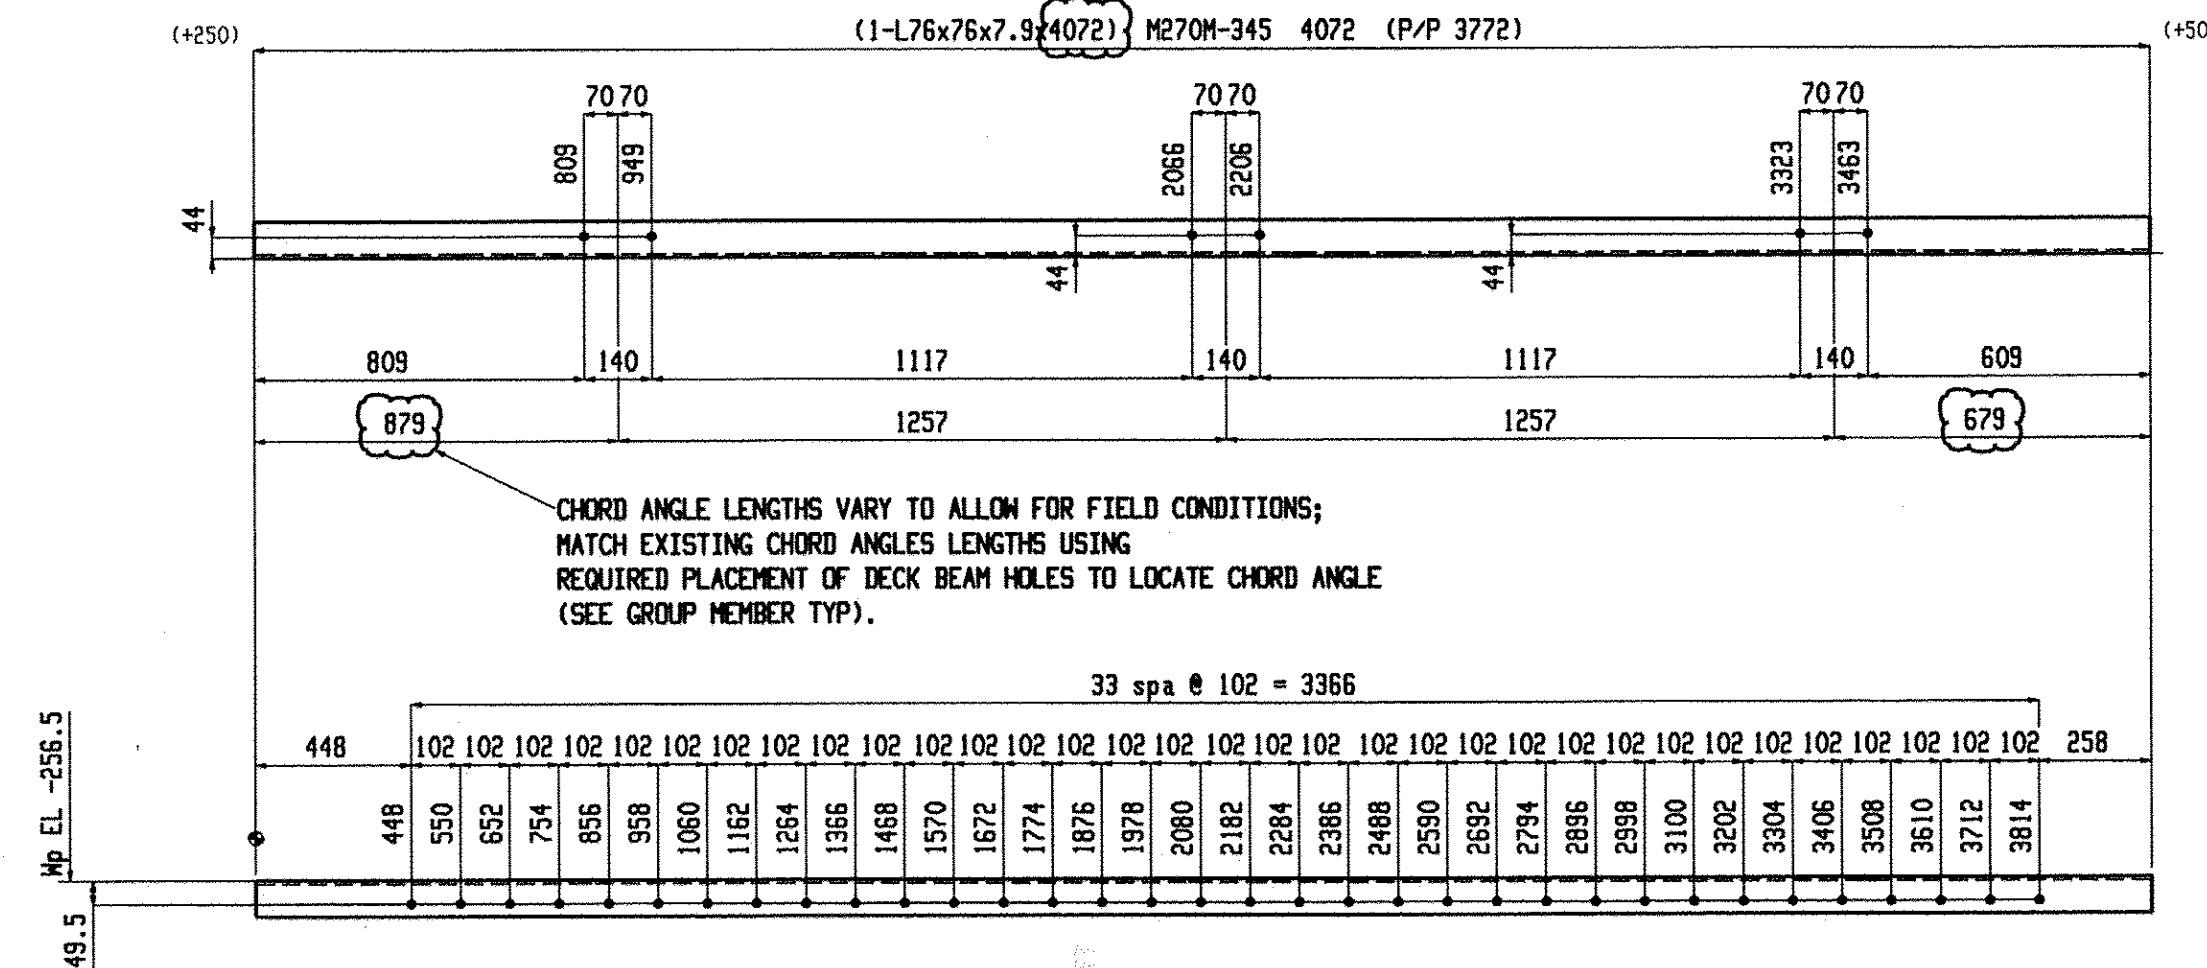


2 ANGLES A14

SHOP NOTE:
TOE DIRECTION FAR SIDE

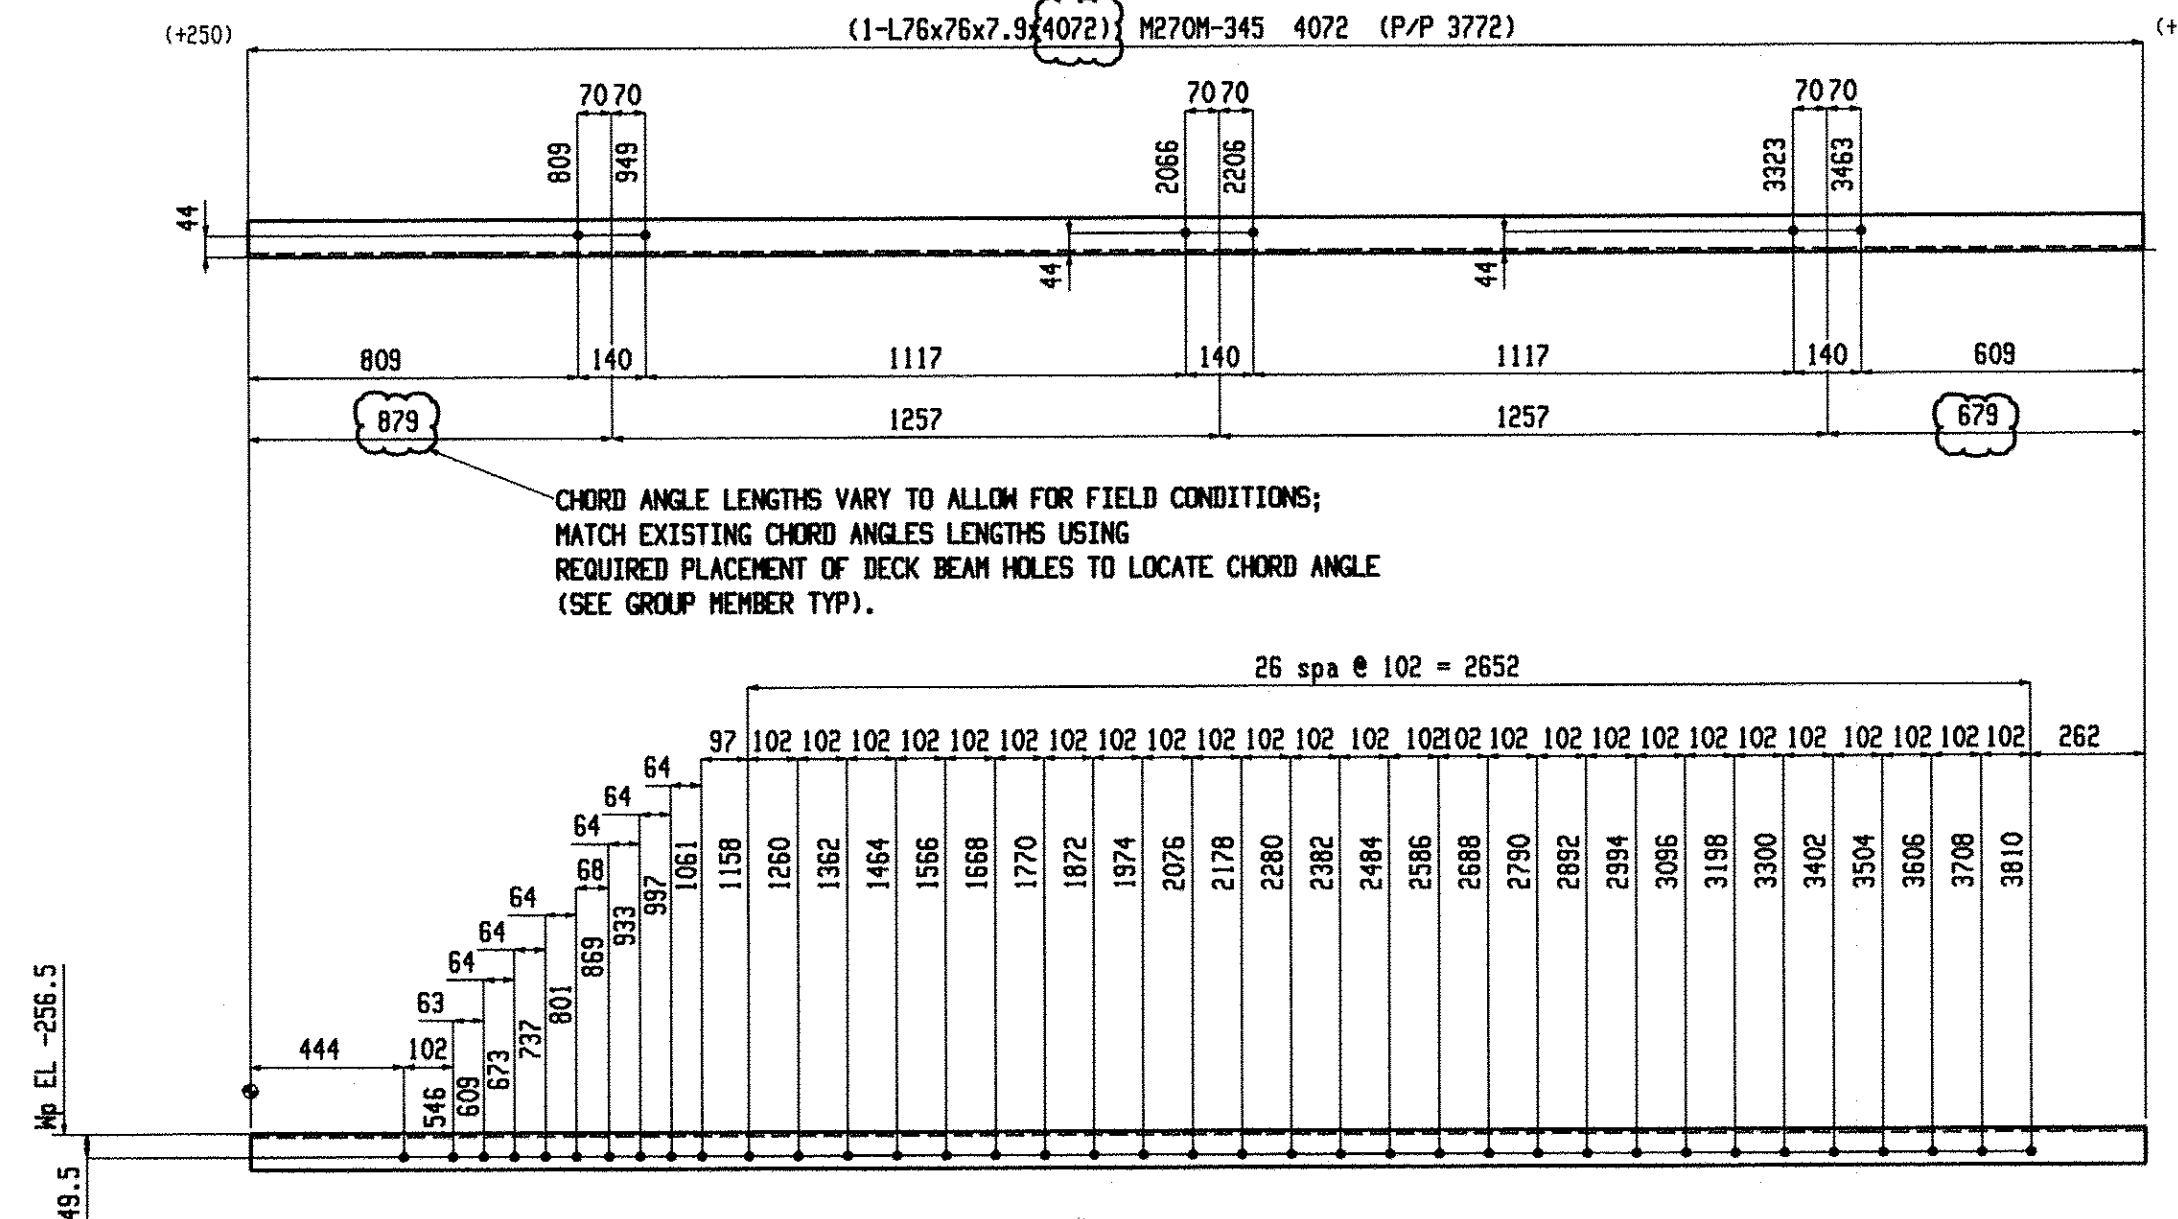


2 ANGLES A16

SHOP NOTE:
TOE DIRECTION FAR SIDE

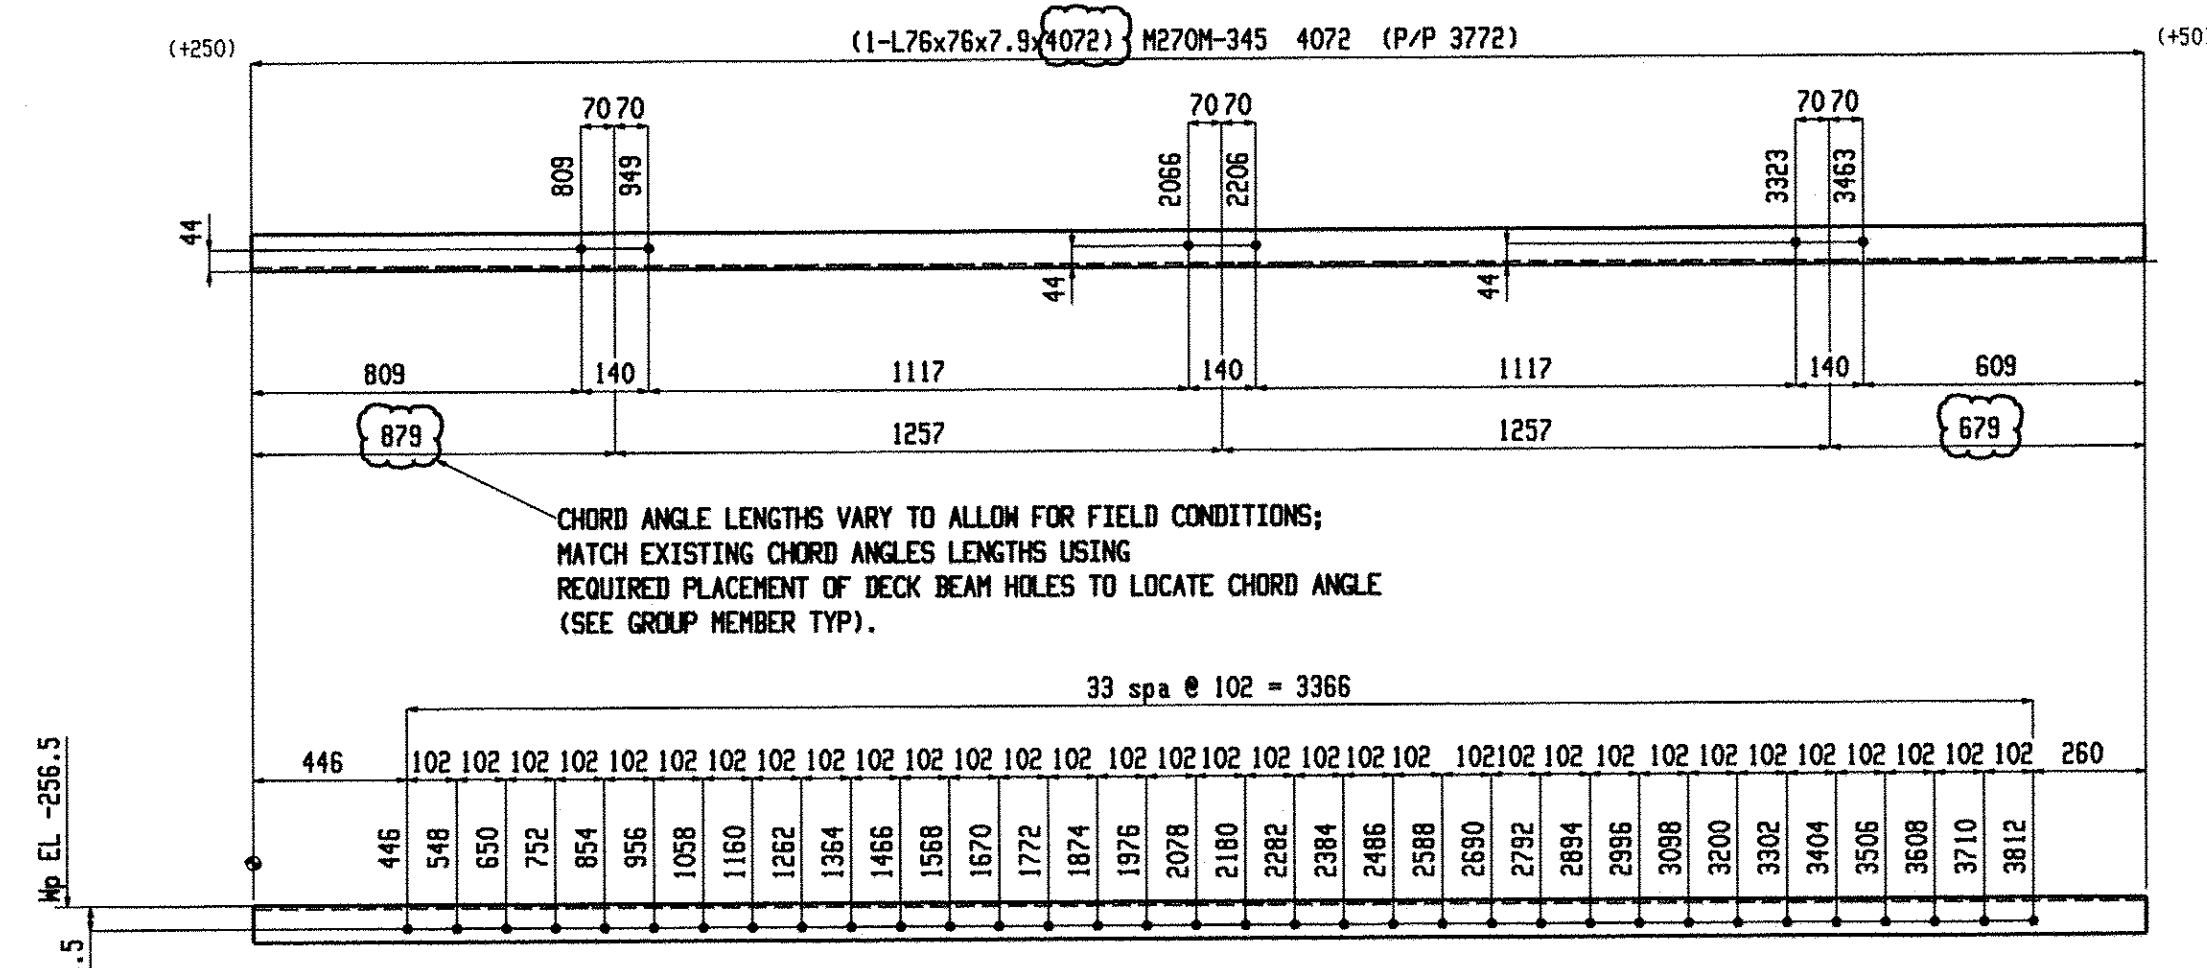

2 ANGLES A15

SHOP NOTE:
TOE DIRECTION FAR SIDE

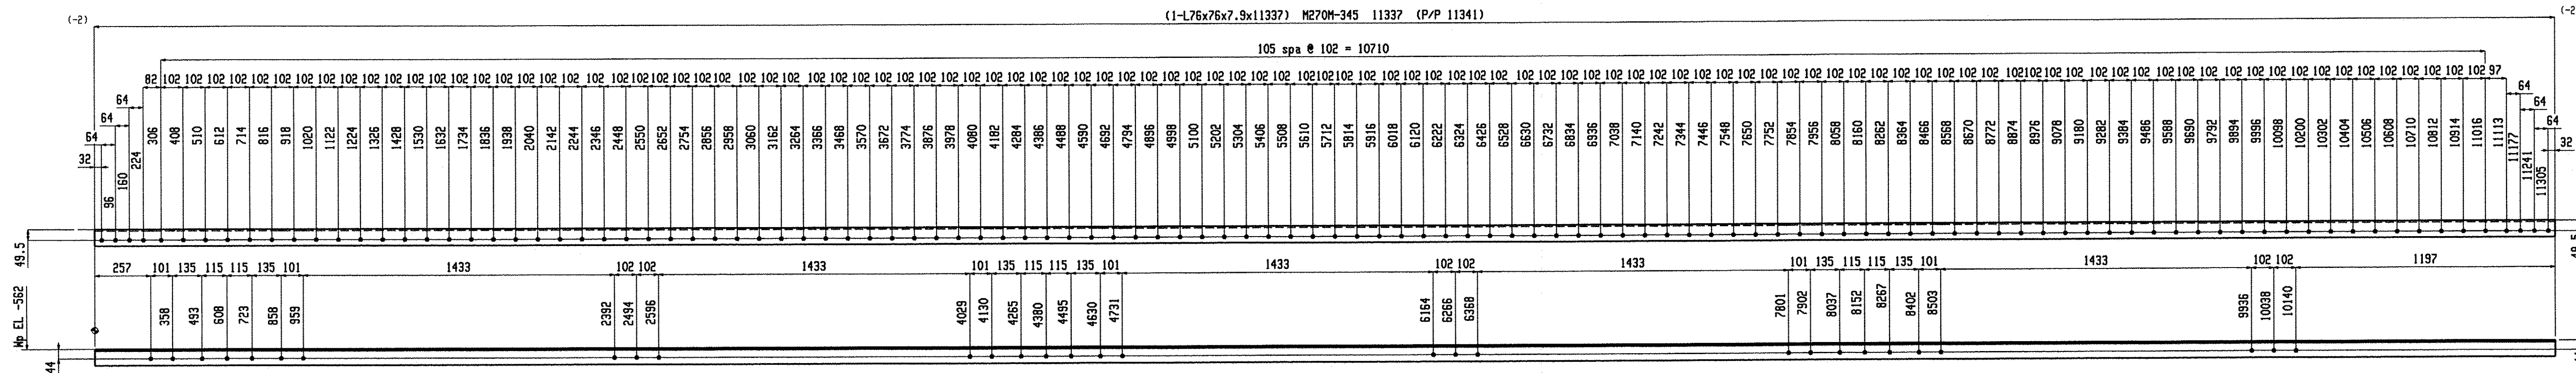

2 ANGLES A17

SHOP NOTE:
TOE DIRECTION NEAR SIDE

BILL OF MATERIAL									BILL OF MATERIAL									BILL OF MATERIAL								
Qty	Piece			Seq	Seq	Adv	Steel		Qty	Piece			Seq	Seq	Adv	Steel		Qty	Piece			Seq	Seq	Adv	Steel	
Tot.	Mark	Description	Length	NO.	Qty	ABM #	Grade	Remarks	Tot.	Mark	Description	Length	NO.	Qty	ABM #	Grade	Remarks	Tot.	Mark	Description	Length	NO.	Qty	ABM #	Grade	Remarks
2	A14	ANGLE		1	2				2	A16	ANGLE		1	2												
2	A14	L76x76x7.9	4072				M270M-345		2	A16	L76x76x7.9	4072				M270M-345										

Total weight: 423

RECEIVED
NOV 17 2009
APPROVED
BY DATE

NOTE: WORK THIS DRAWING WITH
GROUP MEMBER GM4

Renaud Bros. Inc. 283 Fort Bridgeman Rd. #2 Vernon, VT. 05354 Phone 1-802 257-7383		Holes: 21mm UNO	
		BOLTS: 19mm DIA. M164M-I GALV UNO	
		Steel GR: M270M-GR345 UNO	
		Paint: PER SPECS (GREEN) UNO	
Rev.No:	Date:	Surface Prep: PER SPECS	
Project: DUMMERSTON BRIDGE DUMMERSTON, VT		Date: 9-9-09	Job No. BHO 1442 (28)
DMN. BY: EG	Checked: MRS	Sheet No. 8	