



**2 ANGLES A22**

SHOP NOTE:  
TOE DIRECTION FAR SIDE

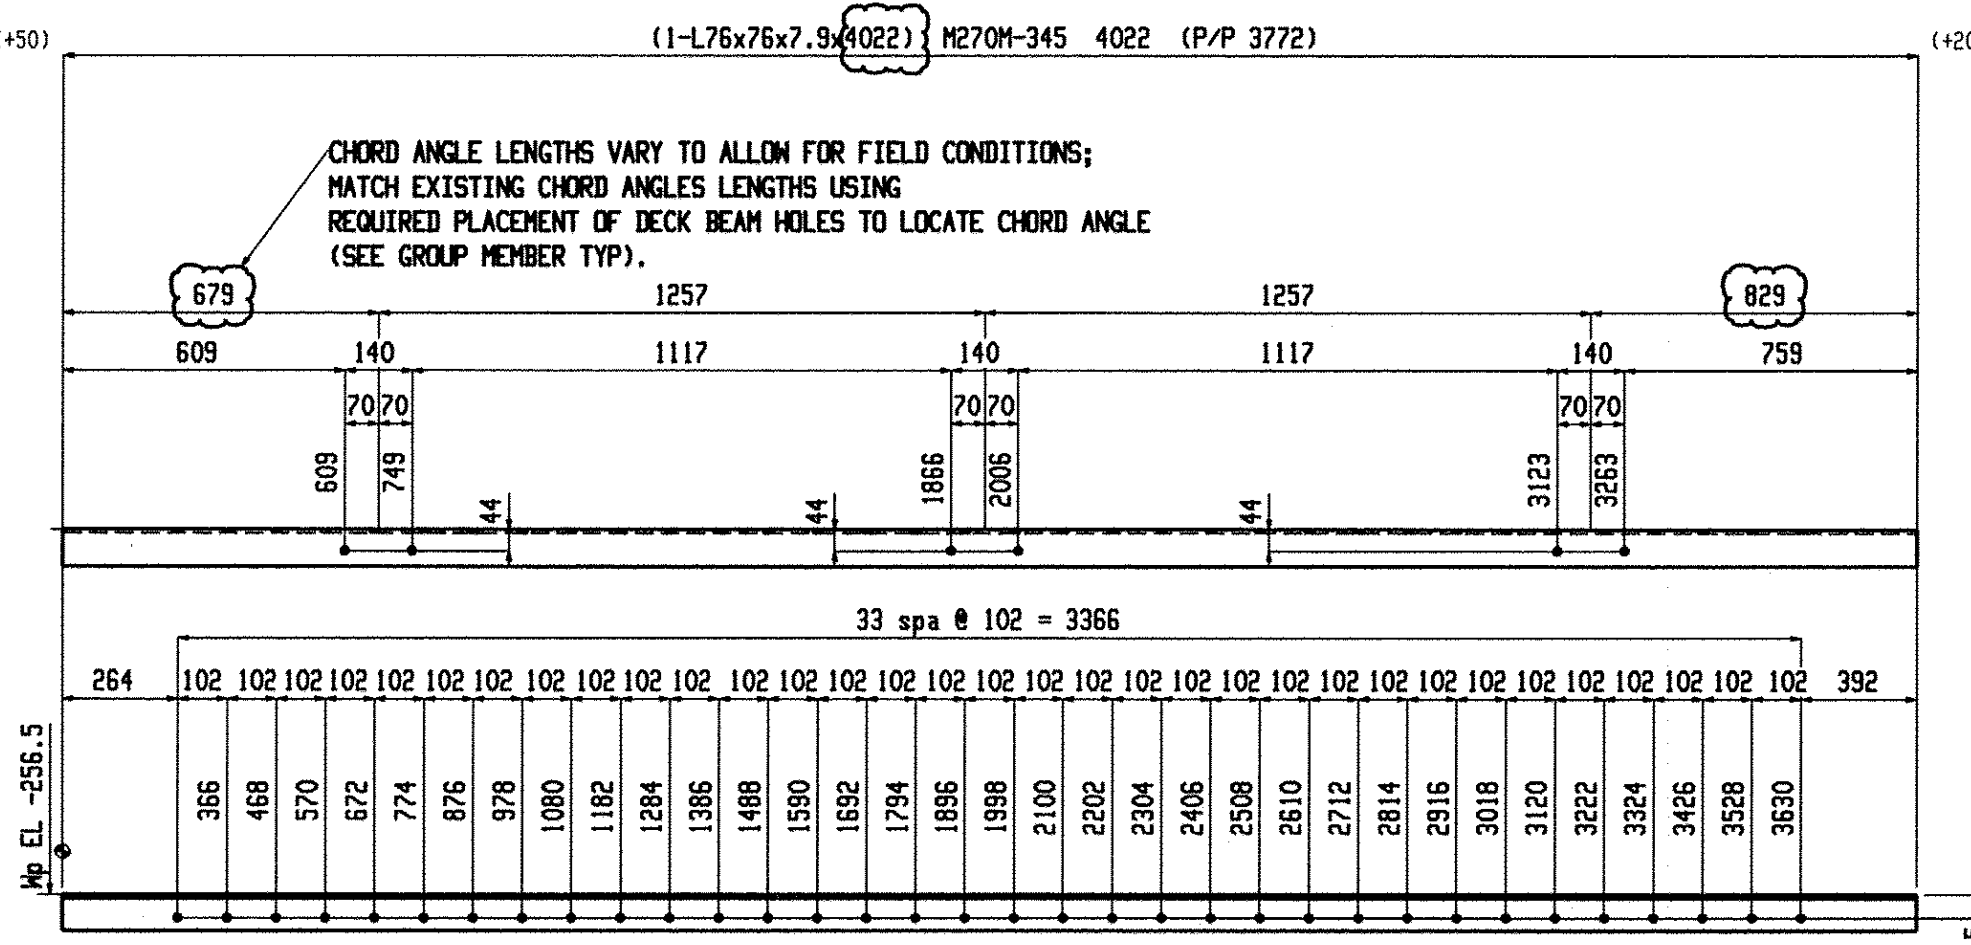


**2 ANGLES A24**

SHOP NOTE:  
TOE DIRECTION NEAR SIDE

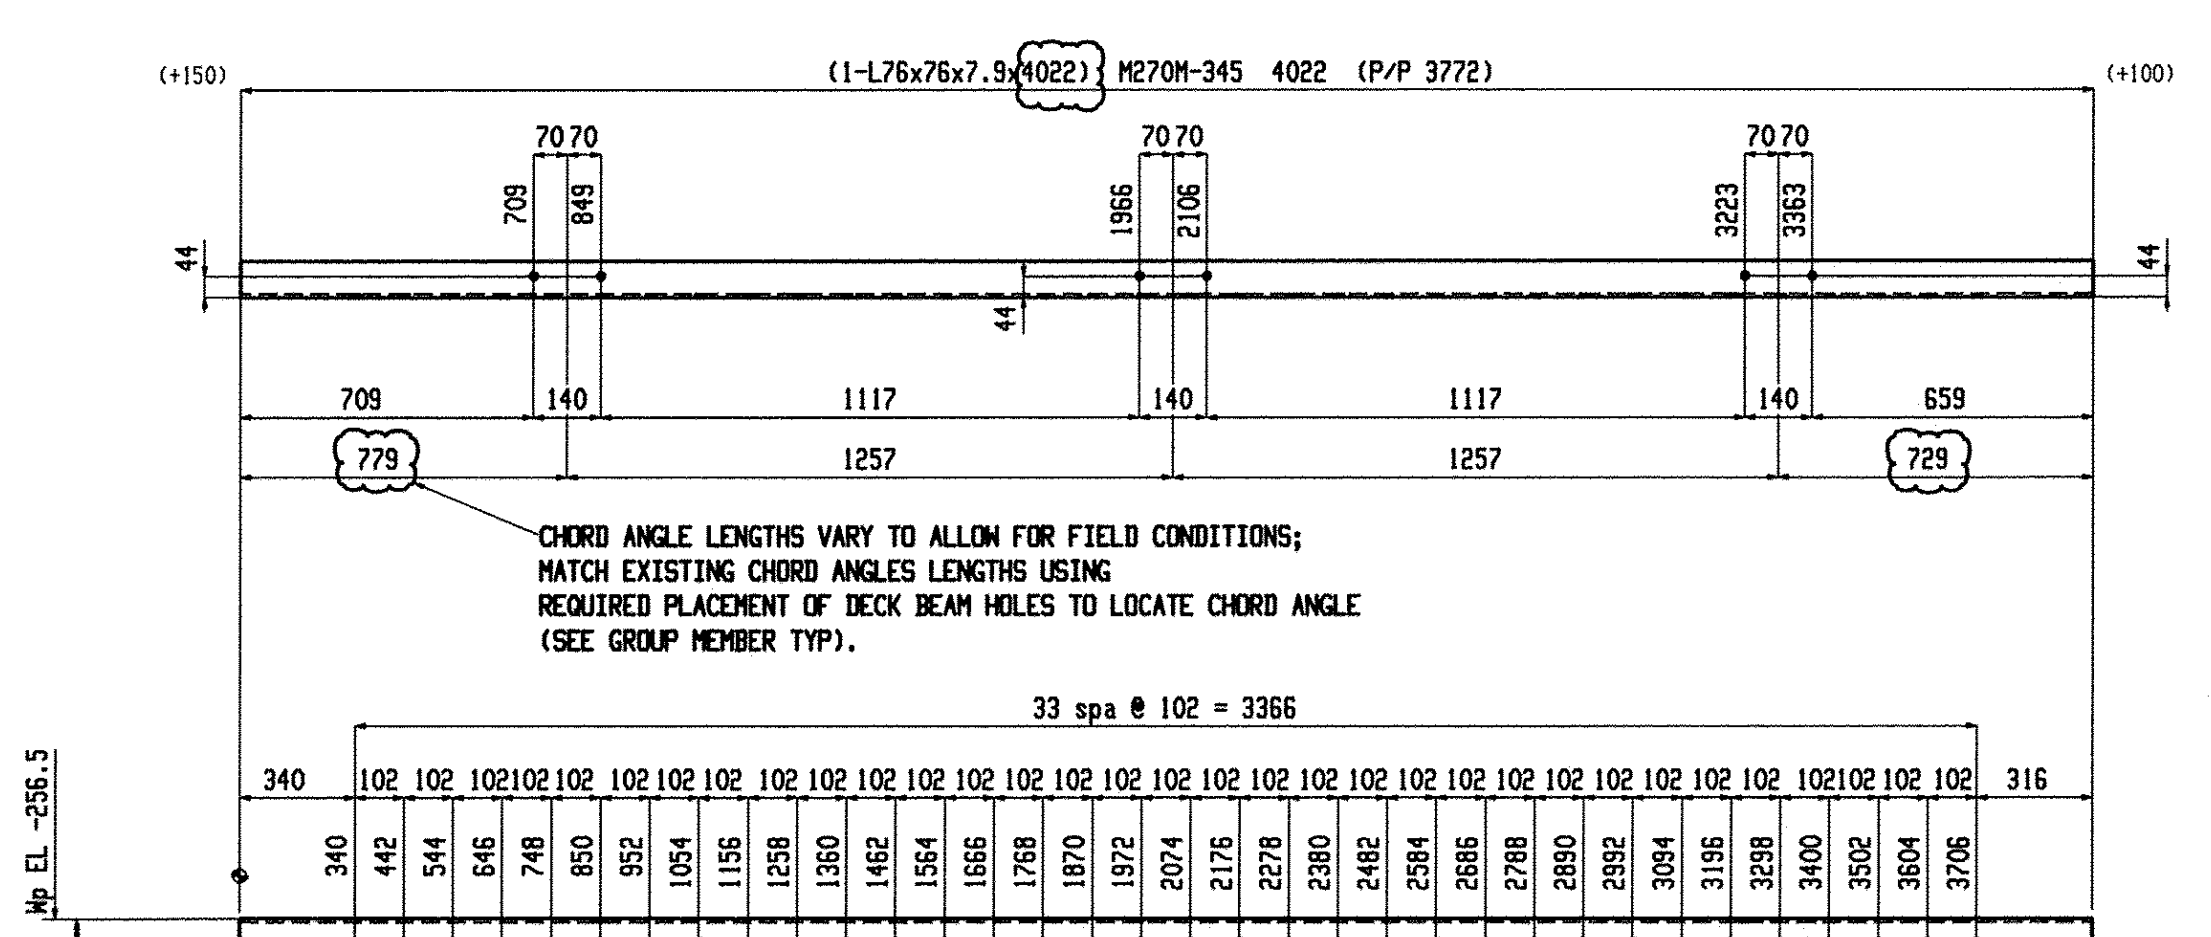

**2 ANGLES A23**

SHOP NOTE:  
TOE DIRECTION FAR SIDE

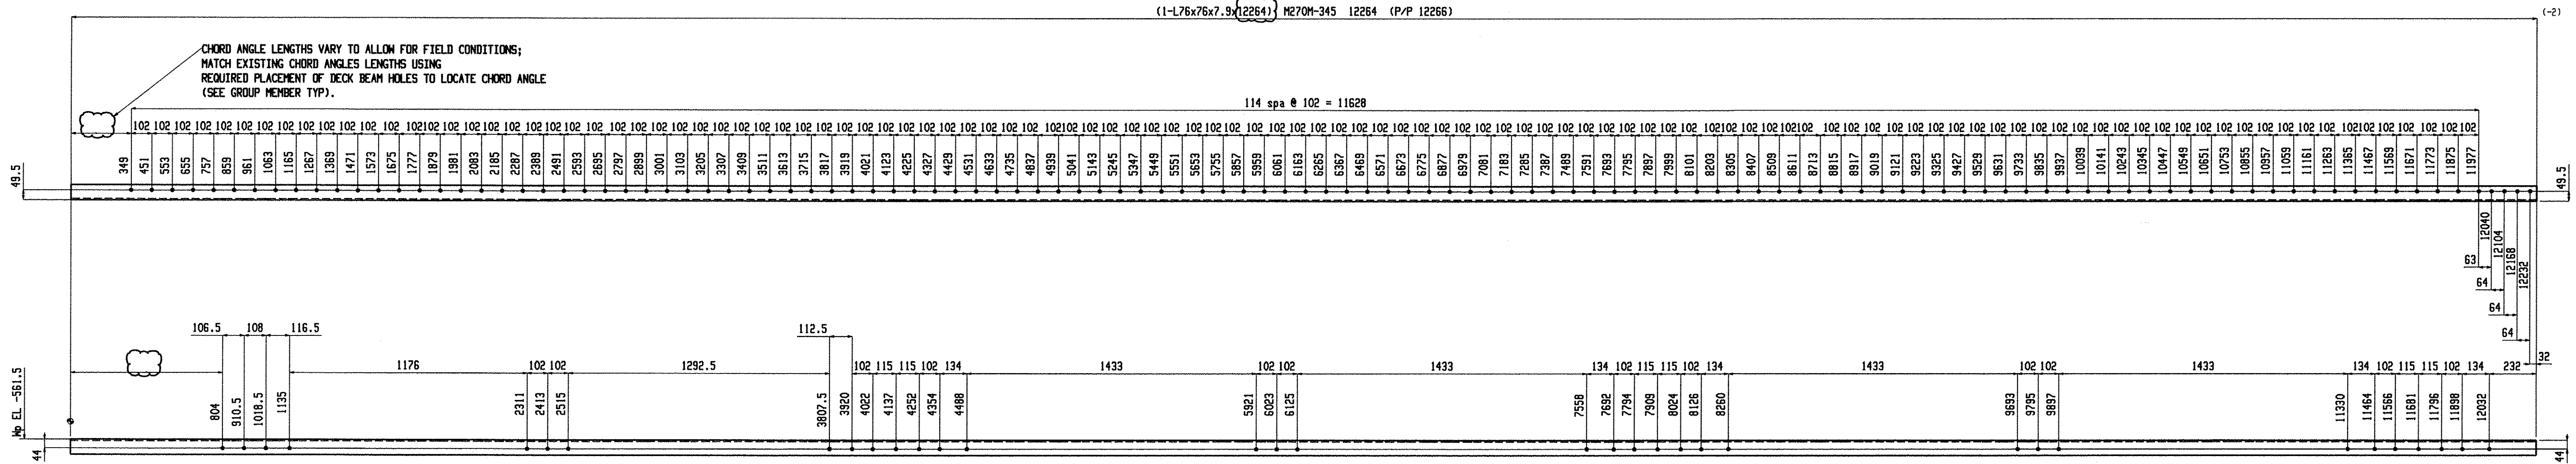

**2 ANGLES A25**

SHOP NOTE:  
TOE DIRECTION FAR SIDE

RECEIVED

CHK'D BY: OK'D BY:

NOV 17 2009

REQUIREMENT APPROVED DATE

NOTE: WORK THIS DRAWING WITH GROUP MEMBER GM6

BILL OF MATERIAL							BILL OF MATERIAL							BILL OF MATERIAL														
Qty	Piece		Seq	Seq	Adv	Steel	Qty	Piece		Seq	Seq	Adv	Steel	Qty	Piece		Seq	Seq	Adv	Steel	Qty	Piece		Seq	Seq	Adv	Steel	Remarks
Tot.	Mark	Description	Length	NO.	Qty	ABM #	Grade	Remarks	Tot.	Mark	Description	Length	NO.	Qty	ABM #	Grade	Remarks	Tot.	Mark	Description	Length	NO.	Qty	ABM #	Grade	Remarks	Remarks	
2	A22	ANGLE		1	2				2	A24	ANGLE		1	2														
2	A22	L76x76x7.9	3887				M270M-345		2	A24	L76x76x7.9	4022				M270M-345												
2	A23	ANGLE		1	2				2	A25	ANGLE		1	2														
2	A23	L76x76x7.9	4022				M270M-345		2	A25	L76x76x7.9	12264				M270M-345												

Total weight : 435

**Renaud Bros. Inc.**  
283 Fort Bridgeman Rd. #2  
Vernon, VT. 05354  
Phone 1-802 257-7383

Holes: 21mm UNG  
BOLTS: 19mm DIA. M164M-I GALV UNG  
Steel GR: M270M-GR345 UNG  
Paint: PER SPECS (GREEN) UNG  
Surface Prep: PER SPECS

Project: **DUMMERSTON BRIDGE**  
DUMMERSTON, VT

Date: 9-9-09  
Job No. 240 1442(28)  
Sheet No. 10

Rev. No.: EG  
Checked: MRS

Nov 08 2009 10:55:01 AM