



Nov 06 2008 10:55:05 AM

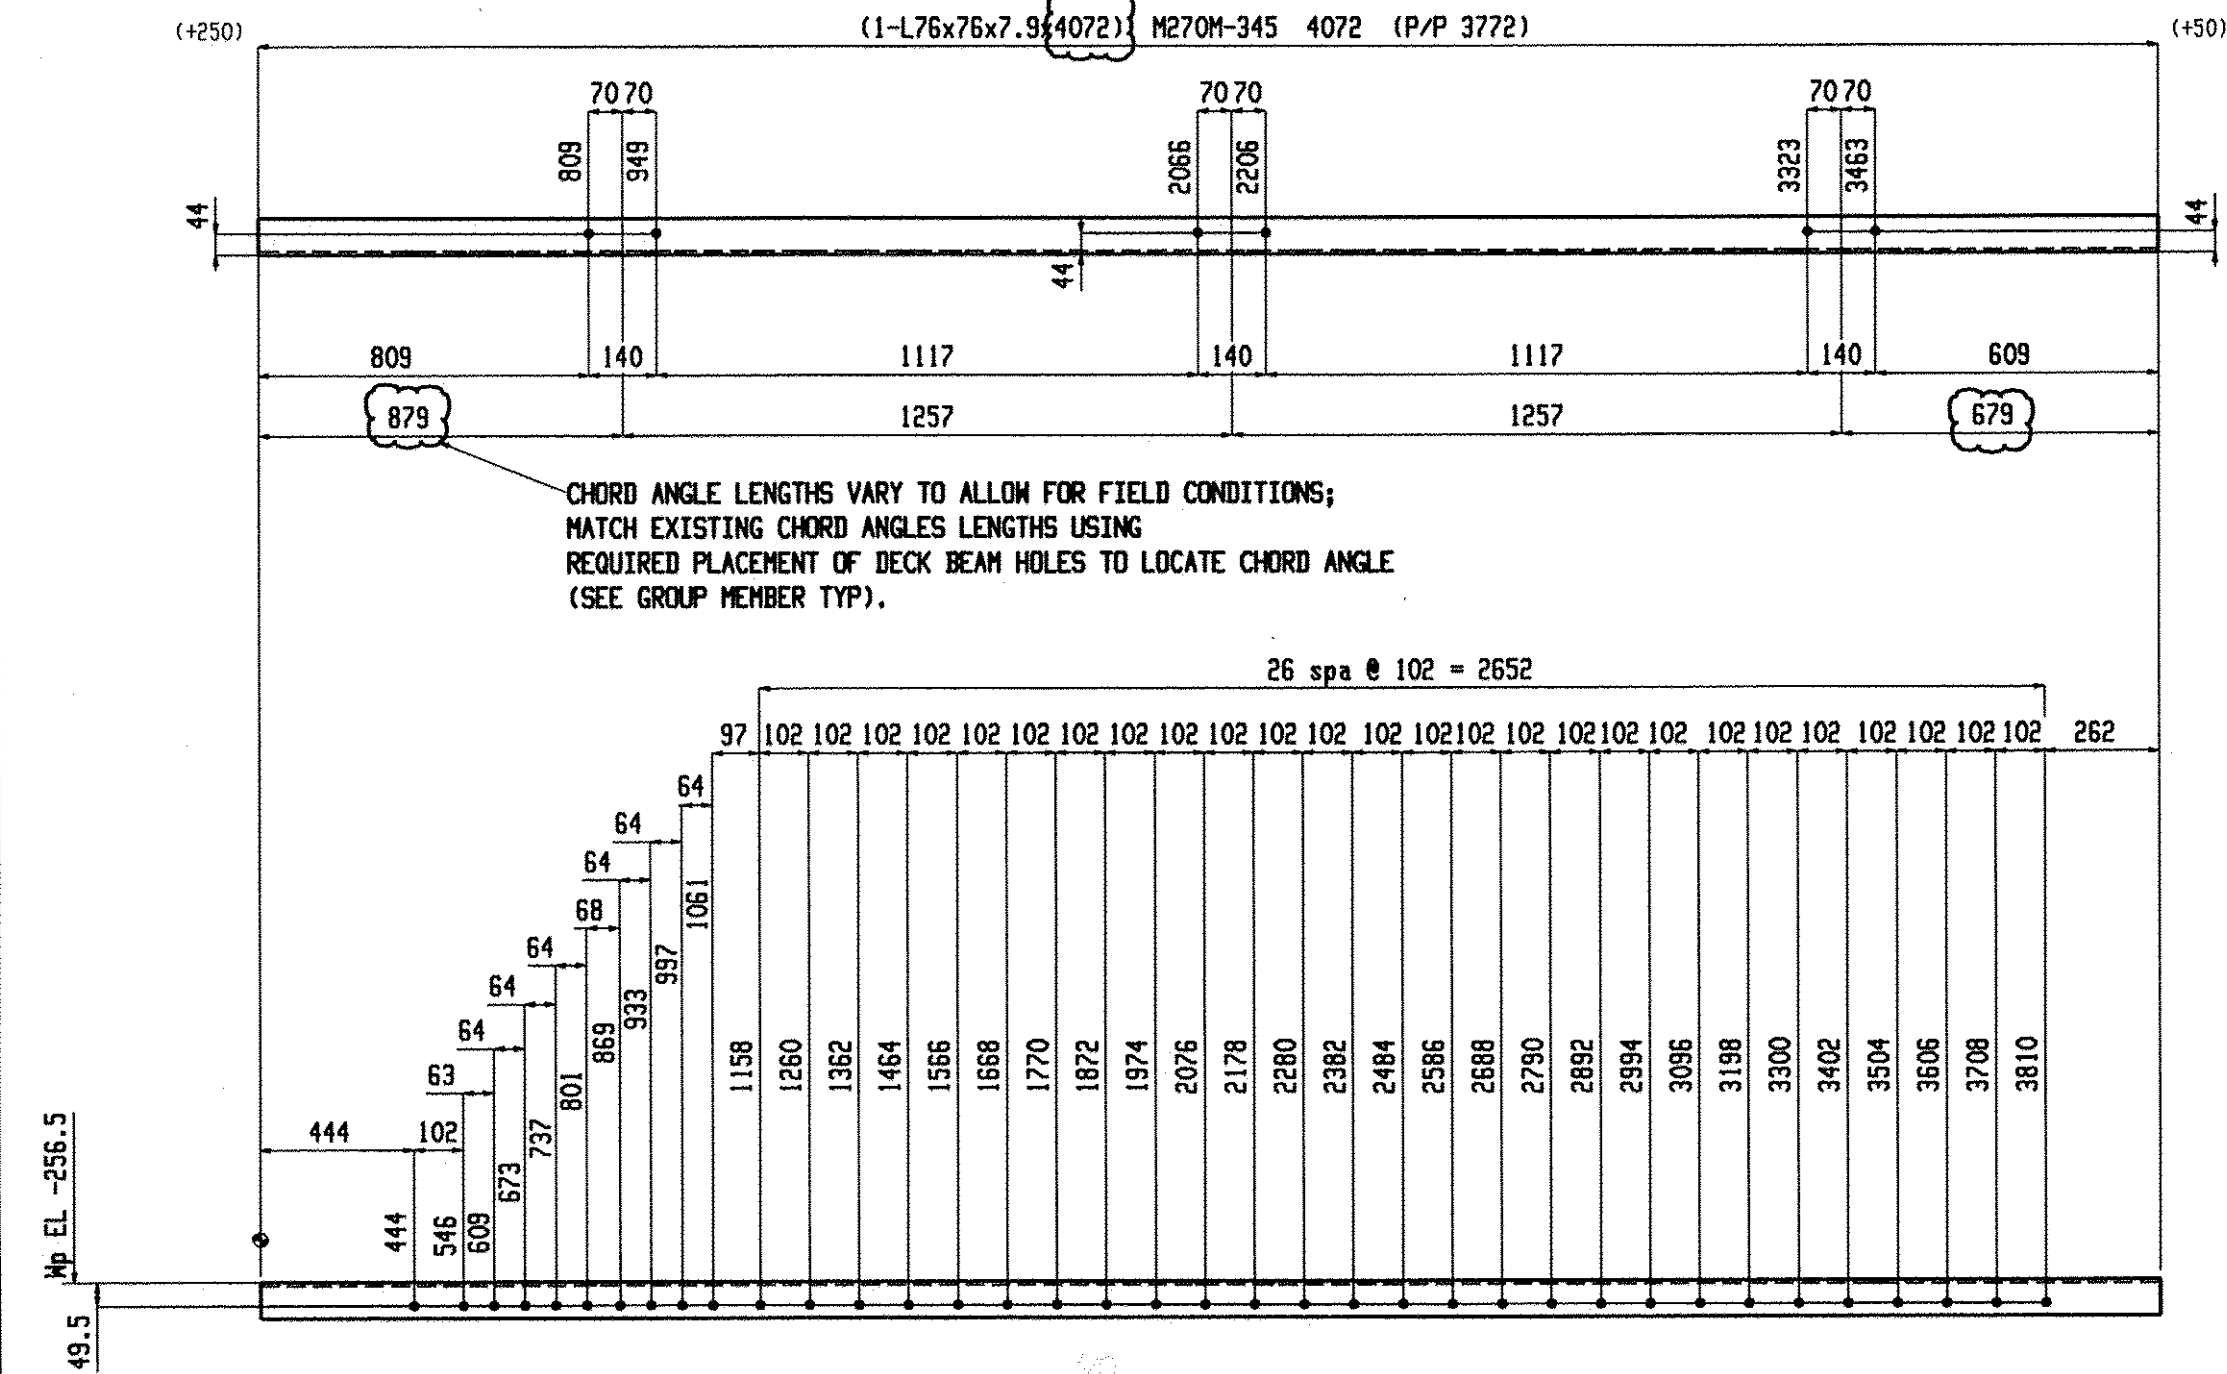


2 ANGLES A26

SHOP NOTE:
TOE DIRECTION FAR SIDE

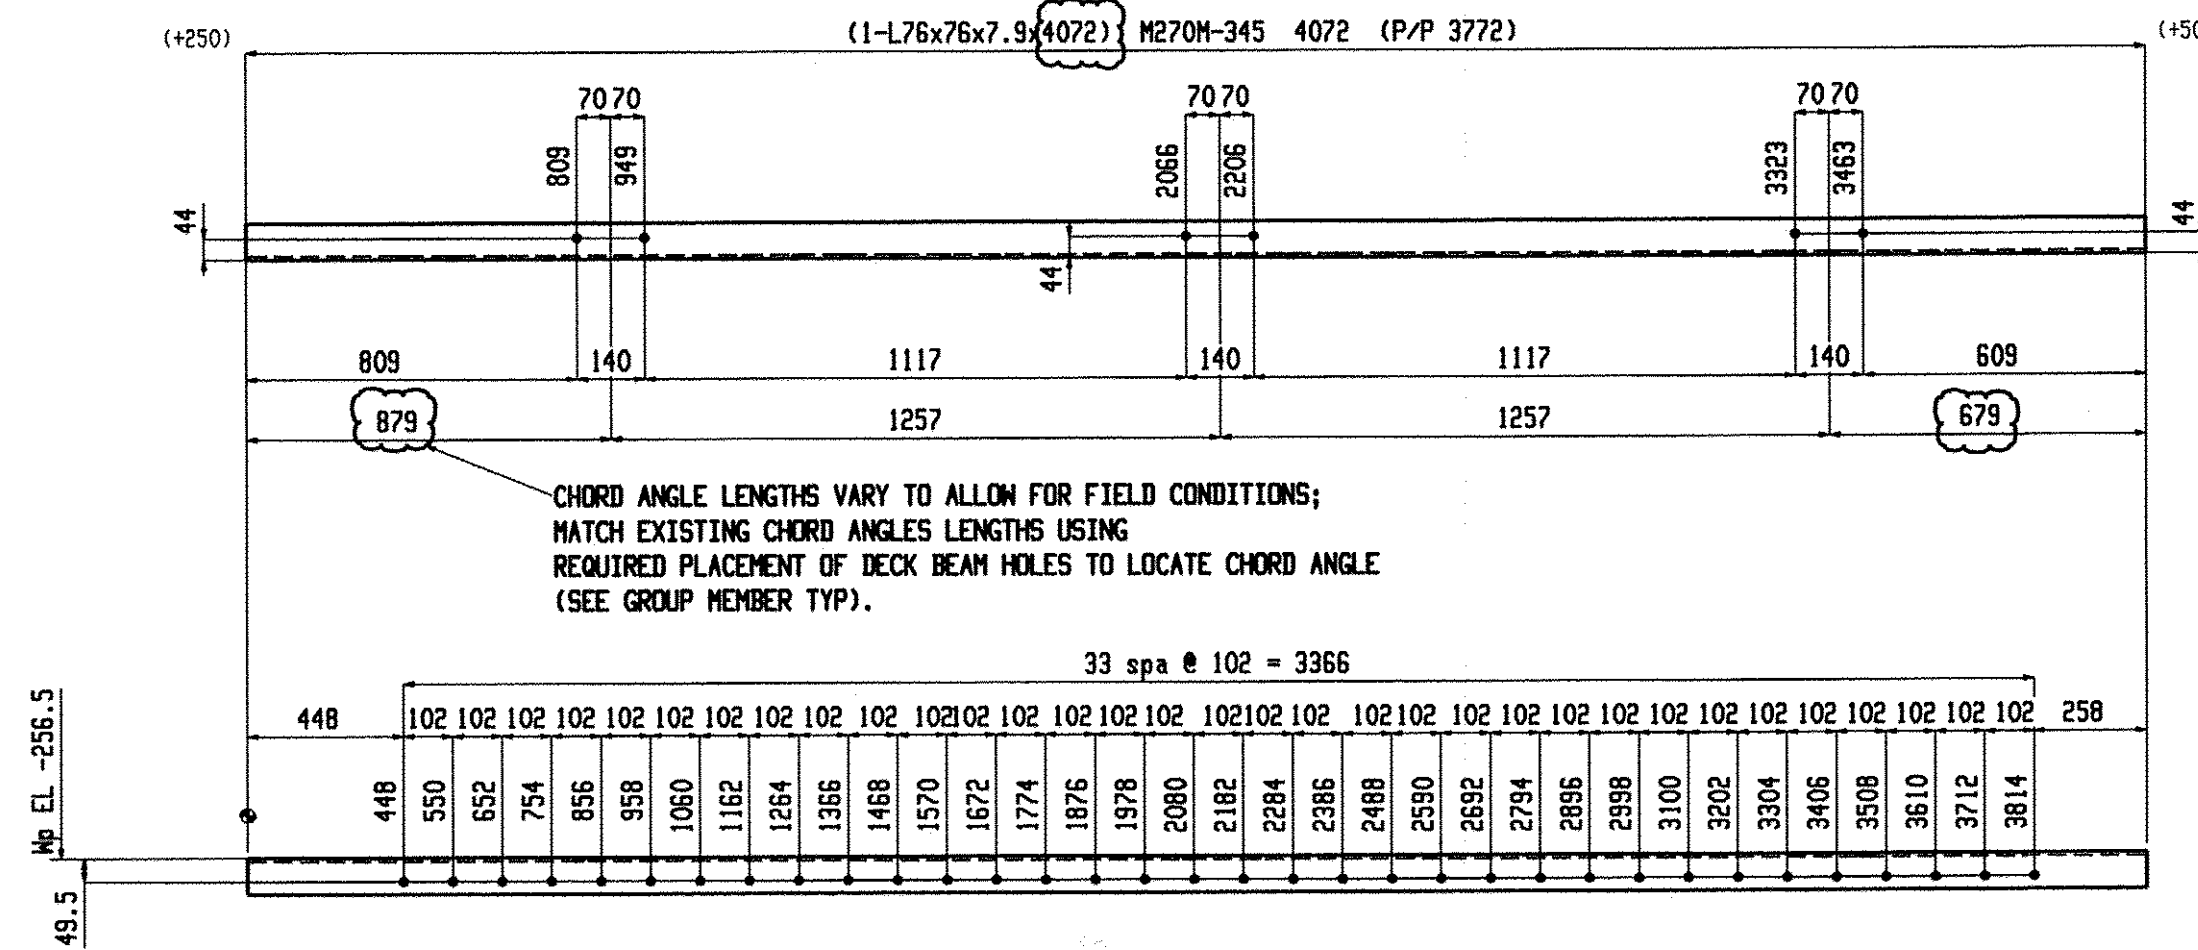


2 ANGLES A28

SHOP NOTE:
TOE DIRECTION FAR SIDE

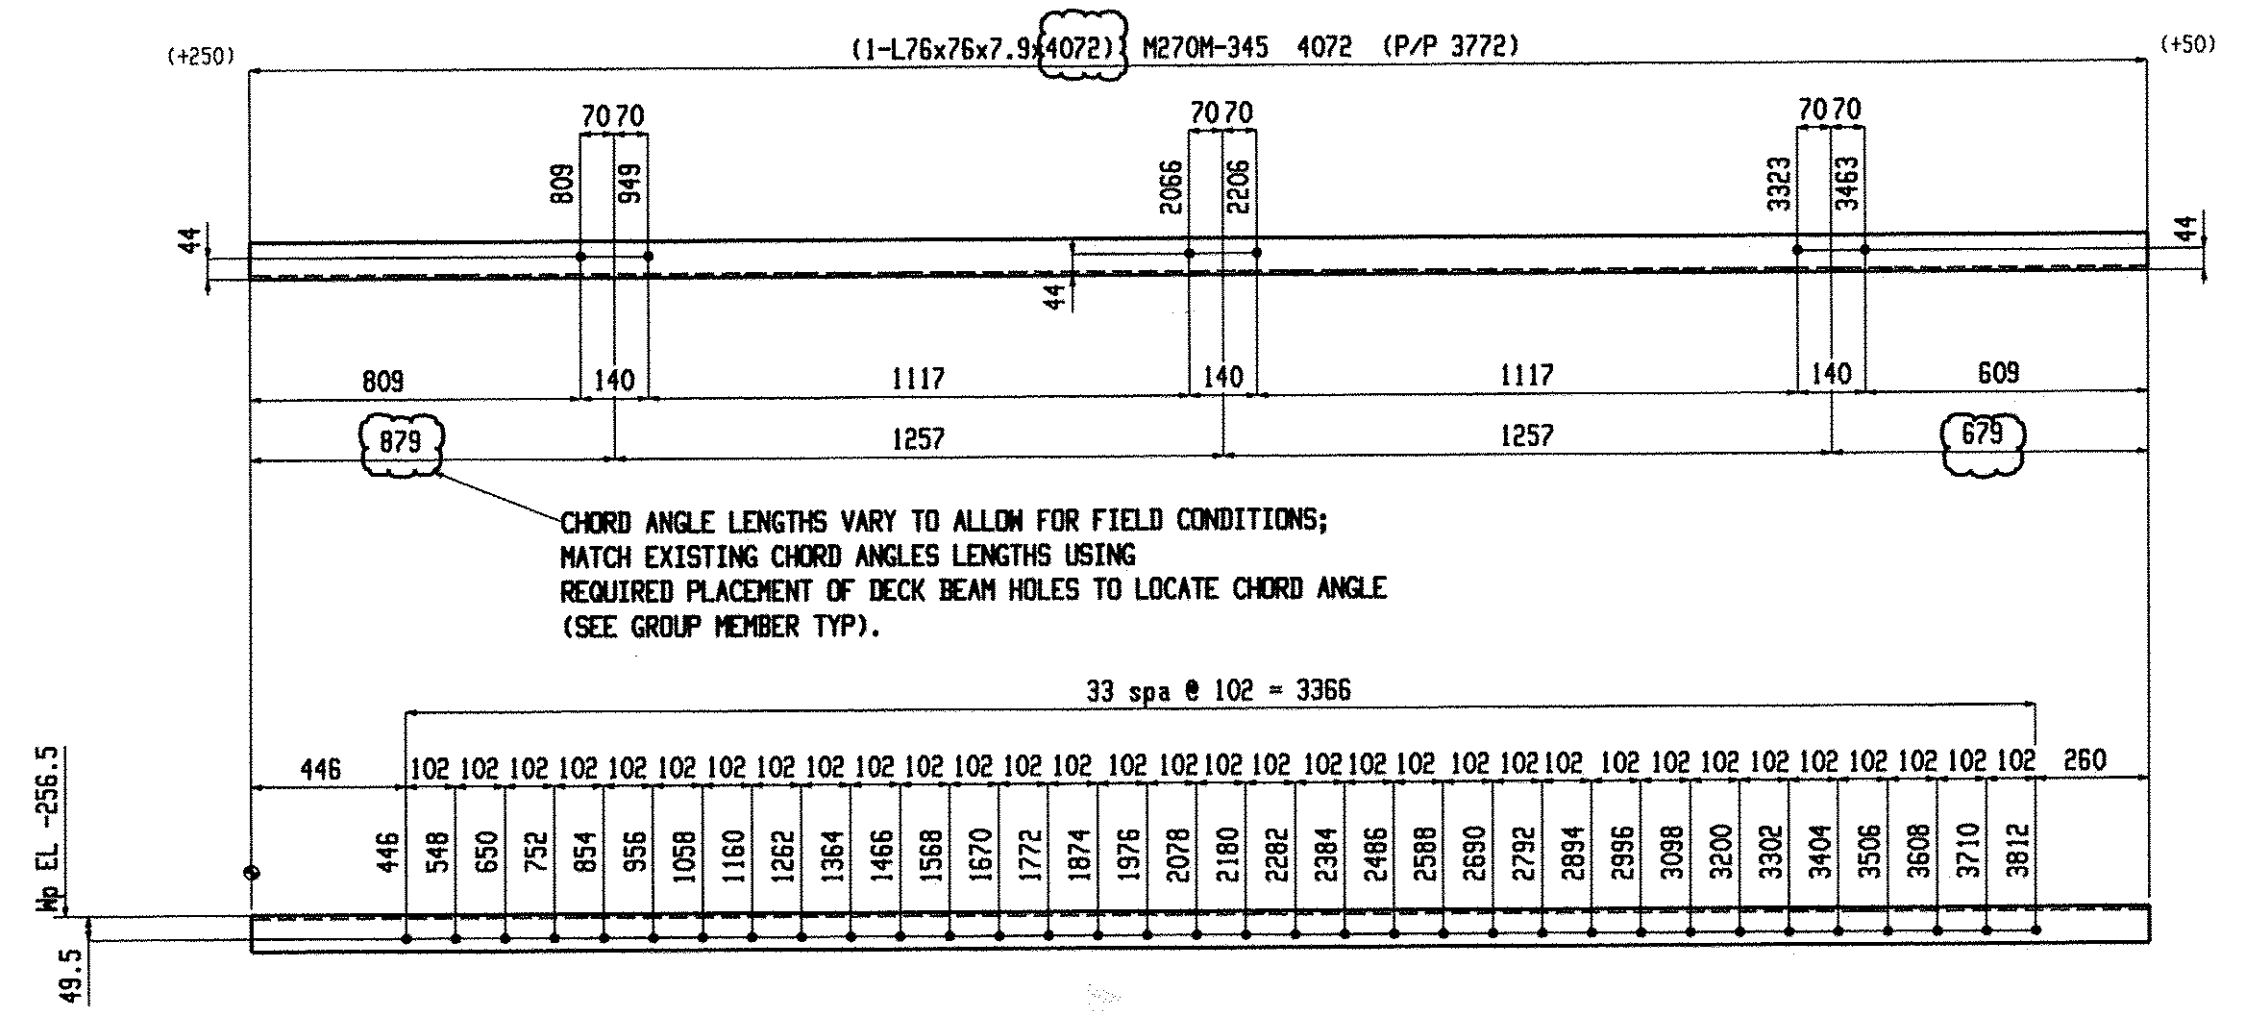

2 ANGLES A27

SHOP NOTE:
TOE DIRECTION FAR SIDE

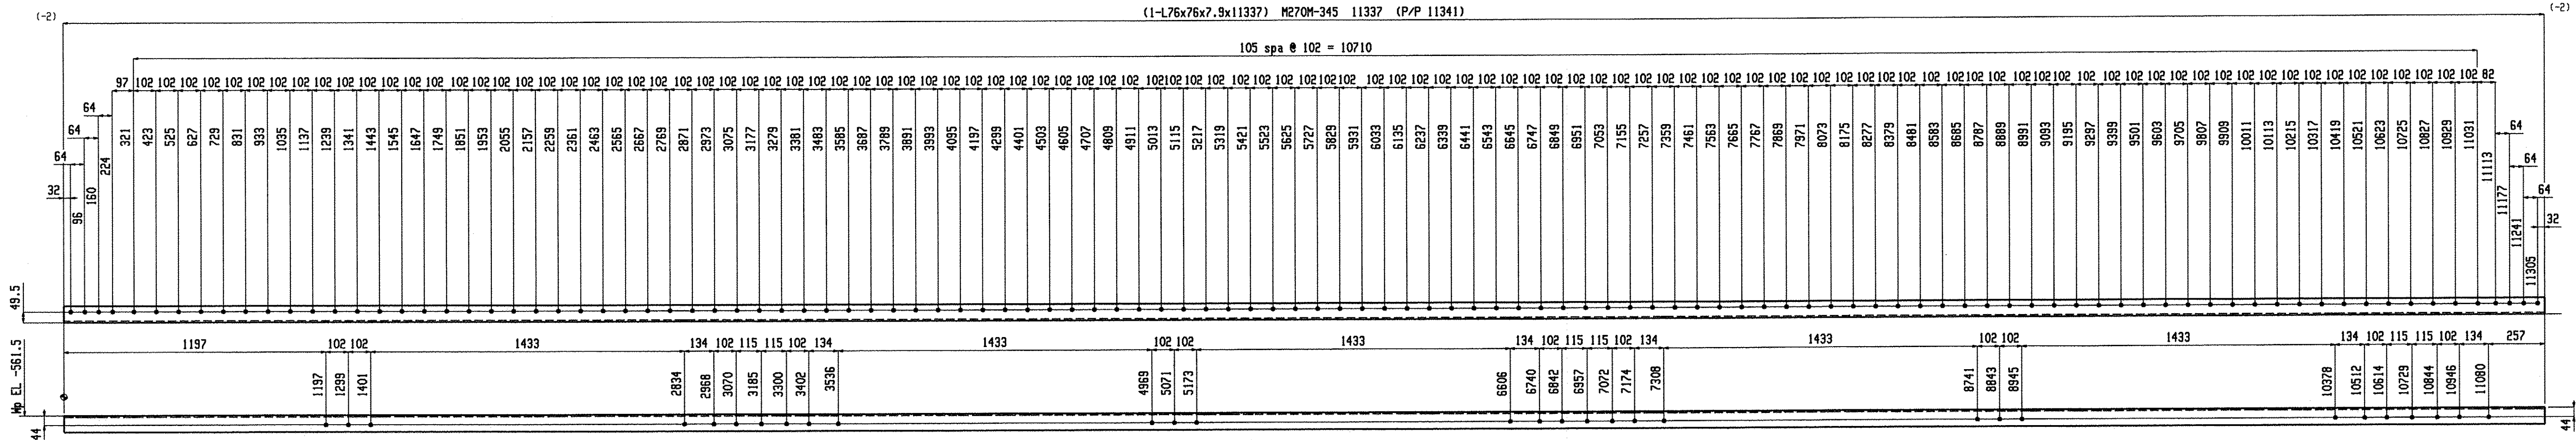

2 ANGLES A29

SHOP NOTE:
TOE DIRECTION FAR SIDE

BILL OF MATERIAL									BILL OF MATERIAL									BILL OF MATERIAL								
Qty	Piece								Qty	Piece								Qty	Piece							
Tot.	Mark	Description	Length	Seq	Seq	Adv	Steel	Remarks	Tot.	Mark	Description	Length	Seq	Seq	Adv	Steel	Remarks	Tot.	Mark	Description	Length	Seq	Seq	Adv	Steel	Remarks
2	A26	ANGLE		1	2				2	A28	ANGLE		1	2												
2	A26	L76x76x7.9	4072				M270M-345		2	A28	L76x76x7.9	4072				M270M-345										
2	A27	ANGLE		1	2				2	A29	ANGLE		1	2												
2	A27	L76x76x7.9	4072				M270M-345		2	A29	L76x76x7.9	11337				M270M-345										

Total weight = 423

NOTE: WORK THIS DRAWING WITH
GROUP MEMBER GM7

Renaud Bros. Inc. 283 Fort Bridgeman Rd. #2 Vernon, VT. 05354 Phone 1-802 257-7383		Holes:		21mm UNO
		BOLTS:		19mm DIA. M164M-I GALV UNO
		Steel GR:		M270M-GR345 UNO
		Paint:		PER SPECS (GREEN) UNO
Rev.No:	Date:	Surface Prep:		PER SPECS
Project:		Date:		Job No.
DUMMERSTON BRIDGE		9-9-09		1442(28)
DUMMERSTON, VT		DWN. BY:	Checked:	Sheet No.
		EG	MRS	11