



SHOP NOTE:
TOE DIRECTION FAR SIDE

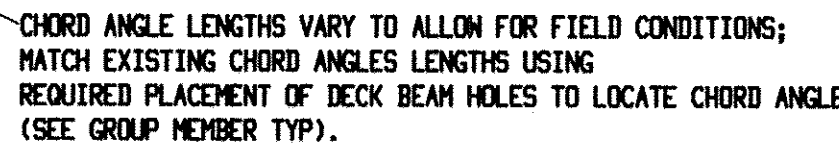

SHOP NOTE:
TOE DIRECTION FAR SIDE

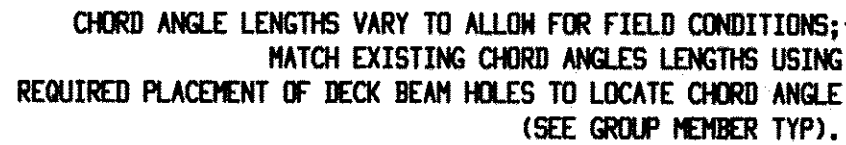

SHOP NOTE:
TOE DIRECTION FAR SIDE

Total weight : 435

NOTE: WORK THIS DRAWING WITH
GROUP MEMBER GM10

Renaud Bros. Inc. 283 Fort Bridgeman Rd. #2 Vernon, VT. 05354 Phone 1-802 257-7383			Holes: 21mm UNCL
			BOLTS: 19mm DIA. M164M-I GALV UNCL
			Steel GR: M270M-GR345
			Paint: 1 PER SPECS (GREEN) UNCL
	Rev. No:	Date:	Surface Prep: PER SPECS
Project: DUMMERSTON BRIDGE DUMMERSTON, VT		Date: 9-9-09 DWN. BY: EG Checked: MRS	Job No. BHO 1442 (28) Sheet No. 14

Product