



12171

CHORD PLATE LENGTHS VARY TO ALLOW FOR FIELD CONDITIONS;
MATCH EXISTING CHORD PLATE LENGTHS AS REQUIRED
(SEE GROUP MEMBER TYP).

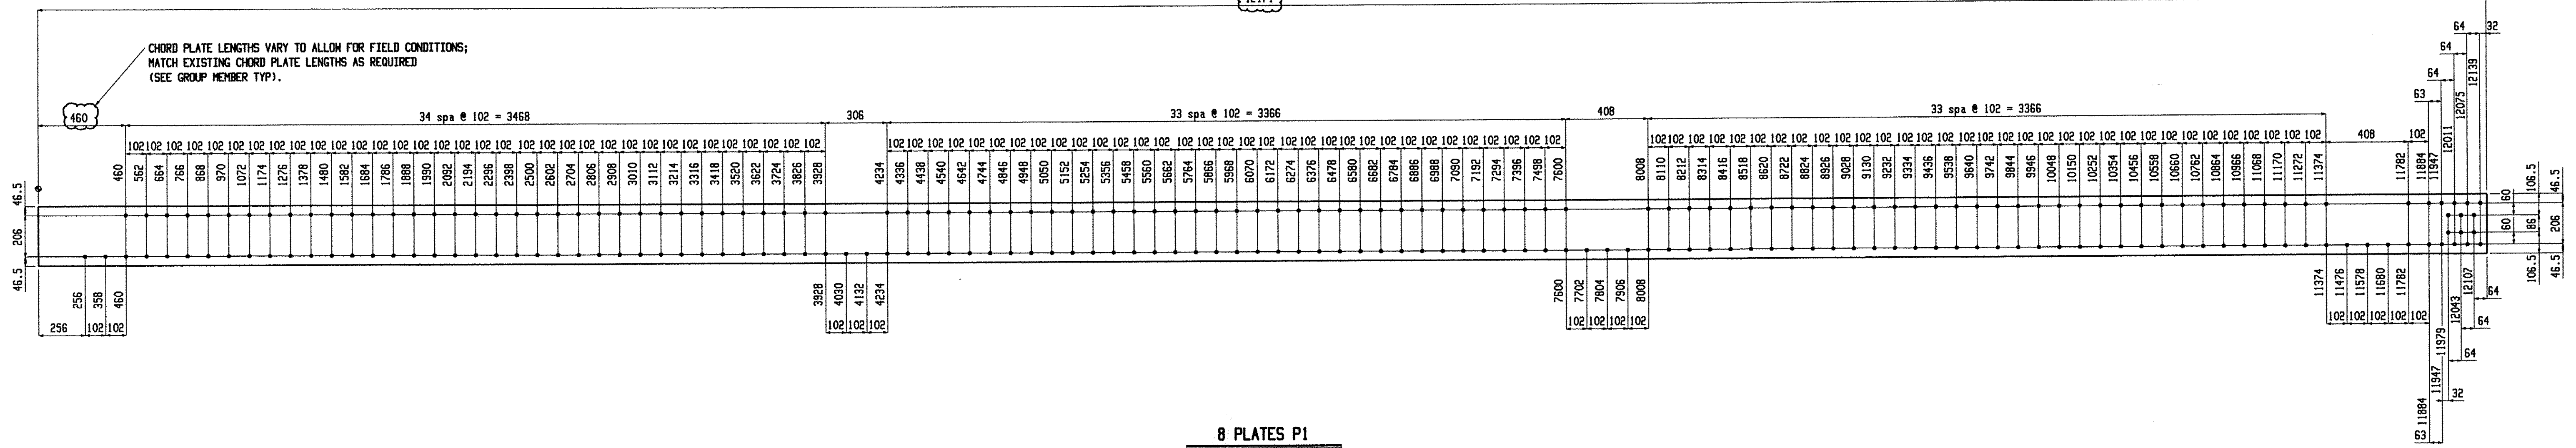


8 PLATES P1

11397

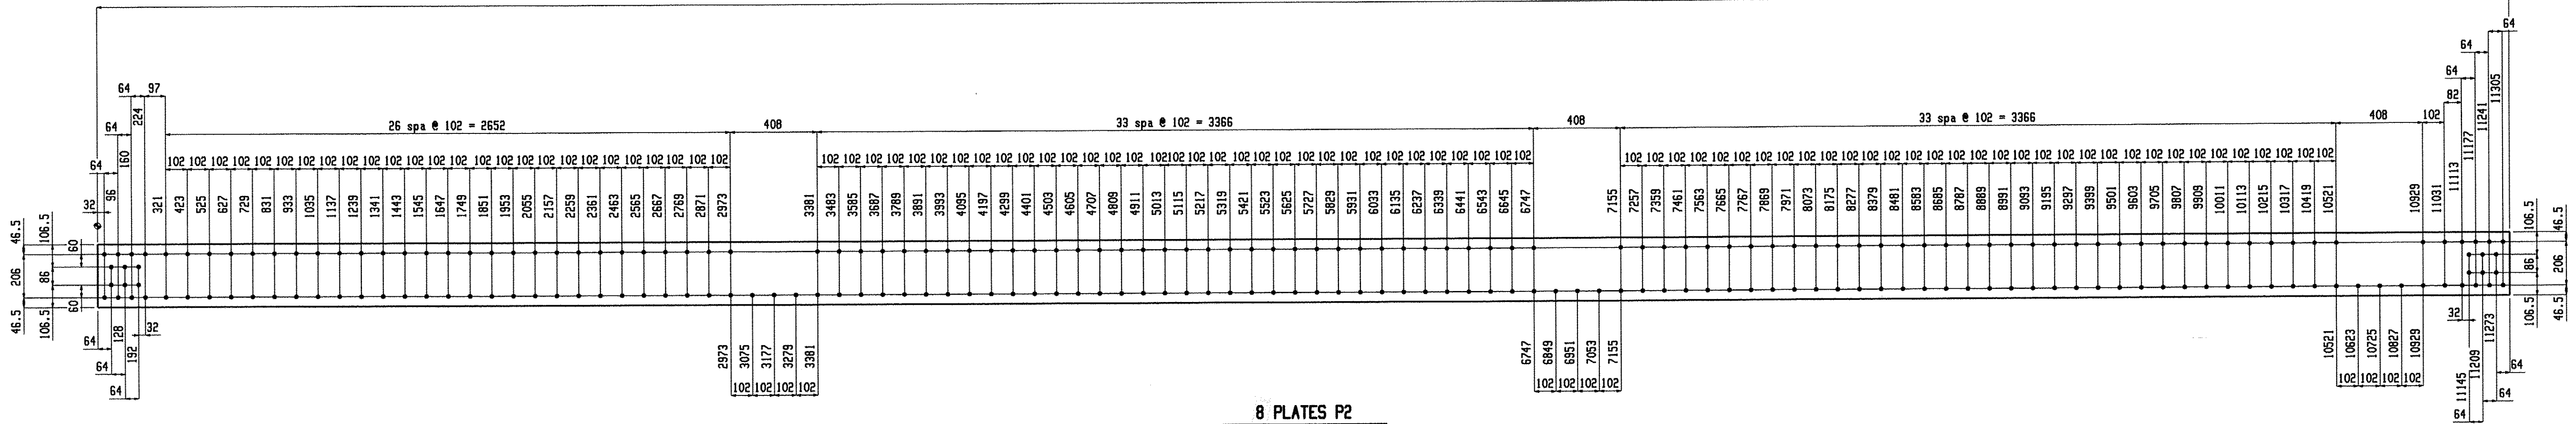

8 PLATES P2

13864

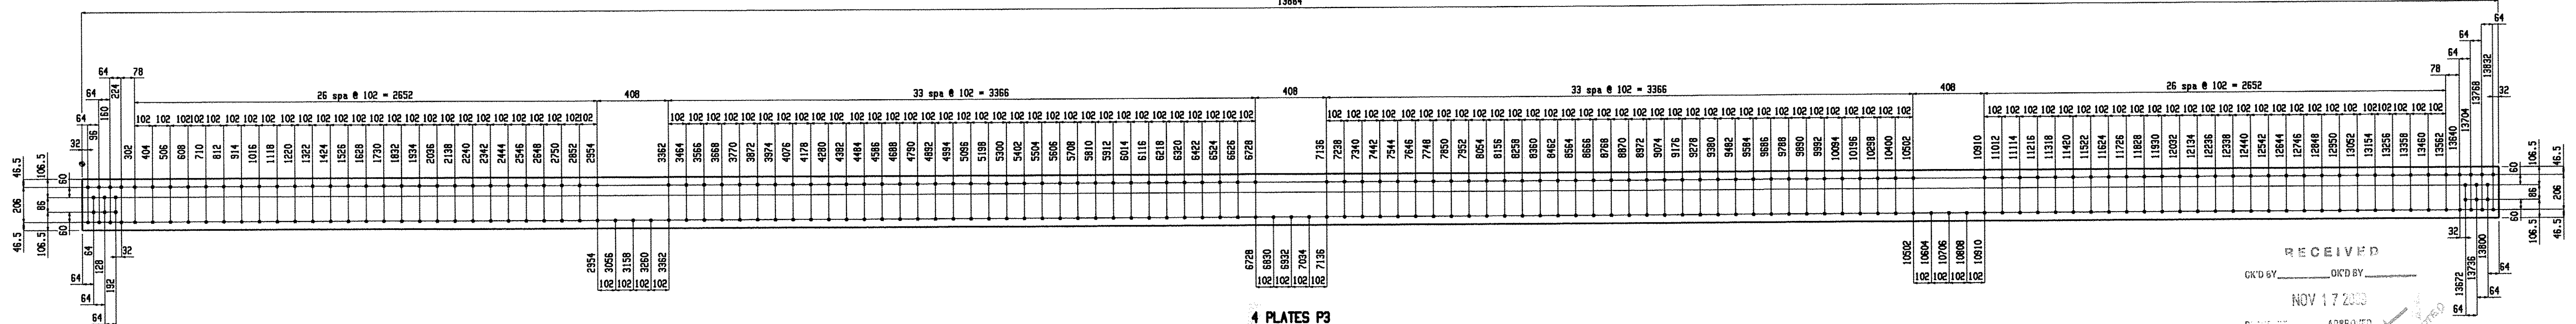

4 PLATES P3

RECEIVED
 OK'D BY _____
 NOV 17 2003
 R. J. ... APPROVED
 BY _____ DATE _____

NOTE: WORK THIS DRAWING WITH GROUP MEMBER GM1-GM10

Qty	Piece	Description	Length	Seq	Seq	Adv	Steel	Remarks
Tot.	Mark			NO.	Qty	ABM #	Grade	
8	P1	PLATE		1		8		
8	P1	PLG. 4x299	12171				M270M-345	
8	P2	PLATE		1		8		
8	P2	PLG. 4x299	11337				M270M-345	

Qty	Piece	Description	Length	Seq	Seq	Adv	Steel	Remarks
Tot.	Mark			NO.	Qty	ABM #	Grade	
4	P3	PLATE		1		4		
4	P3	PLG. 4x299	13864				M270M-345	

Qty	Piece	Description	Length	Seq	Seq	Adv	Steel	Remarks
Tot.	Mark			NO.	Qty	ABM #	Grade	
8	P1	PLATE		1		8		
8	P1	PLG. 4x299	12171				M270M-345	
8	P2	PLATE		1		8		
8	P2	PLG. 4x299	11337				M270M-345	

Total weight : 3657

Renaud Bros. Inc.
 283 Fort Bridgeman Rd. #2
 Vernon, VT. 05354
 Phone 1-802-257-7383

Holes: 21mm UNO
 BOLTS: 19mm DIA. M164M-I GALV UNO
 Steel GR: M270M-GR345 UNO
 Paint: PER SPECS (GREEN) UNO
 Surface Prep: PER SPECS

Rev.No: _____ Date: 9-9-09
 Project: DUMMERSTON BRIDGE
 DUMMERSTON, VT
 Job No. BHO 1442 (28)
 DWN. BY: EG Checked: MRS Sheet No. 15