

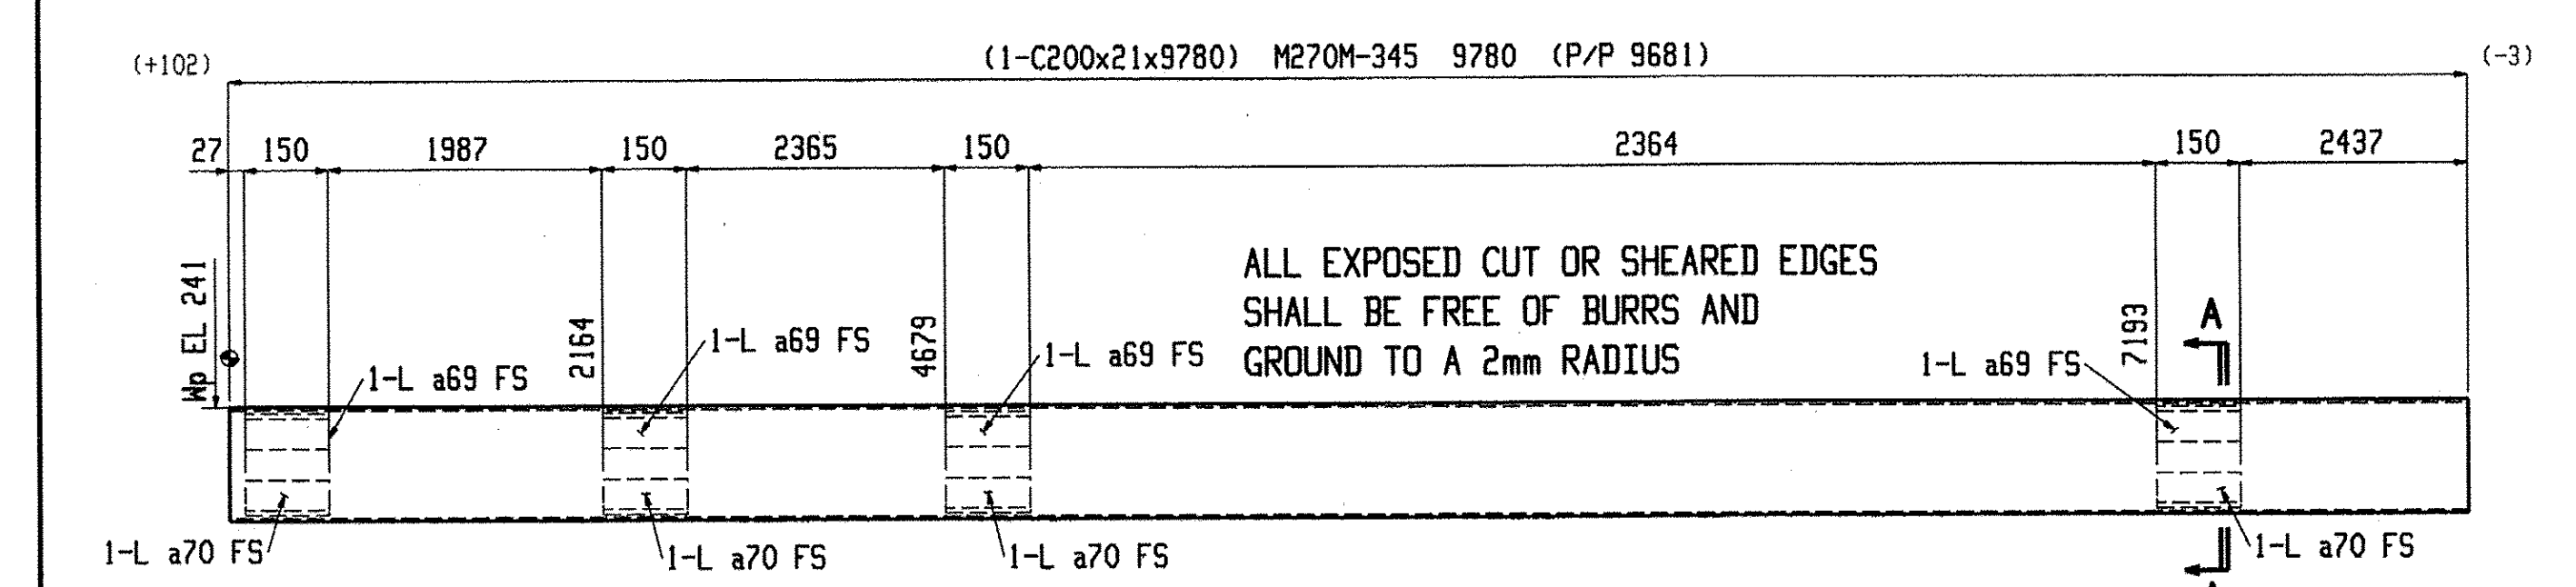


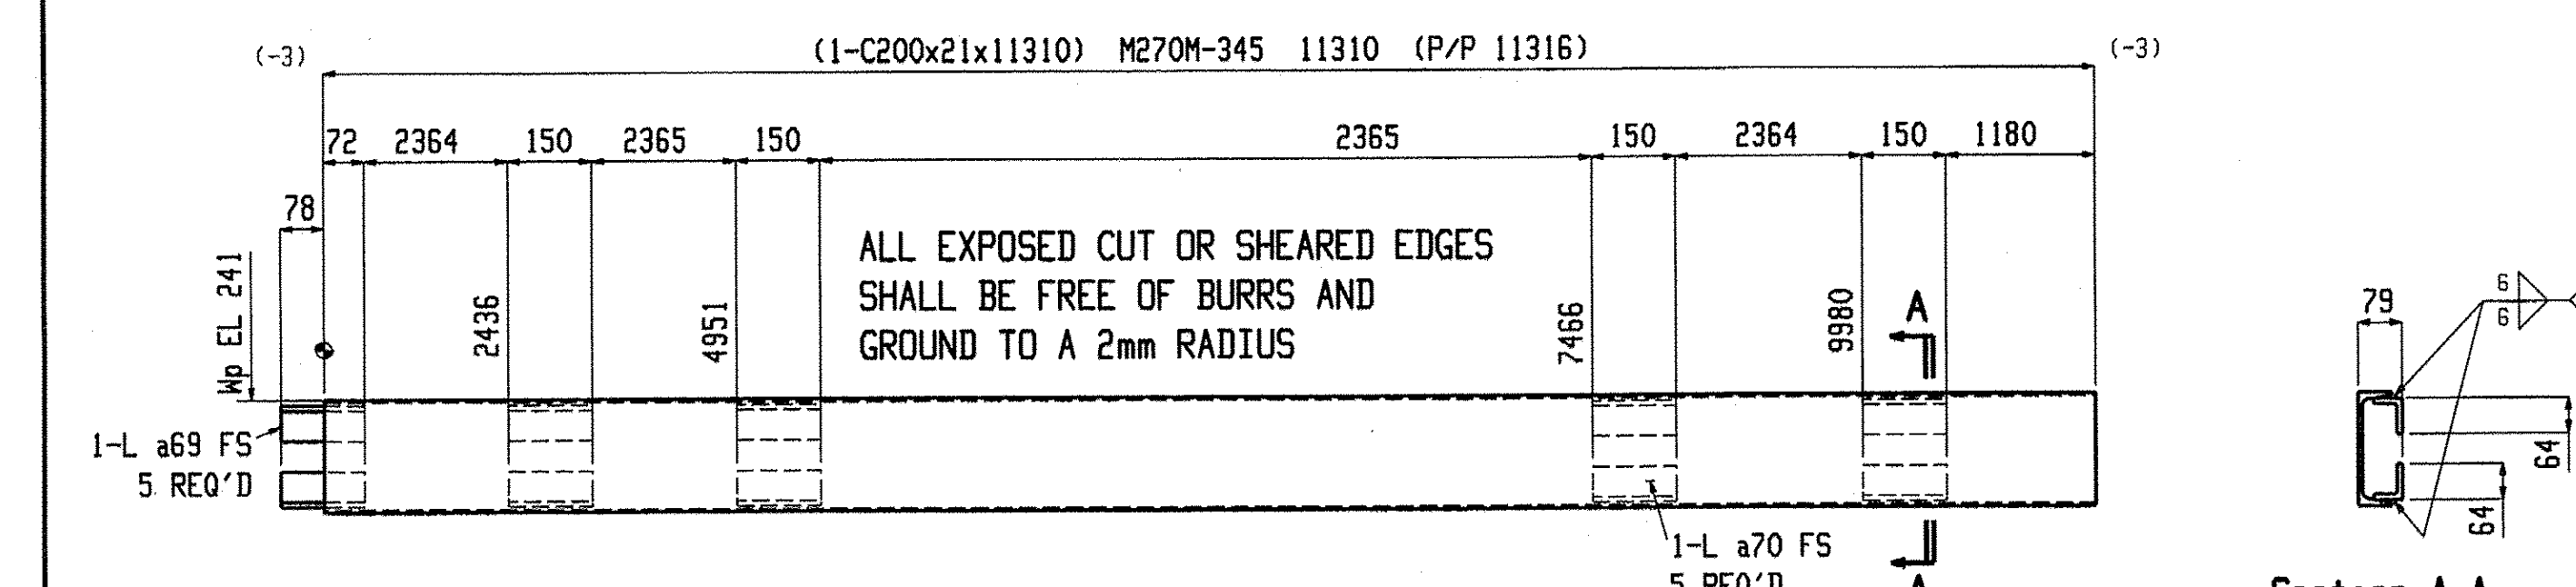



ONE BEAM R12
 W 203x7.5
 F 59.5x10
 K 24x18

SHOP NOTE:
 TOE DIRECTION FAR SIDE

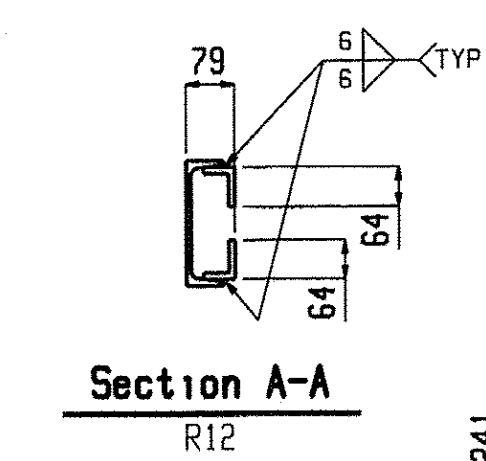


ONE BEAM R14
 W 203x7.5
 F 59.5x10
 K 24x18

SHOP NOTE:
 TOE DIRECTION FAR SIDE

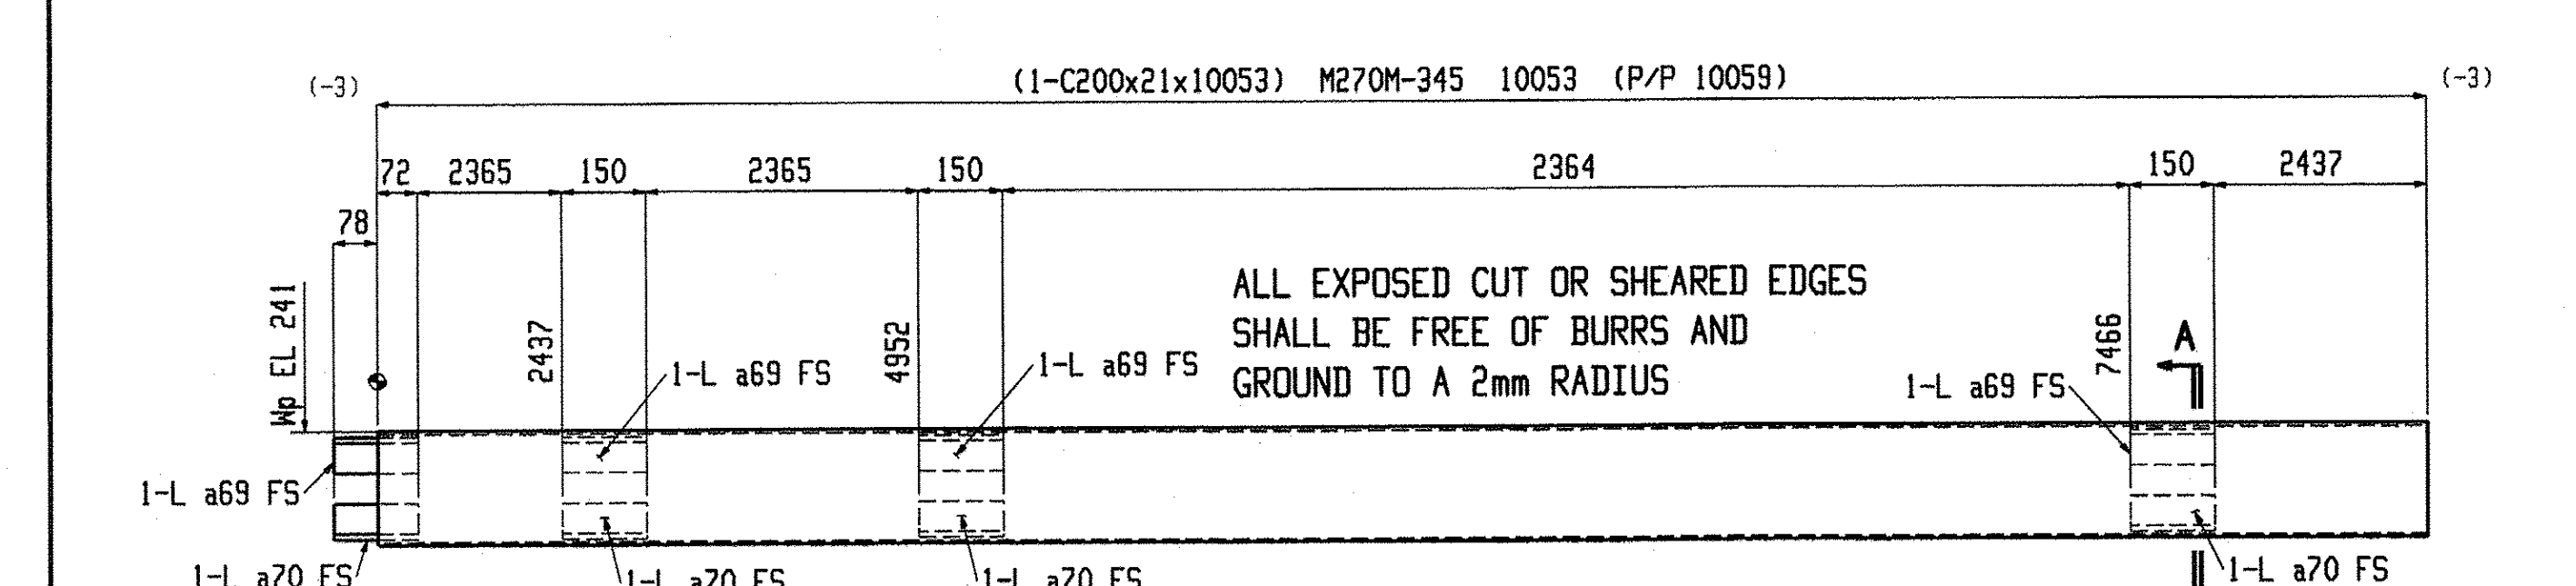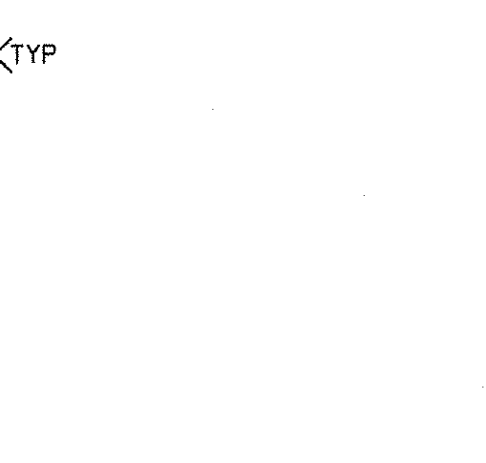

ONE BEAM R16
 W 203x7.5
 F 59.5x10
 K 24x18

SHOP NOTE:
 TOE DIRECTION FAR SIDE

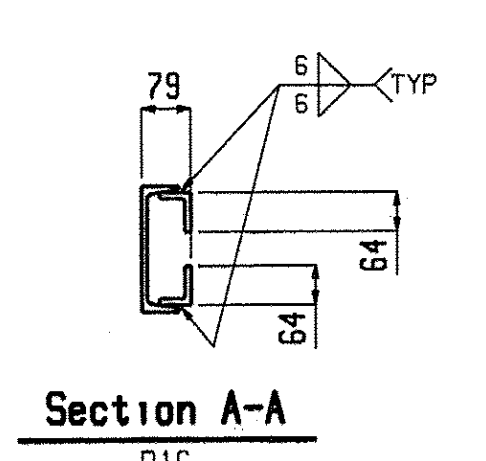


BILL OF MATERIAL									
Qty	Piece			Seq	Seq	Adv	Steel		
Tot.	Mark	Description	Length	NO.	Qty	ABM #	Grade	Remarks	
ONE	R12	BEAM		2	1				
1	R12	C200x21	9780				M270M-345		
4	a69	L64x51x9.5	150				M270M-345		
4	a70	L64x51x9.5	150				M270M-345		
ONE	R13	BEAM		2	1				
1	R13	C200x21	10053				M270M-345		
4	a69	L64x51x9.5	150				M270M-345		
4	a70	L64x51x9.5	150				M270M-345		

BILL OF MATERIAL									
Qty	Piece			Seq	Seq	Adv	Steel		
Tot.	Mark	Description	Length	NO.	Qty	ABM #	Grade	Remarks	
ONE	R14	BEAM		2	1				
1	R14	C200x21	11310				M270M-345		
5	a69	L64x51x9.5	150				M270M-345		
5	a70	L64x51x9.5	150				M270M-345		
ONE	R15	BEAM		2	1				
1	R15	C200x21	10052				M270M-345		
4	a69	L64x51x9.5	150				M270M-345		

BILL OF MATERIAL									
Qty	Piece			Seq	Seq	Adv	Steel		
Tot.	Mark	Description	Length	NO.	Qty	ABM #	Grade	Remarks	
4	a70	L64x51x9.5	150				M270M-345		
ONE	R16	BEAM		2	1				
1	R16	C200x21	10053				M270M-345		
4	a69	L64x51x9.5	150				M270M-345		
4	a70	L64x51x9.5	150				M270M-345		



Total weight : 1098

Nov 06 2008 10:55:46 AM

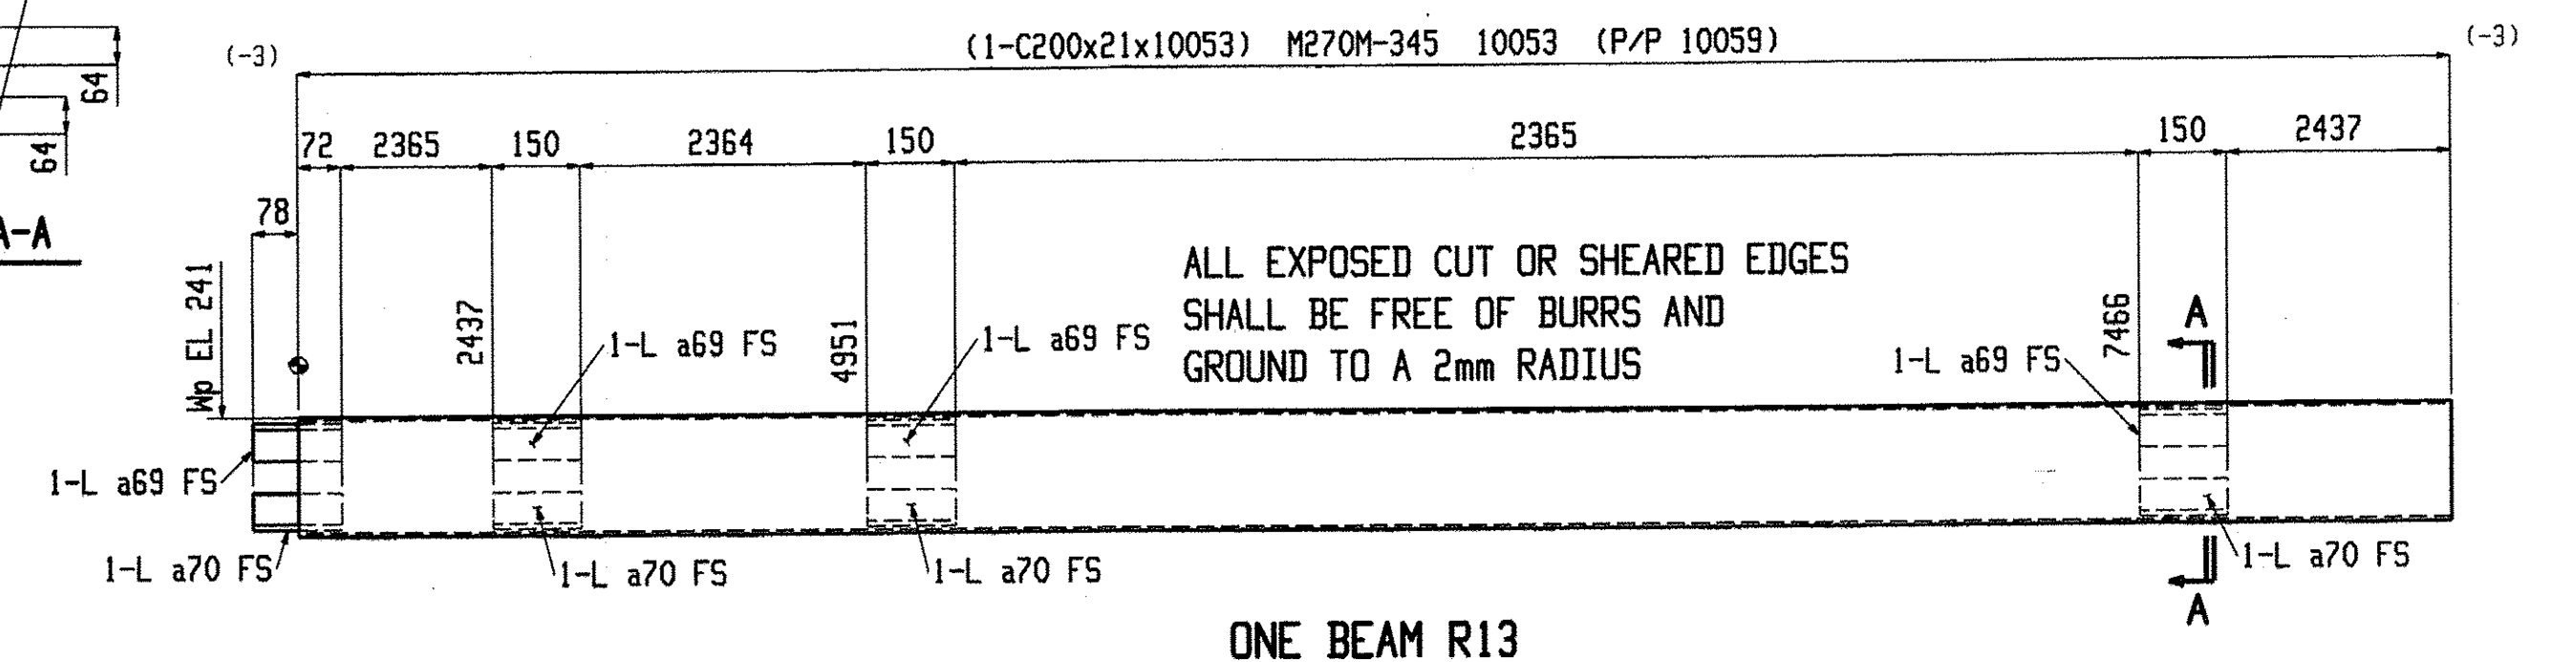


ONE BEAM R13
 W 203x7.5
 F 59.5x10
 K 24x18

SHOP NOTE:
 TOE DIRECTION FAR SIDE

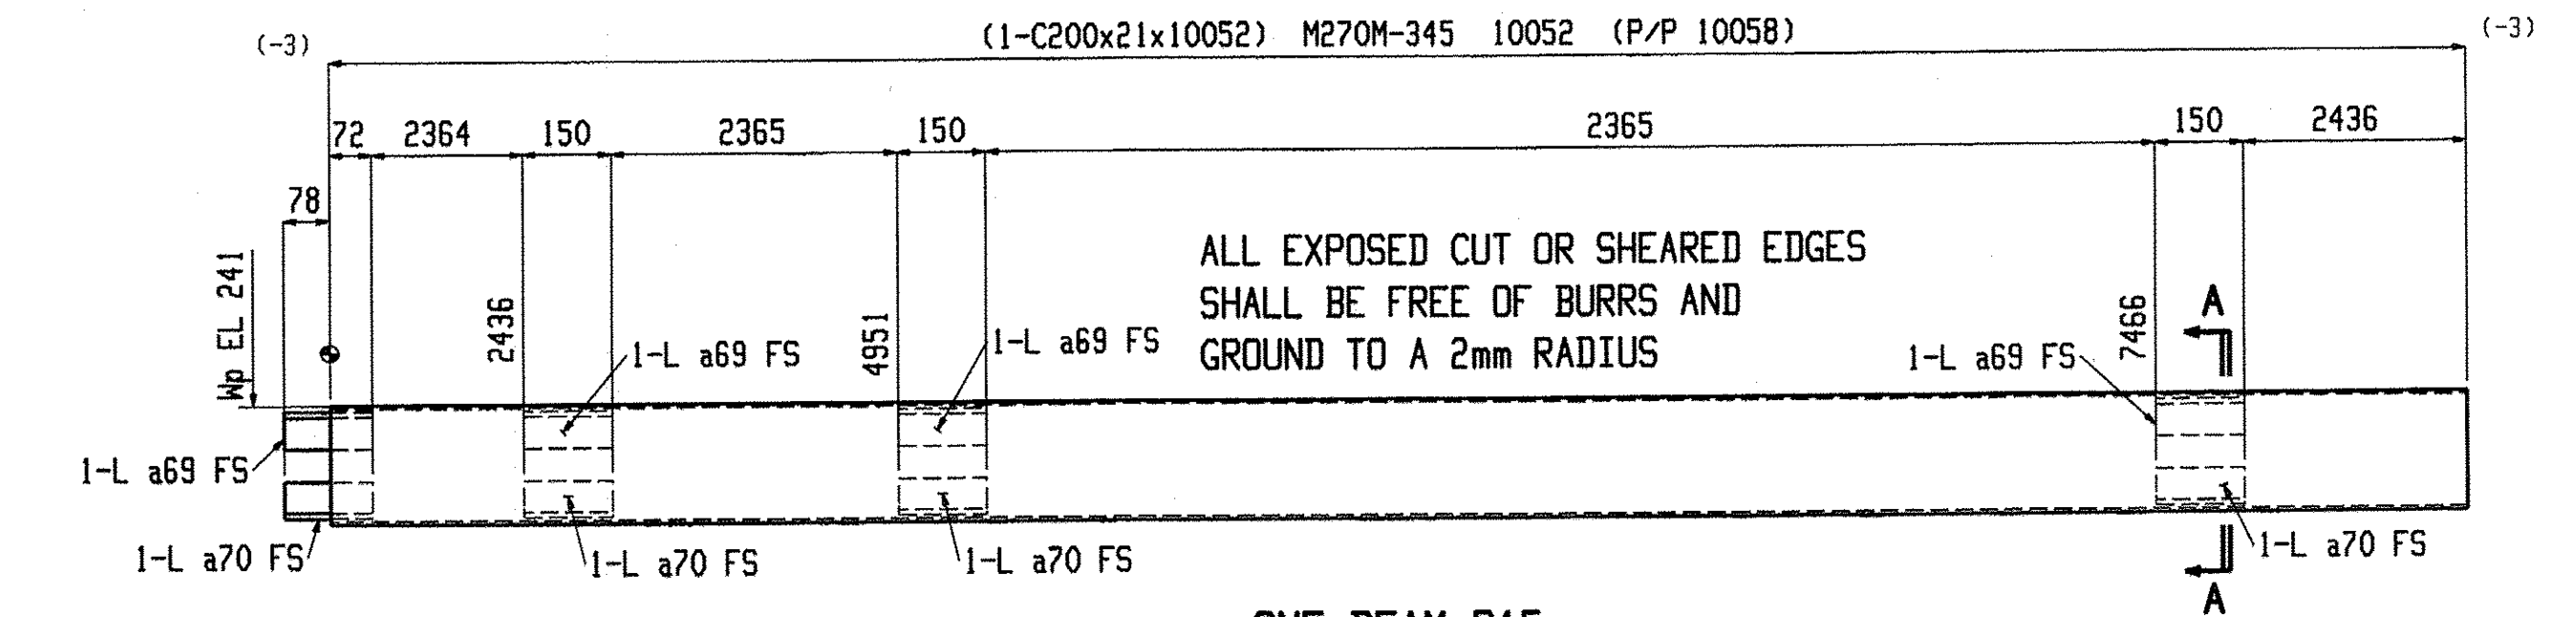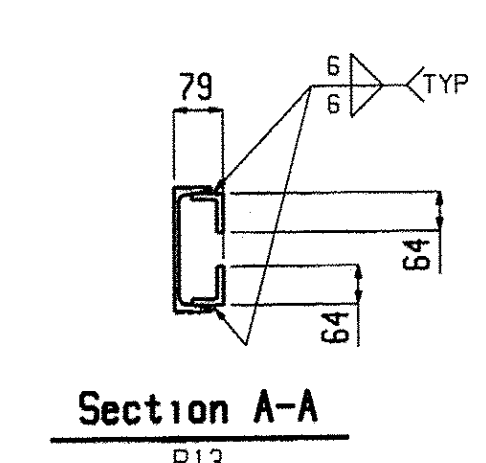

ONE BEAM R15
 W 203x7.5
 F 59.5x10
 K 24x18

SHOP NOTE:
 TOE DIRECTION FAR SIDE

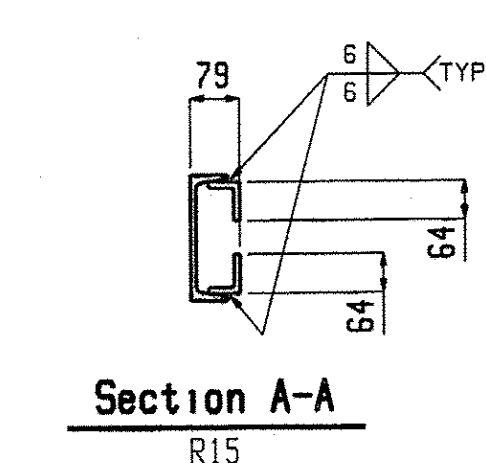

Fabrication is not to be done by Renaud Bros. Have fabricator resubmit with name of fabricator on the drawings.

Renaud Bros. Inc. 283 Fort Bridgeman Rd. #2 Vernon, VT. 05354 Phone 1-802 257-7383		Holes: 21mm UNF BOLTS: 19mm DIA. M16M-I GALV UNF Steel GR: M270M-GR345 UNF Paint: PER SPECS (GREEN) UNF Surface Prep: PER SPECS	
		Date: 9-9-09 Job No. BHO 1442 (28) DWN. BY: EG Checked: MRS Sheet No. 22	
Project: DUMMERSTON BRIDGE DUMMERSTON, VT			