



**ONE BEAM R23**

SHOP NOTE:  
TOE DIRECTION NEAR SIDE

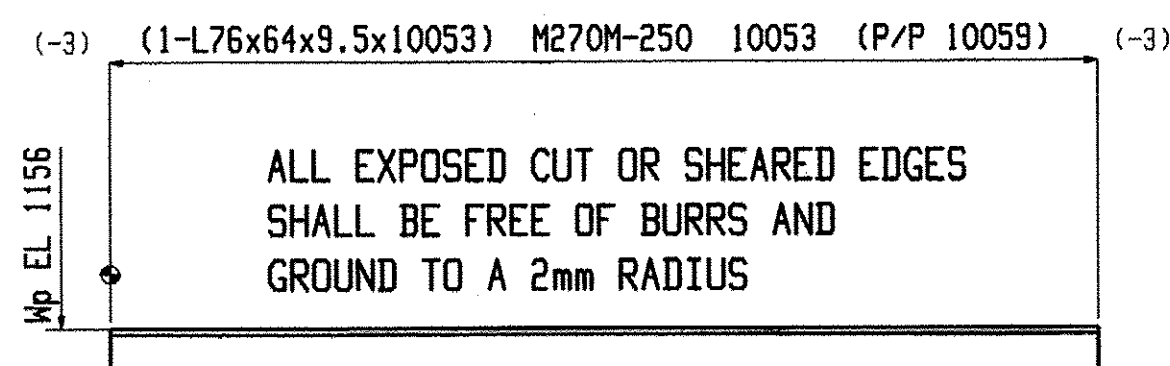


**2 BEAMS R24**

SHOP NOTE:  
TOE DIRECTION NEAR SIDE

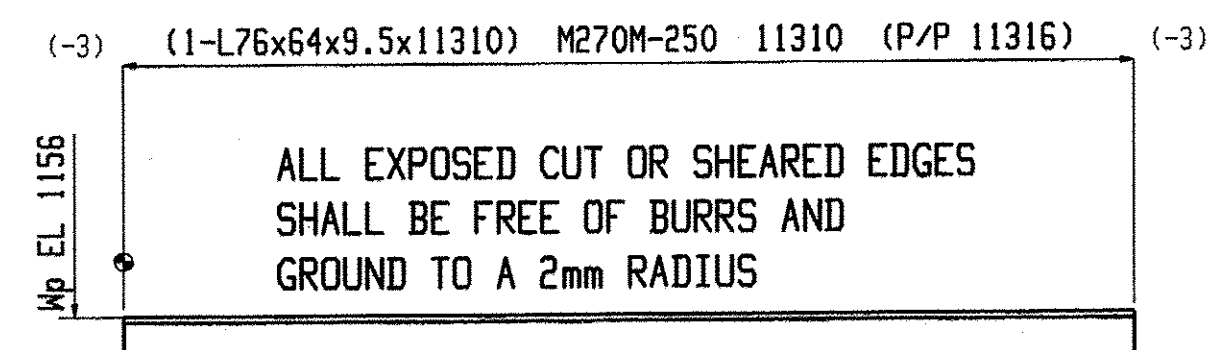


**ONE BEAM R25**

SHOP NOTE:  
TOE DIRECTION NEAR SIDE

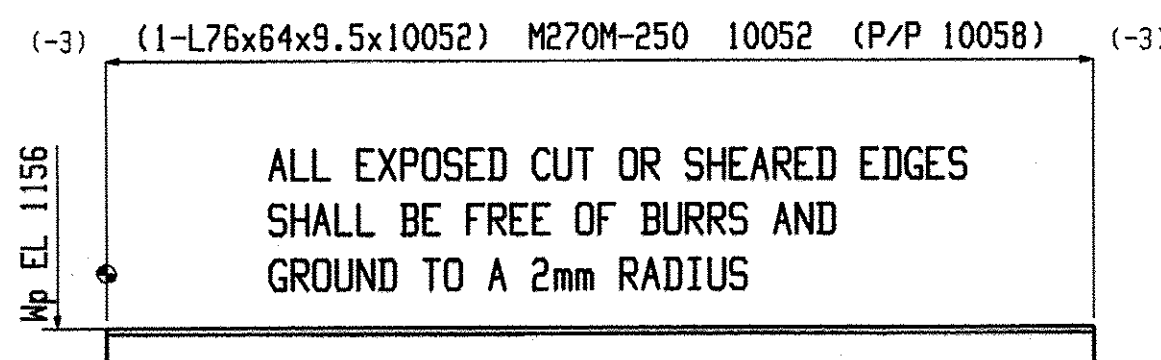


**ONE BEAM R26**

SHOP NOTE:  
TOE DIRECTION NEAR SIDE

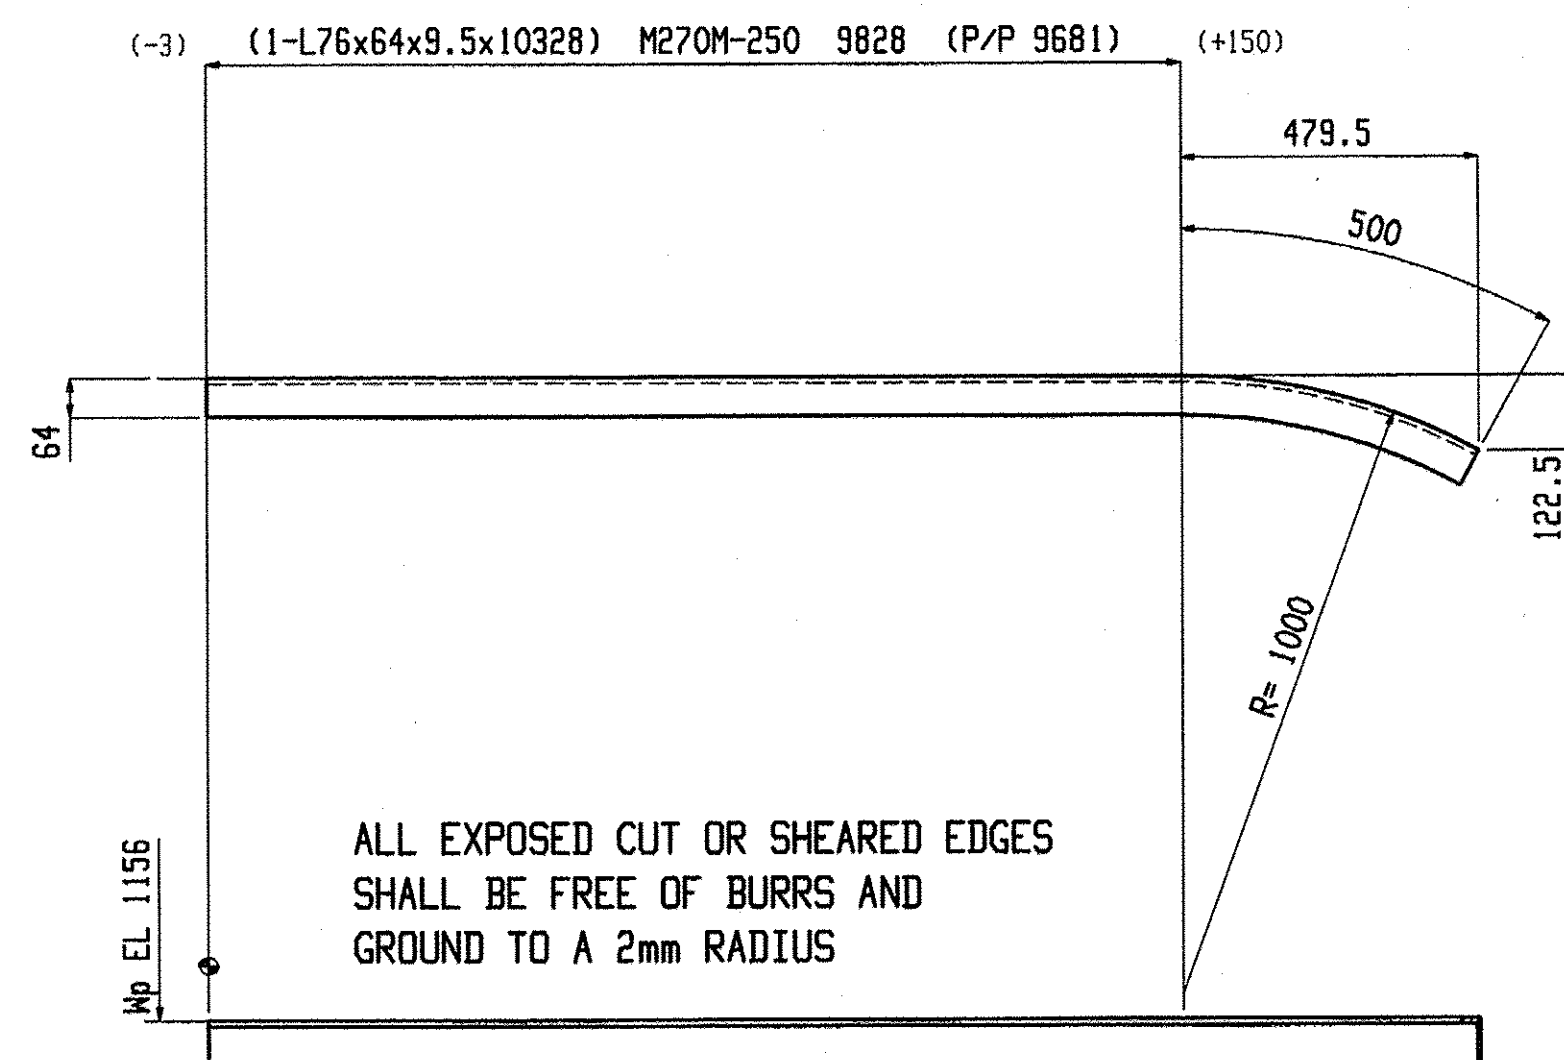


**ONE BEAM R27**

SHOP NOTE:  
TOE DIRECTION NEAR SIDE

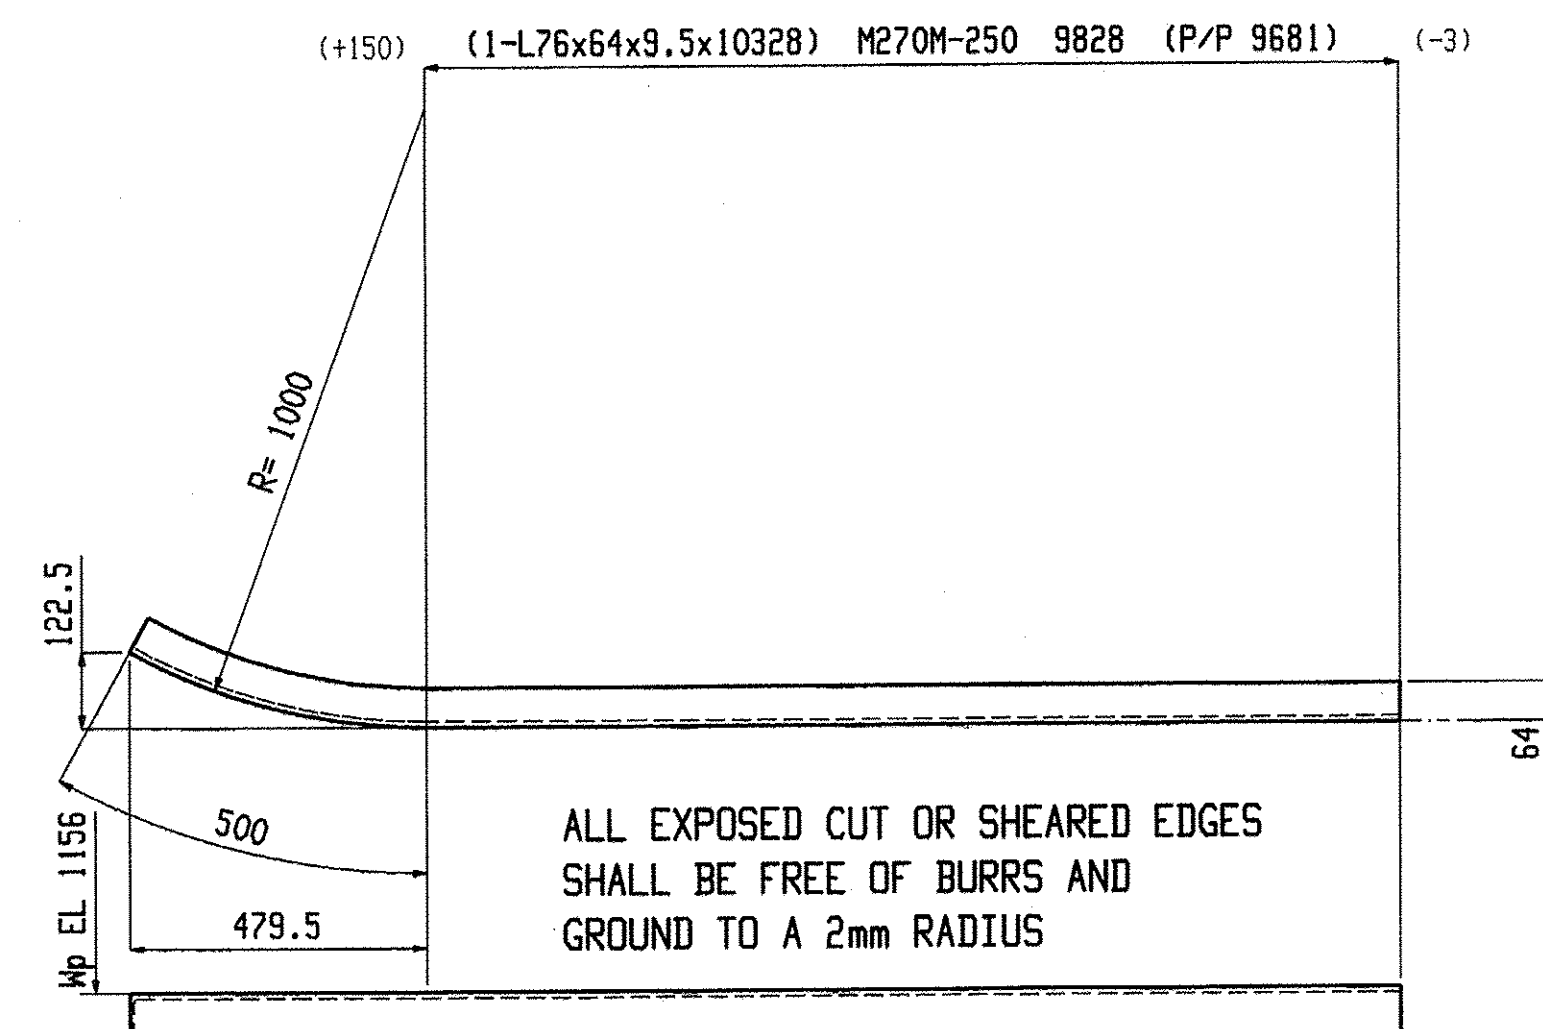


**ONE BEAM R28**

SHOP NOTE:  
TOE DIRECTION FAR SIDE

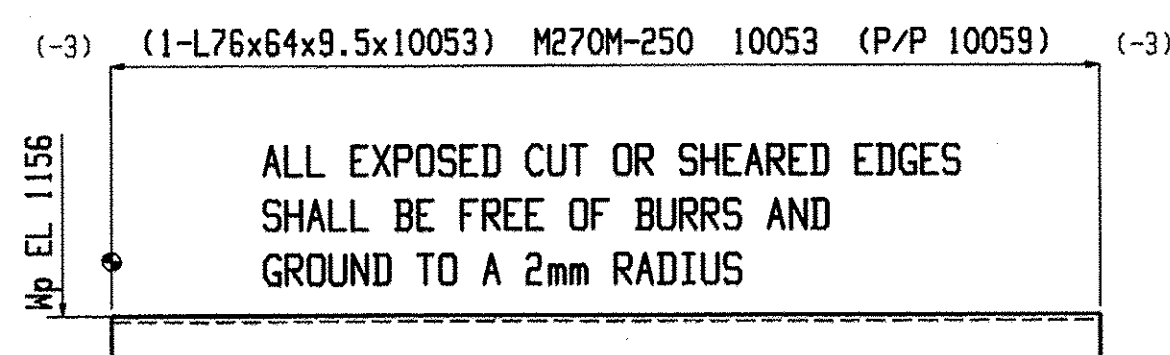


**2 BEAMS R29**

SHOP NOTE:  
TOE DIRECTION FAR SIDE

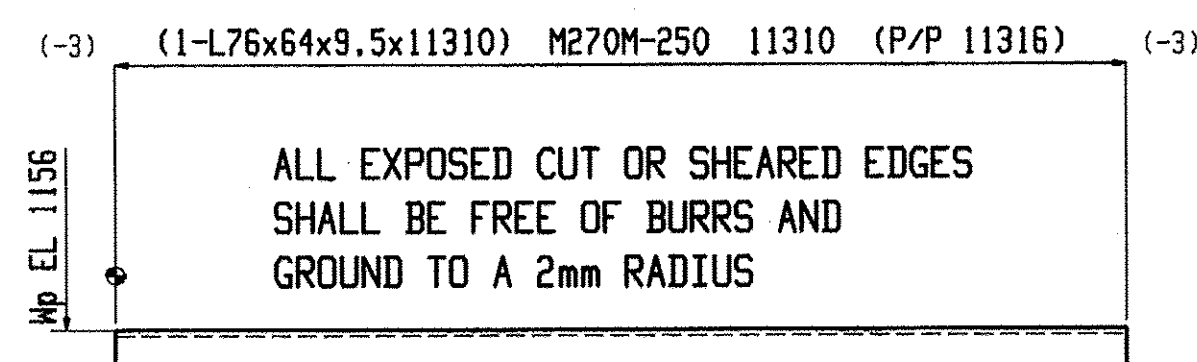

**ONE BEAM R30**

SHOP NOTE:  
TOE DIRECTION FAR SIDE

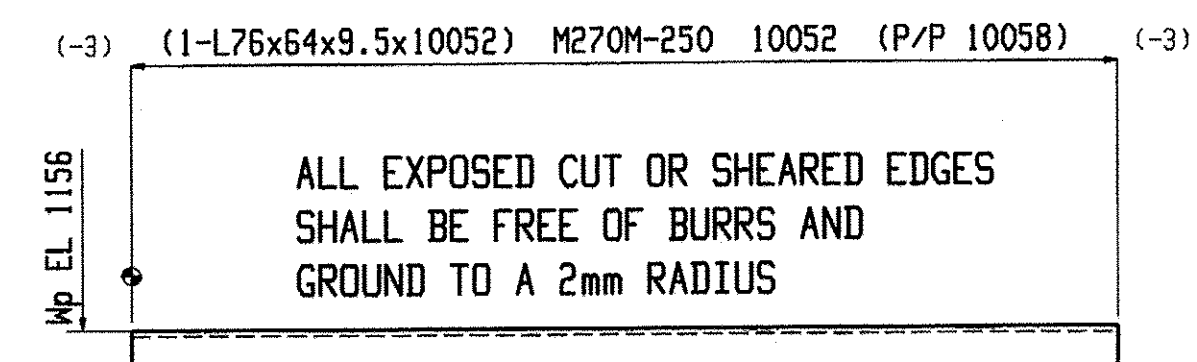

**ONE BEAM R31**

SHOP NOTE:  
TOE DIRECTION FAR SIDE

*Fabrication is not to be done by Renaud Bros. Have fabricator resubmit with name of fabricator on the drawings.*

APPROVED  
DATE 1/12/2010

BILL OF MATERIAL										BILL OF MATERIAL										BILL OF MATERIAL									
Qty	Piece	Description	Length	Seq NO.	Seq Qty	Adv ABM #	Steel Grade	Remarks		Qty	Piece	Description	Length	Seq NO.	Seq Qty	Adv ABM #	Steel Grade	Remarks		Qty	Piece	Description	Length	Seq NO.	Seq Qty	Adv ABM #	Steel Grade	Remarks	
ONE	R23	BEAM		2	1					ONE	R26	BEAM		2	1					2	R29	BEAM		2	2				
1	R23	L76x64x9.5	10328				M270M-250			1	R26	L76x64x9.5	10052				M270M-250			2	R29	L76x64x9.5	10053				M270M-250		
2	R24	BEAM		2	2					ONE	R27	BEAM		2	1					ONE	R30	BEAM		2	1				
2	R24	L76x64x9.5	10053				M270M-250			1	R27	L76x64x9.5	10328				M270M-250			1	R30	L76x64x9.5	11310				M270M-250		
ONE	R25	BEAM		2	1					ONE	R28	BEAM		2	1					ONE	R31	BEAM		2	1				
1	R25	L76x64x9.5	11310				M270M-250			1	R28	L76x64x9.5	10328				M270M-250			1	R31	L76x64x9.5	10052				M270M-250		

Total weight : 1110

**Renaud Bros. Inc.**  
283 Fort Bridgeman Rd. #2  
Vernon, VT. 05354  
Phone 1-802 257-7383

Project: **DUMMERSTON BRIDGE**  
DUMMERSTON, VT

Date: 9-9-09  
Job No. **BHO 1442 (28)**

Checked: MRS  
Sheet No. **24**

Holes: 21mm UNF  
BOLTS: 19mm DIA. M164M-2 GALV UNF  
Steel GR: M270M-GR345 UNF  
Paint: PER SPECS (GREEN) UNF  
Surface Prep: PER SPECS

Nov 05 2009 10:55:52 AM