


PORTAL - 4 Plates

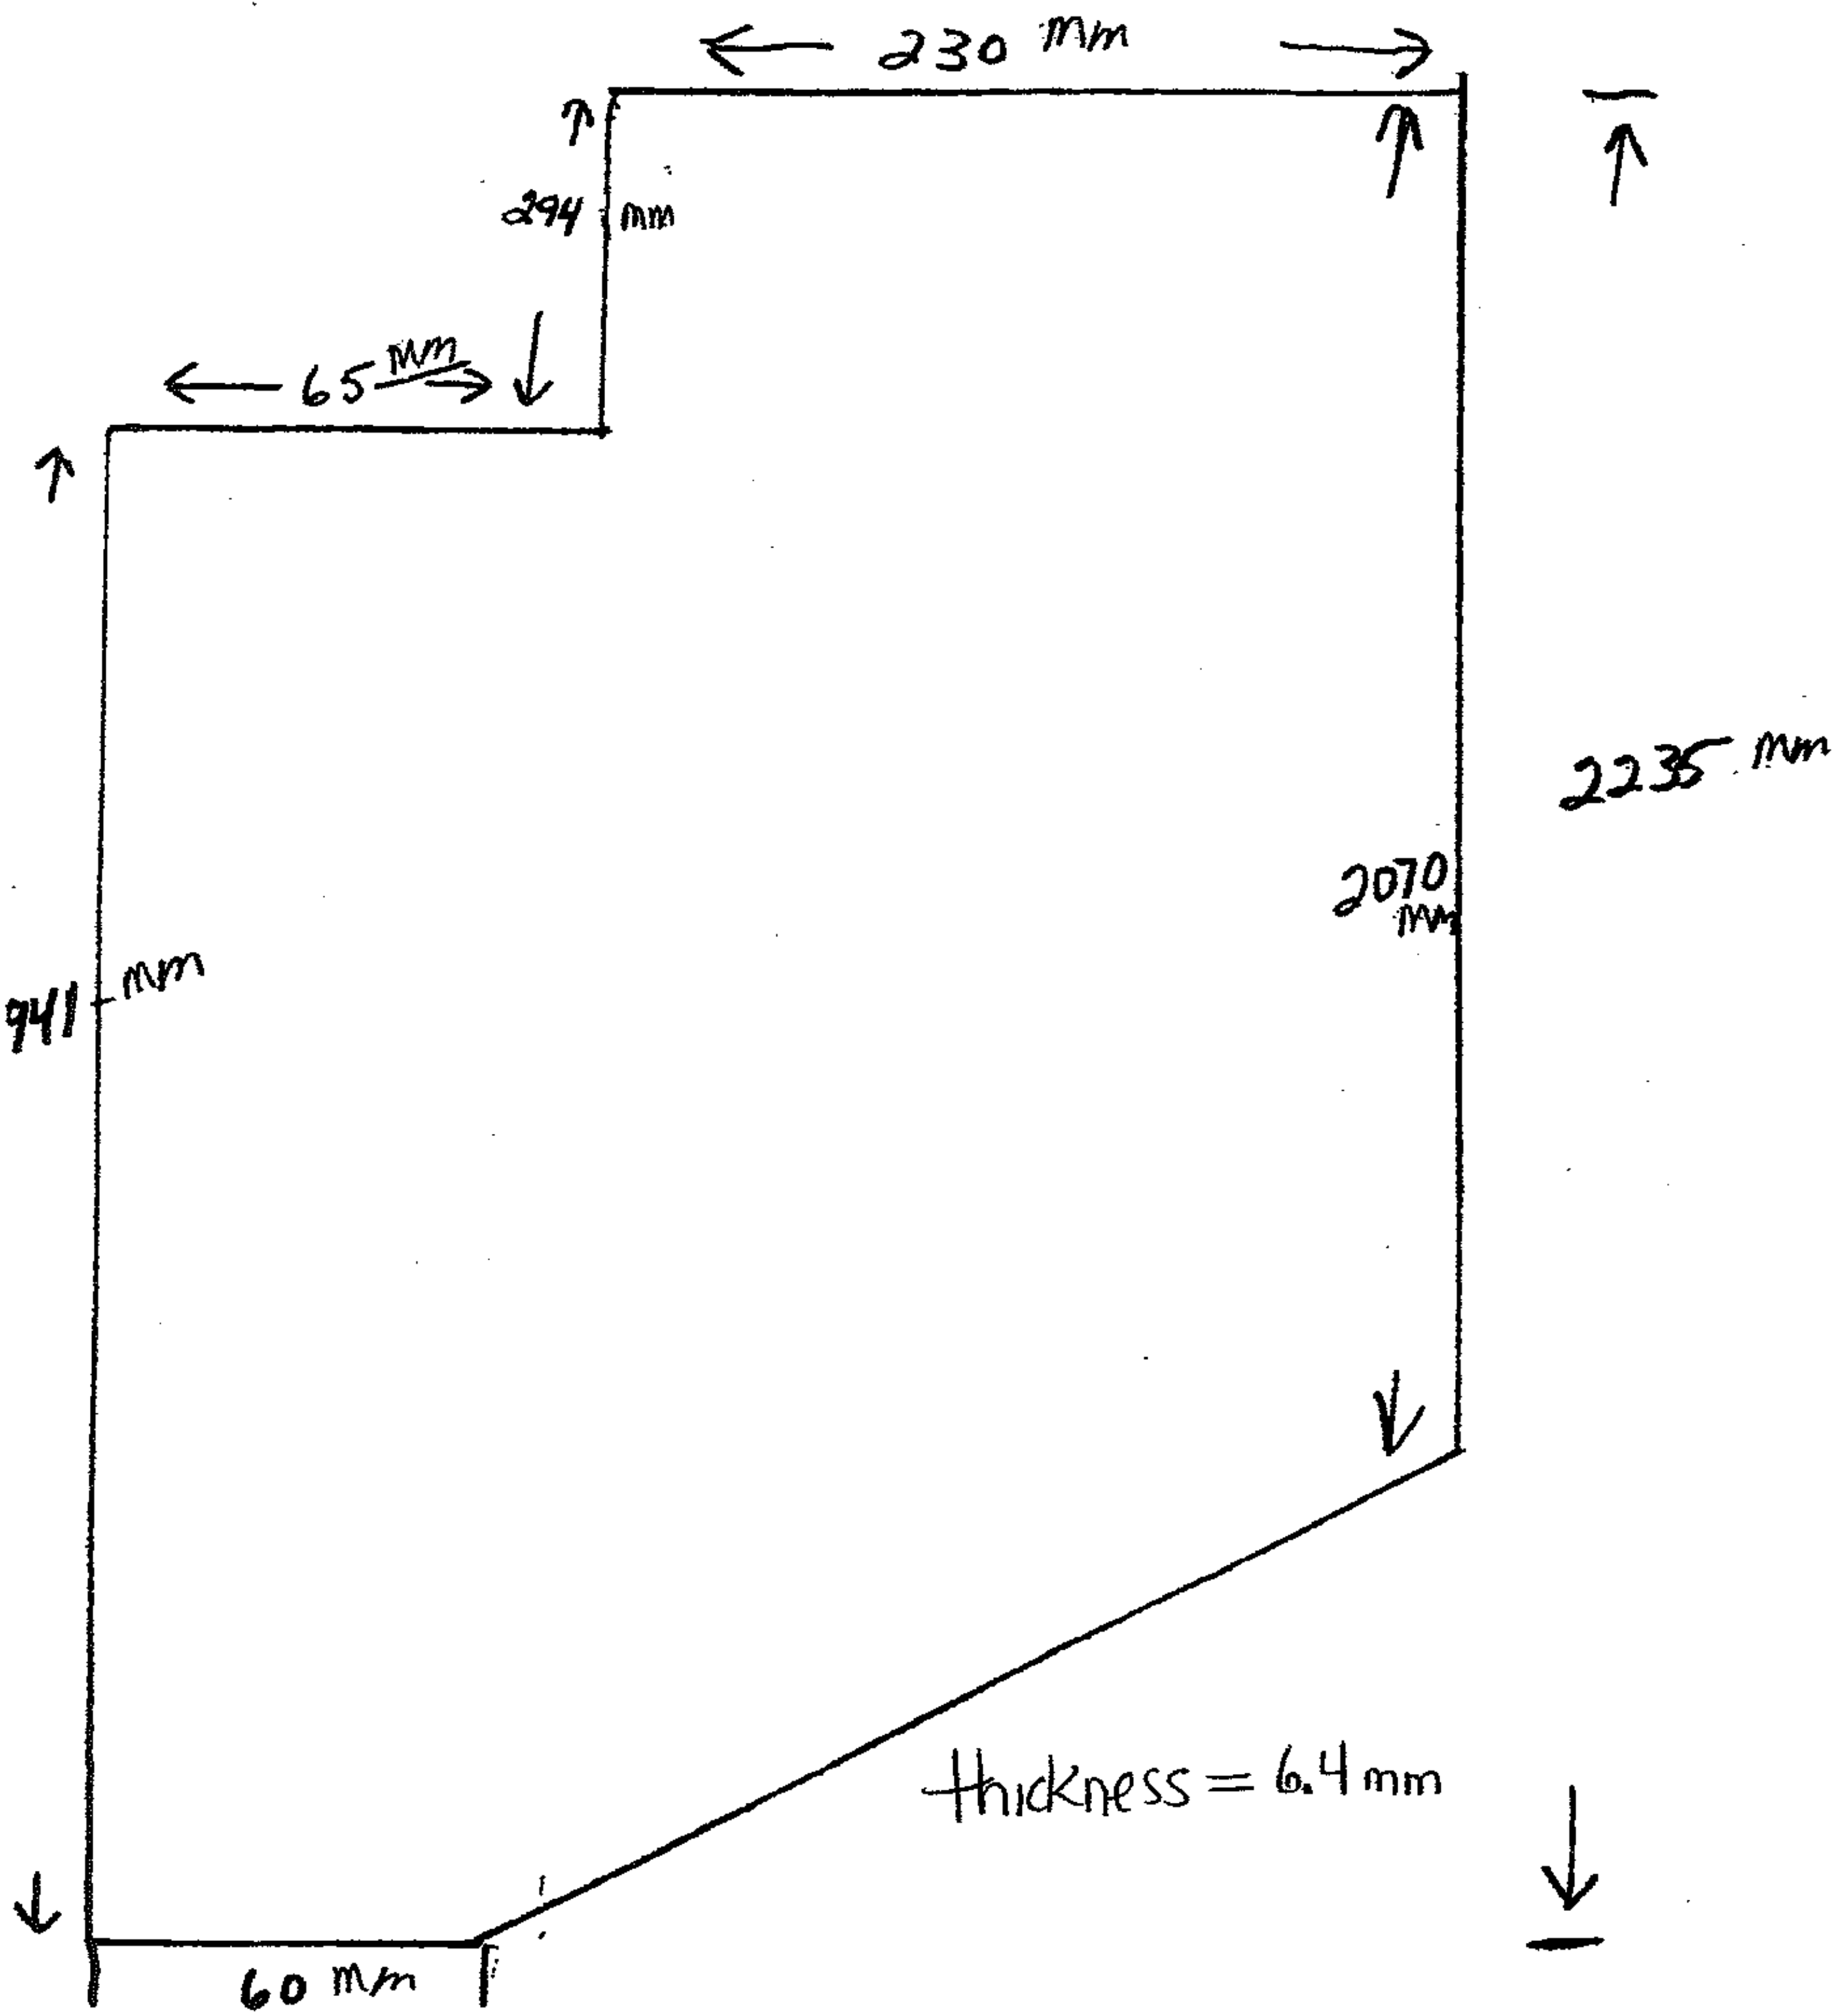

each - 76.58 lbs
- 34.77 Kg

Total - 306.32 lbs
139.09 Kg