


Top Plates — 4 Plates

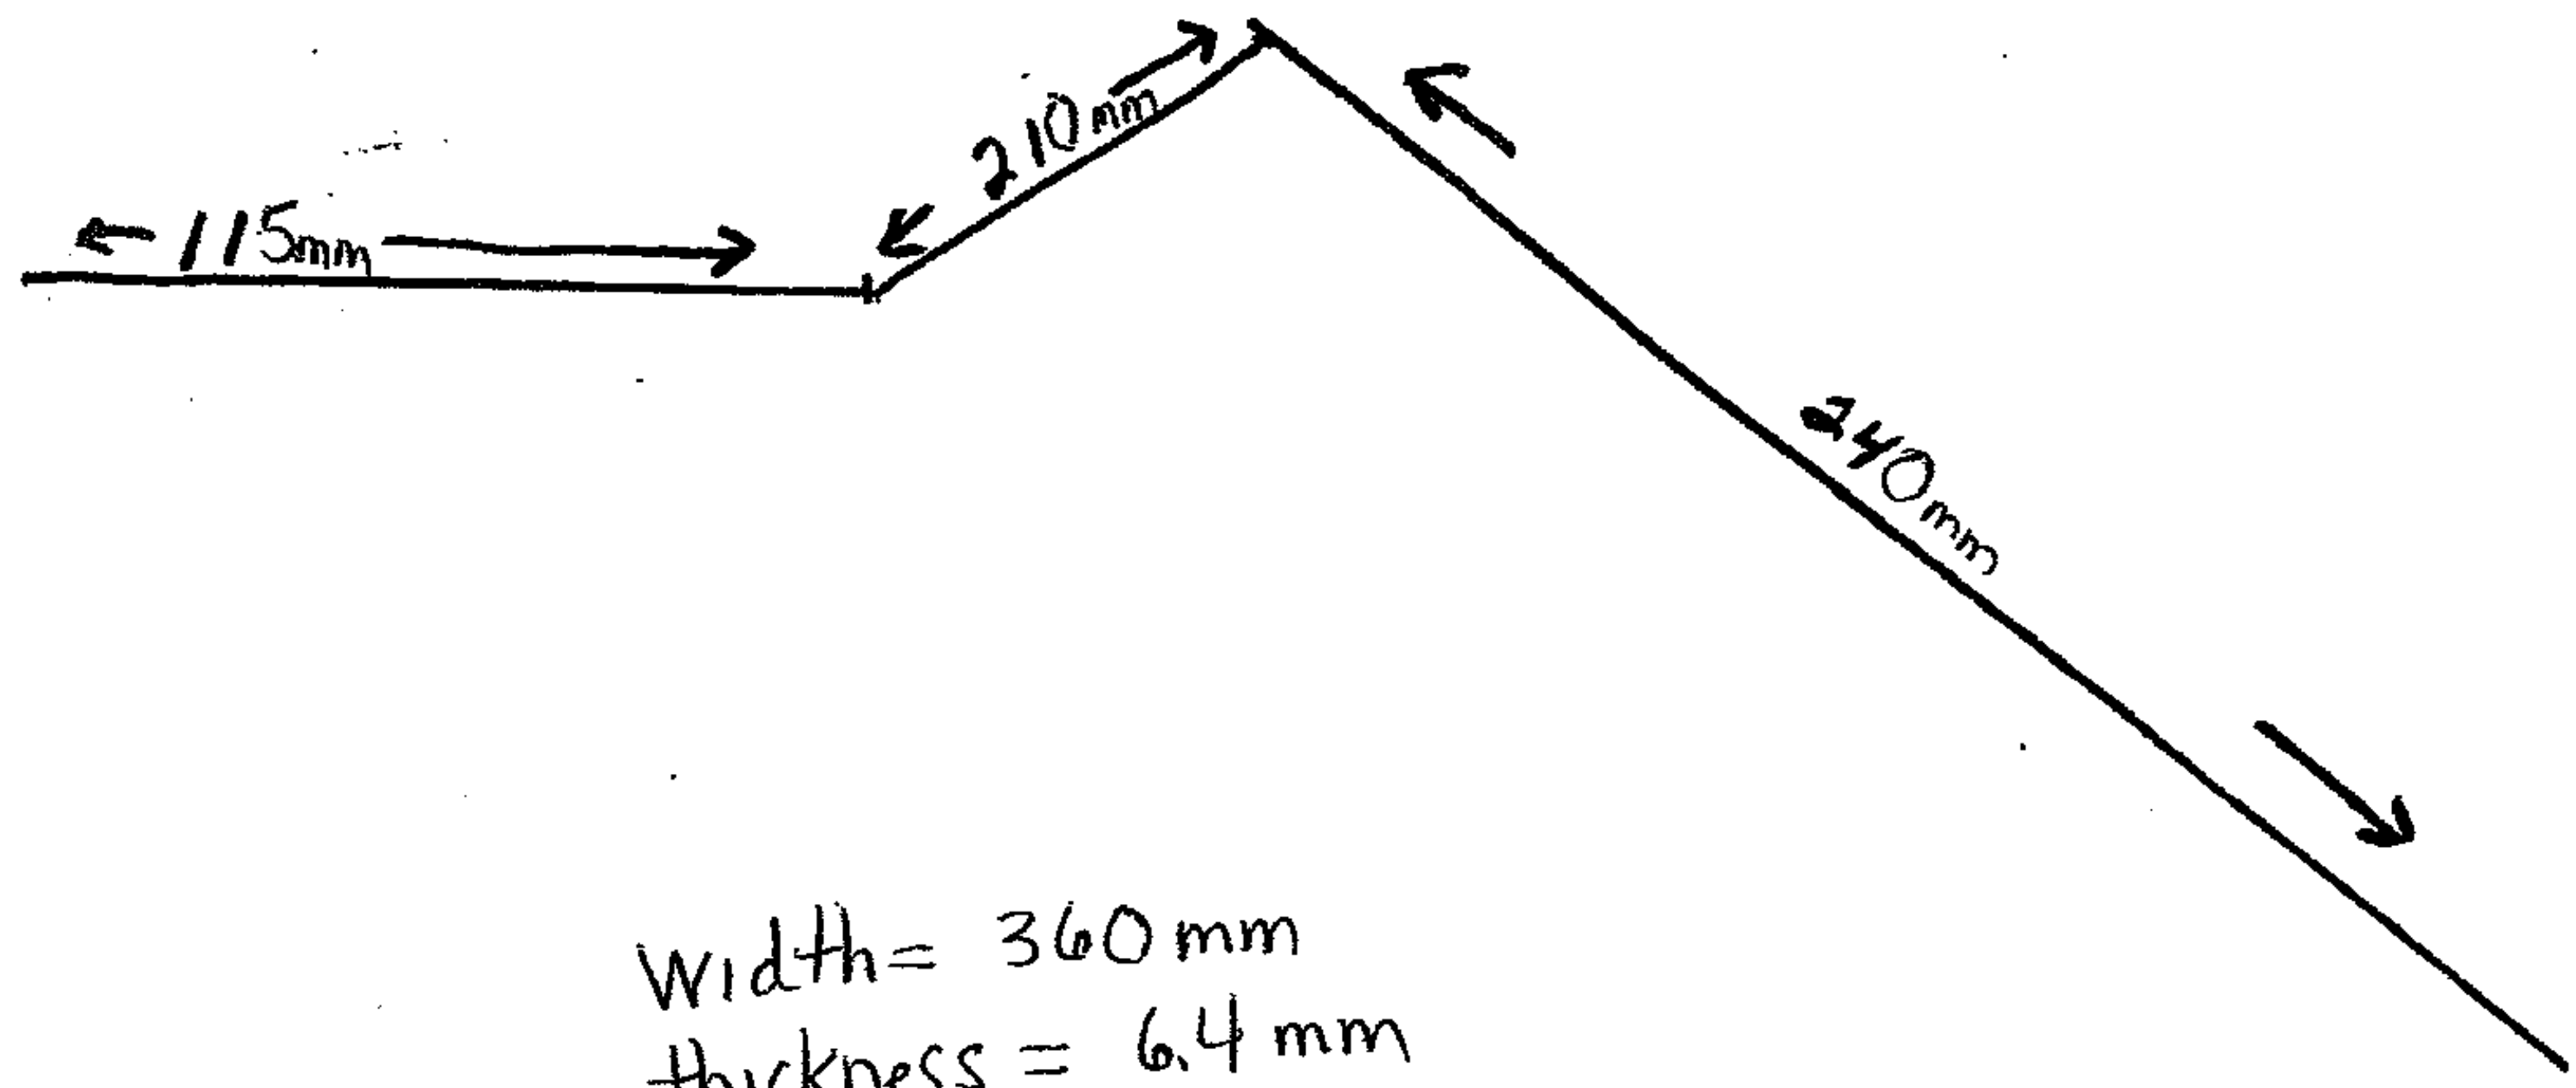

Width = 360 mm  
thickness = 6.4 mm

each - 23.82 lbs  
10.83 kg

TOTAL = 95.26 lbs  
43.30 Kgs