


VT 30 MATERIAL TRANSITION DETAIL
 NOT TO SCALE

3/9/12
 3/9/12

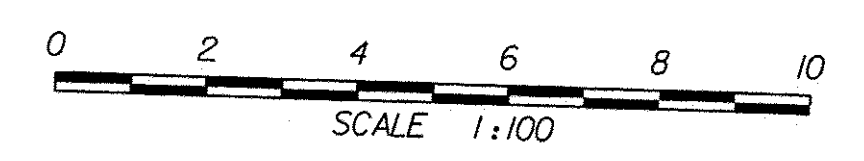

VT 30