



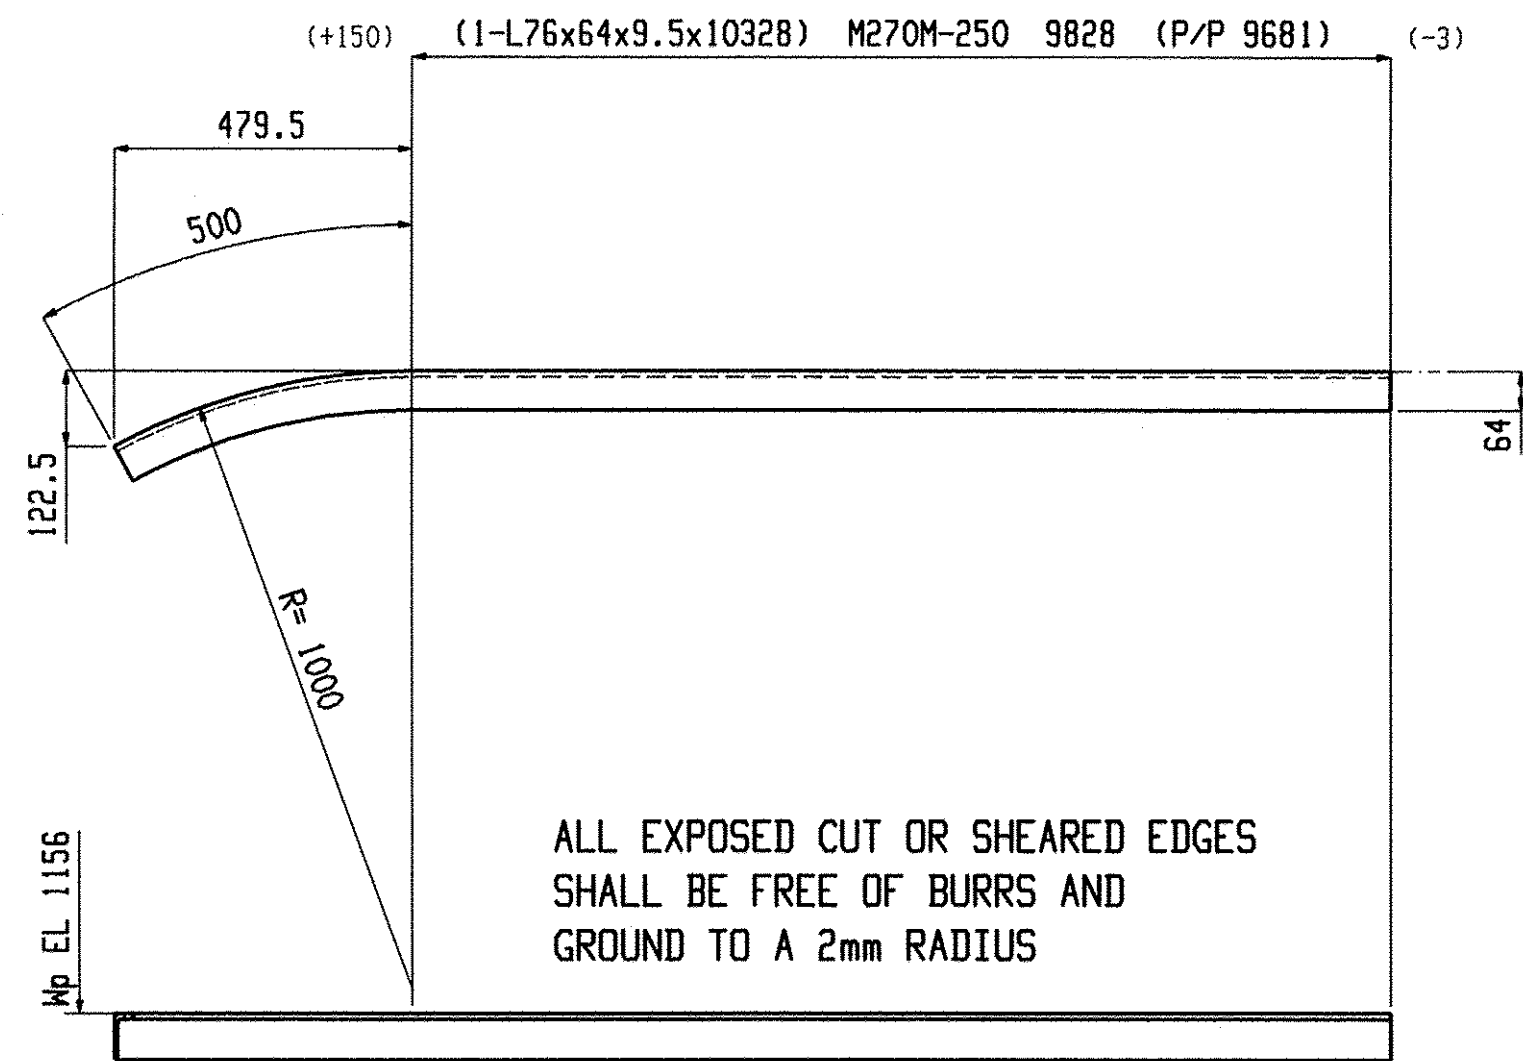


ONE BEAM R23

SHOP NOTE:
TOE DIRECTION NEAR SIDE

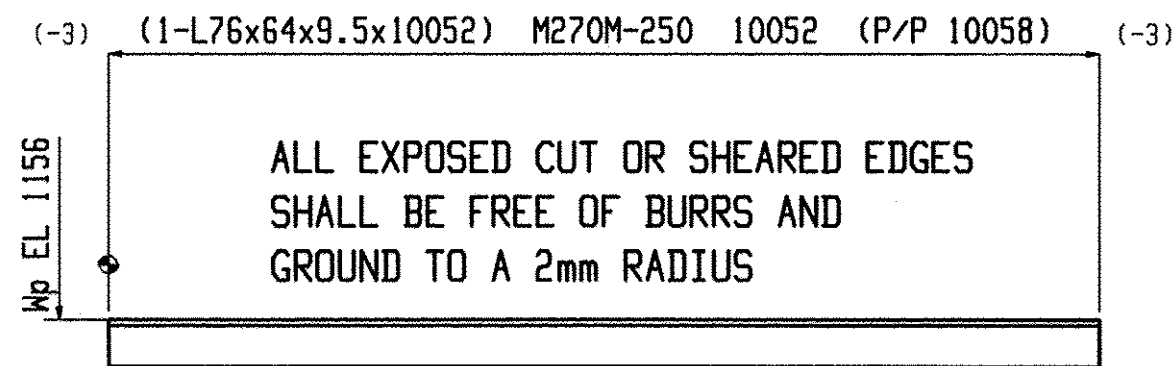


ONE BEAM R26

SHOP NOTE:
TOE DIRECTION NEAR SIDE

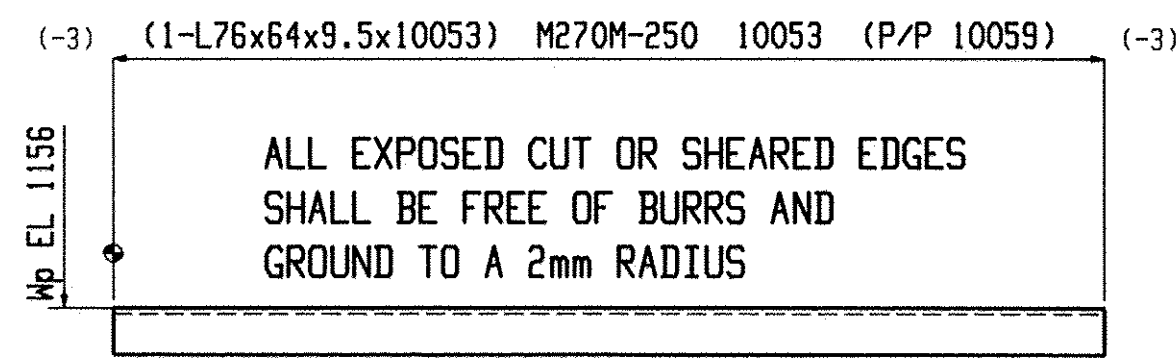


2 BEAMS R29

SHOP NOTE:
TOE DIRECTION FAR SIDE

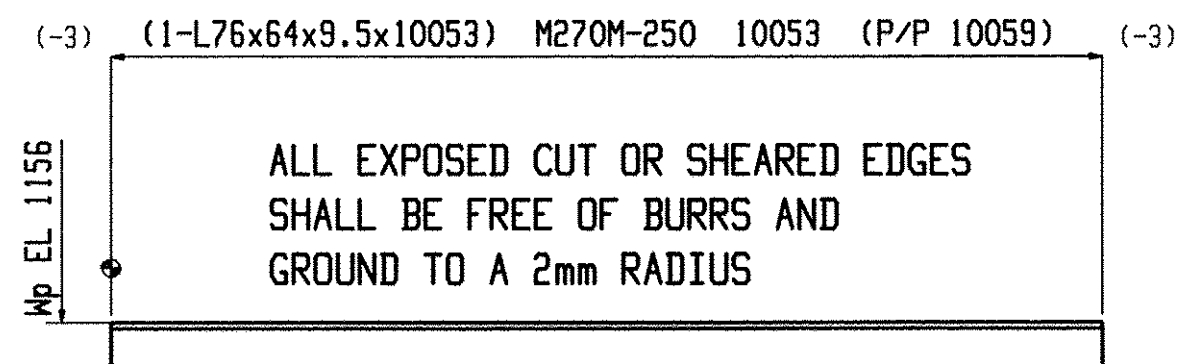


2 BEAMS R24

SHOP NOTE:
TOE DIRECTION NEAR SIDE

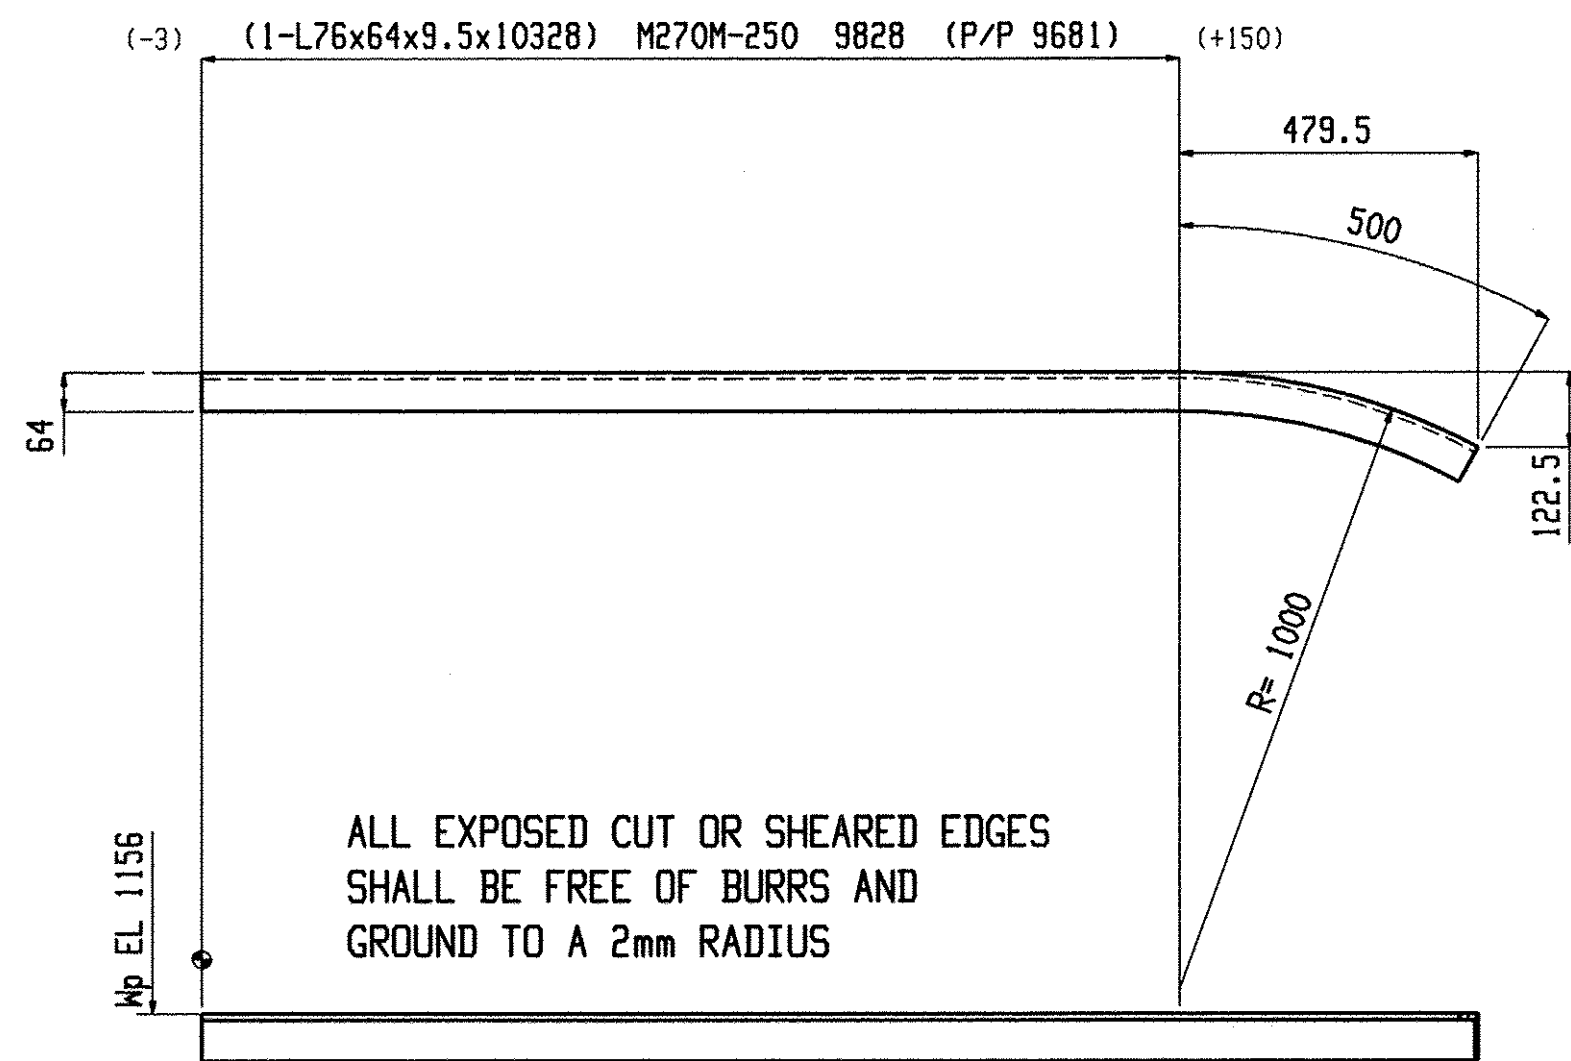


ONE BEAM R27

SHOP NOTE:
TOE DIRECTION NEAR SIDE

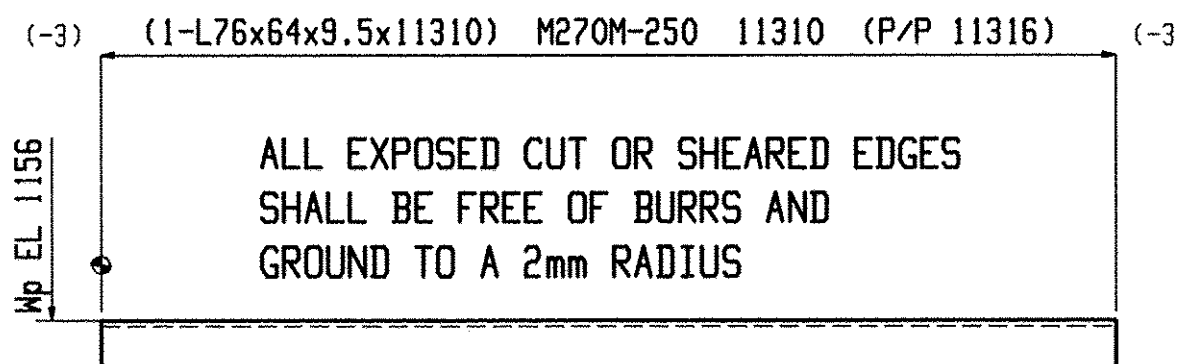


ONE BEAM R30

SHOP NOTE:
TOE DIRECTION FAR SIDE

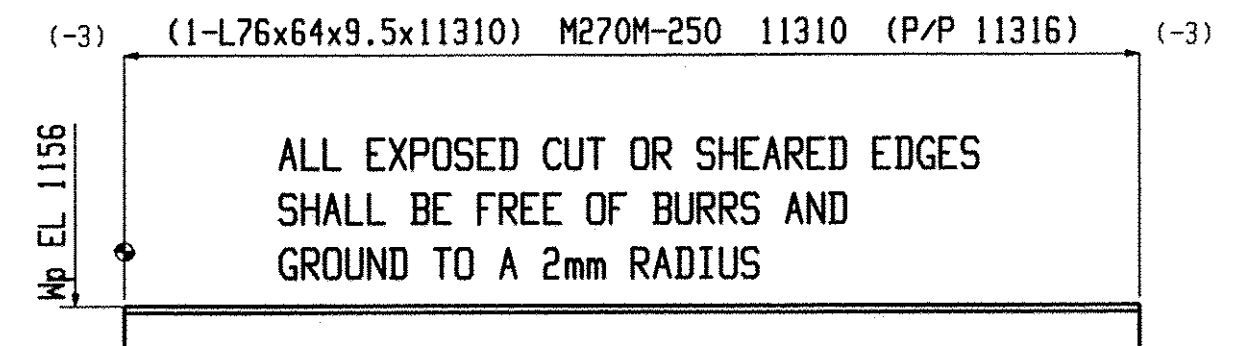


ONE BEAM R25

SHOP NOTE:
TOE DIRECTION NEAR SIDE

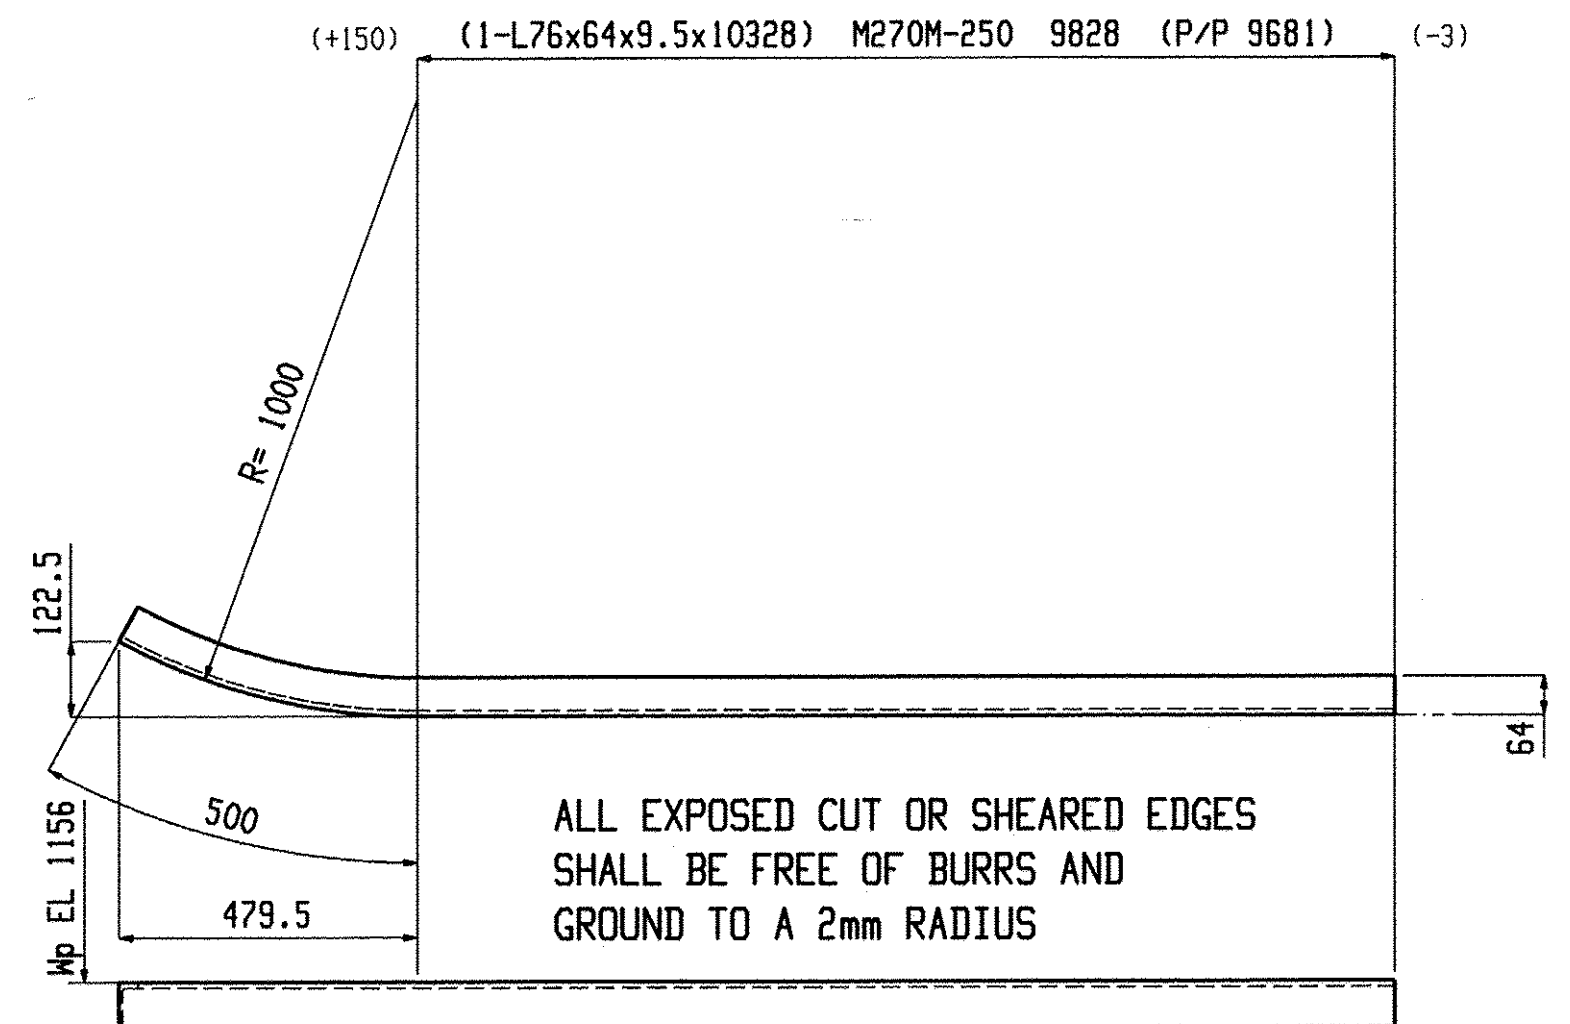

ONE BEAM R28

SHOP NOTE:
TOE DIRECTION FAR SIDE

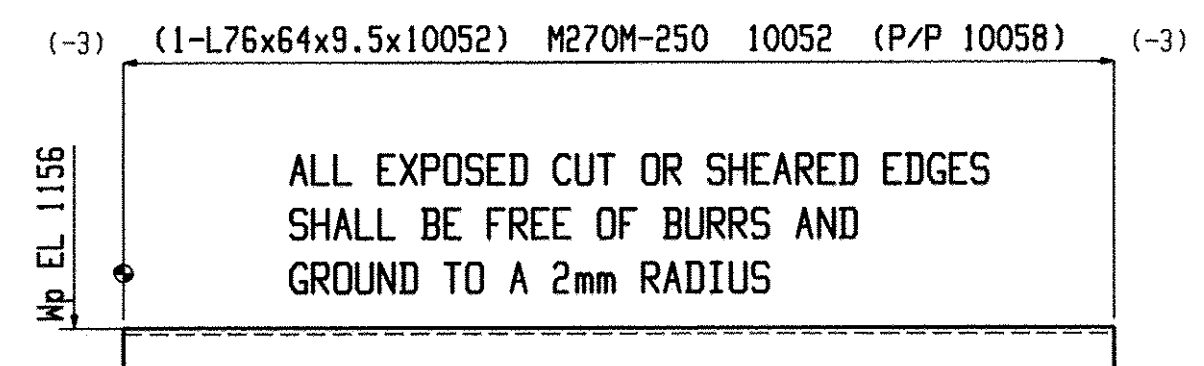

ONE BEAM R31

SHOP NOTE:
TOE DIRECTION FAR SIDE

Mar 18 2010 08:45:20 PM

BILL OF MATERIAL									BILL OF MATERIAL									BILL OF MATERIAL								
Qty	Piece			Seq	Seq	Adv	Steel		Qty	Piece			Seq	Seq	Adv	Steel		Qty	Piece			Seq	Seq	Adv	Steel	
Tot.	Mark	Description	Length	NO.	Qty	ABM #	Grade	Remarks	Tot.	Mark	Description	Length	NO.	Qty	ABM #	Grade	Remarks	Tot.	Mark	Description	Length	NO.	Qty	ABM #	Grade	Remarks
ONE	R23	BEAM		2	1				ONE	R26	BEAM		2	1				2	R29	BEAM		2	2			
1	R23	L76x64x9.5	10328				M270M-250		1	R26	L76x64x9.5	10052				M270M-250		2	R29	L76x64x9.5	10053				M270M-250	
2	R24	BEAM		2	2				ONE	R27	BEAM		2	1				ONE	R30	BEAM		2	1			
2	R24	L76x64x9.5	10053				M270M-250		1	R27	L76x64x9.5	10328				M270M-250		1	R30	L76x64x9.5	11310				M270M-250	
ONE	R25	BEAM		2	1				ONE	R28	BEAM		2	1				ONE	R31	BEAM		2	1			
1	R25	L76x64x9.5	11310				M270M-250		1	R28	L76x64x9.5	10328				M270M-250		1	R31	L76x64x9.5	10052				M270M-250	

RECEIVED
CHK BY: [Signature]
APR 01 2010
RESUBMIT: [Signature]
APPROVED: [Signature]
BY: [Signature] DATE: 4/28/10

ITEMS ON THIS SHEET ARE PAY ITEM: 900.640 (UN)

Casco Bay Steel Structures 75 Spring Hill Rd Saco, ME, 04072 207-282-7360	Holes: 21mm UNO	
	BOLTS: 19mm DIA. M164M-I GALV UNO	
	Steel GR: M270M-GR345 UNO	
	Paint: PER SPECS (GREEN) UNO	
Project: DUMMERSTON RAILS DUMMERSTON, VT	Rev. No: 3-17-10	Date: 9-9-09
DMN. BY: EG	Checked: MRS	Job No. 24