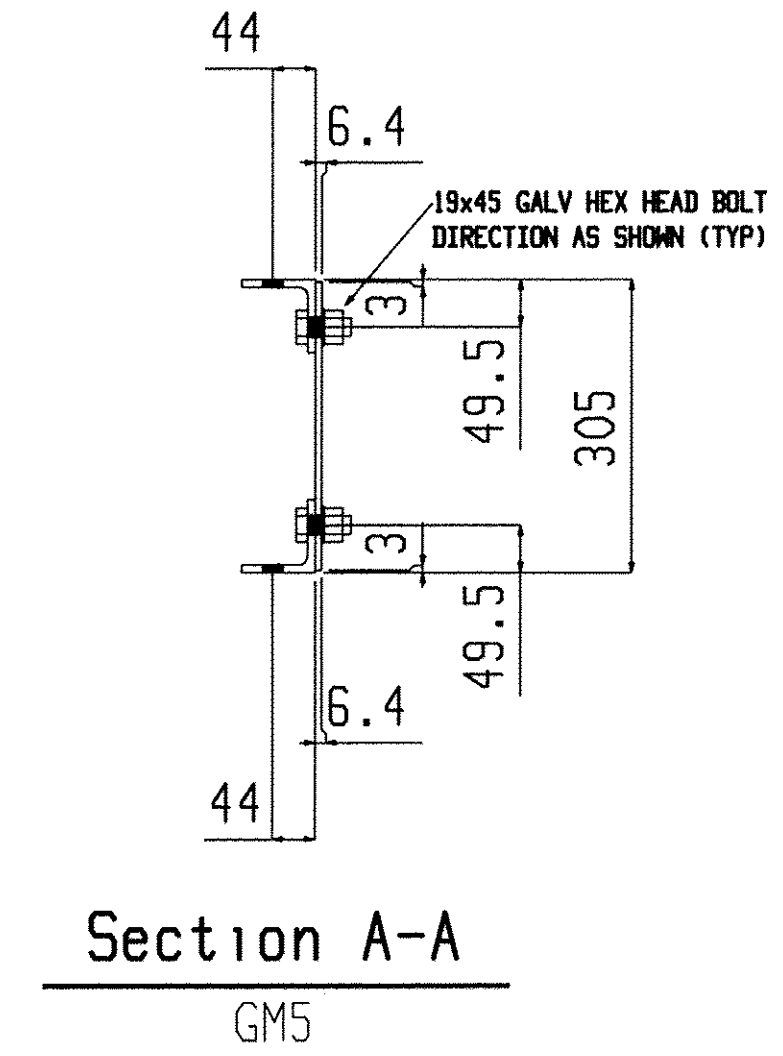
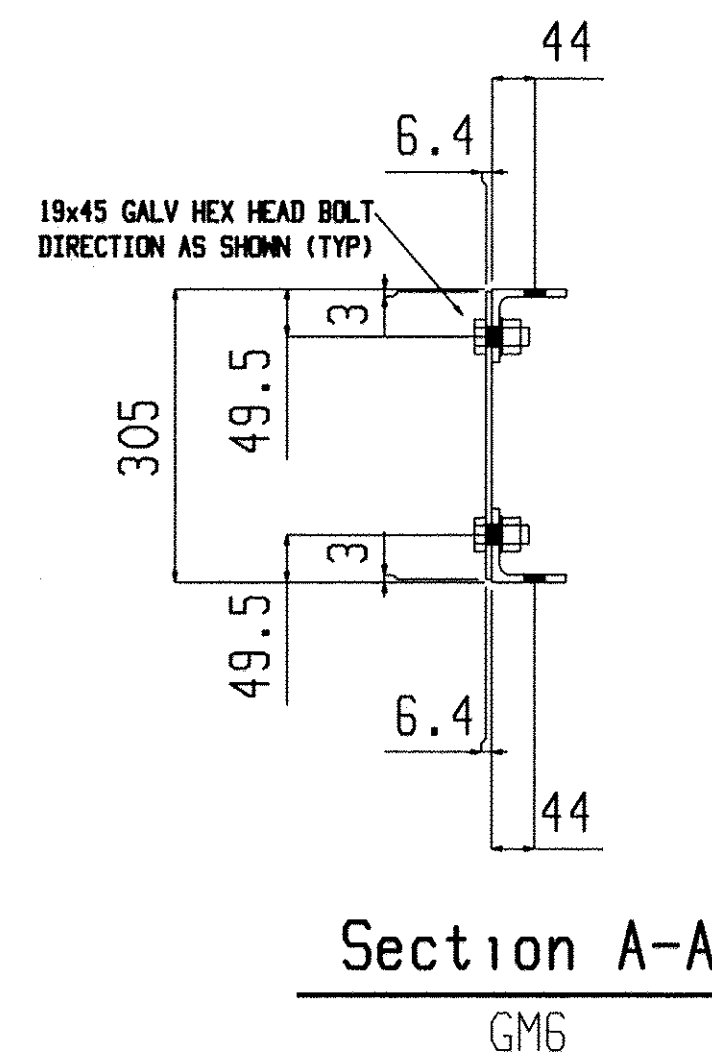
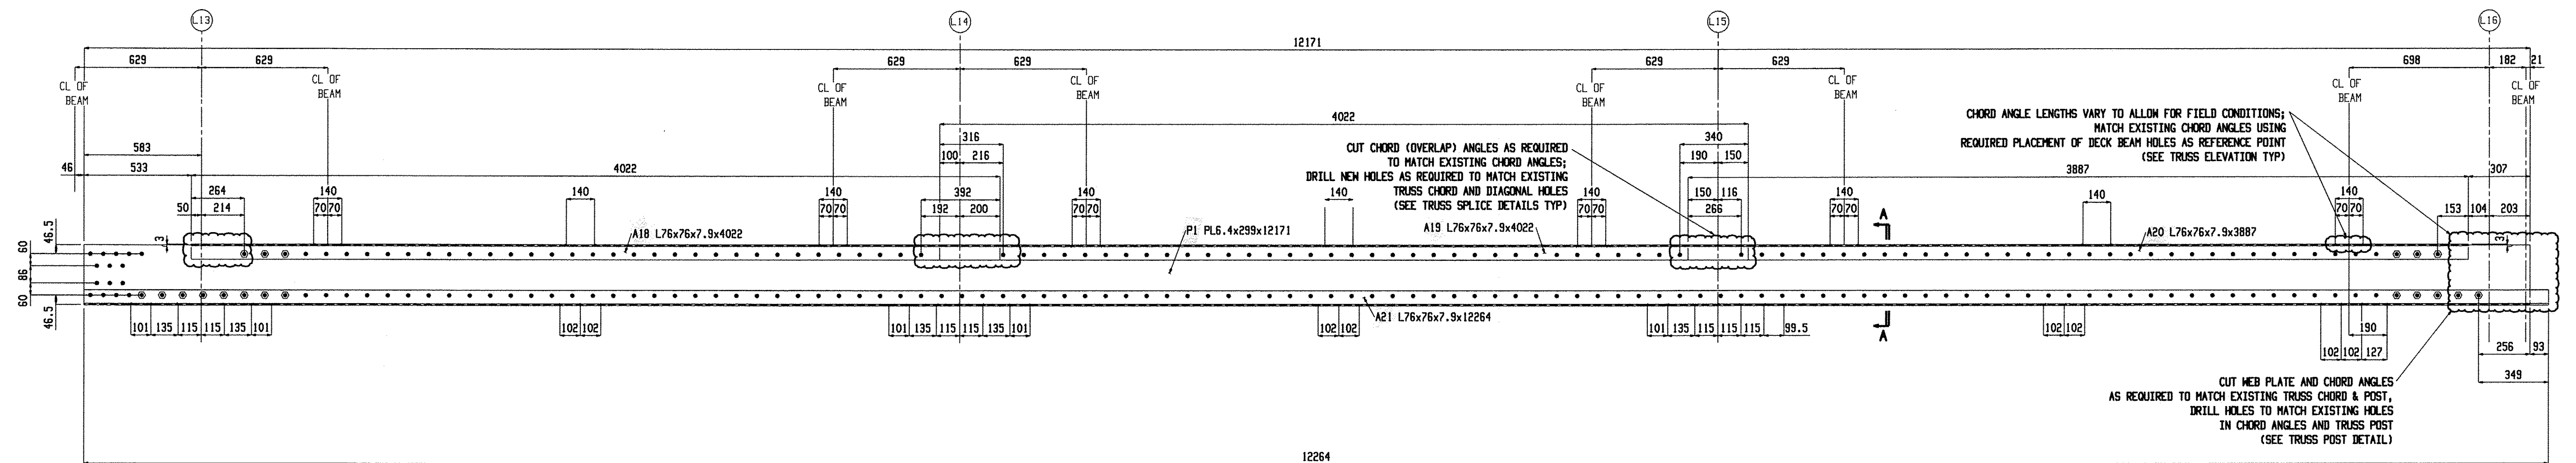


BILL OF MATERIAL										BILL OF MATERIAL										BILL OF MATERIAL									
Qty	Piece			Seq	Seq	Adv	Steel			Qty	Piece			Seq	Seq	Adv	Steel			Qty	Piece			Seq	Seq	Adv	Steel		
Tot.	Mark	Description	Length	NO.	Qty	ABM #	Grade	Remarks		Tot.	Mark	Description	Length	NO.	Qty	ABM #	Grade	Remarks		Tot.	Mark	Description	Length	NO.	Qty	ABM #	Grade	Remarks	
2	GM5	GROUP MEMBER								2	GM6	GROUP MEMBER																	
2	P1	PL6.4x299	12171				M270M-345			2	P1	PL6.4x299	12171				M270M-345												
2	A21	L76x76x7.9	12264				M270M-345			2	A25	L76x76x7.9	12264				M270M-345												
2	A18	L76x76x7.9	4022				M270M-345			2	A24	L76x76x7.9	4022				M270M-345												
2	A19	L76x76x7.9	4022				M270M-345			2	A23	L76x76x7.9	4022				M270M-345												
2	A20	L76x76x7.9	3887				M270M-345			2	A22	L76x76x7.9	3887				M270M-345												

Total weight : 1602

RECEIVED
OK'D BY: _____ OK'D BY: _____
NOV 17 2009
RESUBMIT: _____ APPROVED: ☒ AS NOTED
BY: _____ DATE: _____

Renaud Bros. Inc. 283 Fort Bridgeman Rd. #2 Vernon, VT. 05354 Phone 1-802 257-7383		Holes: 21mm UNO	
		BOLTS: 19mm DIA. M164M-I GALV UNO	
Steel GR: M270M-GR345 UNO		Paint: PER SPECS (GREEN) UNO	
Surface Prep: PER SPECS		Job No. BHO 1442(28)	
Project: DUMMERSTON BRIDGE	Date: 9-9-09	Sheet No. GM5, GM6	
DWN. BY: EG	Checked: MRS		