
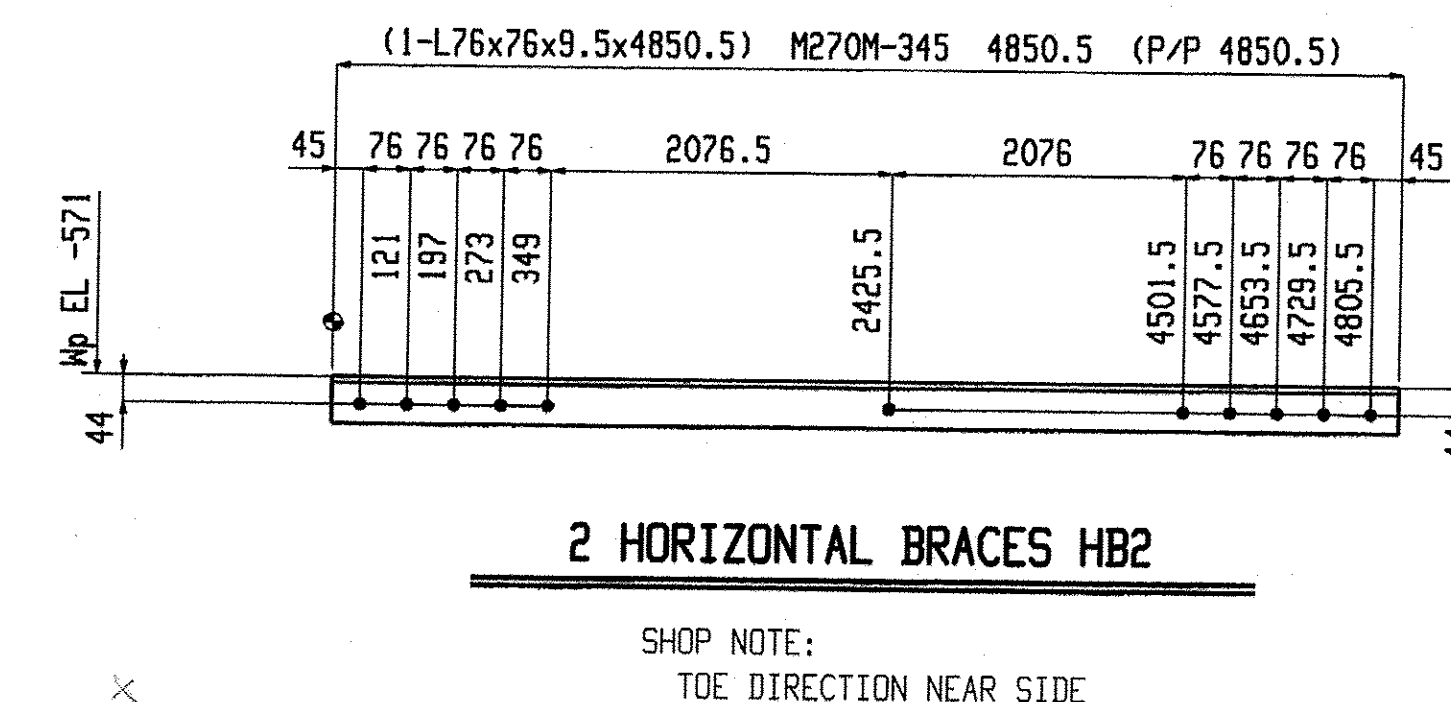
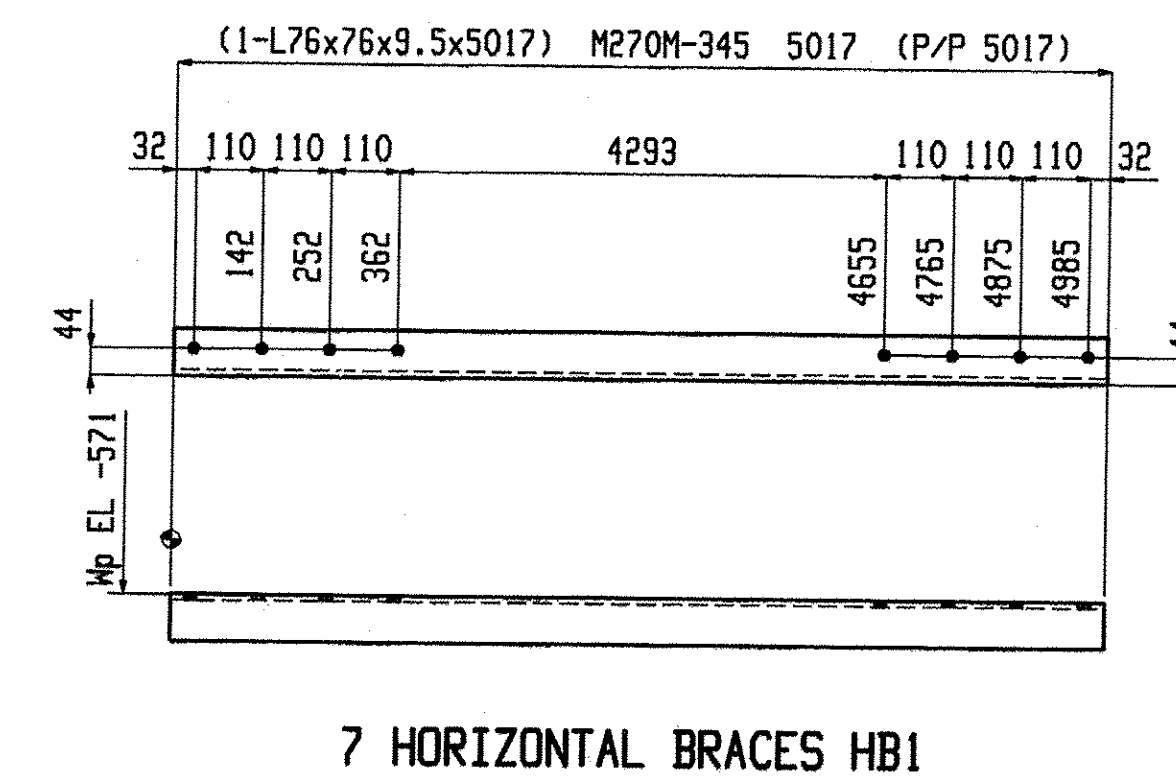
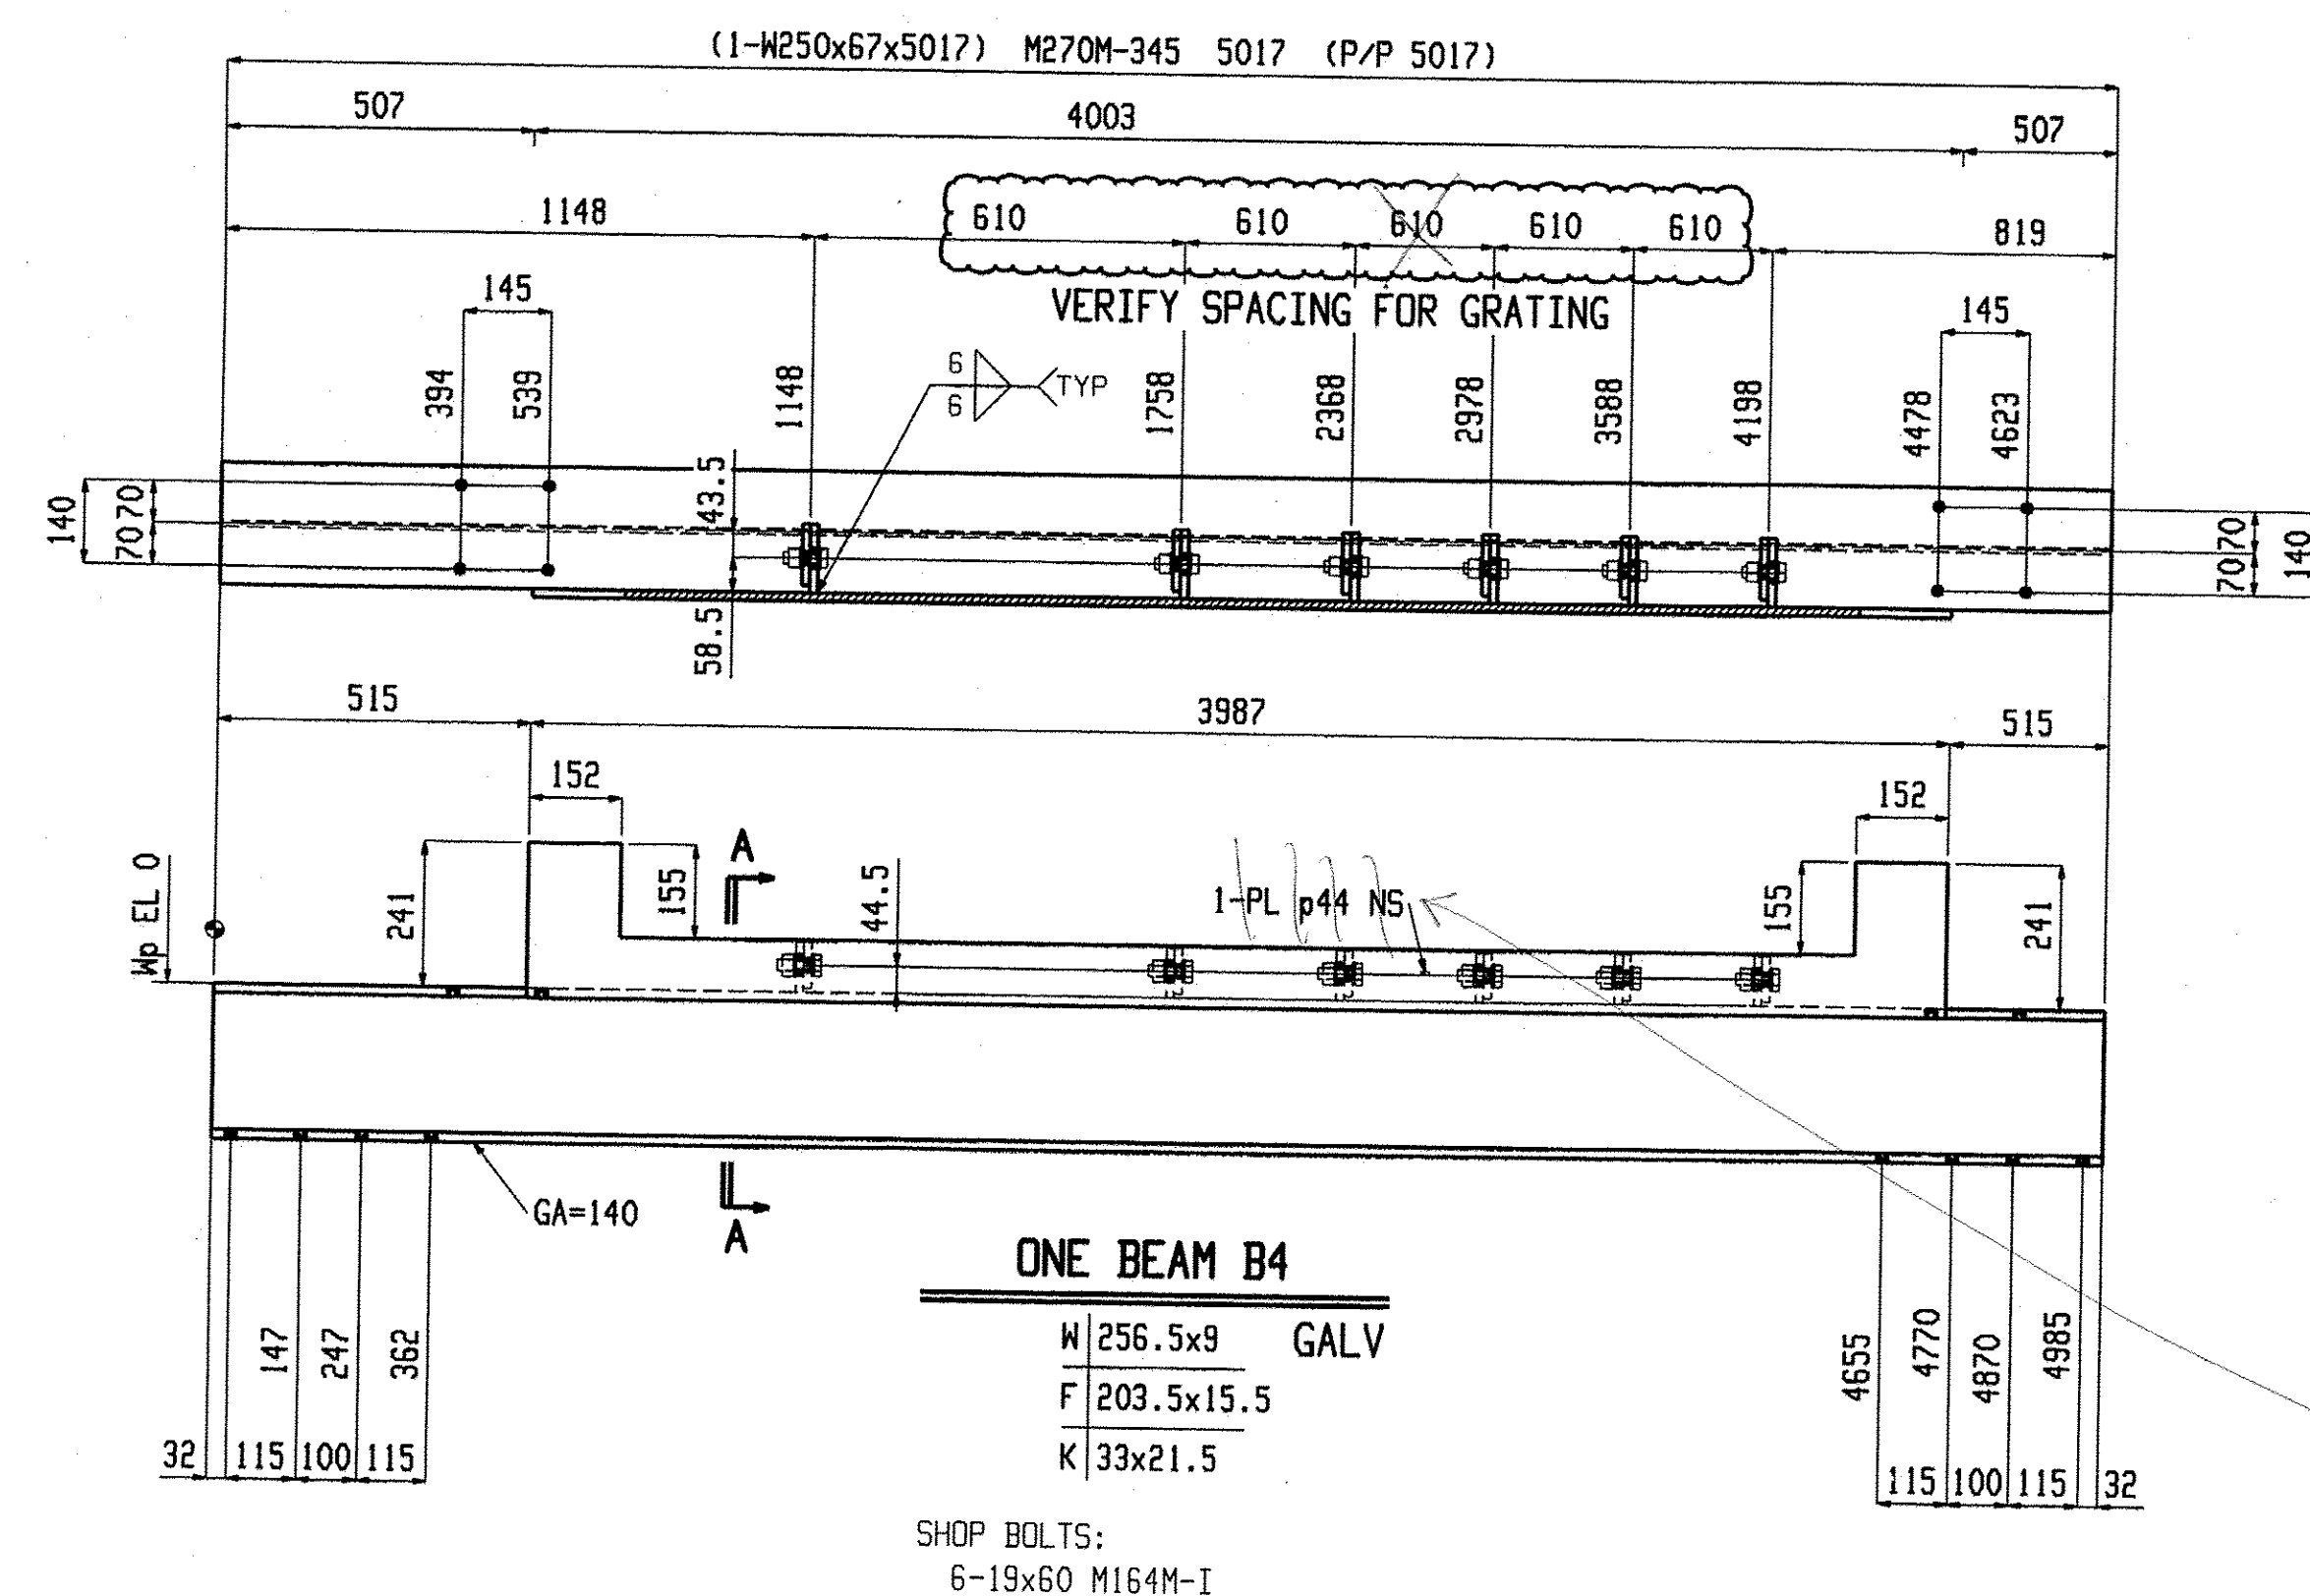
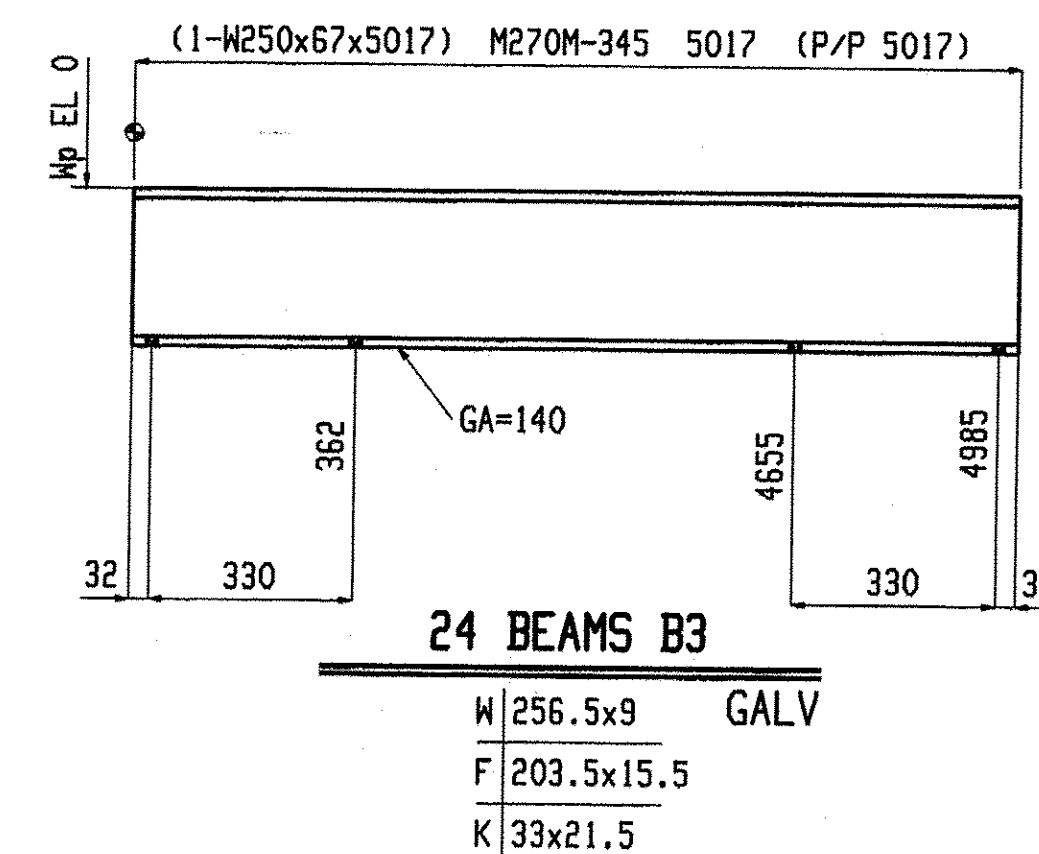
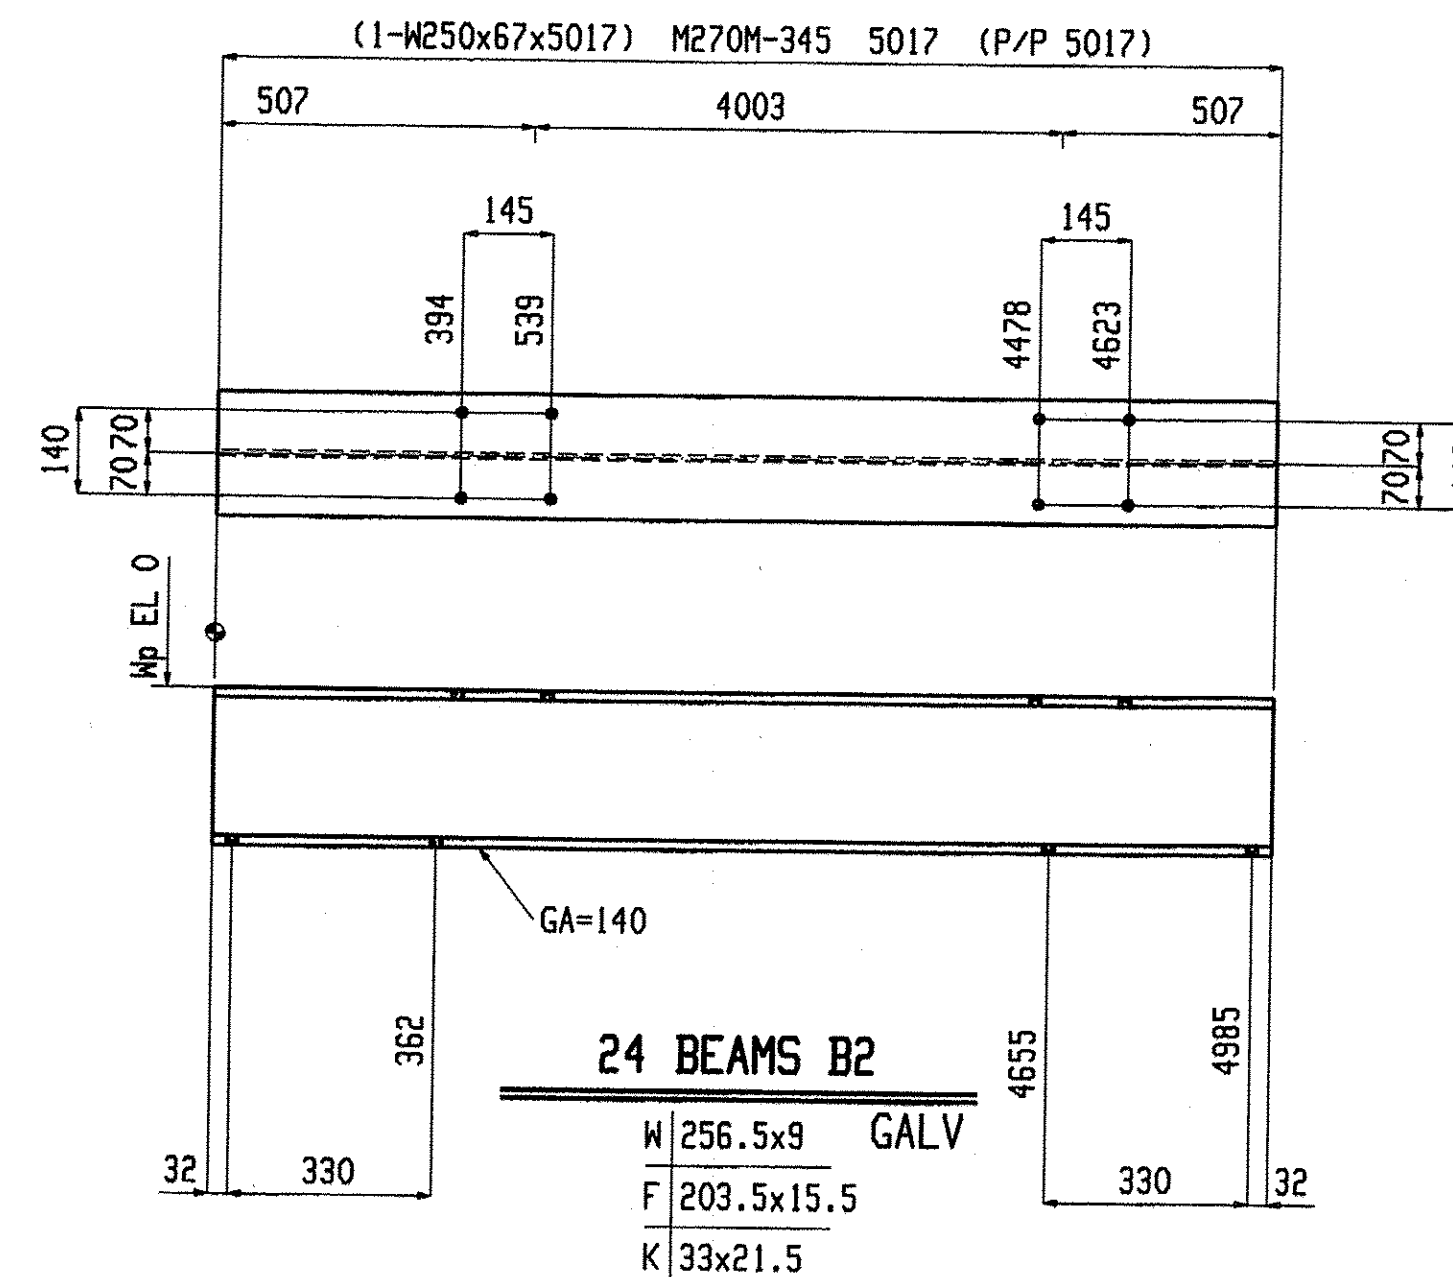


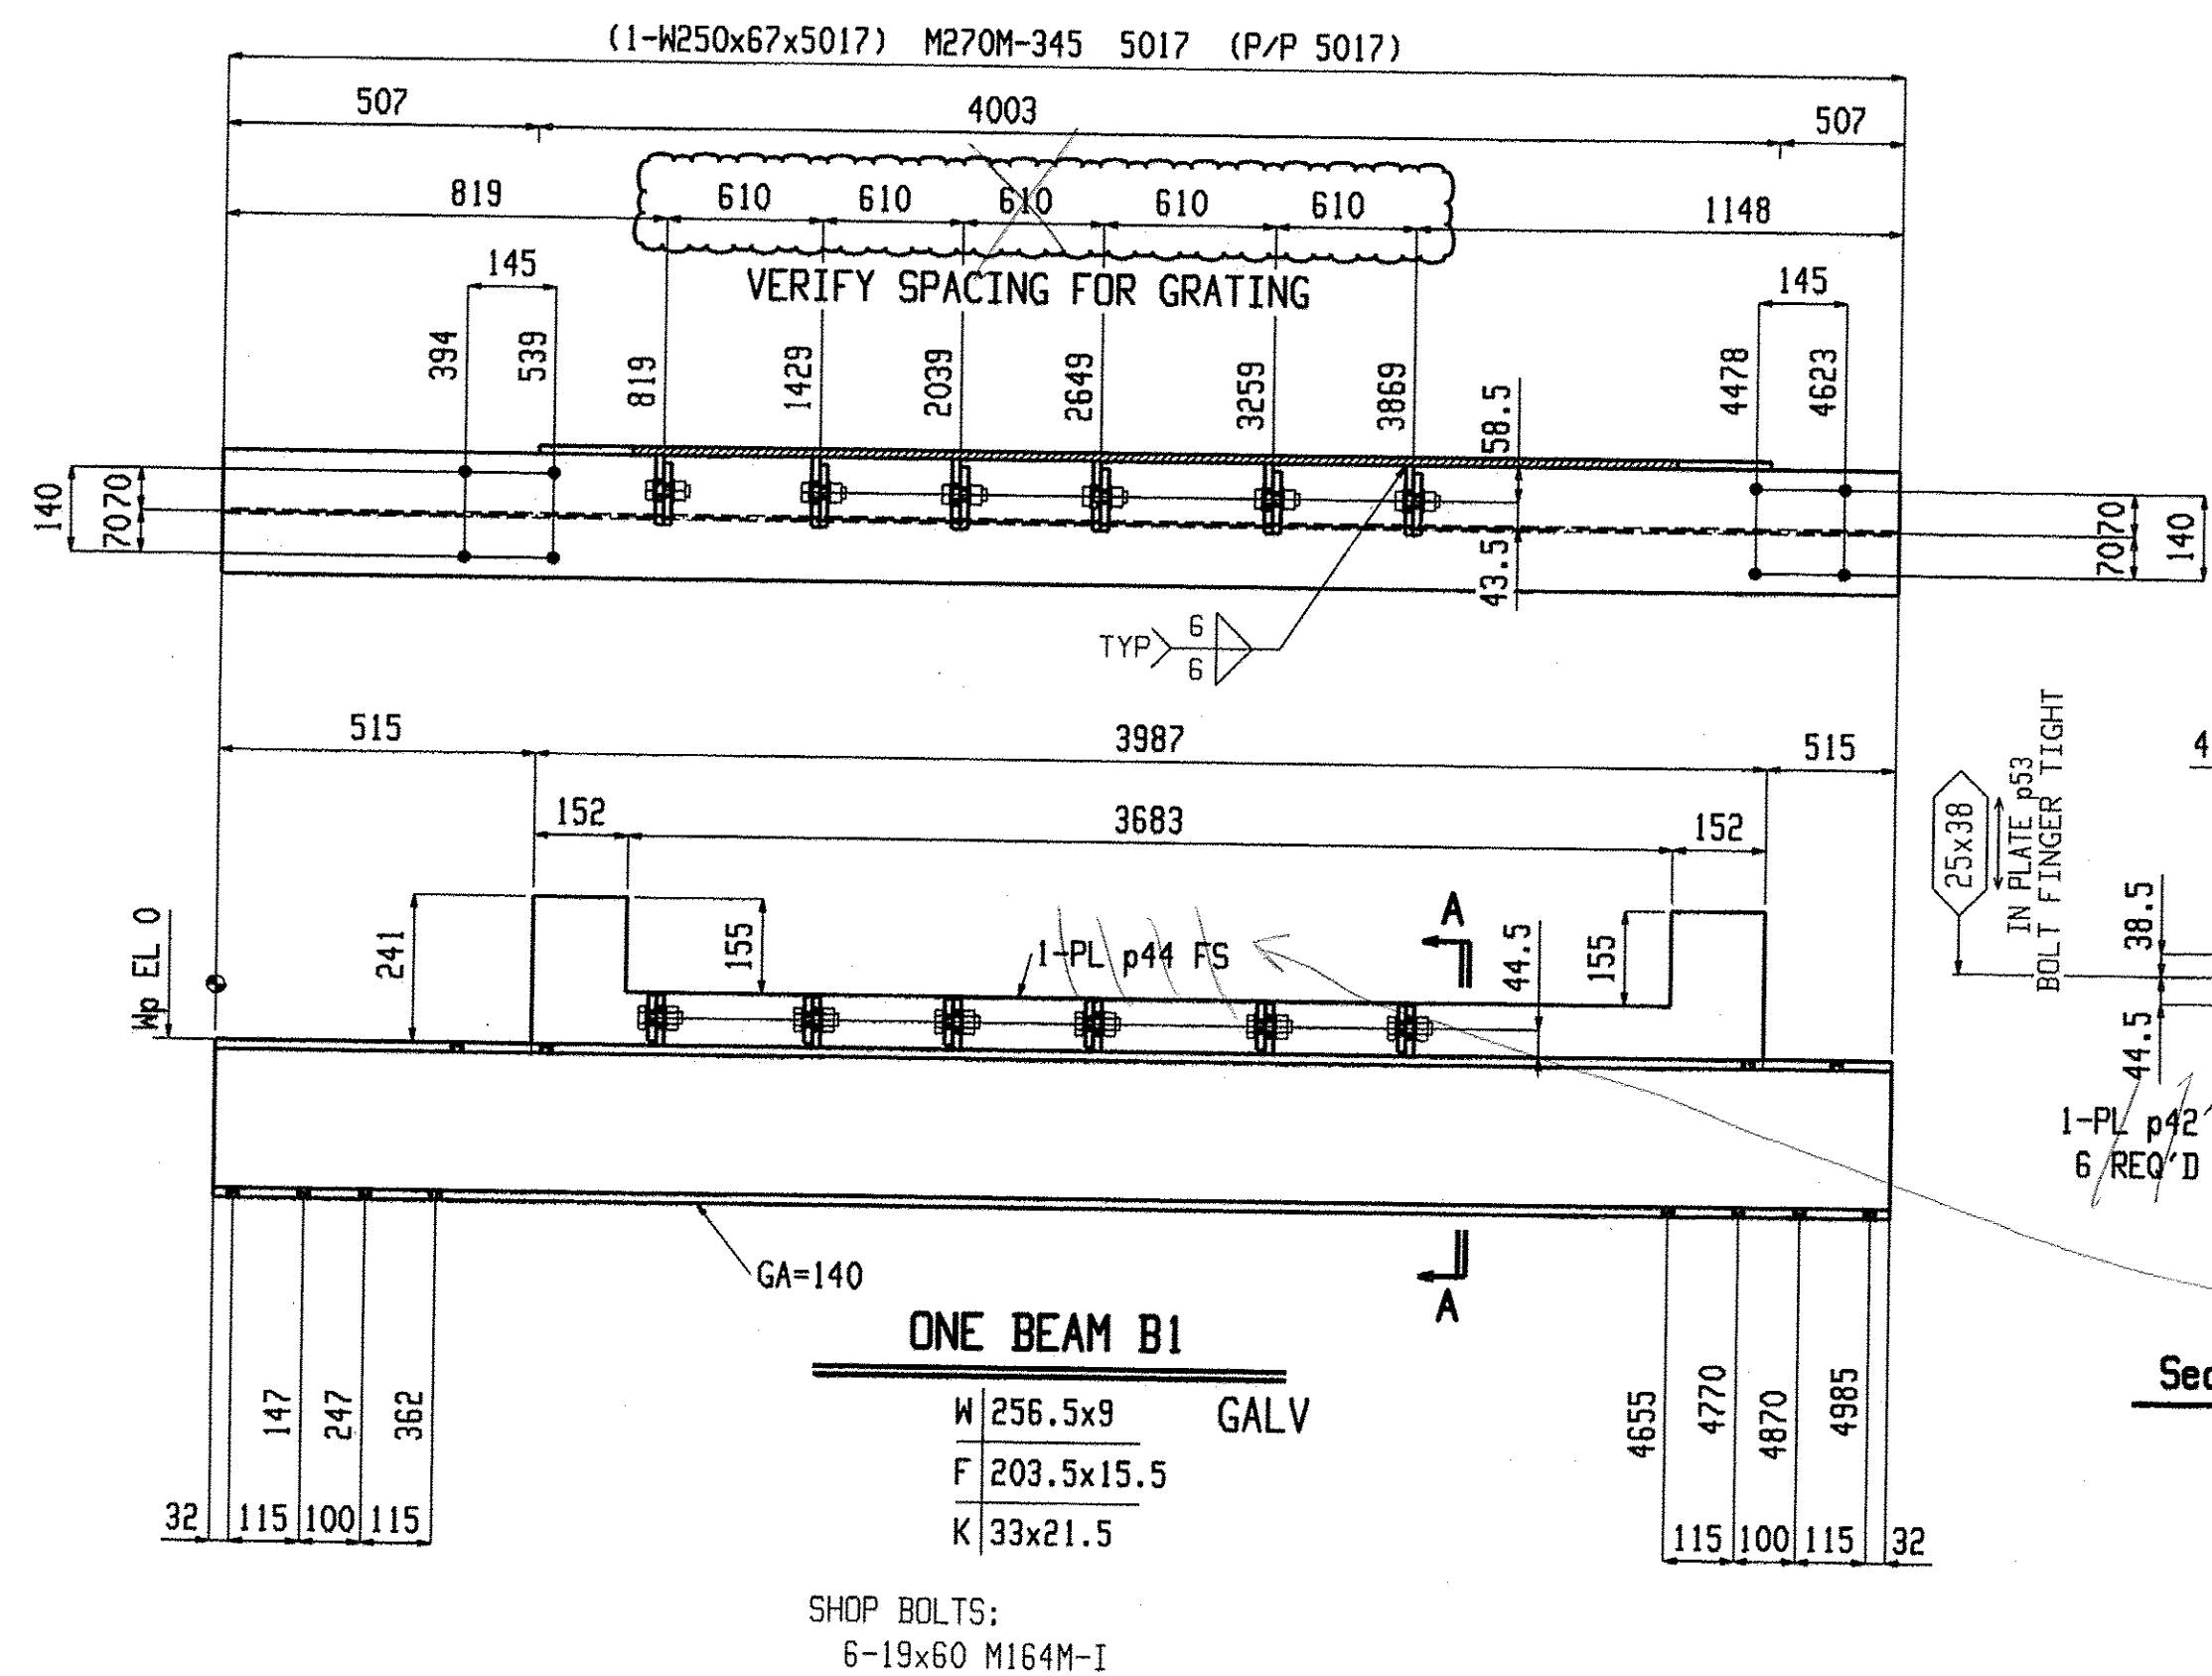

These pieces are
Part of expansion
Joint item and
drawings

BILL OF MATERIAL										BILL OF MATERIAL										BILL OF MATERIAL									
Qty	Piece			Seq	Seq	Adv	Steel			Qty	Piece			Seq	Seq	Adv	Steel			Qty	Piece			Seq	Seq	Adv	Steel		
Tot.	Mark	Description	Length	NO.	Qty	ABM #	Grade	Remarks		Tot.	Mark	Description	Length	NO.	Qty	ABM #	Grade	Remarks		Tot.	Mark	Description	Length	NO.	Qty	ABM #	Grade	Remarks	
ONE B1	BEAM			1	1			GALV		24 B3	BEAM			1	24			GALV		6		19 Dia M164M-I	60					2HD WASH	
1 B1	M250x67		5017				M270M-345			24 B3	M250x67		5017				M270M-345			ONE B4	BEAM			1	1			GALV	
1 p44	PL13x257		3987				M270M-345			1 B4	M250x67		5017				M270M-345			1 p44	PL13x257		3987					M270M-345	
6 p42	PL13x83		101				M270M-345			6 p42	PL13x83		101				M270M-345			6 p42	PL13x83		101					M270M-345	
6 p41	PL13x77		114				M270M-345			6 p41	PL13x77		114				M270M-345			6 p41	PL13x77		114					M270M-345	
6	19 Dia M164M-I		60					2HD WASH		6	19 Dia M164M-I		60							6	19 Dia M164M-I		60						
24 B2	BEAM			1	24			GALV		24 B2	M250x67		5017				M270M-345												
24 B2	M250x67		5017				M270M-345																						

Total weight : 17512

Need to separate out
beams as they are
paid by weight. Other
pieces are lump sum
payment

Renaud Bros. Inc.		Holes: 21mm UNO	
283 Fort Bridgeman Rd. #2 Vernon, VT. 05354 Phone 1-802 257-7383		BOLTS: 19mm DIA. M164M-I GALV UNO	
		Steel GR: M270M-GR345 UNO	
		Paint: PER SPECS (GREEN) UNO	
Rev. No:		Surface Prep: PER SPECS	
Date: 9-9-09		Job No. BHO 1442(28)	
DWN. BY: EG		Checked: MRS	
Project: DUMMERSTON BRIDGE DUMMERSTON, VT		Sheet No. 1	