



2 ANGLES A1

SHOP NOTE:
TOE DIRECTION NEAR SIDE

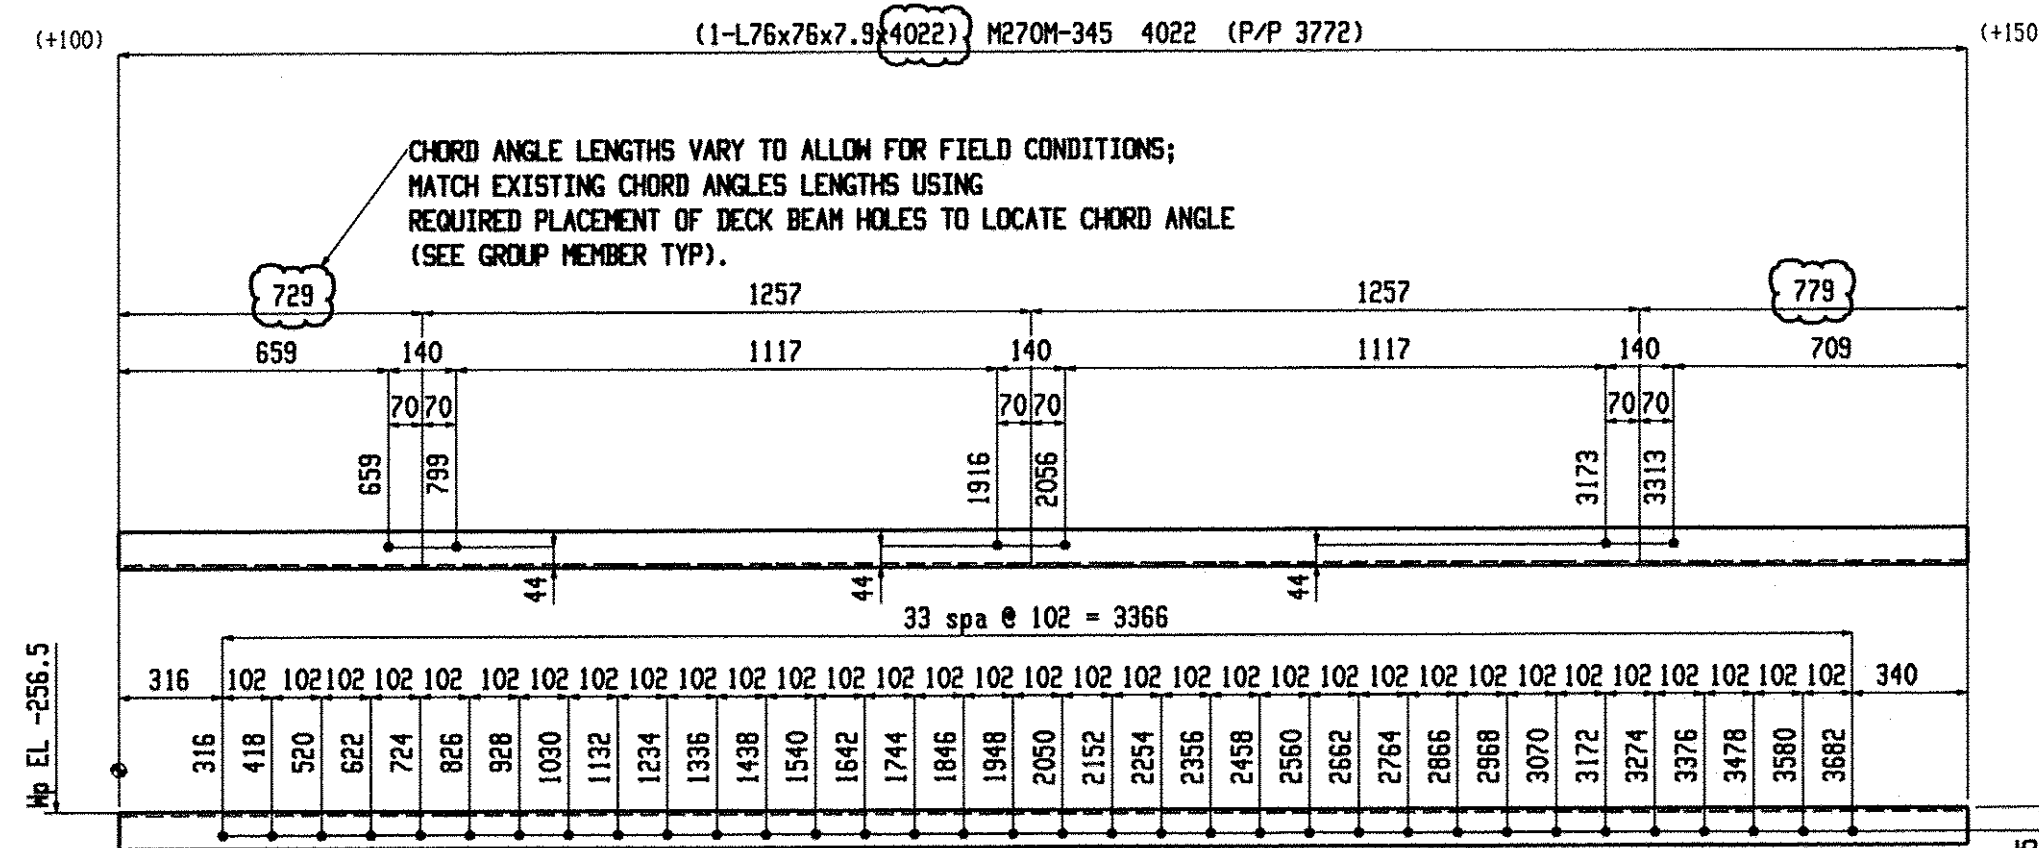


2 ANGLES A2

SHOP NOTE:
TOE DIRECTION FAR SIDE

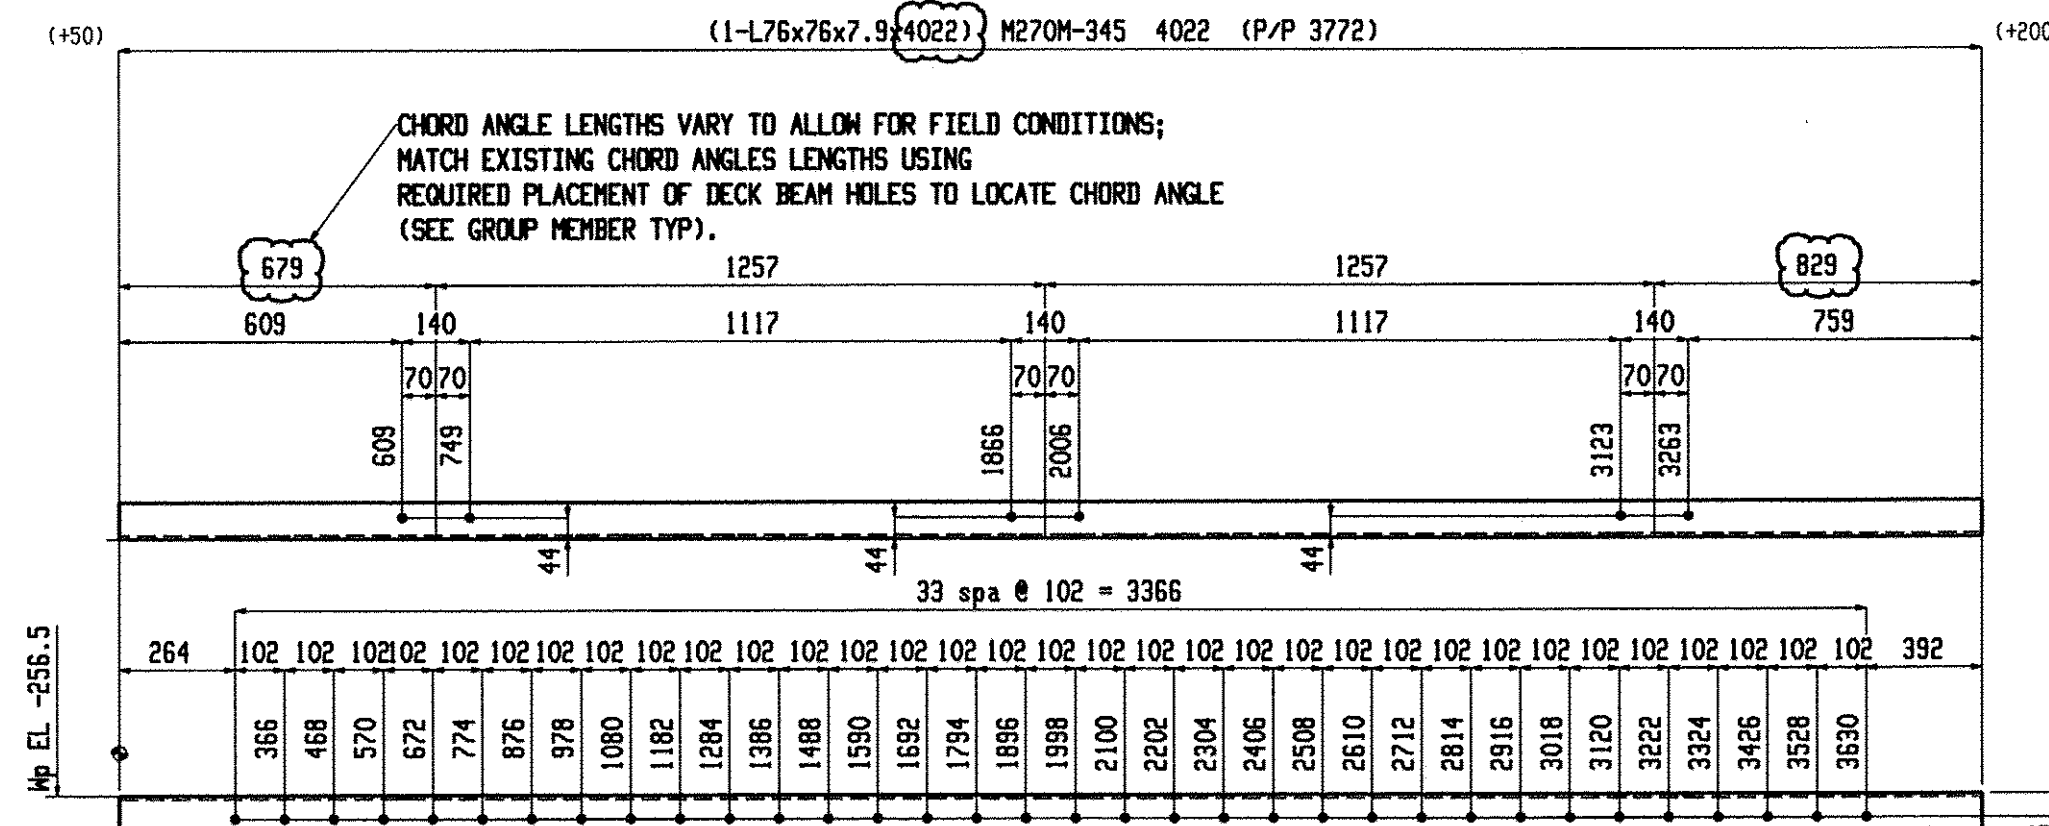

2 ANGLES A3

SHOP NOTE:
TOE DIRECTION FAR SIDE

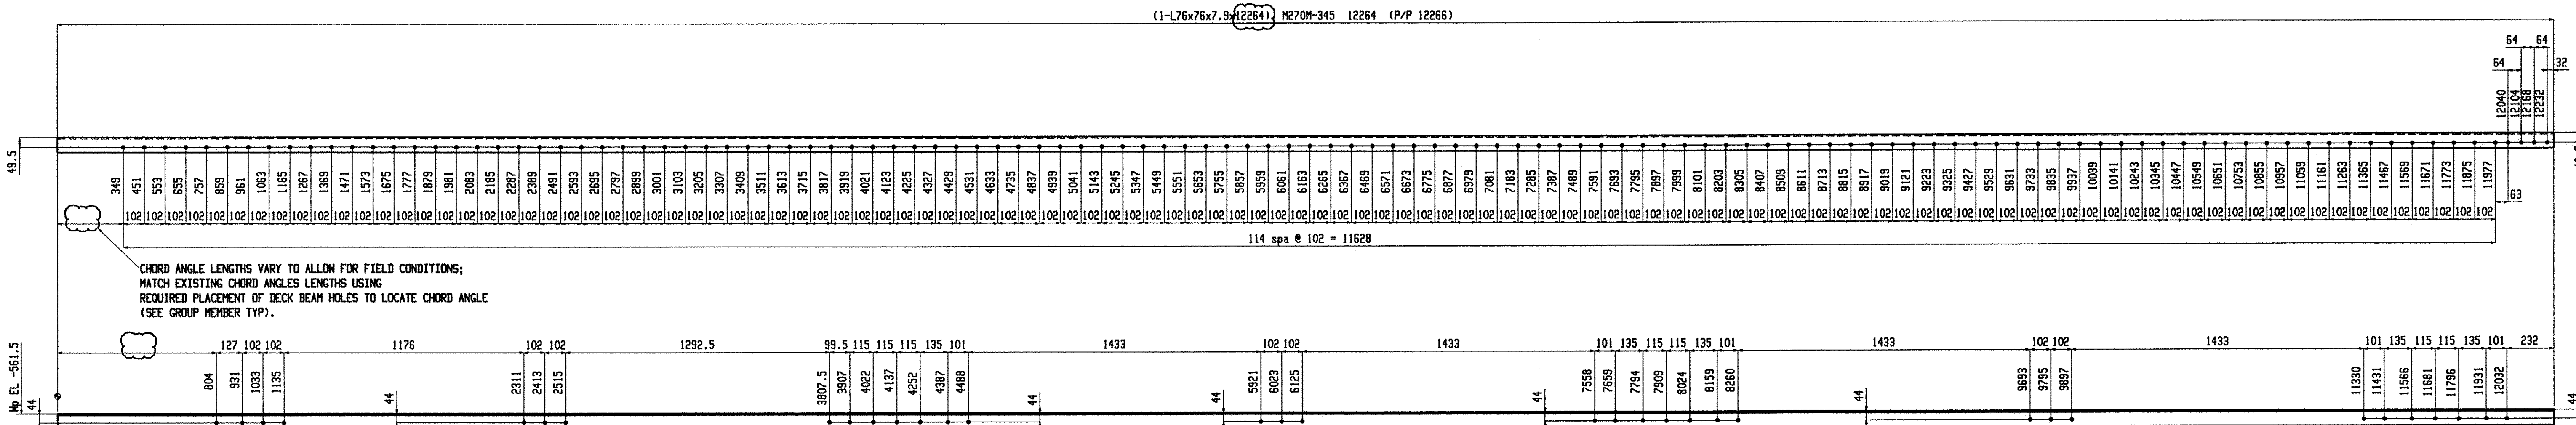

2 ANGLES A4

SHOP NOTE:
TOE DIRECTION NEAR SIDE

RECEIVED
OK'D BY: _____ OK'D BY: _____
NOV 17 2009
RECEIVED APPROVED BY: *As Noted*
BY: _____ DATE: _____

NOTE: WORK THIS DRAWING WITH
GROUP MEMBER GM1

BILL OF MATERIAL										BILL OF MATERIAL										BILL OF MATERIAL										
Qty	Piece									Qty	Piece									Qty	Piece									
Tot.	Mark	Description	Length	Seq. NO.	Seq. Qty	Adv. ABM #	Steel Grade	Remarks		Tot.	Mark	Description	Length	Seq. NO.	Seq. Qty	Adv. ABM #	Steel Grade	Remarks		Tot.	Mark	Description	Length	Seq. NO.	Seq. Qty	Adv. ABM #	Steel Grade	Remarks		
2	A1	ANGLE		1	2					2	A3	ANGLE		1	2															
2	A1	L76x76x7.9	3887				M270M-345			2	A3	L76x76x7.9	4022				M270M-345													
2	A2	ANGLE		1	2					2	A4	ANGLE		1	2															
2	A2	L76x76x7.9	4022				M270M-345			2	A4	L76x76x7.9	12264				M270M-345													

Total weight : 435

Renaud Bros. Inc.
283 Fort Bridgeman Rd. #2
Vernon, VT. 05354
Phone 1-802 257-7383

Holes: 21mm UNO
BOLTS: 19mm DIA. M164M-I GALV UNO
Steel GR: M270M-GR345 UNO
Paint: PER SPECS (GREEN) UNO
Surface Prep: PER SPECS

Project: **DUMMERSTON BRIDGE**
DUMMERSTON, VT

Date: 9-9-09
Job No. BHO 1442 (28)
Checked: MRS
Sheet No. 5