




**2 ANGLES A5**  
SHOP NOTE:  
TOE DIRECTION NEAR SIDE

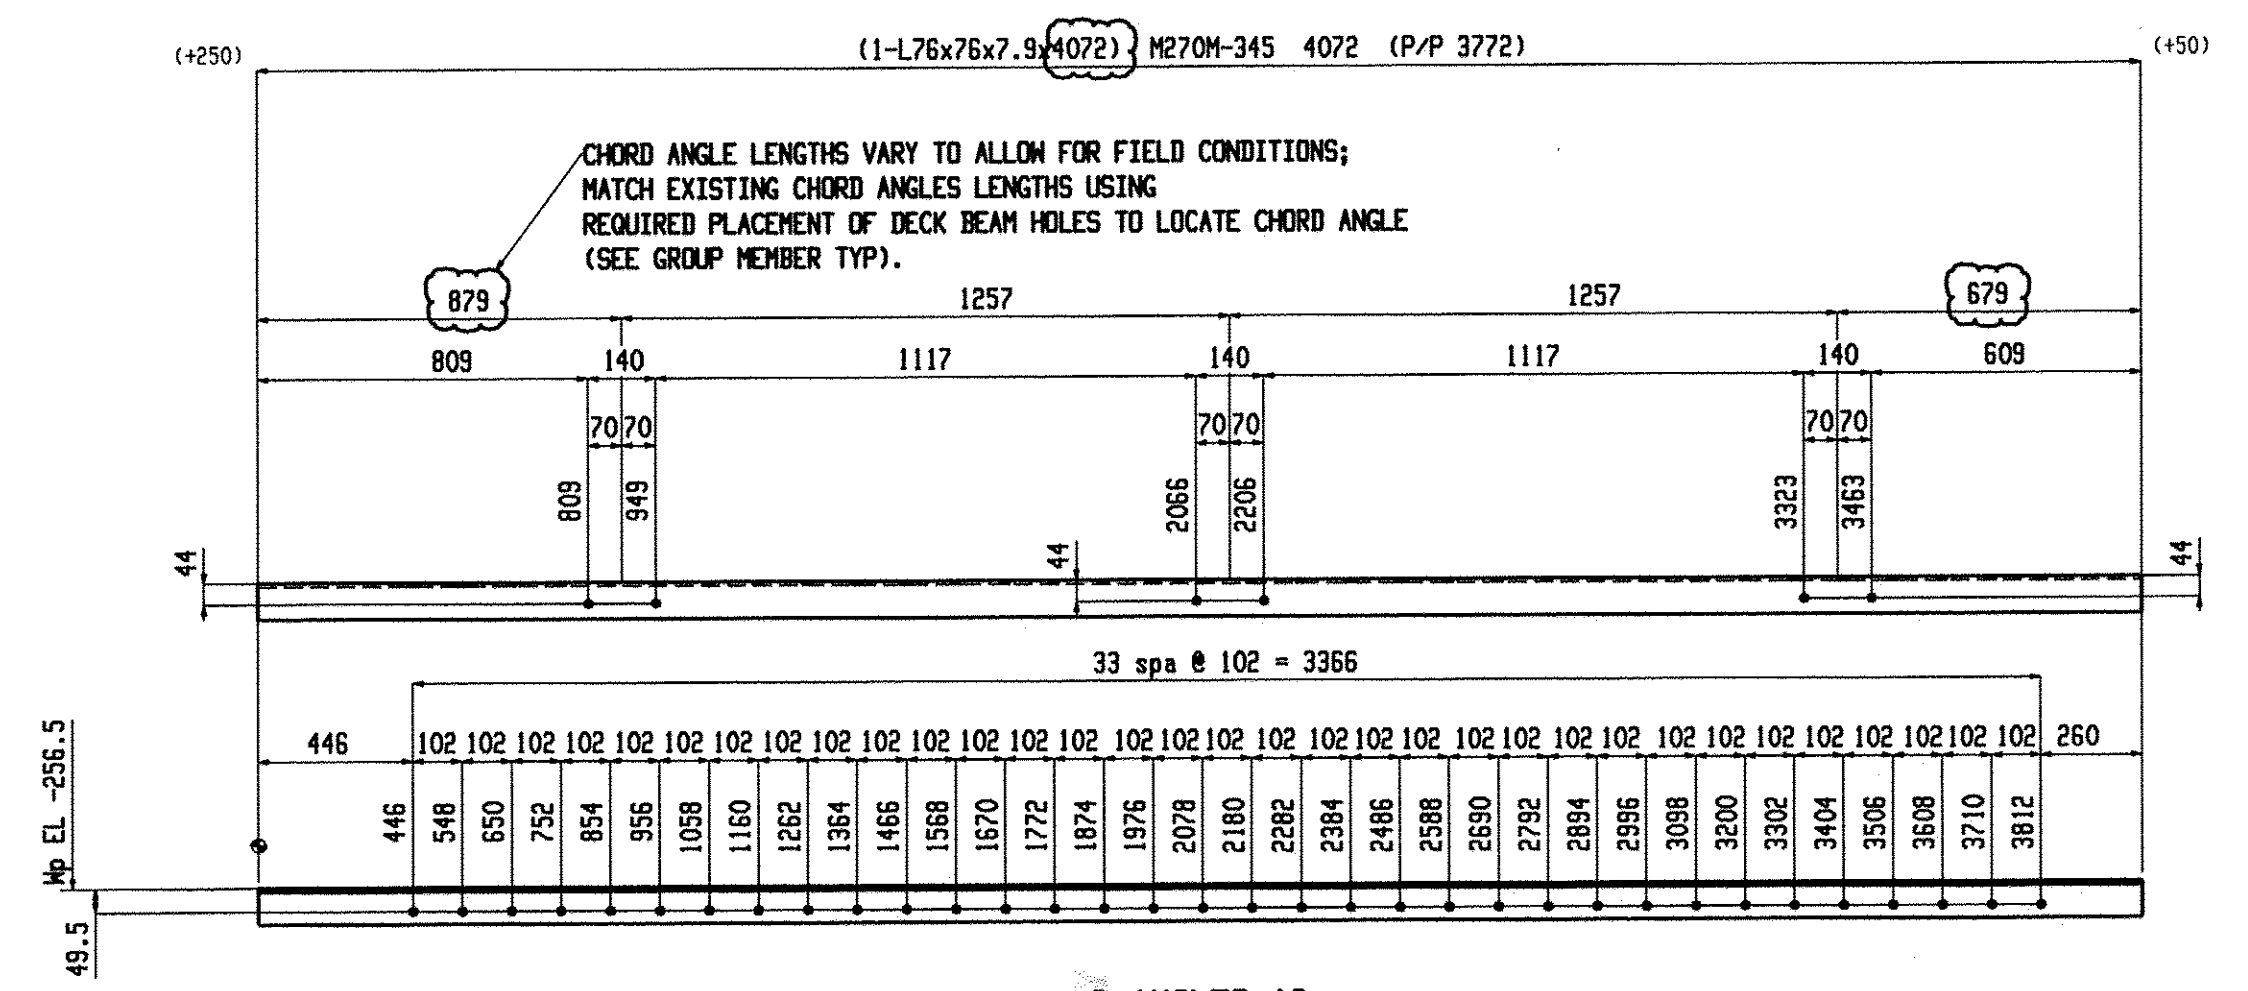

**2 ANGLES A6**  
SHOP NOTE:  
TOE DIRECTION NEAR SIDE

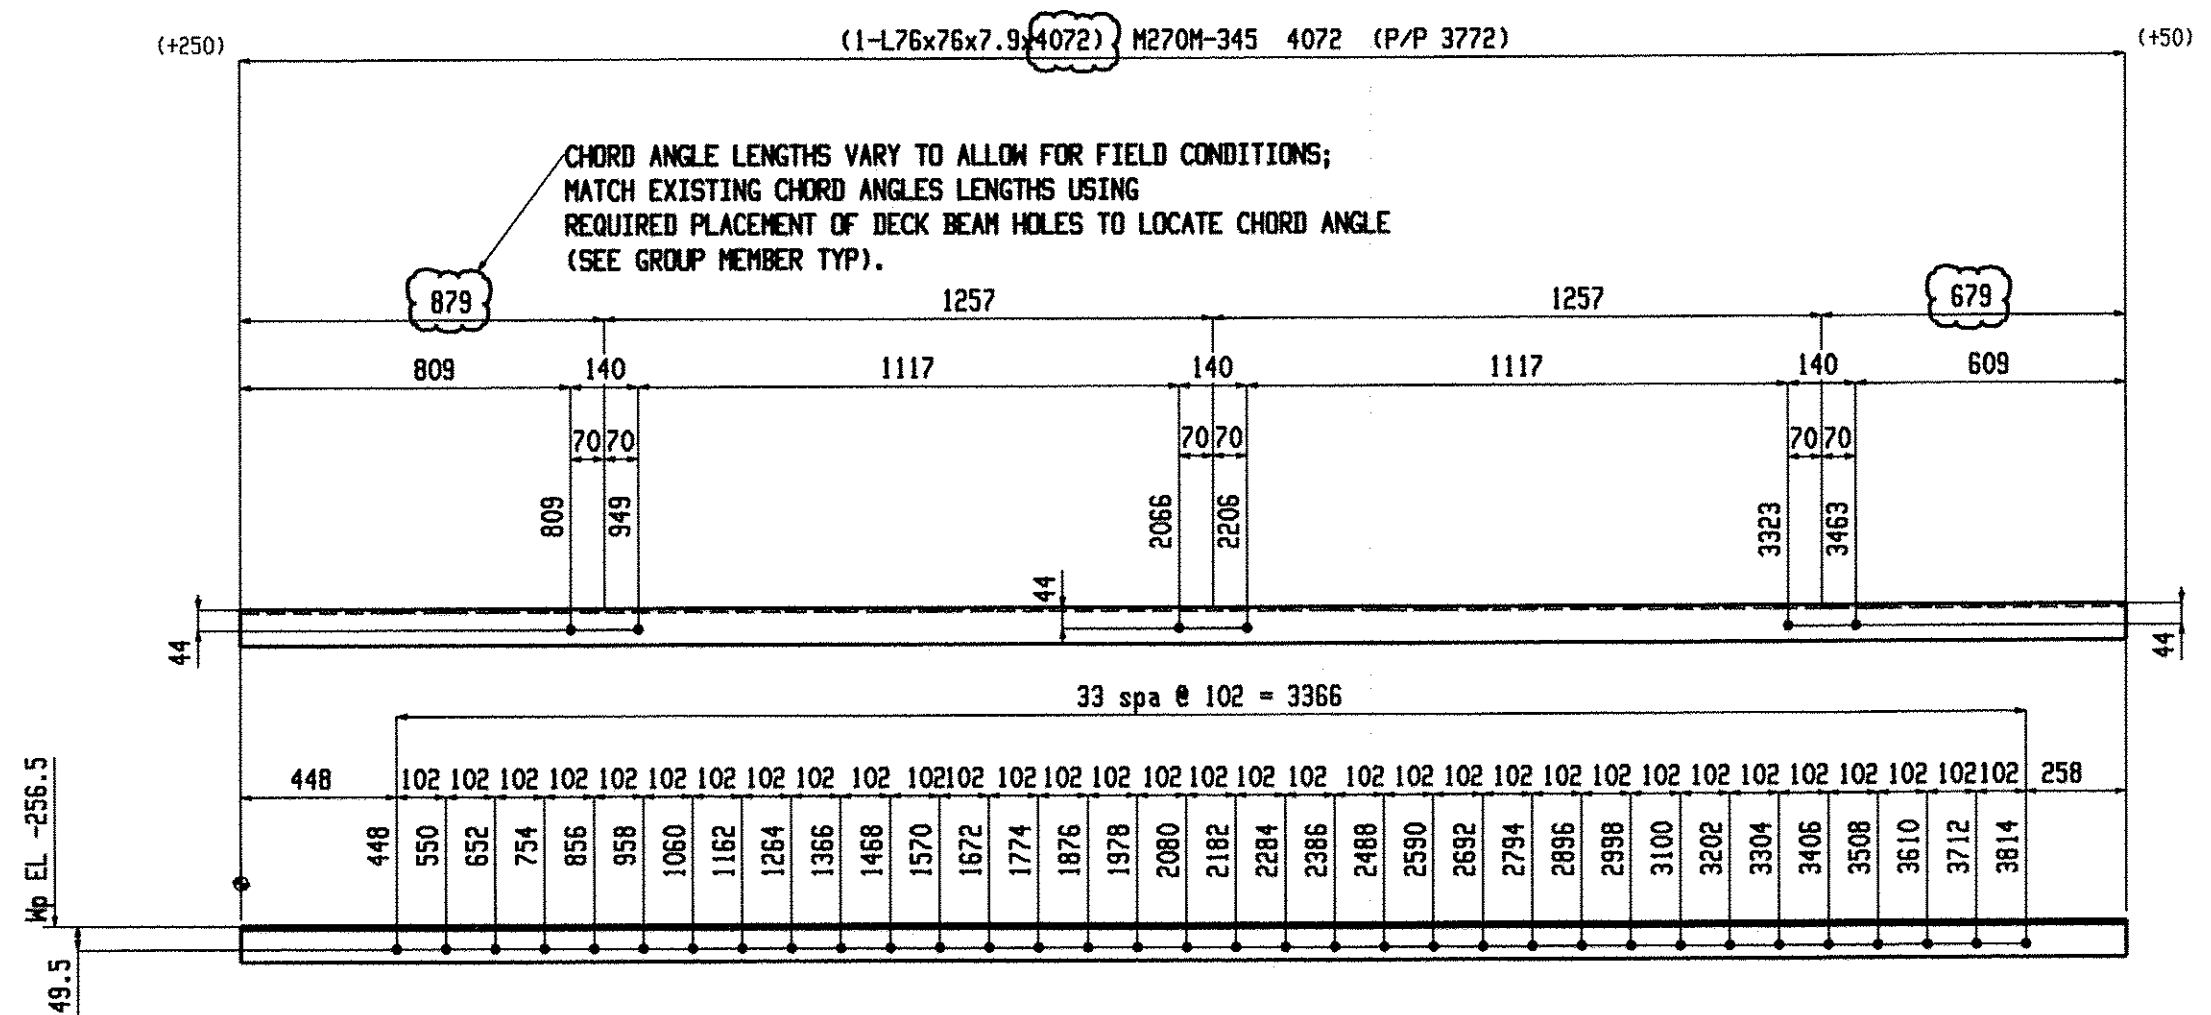

**2 ANGLES A7**  
SHOP NOTE:  
TOE DIRECTION NEAR SIDE

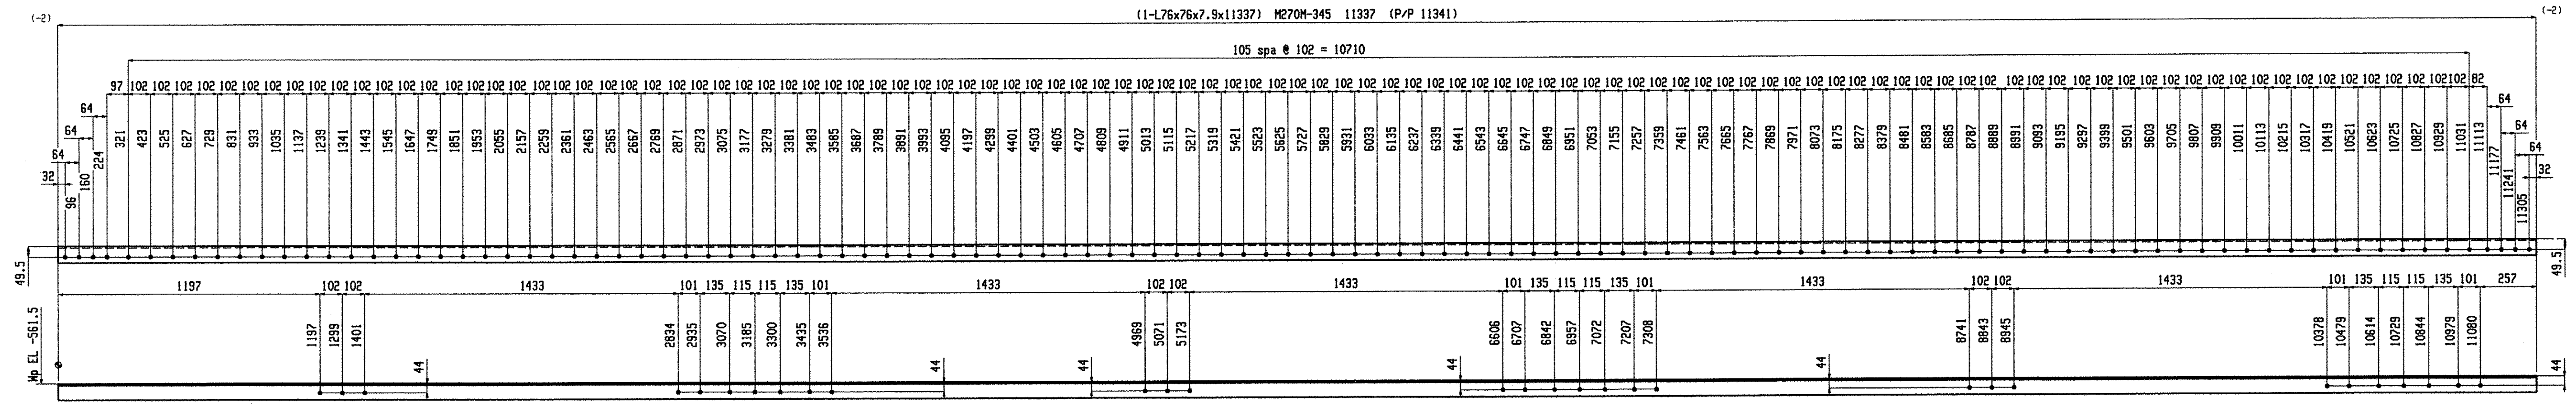

**2 ANGLES A8**  
SHOP NOTE:  
TOE DIRECTION NEAR SIDE

RECEIVED  
NOV 17 2008  
APPROVED: [Signature]  
DATE

NOTE: WORK THIS DRAWING WITH GROUP MEMBER GM2

BILL OF MATERIAL										BILL OF MATERIAL										BILL OF MATERIAL										
Qty	Prece									Qty	Prece									Qty	Prece									
Tot.	Mark	Description	Length	Seq NO.	Seq Qty	Adv ABM #	Steel Grade	Remarks		Tot.	Mark	Description	Length	Seq NO.	Seq Qty	Adv ABM #	Steel Grade	Remarks		Tot.	Mark	Description	Length	Seq NO.	Seq Qty	Adv ABM #	Steel Grade	Remarks		
2	A5	ANGLE		1	2					2	A7	ANGLE		1	2															
2	A5	L76x76x7.9	4072				M270M-345			2	A7	L76x76x7.9	4072				M270M-345													
2	A6	ANGLE		1	2					2	A8	ANGLE		1	2															
2	A6	L76x76x7.9	4072				M270M-345			2	A8	L76x76x7.9	11337				M270M-345													

Total weight : 423

**Renaud Bros. Inc.**  
283 Fort Bridgeman Rd. #2  
Vernon, VT. 05354  
Phone 1-802 257-7383

Holes: 21mm UNO  
BOLTS: 19mm DIA. M164M-I GALV UNO  
Steel GR: M270M-GR345 UNO  
Paint: PER SPECS (GREEN) UNO  
Surface Prep: PER SPECS

Project: **DUMMERSTON BRIDGE**  
DUMMERSTON, VT

Date: 9-9-09  
Job No. BHO 1442(28)  
Sheet No. 6

Rev.No. Date: 9-9-09  
DWN. BY: EG  
Checked: MRS