




2 ANGLES A14
SHOP NOTE:
TOE DIRECTION FAR SIDE

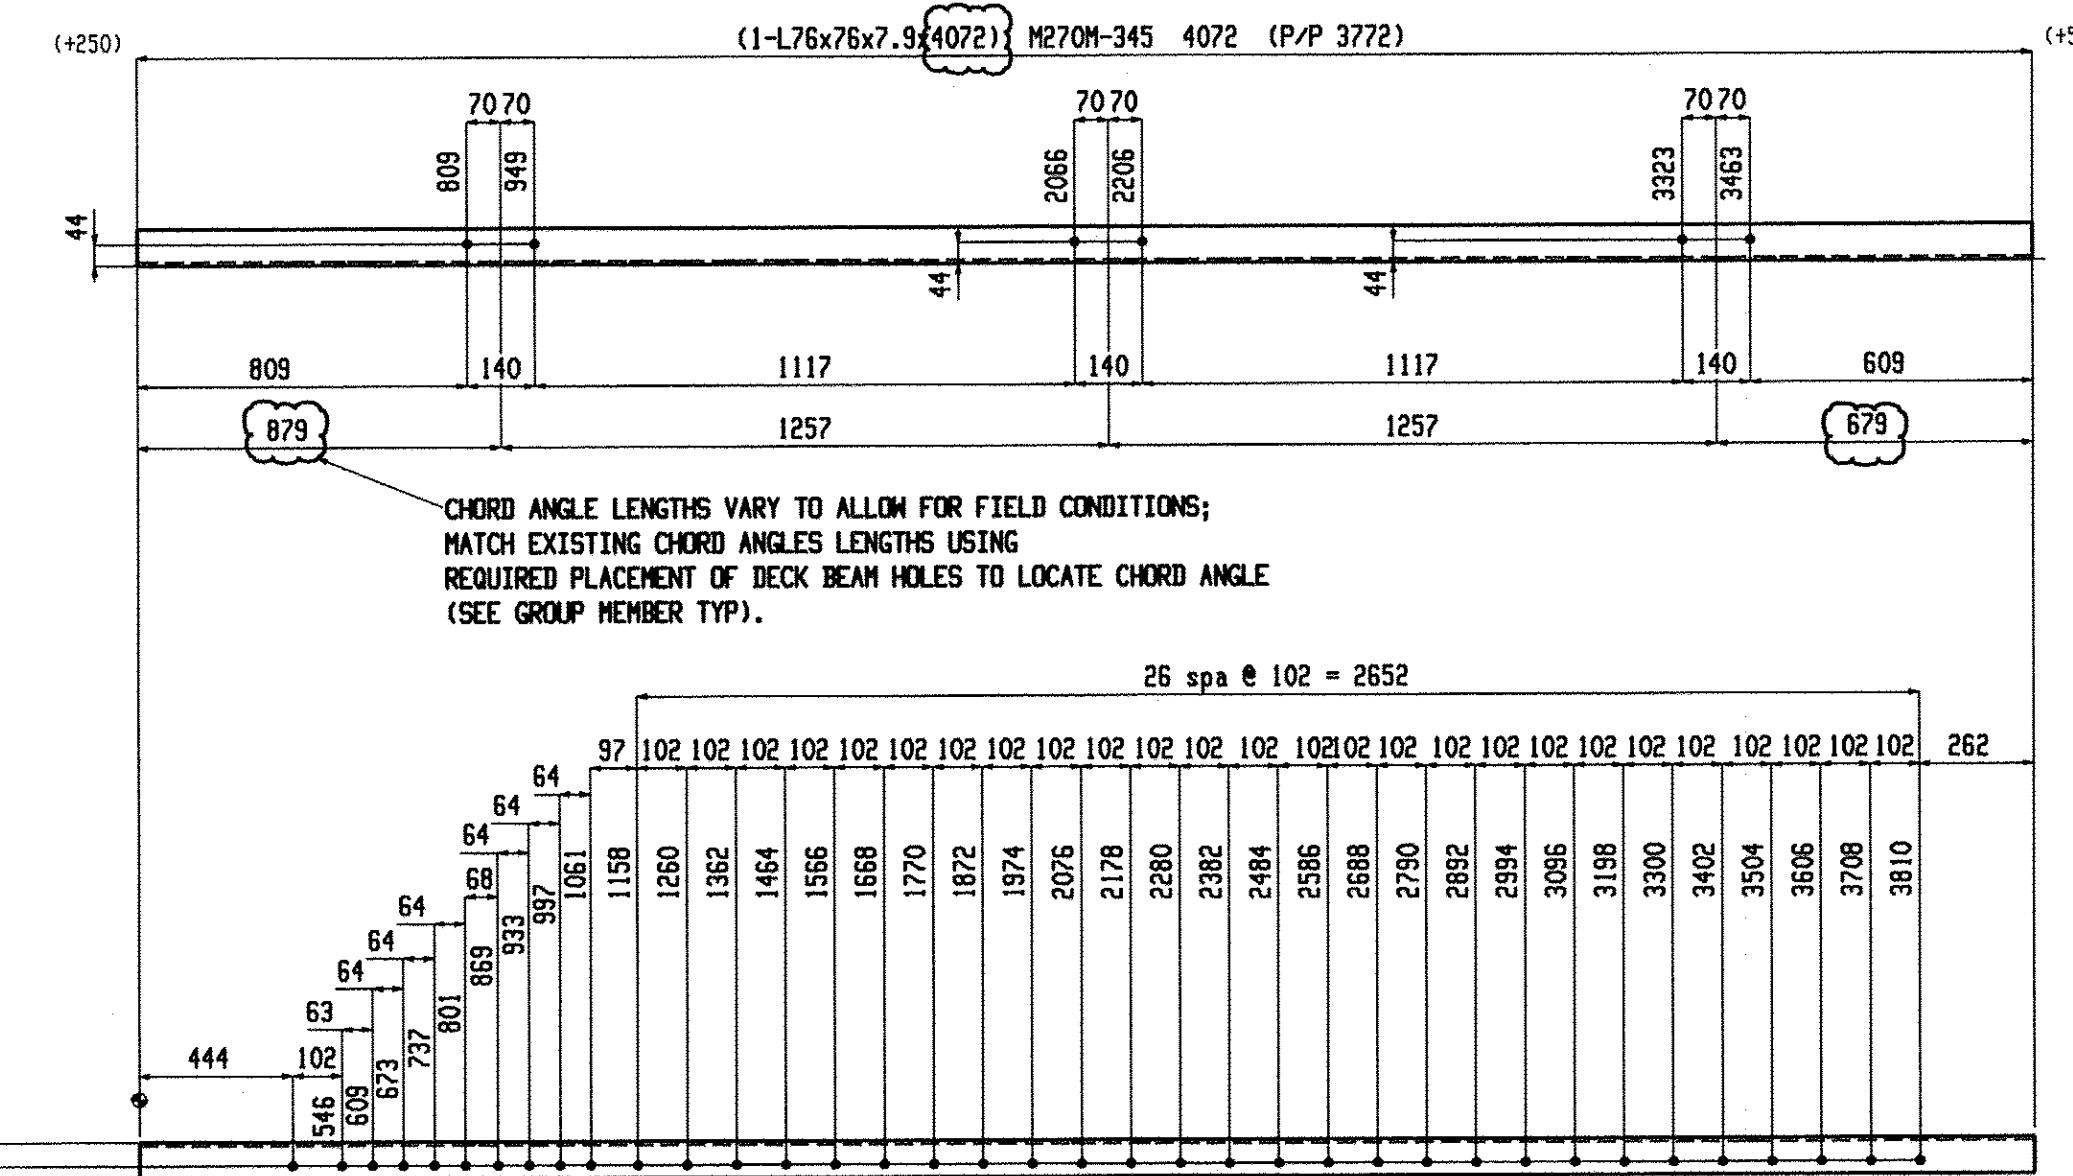

2 ANGLES A16
SHOP NOTE:
TOE DIRECTION FAR SIDE

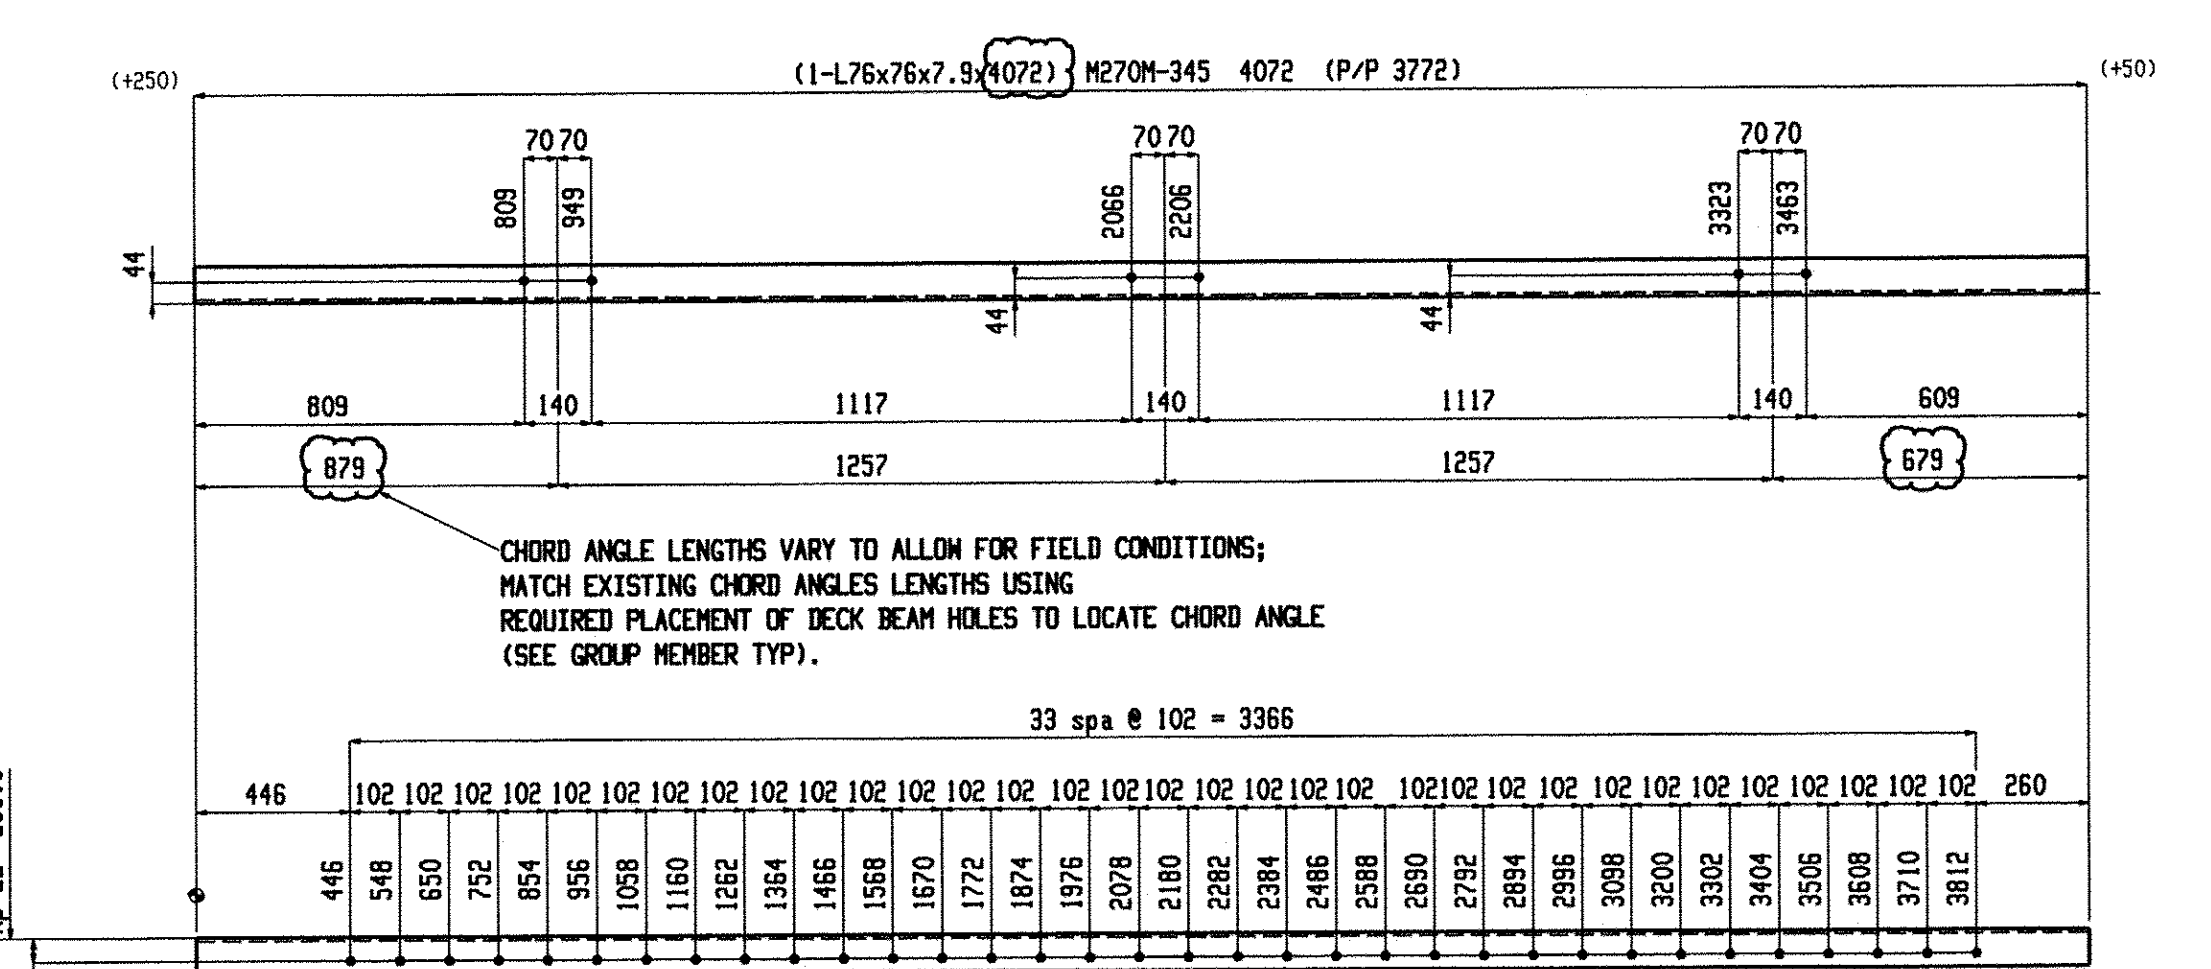

2 ANGLES A15
SHOP NOTE:
TOE DIRECTION FAR SIDE

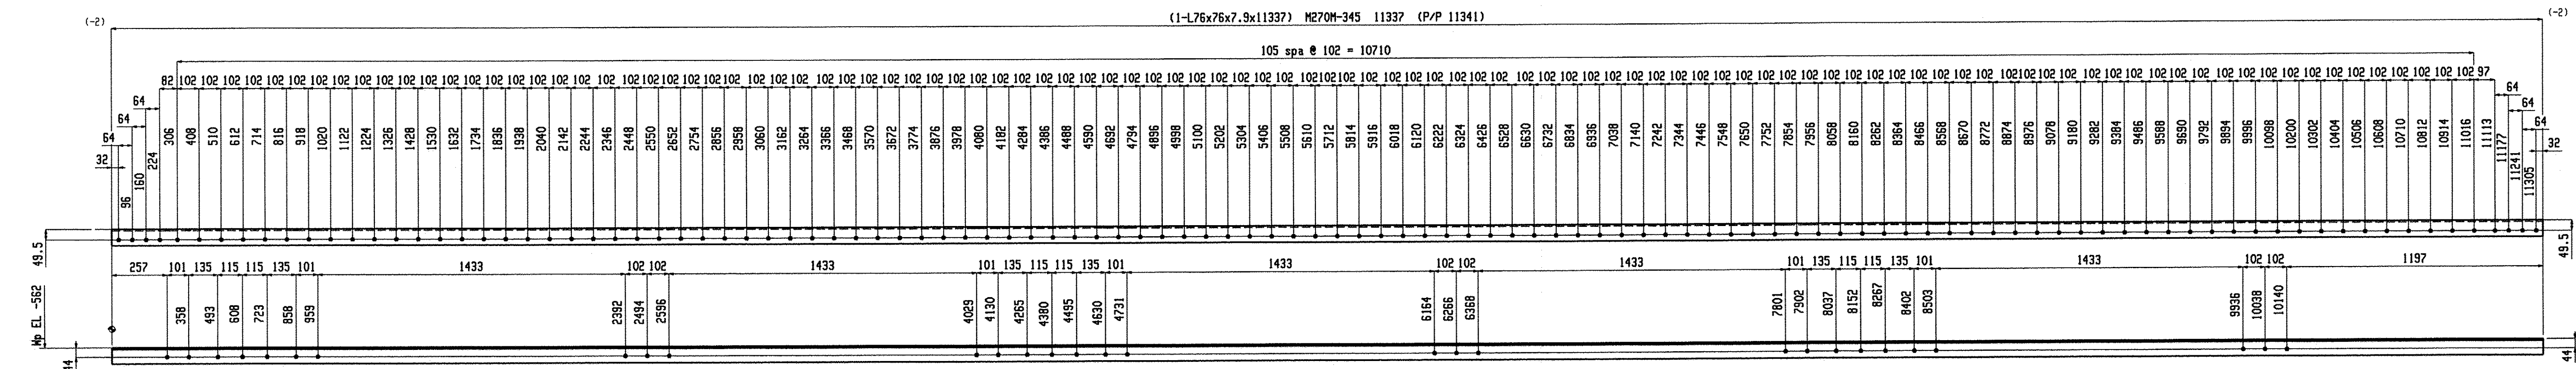

2 ANGLES A17
SHOP NOTE:
TOE DIRECTION NEAR SIDE

RECEIVED
NOV 17 2009
APPROVED
BY DATE

NOTE: WORK THIS DRAWING WITH GROUP MEMBER GM4

BILL OF MATERIAL								BILL OF MATERIAL								BILL OF MATERIAL										
Qty	Piece	Description	Length	Seq NO.	Seq Qty	Adv ABM #	Steel Grade	Remarks	Qty	Piece	Description	Length	Seq NO.	Seq Qty	Adv ABM #	Steel Grade	Remarks	Qty	Piece	Description	Length	Seq NO.	Seq Qty	Adv ABM #	Steel Grade	Remarks
2	A14	ANGLE		1	2				2	A16	ANGLE		1	2												
2	A14	L76x76x7.9	4072				M270M-345		2	A16	L76x76x7.9	4072					M270M-345									
2	A15	ANGLE		1	2				2	A17	ANGLE		1	2												
2	A15	L76x76x7.9	4072				M270M-345		2	A17	L76x76x7.9	11337					M270M-345									

Total weight: 423

Renaud Bros. Inc.
283 Fort Bridgeman Rd. #2
Vernon, VT. 05354
Phone 1-802 257-7383

Project: **DUMMERSTON BRIDGE**
DUMMERSTON, VT

Date: 9-9-09
Checked: MRS

Holes: 21mm UNF
Bolts: 19mm DIA. M164M-I GALV UNF
Steel GR: M270M-GR345 UNF
Paint: PER SPECS (GREEN) UNF
Surface Prep: PER SPECS

Job No. BHO 1442 (28)
Sheet No. 8